


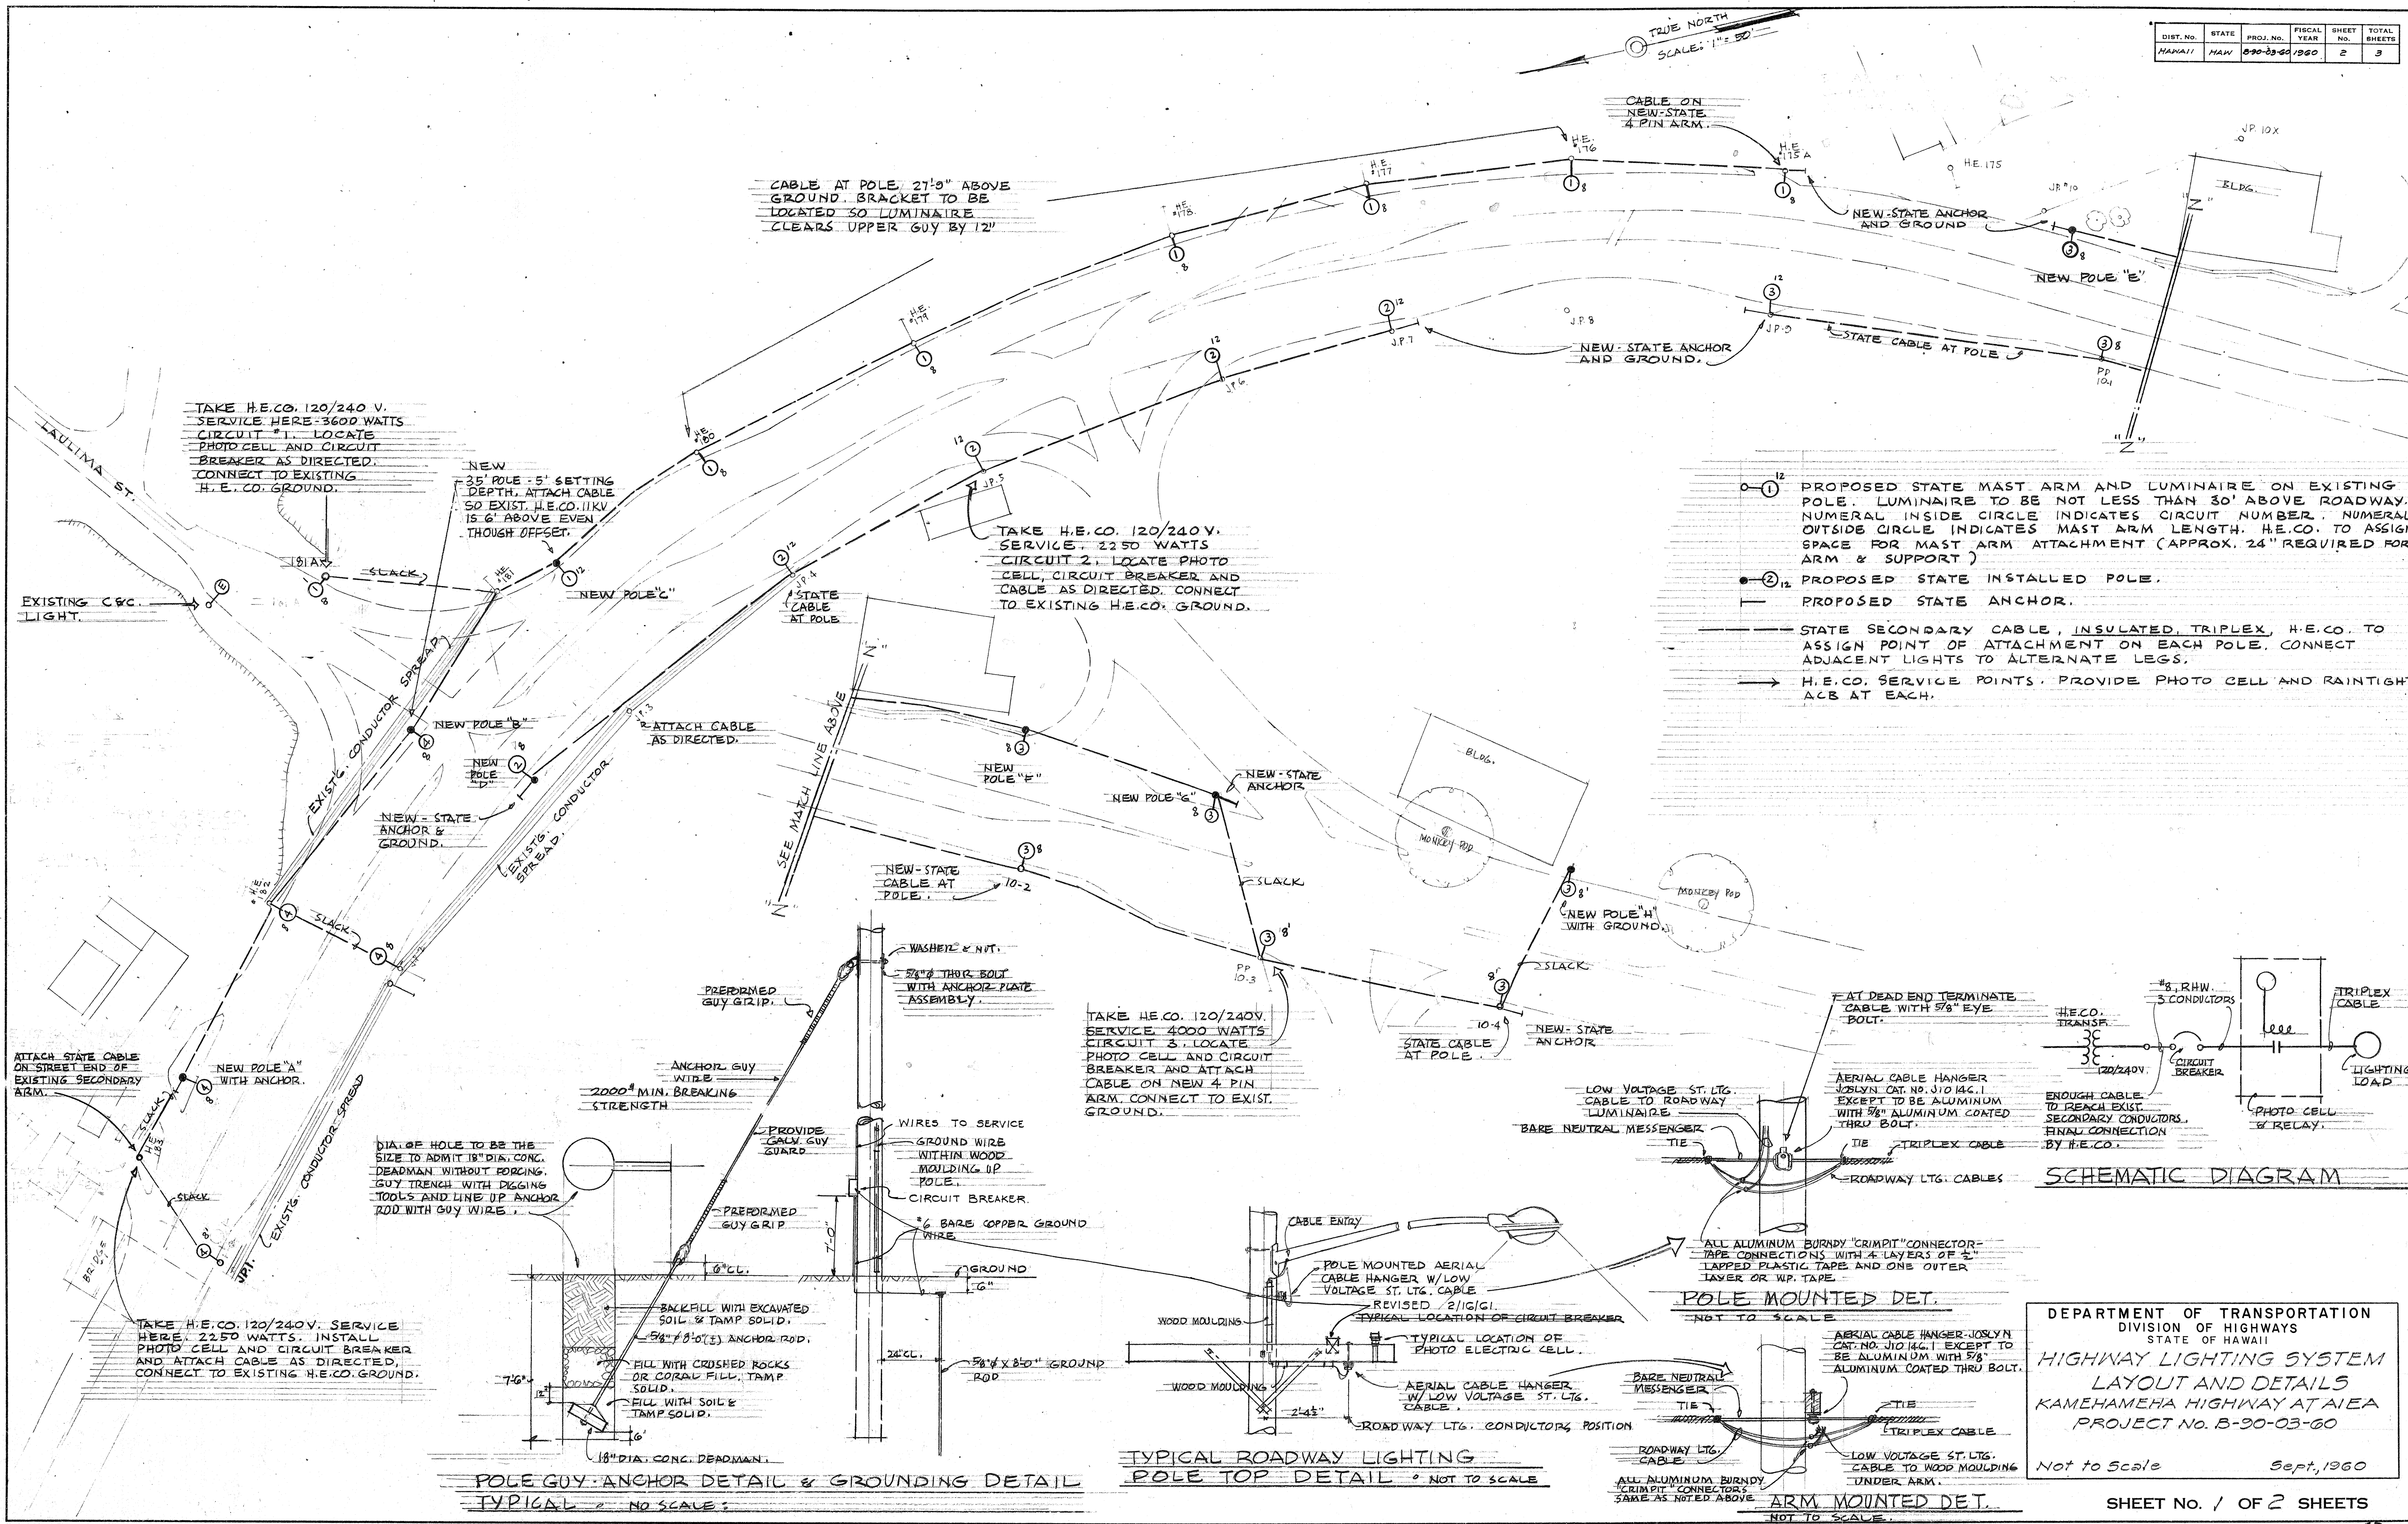


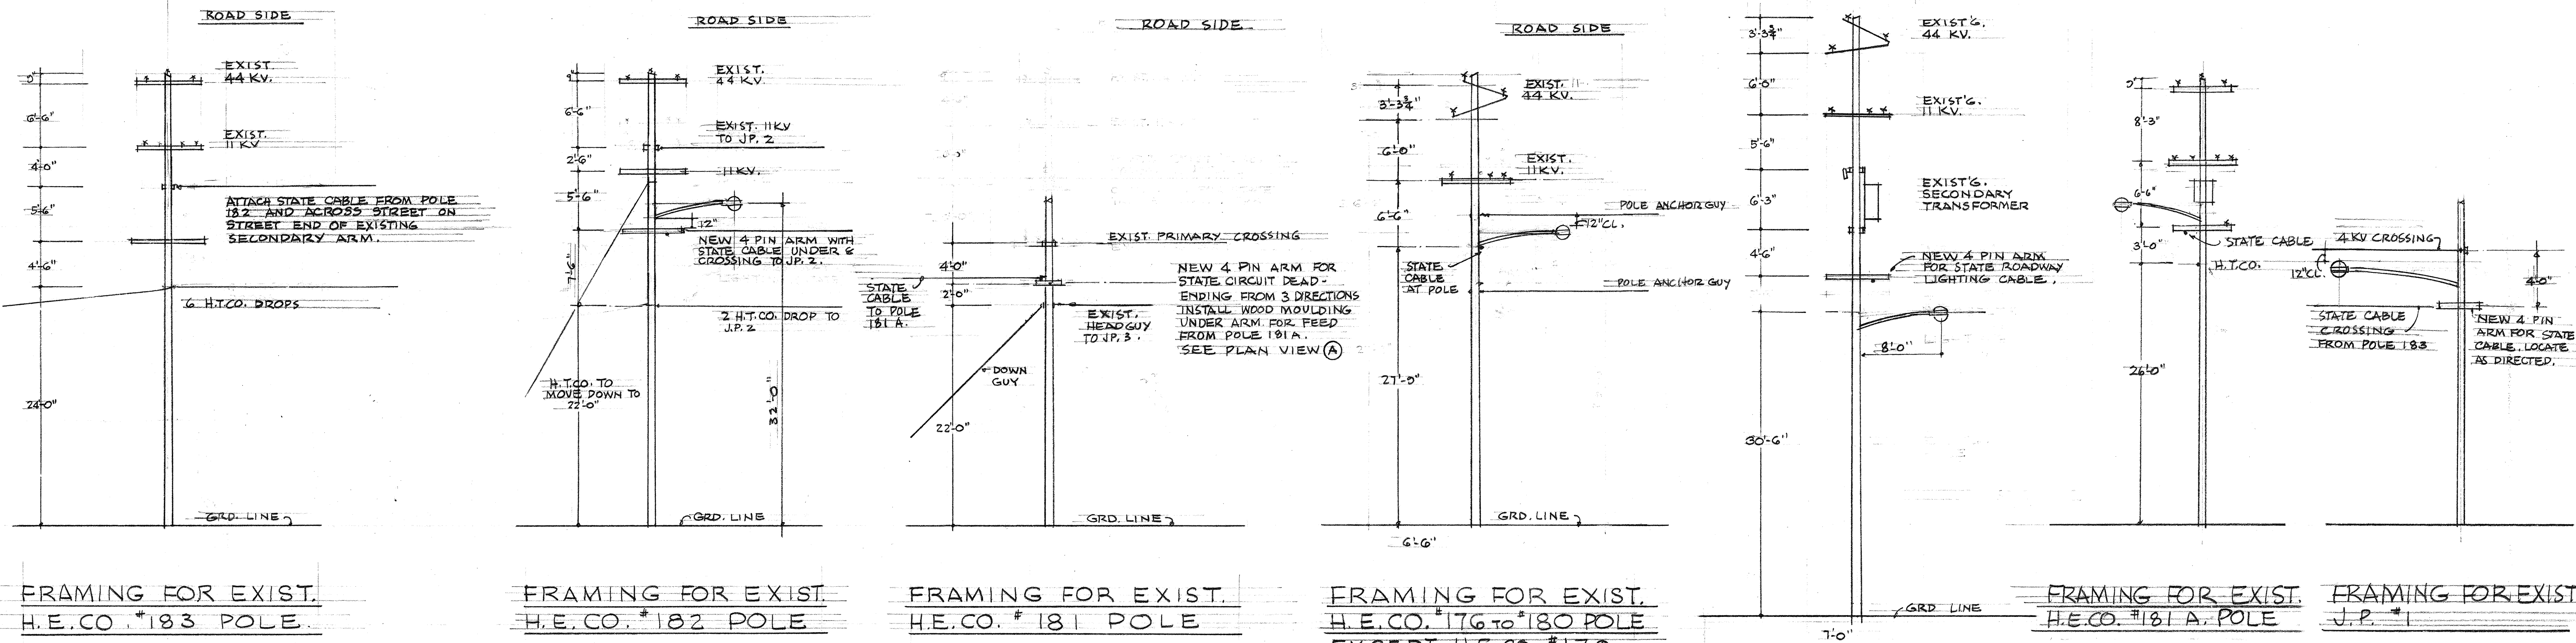


DIST. NO.	STATE	PROJ. NO.	FISCAL YEAR	SHEET NO.	TOTAL SHEETS
HAWAII	HAW.	B-90-03-60	1960	3	3

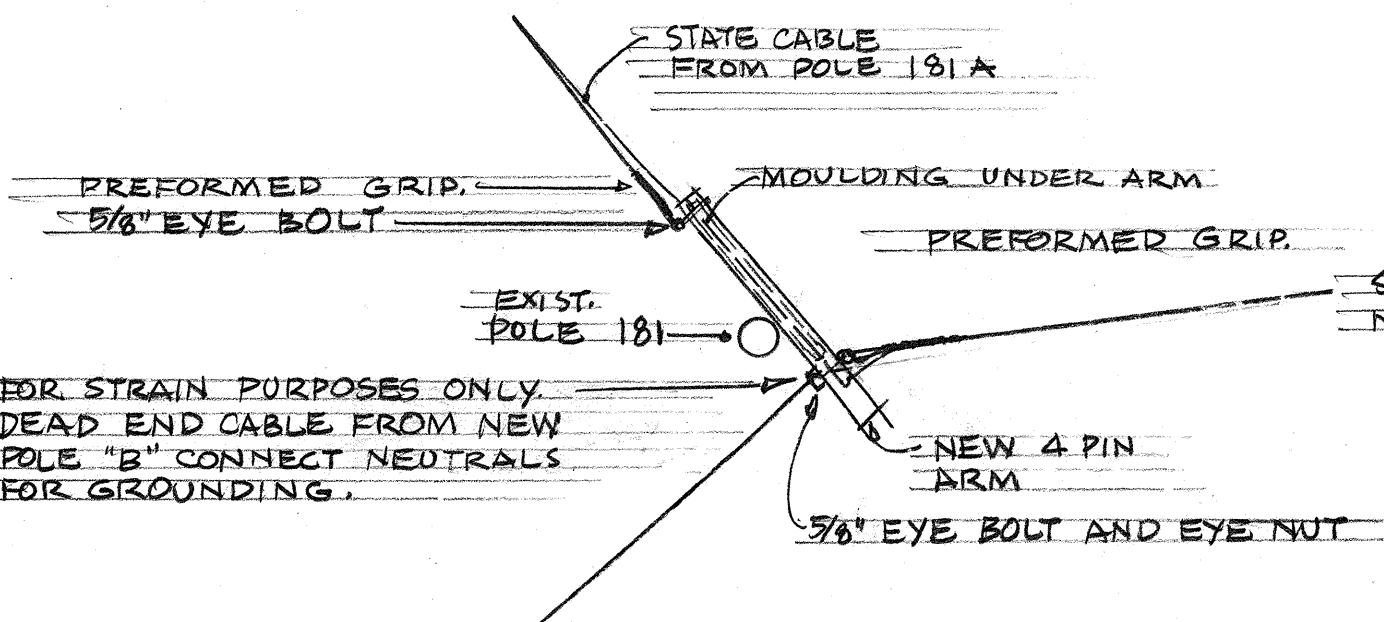

LOCATE BRACKET AS HIGH AS POSSIBLE BUT MAINTAIN 12" RADIAL CLEARANCE HERE.

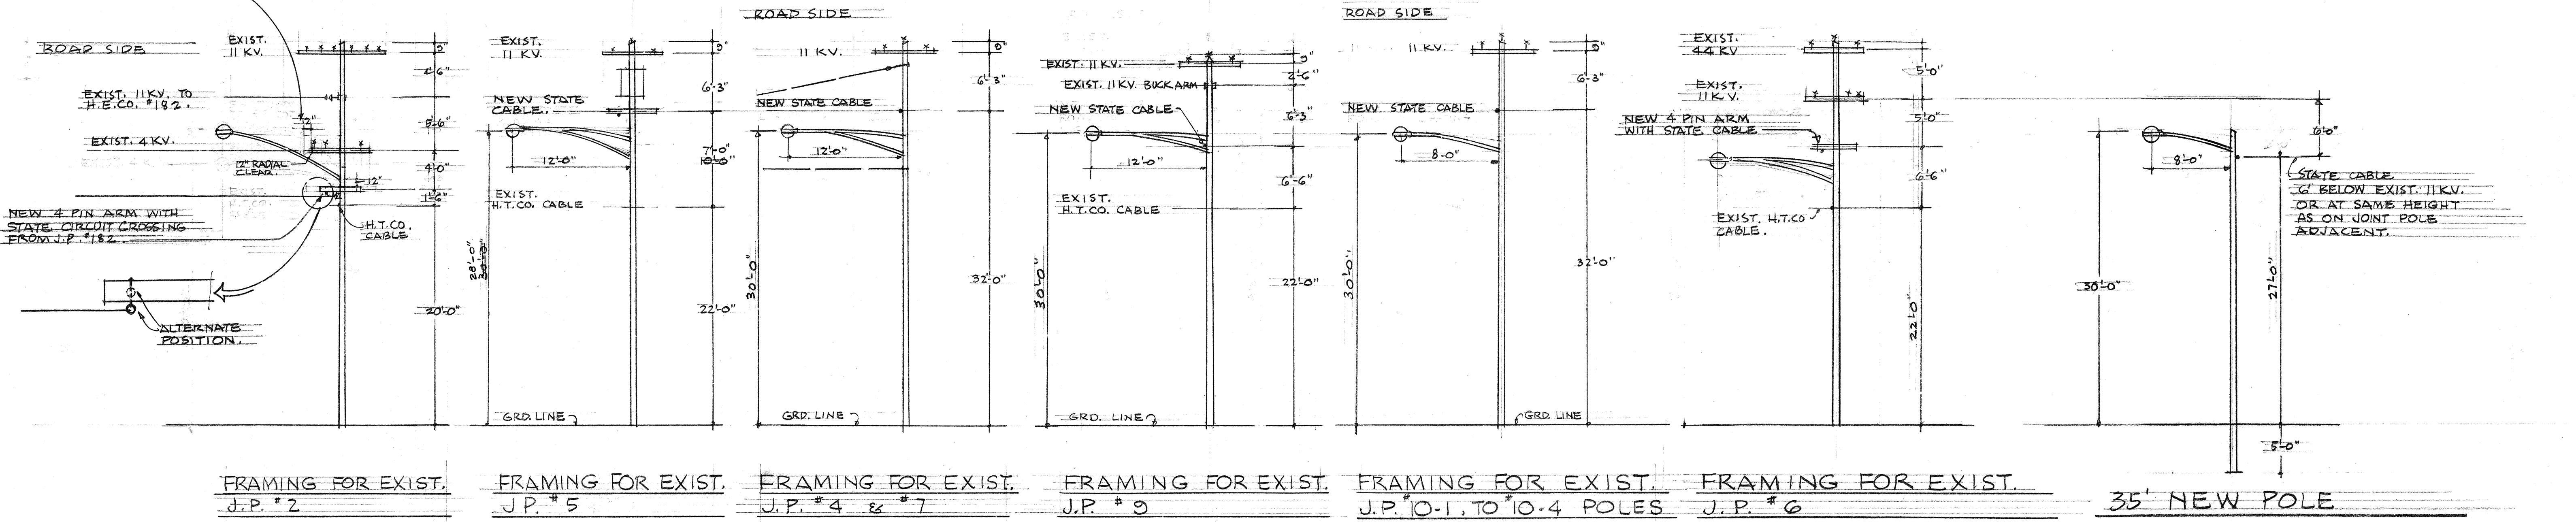

EXIST. POLE 181. PLAN VIEW (A)

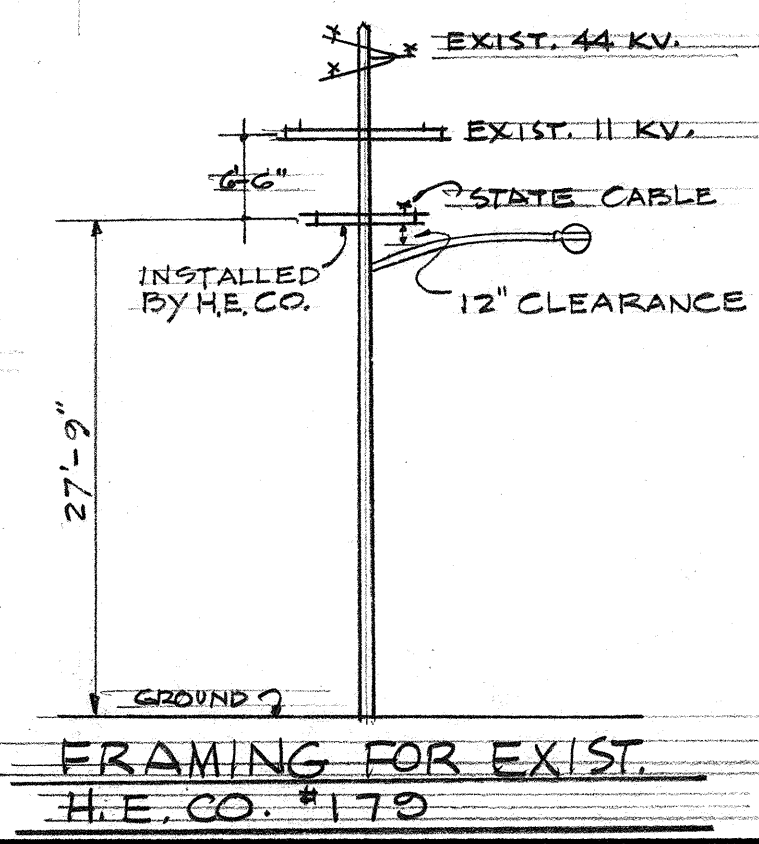

NOTE: ALL STATE CABLE TO BE ON STREET SIDE.

DEPARTMENT OF TRANSPORTATION
DIVISION OF HIGHWAYS
STATE OF HAWAII
HIGHWAY LIGHTING SYSTEM
POLE FRAMING DETAILS
KAMEHAMEHA HIGHWAY AT AIEA
PROJECT NO. B-90-03-60
Not to Scale Sept, 1960