


INDEX TO DRAWINGS	
SHEET NO.	DESCRIPTION
1	TITLE SHEET
2 - 3	HIGHWAY LIGHTING
	SYSTEM PLAN & DETAILS

STATE OF HAWAII
DEPARTMENT OF TRANSPORTATION
DIVISION OF HIGHWAYS
"AS BUILT"
PLANS OF
HIGHWAY LIGHTING SYSTEM
KAMEHAMEHA HIGHWAY AT AIEA
PROJECT NO. B-90-03-60

DISTRICT OF EWA
ISLAND OF OAHU

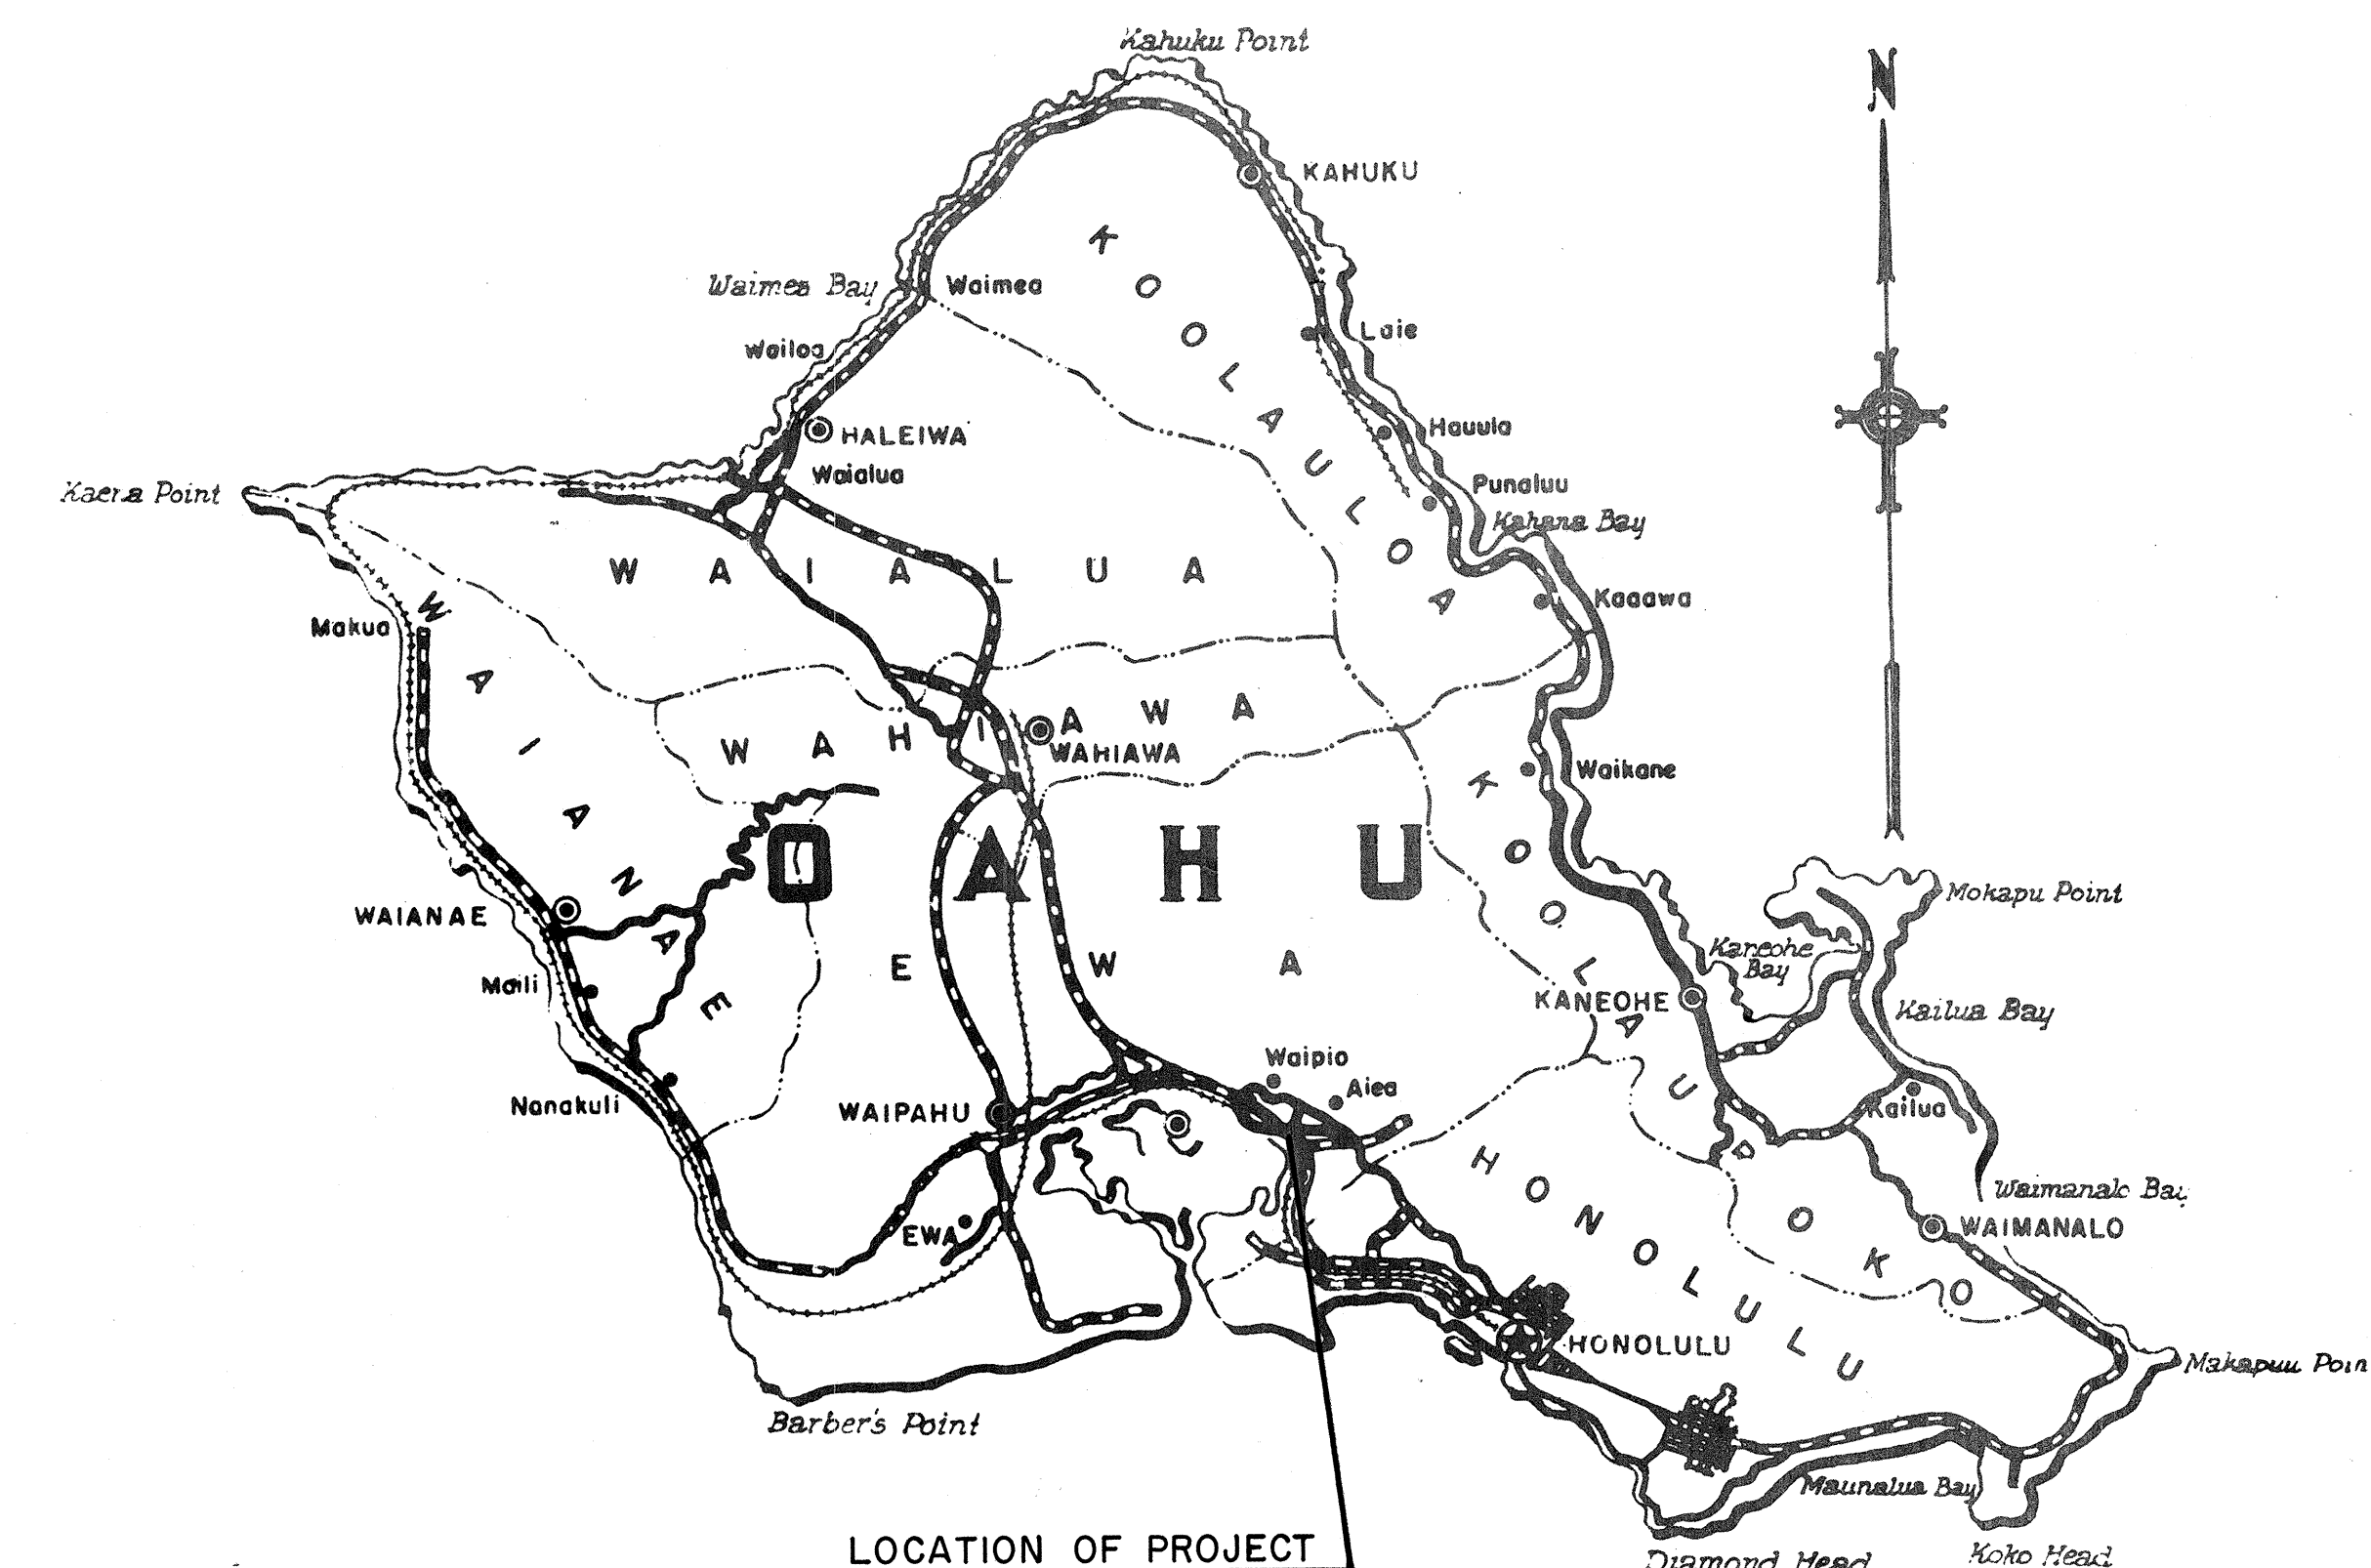

Federal Aid Projects Previously Constructed Or Under Construction



NOTE:
ALL CHANGES MADE DURING CONSTRUCTION
HAVE BEEN NOTED IN RED ON THESE TRACINGS
AND CHECKED BY :

T. Harano


CONSTRUCTION ENGINEER, OAHU

1/23/62

DATE

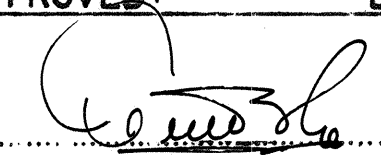APPROVED:  DATE 2/26/60
DIRECTOR OF TRANSPORTATION

LAYOUT PLAN

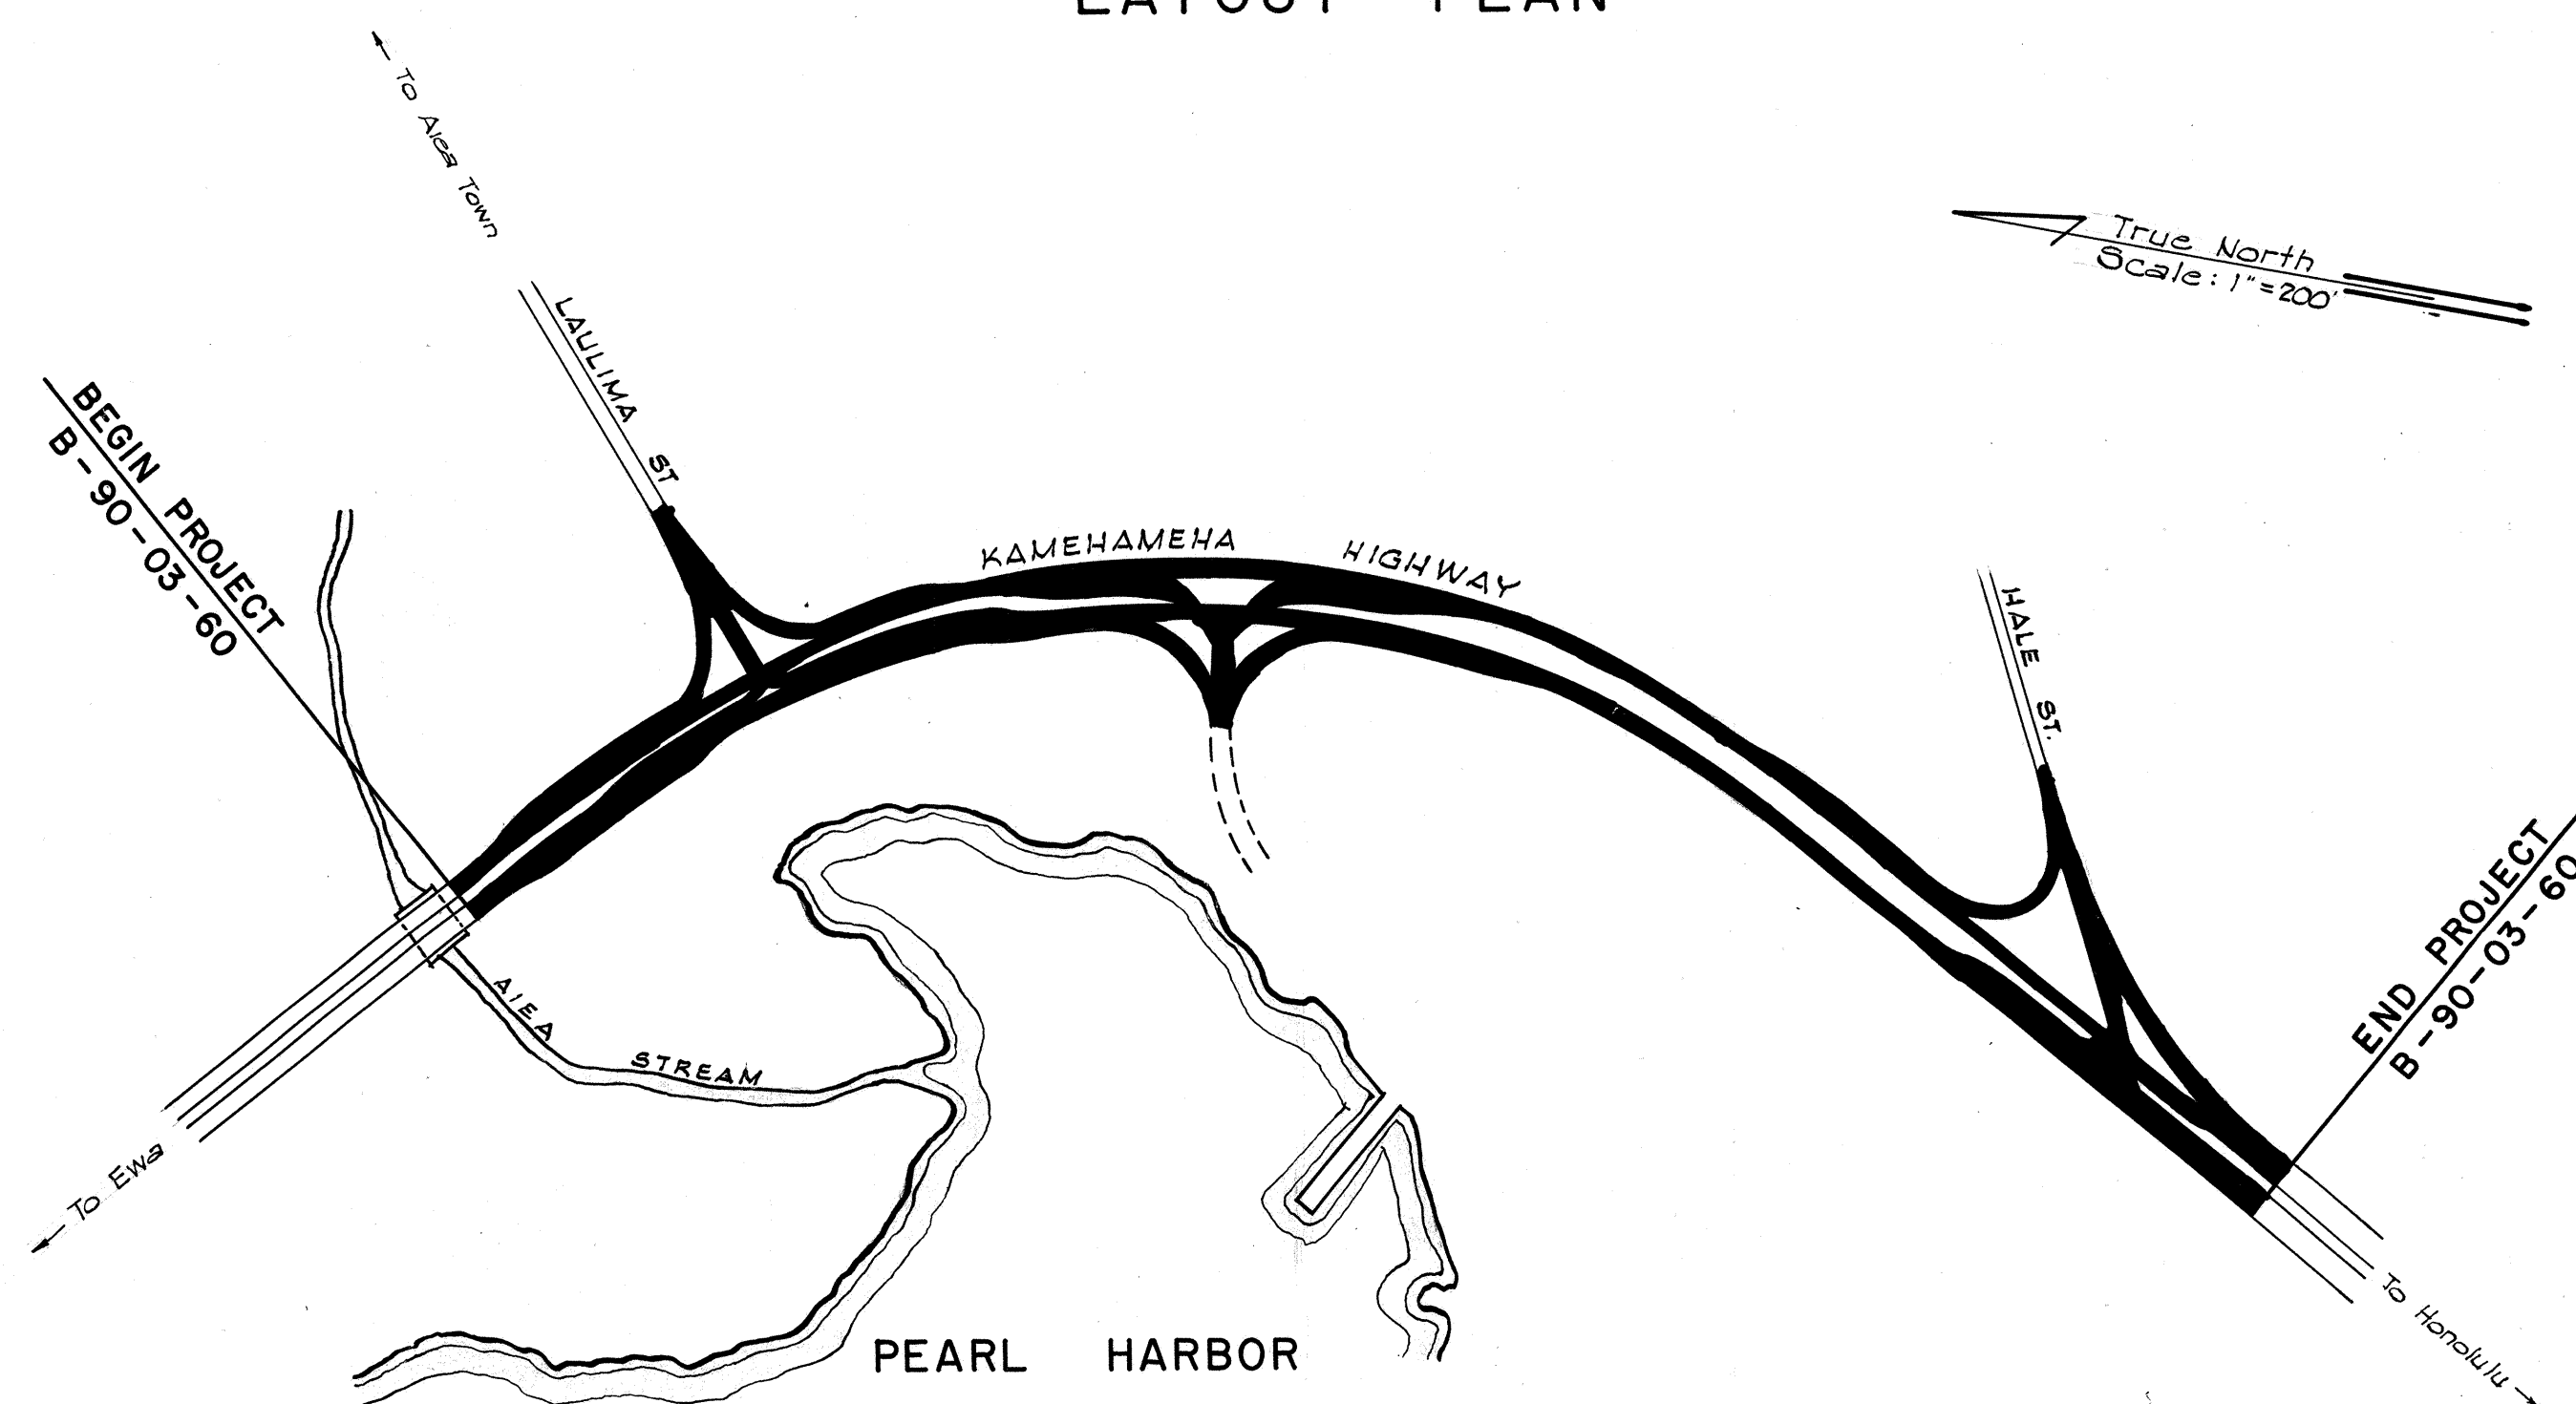

SURVEY PLOTTED BY	DATE
DESIGNED BY	
DRAWN BY	
CHECKED BY	
NOTED BY	
QUANTITIES CHECKED BY	
CHECKED BY	