

INDEX TO DRAWINGS	
SHEET NO.	DESCRIPTION
1	TITLE SHEET
2	TYPICAL SECTION
3-7	PLAN & PROFILE
8	ALTERATION TO TRAFFIC SIGNAL SYSTEM
9-10	STORM DRAINAGE DETAILS
11	MISCELLANEOUS DETAILS
12, 35	UTILITY ADJUSTMENT AT BRIDGE
13-15	WATER DETAILS
16-17	SEWER DETAILS
18-20, 36	ELECTRIC & TELEPHONE DETAILS
21-23	TRAFFIC SIGNS
24-25	DELETED
26-27, 34	RETAINING WALLS
28-36	BRIDGE WIDENING
37-39	BRIDGE & RETAINING WALL DETAILS
40-46	STANDARD DETAILS
47-73	CROSS SECTIONS

STATE OF HAWAII
DEPARTMENT OF TRANSPORTATION
DIVISION OF HIGHWAYS
HONOLULU, HAWAII
"AS BUILT"
PLANS OF



WIDENING OF KAMEHAMEHA HIGHWAY

MOANALUA ROAD TO WAIAWA OVERPASS


FEDERAL AID PROJECT NO F-090-1(6)

DISTRICT OF EWA
ISLAND OF OAHU

FED. ROAD DIST. NO.	STATE	FED. AID PROJ. NO.	FISCAL YEAR	SHEET NO.	TOTAL SHEETS
HAWAII	HAW.	F-090-1(6)	1961	1	77

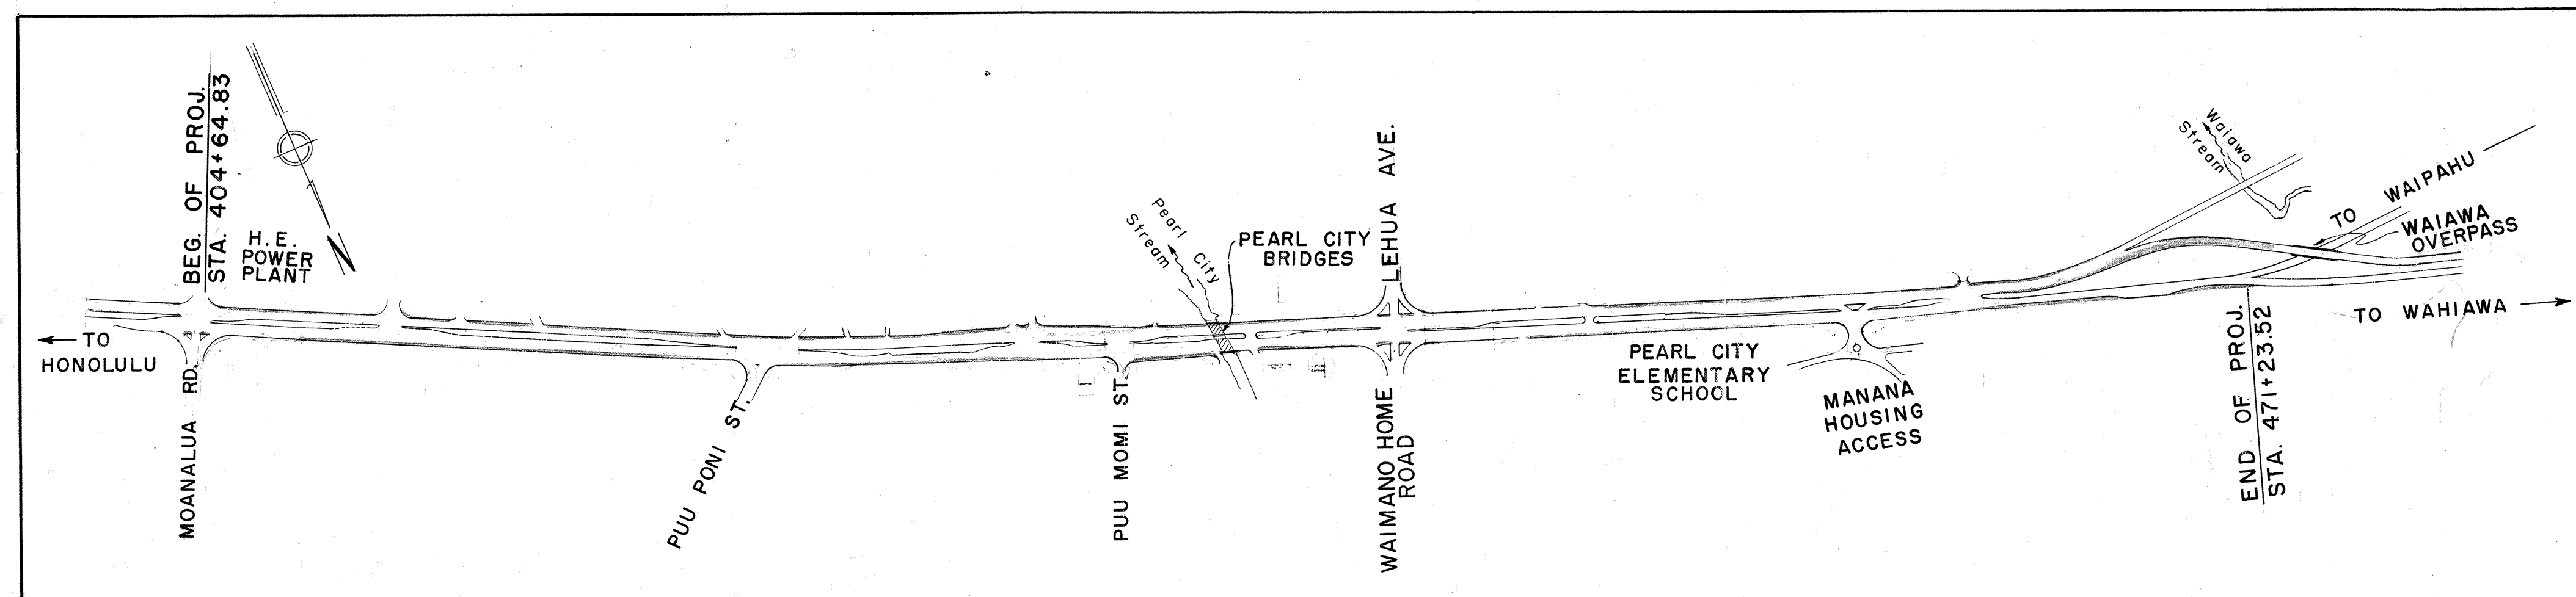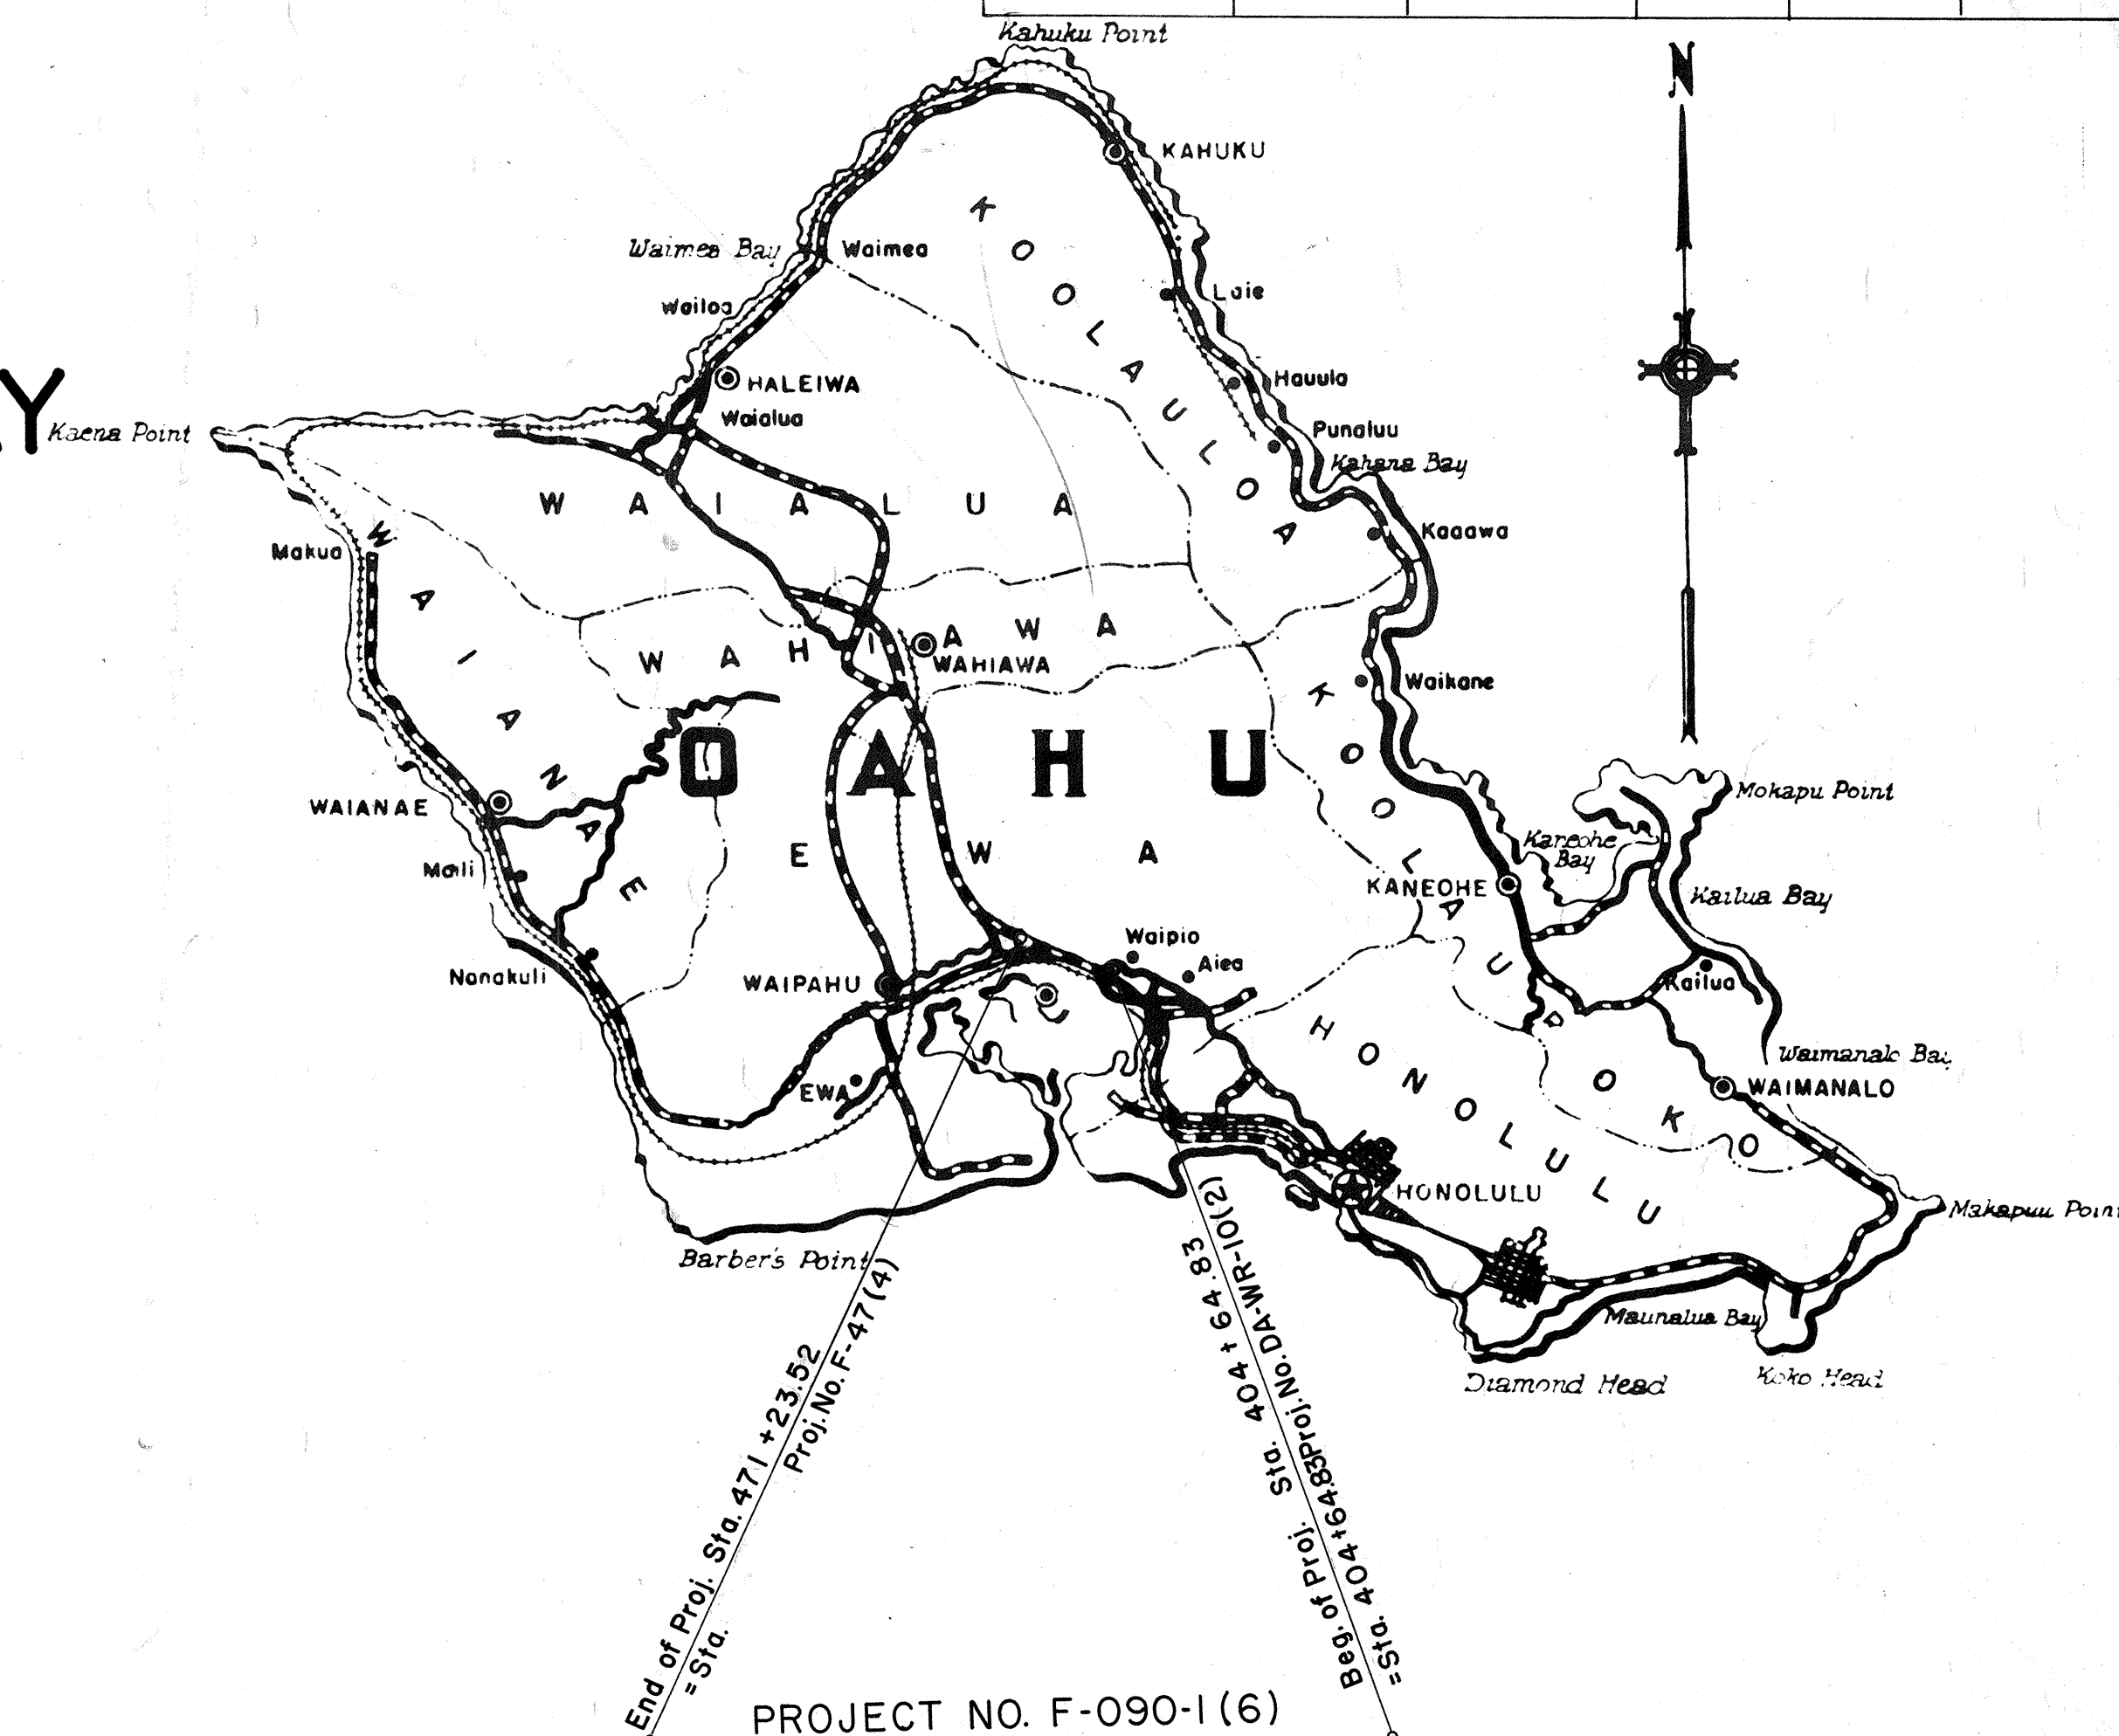


LAYOUT PLAN

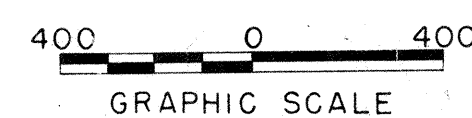

GROSS LENGTH = 1.261 mi.
BRIDGES = 0.007 mi.
NET LENGTH = 1.254 mi.

Federal Aid Projects Previously Constructed Or Under Construction

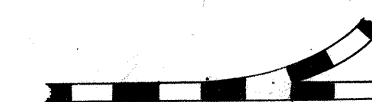

NOTE:
ALL CHANGES MADE DURING CONSTRUCTION
HAVE BEEN NOTED ON THESE TRACINGS IN
RED AND CHECKED BY:

Thomas D. Meijard
PROJECT ENGINEER
6/25/63
DATE

APPROVED: *Sam O. Hirota*
DATE 5/31/61
STATE HIGHWAY ENGINEER

DEPARTMENT OF COMMERCE
BUREAU OF PUBLIC ROADS
APPROVED:
DIVISION ENGINEER DATE

F090106.1