


FED AID DIST. NO.	STATE	FED AID PROJ. NO.	FISCAL YEAR	SHEET NO.	TOTAL SHEETS
HAWAII	HAW	F-090-1(6)	1961	21A	71

For Detail of Delineators
See Sheet No. 11

For Detail of Flashing Beacon
Installation See Sheet No. 23B

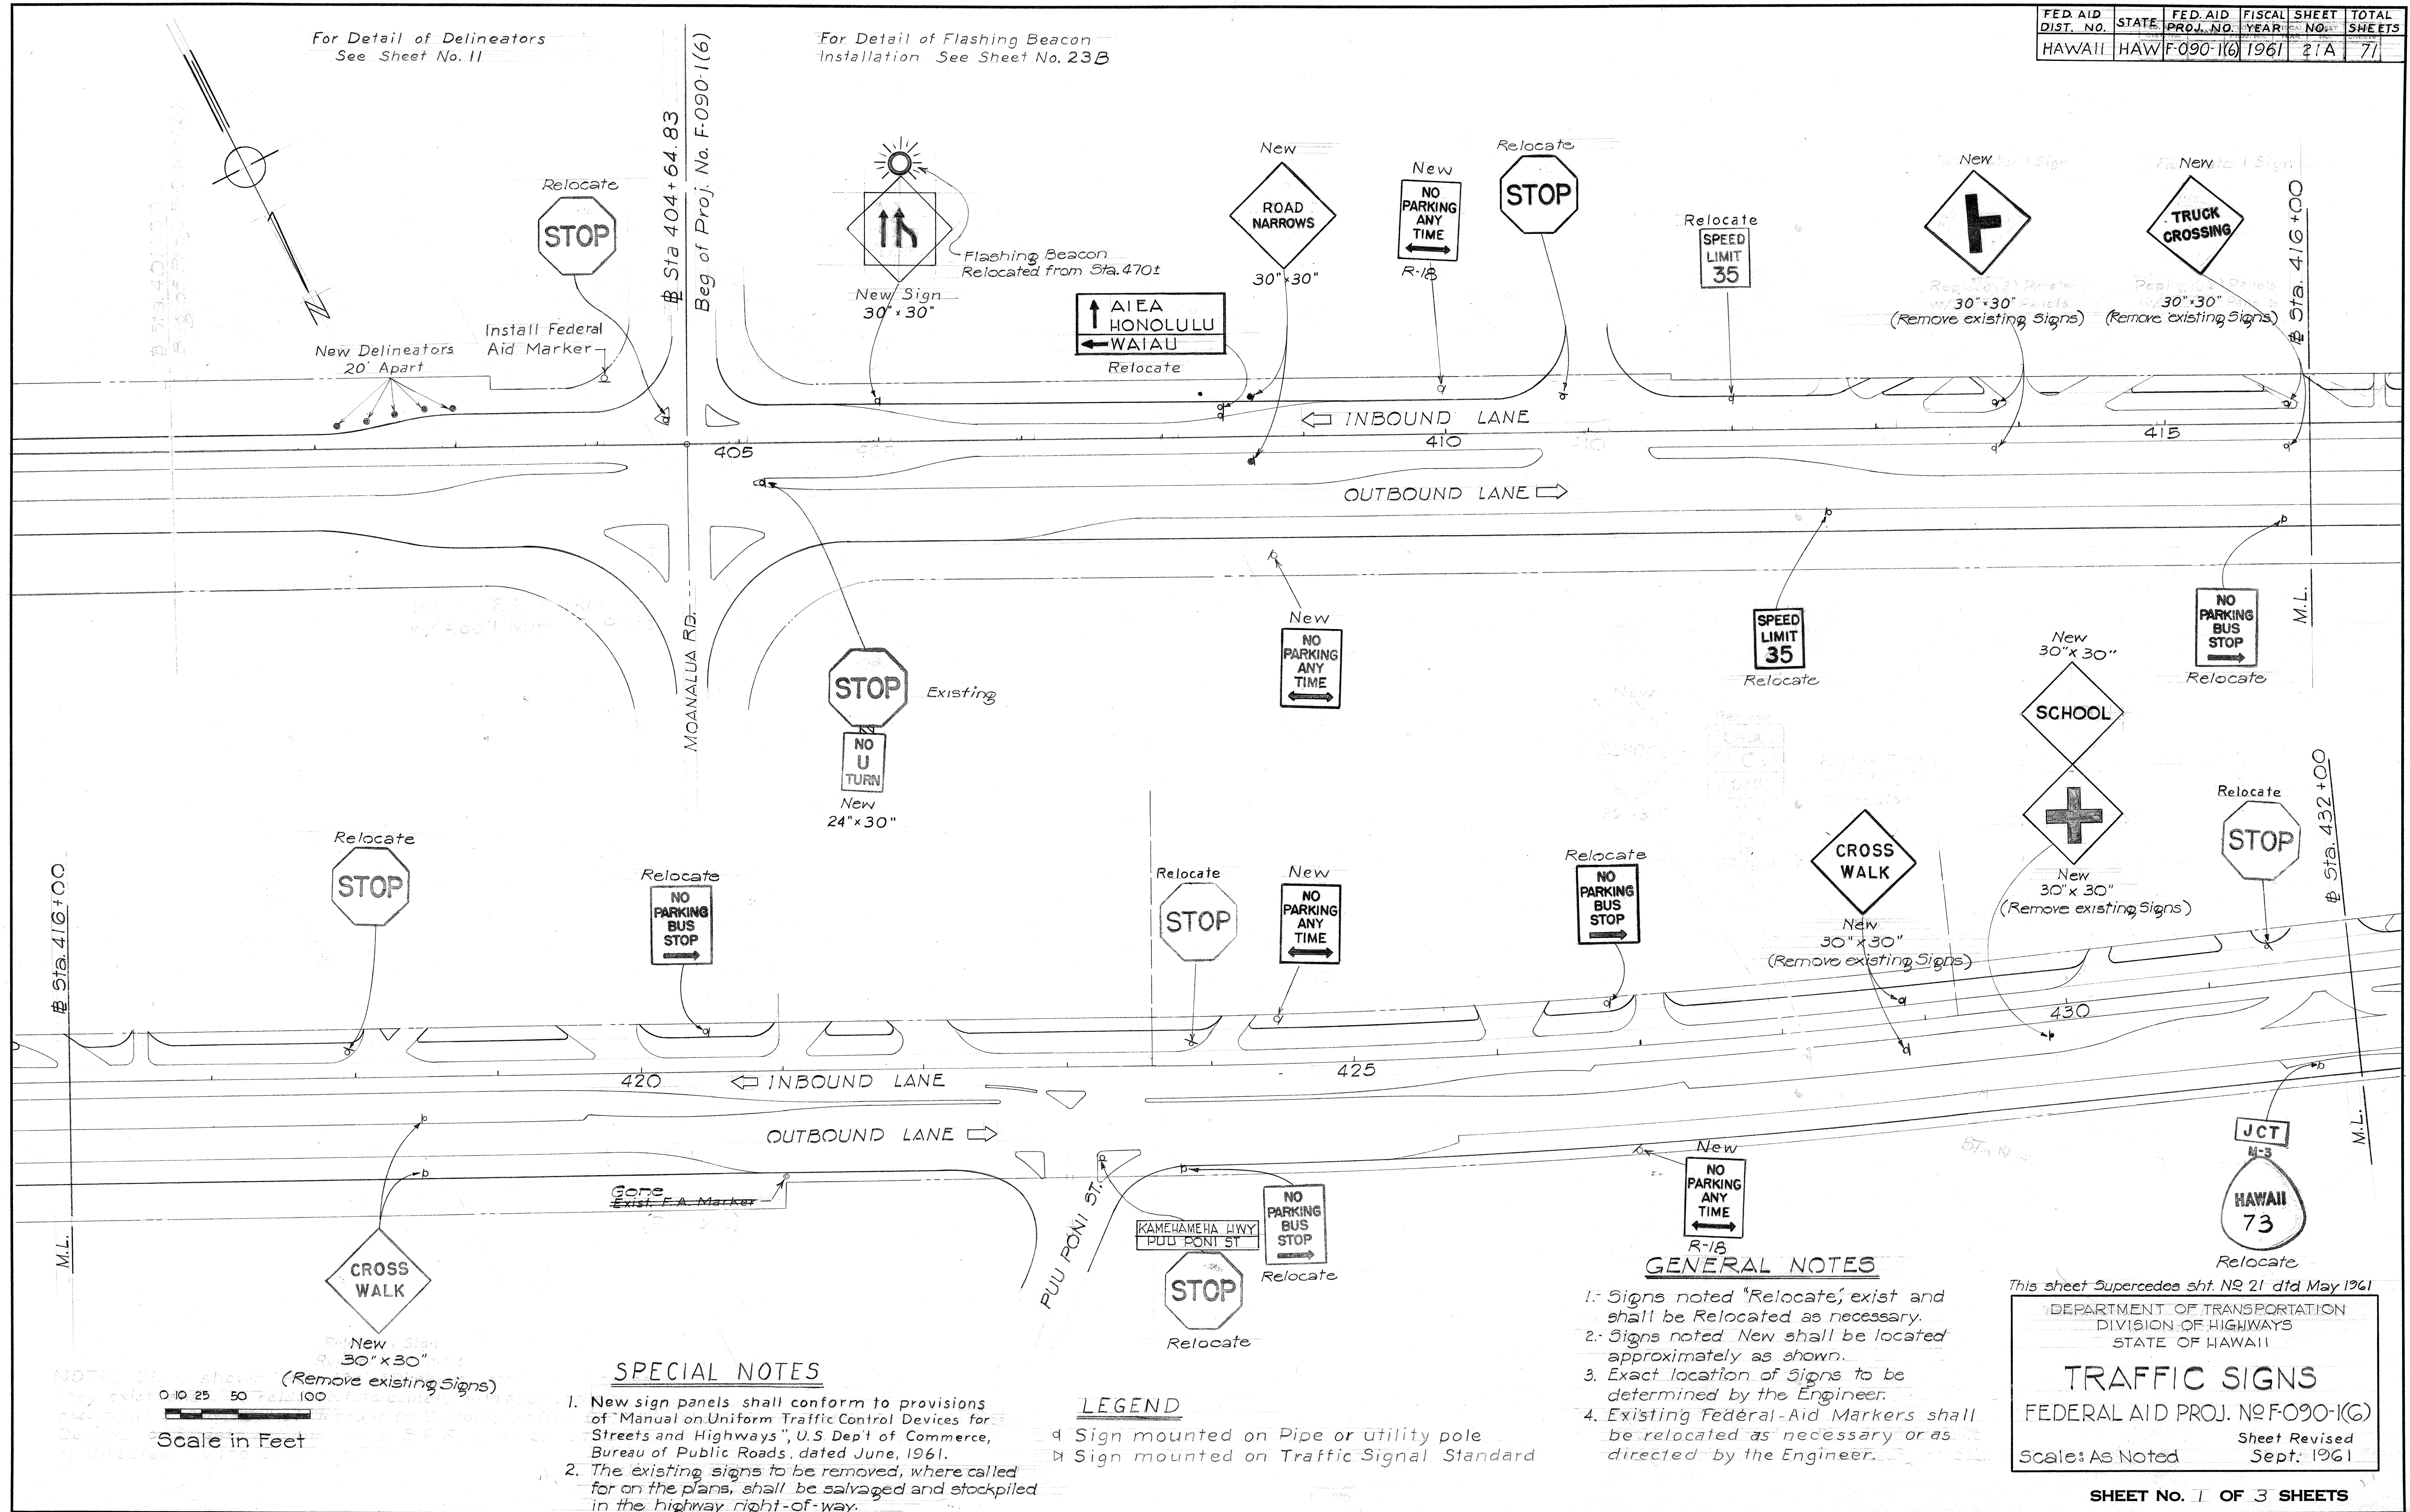

SPECIAL NOTES

1. New sign panels shall conform to provisions of "Manual on Uniform Traffic Control Devices for Streets and Highways", U.S. Dept of Commerce, Bureau of Public Roads, dated June, 1961.
2. The existing signs to be removed, where called for on the plans, shall be salvaged and stockpiled in the highway right-of-way.

LEGEND

- ▷ Sign mounted on Pipe or utility pole.
- ▷ Sign mounted on Traffic Signal Standard

GENERAL NOTES

- 1- Signs noted "Relocate," exist and shall be Relocated as necessary.
- 2- Signs noted New shall be located approximately as shown.
3. Exact location of Signs to be determined by the Engineer.
4. Existing Federal-Aid Markers shall be relocated as necessary or as directed by the Engineer.

This sheet Supercedes sht. NQ 21 dtd May 1961

DEPARTMENT OF TRANSPORTATION
DIVISION OF HIGHWAYS
STATE OF HAWAII


TRAFFIC SIGNS

FEDERAL AID PROJ. NO F-090-1(6)

Scale: As Noted

SHEET No. 1 OF 3 SHEETS

FED. ROAD DIST. NO.	STATE	FED. AID PROJ. NO.	FISCAL YEAR	SHEET NO.	TOTAL SHEETS
HAWAII	HAW.	F090-1(6)	1961	22A	71

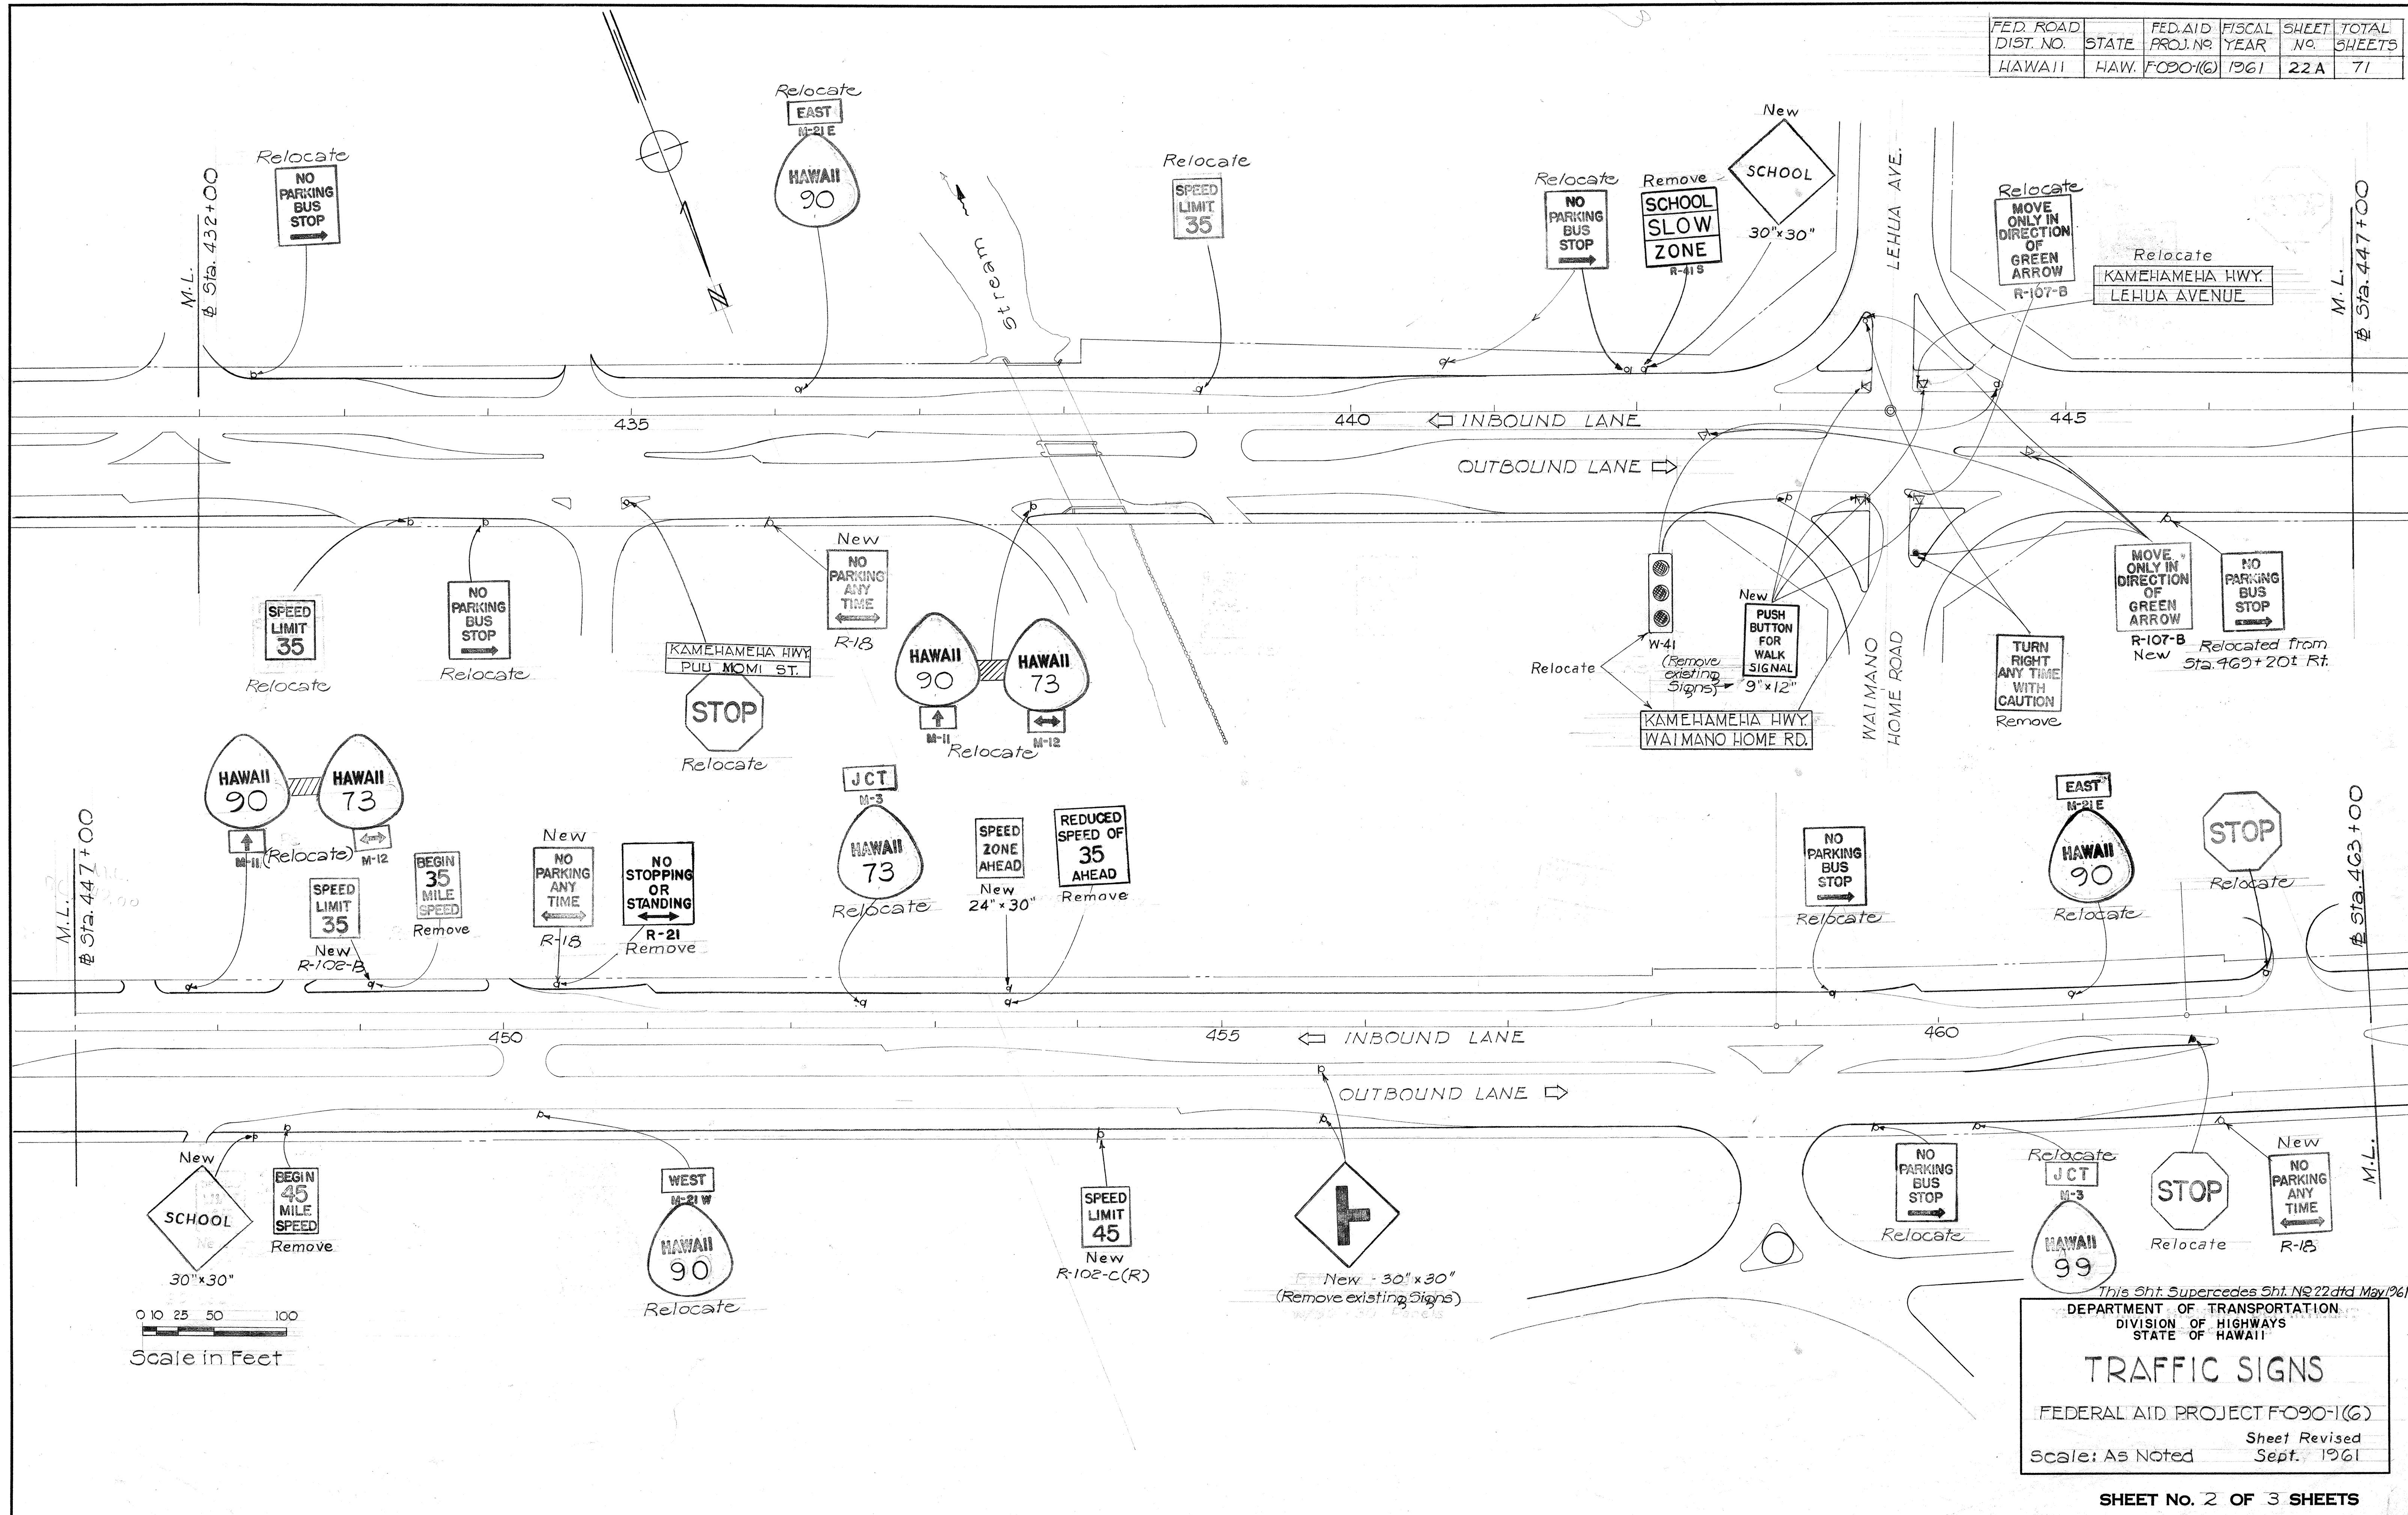


SURVEY PLOTTED BY	DATE
DESIGNED BY	
TRACED BY	
QUANTITIES BY	
CHECKED BY	
NOTE BOOK	
No.	


This Sht. Supercedes Sht. No. 22 dtd May 1961
 DEPARTMENT OF TRANSPORTATION
 DIVISION OF HIGHWAYS
 STATE OF HAWAII
TRAFFIC SIGNS
 FEDERAL AID PROJECT F-090-1(6)
 Sheet Revised Sept. 1961
 Scale: As Noted

PRIMARY SYSTEM PROJECT SIGN
NO SCALE

PRIMARY SYSTEM PROJECT SIGN
NO SCALE

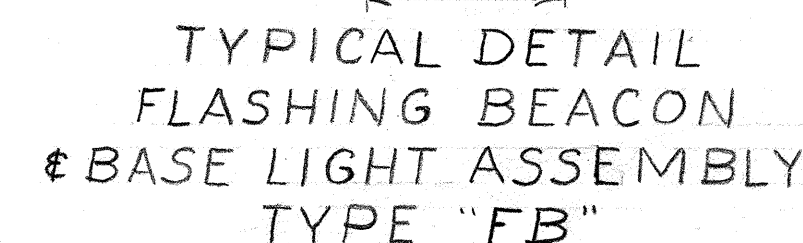


1. The legend shall be black on white background.
2. All letters shall be of size and design shown and shall conform with "Standard Alphabets for Highway Signs" as set forth by the Public Roads Administration, Federal Work Agency.
3. Letters shall be Series "C", sizes as shown, except where noted otherwise on the plan.

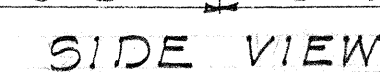

ELEVATION
Not to Scale

FRONT VIEW

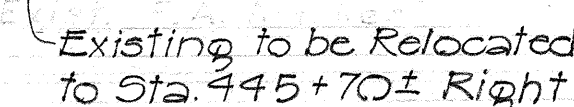

1. Sta. 403+00 ± - Facing Outbound Lanes.
2. Sta. 468+00 ± - Facing Inbound Lanes.

Graphic Scale, Feet

SHEET No. 3 OF 3 SHEETS