
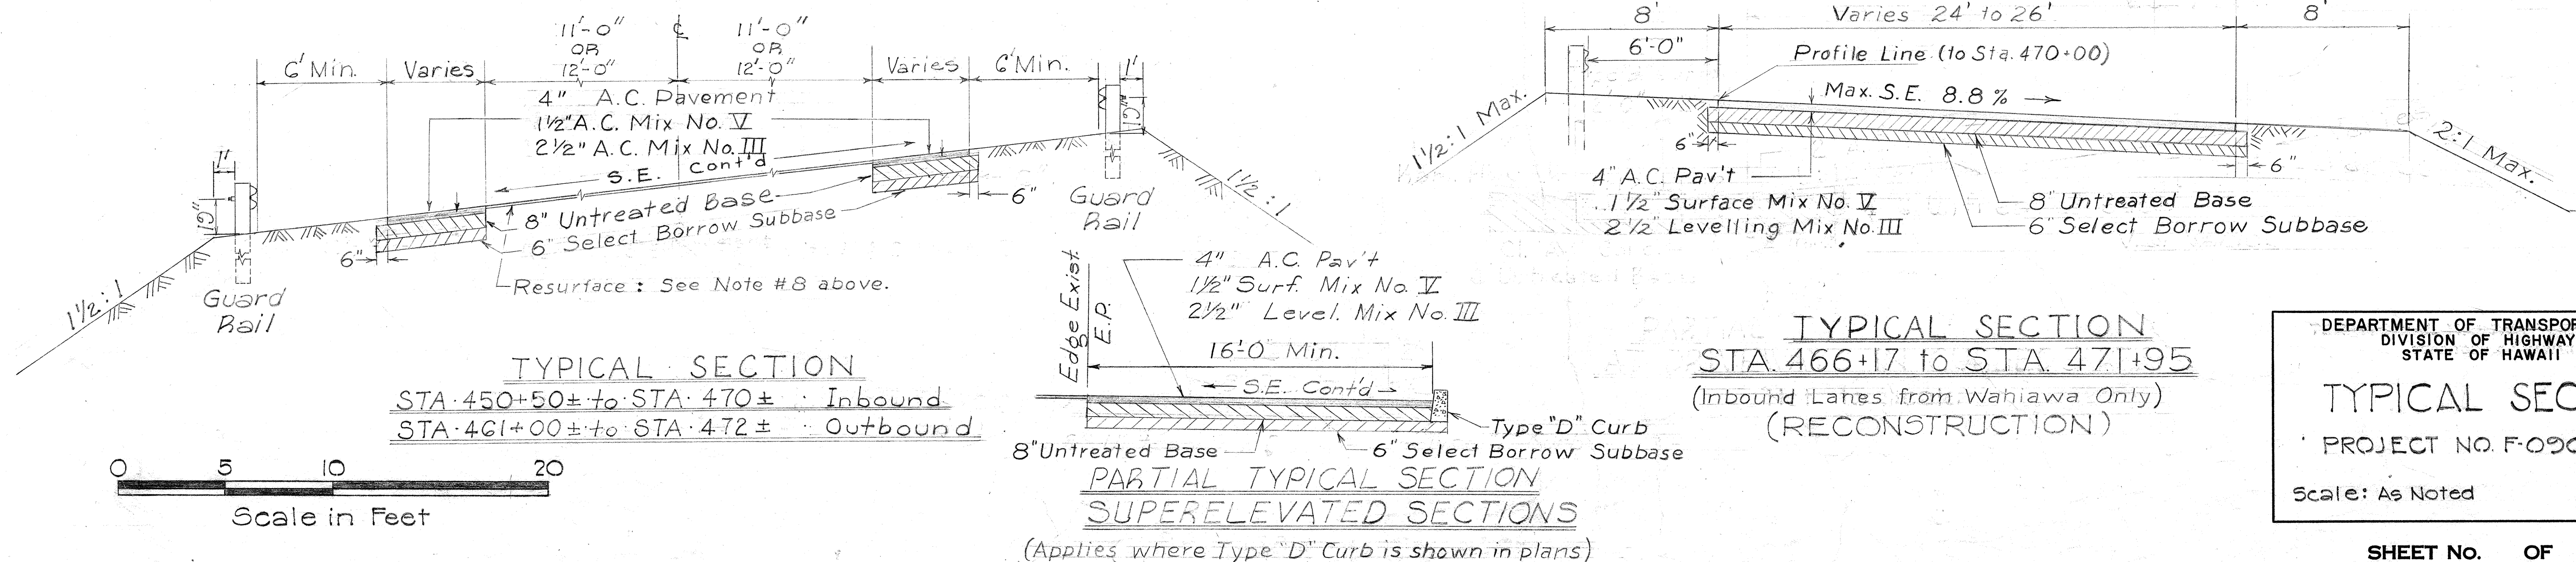
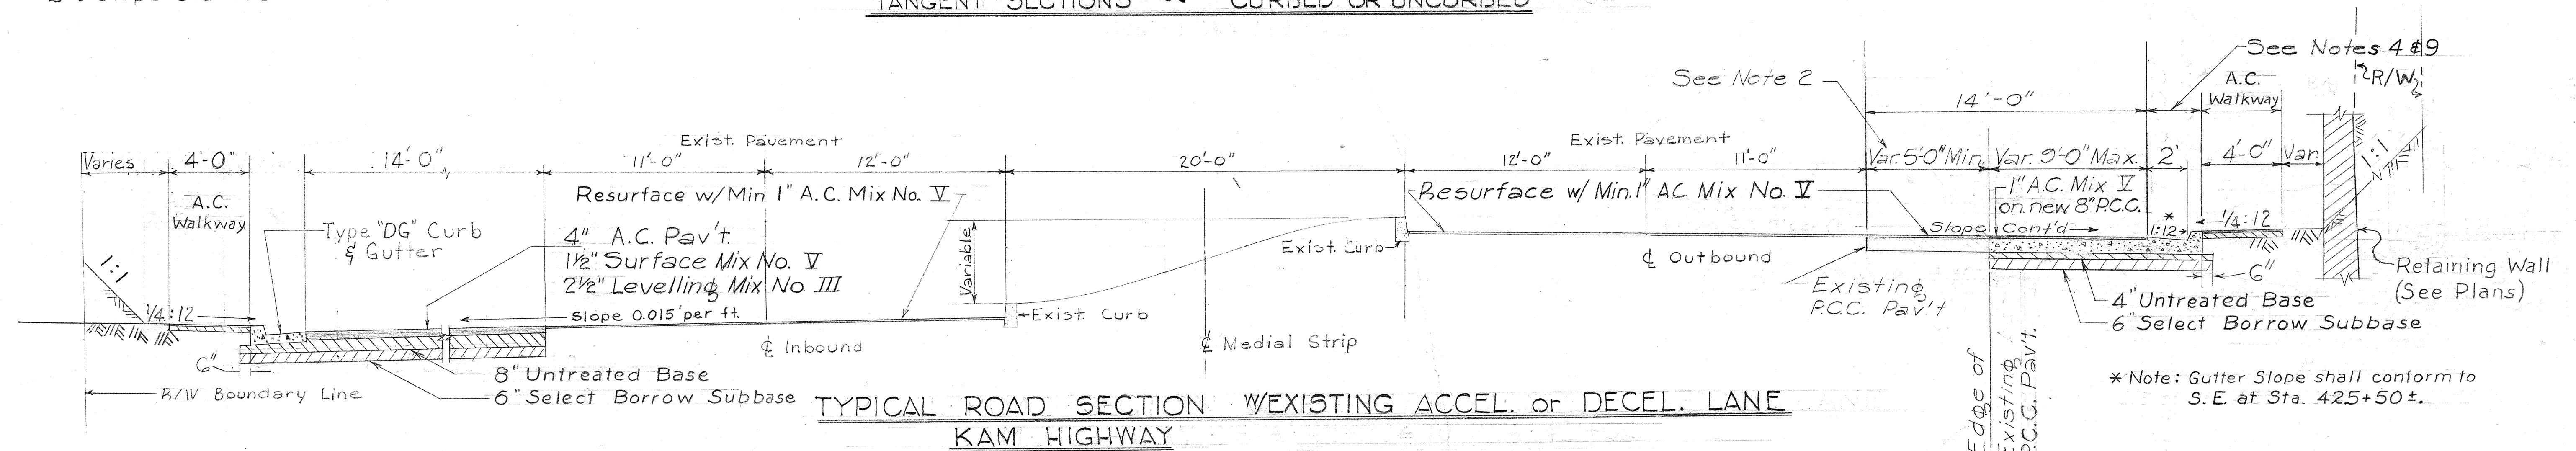


NOTE :

1. All existing pavement shall be resurfaced with 1 inch minimum thickness of A.C. mix no. V except as noted below.
2. The P.C.C. pavement on existing accel. and decel. lanes shall be demolished where the width of Pavement is less than 5'-0".
3. Curb returns on driveways shall have type "D" curb which shall extend to the far edge of the A.C. Footpath.
4. Type "DG" curb-gutter shall be transitioned into existing curb that is to remain. Transitions shall be 5' long.
5. No curb or curb-gutter shall be installed in areas where no footpath or sidewalk exists.
6. Existing curb, including islands, that falls within the limits of new pavement shall be removed and paid for as incidental to "Roadway Excavation".
7. A.C. Walkways shall have 1 inch A.C. Pavement Mix No. V on 3 inches of Untreated Base. (See Special Provisions)
8. Existing pavement Sta. 448+00 to 471+65 Outbound and Sta. 456+00 to 467+40± Inbound shall be resurfaced with 1" A.C. Mix No. V surface and 1 1/2" minimum levelling course of A.C. Mix No. III.
9. Curb and/or Gutter Sections shall be Cast Monolithically with the P.C.C. Slab where shown in the plans, and Paid for under Item 70 (3d).

FED. ROAD DIST. NO.	STATE	FED. AID PROJ. NO.	FISCAL YEAR	SHEET NO.	TOTAL SHEETS
HAWAII	HAW.	F-090-1(6)	1961	2	71

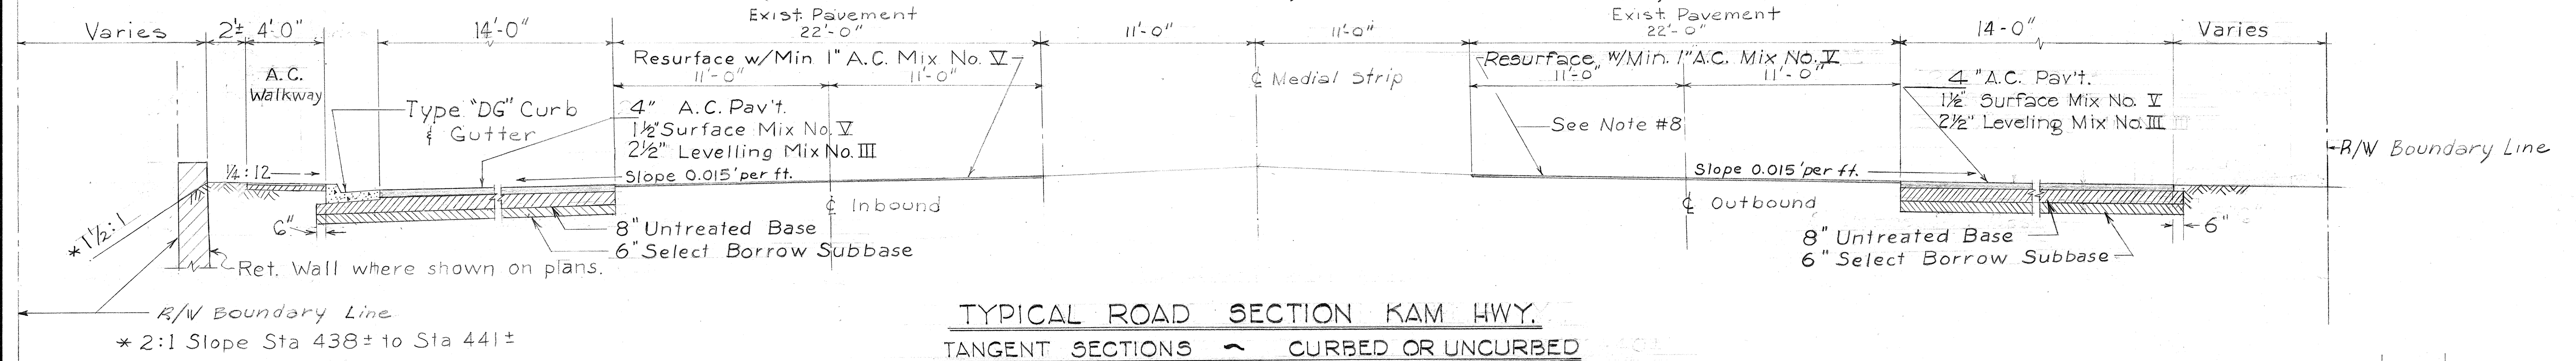

DATE	
DESIGNED BY	
DRAWN BY	
CHECKED BY	
NOTED BY	
QUANTITIES CHECKED BY	
NO.	