

FED. ROAD DIST. NO.	STATE	FED. AID PROJ. NO.	FISCAL YEAR	SHEET NO.	TOTAL SHEETS
HAWAII	HAW.	5U-0720(6)	1964	20	177

CHANGE ORDER NO. 24
C.D.I. AUX. LN. 7+62
INV. = 71.21

Curve Data

Δ	67°43'30"
Δ _h	23°51'45"
R	20.00
T	20.12
C	23.43
Lc	32.42

NAVY LAUNDRY

AREA ELEM. SCHOOL

Curve Data


Δ	112°16'30"
Δ _h	56°08'15"
R	30.00
T	44.71
C	44.82
Lc	58.29

6' Aux. Ln. Sta. 8+10
8' Stub of 24" Cl. III RCCP

6' Aux. Ln. Sta. 4+50
6' Stub of 24" Cl. III RCCP
C.R.M. Wall No. 4
For detail see
Sht. No. 24

6' Aux. Ln. Sta. 3+75
C.I. # 20
Existing Chain Link Fence

6' Aux. Ln. Sta. 3+10
8" DMH "G" type "E"
Inv. = 70.0

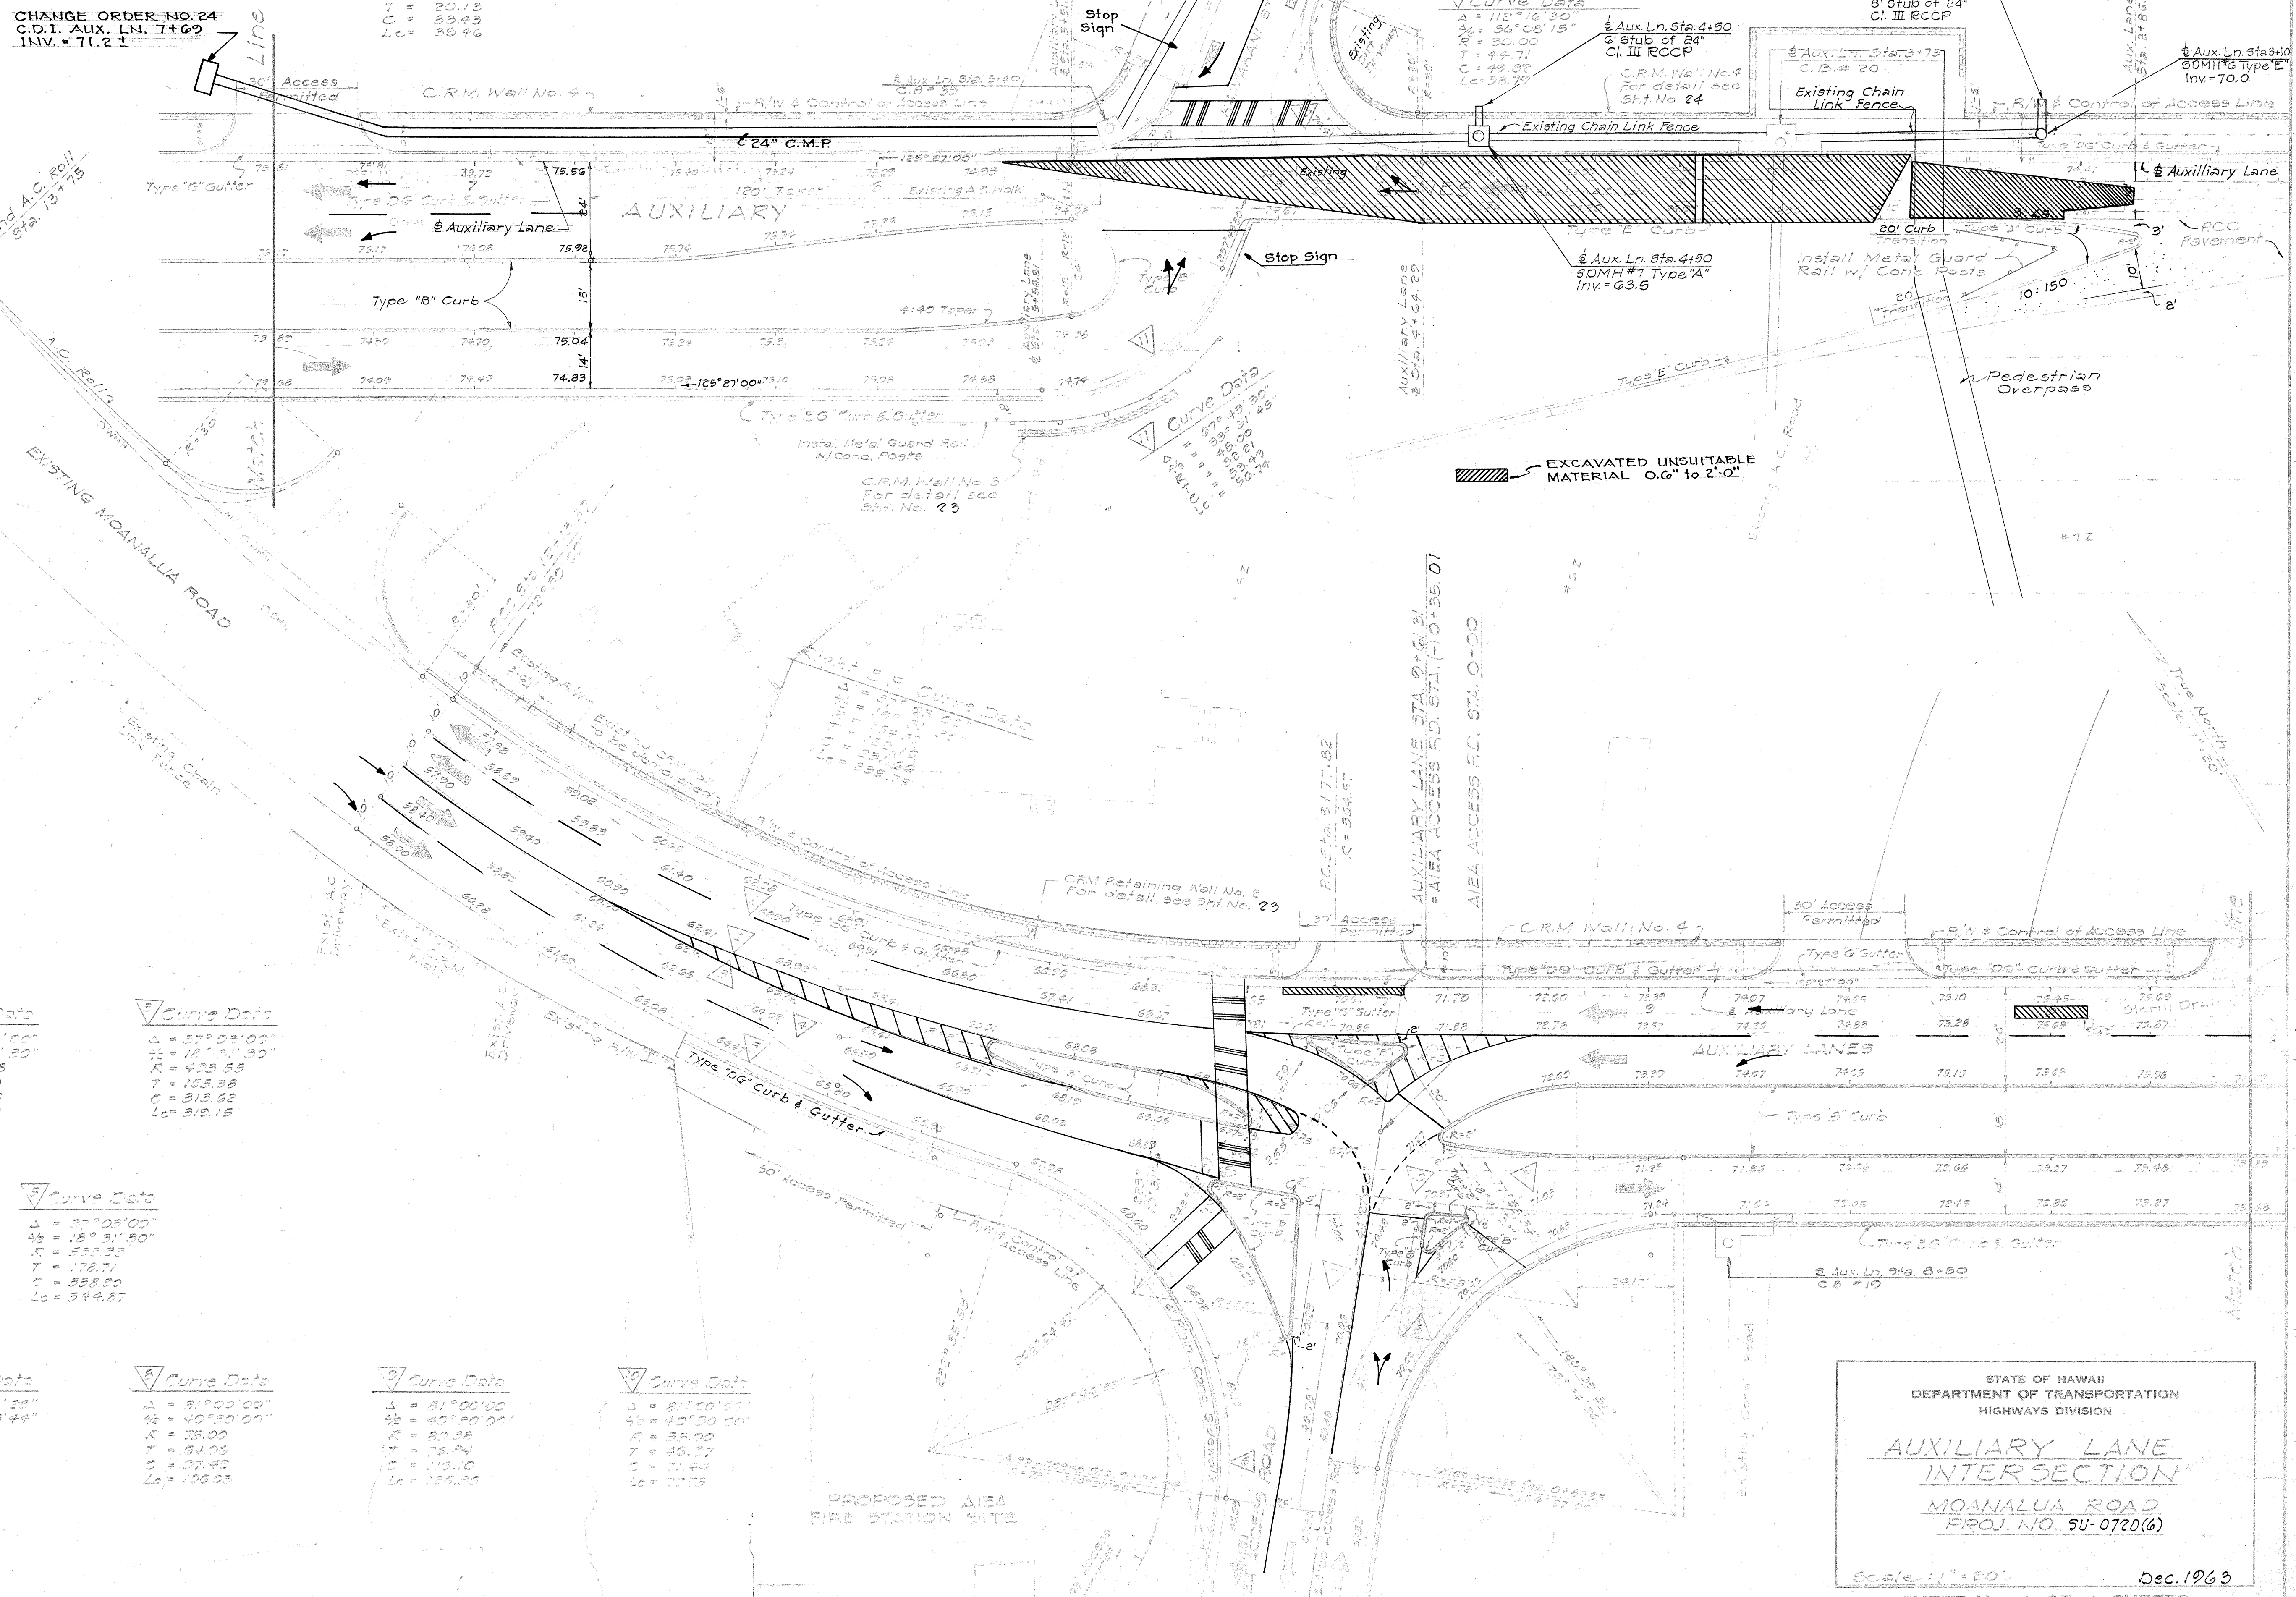

ORIGINAL	DATE
PLAN	
DESIGNED BY	
QUANTITIES BY	
CHECKED BY	
NO.	

STATE OF HAWAII
DEPARTMENT OF TRANSPORTATION
HIGHWAYS DIVISION

**AUXILIARY LANE
INTERSECTION**

MOANALUA ROAD
PROJ. NO. 5U-0720(6)

Scale: 1" = 40'

Dec. 1963

SHEET No. 20 OF 177 SHEETS