

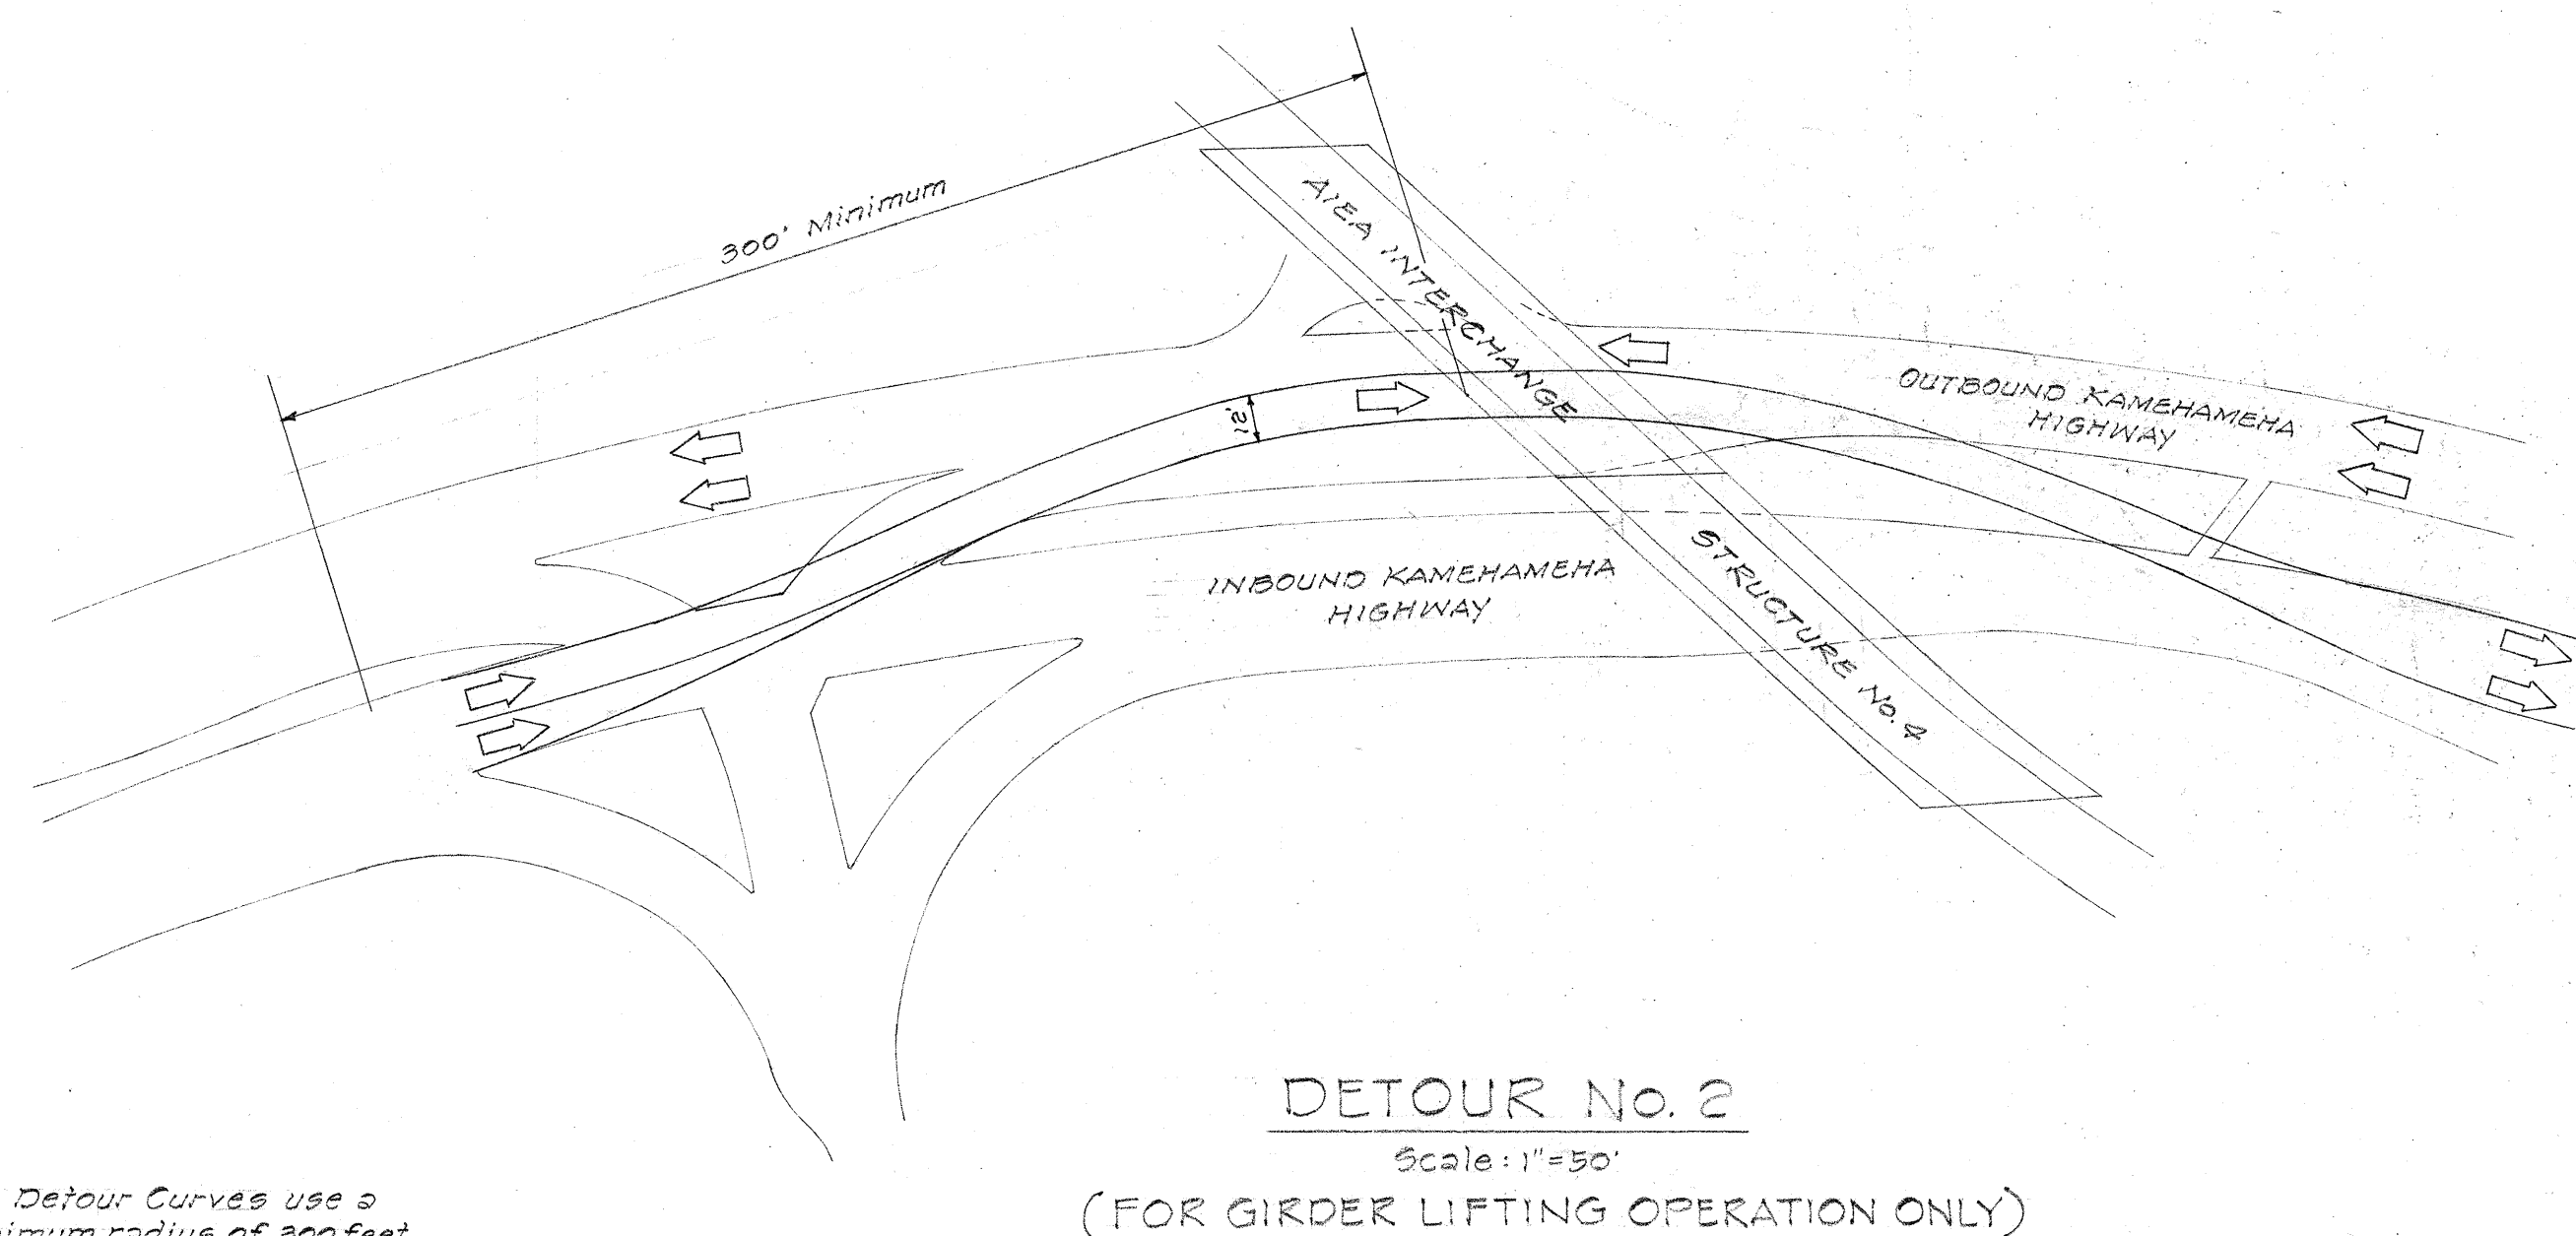
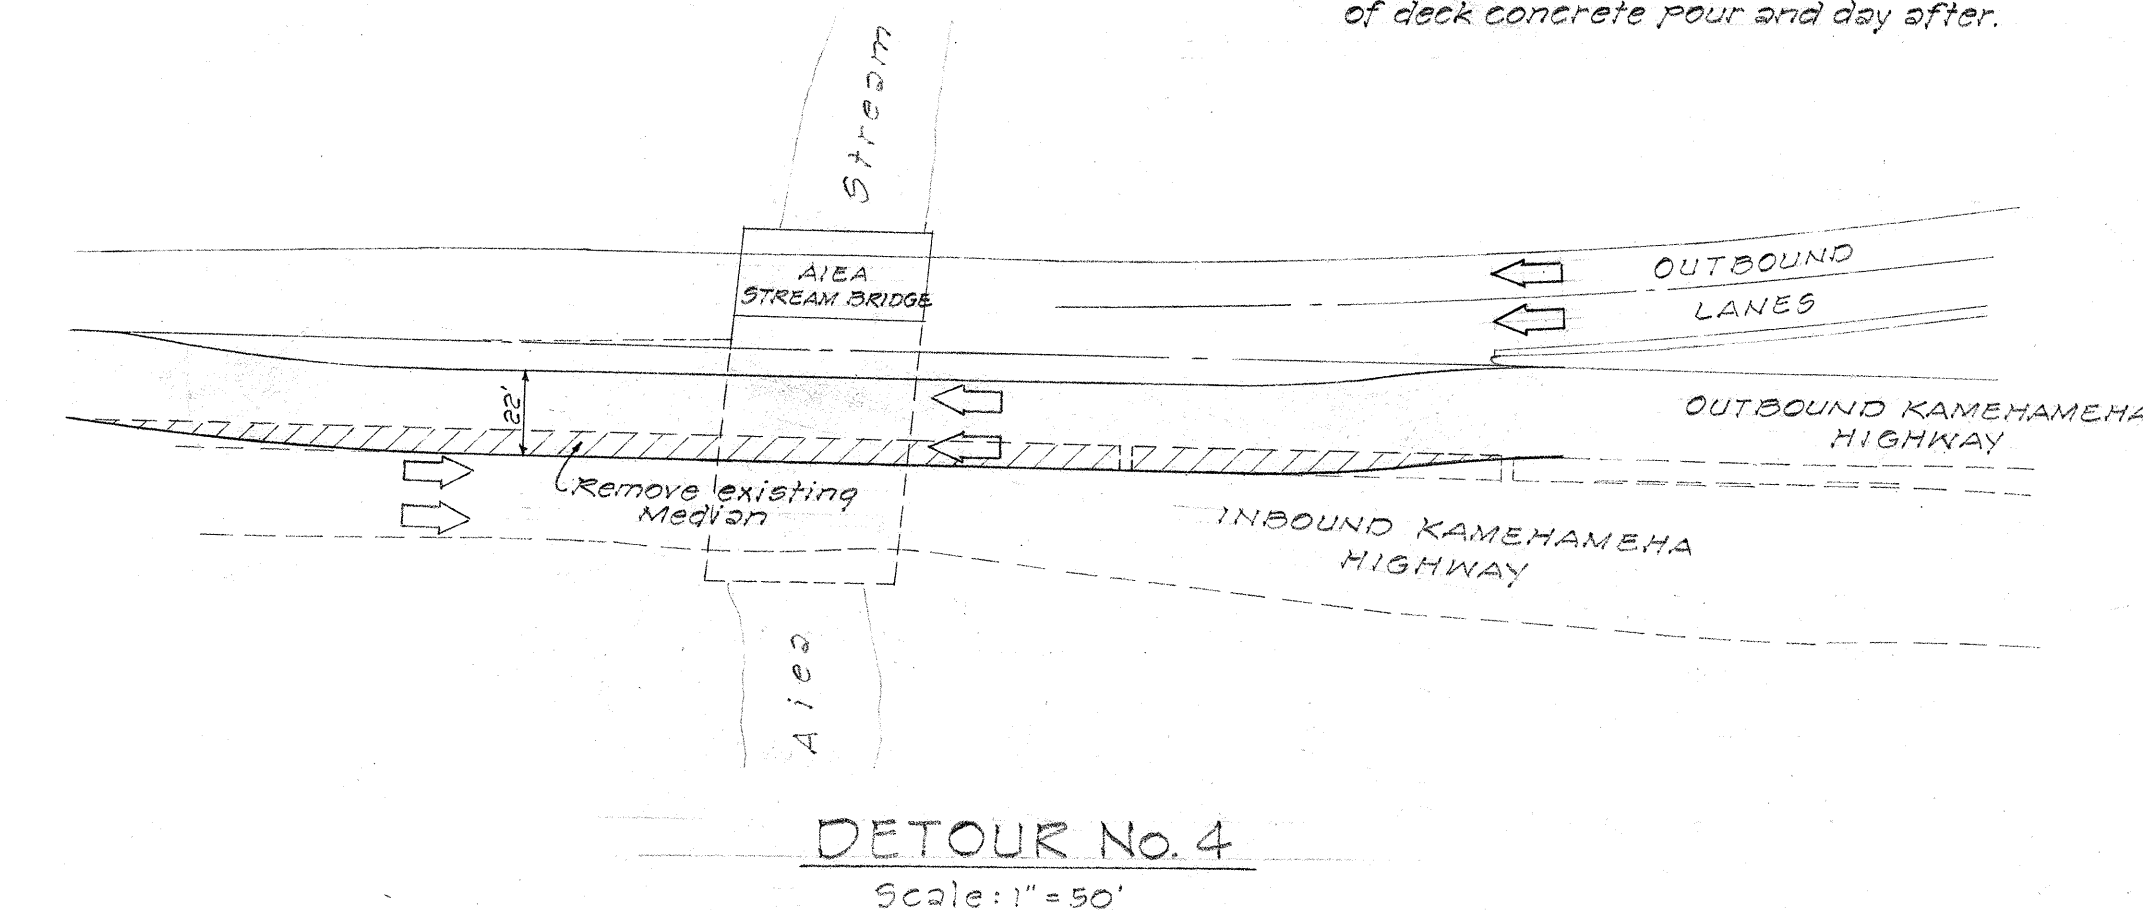
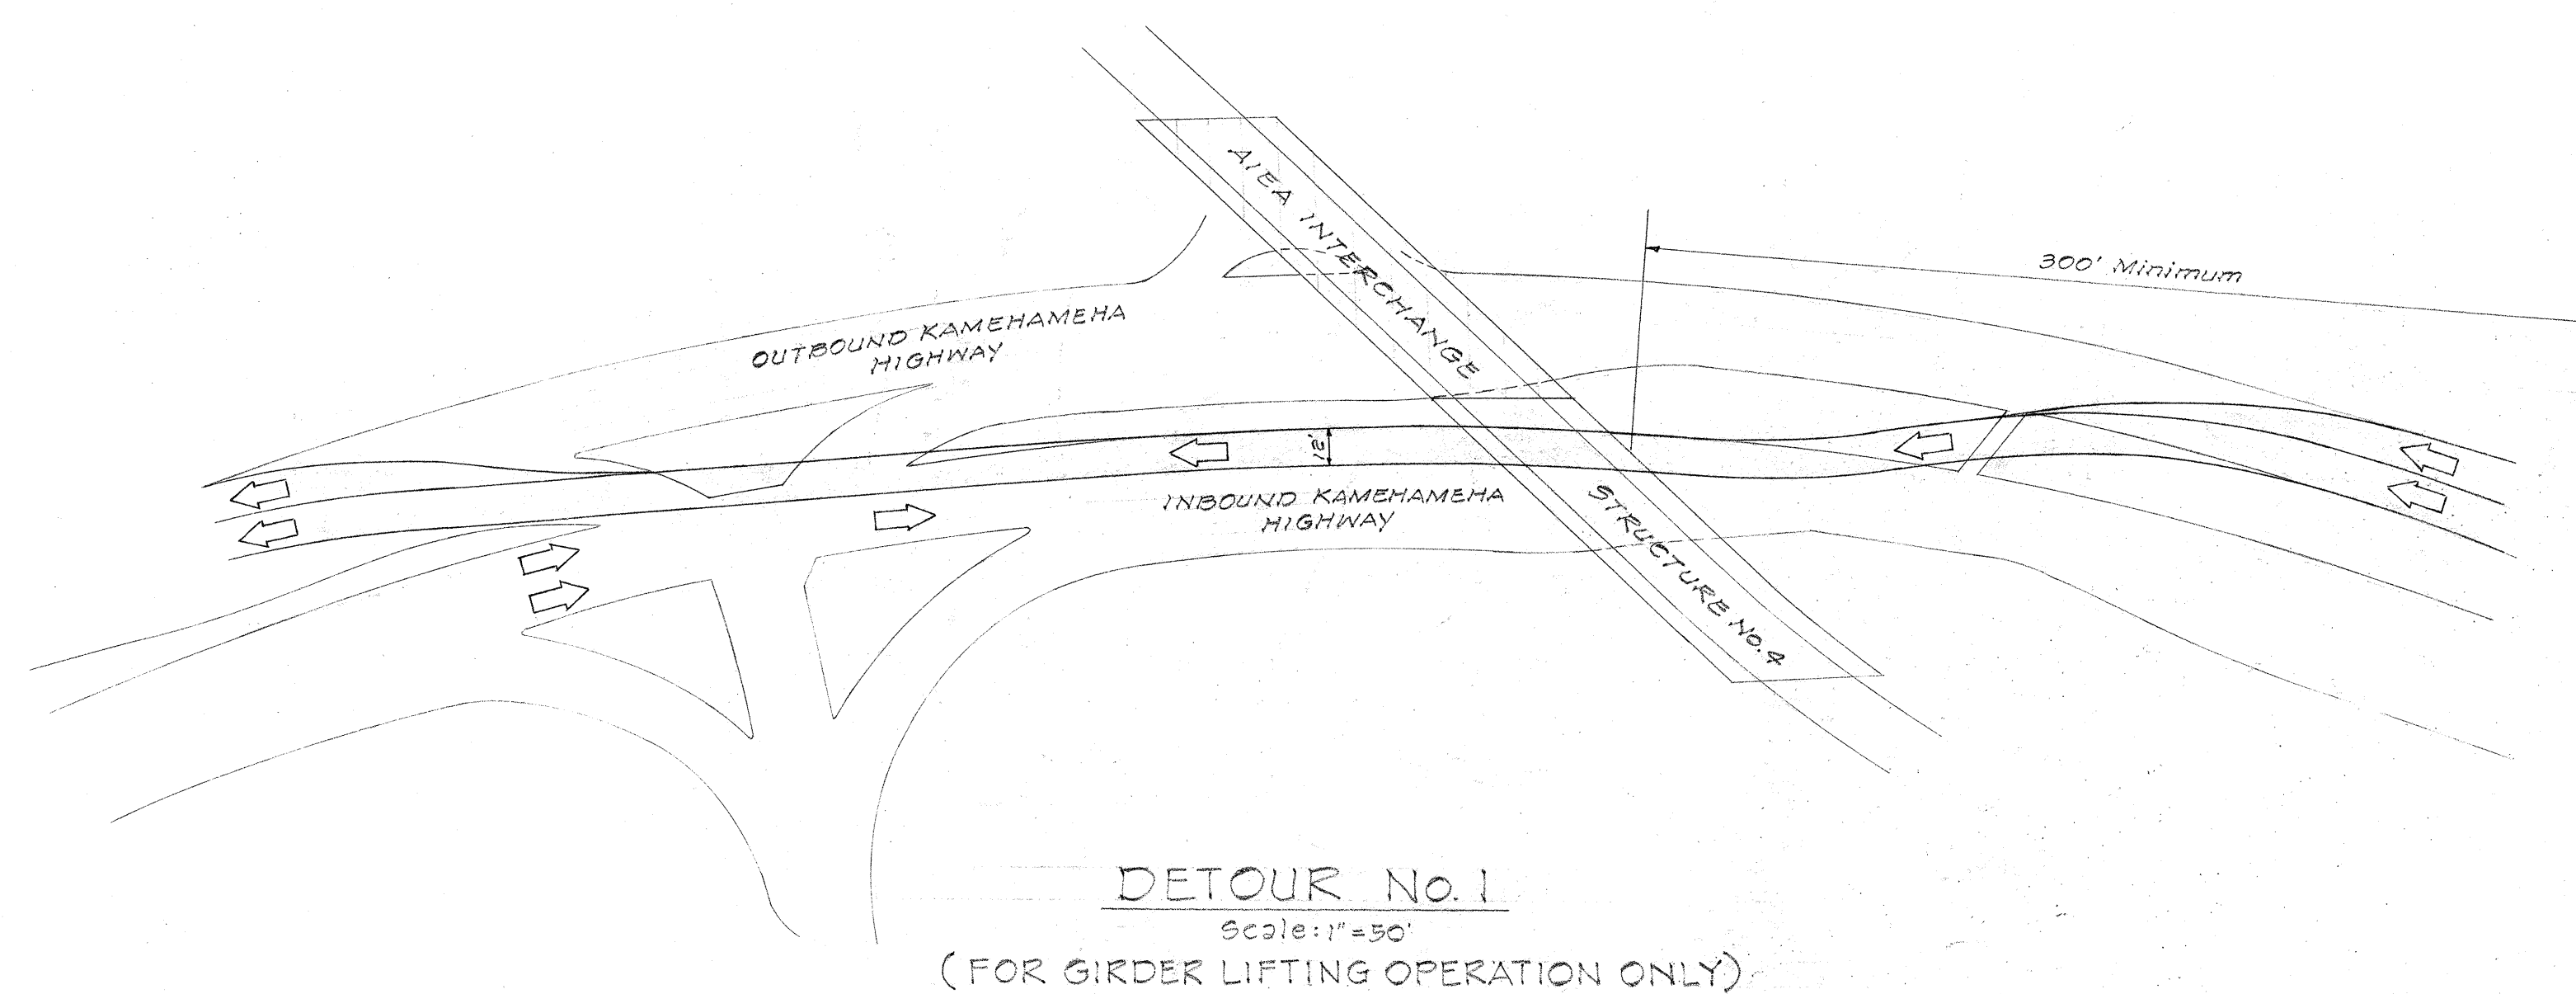
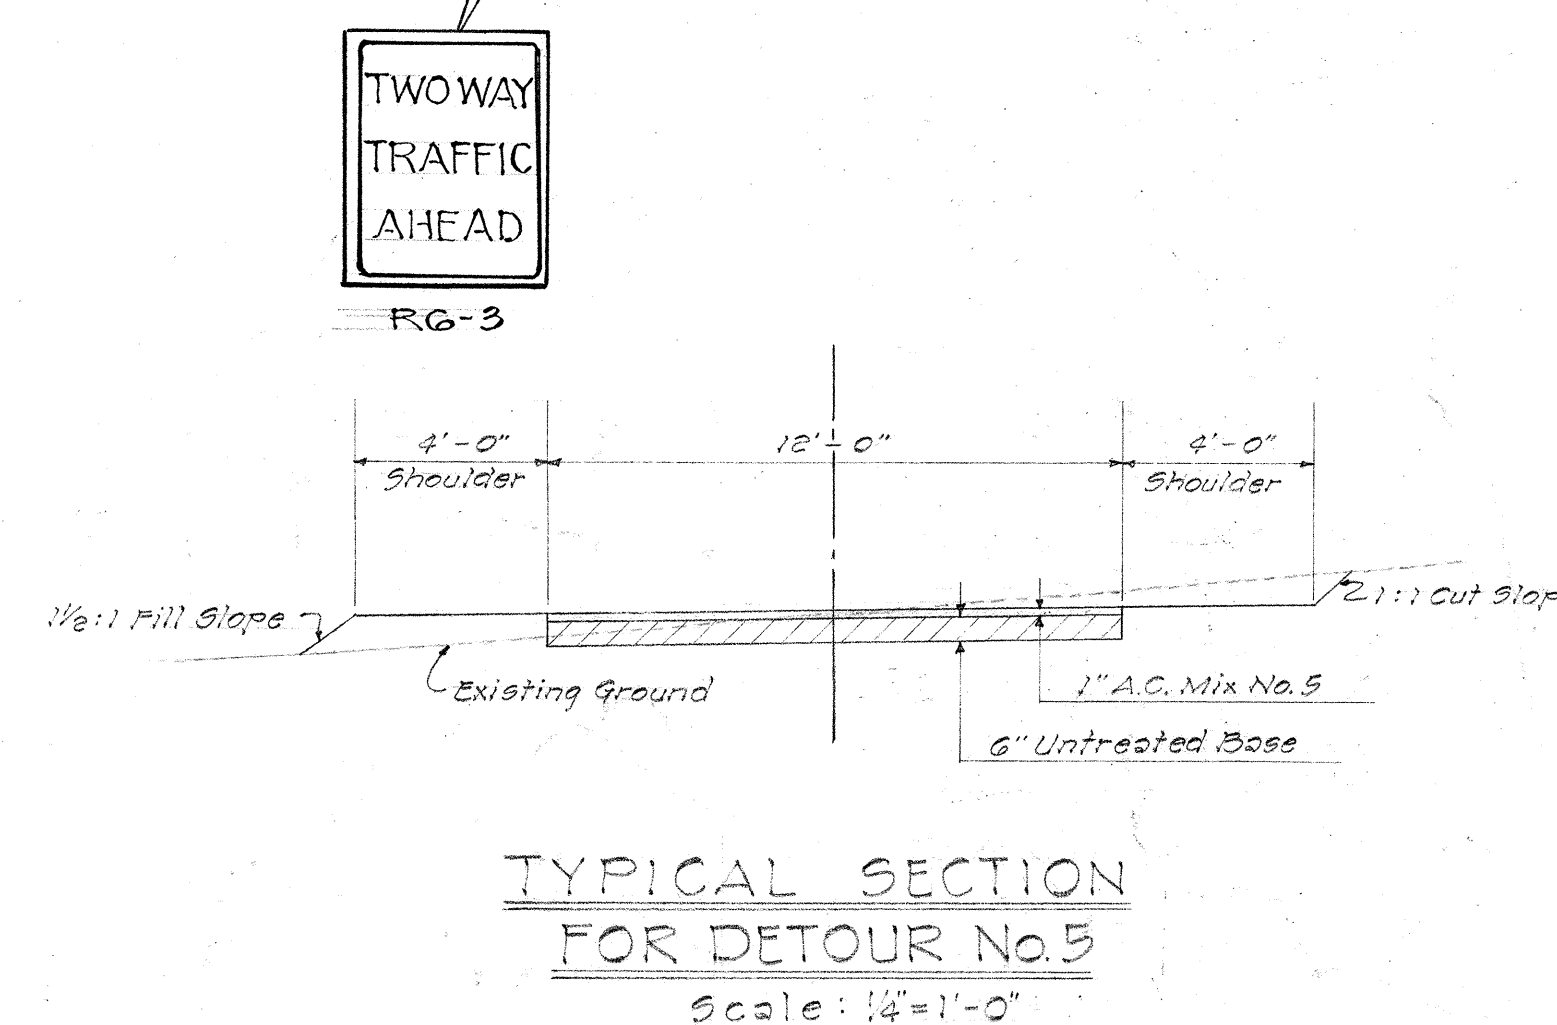


FED. ROAD DIST. NO.	STATE	FED. AID PROJ. NO.	FISCAL YEAR	SHEET NO.	TOTAL SHEETS
HAWAII	HAW.	F-030-1(4)	1964	18	177
SU-0720(6)					

Note: Use detour no. 4 during construction of bridge and for 15 days after deck concrete pour except for the day of deck concrete pour and day after.

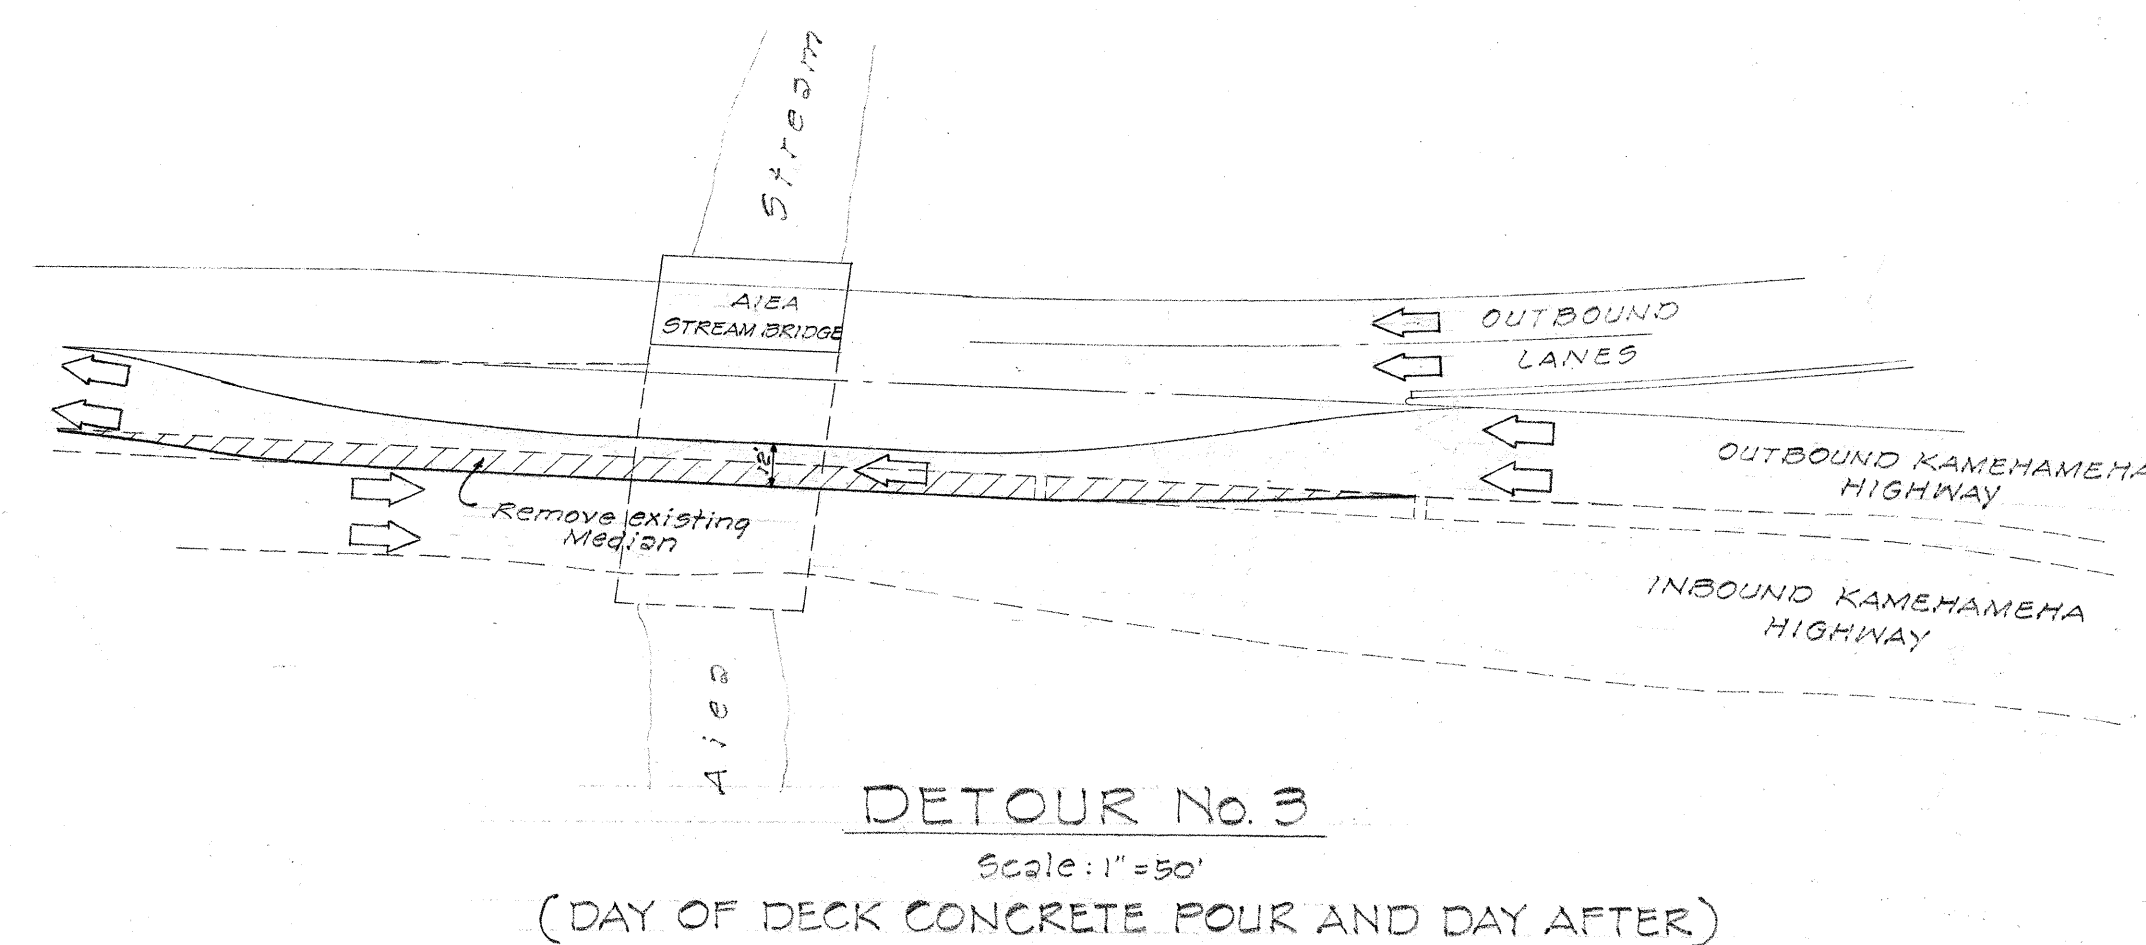

Note: For Detour Curves use a minimum radius of 300 feet.

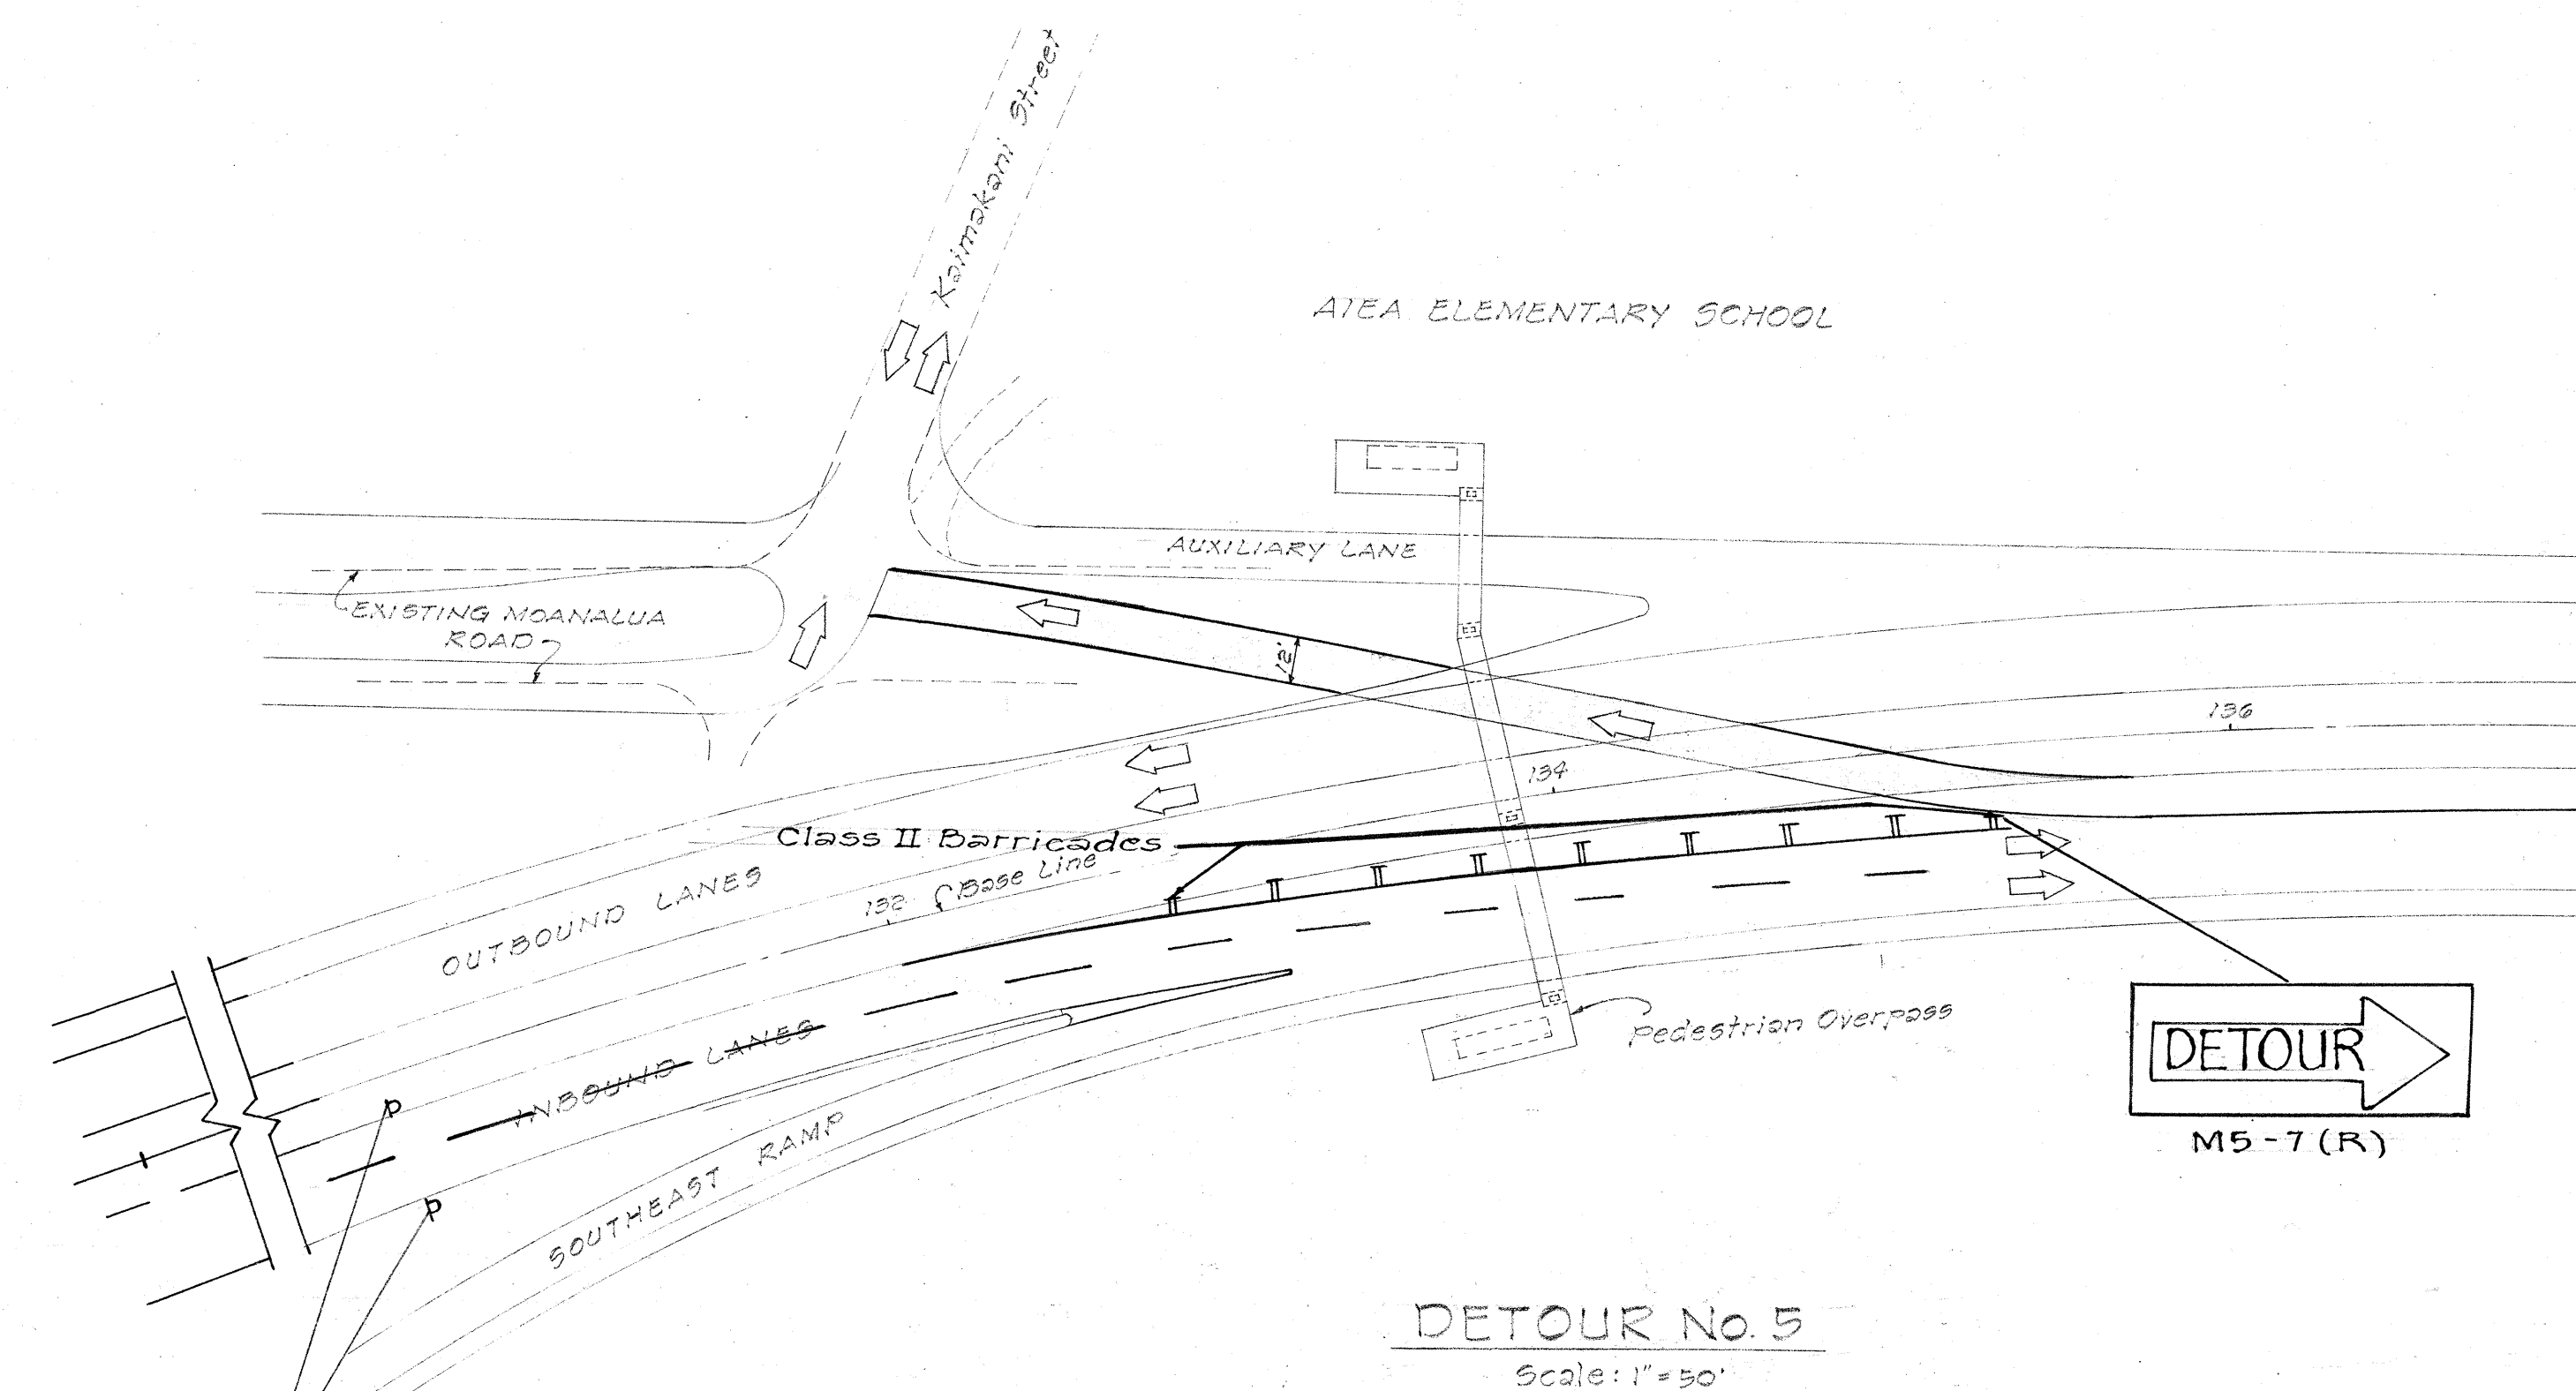

STATE OF HAWAII
DEPARTMENT OF TRANSPORTATION
HIGHWAYS DIVISION

DETAILS OF DETOURS

KAMEHAMEHA HIGHWAY PROJ. No. F-030-1(4)
MOANALUA ROAD PROJ. No. SU-0720(6)

Scales: As Noted Feb, 1964

SHEET No. OF SHEETS

SURVEY PLOTTED BY	DATE
DRAWN BY	"
CHECKED BY	"
NOTE BOOK	"
No.	"