


FED. ROAD DIST. NO.	STATE	FED. AID PROJ. NO.	FISCAL YEAR	SHEET NO.	TOTAL SHEETS
HAWAII	HAW.	F-090-1(4)	1964	14	177


LIMIT OF KAM. HWY.
PROJ. NO. F-090-1(4)

END REF. LINE
STA. 114+78.04
C.B. #16
OUTB. PC STA. 113+13.39
BEG. MOANALUA ROAD
PROJ. NO. 5U-0720(6)

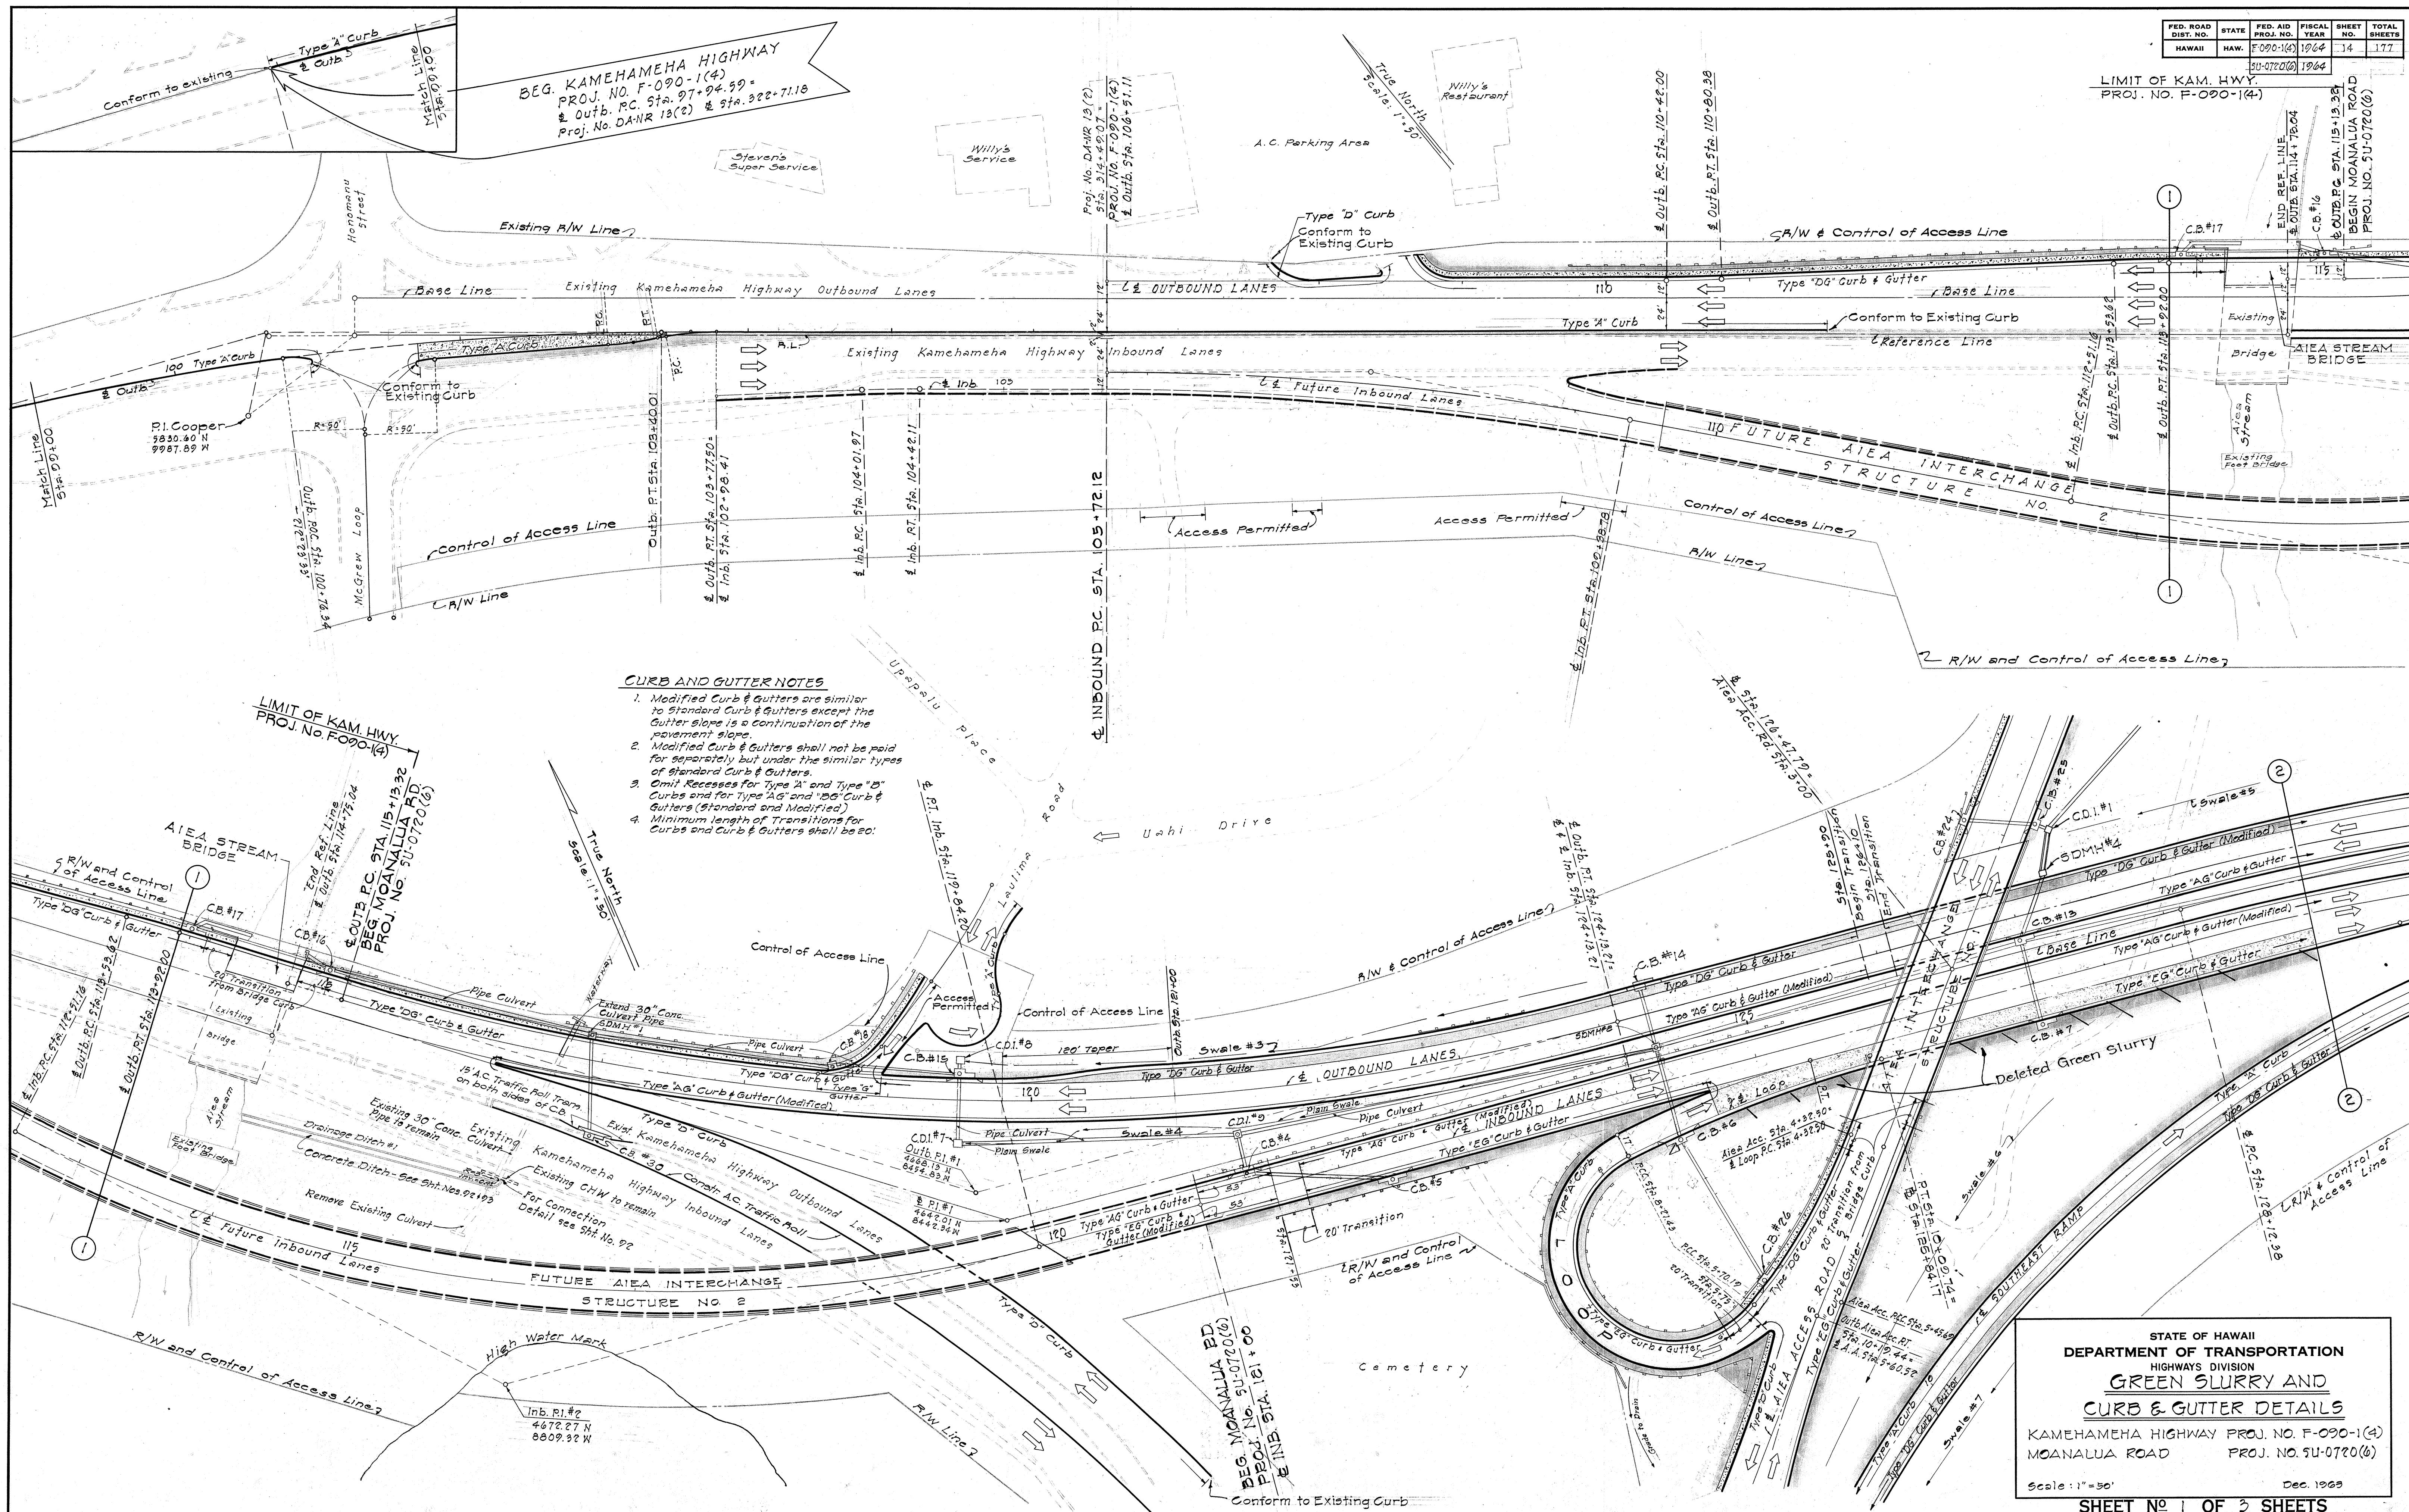

DATE	BY
DESIGNED BY	
TRACED BY	
NOTE BOOK	
QUANTITIES BY	
CHECKED BY	

FED. ROAD DIST. NO.	STATE	FED. AID PROJ. NO.	FISCAL YEAR	SHEET NO.	TOTAL SHEETS
HAWAII	HAW.	5U-0720(6)	1964	15	177

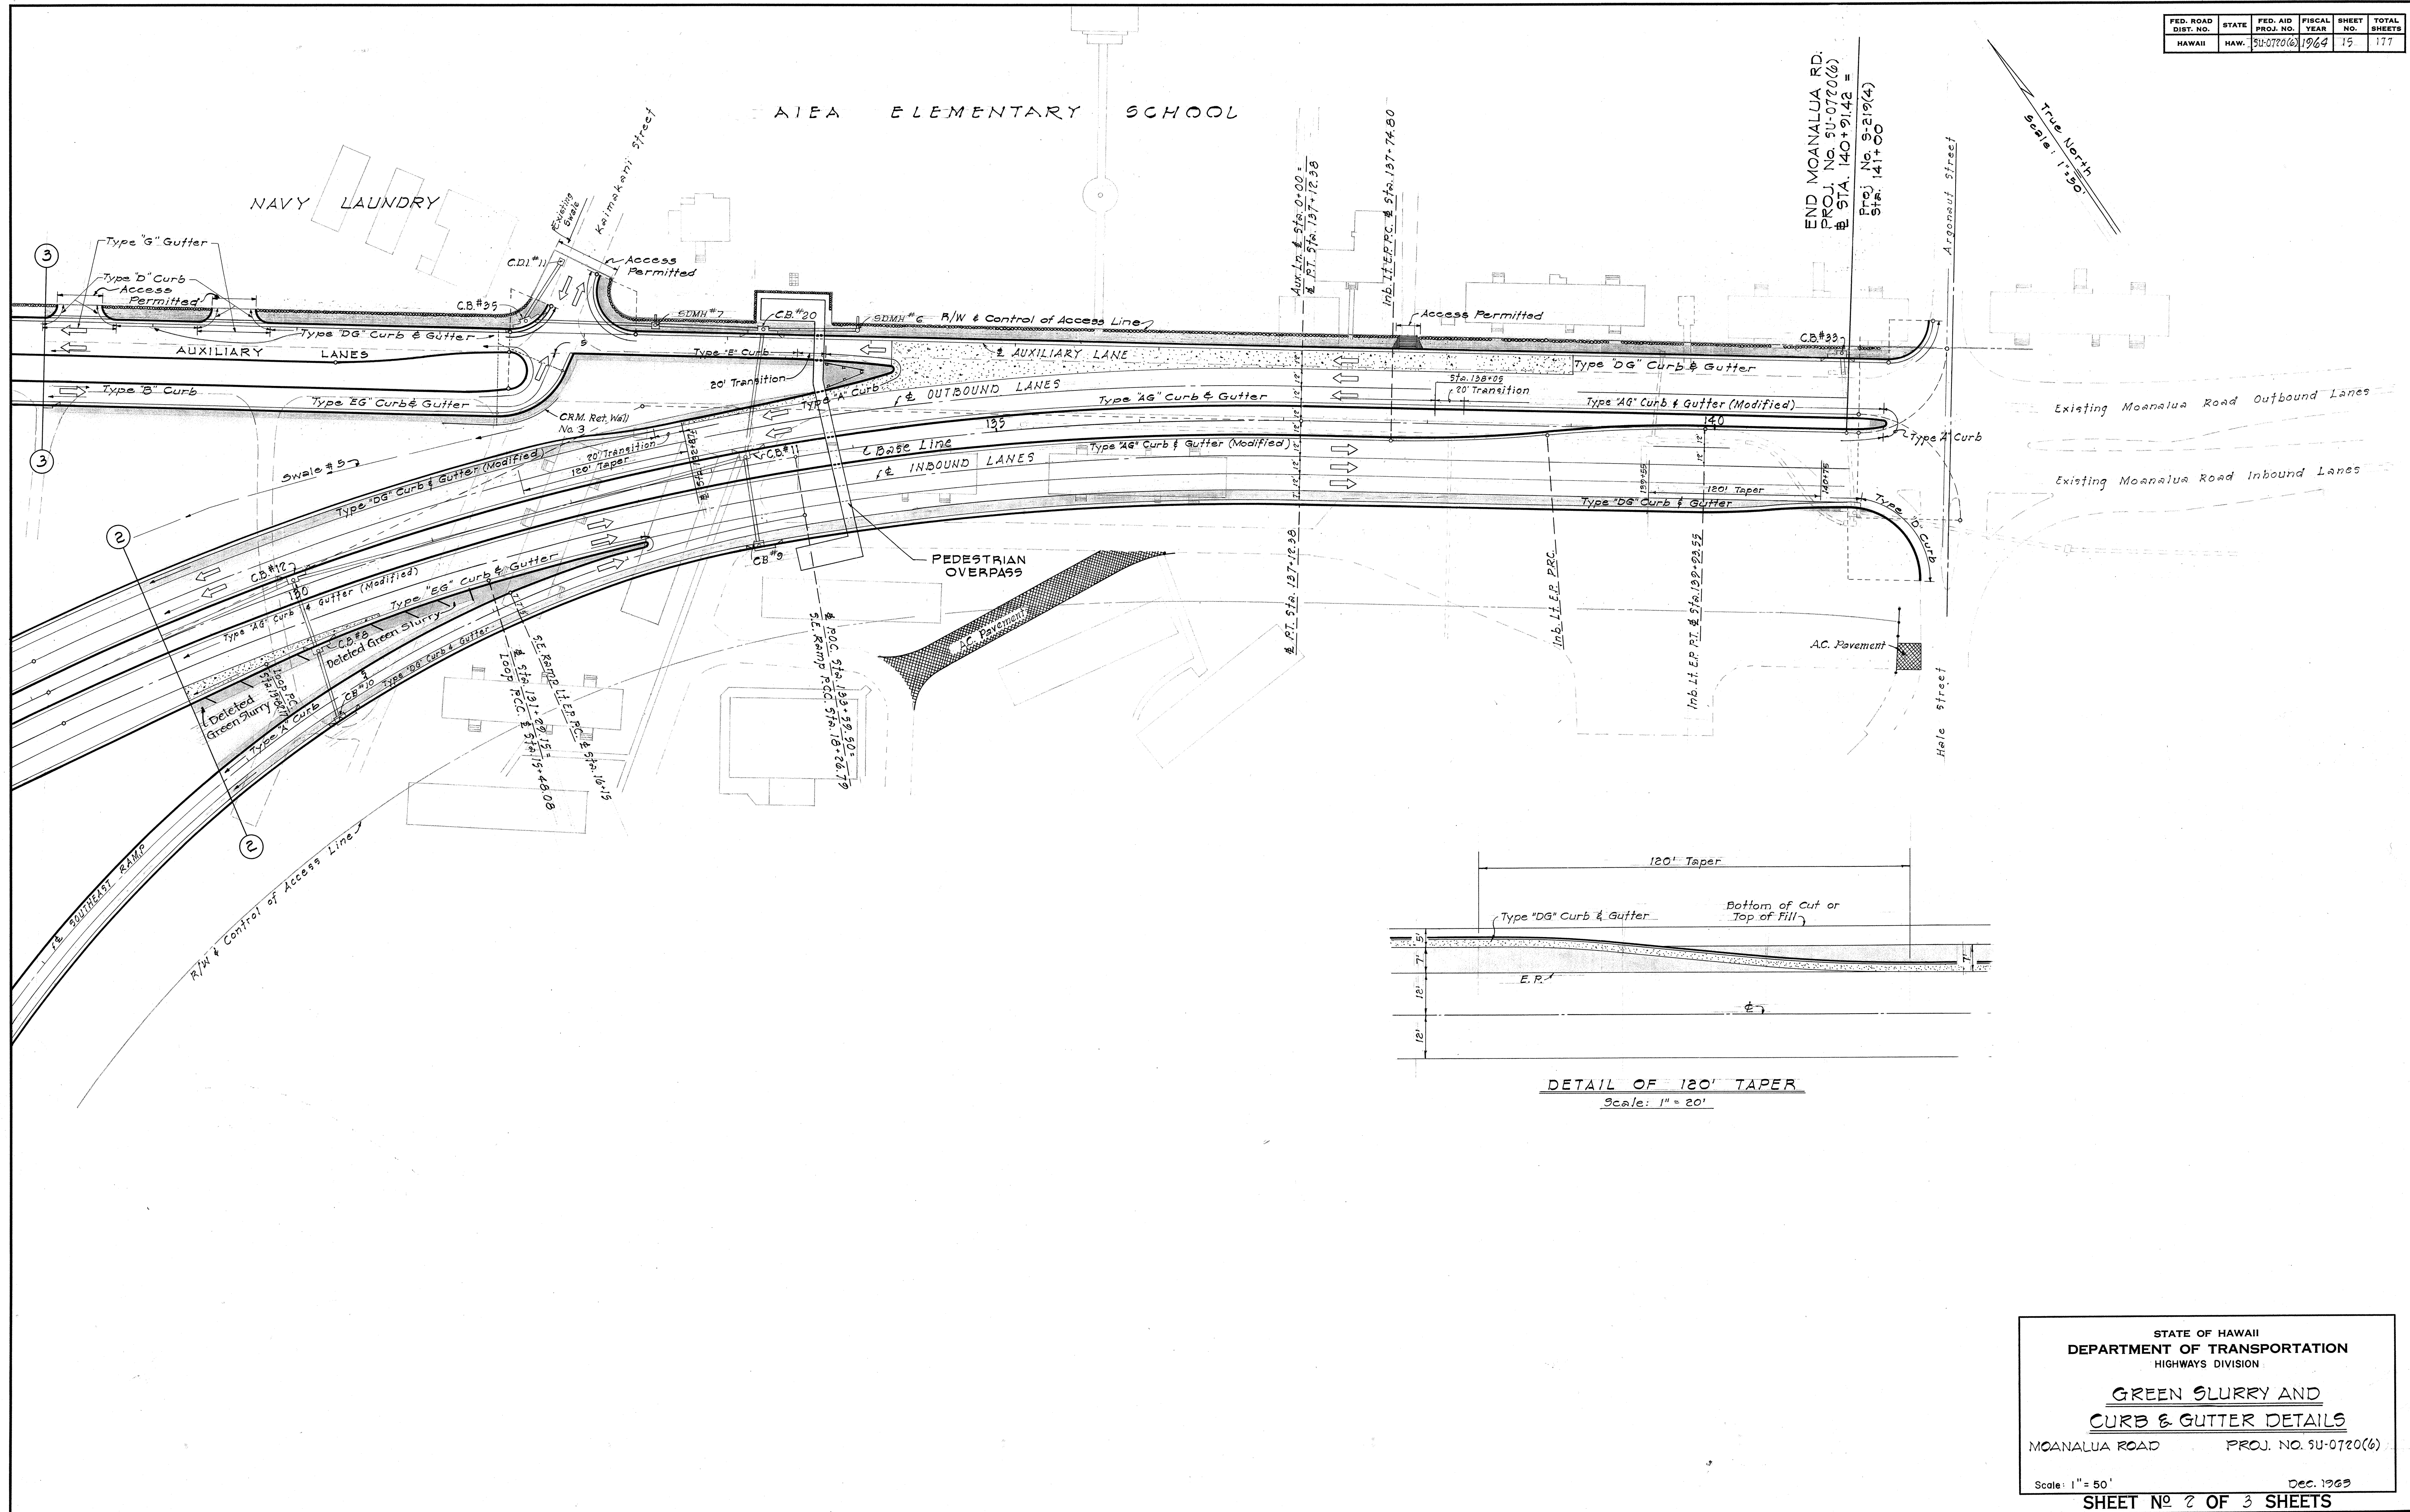

ORIGINAL PLAN	DATE
DRAWN BY	
TRACED BY	
NOTED BY	
CHECKED BY	

STATE OF HAWAII
DEPARTMENT OF TRANSPORTATION
HIGHWAYS DIVISION

GREEN SLURRY AND CURB & GUTTER DETAILS


MOANALUA ROAD PROJ. NO. 5U-0720(6)

Scale: 1" = 50' Dec. 1963

SHEET NO. 2 OF 3 SHEETS

FED. ROAD DIST. NO.	STATE	FED. AID PROJ. NO.	FISCAL YEAR	SHEET NO.	TOTAL SHEETS
HAWAII	HAW.	F-090-1(4)	1964	16	177
SU-0720(6) 1964					

ORIGINAL PLAN	DATE
DRAWN BY	
CHECKED BY	
QUANTITIES BY	
NOTED BY	
NO.	

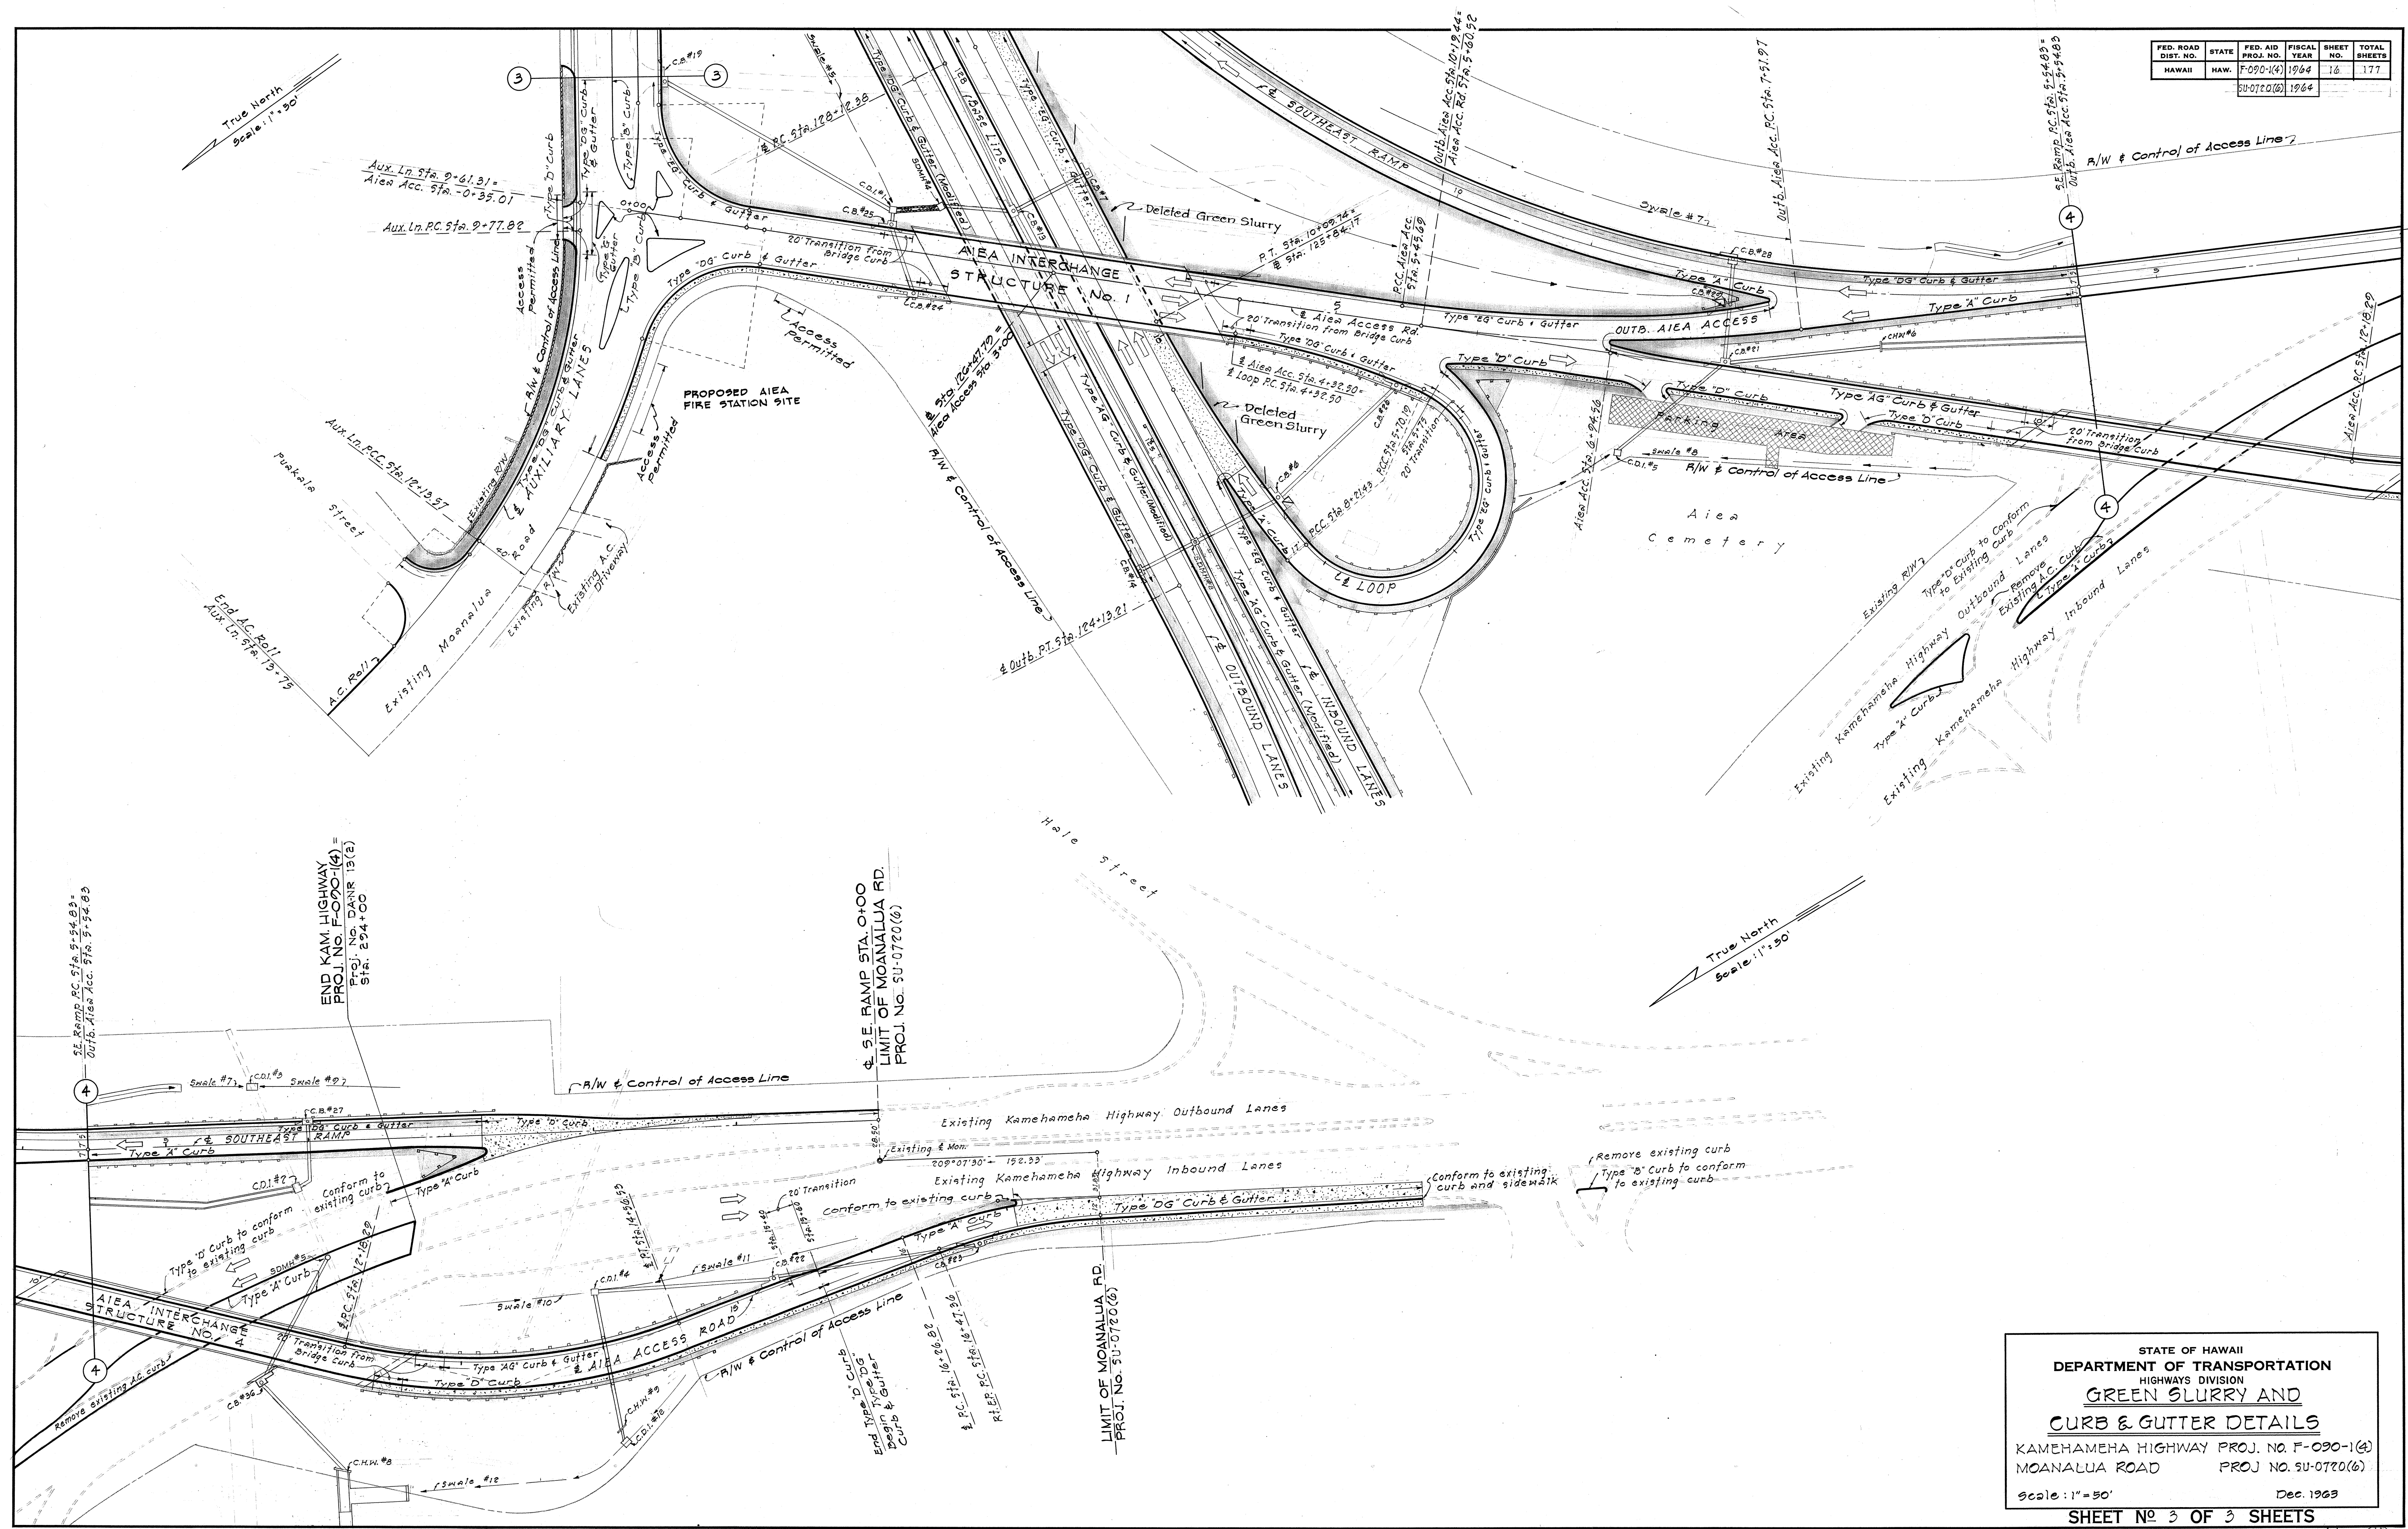

STATE OF HAWAII
DEPARTMENT OF TRANSPORTATION
HIGHWAYS DIVISION
GREEN SLURRY AND CURB & GUTTER DETAILS
KAMEHAMEHA HIGHWAY PROJ. NO. F-090-1(4)
MOANALUA ROAD PROJ. NO. SU-0720(6)
Scale: 1"=50' Dec. 1963
SHEET NO. 3 OF 3 SHEETS