


FED. ROAD DIST. NO.	STATE	FED. AID PROJ. NO.	FISCAL YEAR	SHEET NO.	TOTAL SHEETS
HAWAII	HAW.	50-0720(6)	1964	12	177

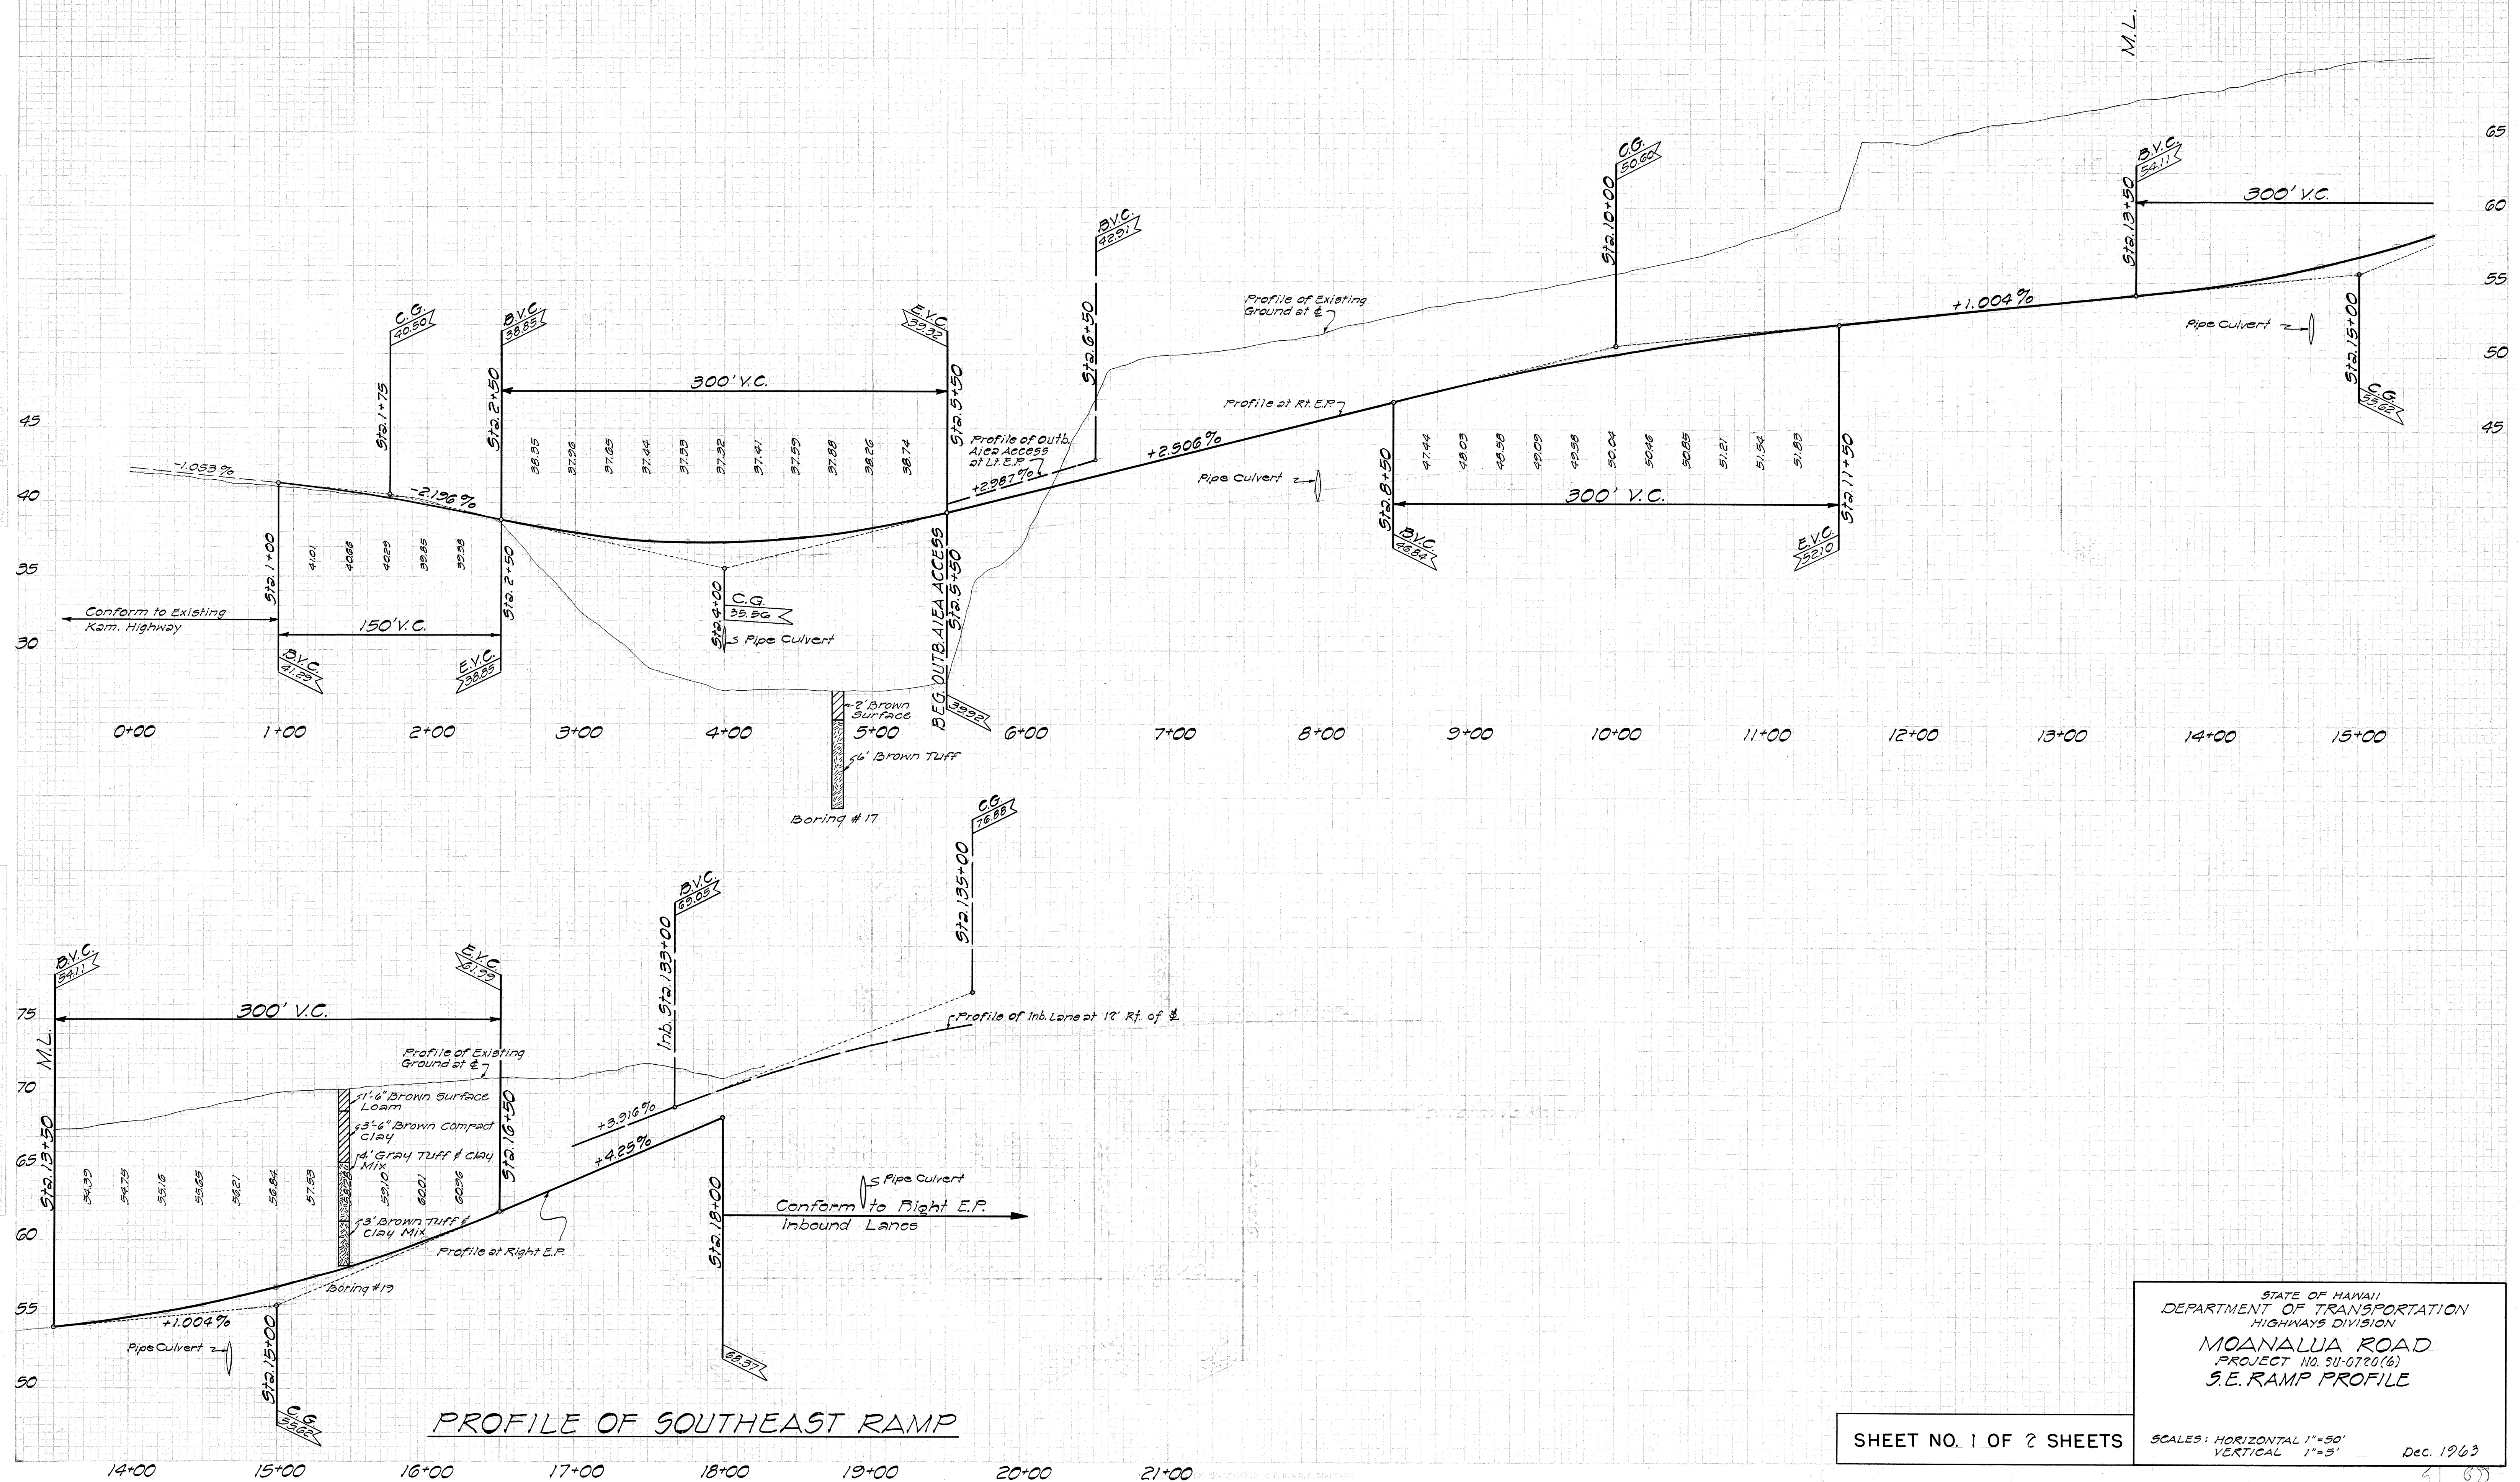

PROFILE OF SOUTHEAST RAMP


SHEET NO. 1 OF 2 SHEETS

STATE OF HAWAII
DEPARTMENT OF TRANSPORTATION
HIGHWAYS DIVISION
MOANALUA ROAD
PROJECT NO. 50-0720(6)
S.E. RAMP PROFILE


SCALES: HORIZONTAL 1"=50'
VERTICAL 1"=5'

Dec. 1963

FED. ROAD DIST. NO.	STATE	FED. AID PROJ. NO.	FISCAL YEAR	SHEET NO.	TOTAL SHEETS
HAWAII	HAW.	5U-0720(6)	1964	12	177

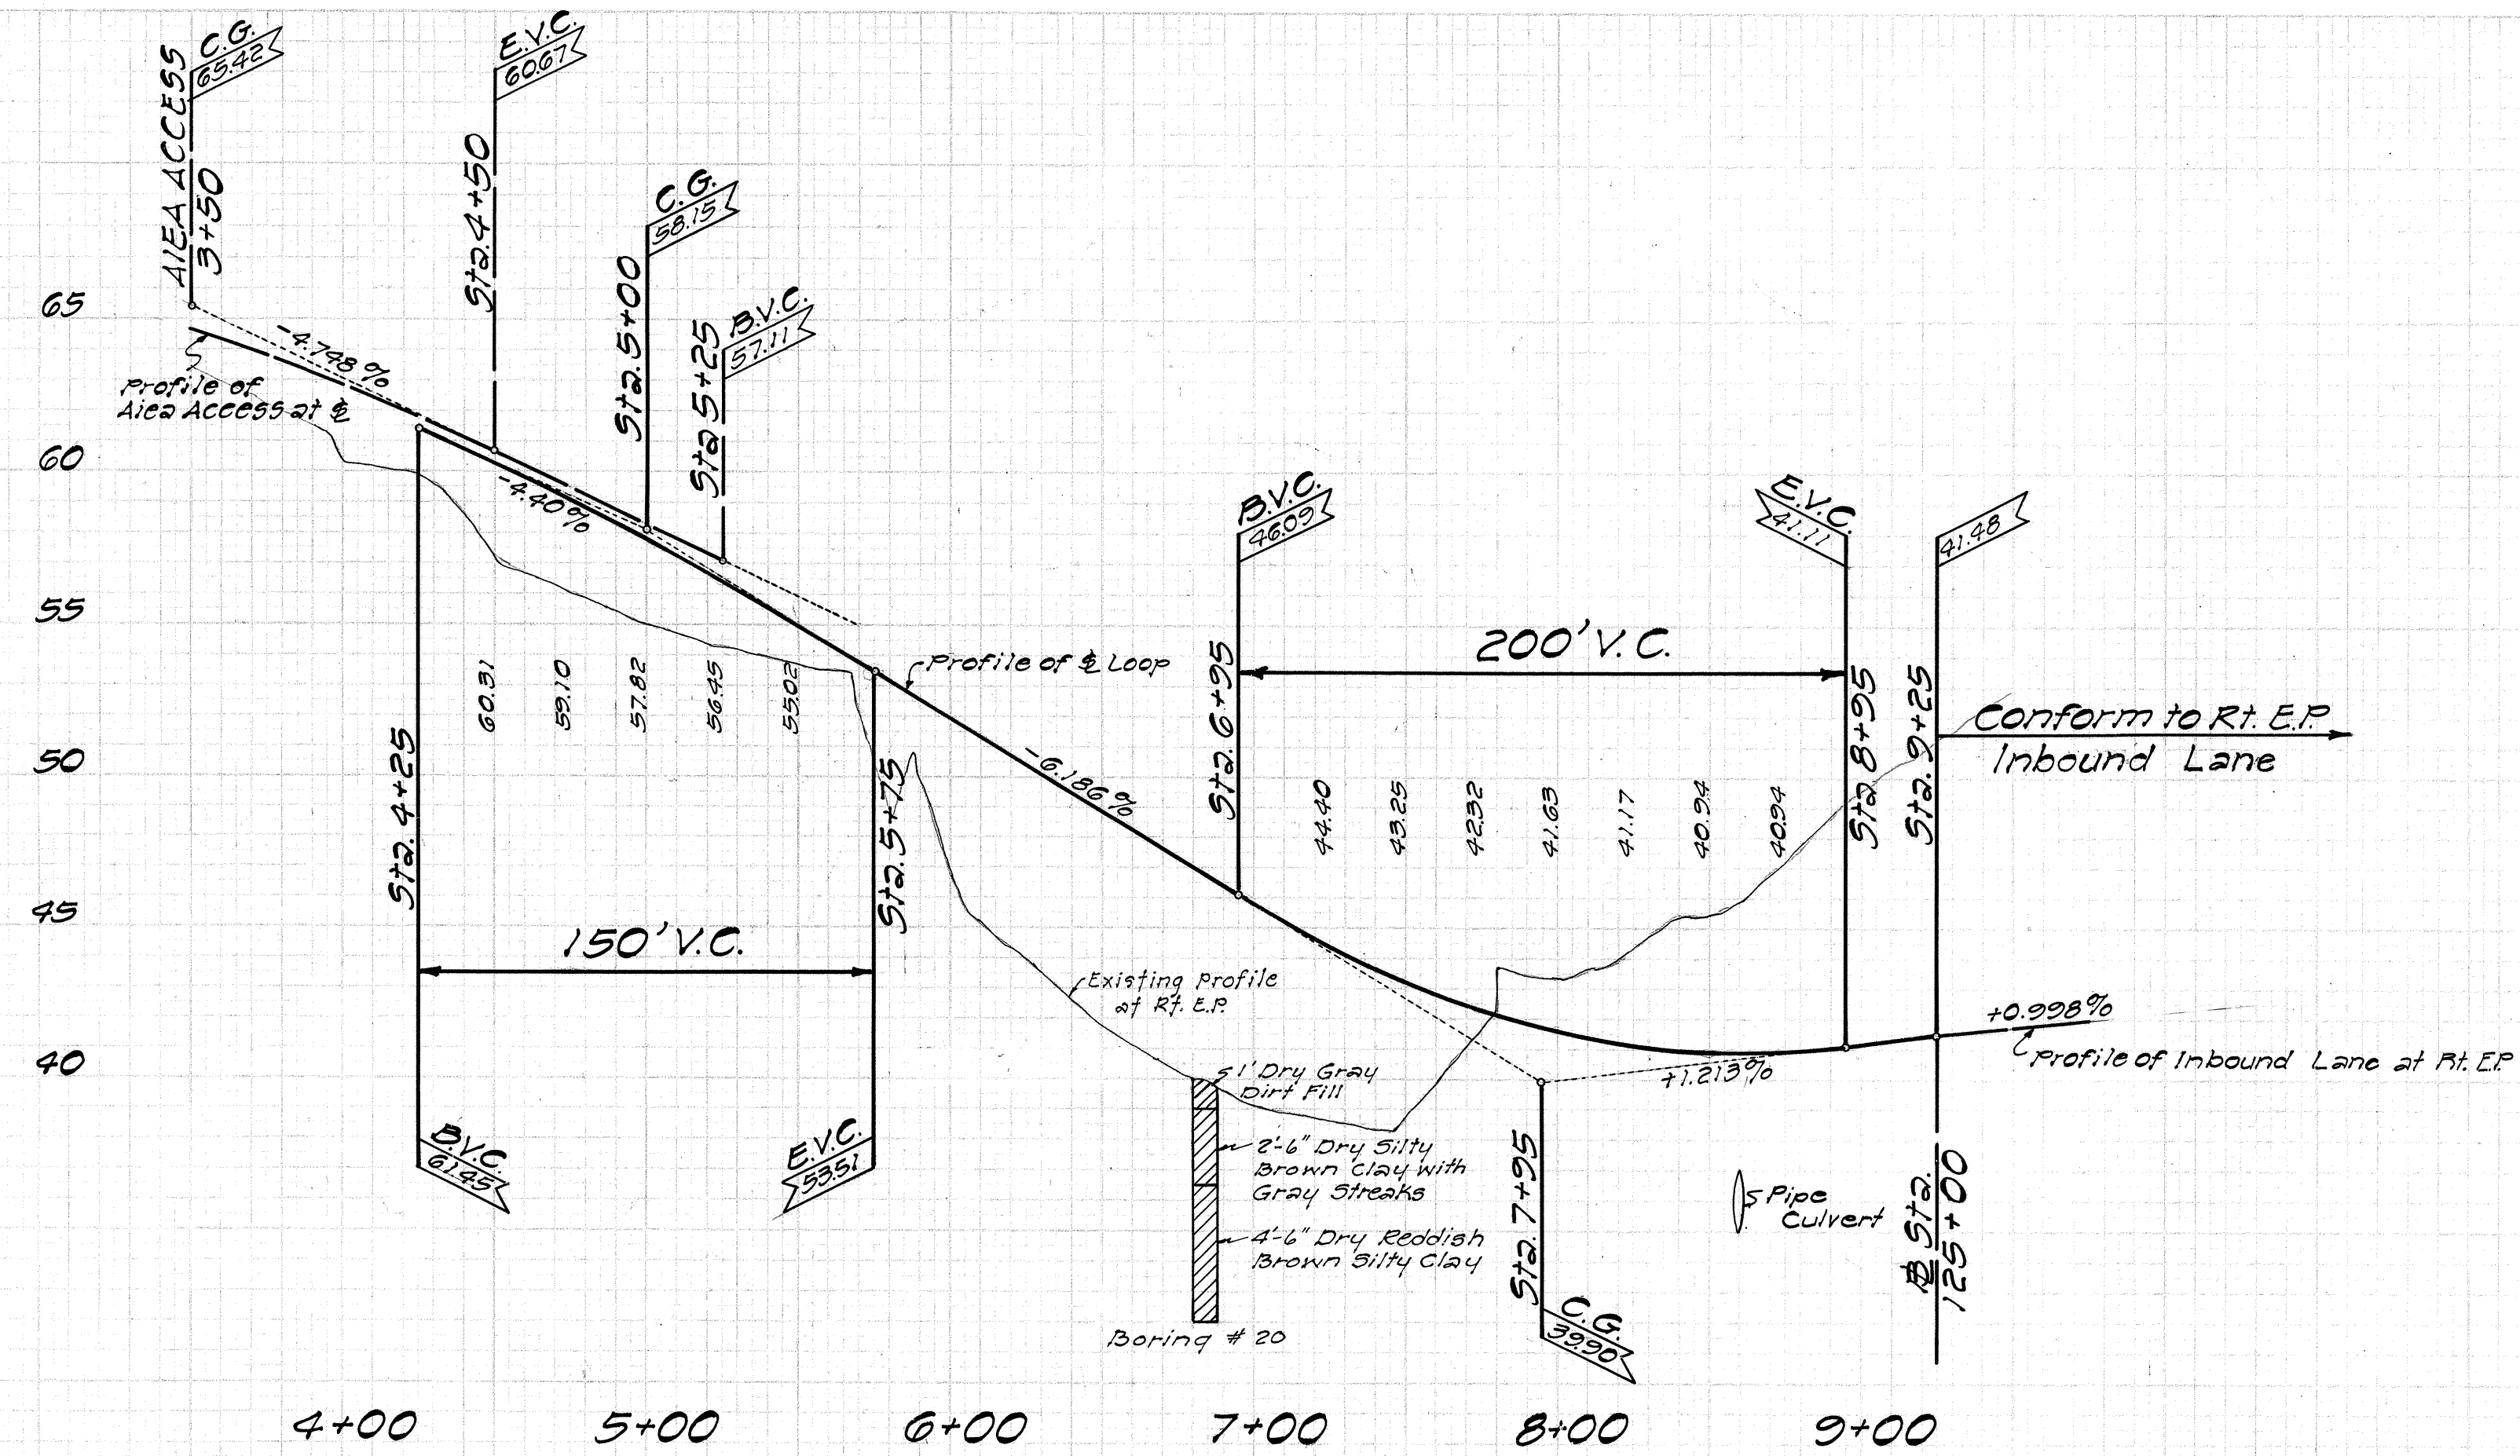

PROFILE OF LOOP

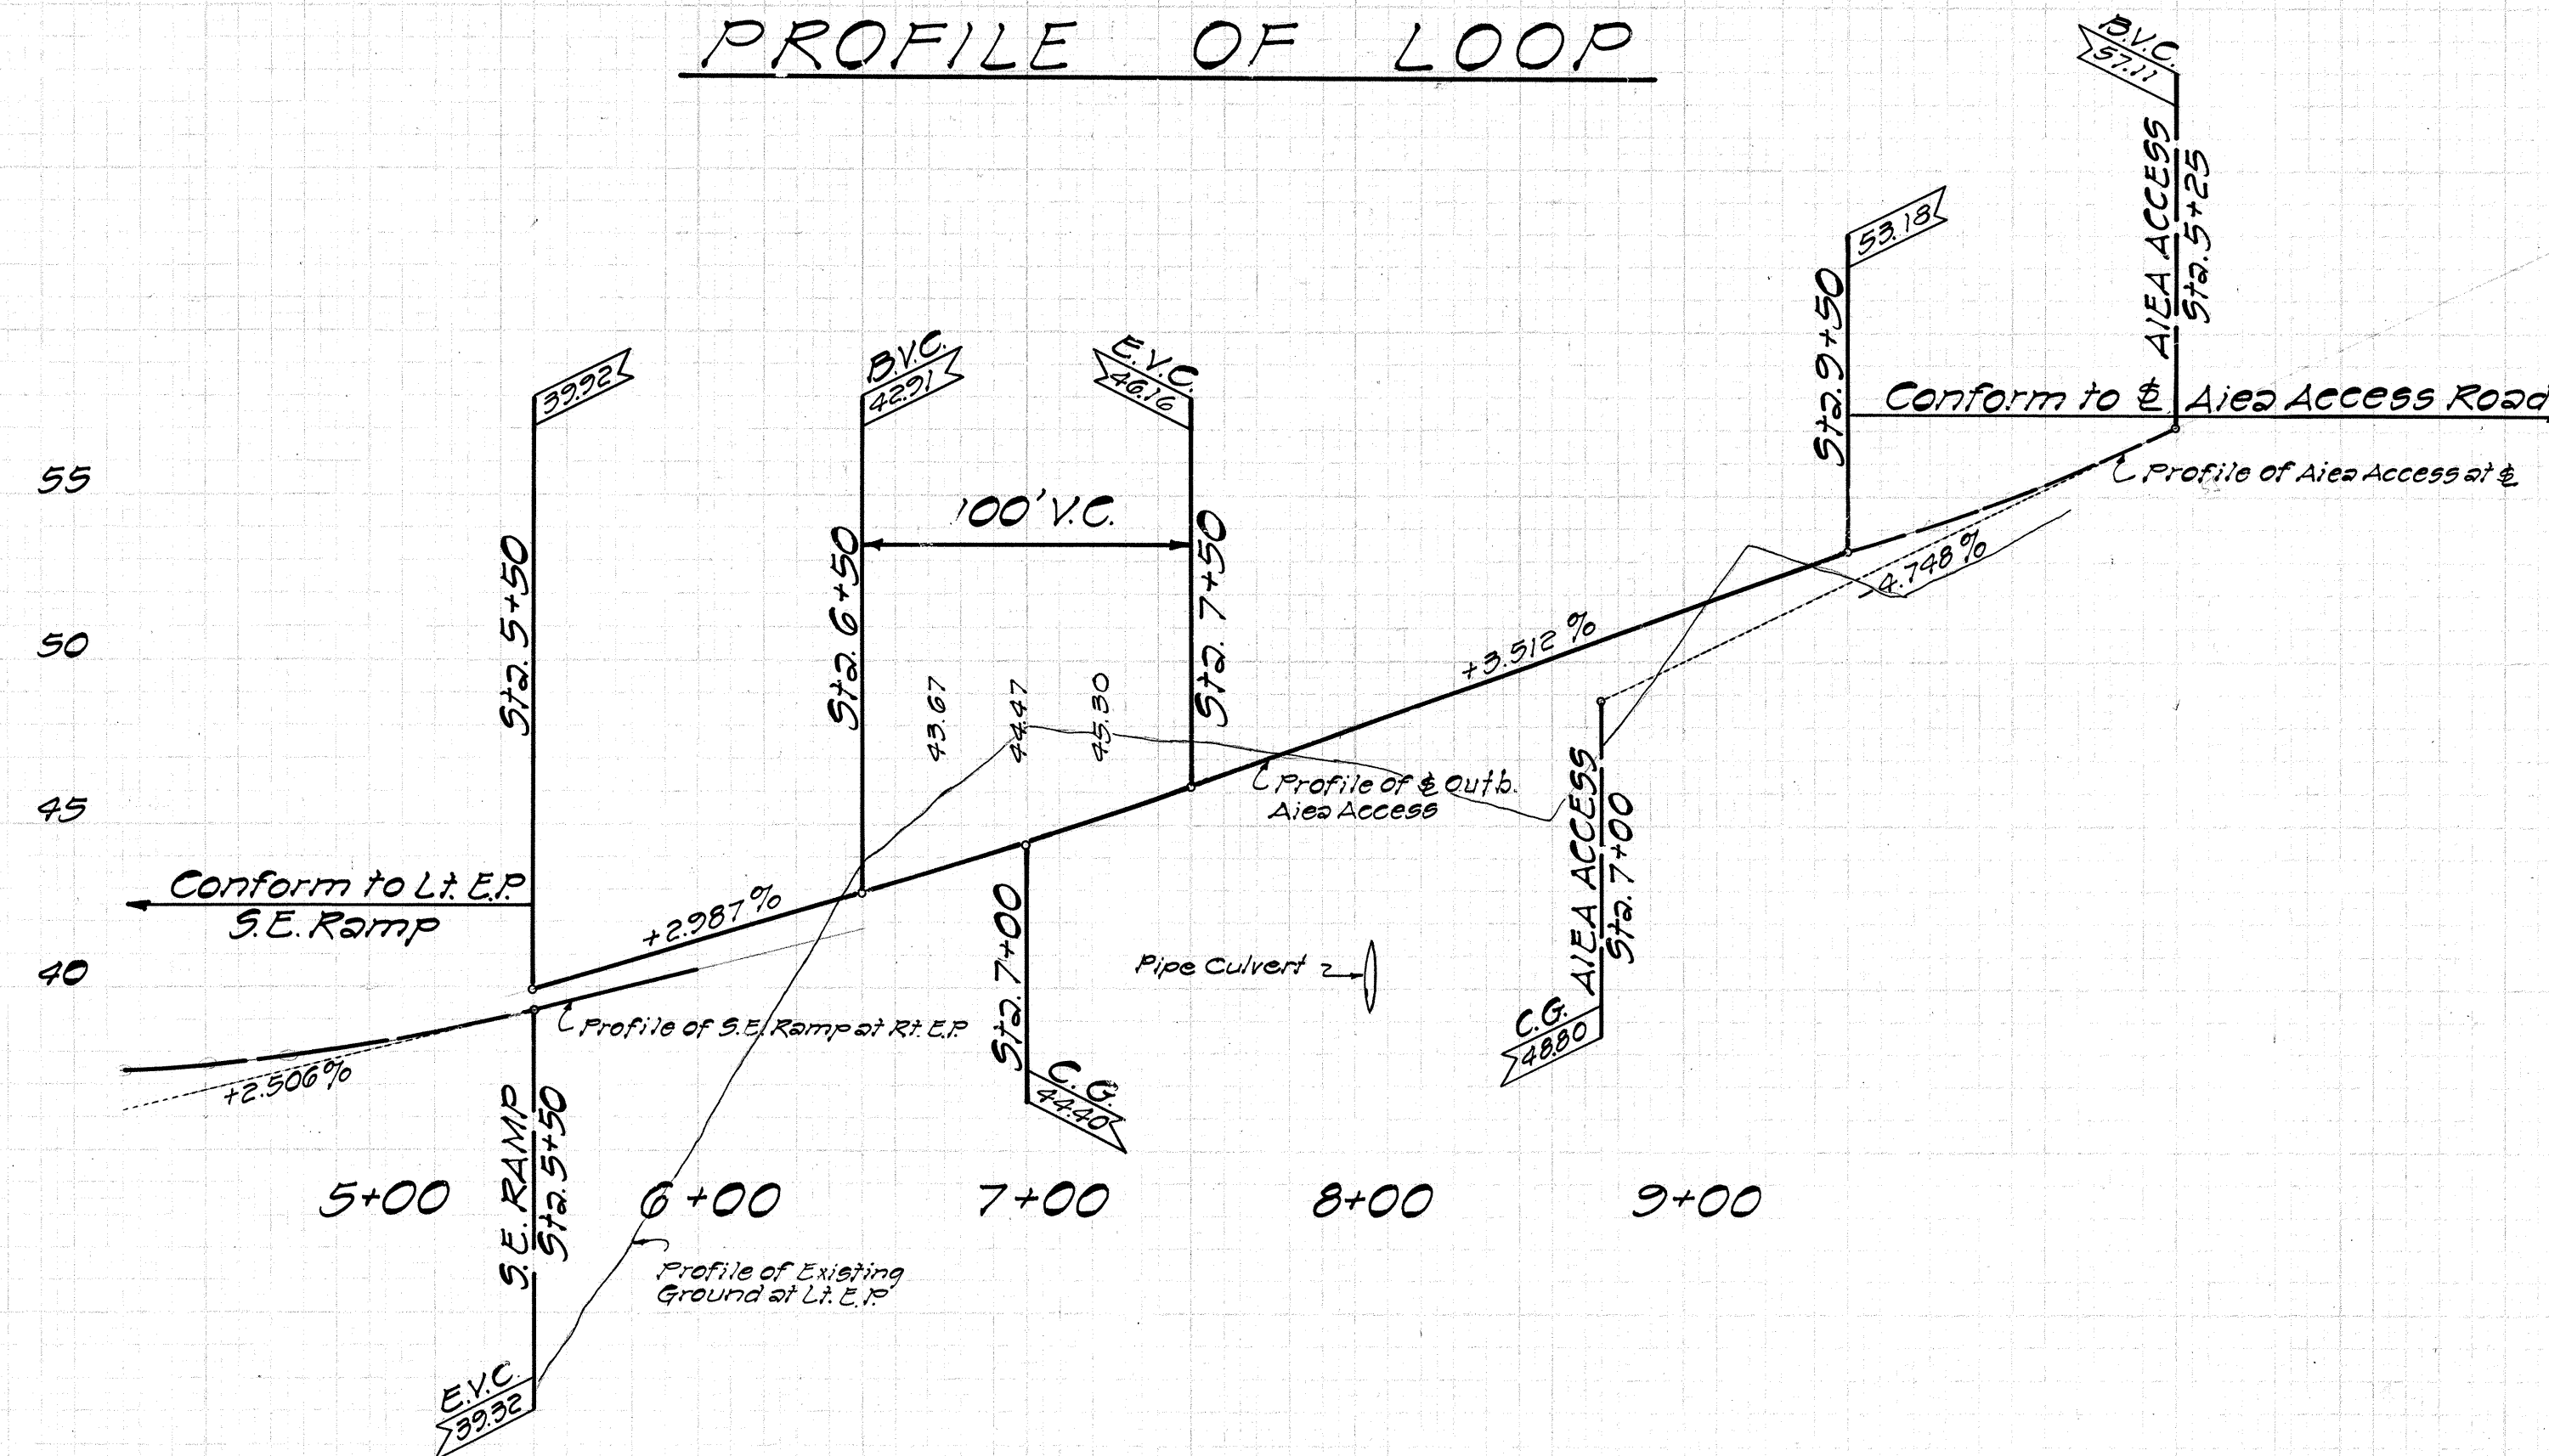

PROFILE OF
OUTBOUND AREA ACCESS

SHEET NO. 12 OF 177 SHEETS

STATE OF HAWAII
DEPARTMENT OF TRANSPORTATION
HIGHWAYS DIVISION
MOANALUA ROAD
PROJECT NO. 5U-0720(6)
PROFILE OF LOOP AND
OUTBOUND AREA ACCESS
SCALES: HORIZONTAL 1"=50'
VERTICAL 1"=5'
Dec. 1963