




FED. ROAD DIST. NO.	STATE	FED. AID PROJ. NO.	FISCAL YEAR	SHEET NO.	TOTAL SHEETS
HAWAII	HAW.	5U-0720(6)	1964	41	177

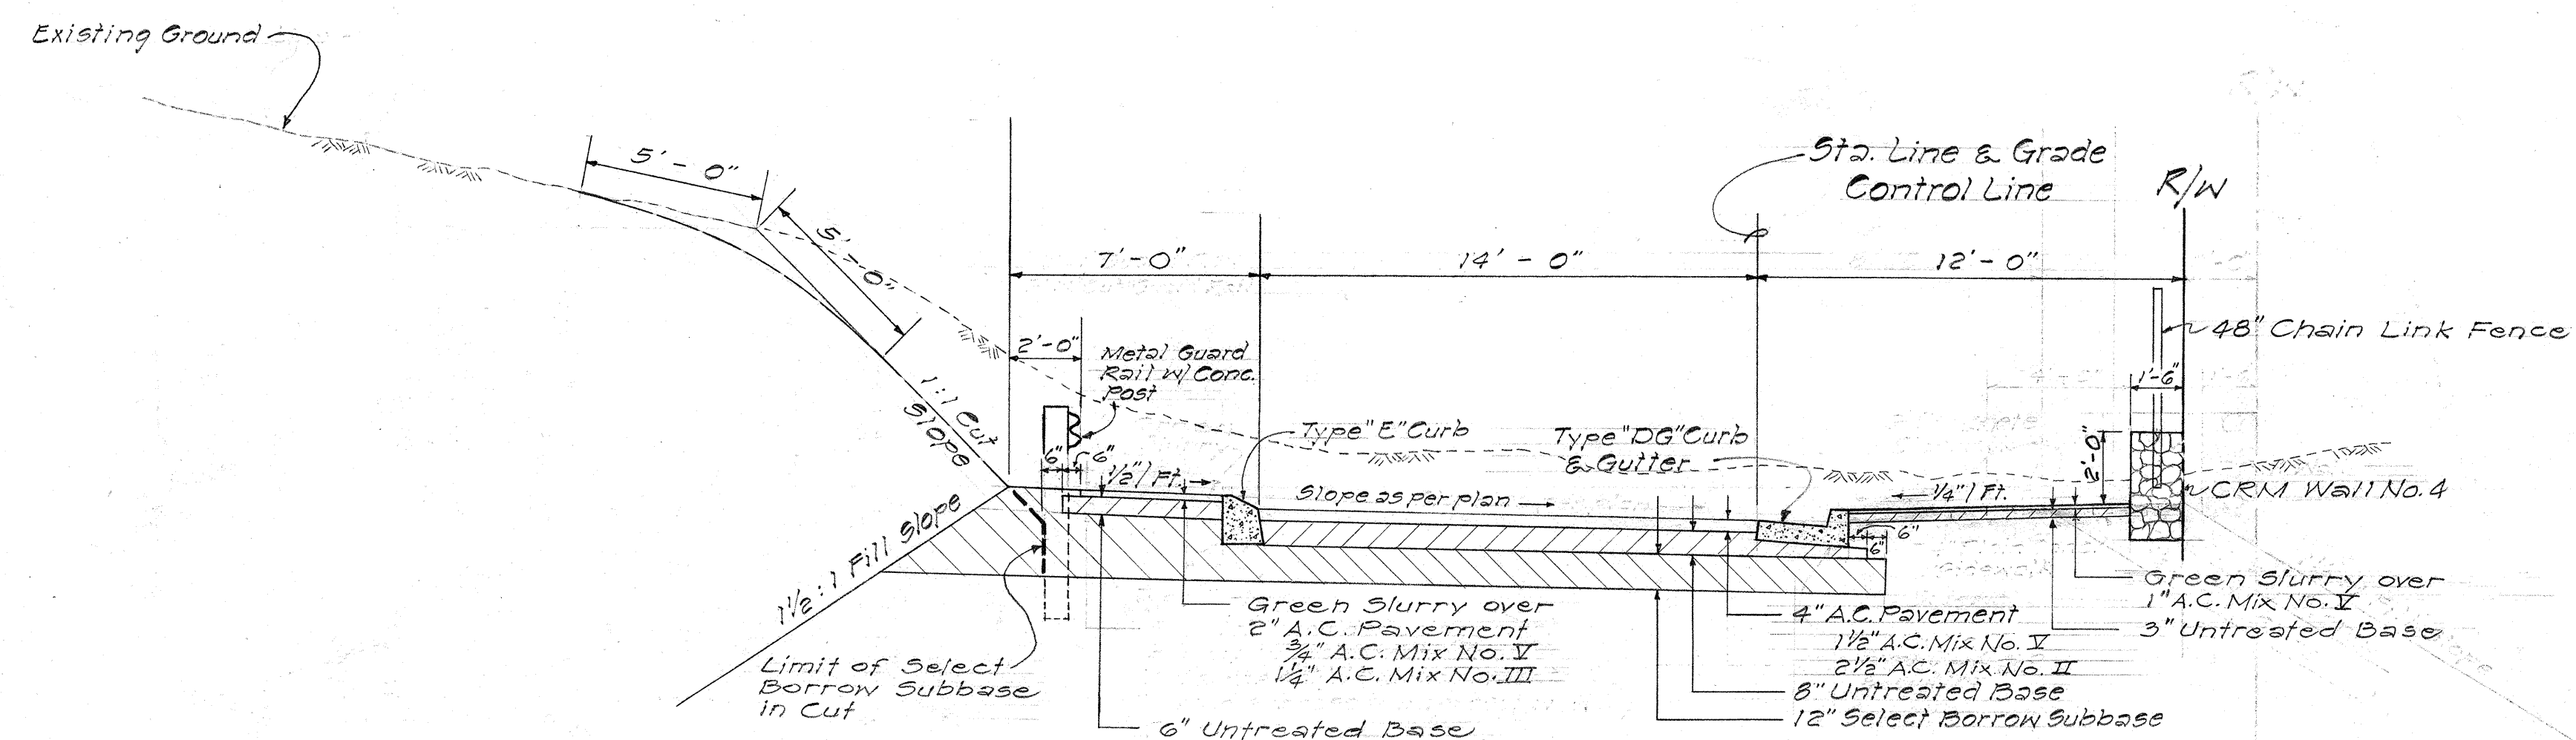

AUXILIARY LANE
STA. 2+86± TO STA. 5+00
 Scale: 1/4" = 1'-0"

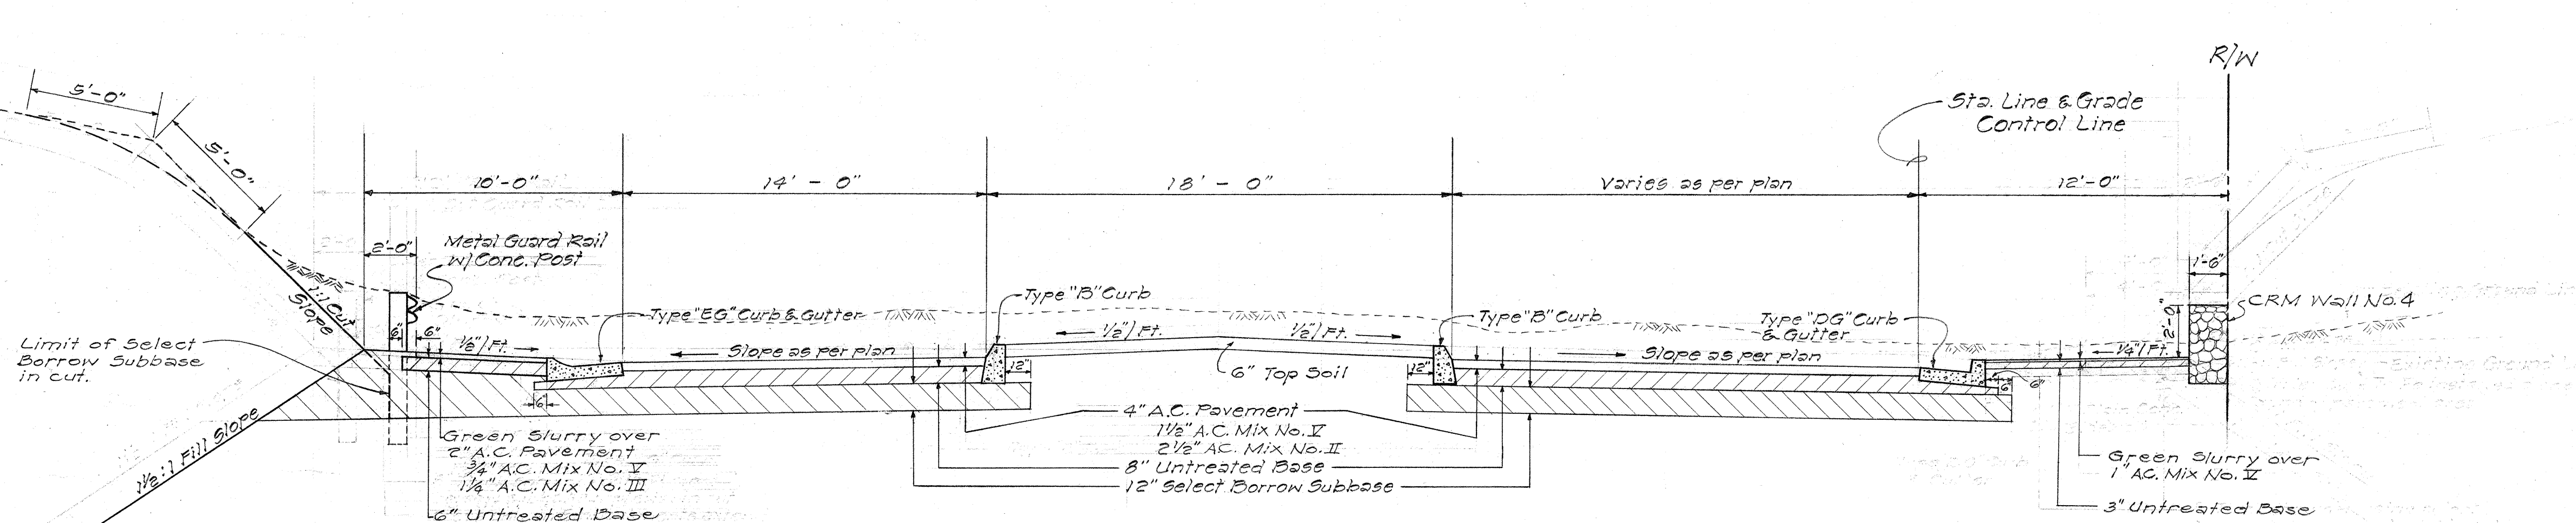

AUXILIARY LANE
STA. 5+50± TO STA. 9+61±
 Scale: 1/4" = 1'-0"






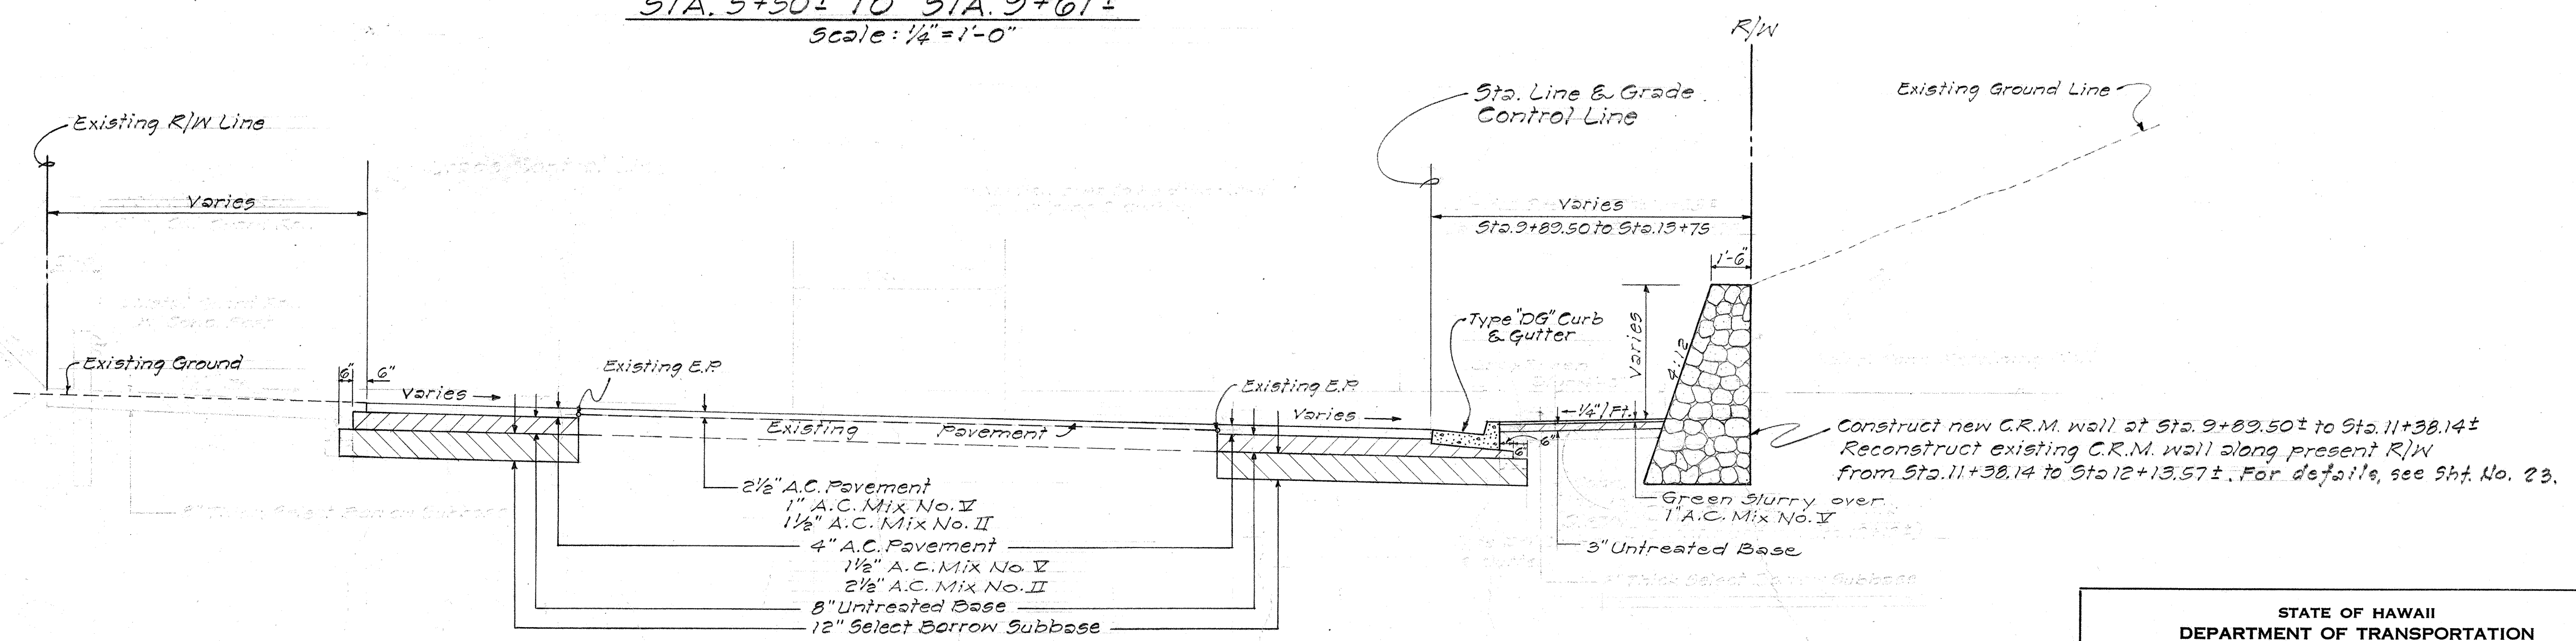


WIDENING EXISTING MOANALUA ROAD
AUX. LN. STA. 9+89.50± TO STA. 13+75
 Scale: 1/4" = 1'-0"

STATE OF HAWAII
 DEPARTMENT OF TRANSPORTATION
 HIGHWAYS DIVISION
TYPICAL SECTIONS
 MOANALUA ROAD
 PROJ. NO. 5U-0720(6)

DATE	DESIGNED BY	CHECKED BY
PLAN	DESIGNED BY	CHECKED BY
NOTE BOOK	DESIGNED BY	CHECKED BY
No.	DESIGNED BY	CHECKED BY


FED. ROAD DIST. NO.	STATE	FED. AID PROJ. NO.	FISCAL YEAR	SHEET NO.	TOTAL SHEETS
HAWAII	HAW.	F-090-1(4)	1964	5	177
		5U-0720(6)	1964		

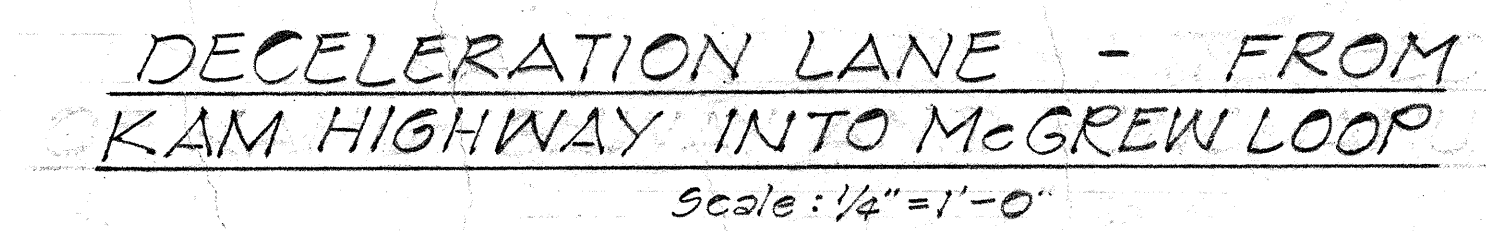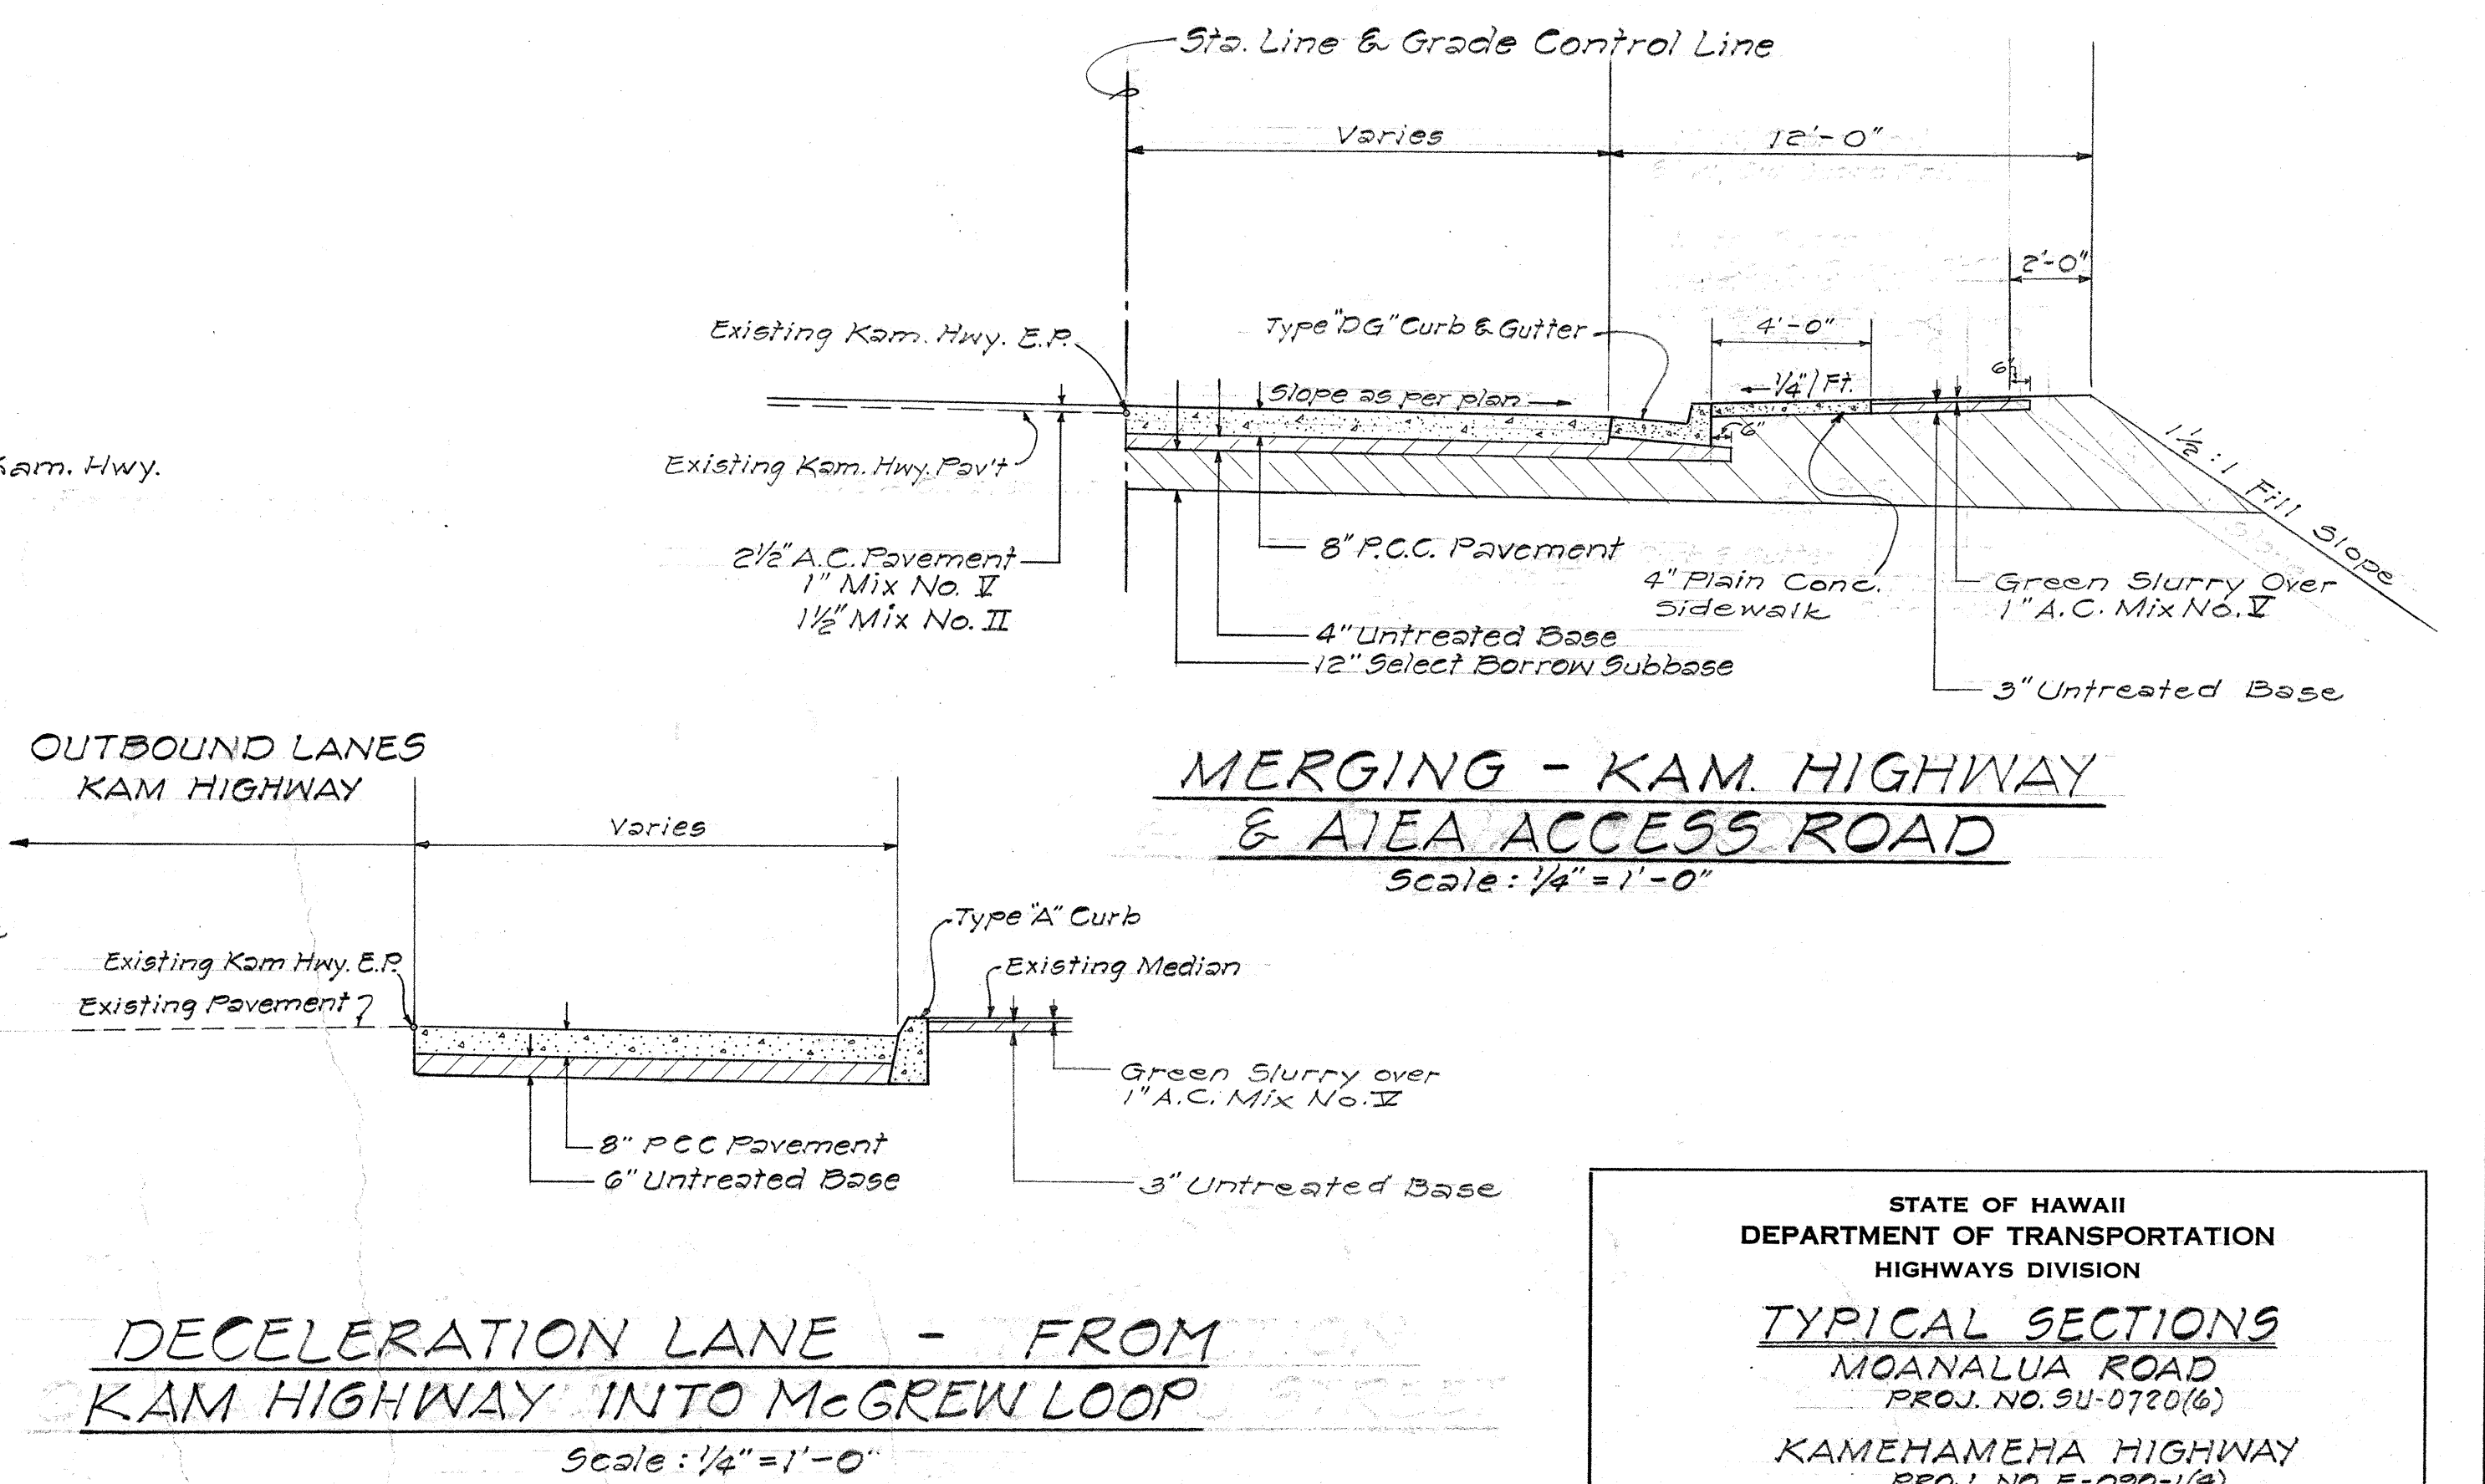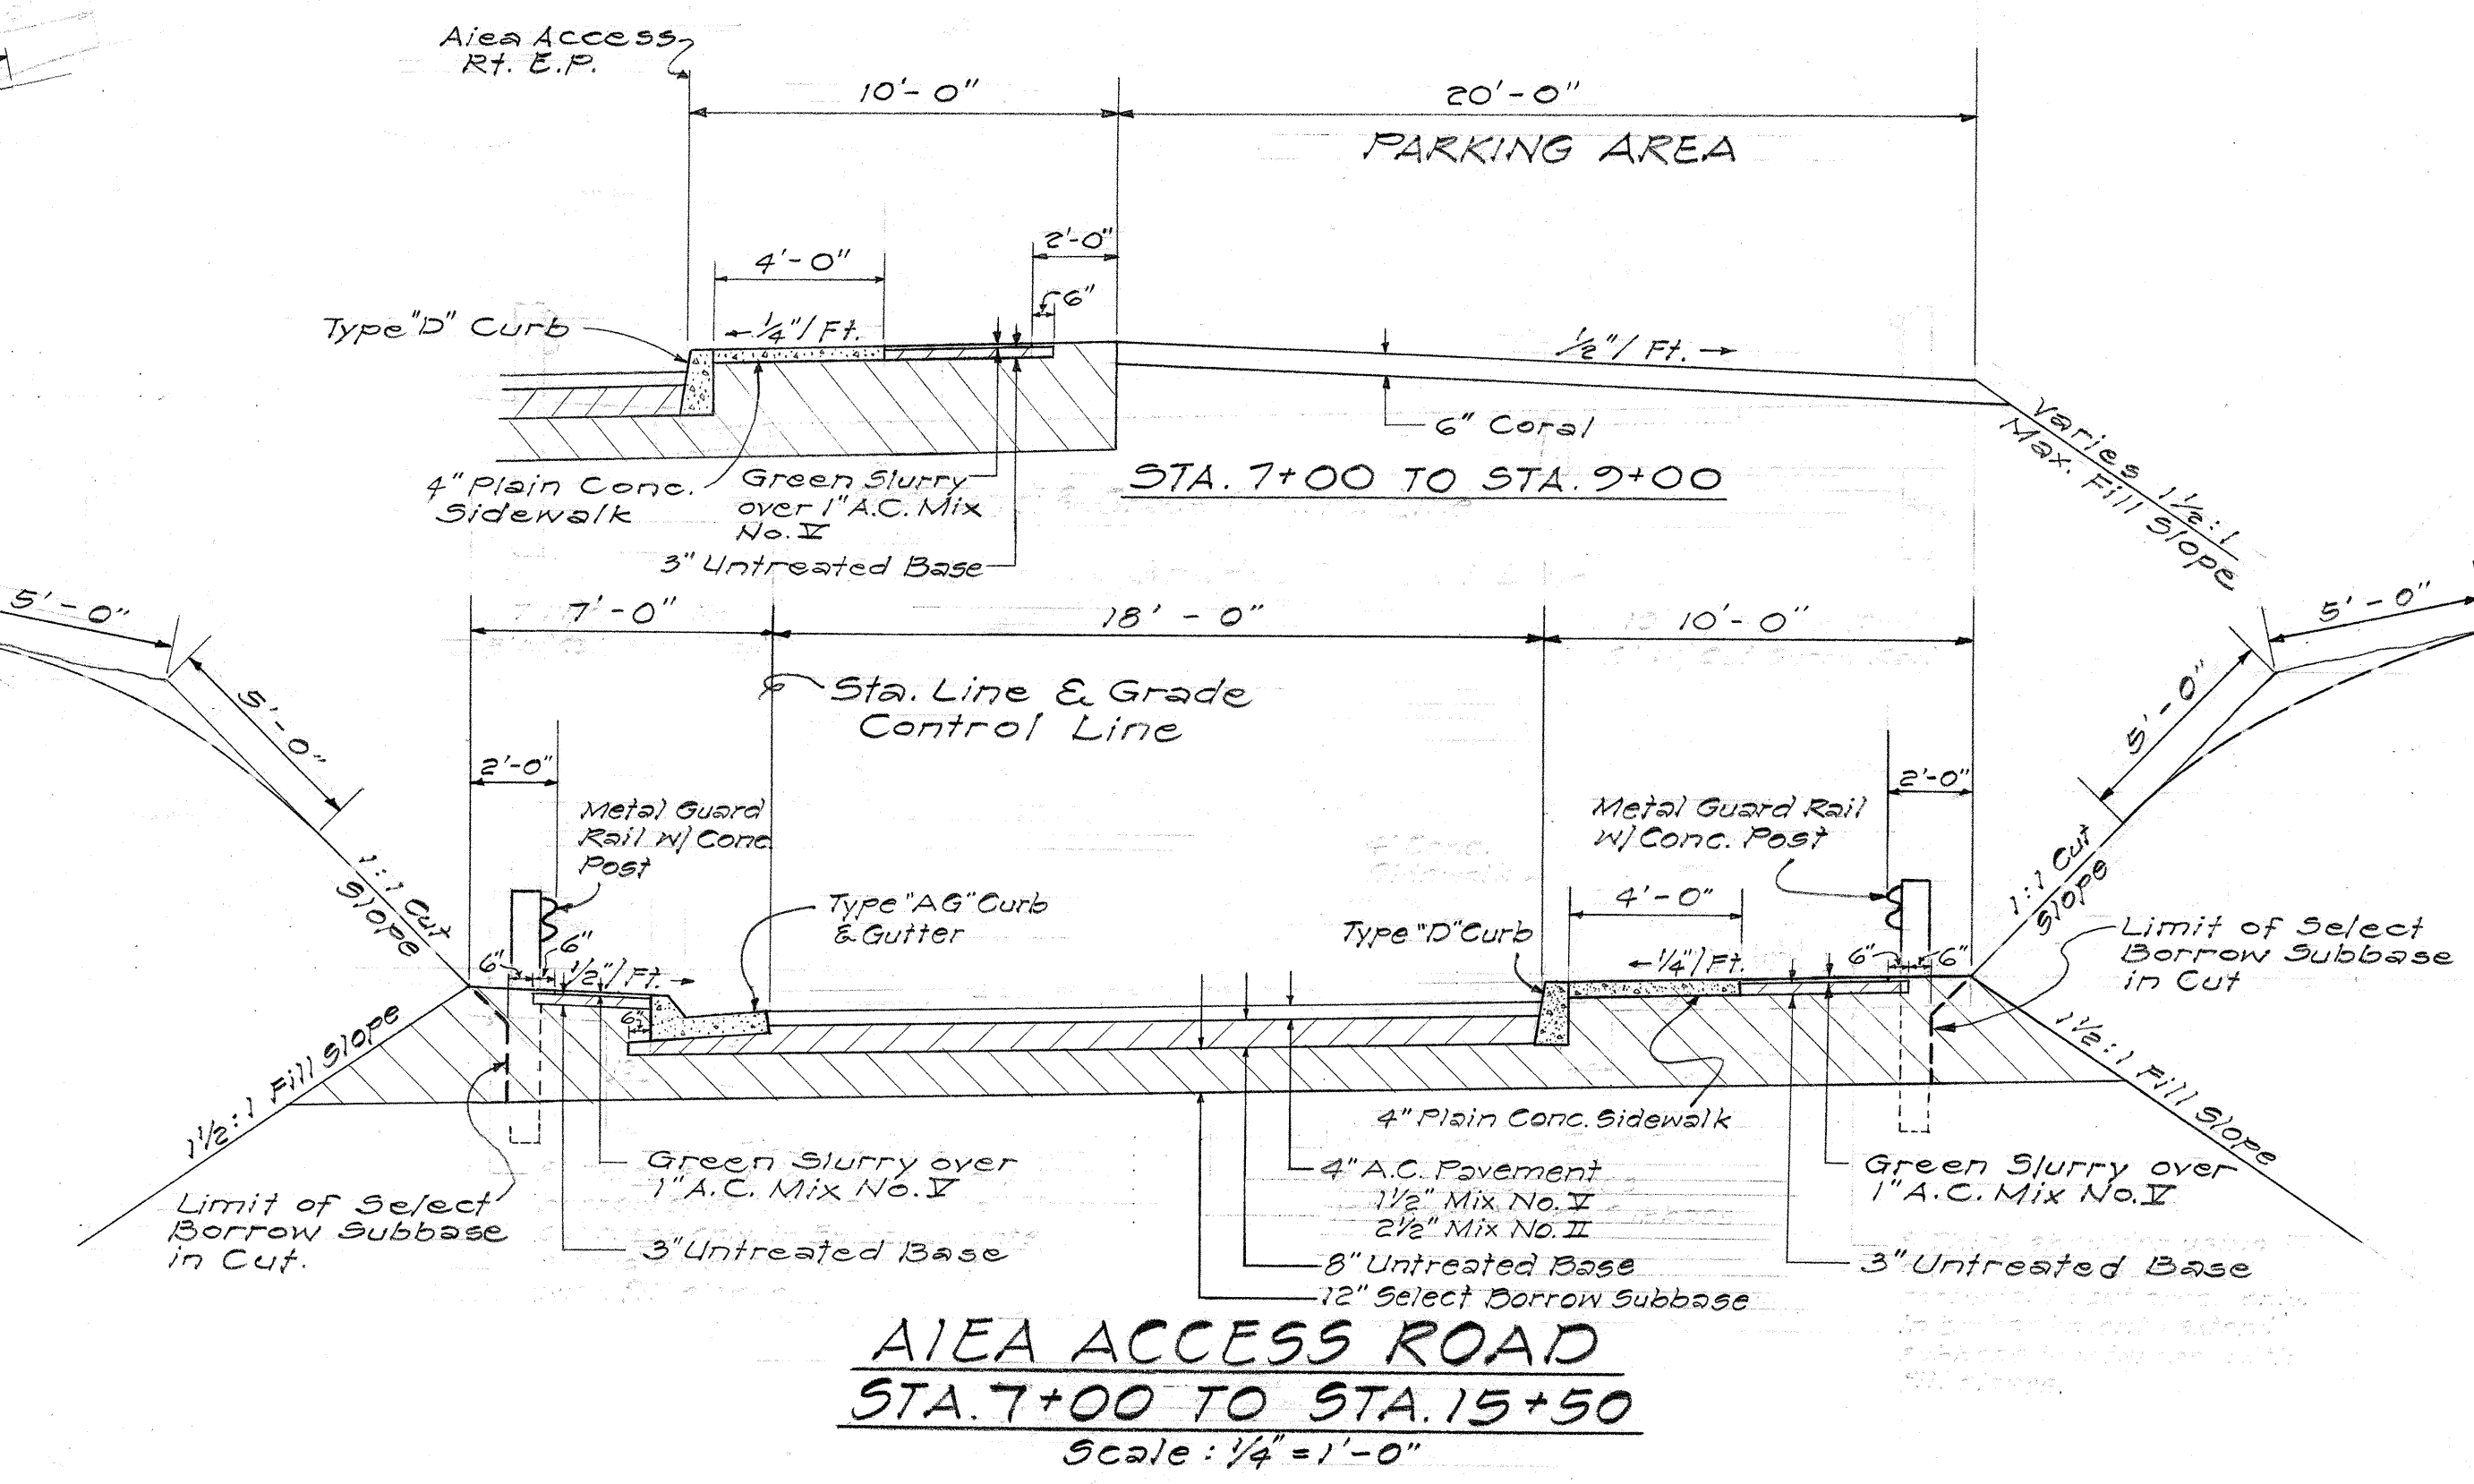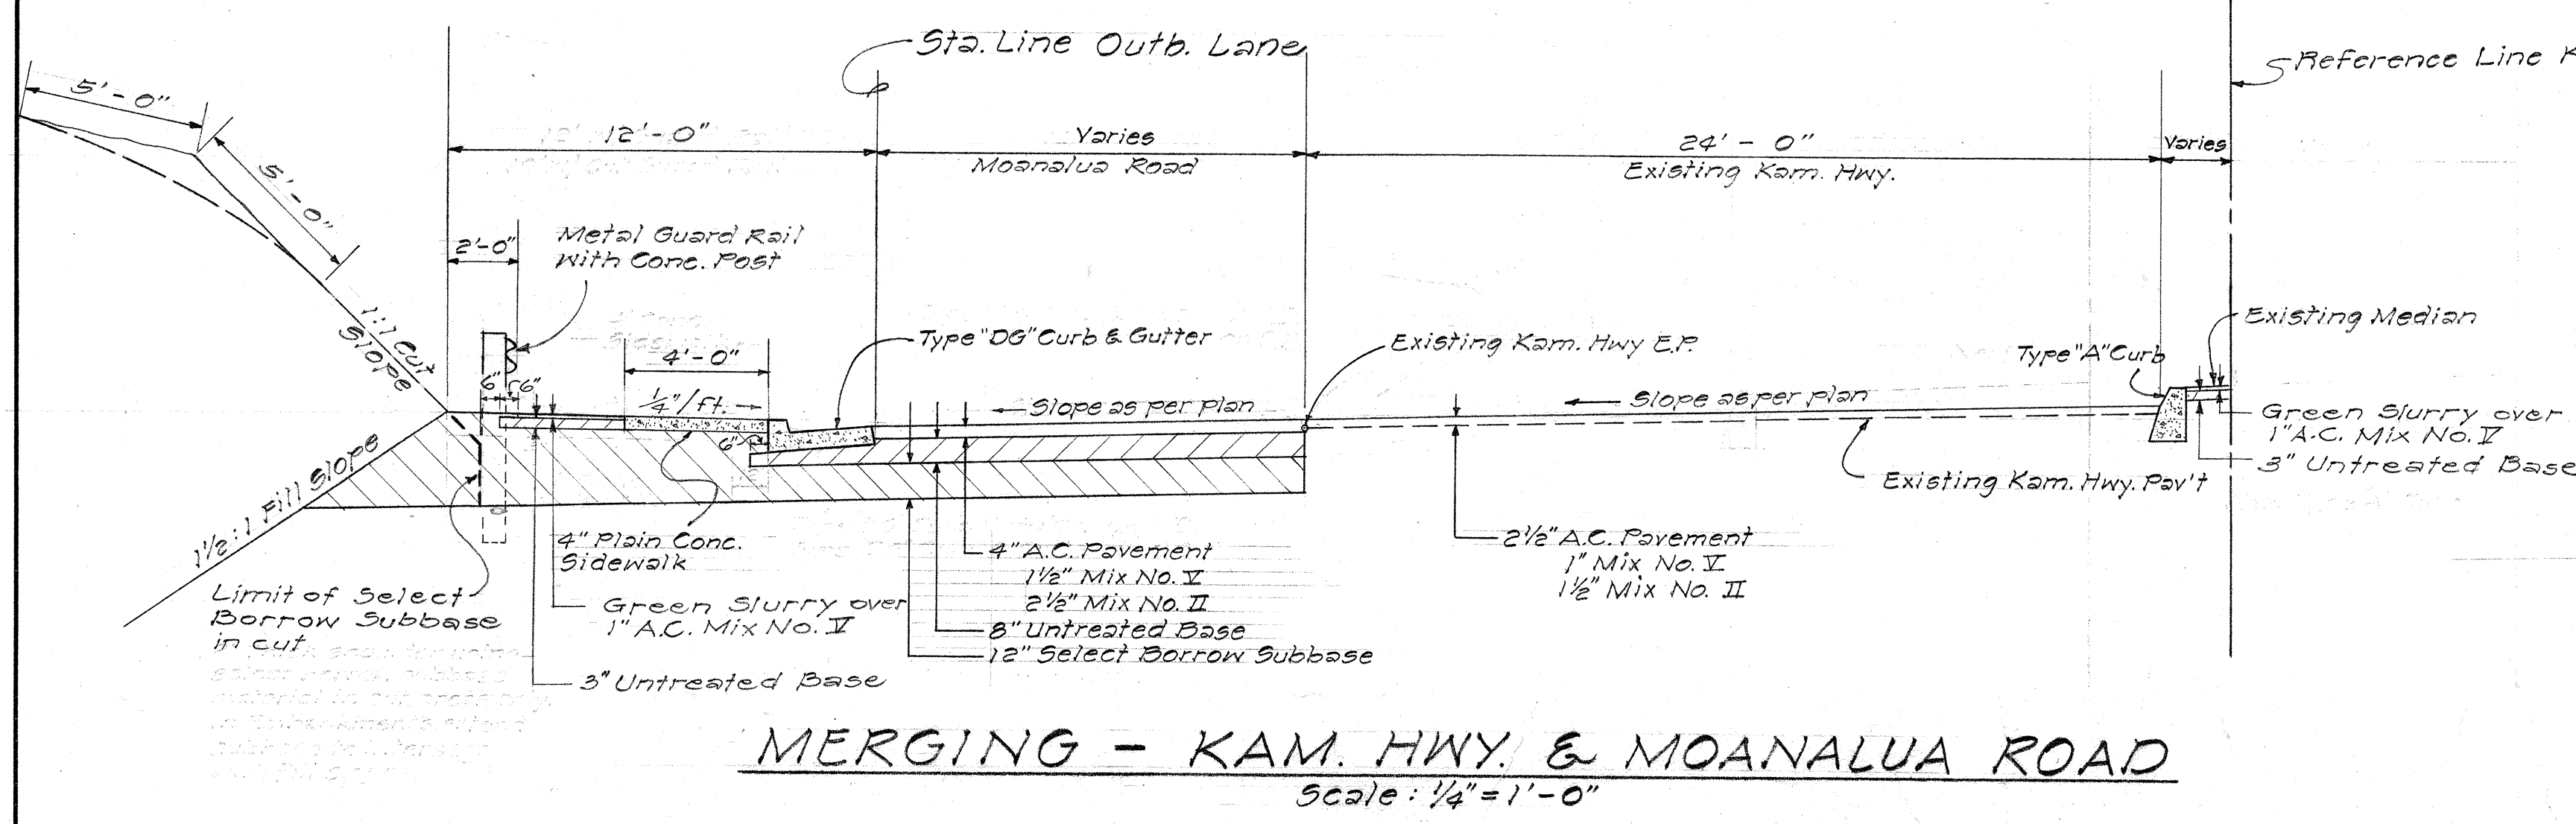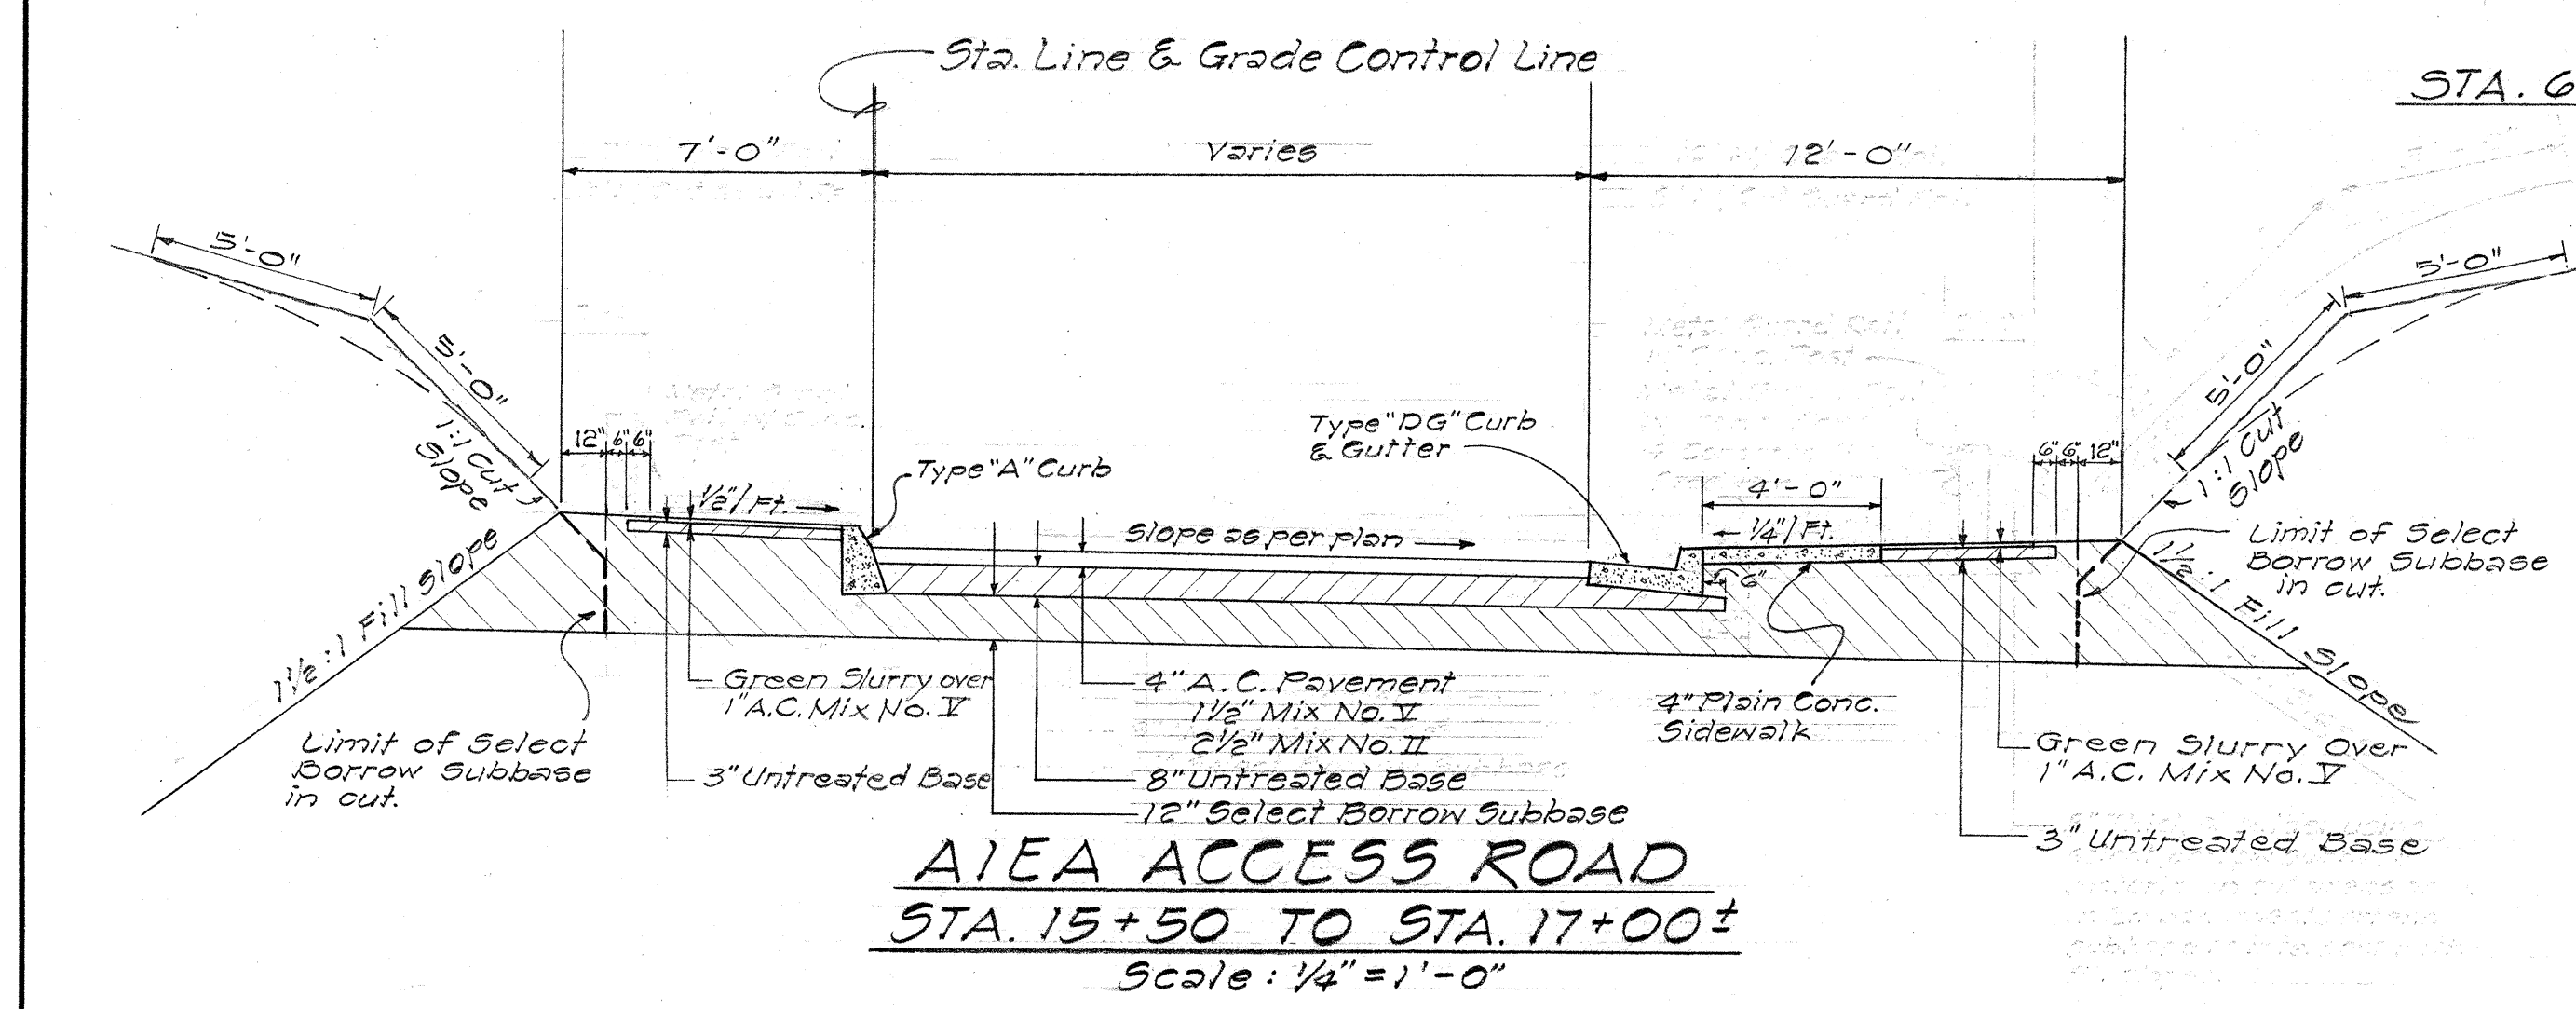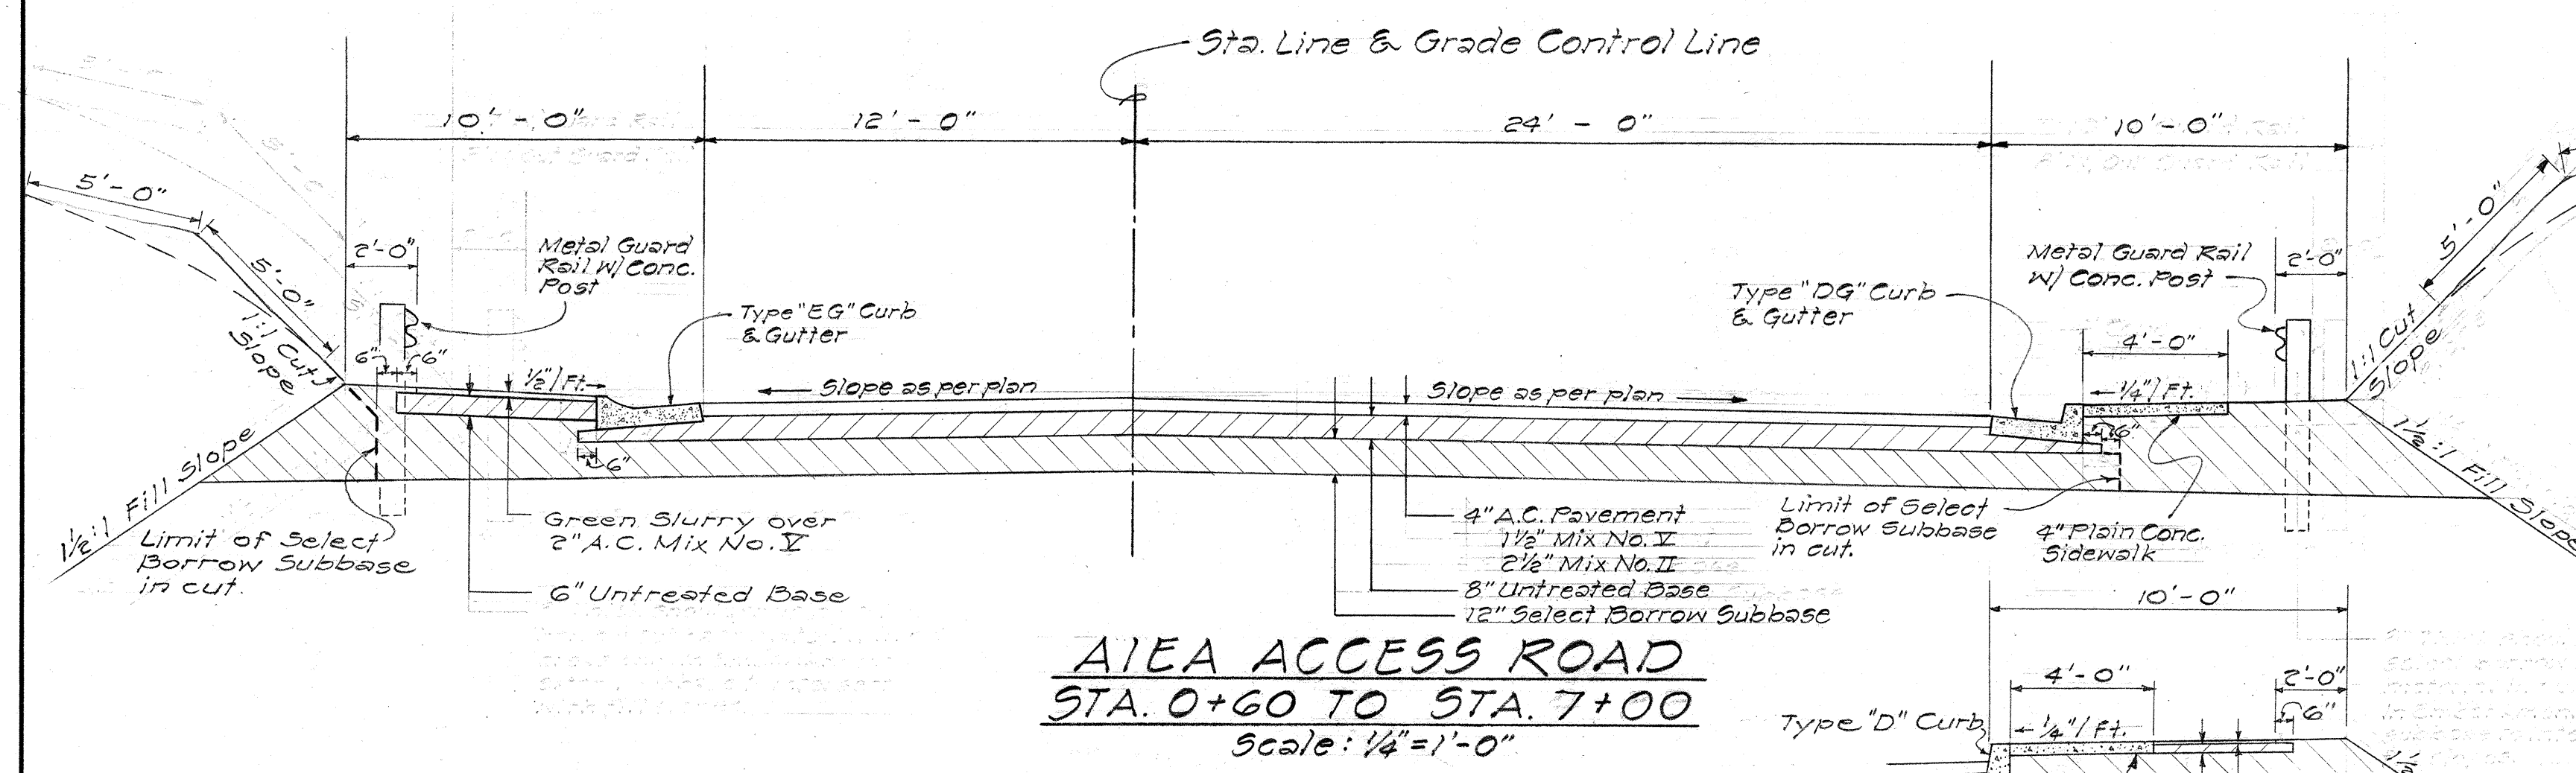


STATE OF HAWAII
DEPARTMENT OF TRANSPORTATION
HIGHWAYS DIVISION
TYPICAL SECTIONS
MOANALUA ROAD
PROJ. NO. 5U-0720(6)
KAMEHAMEHA HIGHWAY
PROJ. NO. F-090-1(4)
Scale: 1/4" = 1'-0" November 1963
SHEET No. 3 OF 4 SHEETS

DATE	_____
DESIGNED BY	_____
CHECKED BY	_____
NOTED BY	_____
ORIGINAL PLAN	_____
NO.	_____


FED. ROAD DIST. NO.	STATE	FED. AID PROJ. NO.	FISCAL YEAR	SHEET NO.	TOTAL SHEETS
HAWAII	HAW.	F-090-1(4)	1964	6	177
		50-0720(6)	1964		

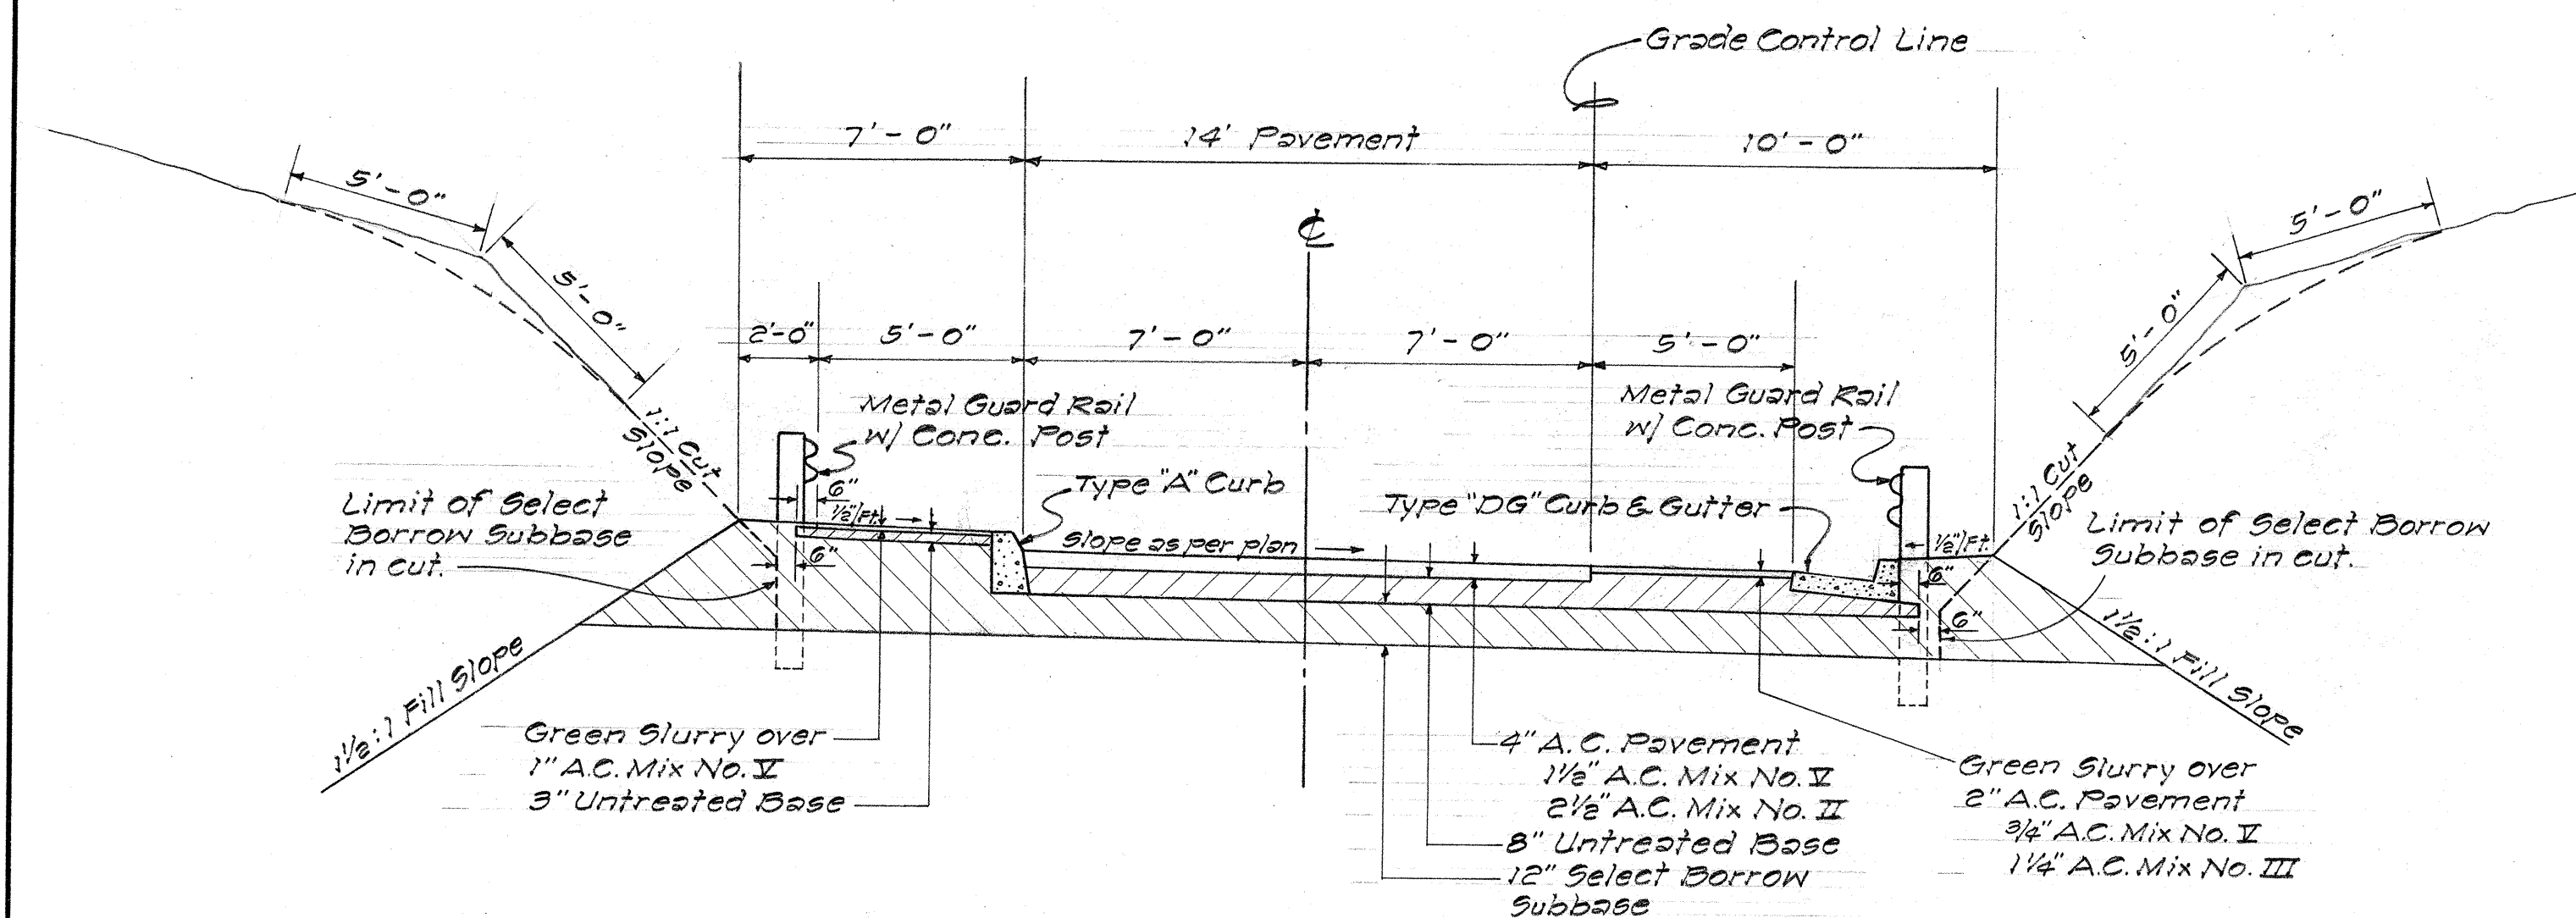


S.E. RAMP STA. 2+87± TO 17+15.30

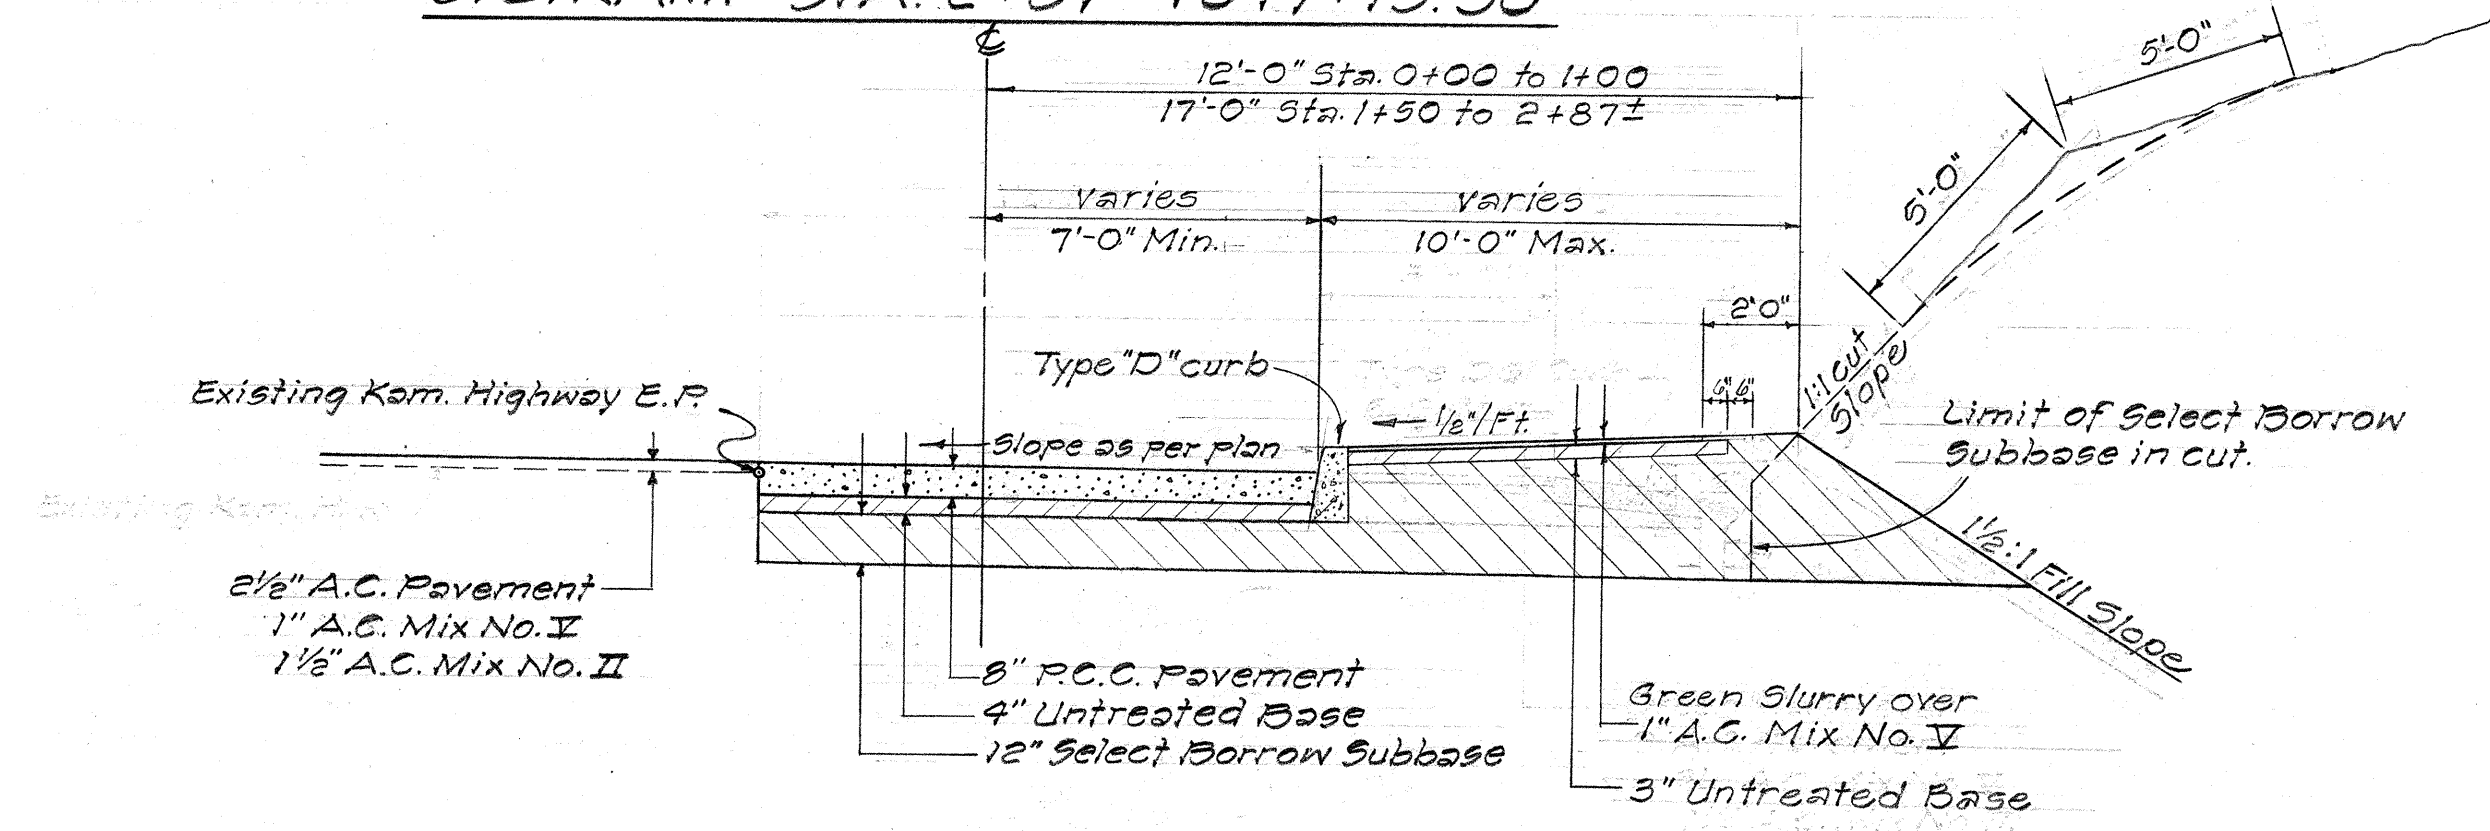


P.C.C. PAVEMENT
S.E. RAMP STA. 0+00 TO 2+87±
SOUTHEAST RAMP
Scale: 1/4" = 1'-0"

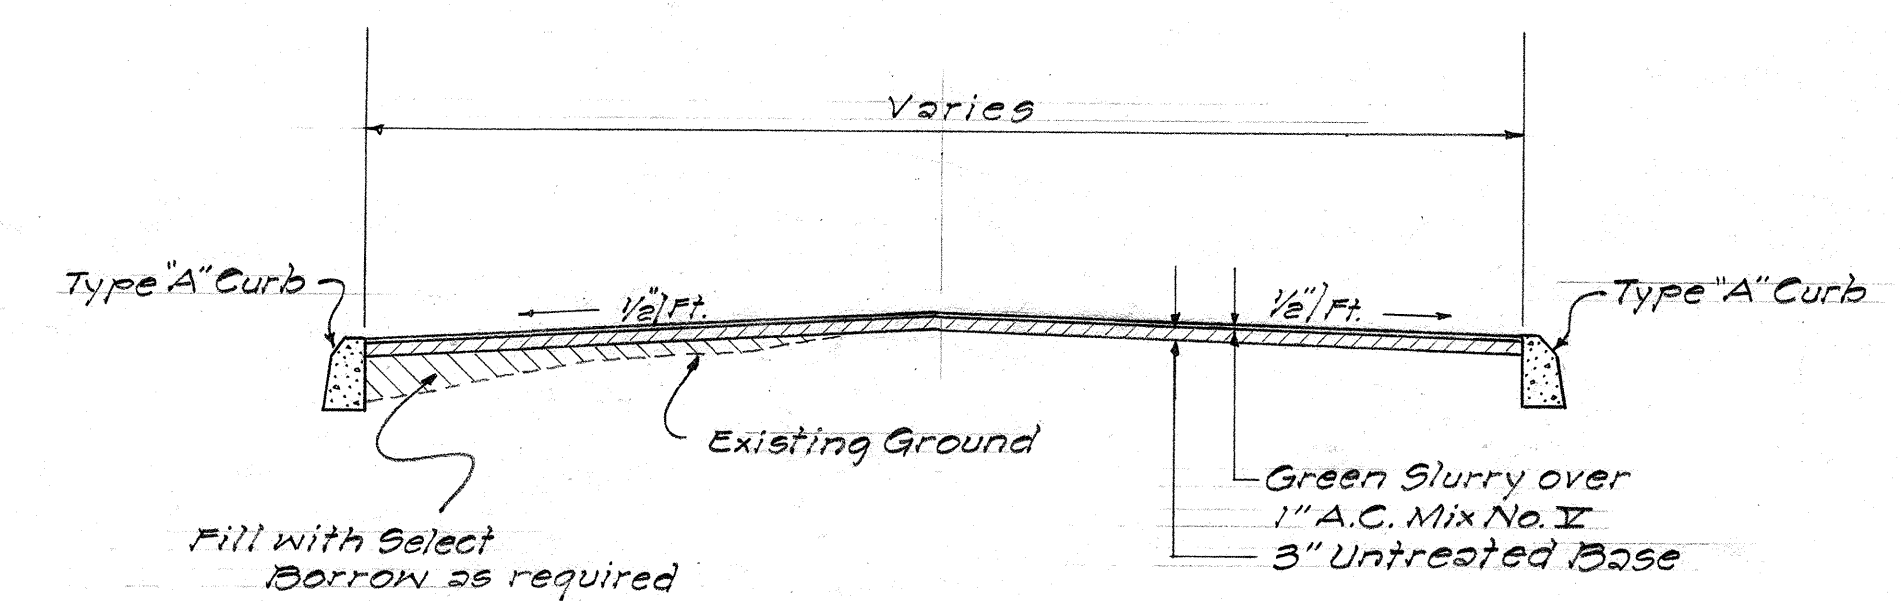

EXISTING KAM. HWY AT MEDIAN
Scale: 1/4" = 1'-0"

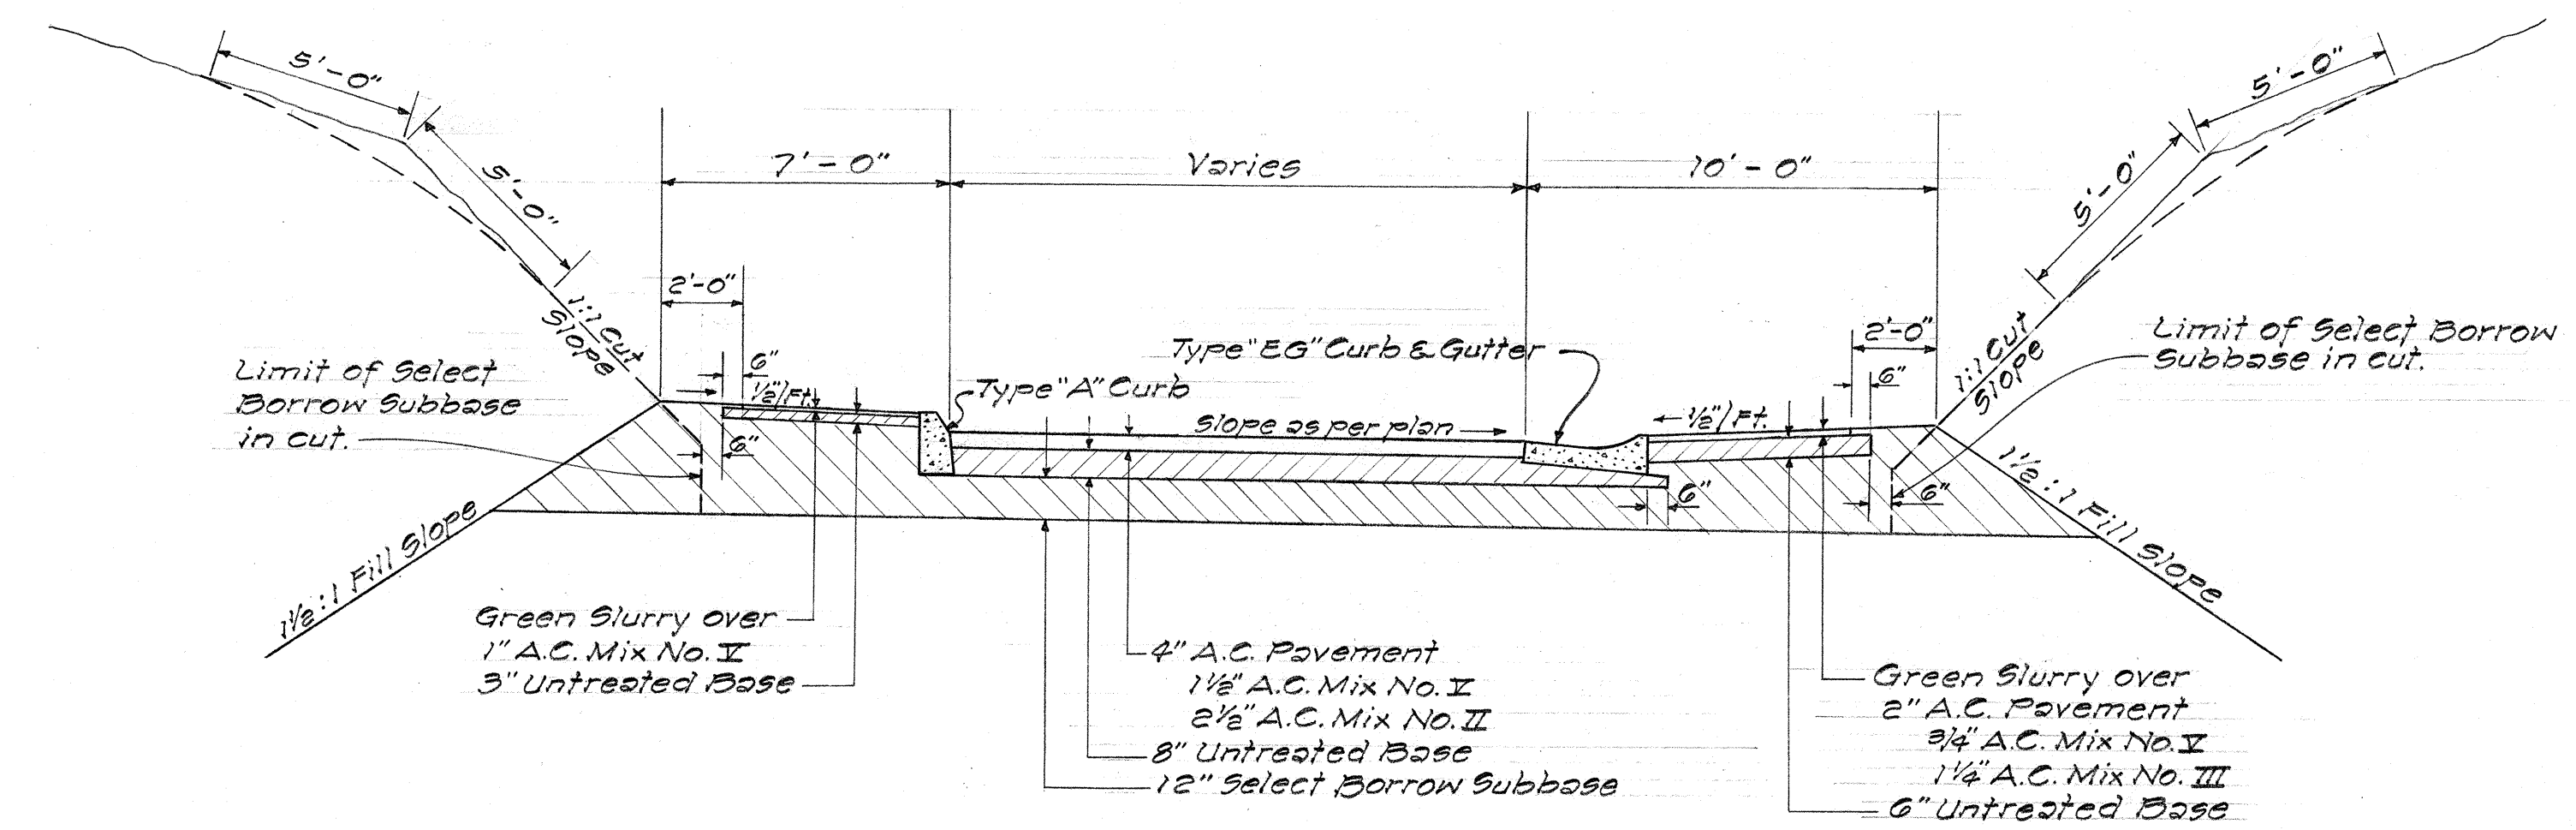

OUTBOUND AREA ACCESS
Scale: 1/4" = 1'-0"

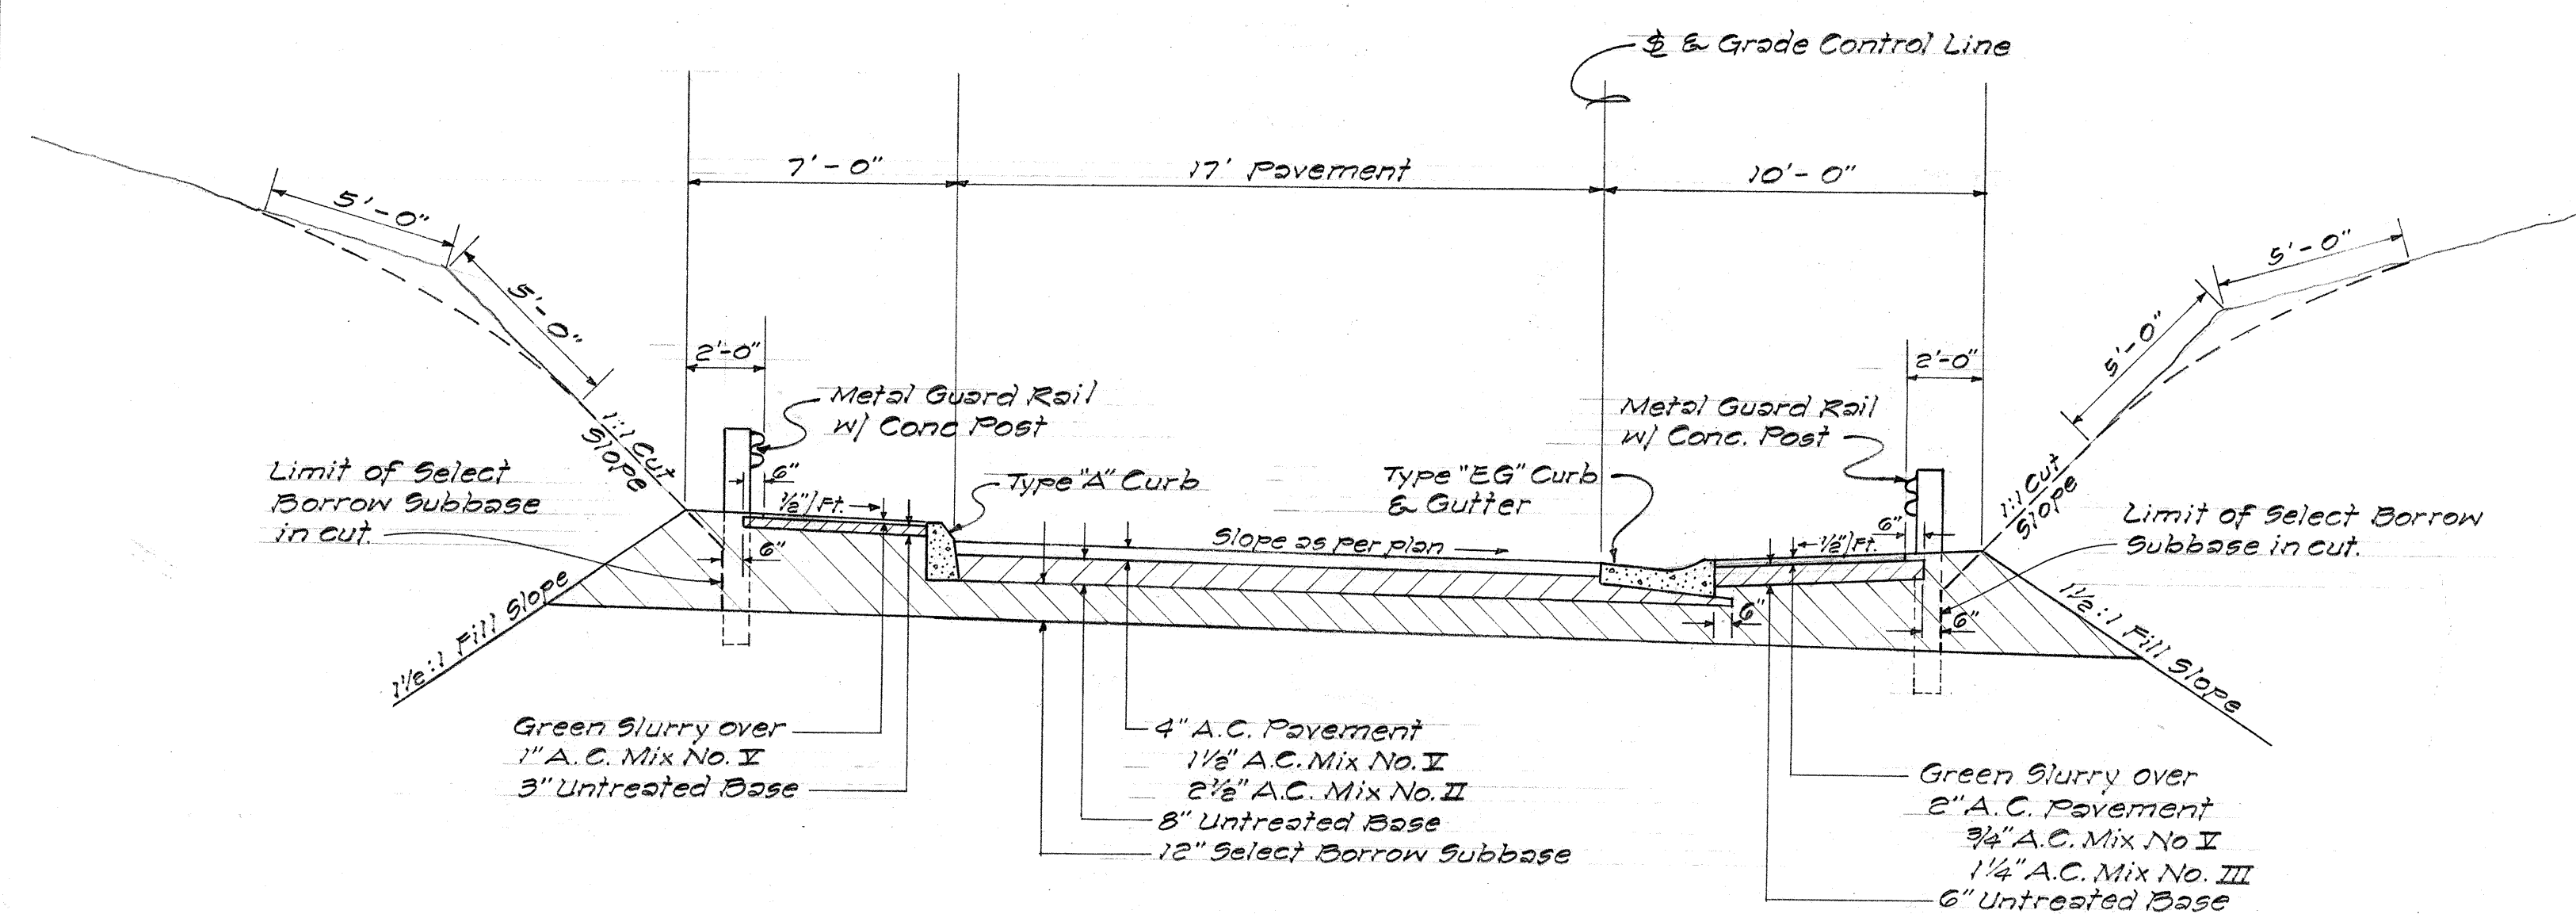

LOOP
Scale: 1/4" = 1'-0"

DATE	DESIGNED BY	CHECKED BY
11/1/63	W. H. HARRIS	W. H. HARRIS
11/1/63	TRACED BY	CHECKED BY
11/1/63	W. H. HARRIS	W. H. HARRIS
11/1/63	NOTE BOOK	CHECKED BY
11/1/63	W. H. HARRIS	W. H. HARRIS

STATE OF HAWAII
DEPARTMENT OF TRANSPORTATION
HIGHWAYS DIVISION

TYPICAL SECTIONS
MOANALUA ROAD
PROJ. NO. 50-0720(6)
KAMEHAMEHA HIGHWAY
PROJ. NO. F-090-1(4)

Scale: 1/4" = 1'-0" November 1963

SHEET No. 4 OF 4 SHEETS