


The diagram illustrates a road cross-section with the following components and dimensions:

- RM-3 Reflector Marker with Post:** Located on the shoulder, with a height dimension of 16.
- End Post:** Located at the edge of the pavement, with a height dimension of 16.
- Shoulder or Sidewalk:** The area between the end post and the shoulder line, with a width dimension of 16.
- Edge of Pavement:** The boundary between the pavement and the shoulder.
- Shoulder Line:** The boundary between the shoulder and the travel lane.
- Metal Guard Rail:** Located on the shoulder, with a height dimension of 16.
- Type "DG" Curb and Gutter:** Located on the shoulder, with a height dimension of 16.
- End of Structure:** The boundary between the structure and the shoulder, with a width dimension of 16.


Scale: $\frac{3}{16}'' = 1'-0''$

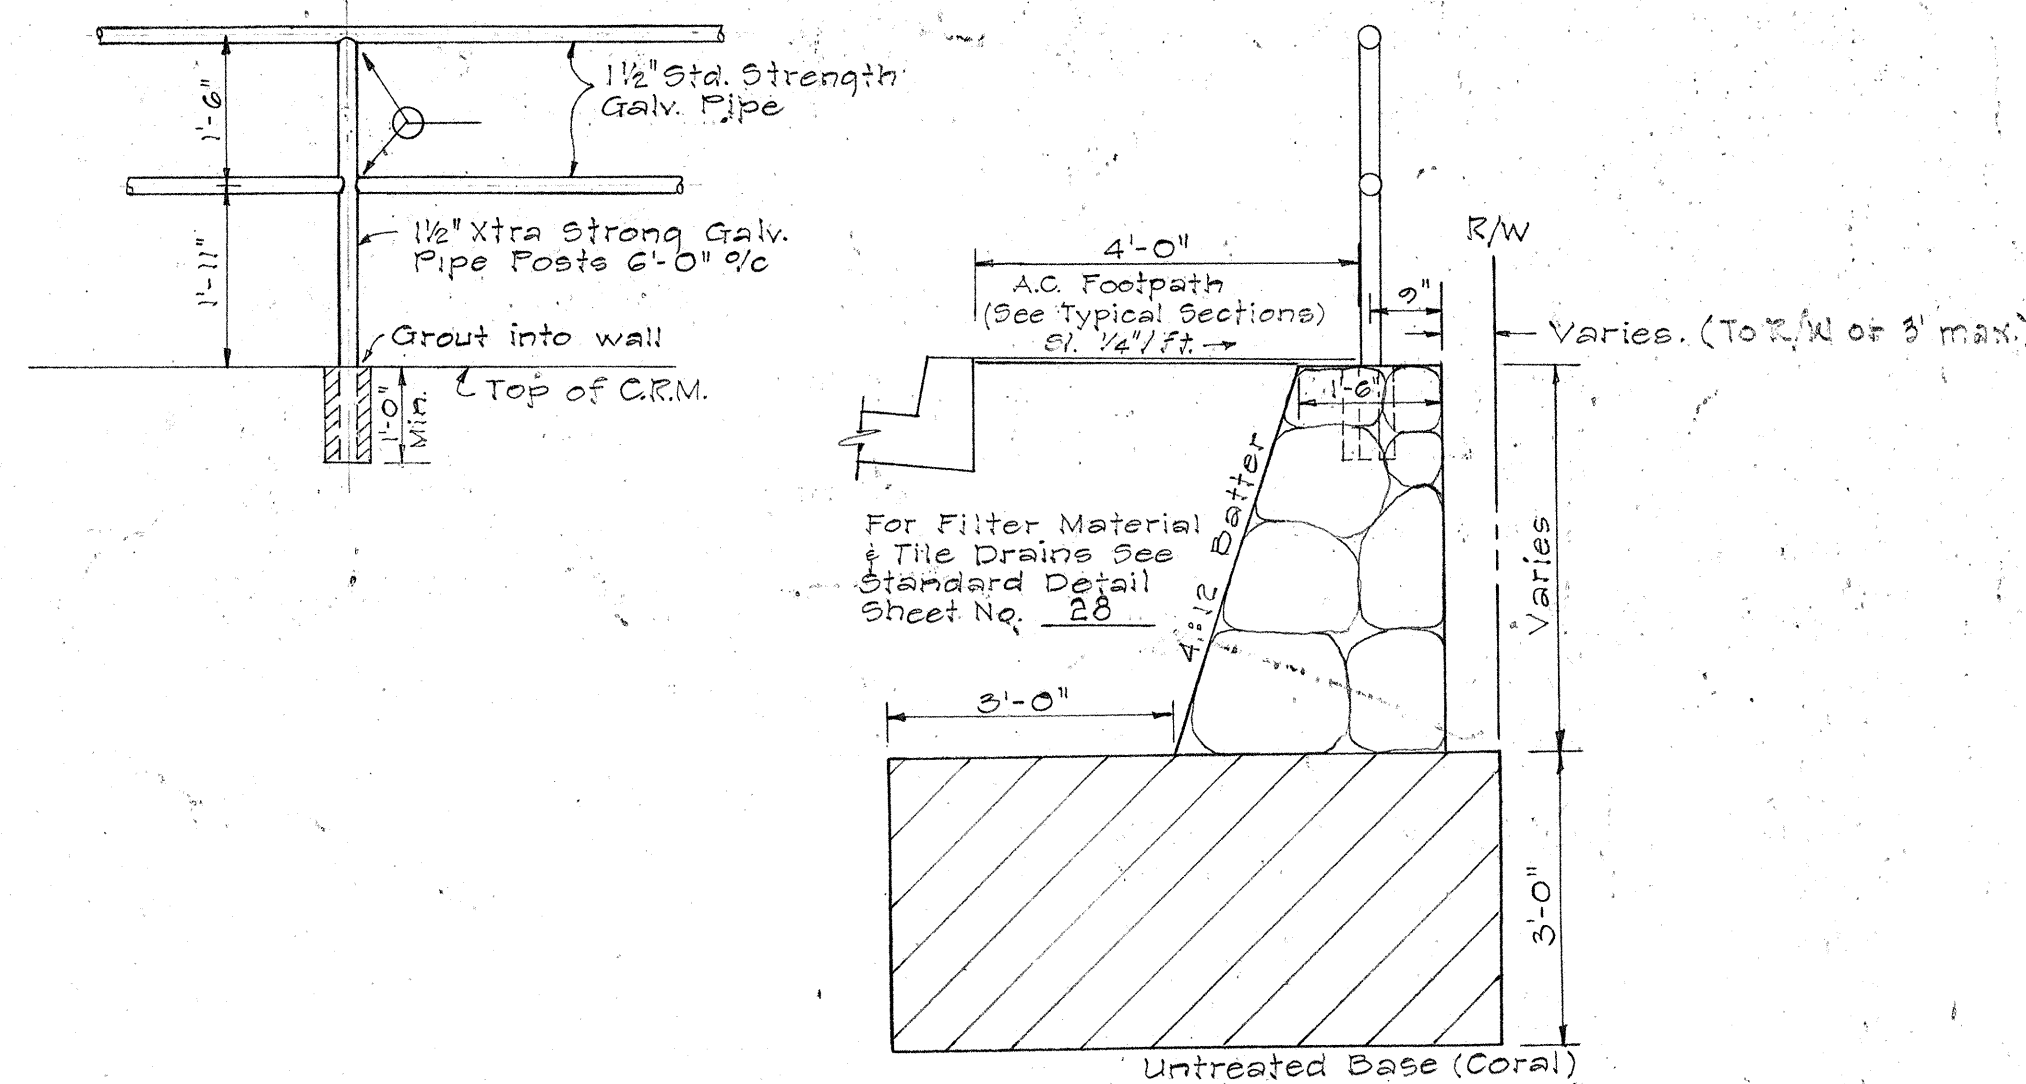


TYPICAL DETAIL: SECTION GALVANIZED PIPE RAILING
AND C.R.M. Wall ~ Sta. 324+15 ± to 324+80 ±
Scale: 1/2" = 1'-0"




TOP VIEW OF COVER
Not to Scale

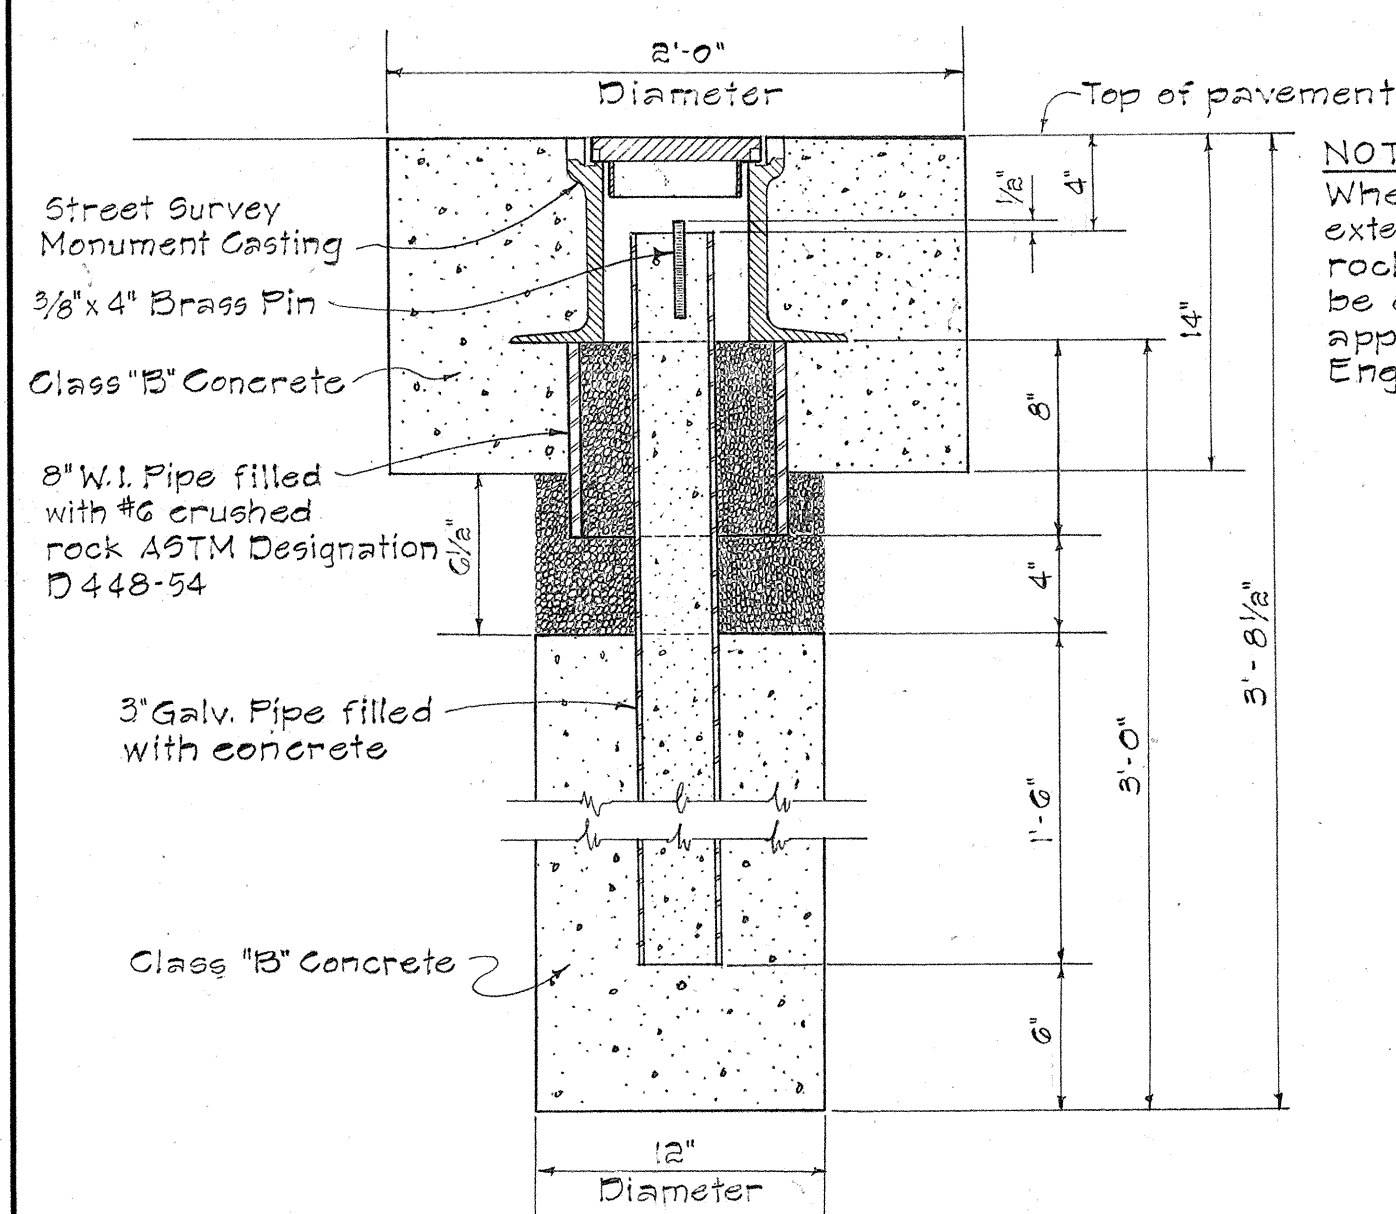


STREET SURVEY MONUMENT
Scale: $1\frac{1}{2}" = 1'-0"$

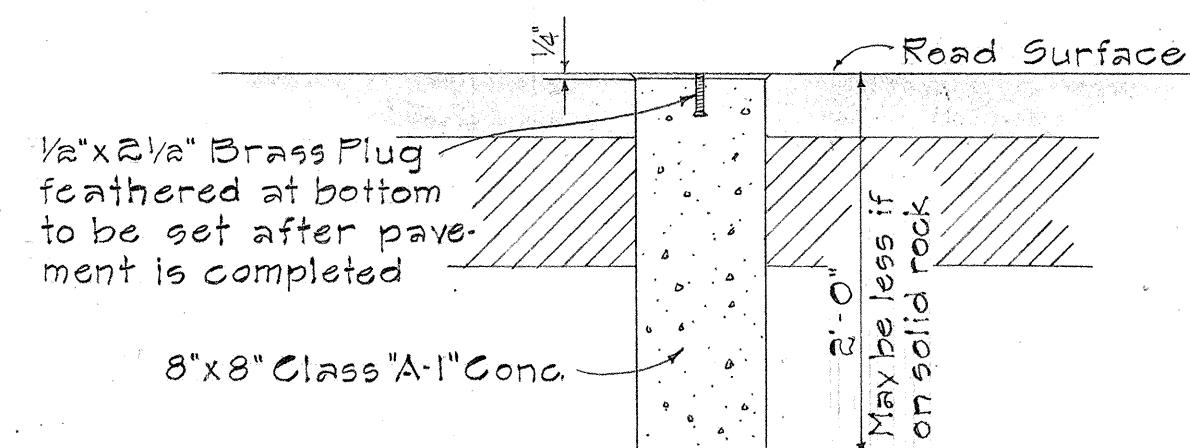

CENTERLINE MONUMENT
Scale: 1" = 1'-0"

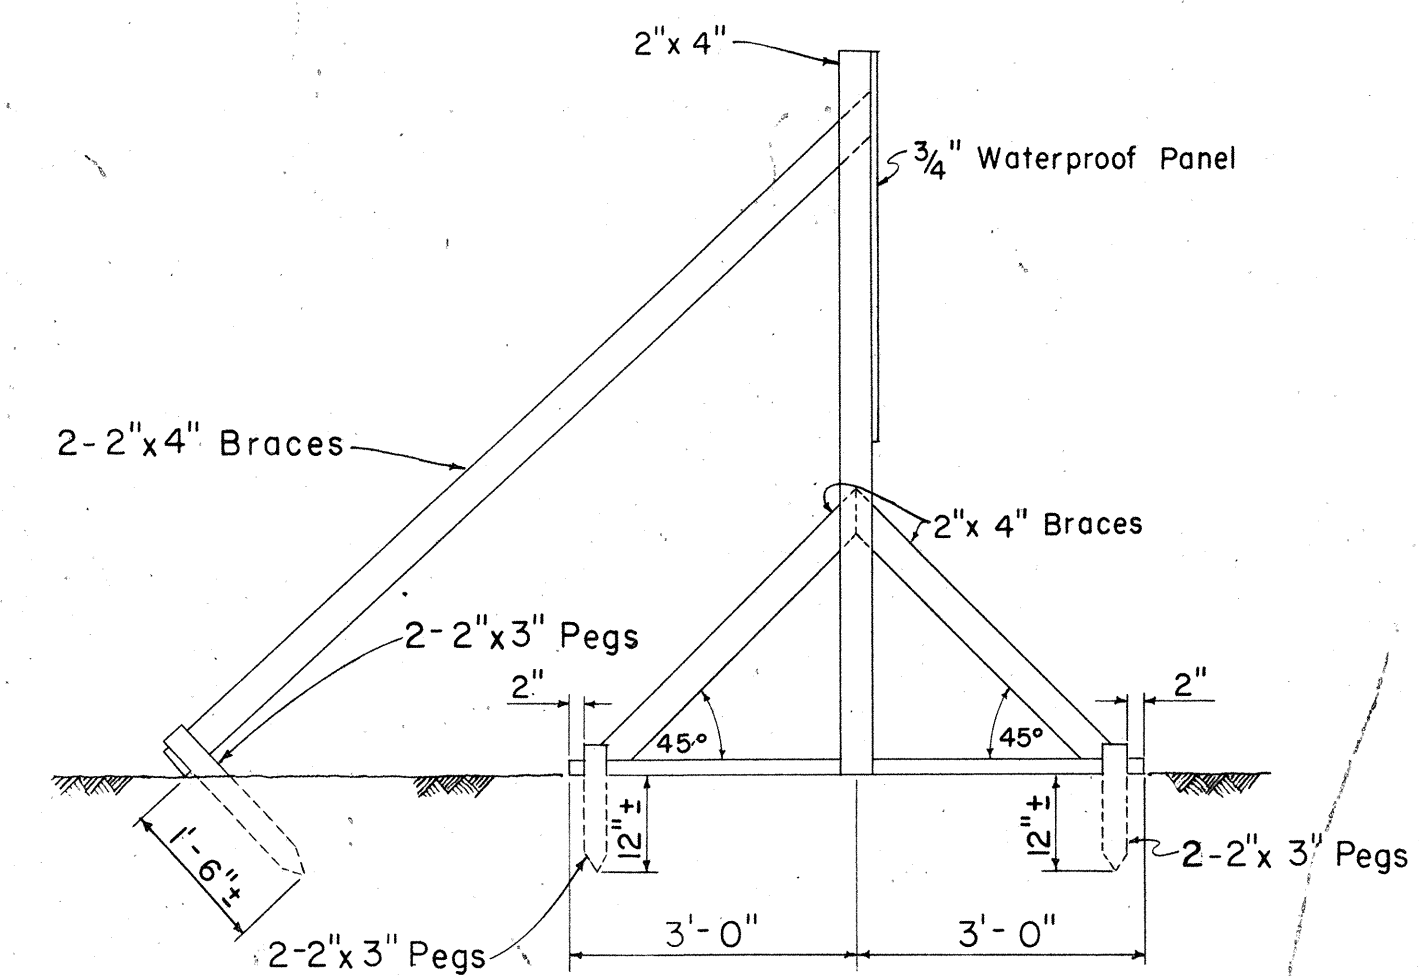


SIDE VIEW

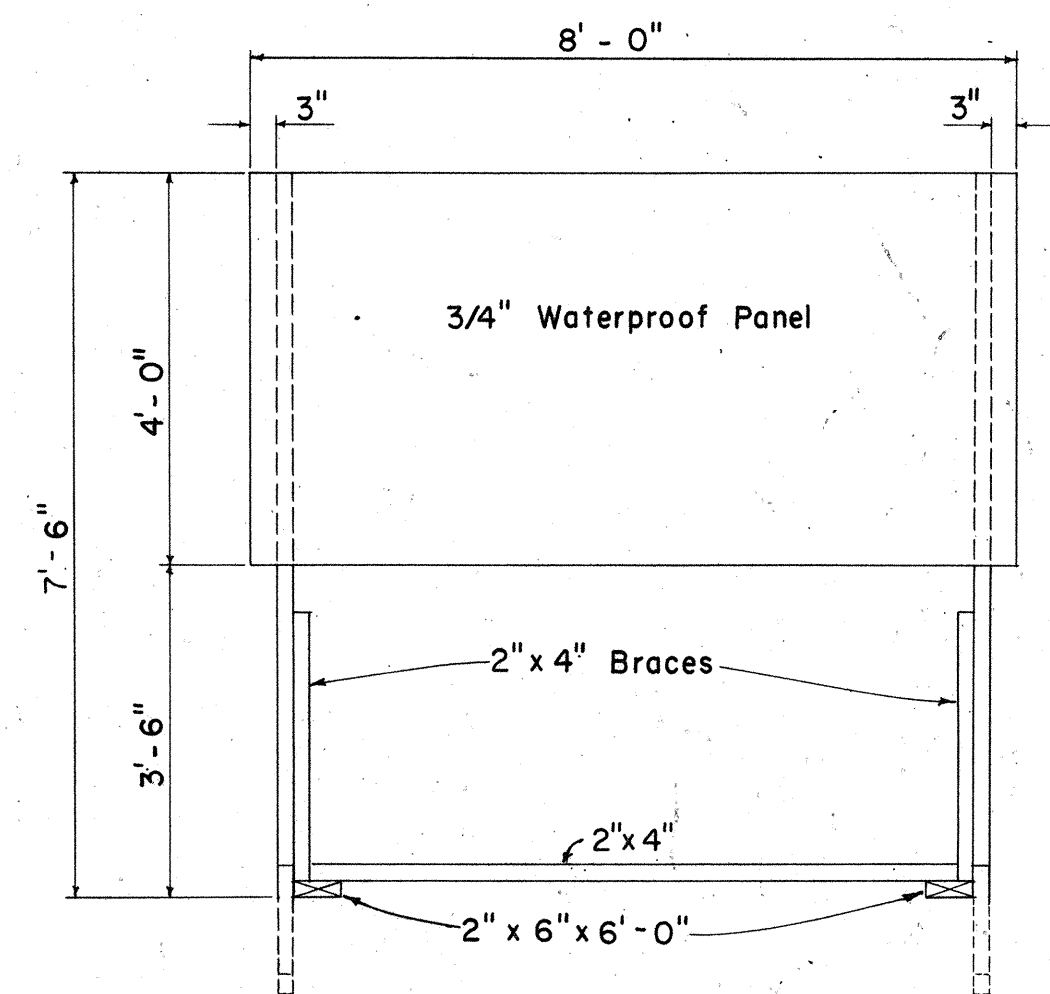

FRONT VIEW

ELEVATIONS

Scale: $\frac{1}{2}" = 1'-0"$

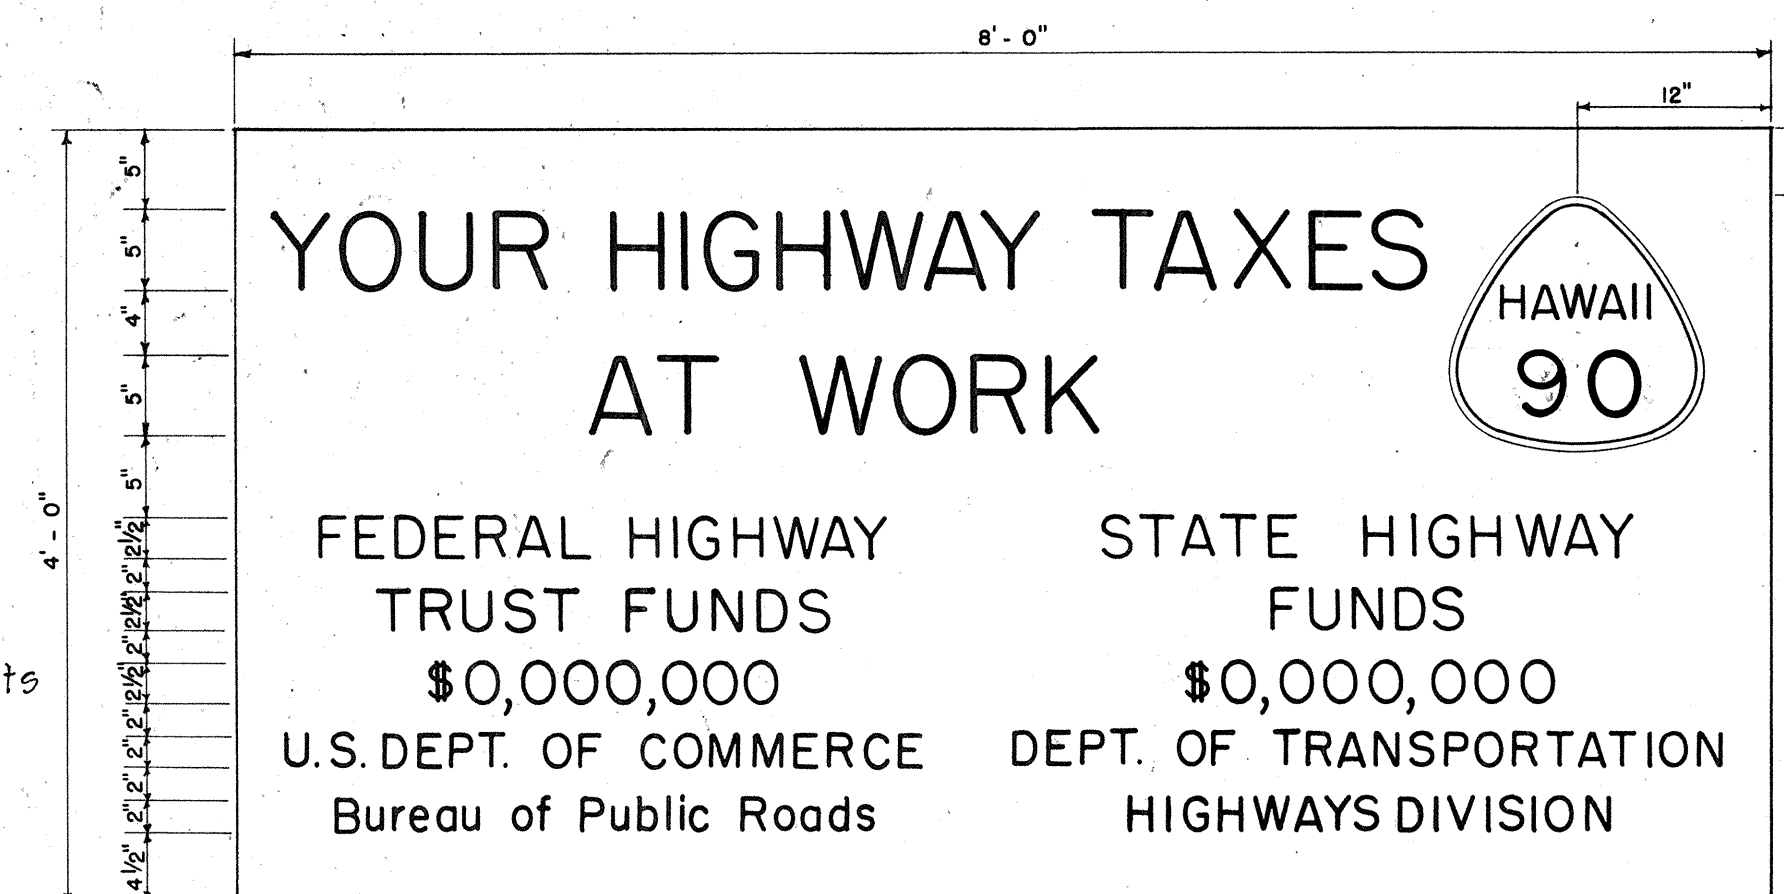

PROJECT SIGN PANEL
Scale: 1" = 1' - 0"

Scale: As Shown

- ## PROJECT SIGNS NOTES
1. The Contractor shall construct, install and maintain the Project Signs, at the locations shown on the plans and as ordered by the Engineer.
 2. All costs incurred in the construction, installation and maintenance of the Project Signs, will not be paid for separately, but shall be considered as included in the unit price paid for the various items in the proposal.
 3. The Project Signs shall be removed and stockpiled at the completion of the project as ordered by the Engineer and are to become State Property.
 4. The exact figures for the various funds involved will be furnished to the Contractor for the incorporation in the Project Signs.
 5. The legend shall be black on white background unless otherwise specified.
 6. Refer to Sheet No. 26 for details on the exact shape and size of the State route marker to be shown on these Project Signs.
 7. All letters shall be of size and design shown and shall conform with "Standard Alphabets for Highway Signs", Bureau of Public Roads, 1952. Use Series "C" letters unless otherwise noted.

MISCELLANEOUS DETAILS

JUNE 1965

SHEET No. 1 OF 1 SHEETS