



FED. ROAD DIST. No.	STATE	FED. AID PROJ. No.	FISCAL YEAR	SHEET No.	TOTAL SHEETS
HAWAII	HAW	F-000-100	1967	13	16

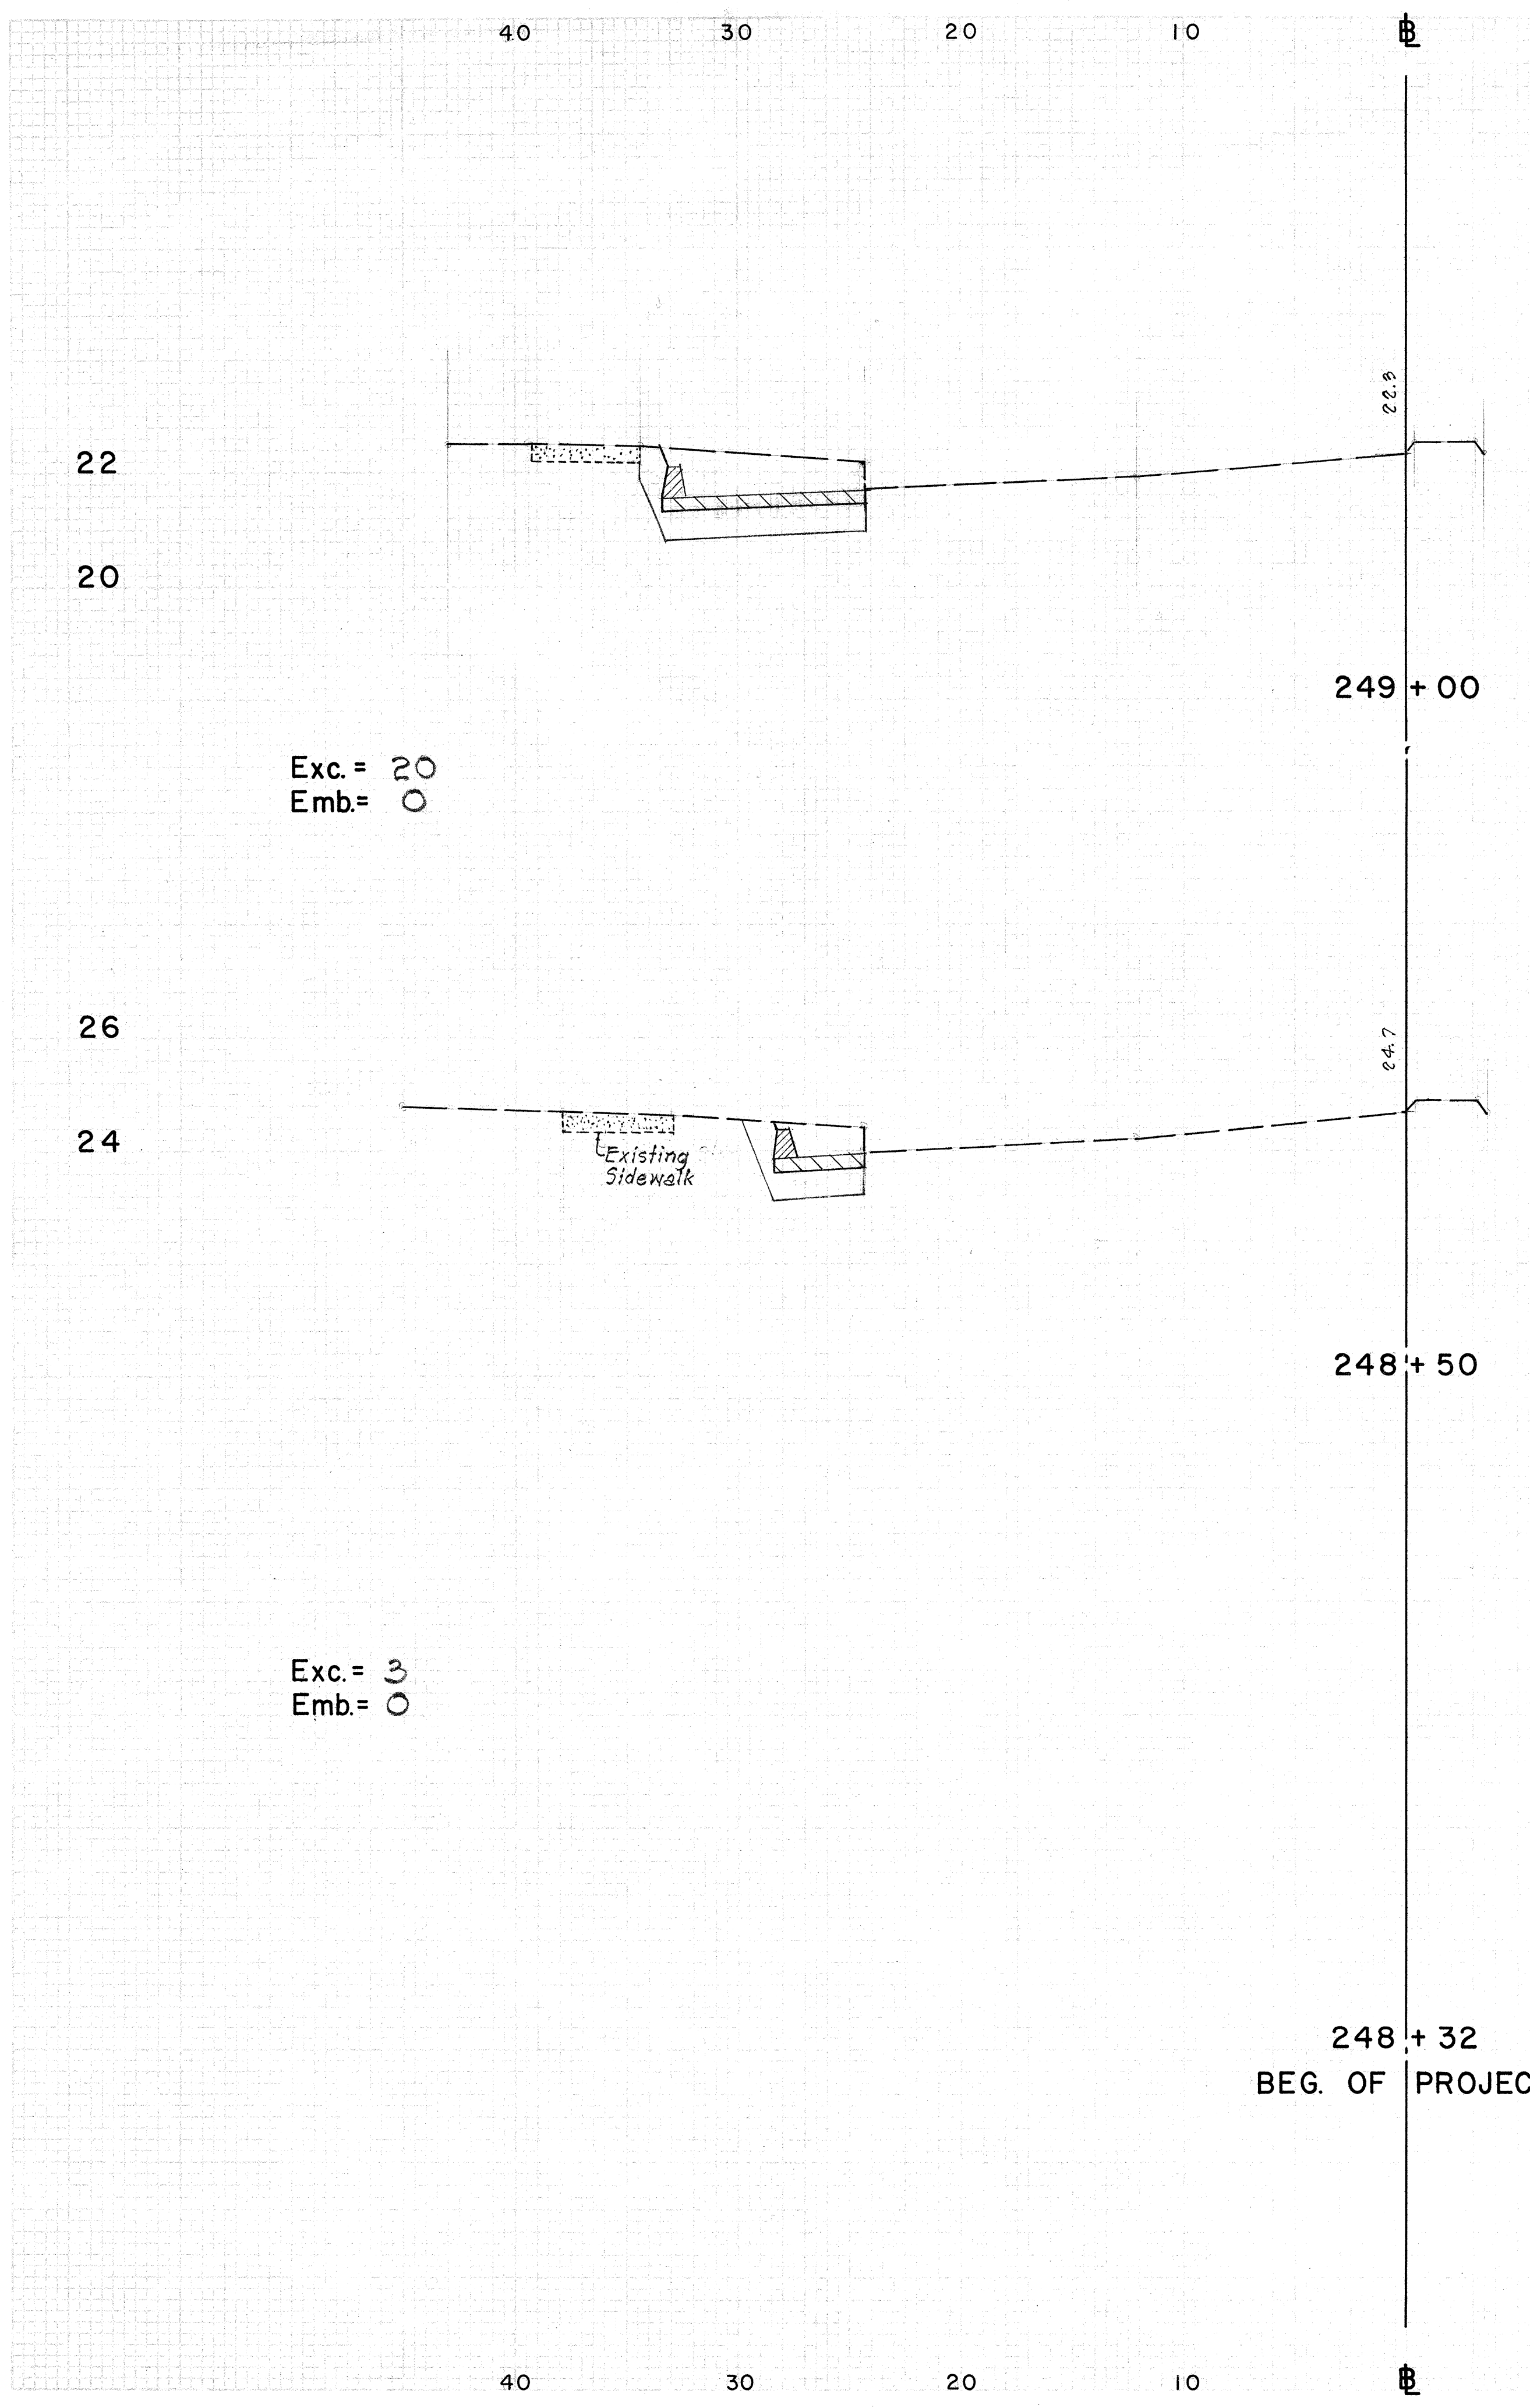

C = 14
C.U.B. = 6

C = 8
C.U.B. = 4

C = 0
F = 0

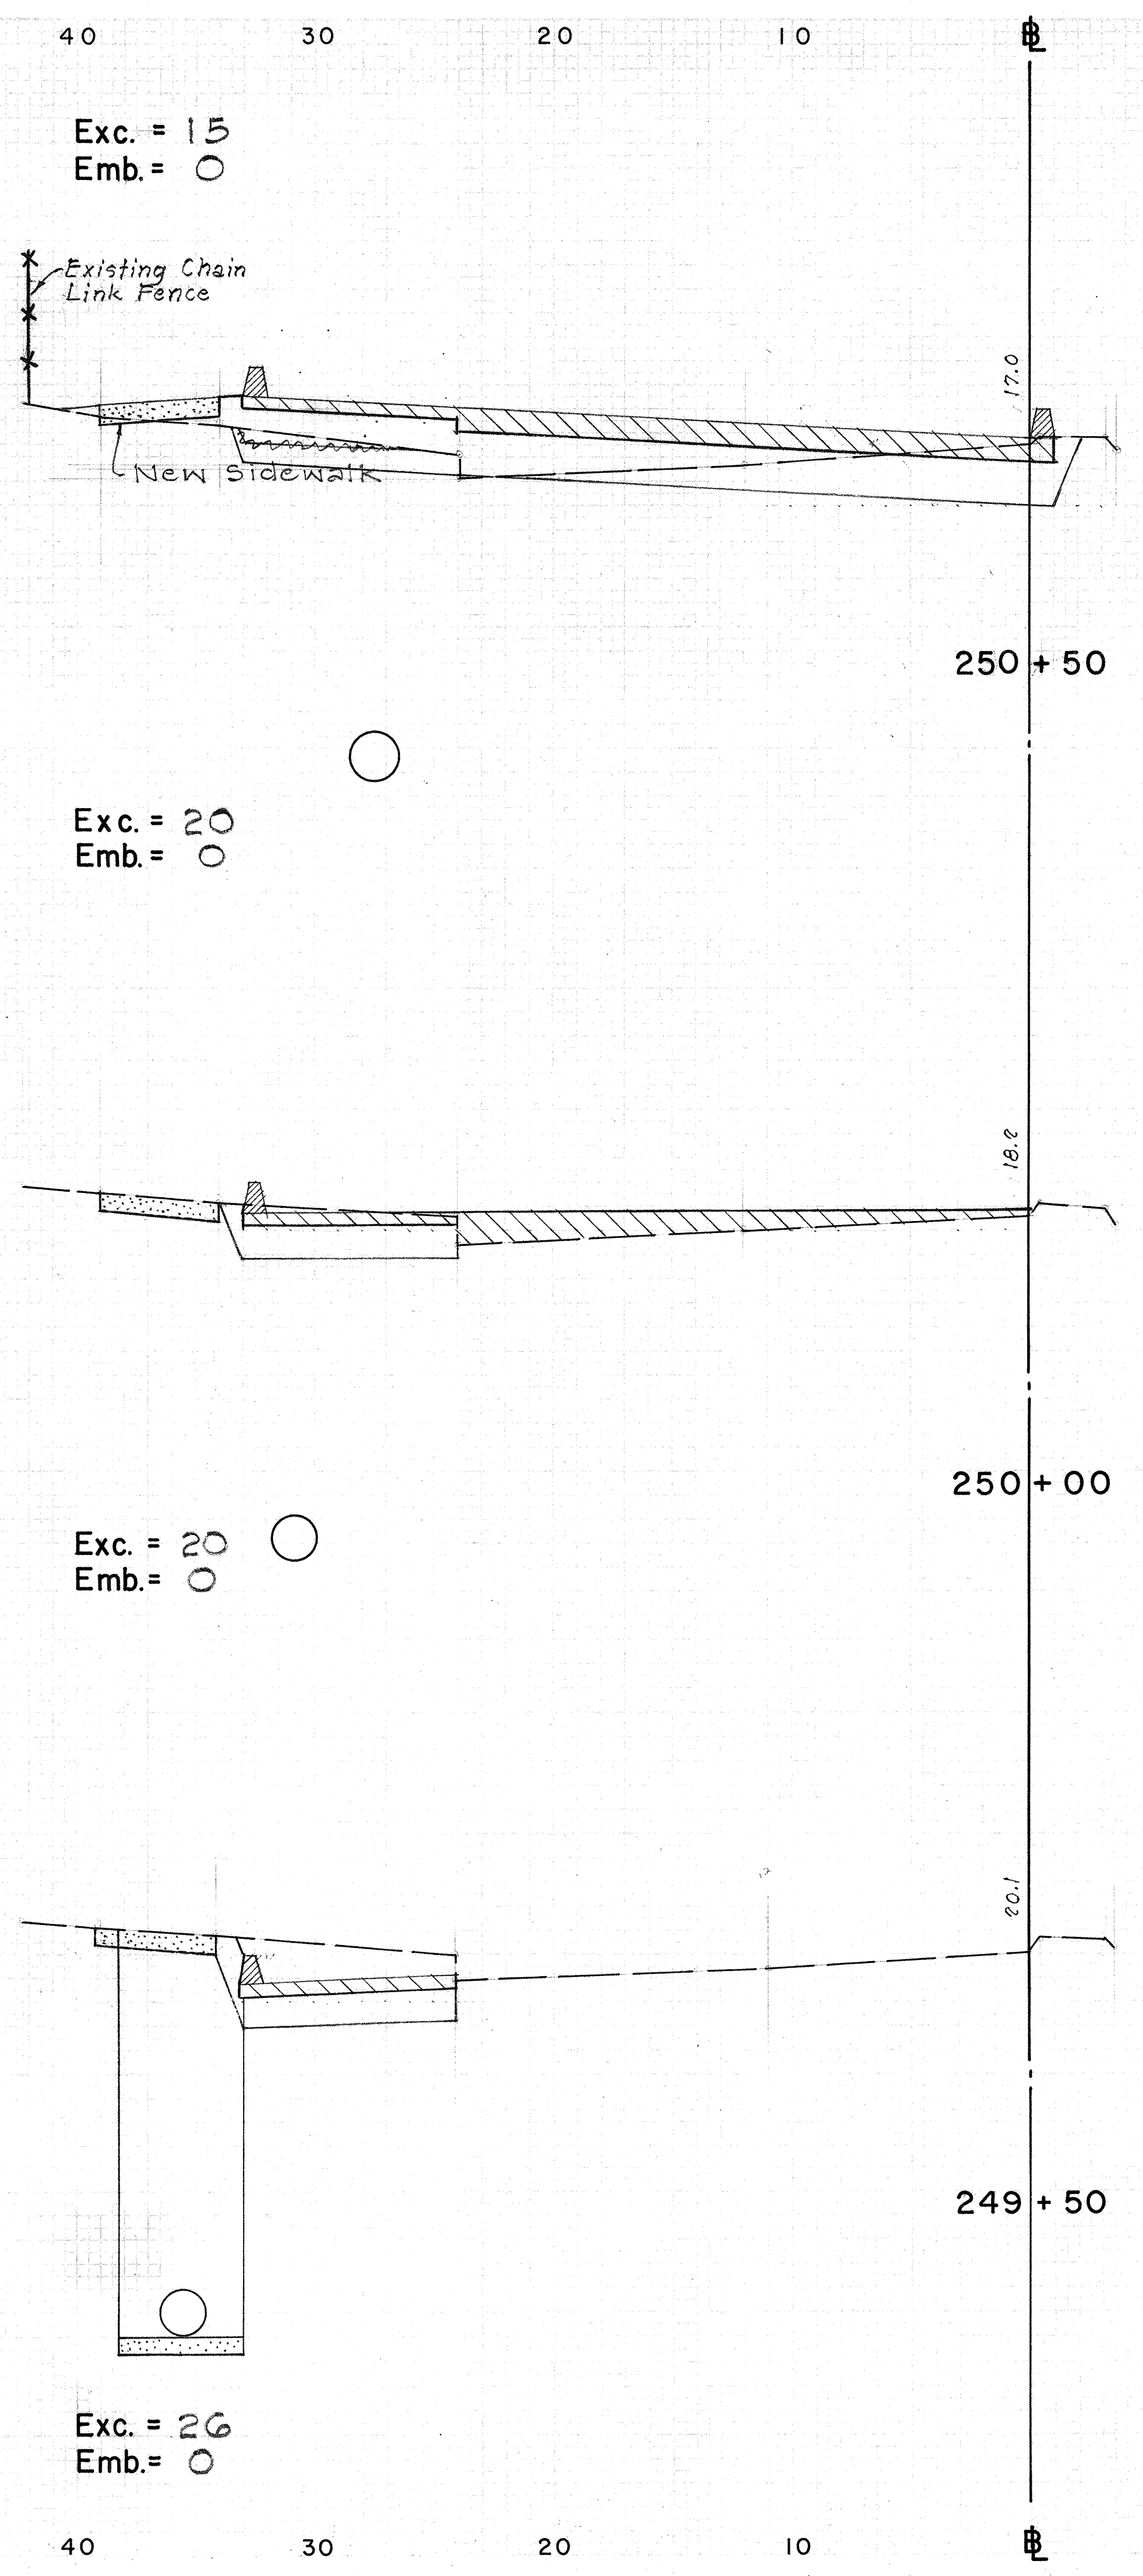


C = 14
C.U.B. = 26


C = 8
C.U.B. = 5

C = 14
C.U.B. = 6

FED. ROAD DIST. No.	STATE	FED. AID PROJ. No.	FISCAL YEAR	SHEET No.	TOTAL SHEETS
HAWAII	HAW	F-090-1(1)	1967	14	16

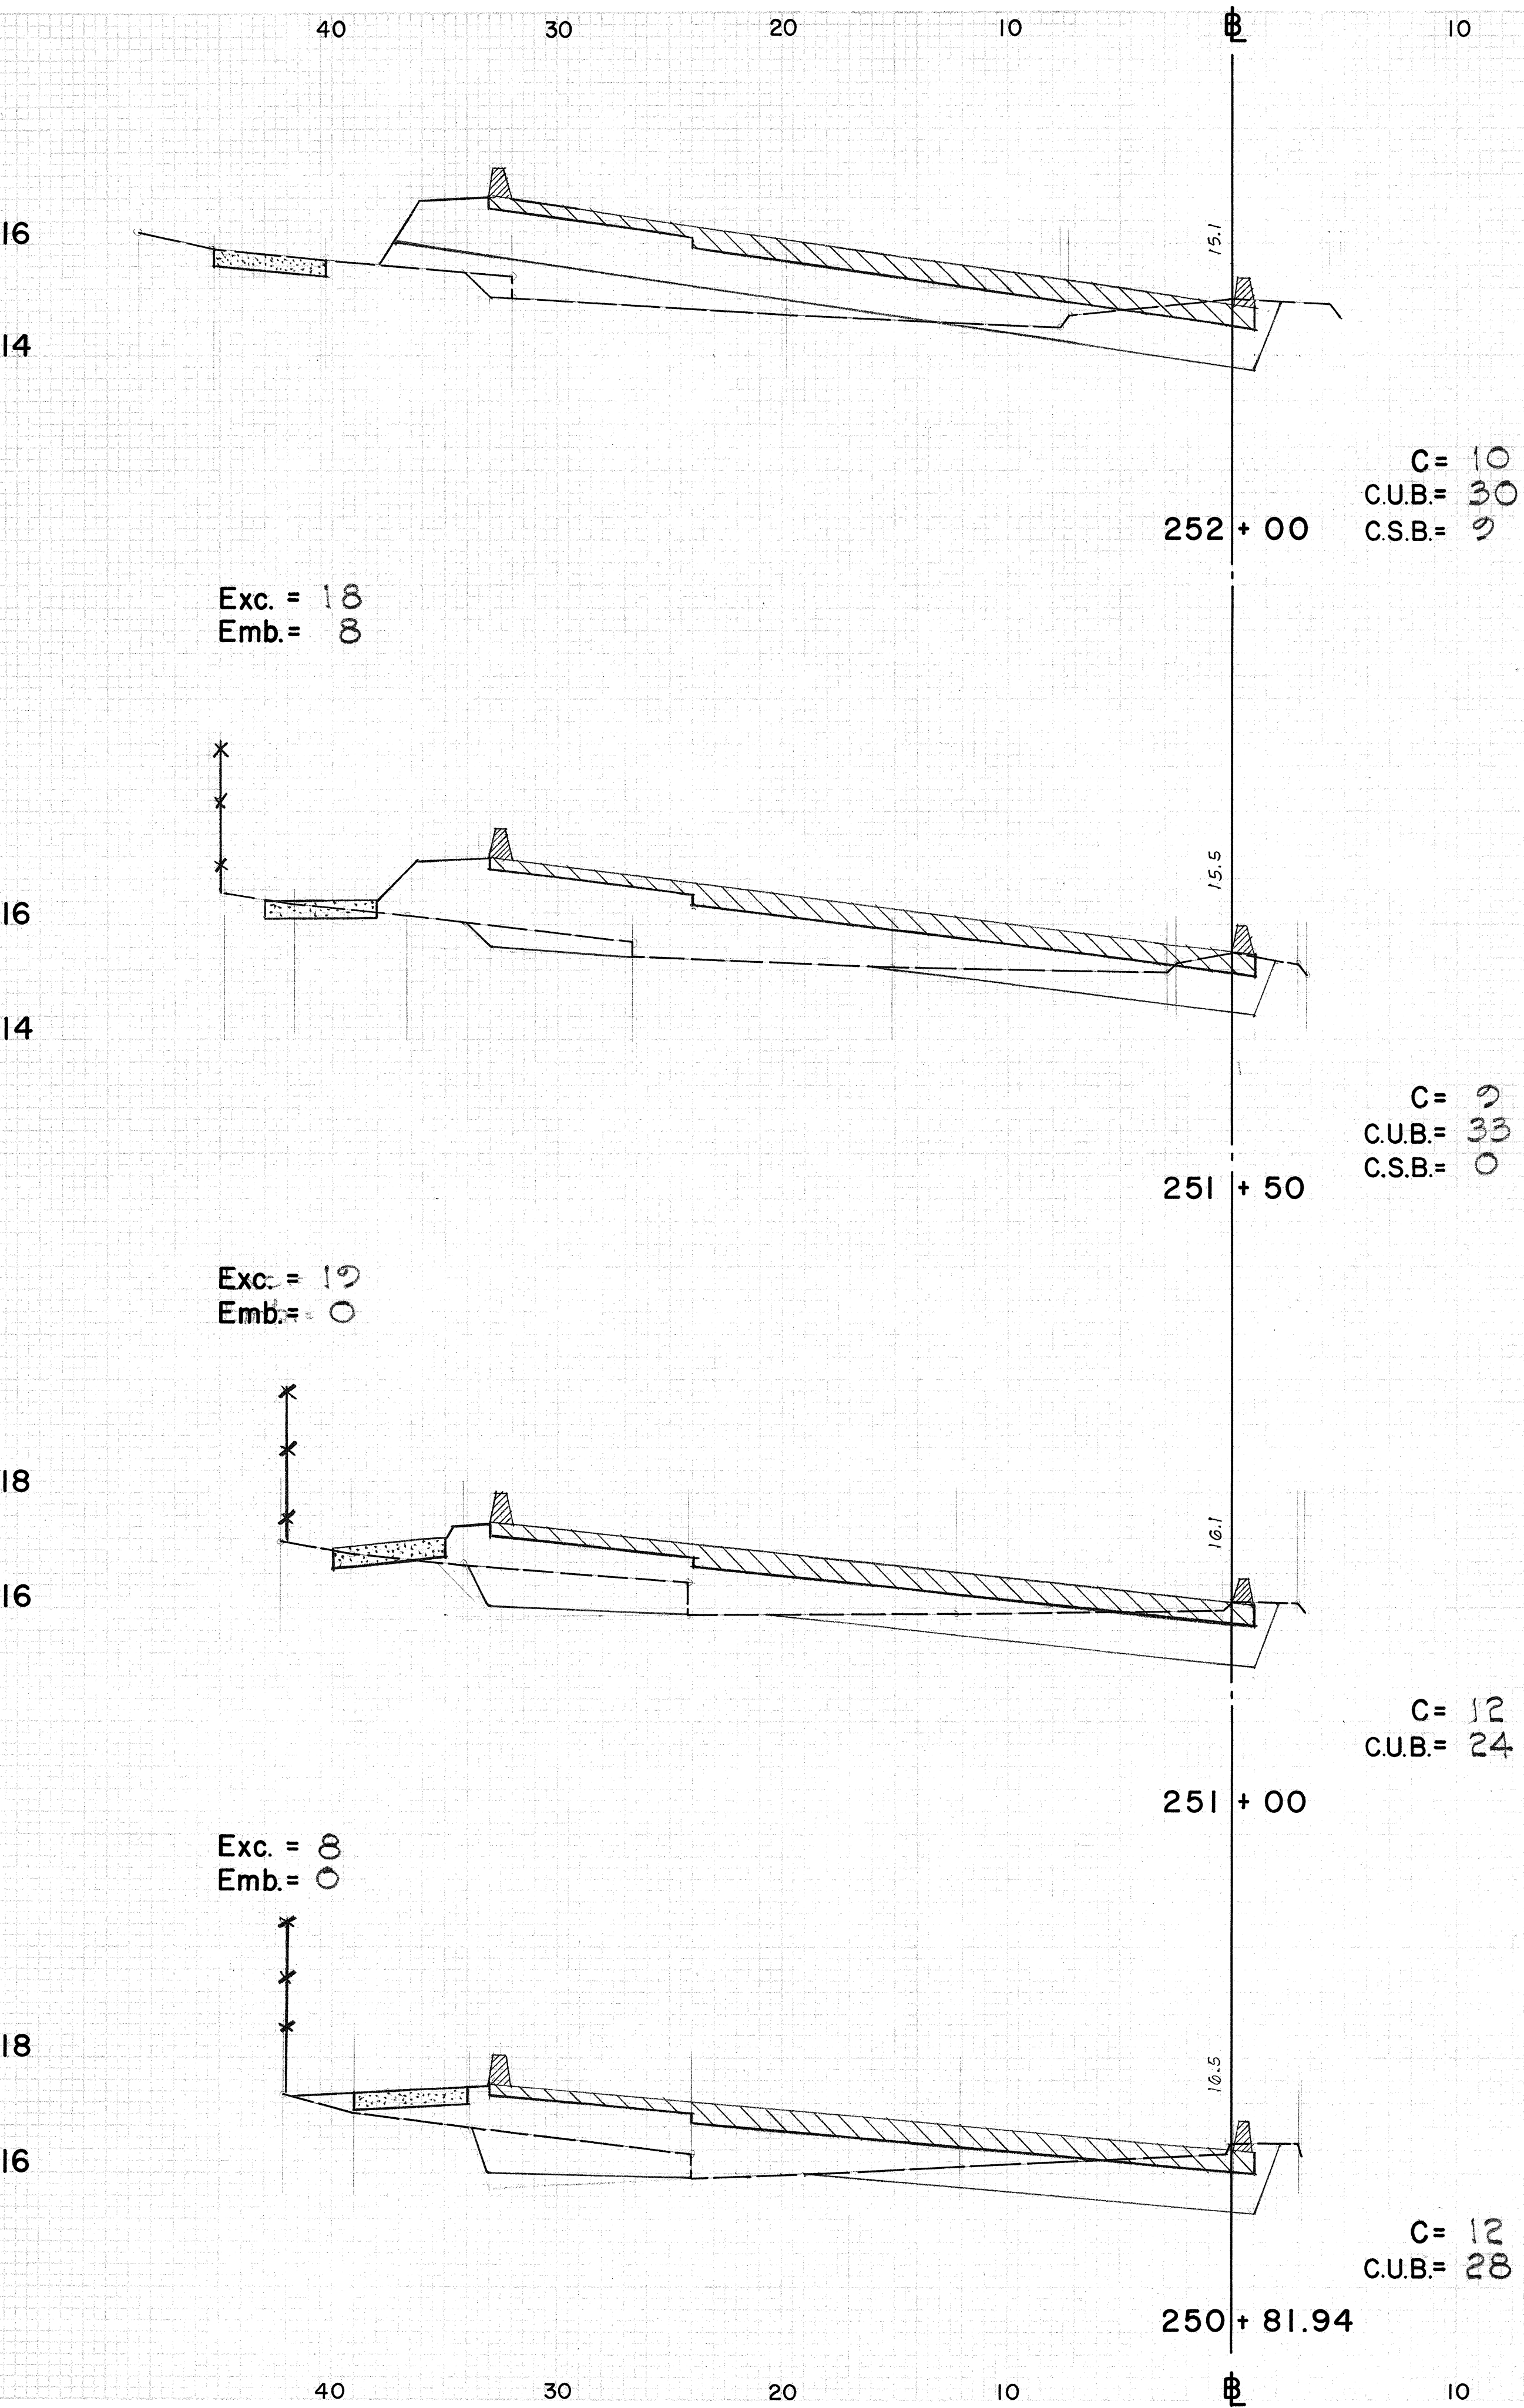

Exc. = 6
Emb. = 84

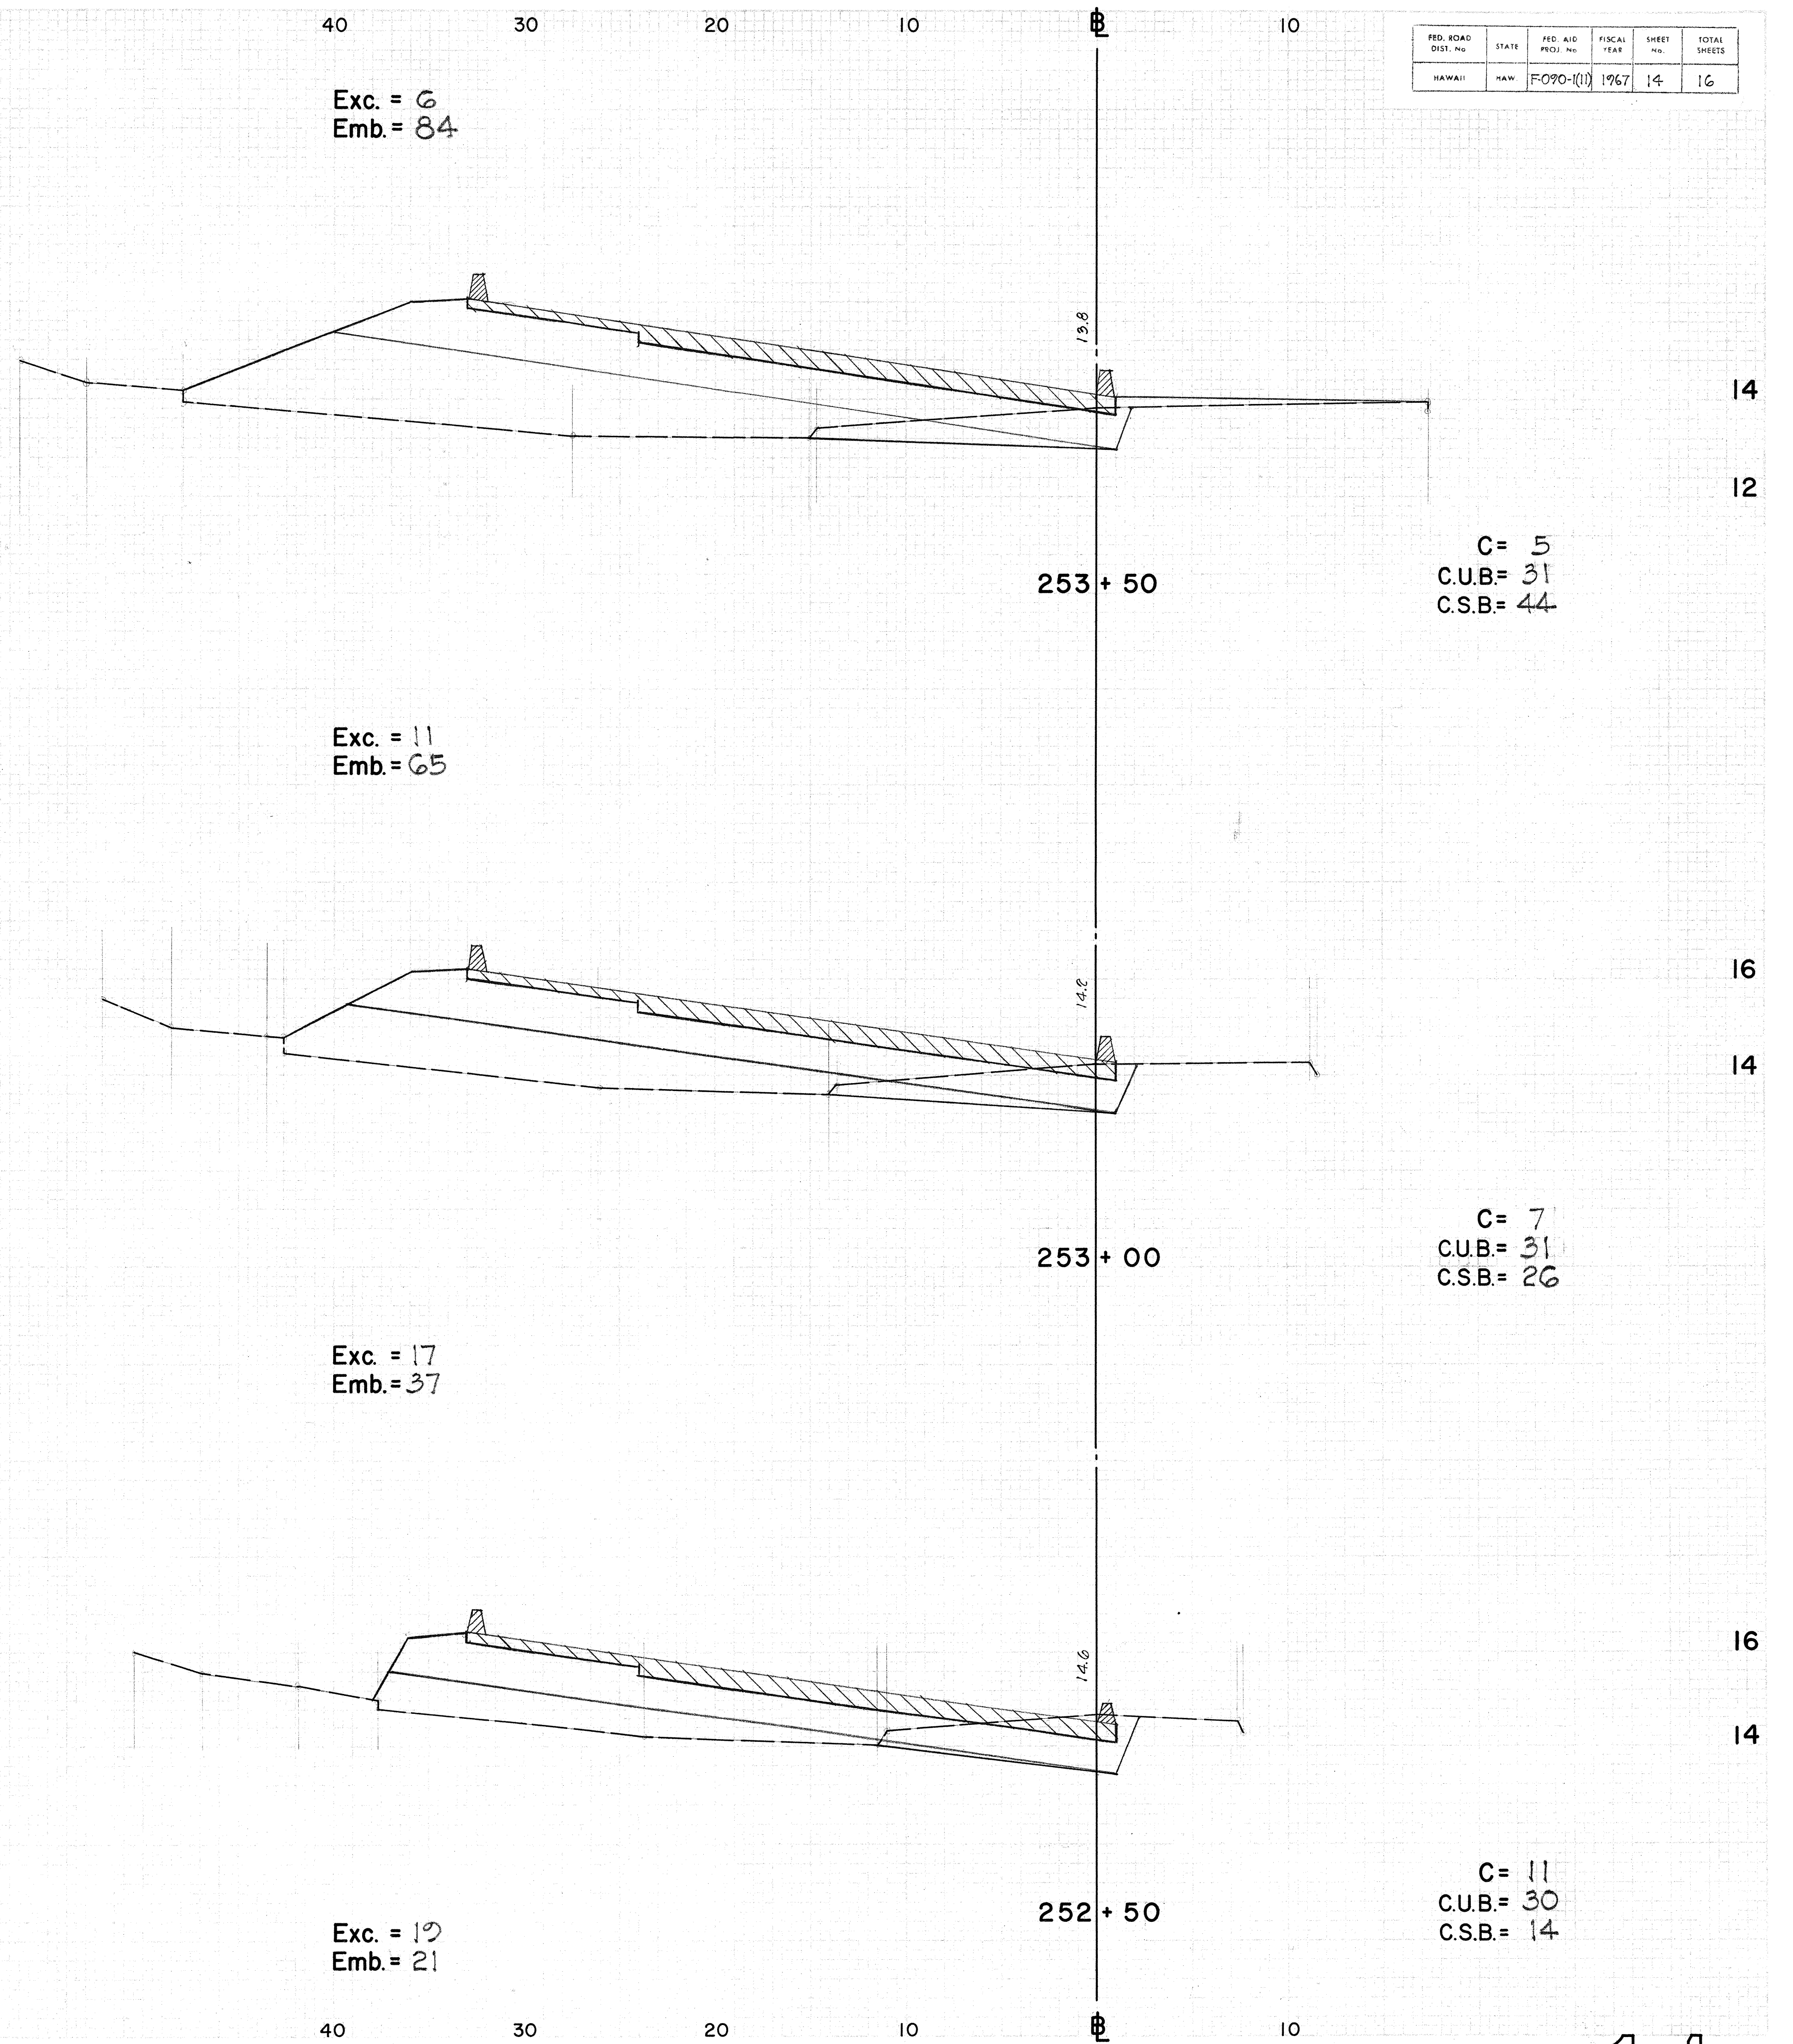

FED. ROAD DIST. NO.	STATE	FED. AID PROJ. NO.	FISCAL YEAR	SHEET NO.	TOTAL SHEETS
HAWAII	HAW.	F-090-1(1)	1967	15	16

Exc. =
Emb. =

Exc. = 1
Emb. = 24

Exc. = 3
Emb. = 61

Exc. = 4
Emb. = 81

255 + 50

C = 0
C.U.B. = 15
C.S.B. = 0

255 + 00

C = 1
C.U.B. = 32
C.S.B. = 26

254 + 50

C = 2
C.U.B. = 29
C.S.B. = 40

254 + 00

C = 2
C.U.B. = 29
C.S.B. = 47

FED. ROAD DIST. NO.	STATE	FED. AID PROJ. NO.	FISCAL YEAR	SHEET NO.	TOTAL SHEETS
HAWAII	HAW	F-090-1(1)	1967	16	16

