


FED. ROAD DIST. NO.	STATE	FED. AID PROJ. NO.	FISCAL YEAR	SHEET NO.	TOTAL SHEETS
HAWAII	HAW.				

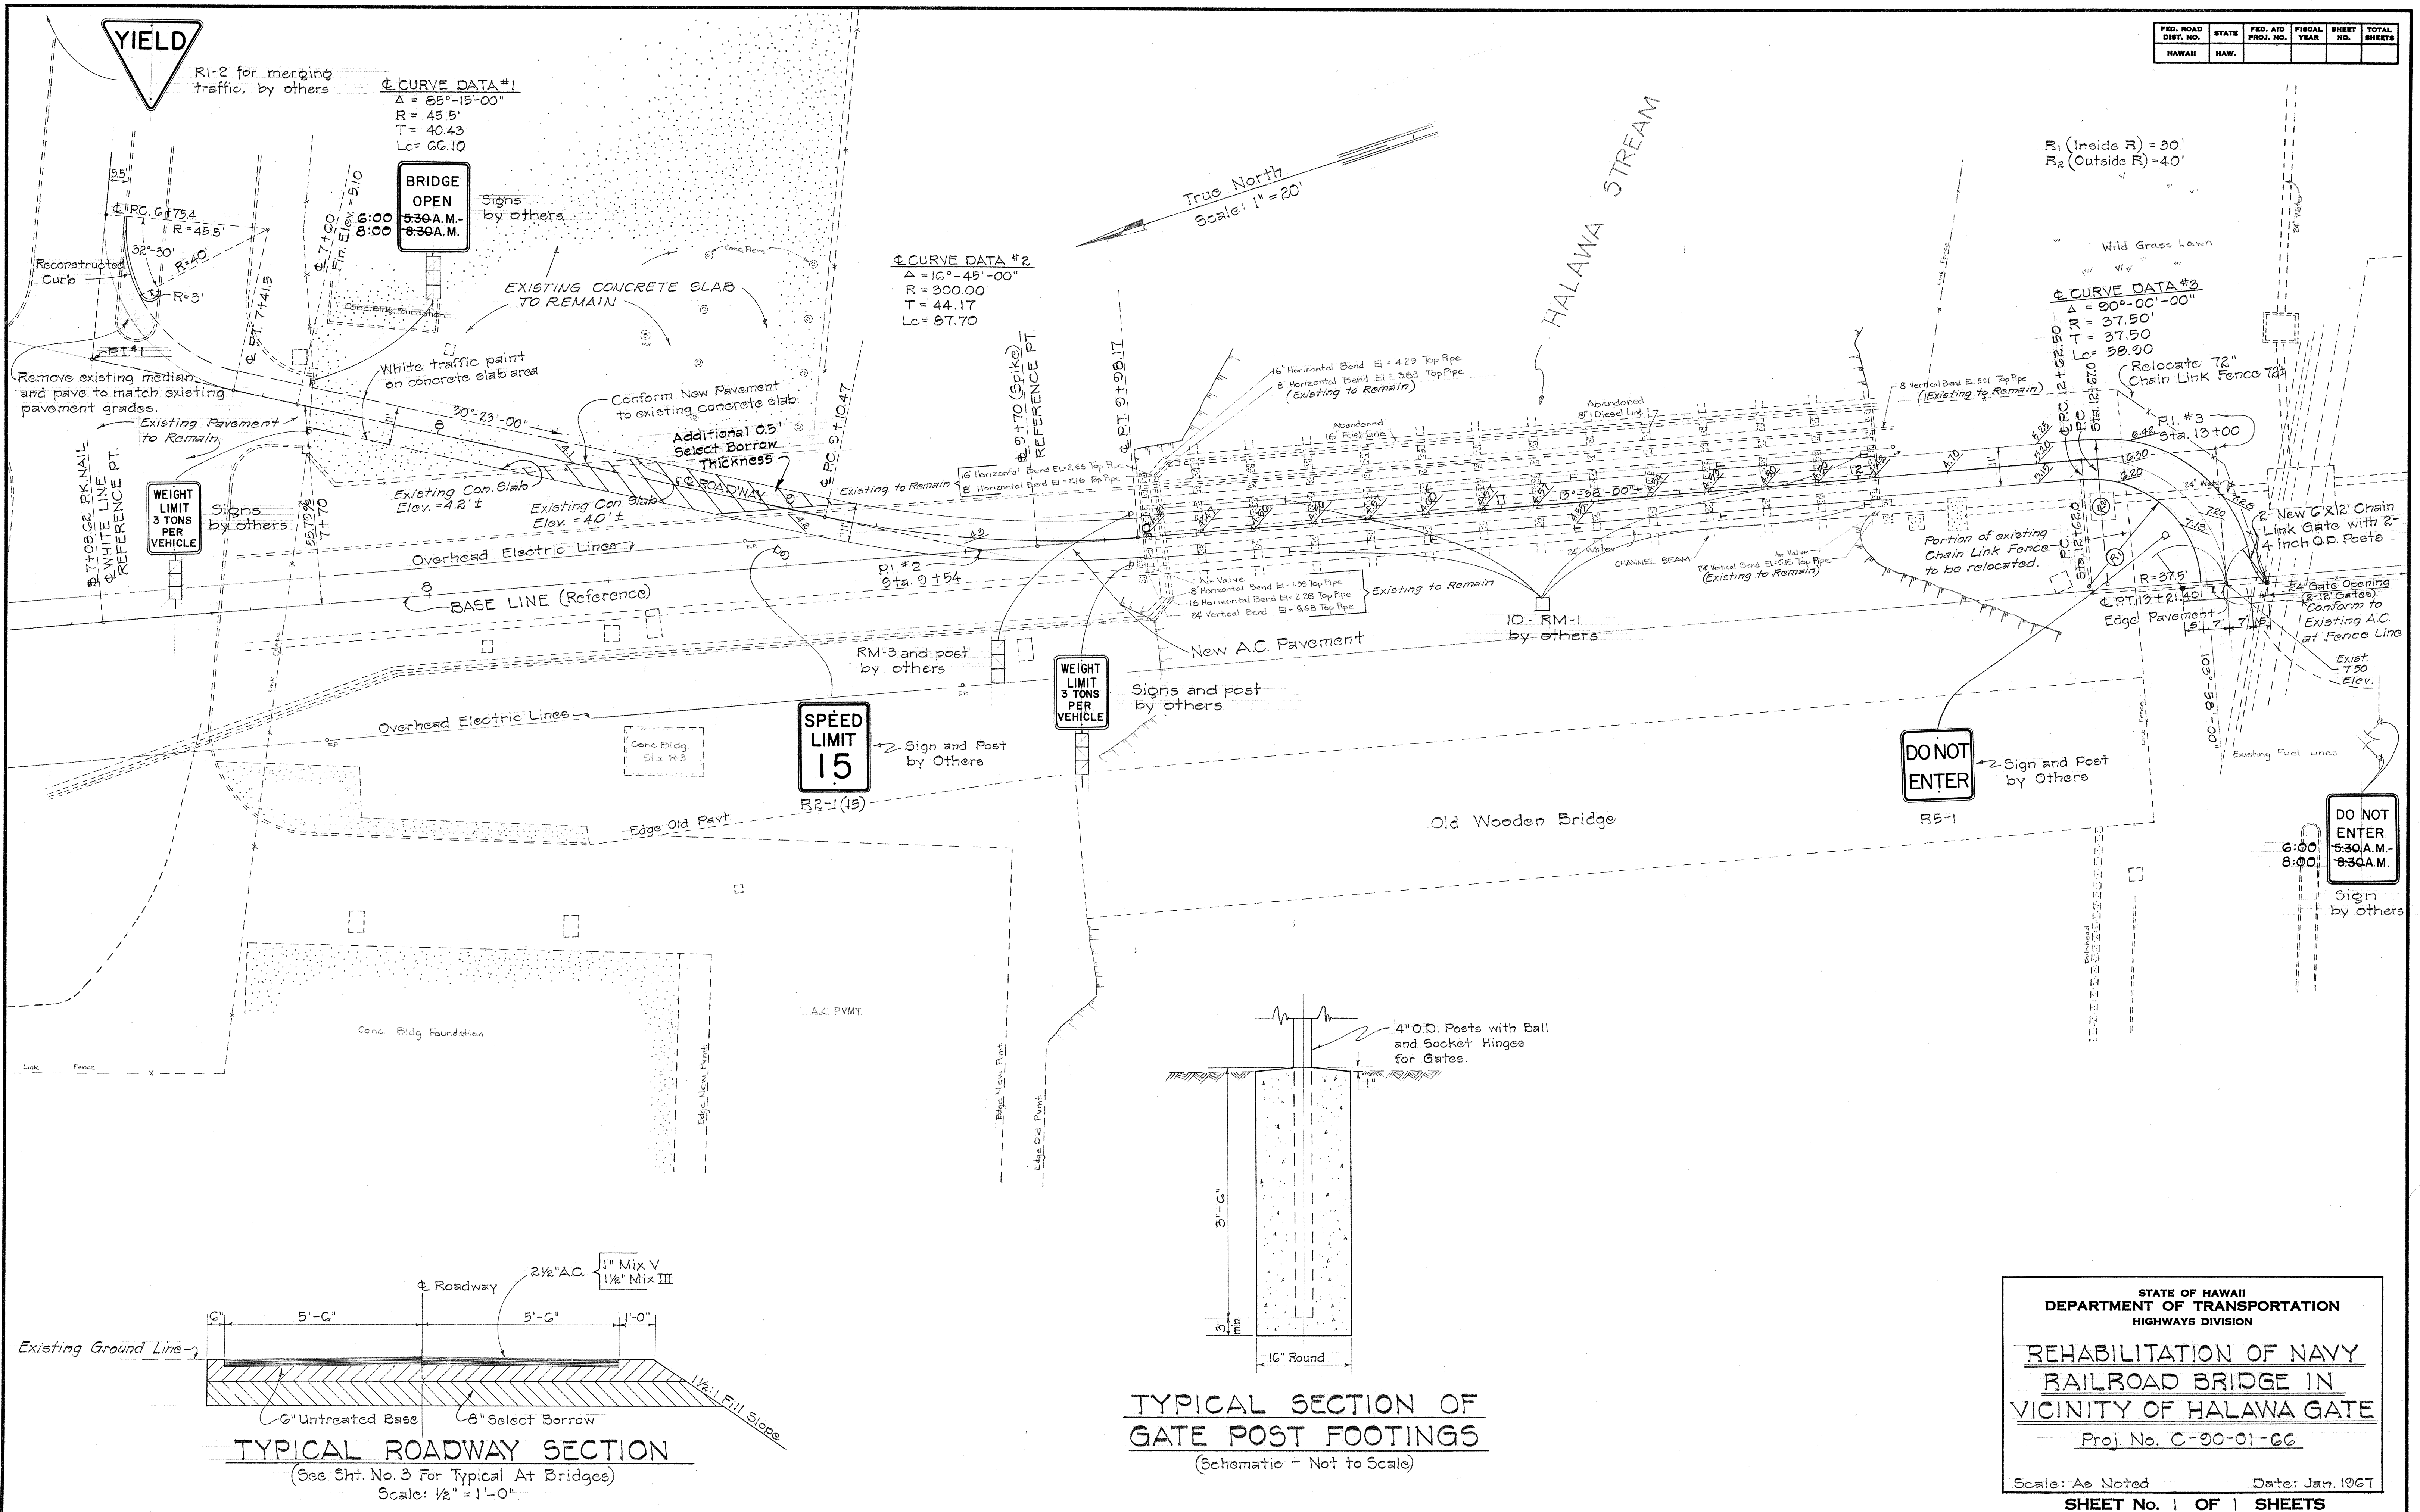

DATE:	1/1/67
SURVEY PLOTTED BY:	
TRACED BY:	
DESIGNED BY:	
CHECKED BY:	
ORIGINAL PLAN:	
NOTE BOOK:	No.