-	5	
	INDEX TO DRAWINGS	
	SHEET NO.	DESCRIPTION
ľ	the second secon	Title Sheet
l		
ĺ	2	Roadway Plan and Typical
		Sections
I	3	Roadway Cross-Sections
	and the second section of the second section of the second section of the second section sec	and Misc. Details
	4 5 , and	Standard Details - Drainage
I		Structures
I		
	<u>annidera eran eran eran eran eran eran eran e</u>	
		7
L		
1		

STATE OF HAWAII

DEPARTMENT OF TRANSPORTATION

HIGHWAYS

DIVISION

HONOLULU, HAWAII

PLANS OF

INTERSECTION IMPROVEMENTS, KAMEHAMEHA HIGHWAY AT WAIKALANI DRIVE (formerly WAIHONU ST.)

PROJECT NO. 99C-03-68


DISTRICT OF EWA ISLAND OF OAHU

SCALES

11N. = 20 FT. HOR. 1 IN. = 10 FT.


VERT. | 1 N. = 10 FT.

4 0 4
SCALE IN MILES Location of Project No. 990-03-68 Federal Aid Projects Previously Constructed or Under Construction

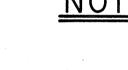

CONSTRUCTION HAVE BEEN NOTED IN RED ON THESE TRACINGS AND CHECKED BY

> 7. Bacena PROJ. ENG'R 10/27/69

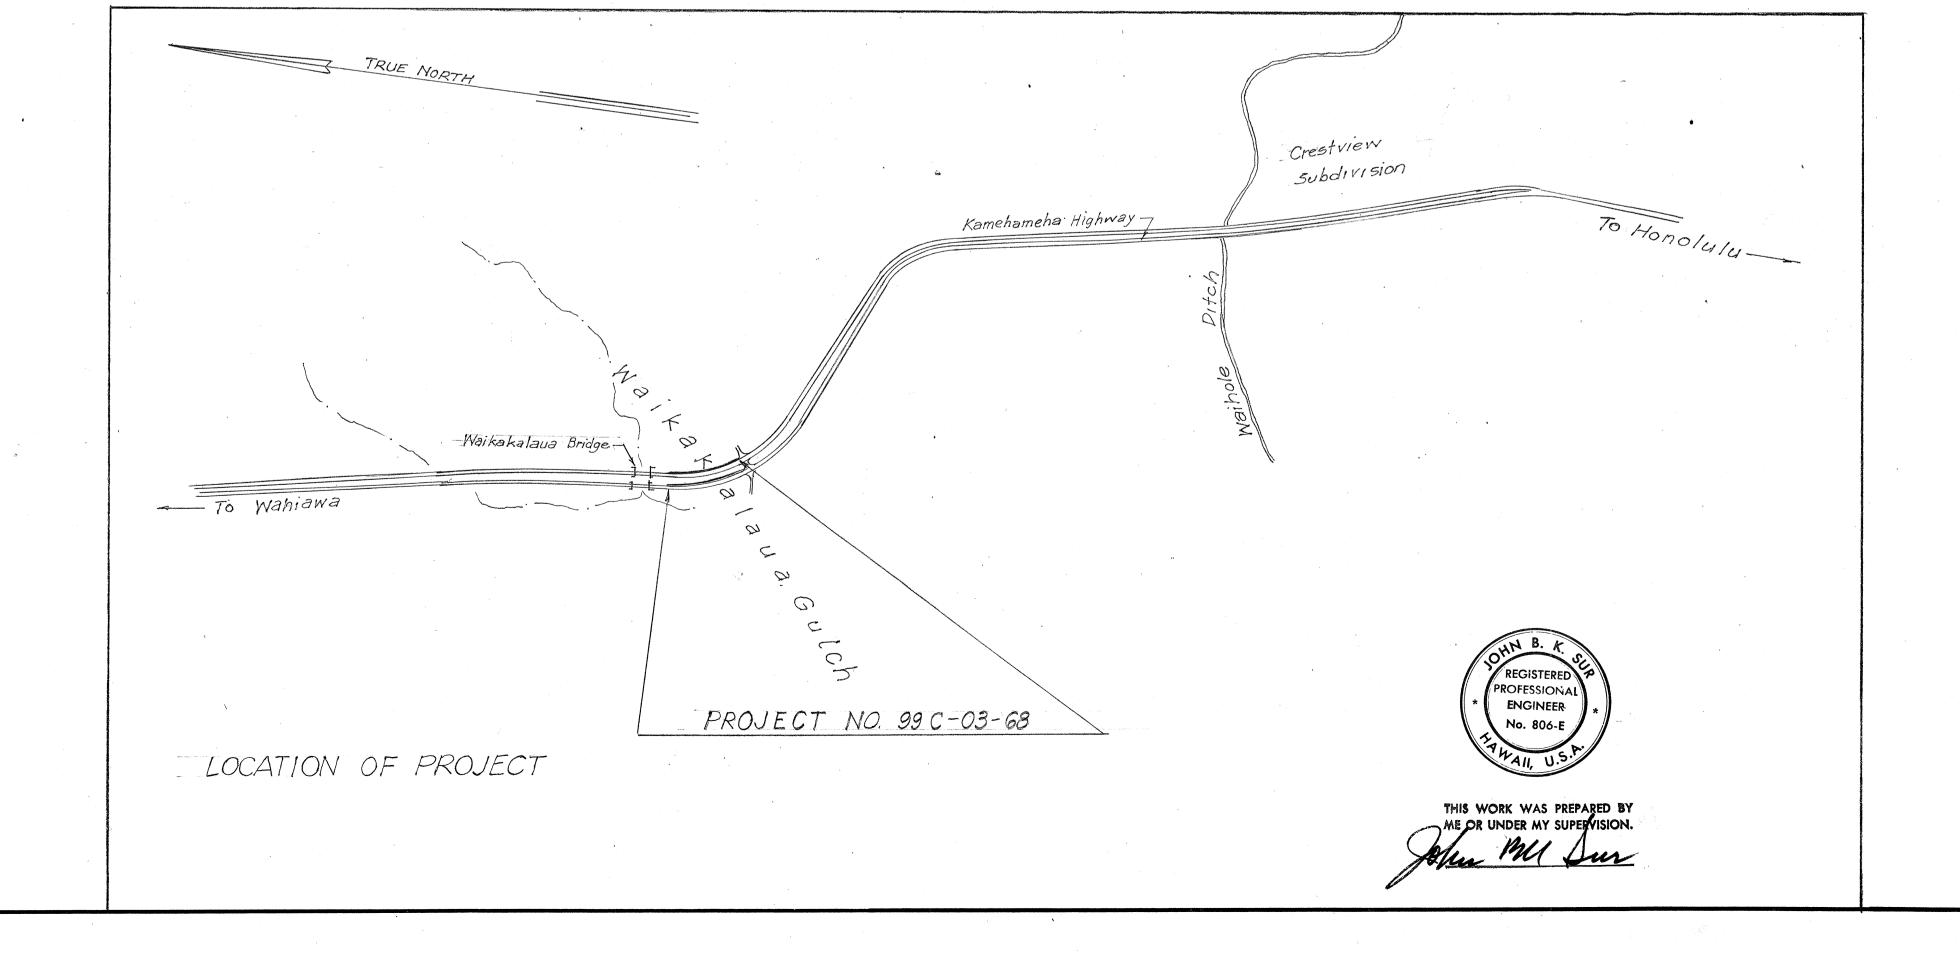

DEPARTMENT OF TRANSPORTATION STATE OF HAWAII APPROVED: