




PAVEMENT RETURN DATA

CURVE 1	CURVE 2	CURVE 3
Δ = 23° 37' 38"	Δ = 40° 00' 48"	Δ = 21° 36' 18"
½ = 11° 48' 49"	½ = 20° 00' 24"	½ = 10° 48' 09"
R = 180.00'	R = 65.00'	R = 180.00'
T = 37.65'	T = 23.67'	T = 33.74'
Lc = 74.23'	Lc = 45.39'	Lc = 67.87'
Ch = 73.70'	Ch = 44.48'	Ch = 67.47'

CURVE 4	CURVE 5	CURVE 6
Δ = 23° 37' 38"	Δ = 44° 35' 34"	Δ = 28° 35' 50"
½ = 11° 48' 49"	½ = 22° 17' 47"	½ = 14° 17' 55"
R = 180.00'	R = 65.00'	R = 180.00'
T = 37.65'	T = 26.65'	T = 45.88'
Lc = 74.23'	Lc = 50.59'	Lc = 89.84'
Ch = 73.70'	Ch = 40.32'	Ch = 88.91'

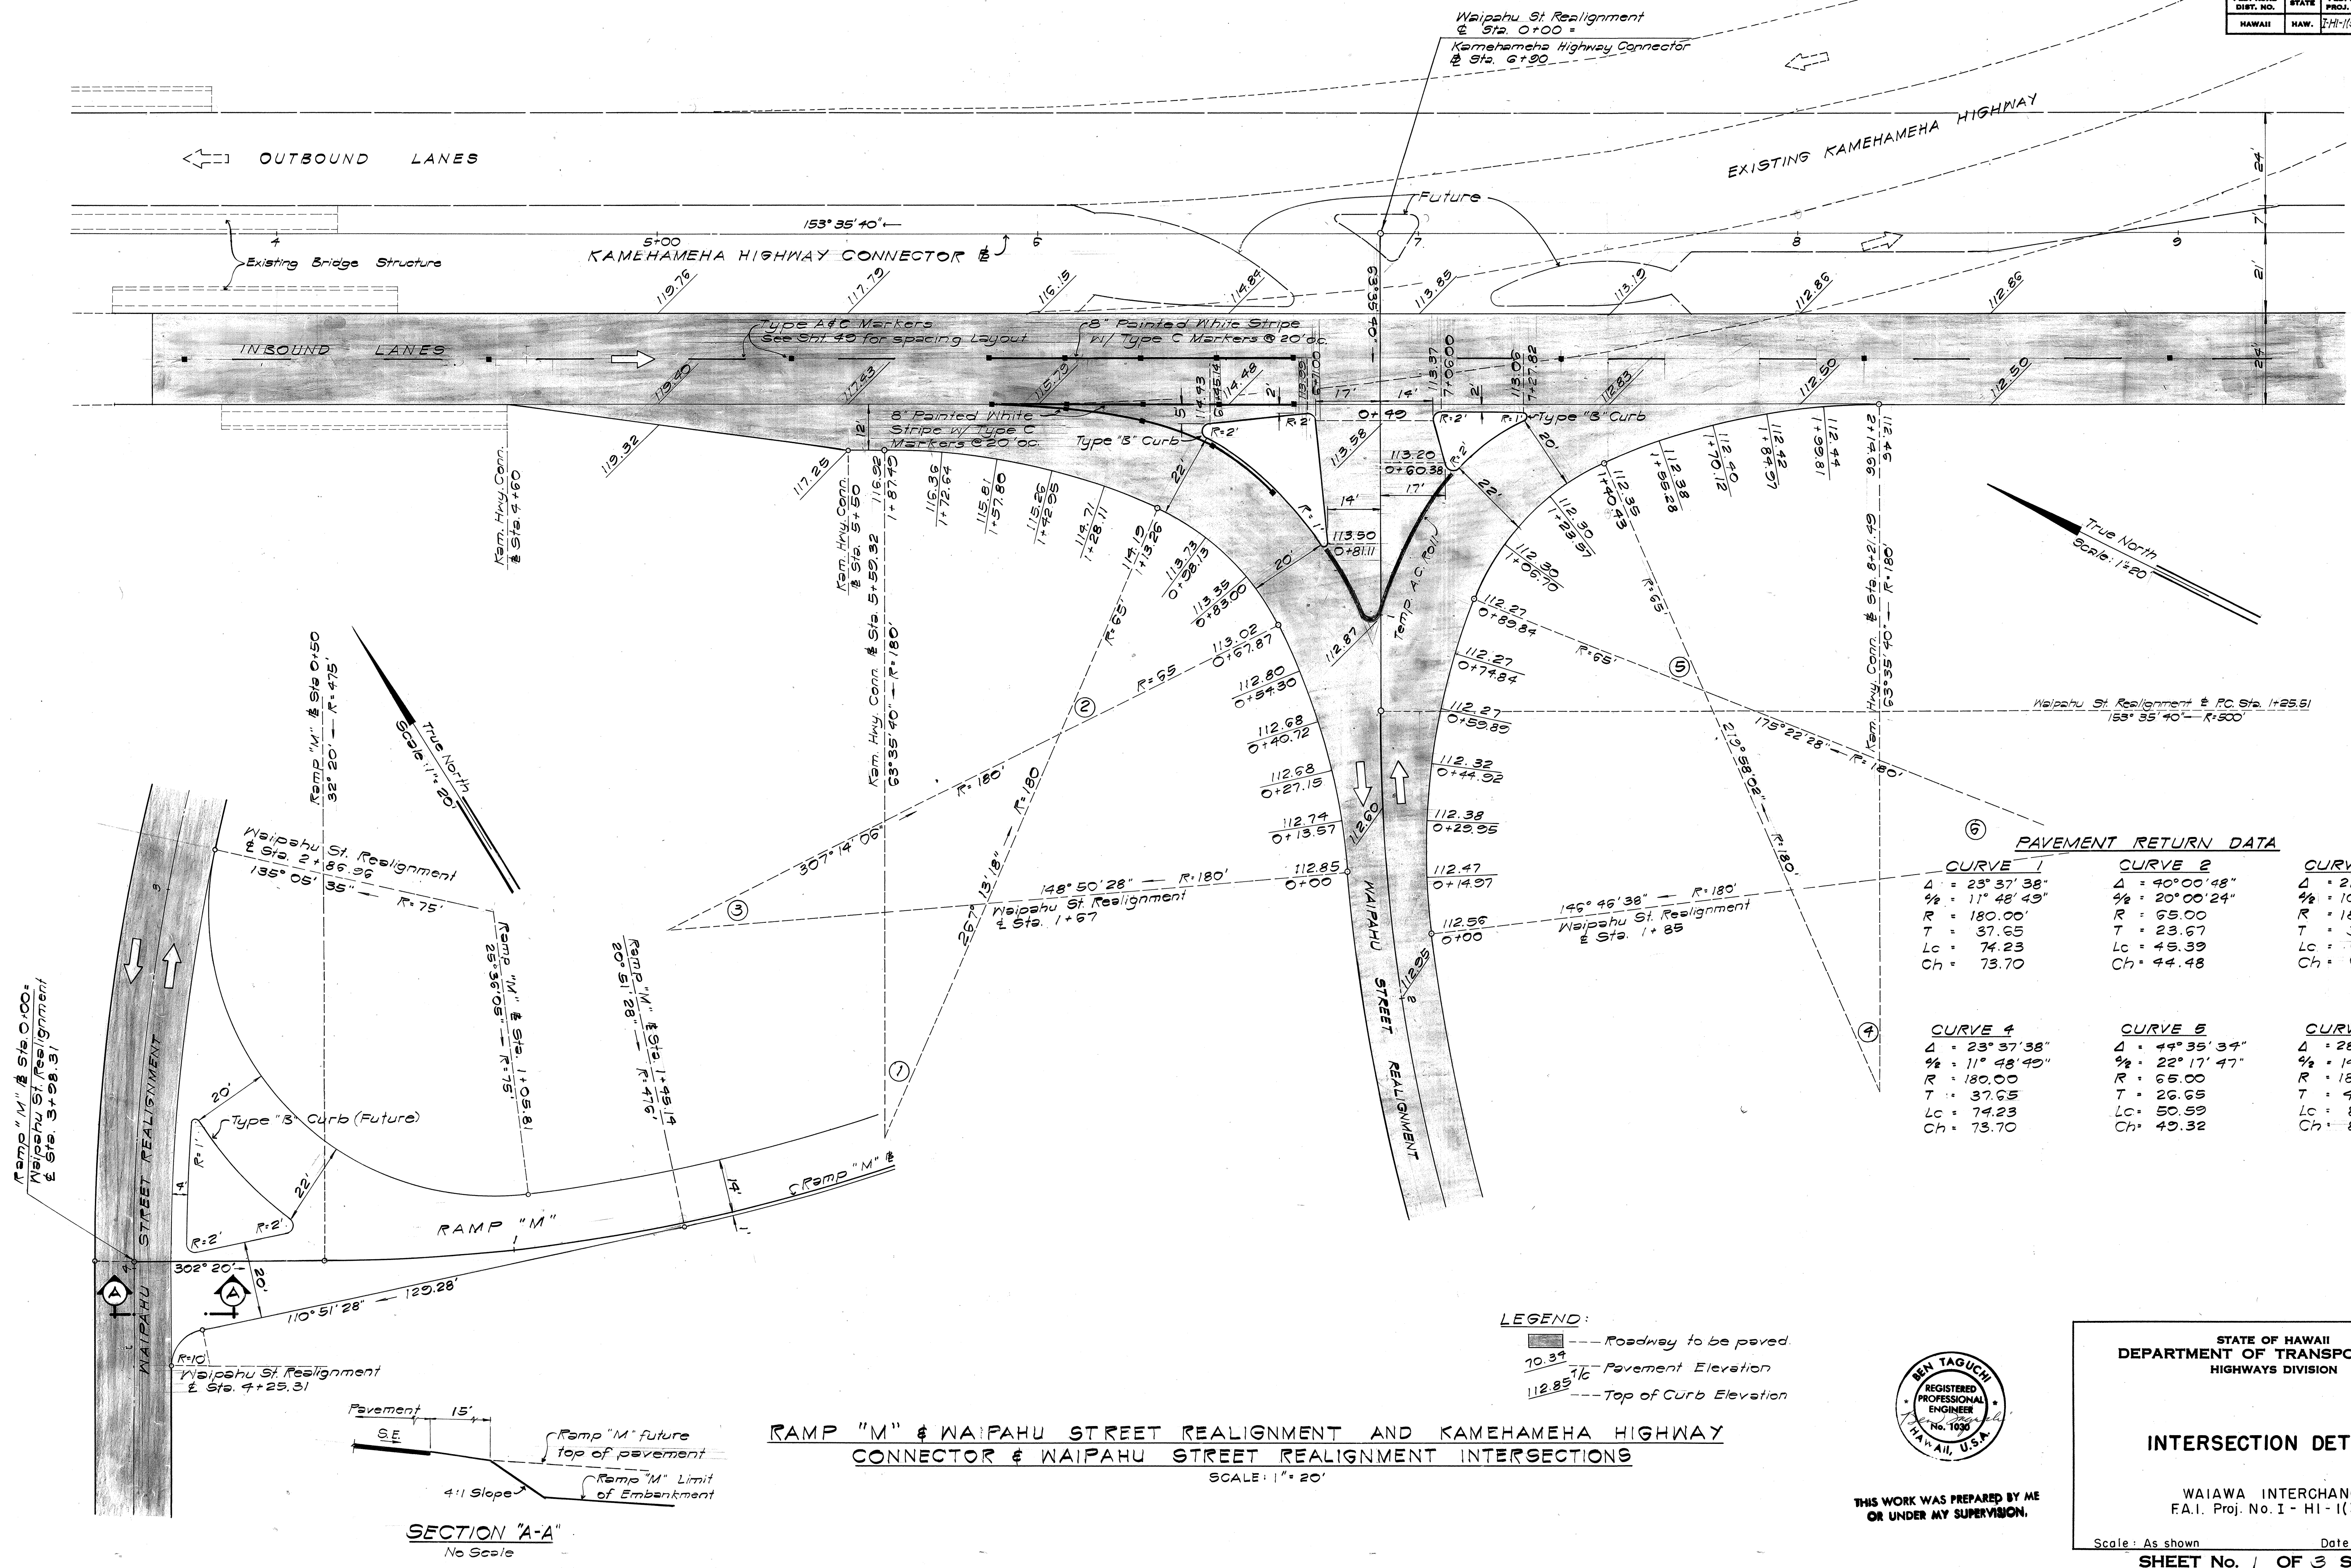

THIS WORK WAS PREPARED BY ME
OR UNDER MY SUPERVISION.

STATE OF HAWAII
DEPARTMENT OF TRANSPORTATION
HIGHWAYS DIVISION

INTERSECTION DETAILS

WAIAWA INTERCHANGE
F.A.I. Proj. No. I - HI - 11368


Scale: As shown Date: OCT 1967

SHEET No. 1 OF 3 SHEETS



INTERSECTION

FED. ROAD DIST. NO.	STATE	FED. AID PROJ. NO.	FISCAL YEAR	SHEET NO.	TOTAL SHEETS
HAWAII	HAW.	1H-1342	1967	19	124

TEMPORARY CONNECTOR #1	
EP CURVE DATA	EC CURVE DATA
$\Delta = 13^\circ 29' 40''$	$\Delta = 13^\circ 29' 40''$
$\frac{1}{2} = 06^\circ 44' 50''$	$\frac{1}{2} = 06^\circ 44' 50''$
$R = 400.00$	$R = 250.00$
$T = 47.32$	$T = 29.58$
$Lc = 94.21$	$Lc = 58.88$
$Ch = 93.99$	$Ch = 58.74$

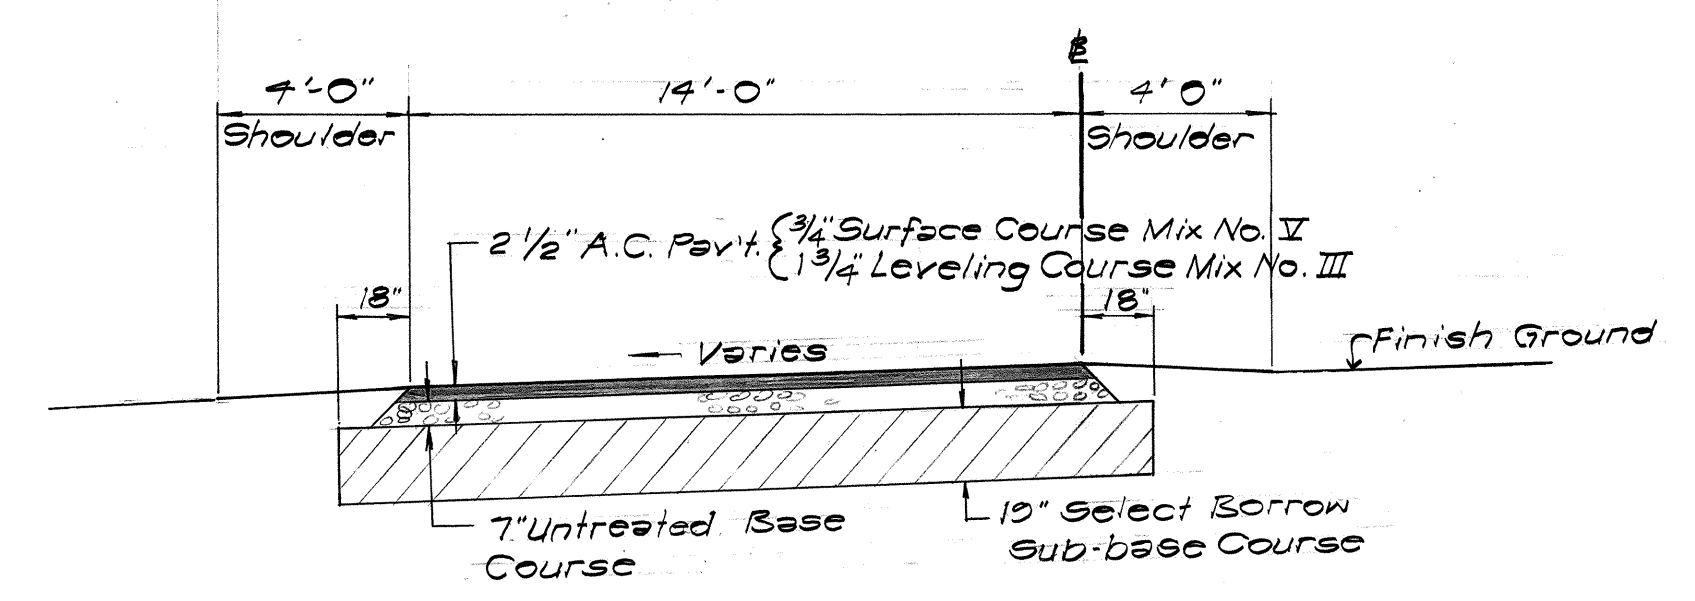


TYPICAL SECTION TEMP. CONN. #1
Scale: 1/4" = 1'-0"

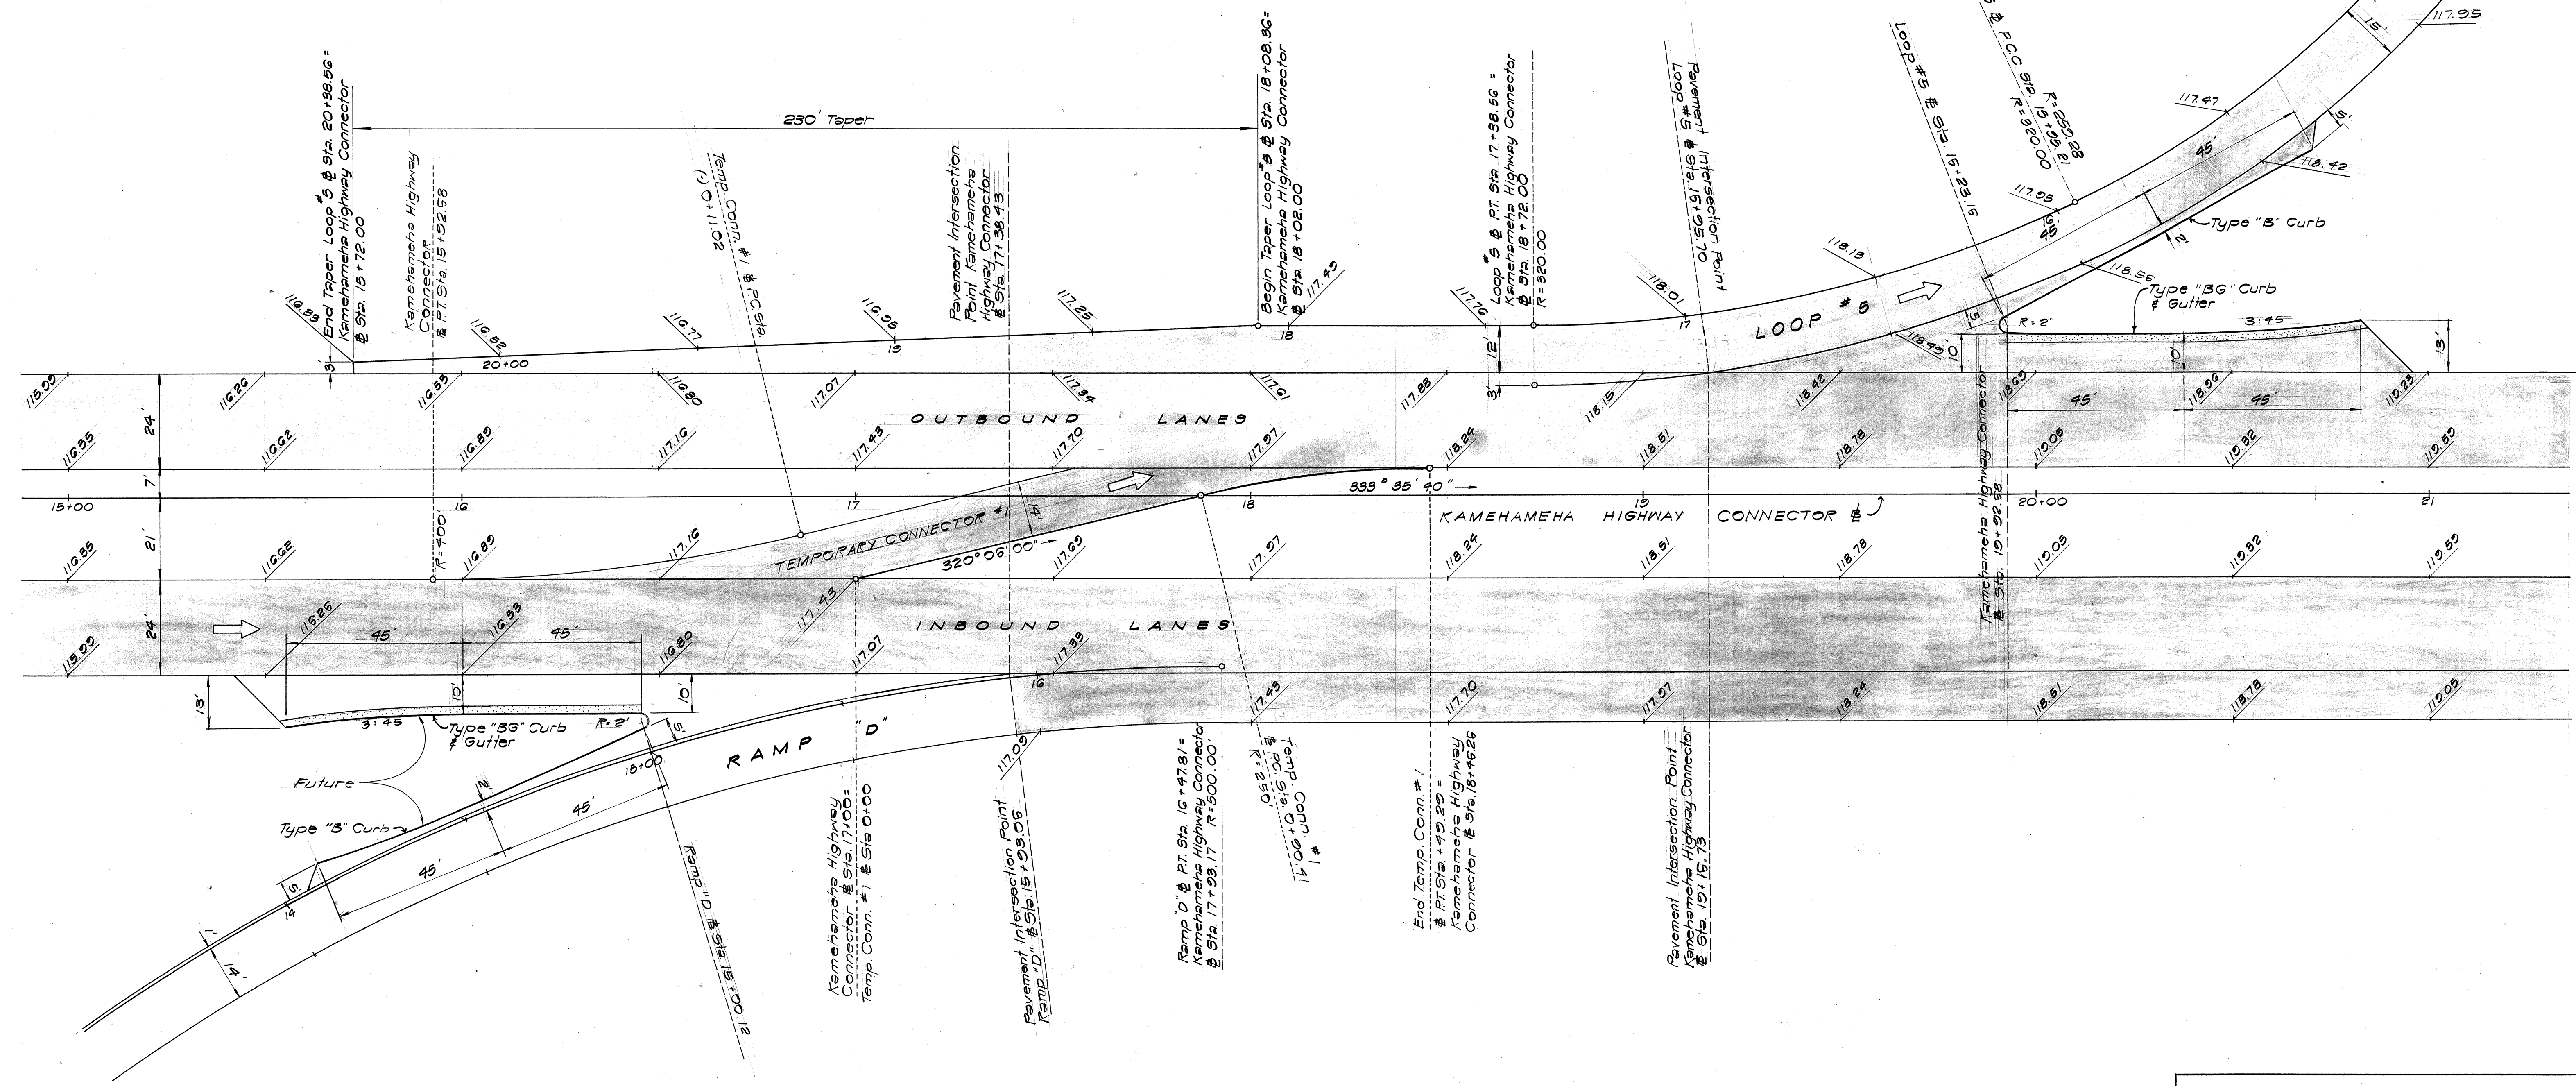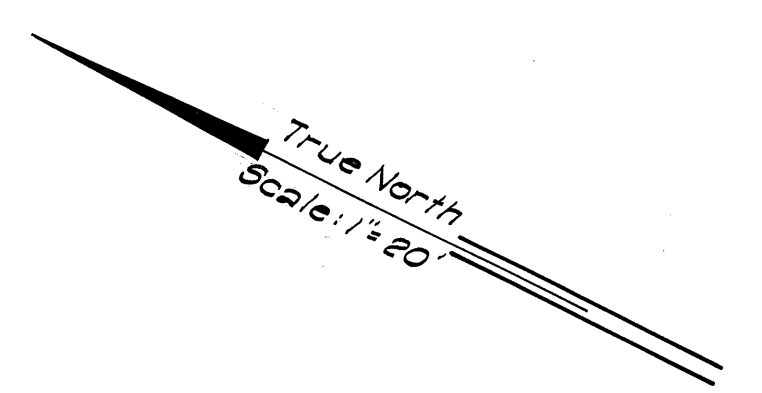

LOOP #5 & KAMEHAMEHA HIGHWAY CONNECTOR AND RAMP "D" & KAMEHAMEHA HIGHWAY CONNECTOR INTERSECTIONS

SCALE: 1" = 20'

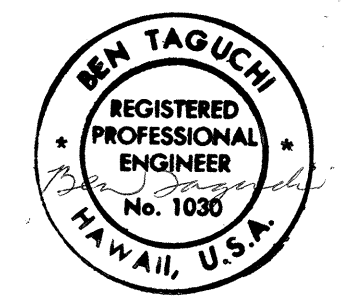

THIS WORK WAS PREPARED BY ME
OR UNDER MY SUPERVISION.

STATE OF HAWAII
DEPARTMENT OF TRANSPORTATION
HIGHWAYS DIVISION

INTERSECTION DETAILS


WAIAWA INTERCHANGE
F.A.I. Proj. No. I - HI - 11(36)8

Scale: As shown Date: OCT 1967

SHEET No. 2 OF 3 SHEETS

Intersections
Ramp Conn. Ramp D
New Loop

FED. ROAD DIST. NO.	STATE	FED. AID PROJ. NO.	FISCAL YEAR	SHEET NO.	TOTAL SHEETS
HAWAII	HAW.	1-11-136	1967	20	124

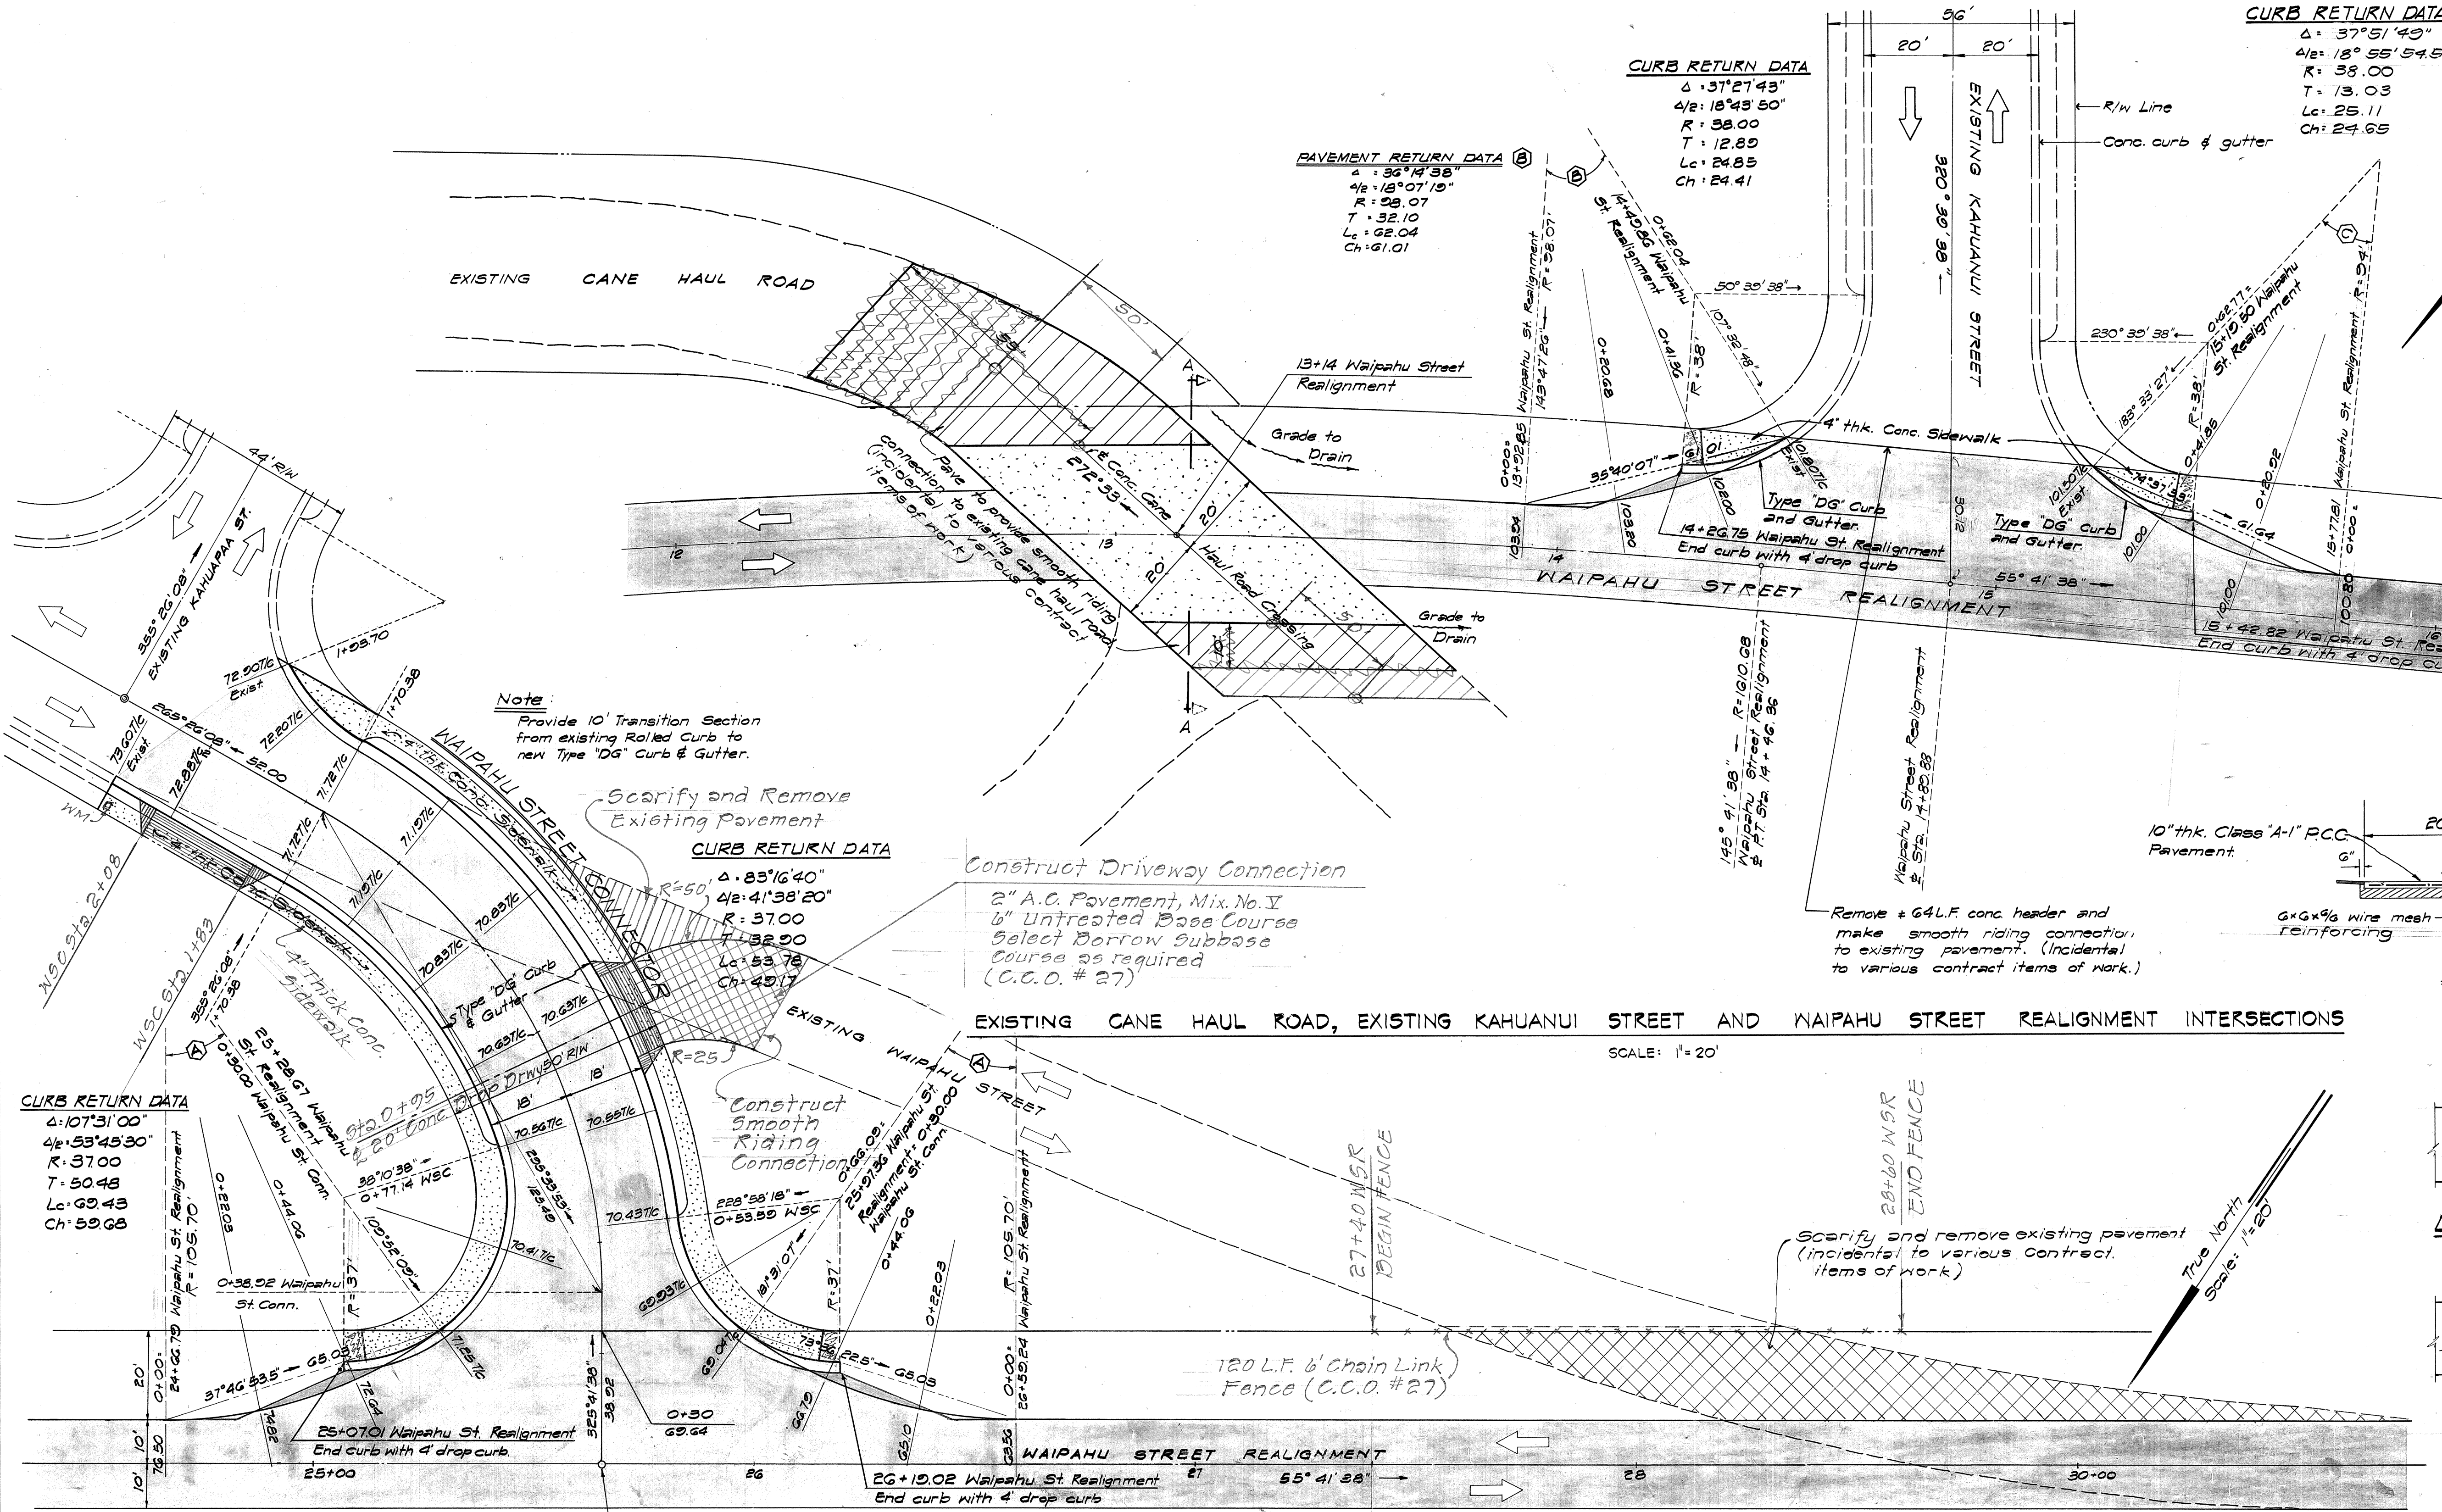

CURB RETURN DATA
 $\Delta = 37^\circ 51' 40''$
 $\Delta/2 = 18^\circ 55' 54.5''$
 $R = 38.00$
 $T = 13.03$
 $Lc = 25.11$
 $Ch = 24.65$

PAVEMENT RETURN DATA
 $\Delta = 36^\circ 14' 38''$
 $\Delta/2 = 18^\circ 07' 19''$
 $R = 38.07$
 $T = 32.10$
 $Lc = 62.04$
 $Ch = 61.01$


PAVEMENT RETURN DATA
 $\Delta = 37^\circ 51' 40''$
 $\Delta/2 = 18^\circ 55' 54.5''$
 $R = 38.00$
 $T = 32.58$
 $Lc = 62.77$
 $Ch = 61.64$

Note:
 Provide 10' Transition Section from existing Rolled Curb to new Type 'DG' Curb & Gutter.



CURB RETURN DATA
 $\Delta = 83^\circ 16' 40''$
 $\Delta/2 = 41^\circ 58' 20''$
 $R = 37.00$
 $T = 32.00$
 $Lc = 53.78$
 $Ch = 49.17$

Construct Driveway Connection
 2" A.C. Pavement, Mix. No. V
 6" Untreated Base Course
 Select Borrow Subbase Course as required (C.C.O. # 27)

Remove 6" L.F. conc. header and make smooth riding connection to existing pavement. (Incidental to various contract items of work.)

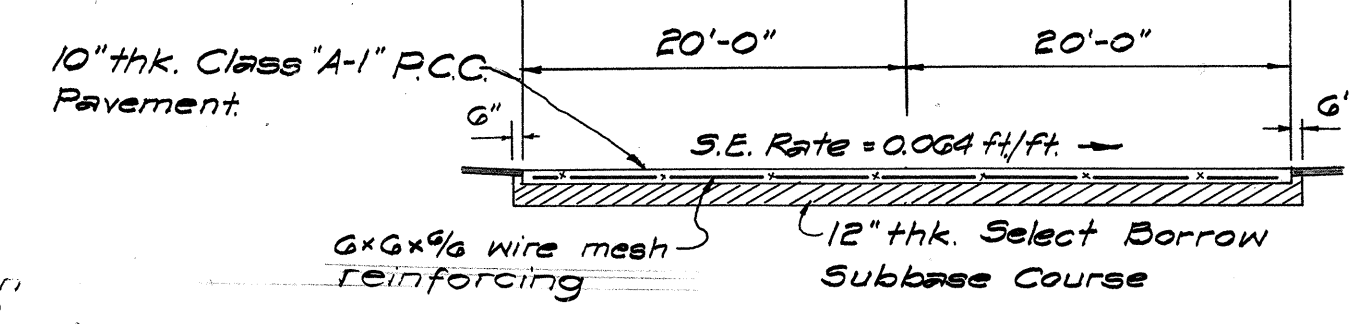


SECTION A-A
 Scale: 1" = 10'-0"

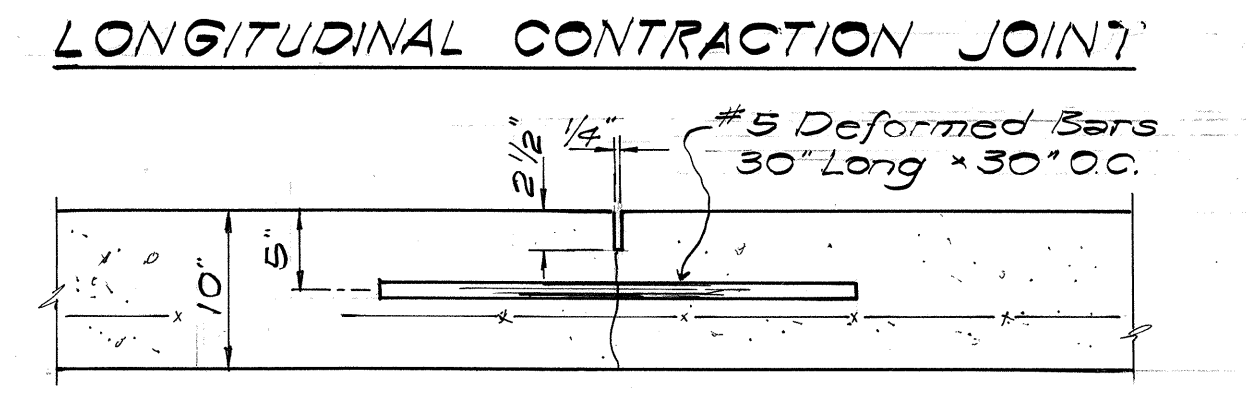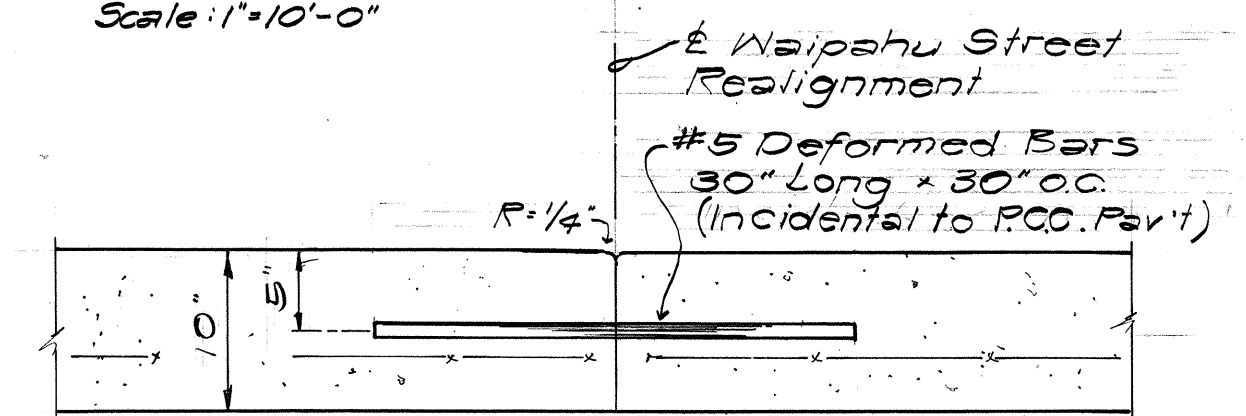

LONGITUDINAL WEAKENED PLANE JOINT
 Scale: 1" = 1'-0"

PAVEMENT RETURN DATA
 (Both Sides)
 $\Delta = 35^\circ 40' 20''$
 $\Delta/2 = 17^\circ 50' 10''$
 $R = 105.70$
 $T = 34.17$
 $Lc = 66.09$
 $Ch = 65.03$

WAIPAHU STREET CONNECTOR AND WAIPAHU STREET REALIGNMENT INTERSECTION
 SCALE: 1" = 20'

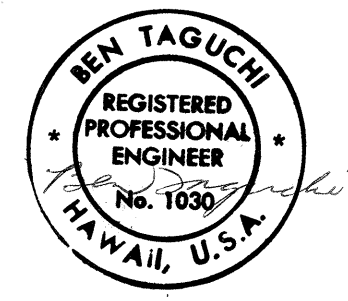

THIS WORK WAS PREPARED BY ME OR UNDER MY SUPERVISION.

STATE OF HAWAII
DEPARTMENT OF TRANSPORTATION
HIGHWAYS DIVISION

INTERSECTION DETAILS

WAIAWA INTERCHANGE
F.A.I. Proj. No. 1 - HI - (136)8

Scale As shown Date: OCT 1967

SHEET No. 3 OF 3 SHEETS

UNIT 3
 WSR & KAHUANUI ST. INTER.
 WAIPAHU ST. REALIGNMENT

DATE	_____
DESIGNED BY	_____
CHECKED BY	_____
ORIGINAL PLAN	_____
NOTE BOOK	_____
QUANTITIES BY	_____
NO.	_____