
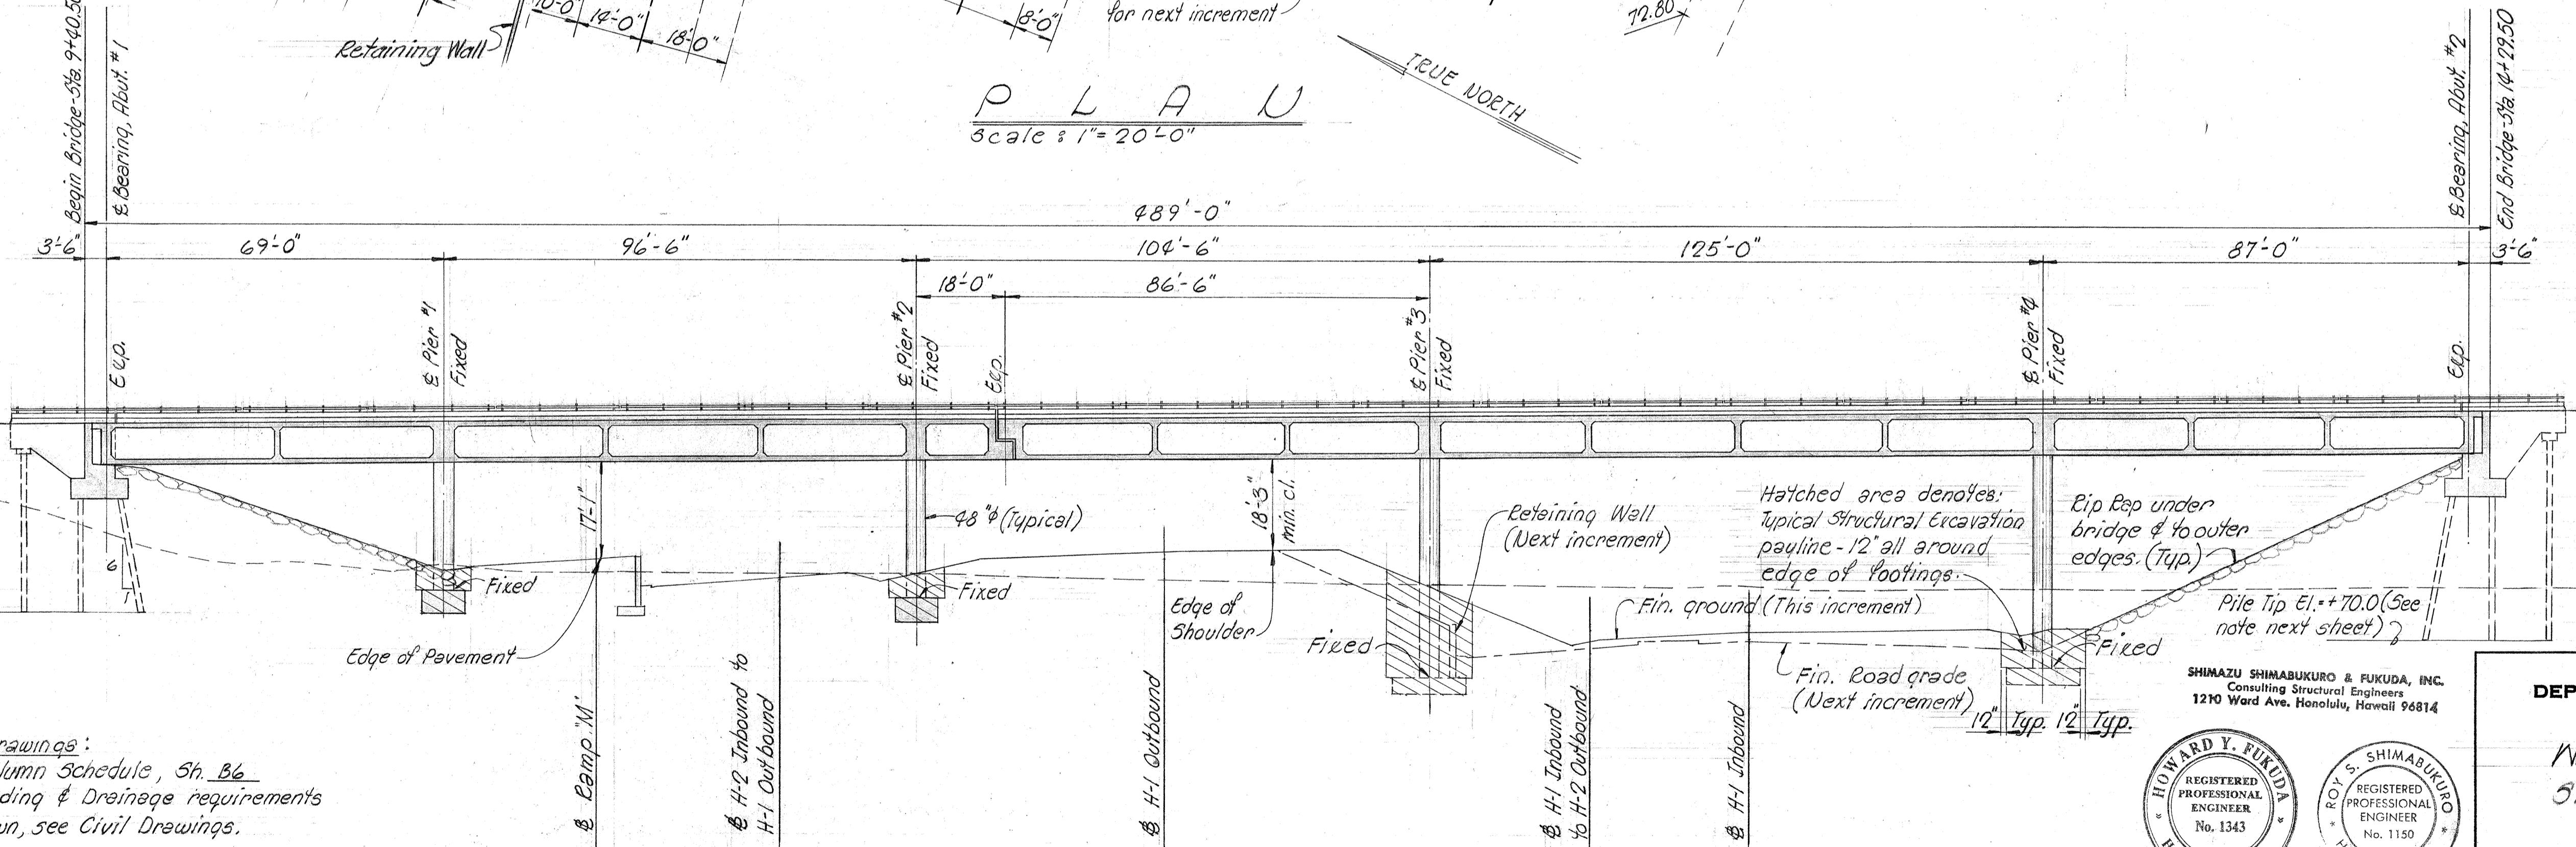


NOTE "A" (Construction Notes)

- Hatched portion of Bridge 4a shall be built at a later stage than the rest of the bridges.
- Shorings shall be arranged so that H-1 Inbound & H-1 Outbound can be paved without removing shorings.
- Shorings for Bridge 4a from Abut. #1 to expansion hinge shall remain in place until the entire bridge is cured as per specs. Shorings under the expansion hinge shall be able to carry the load from the 3rd span.


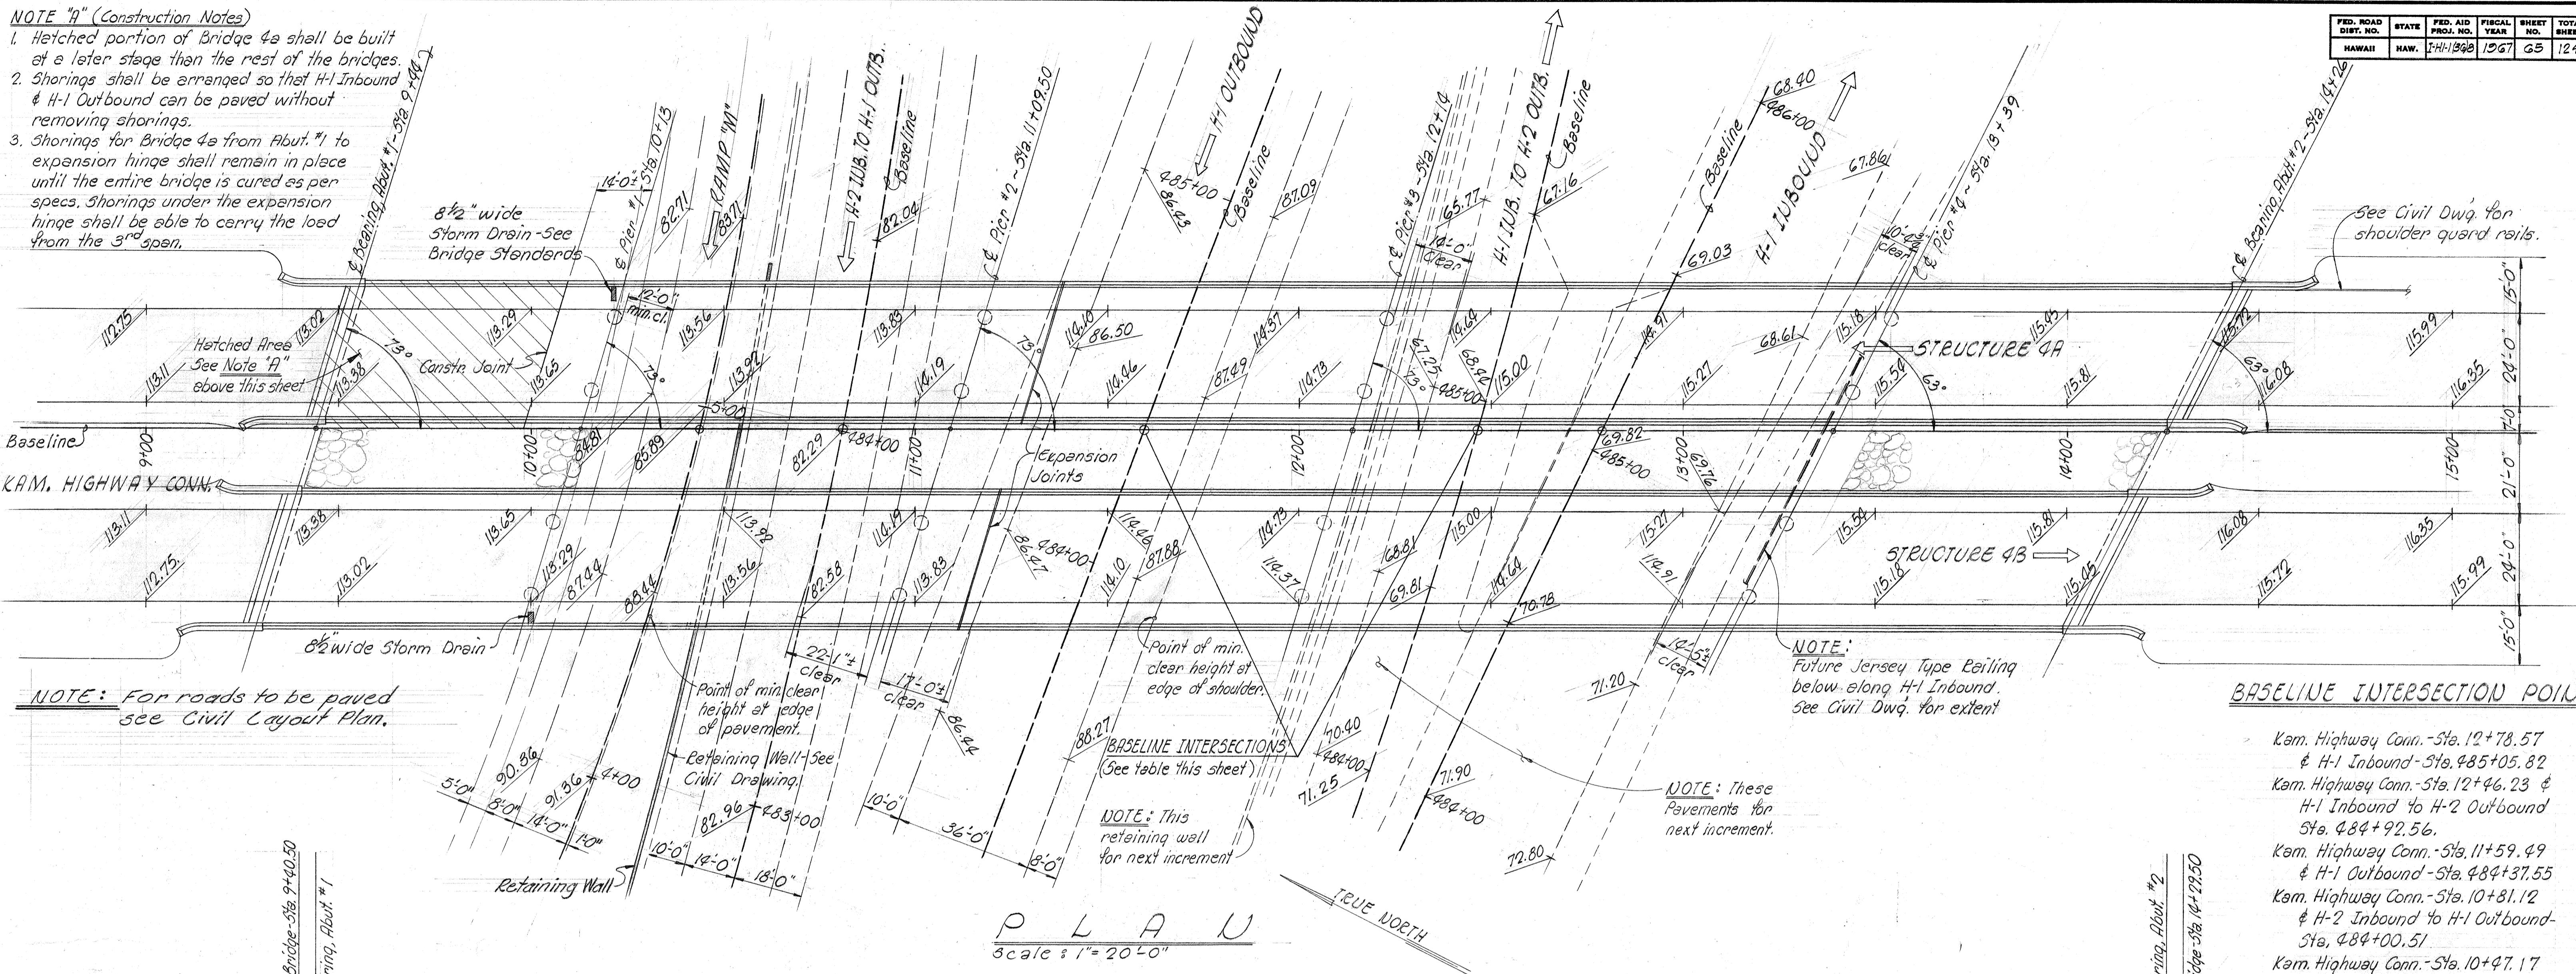


Reference Drawings:

- Pier Column Schedule, Sh. B6
- For Grading & Drainage requirements not shown, see Civil Drawings.

SECTION PROJECTED ALONG

Scale: 1" = 20'-0"

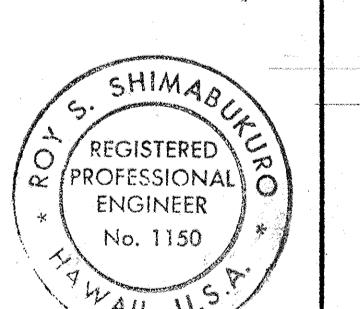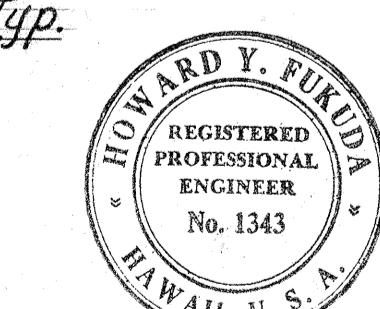SHIMAZU SHIMABUKURO & FUKUDA, INC.
Consulting Structural Engineers
1210 Ward Ave, Honolulu, Hawaii 96814


This work was prepared by
me or under my supervision.
Howard Y. Fukada

STATE OF HAWAII
DEPARTMENT OF TRANSPORTATION
HIGHWAYS DIVISIONNAIAWA INTERCHANGE
STRUCTURE NO. 4A & 4B

F.A.I. PROJ. NO. I-H-1 (3G)8

Scale: As Shown Date:

SHEET NO. B1 OF 25 SHEETS

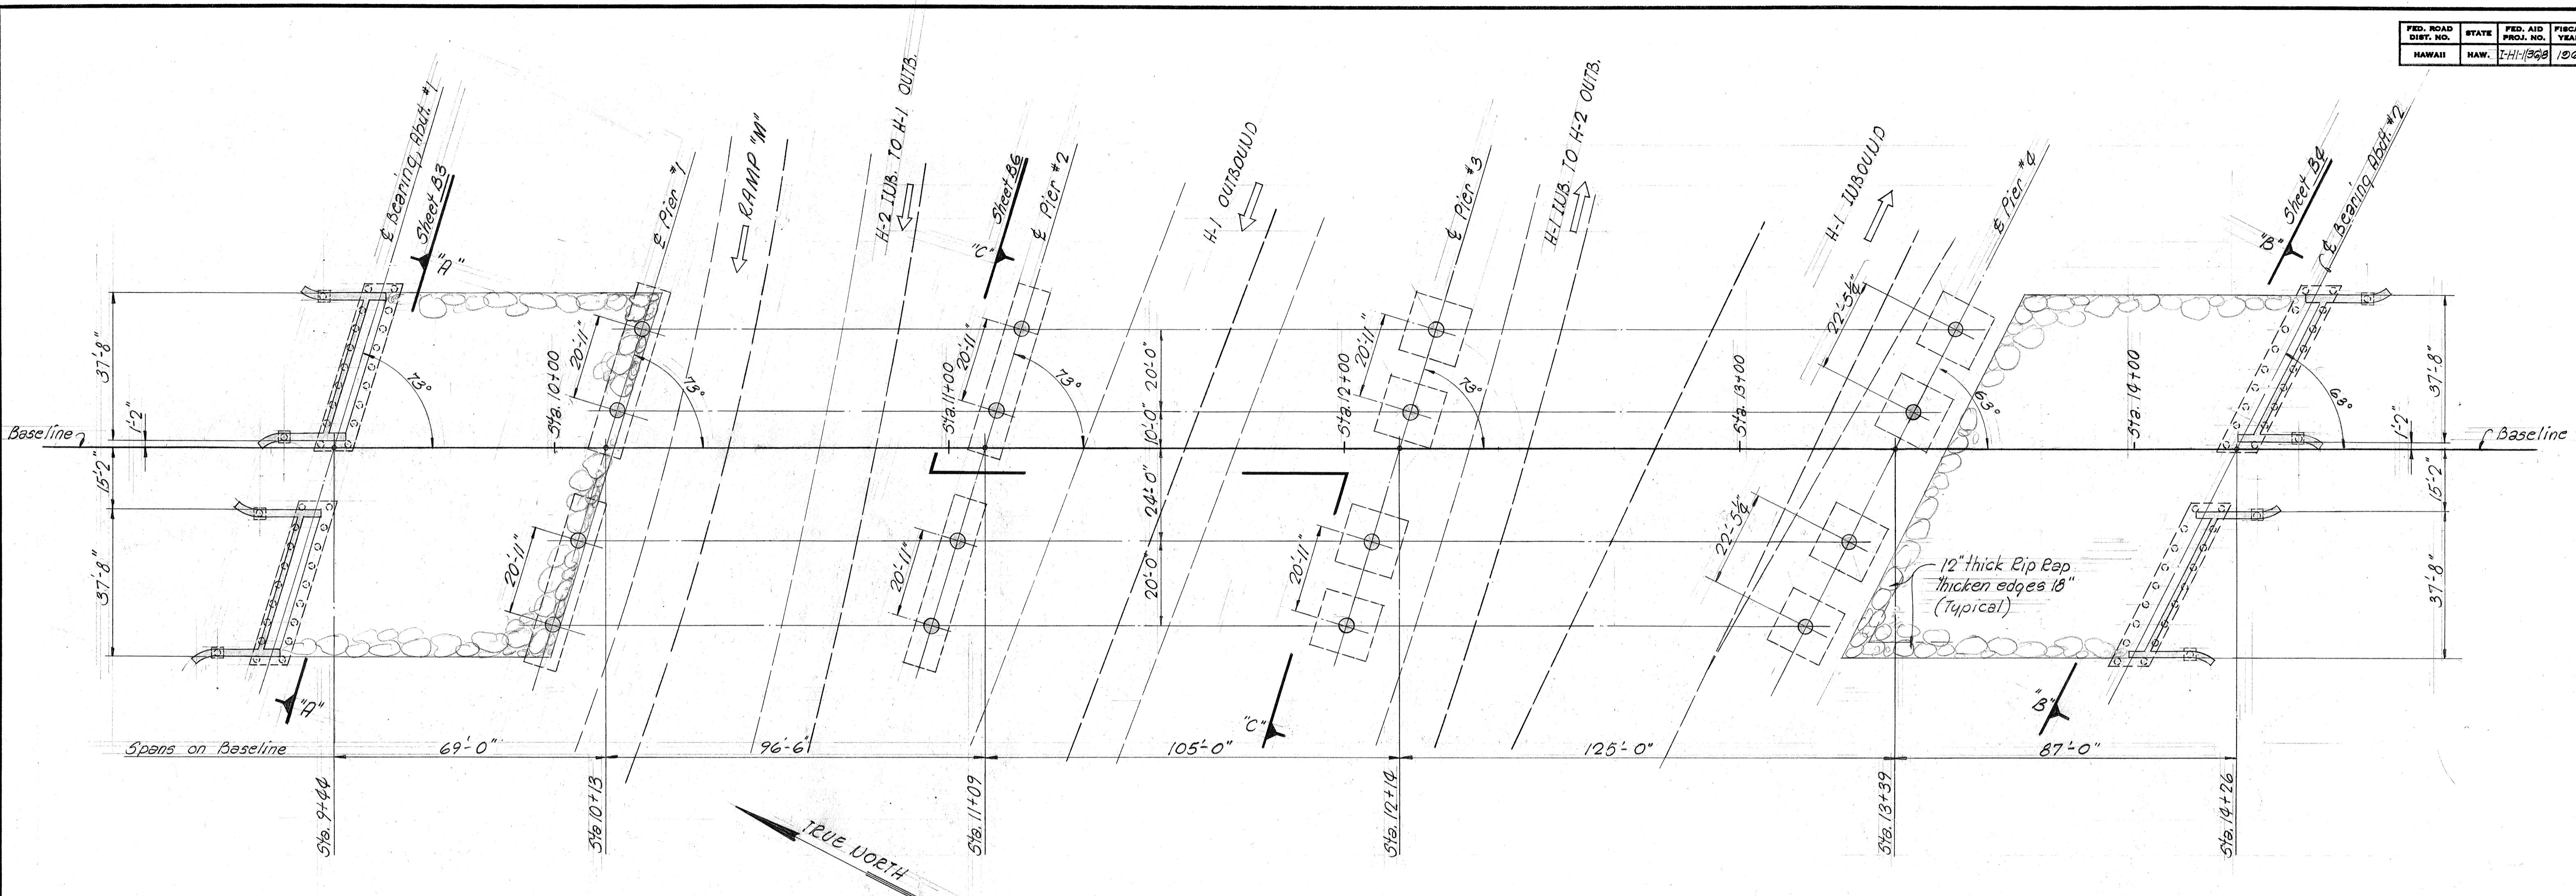

FOUNDATION LAYOUT PLAN

Scale: 1" = 20'-0"

NOTES:

- For General Notes, See Sh. 510.
- In general, bridge superstructure shall be constructed to follow the finished roadway.
- Construction methods:
 - Sides of footings shall be excavated to nest lines when called for on plans. Over excavation below elevations indicated on the plans for bottom of footings shall be backfilled with a minimum of class D concrete as directed by the Engineer at the Contractors' expense.
 - Backfill behind abutments of structures #2 & #6 shall be complete in place before pouring of superstructure.
 - Obtain camber by forming and shoring concrete surface above profile grade by amount shown on camber diagram.
 - Backfill against wingwall shall be carried out in such a manner that the differential of soil on each side of the wall shall not exceed 2'-0" at any time.
- See also Civil and Electrical Sheets for items not shown.

REFERENCE DRAWINGS

- Abutment #1 Foundation, Sh. B3
- Abutment #2 Foundation, Sh. B4
- Pier Column Foundation, Sh. B5

DESIGN CRITERIA



Loading = H 20 - S16

Allowable Foundation Pressure

Pier #1	= 5,000 p.s.f. (Group I)
Pier #2	= 5,000 "
Pier #3	= 5,000 "
Pier #4	= 5,000 "

Pile Capacity = 32 Tons
Pile Size = 16" Octagonal

SHIMAZU SHIMABUKURO & FUKUDA, INC.
Consulting Structural Engineers
1210 Ward Ave. Honolulu, Hawaii 96814

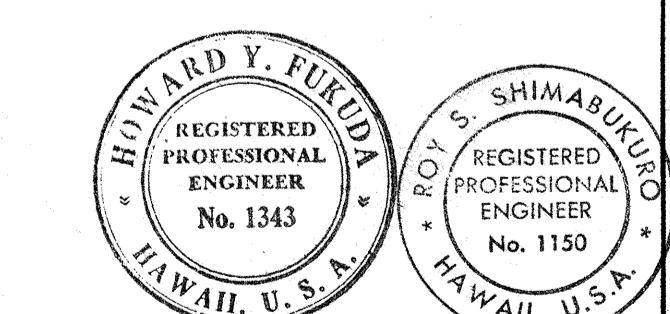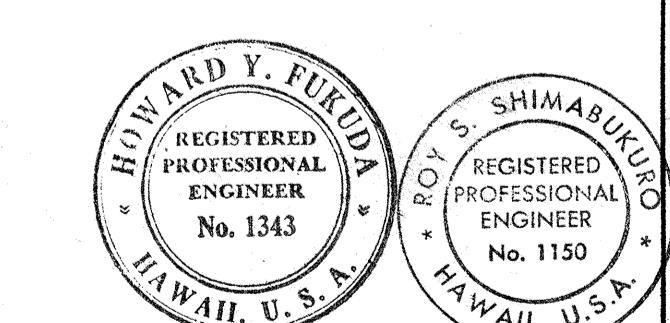


STATE OF HAWAII
DEPARTMENT OF TRANSPORTATION
HIGHWAYS DIVISION
WAIAWA INTERCHANGE
STRUCTURE No. 4A & 4B



F. A. I. Proj. No. I-HI-1 (36)8
Scale: As Shown Date:

SHEET No. B2 OF 25 SHEETS


This work was prepared by
me or under my supervision.
Howard Y. Fukuda

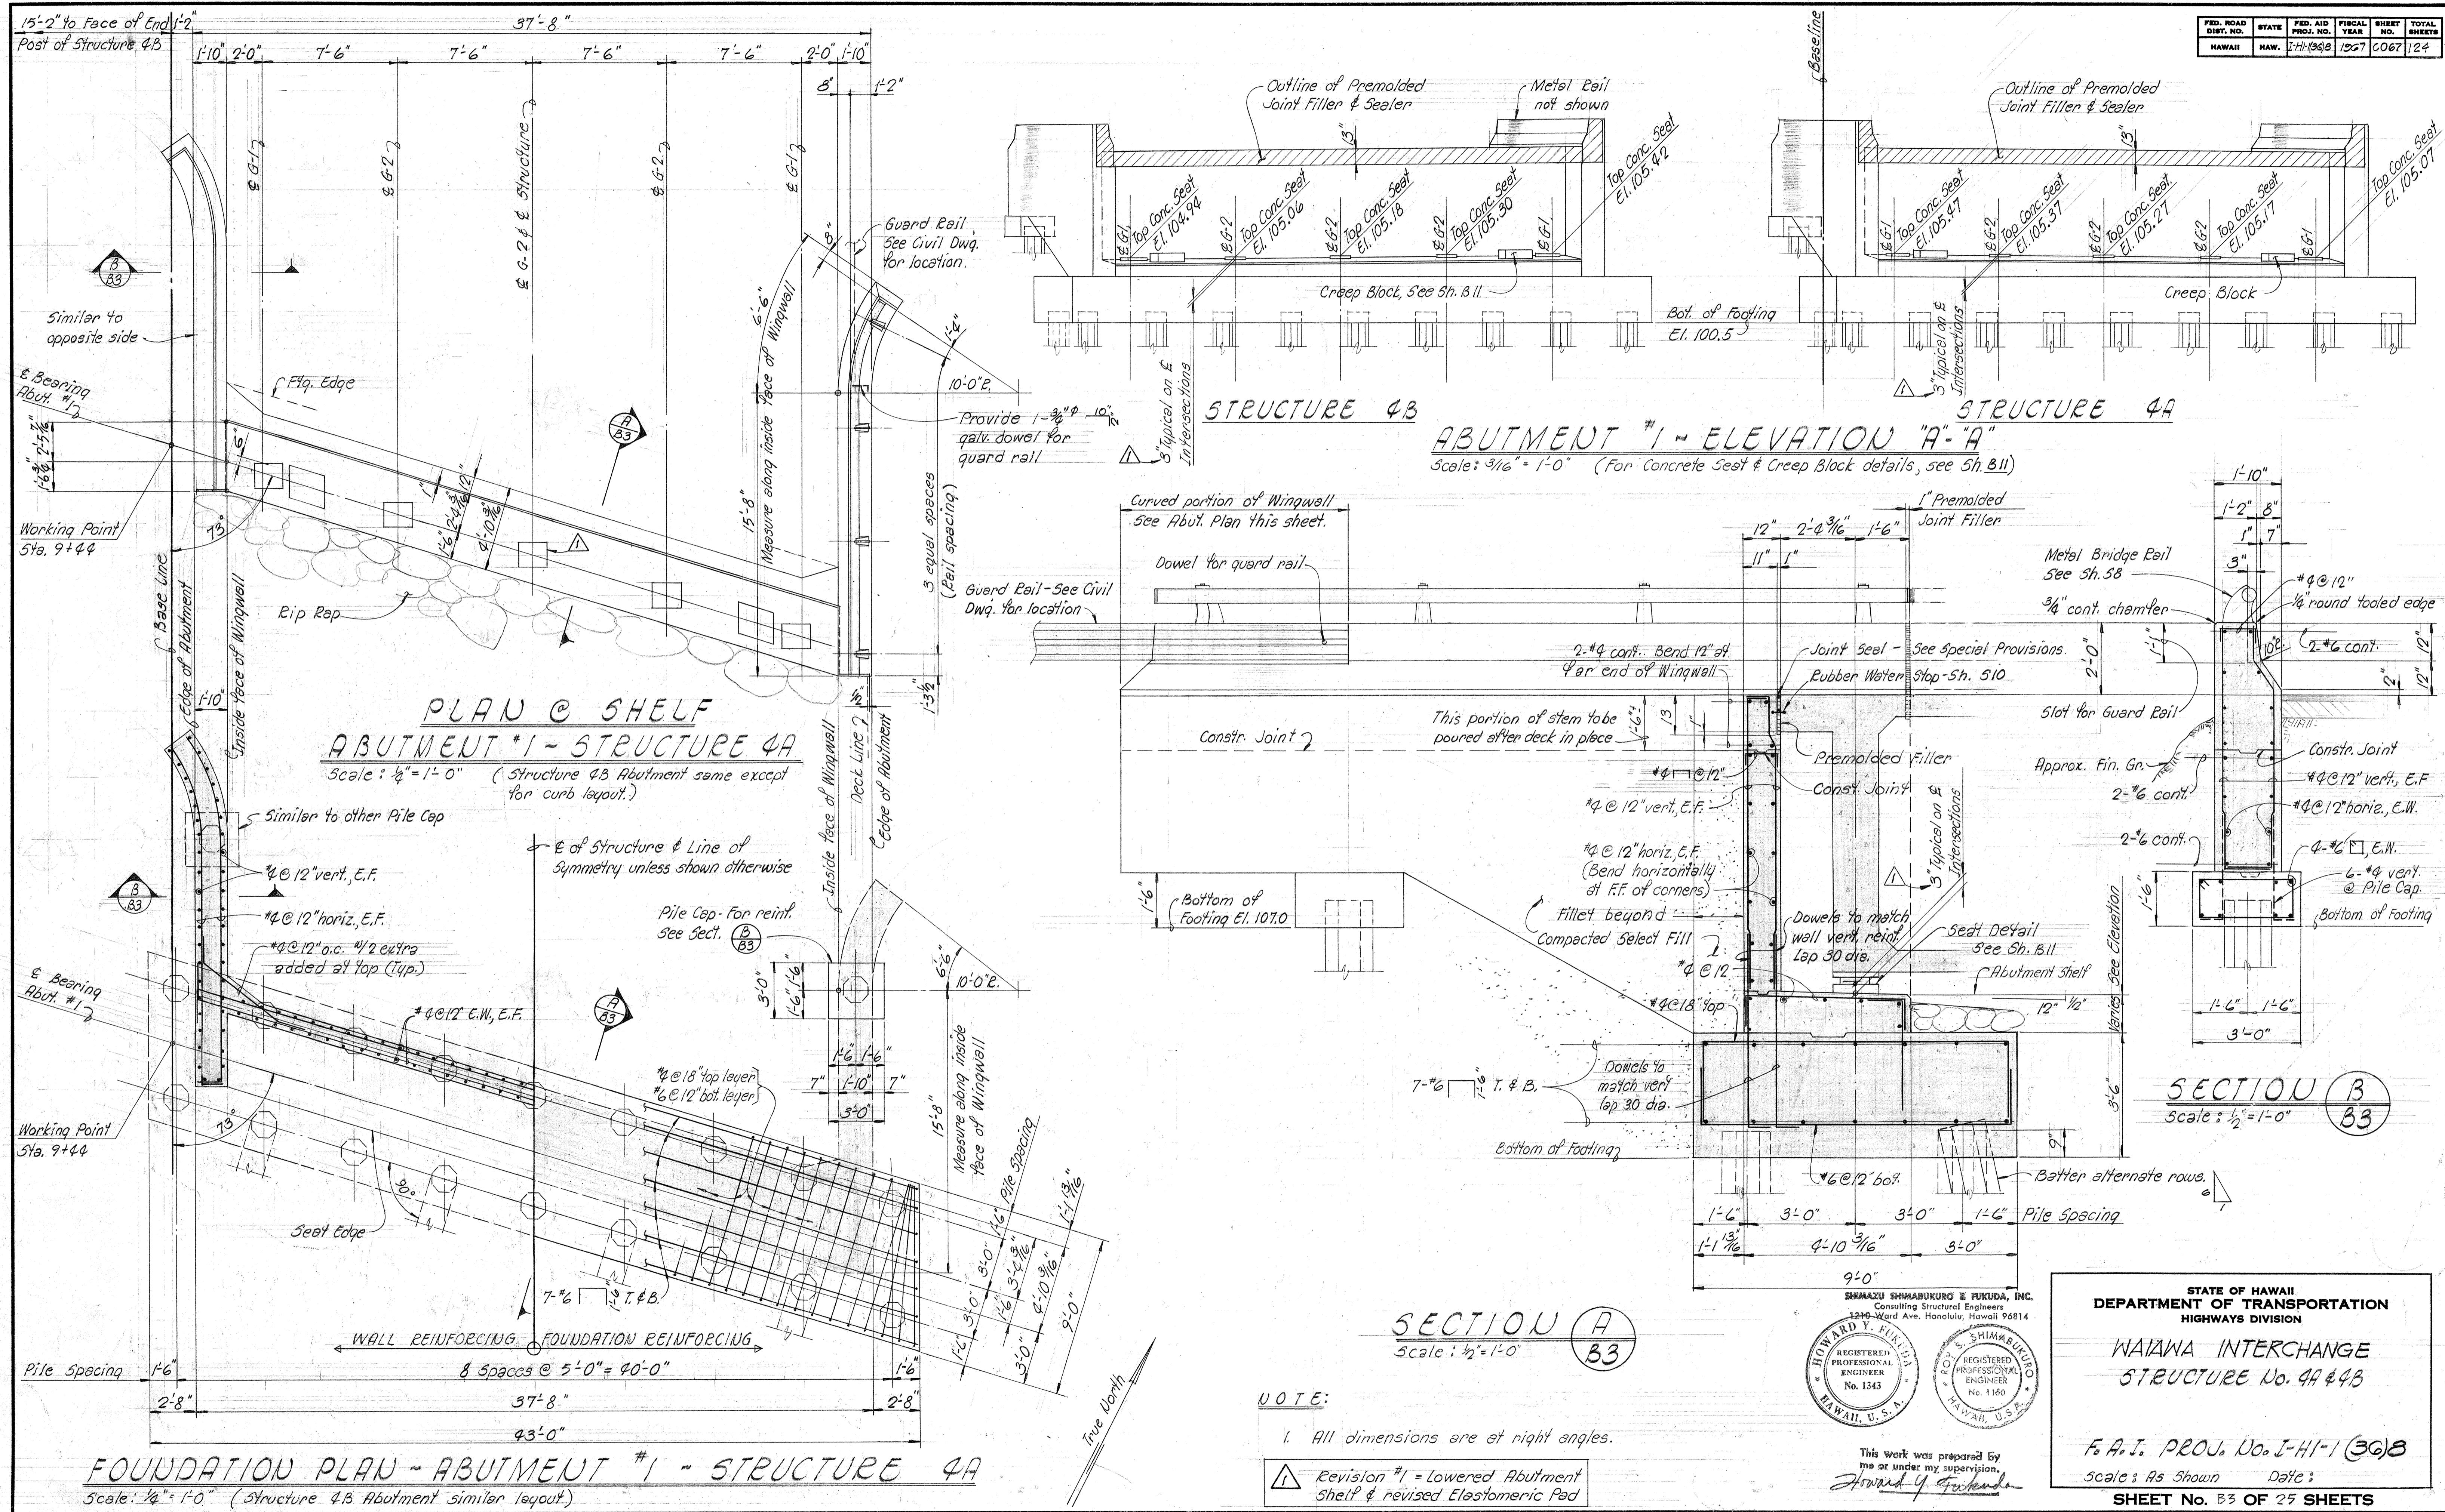


FED. ROAD DIST. NO.	STATE	FED. AID. NO.	FISCAL YEAR	SHEET NO.	TOTAL SHEETS
HAWAII	HAW.	I-HI-368	1967	0067	124

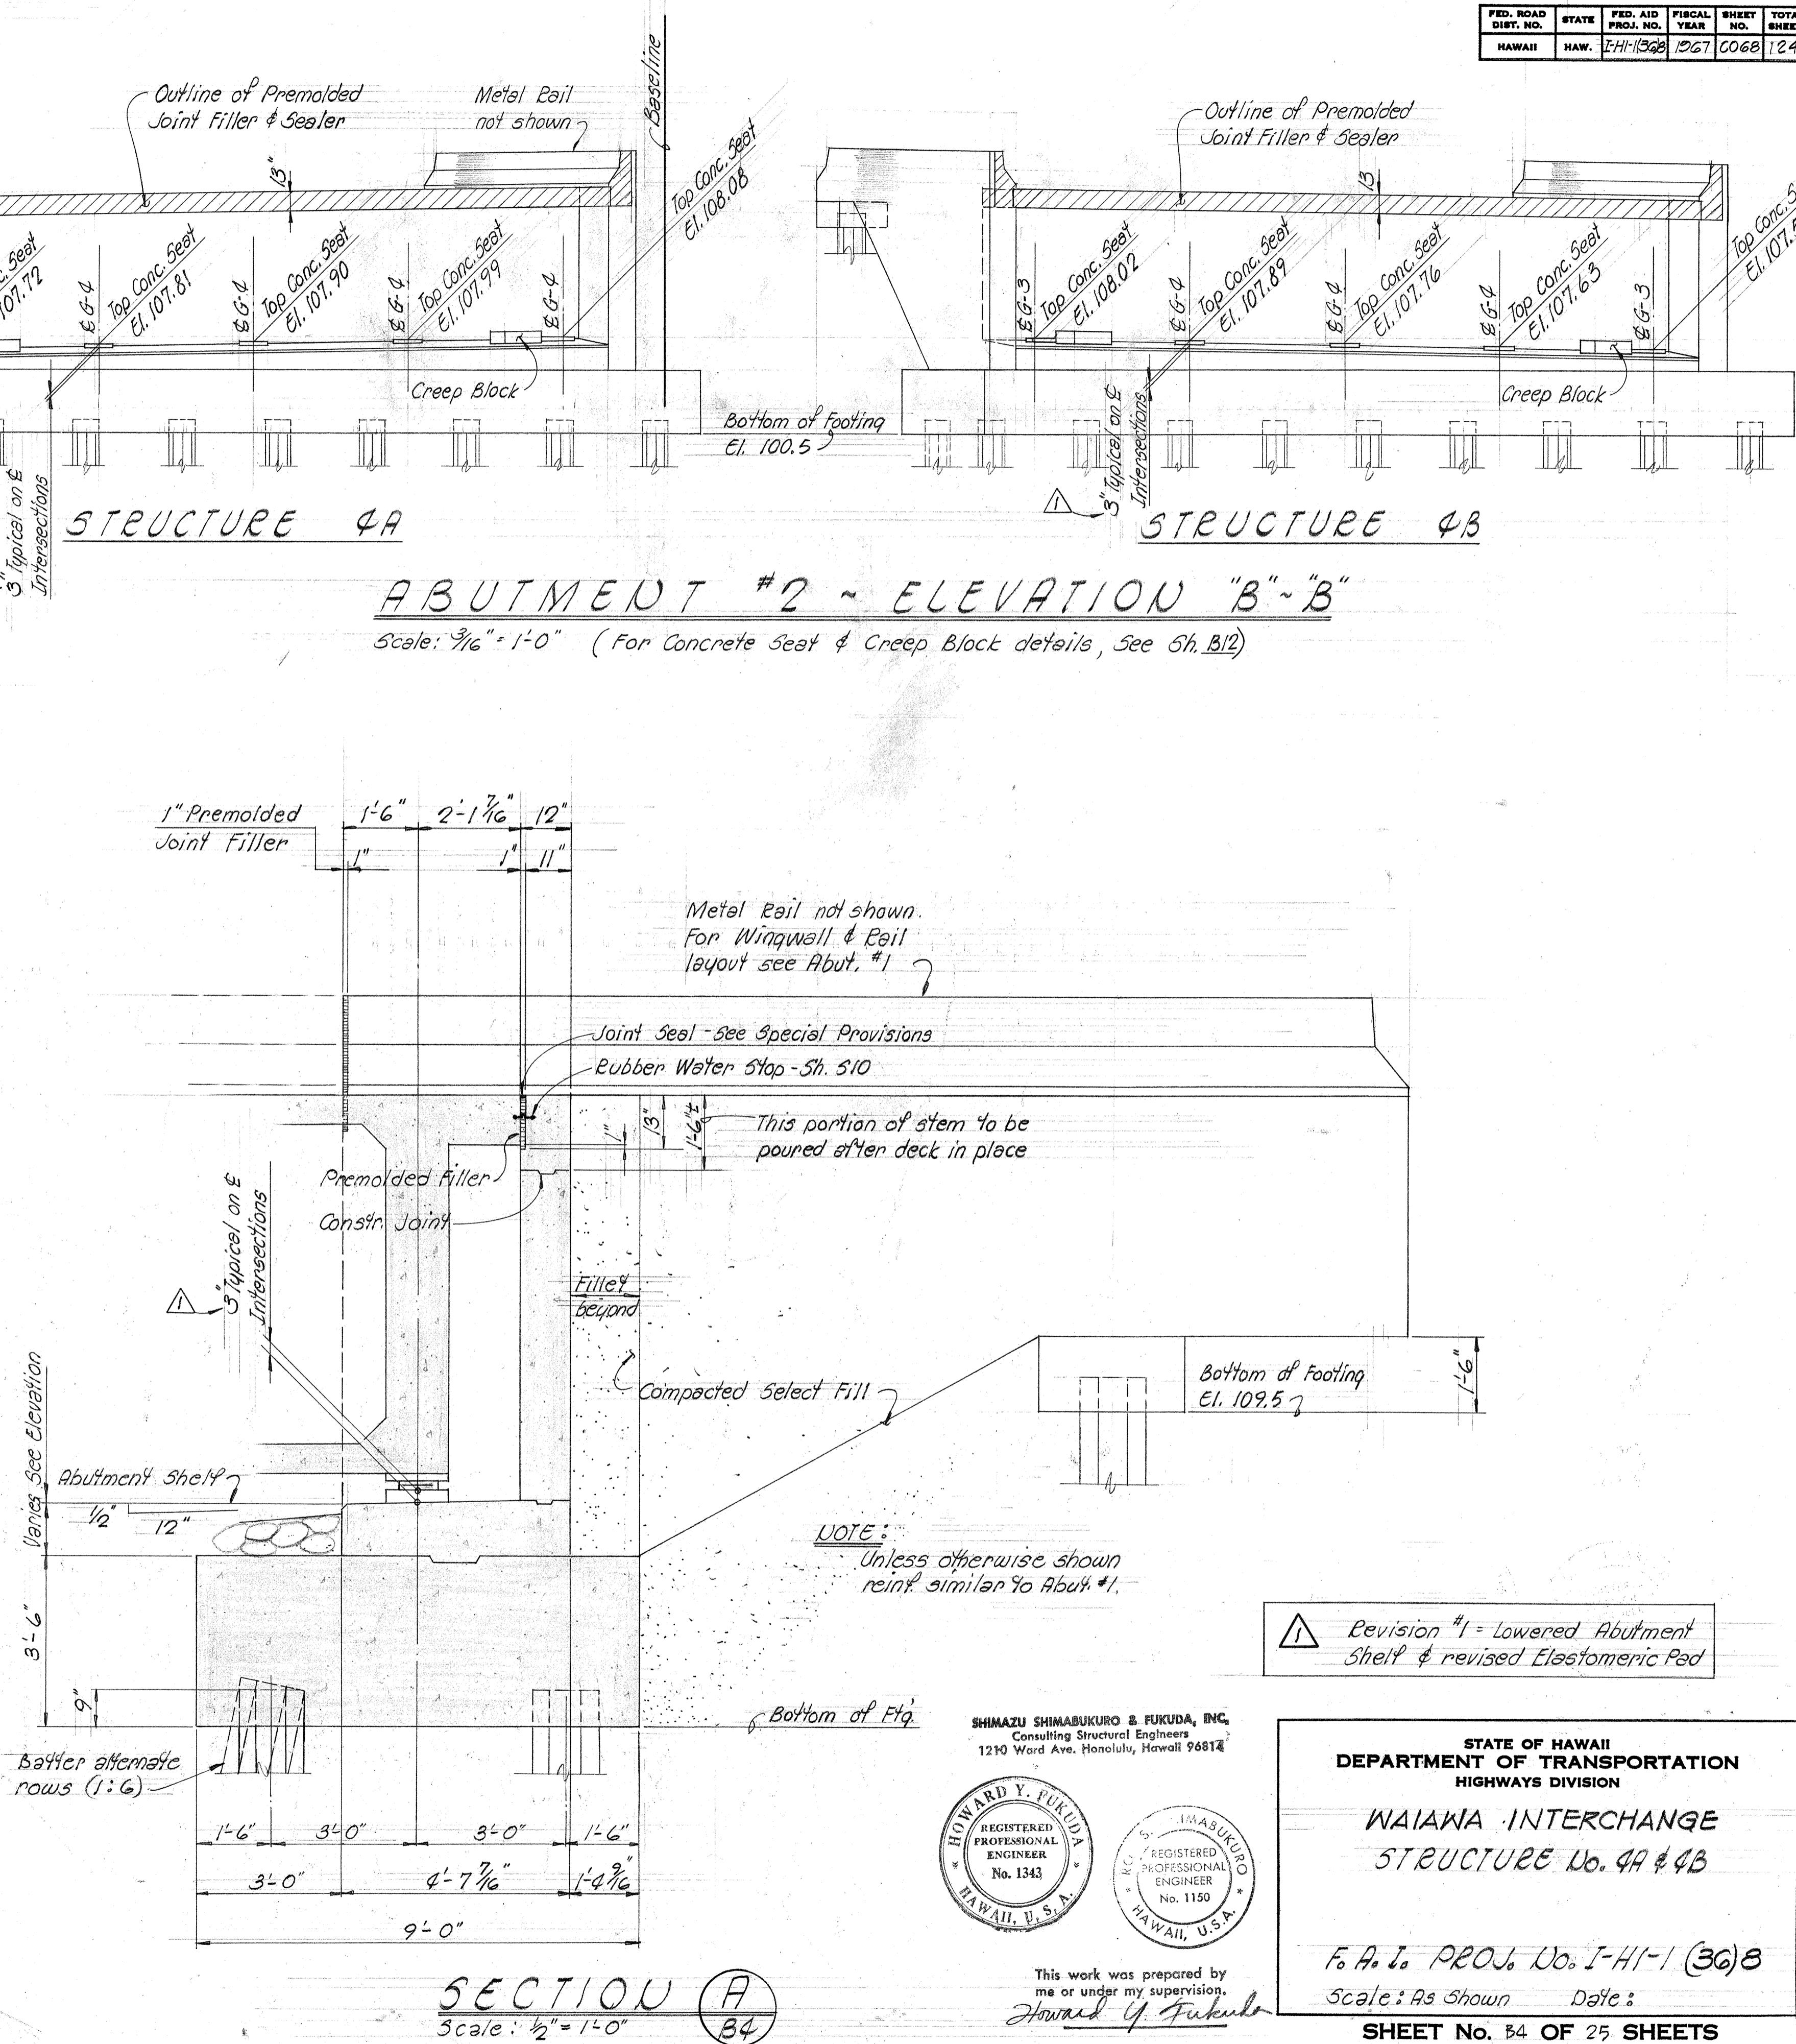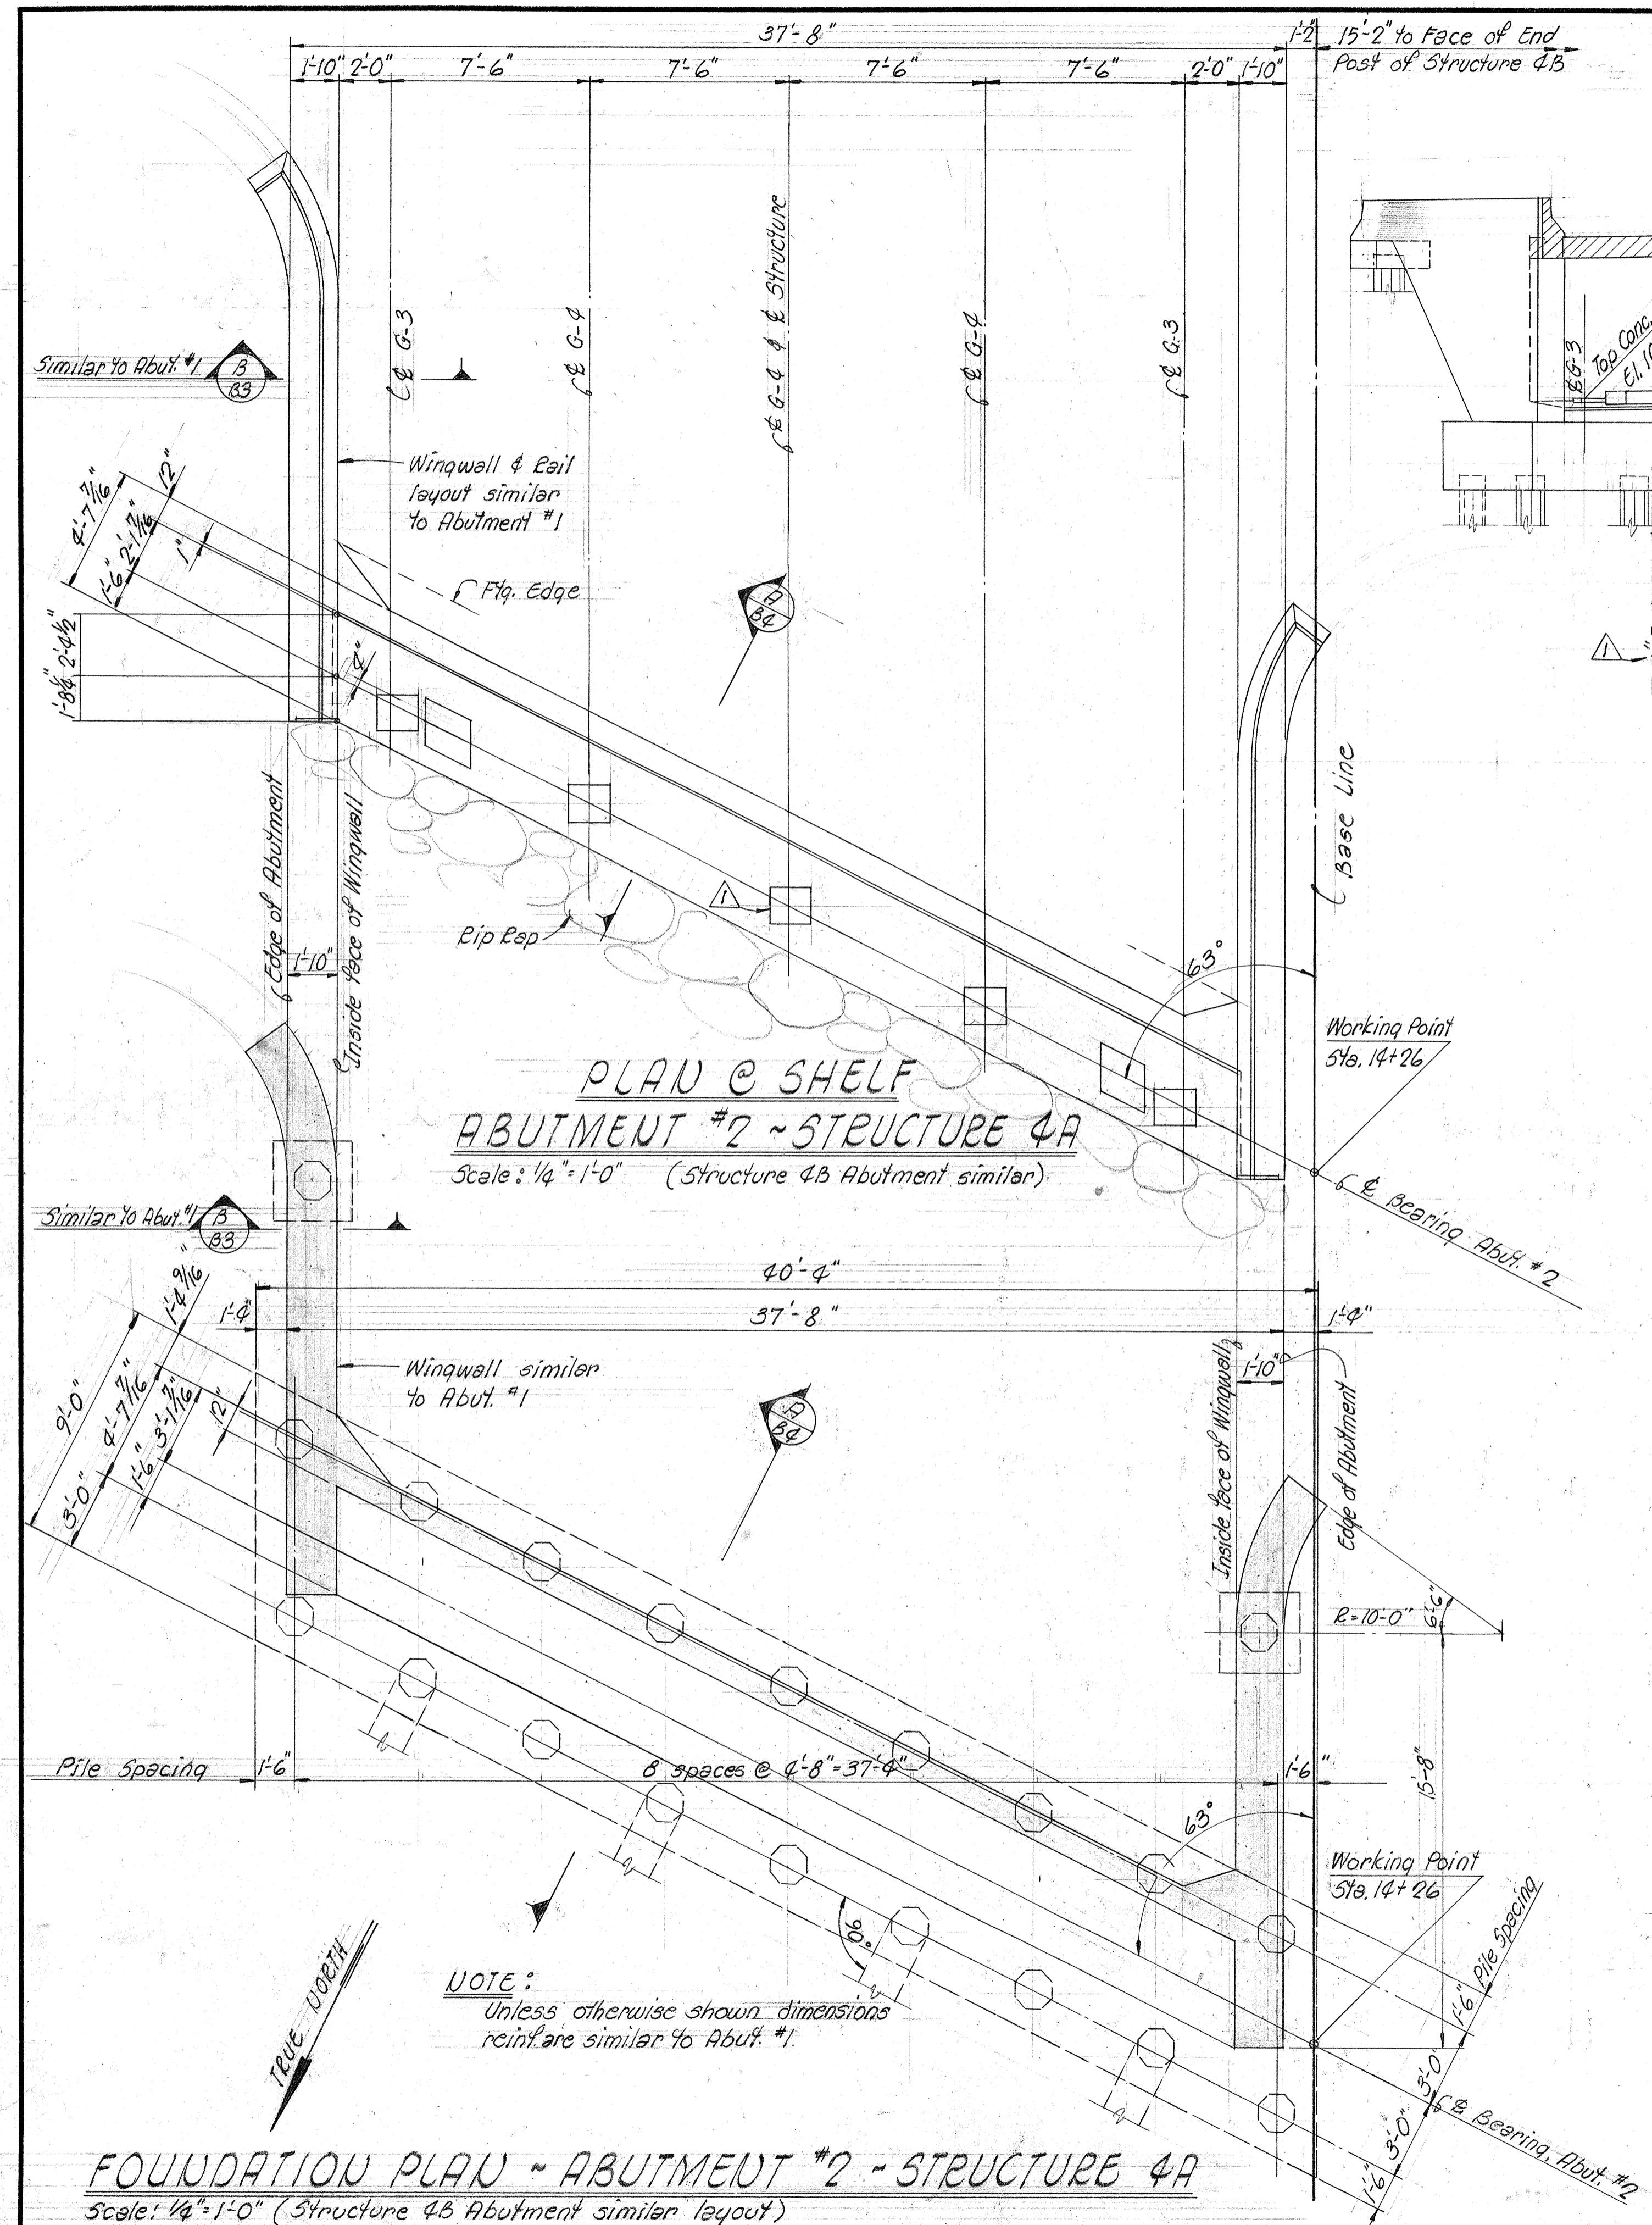

FED. ROAD DIST. NO.	STATE	FED. AID PROJ. NO.	FISCAL YEAR	SHEET NO.	TOTAL SHEETS
HAWAII	HAW.	I-HI-1(308)	1967	60	124

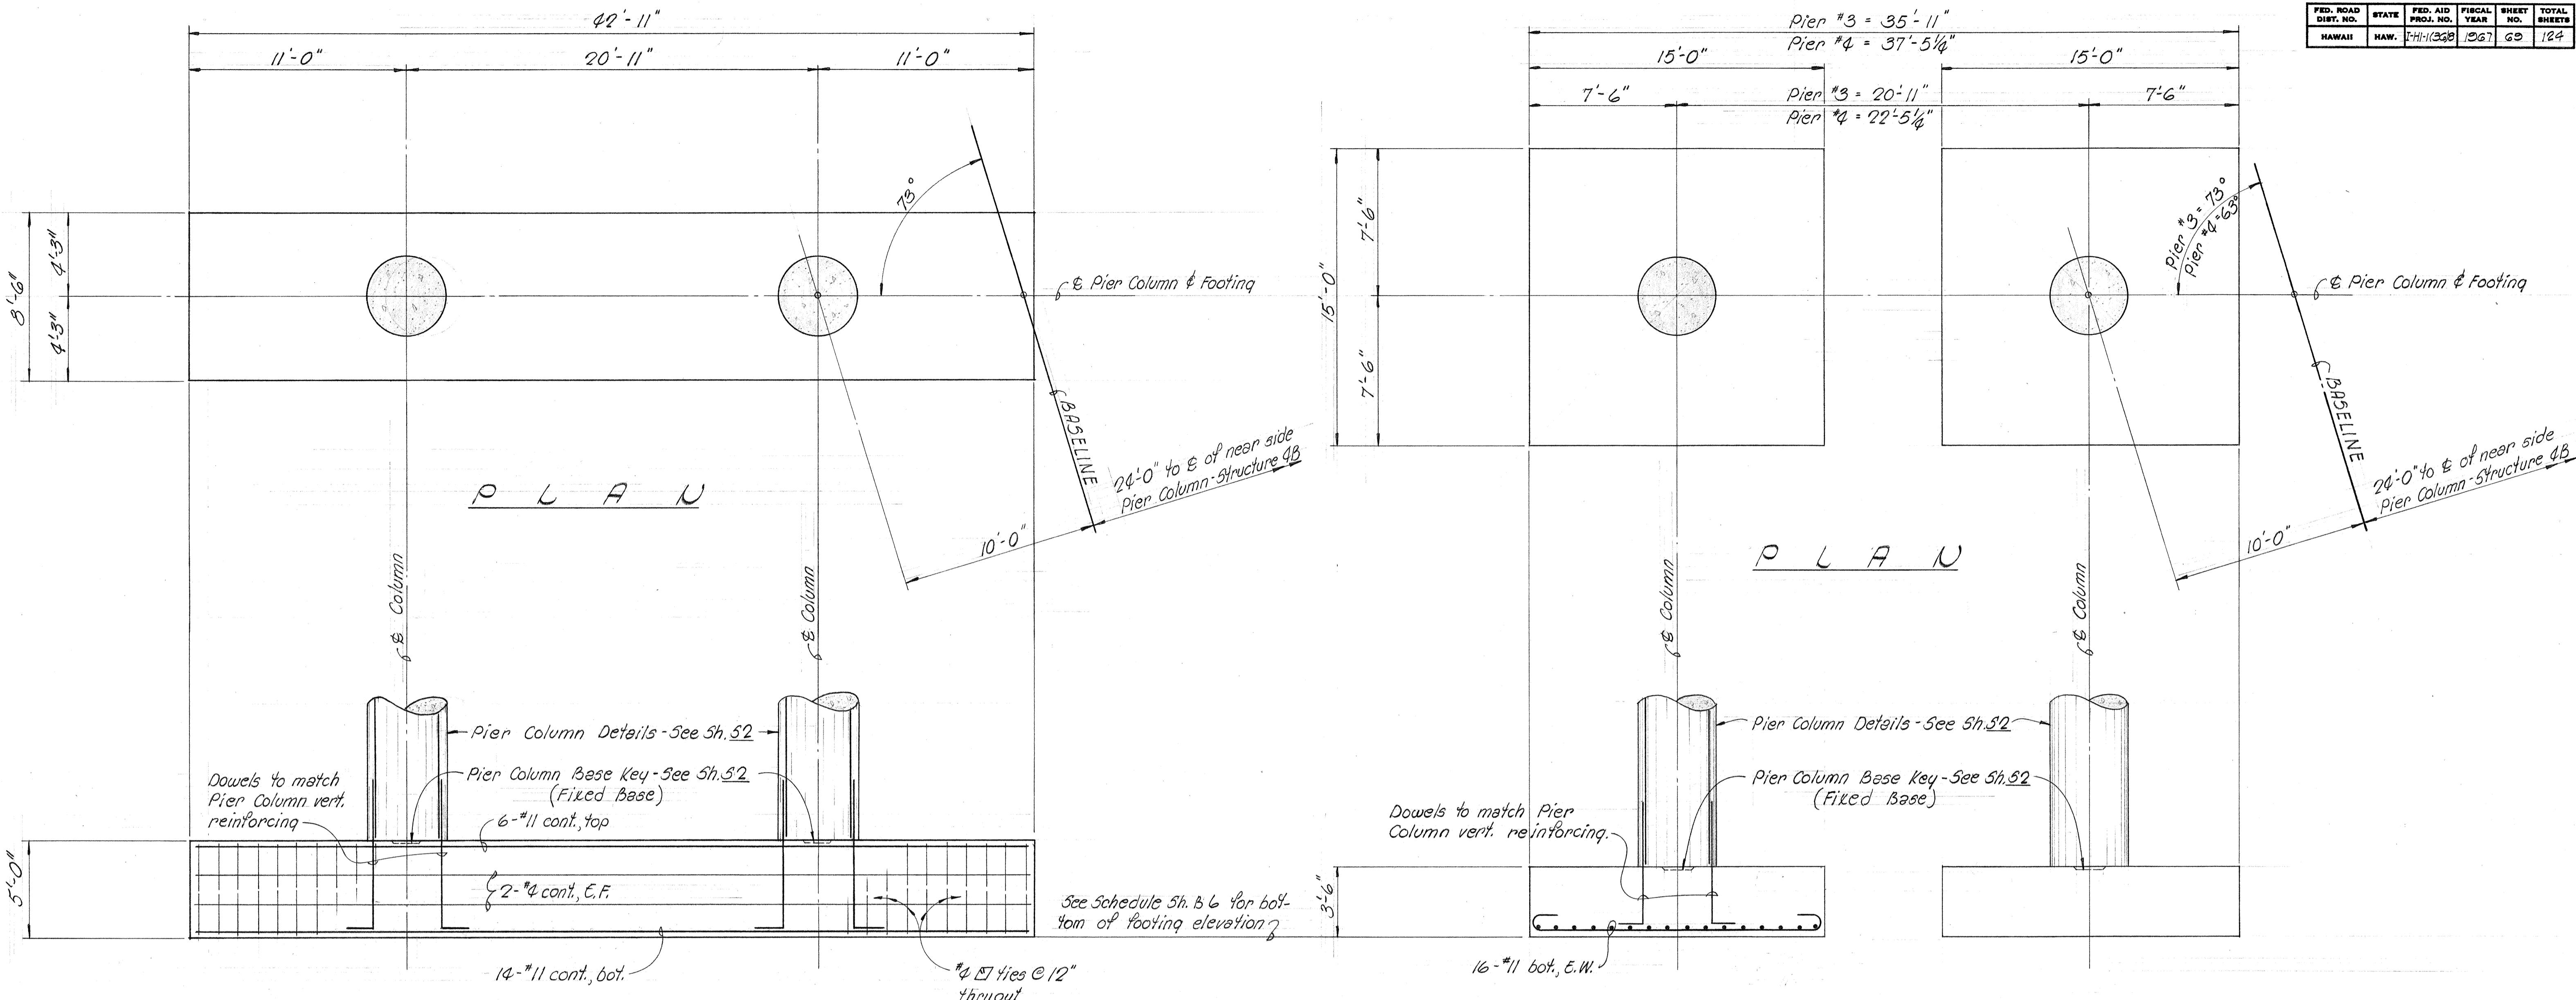

E L E V A T I O N

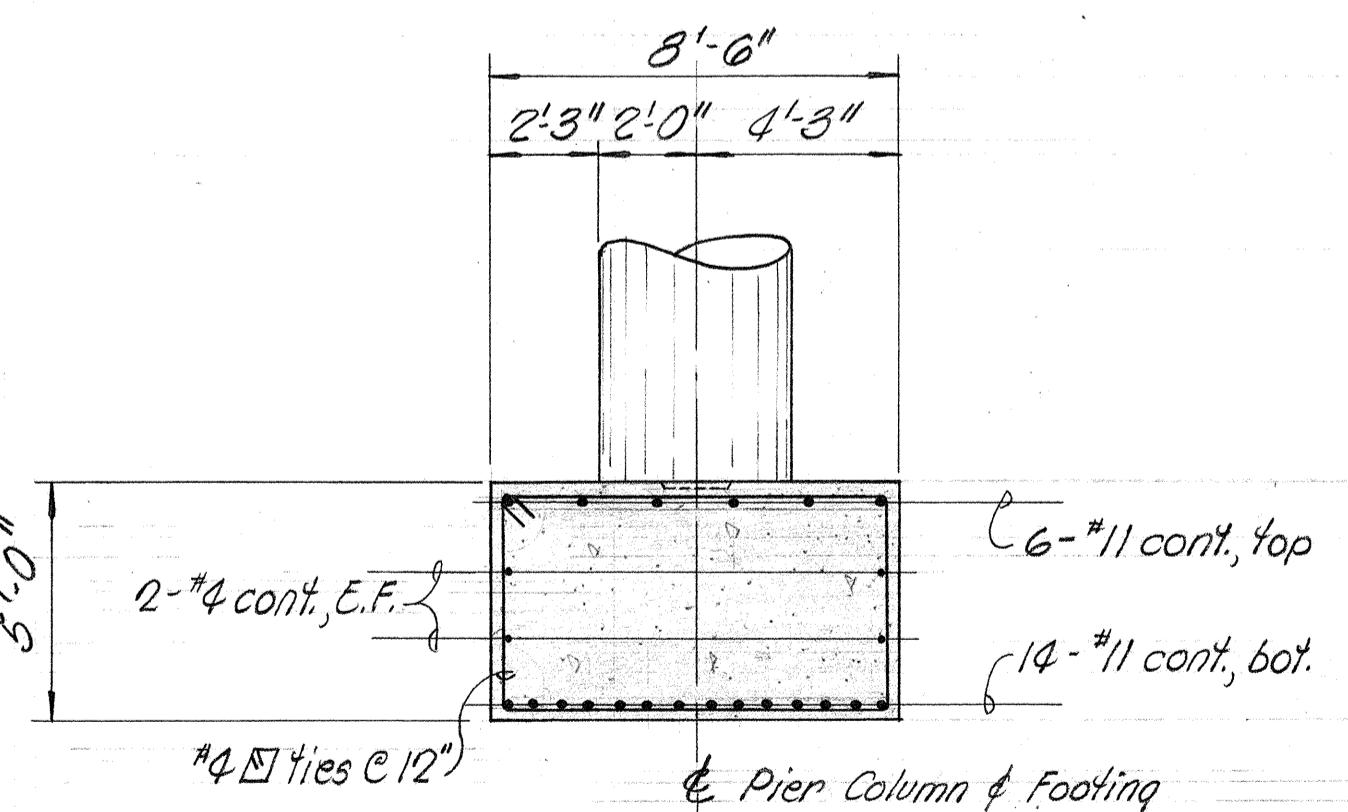

T Y P I C A L S E C T I O N



STRUCTURE 4A PIERS #1 & #2 FOOTING DETAILS

Scale: 1/4" = 1'-0" (Piers 1 & 2 Footing details for structure 4B similar.)

STRUCTURE 4A PIERS #3 & #4 FOOTING DETAILS

Scale: 1/4" = 1'-0" (Piers 3 & 4 Footing details for structure 4B similar.)

SHIMAZU SHIMASUKURO & FUKUDA, INC.
Consulting Structural Engineers
1210 Ward Ave, Honolulu, Hawaii 96814

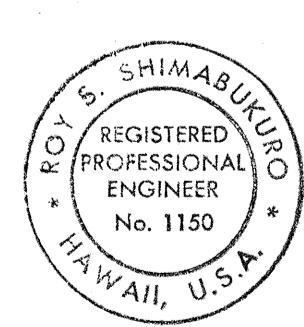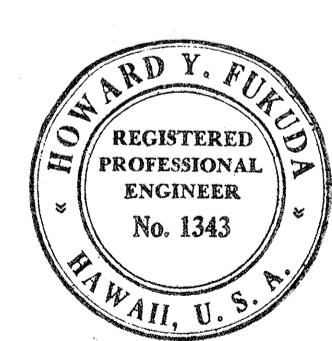

This work was prepared by
me or under my supervision.
Howard Y. Fukuda





STATE OF HAWAII
DEPARTMENT OF TRANSPORTATION
HIGHWAYS DIVISION

WAIAWA INTERCHANGE
STRUCTURE No. 4A & 4B

F.A.I. P2006 Na I-HI-1 (308)

Scale: As Shown Date:

SHEET No. B5 OF 25 SHEETS

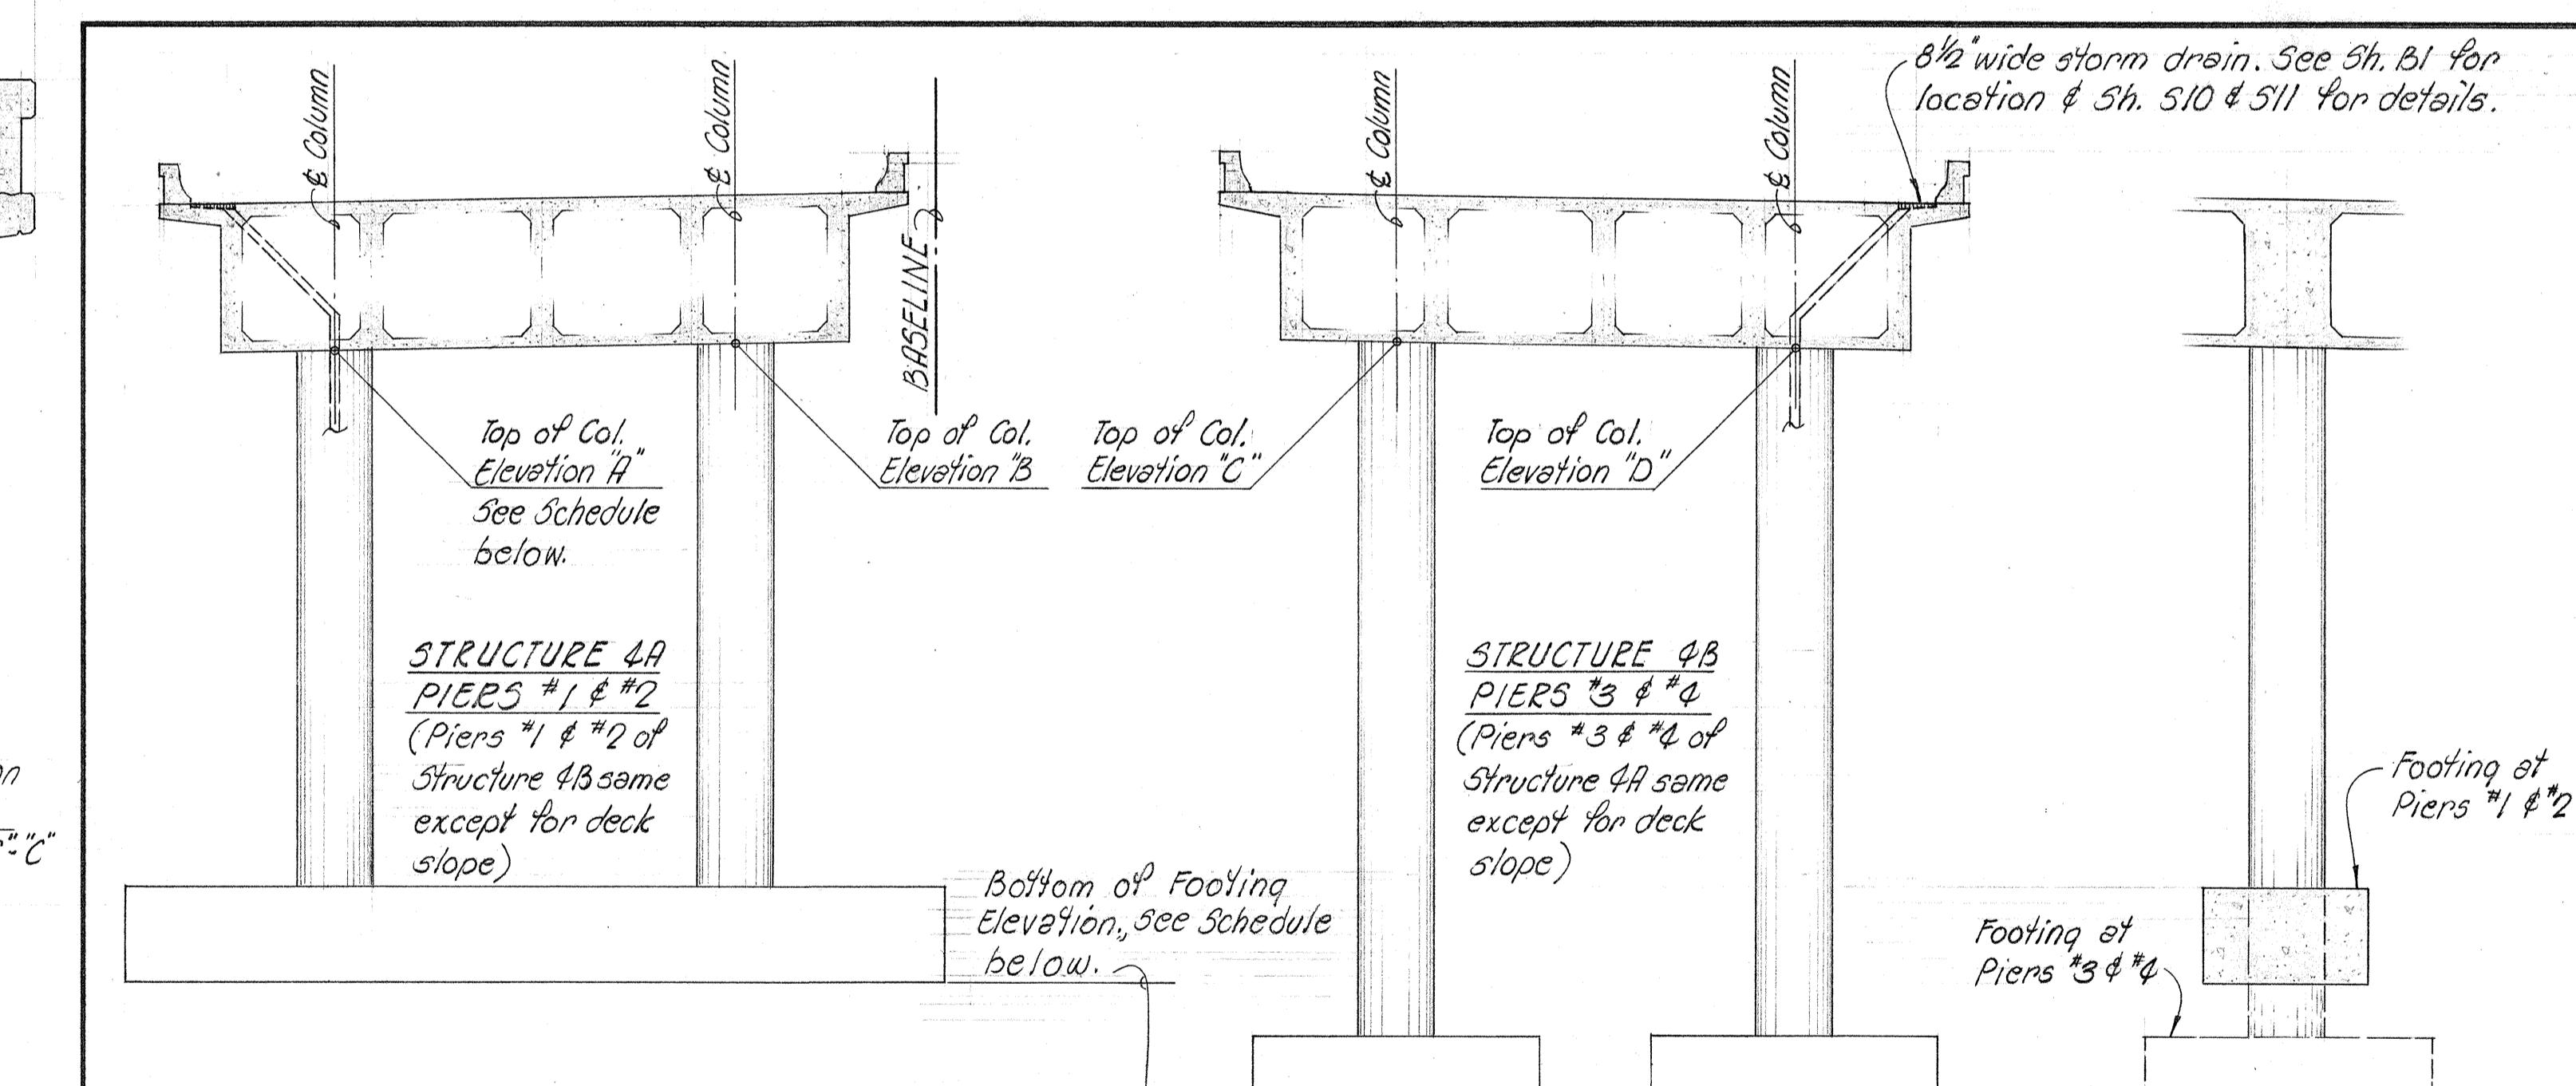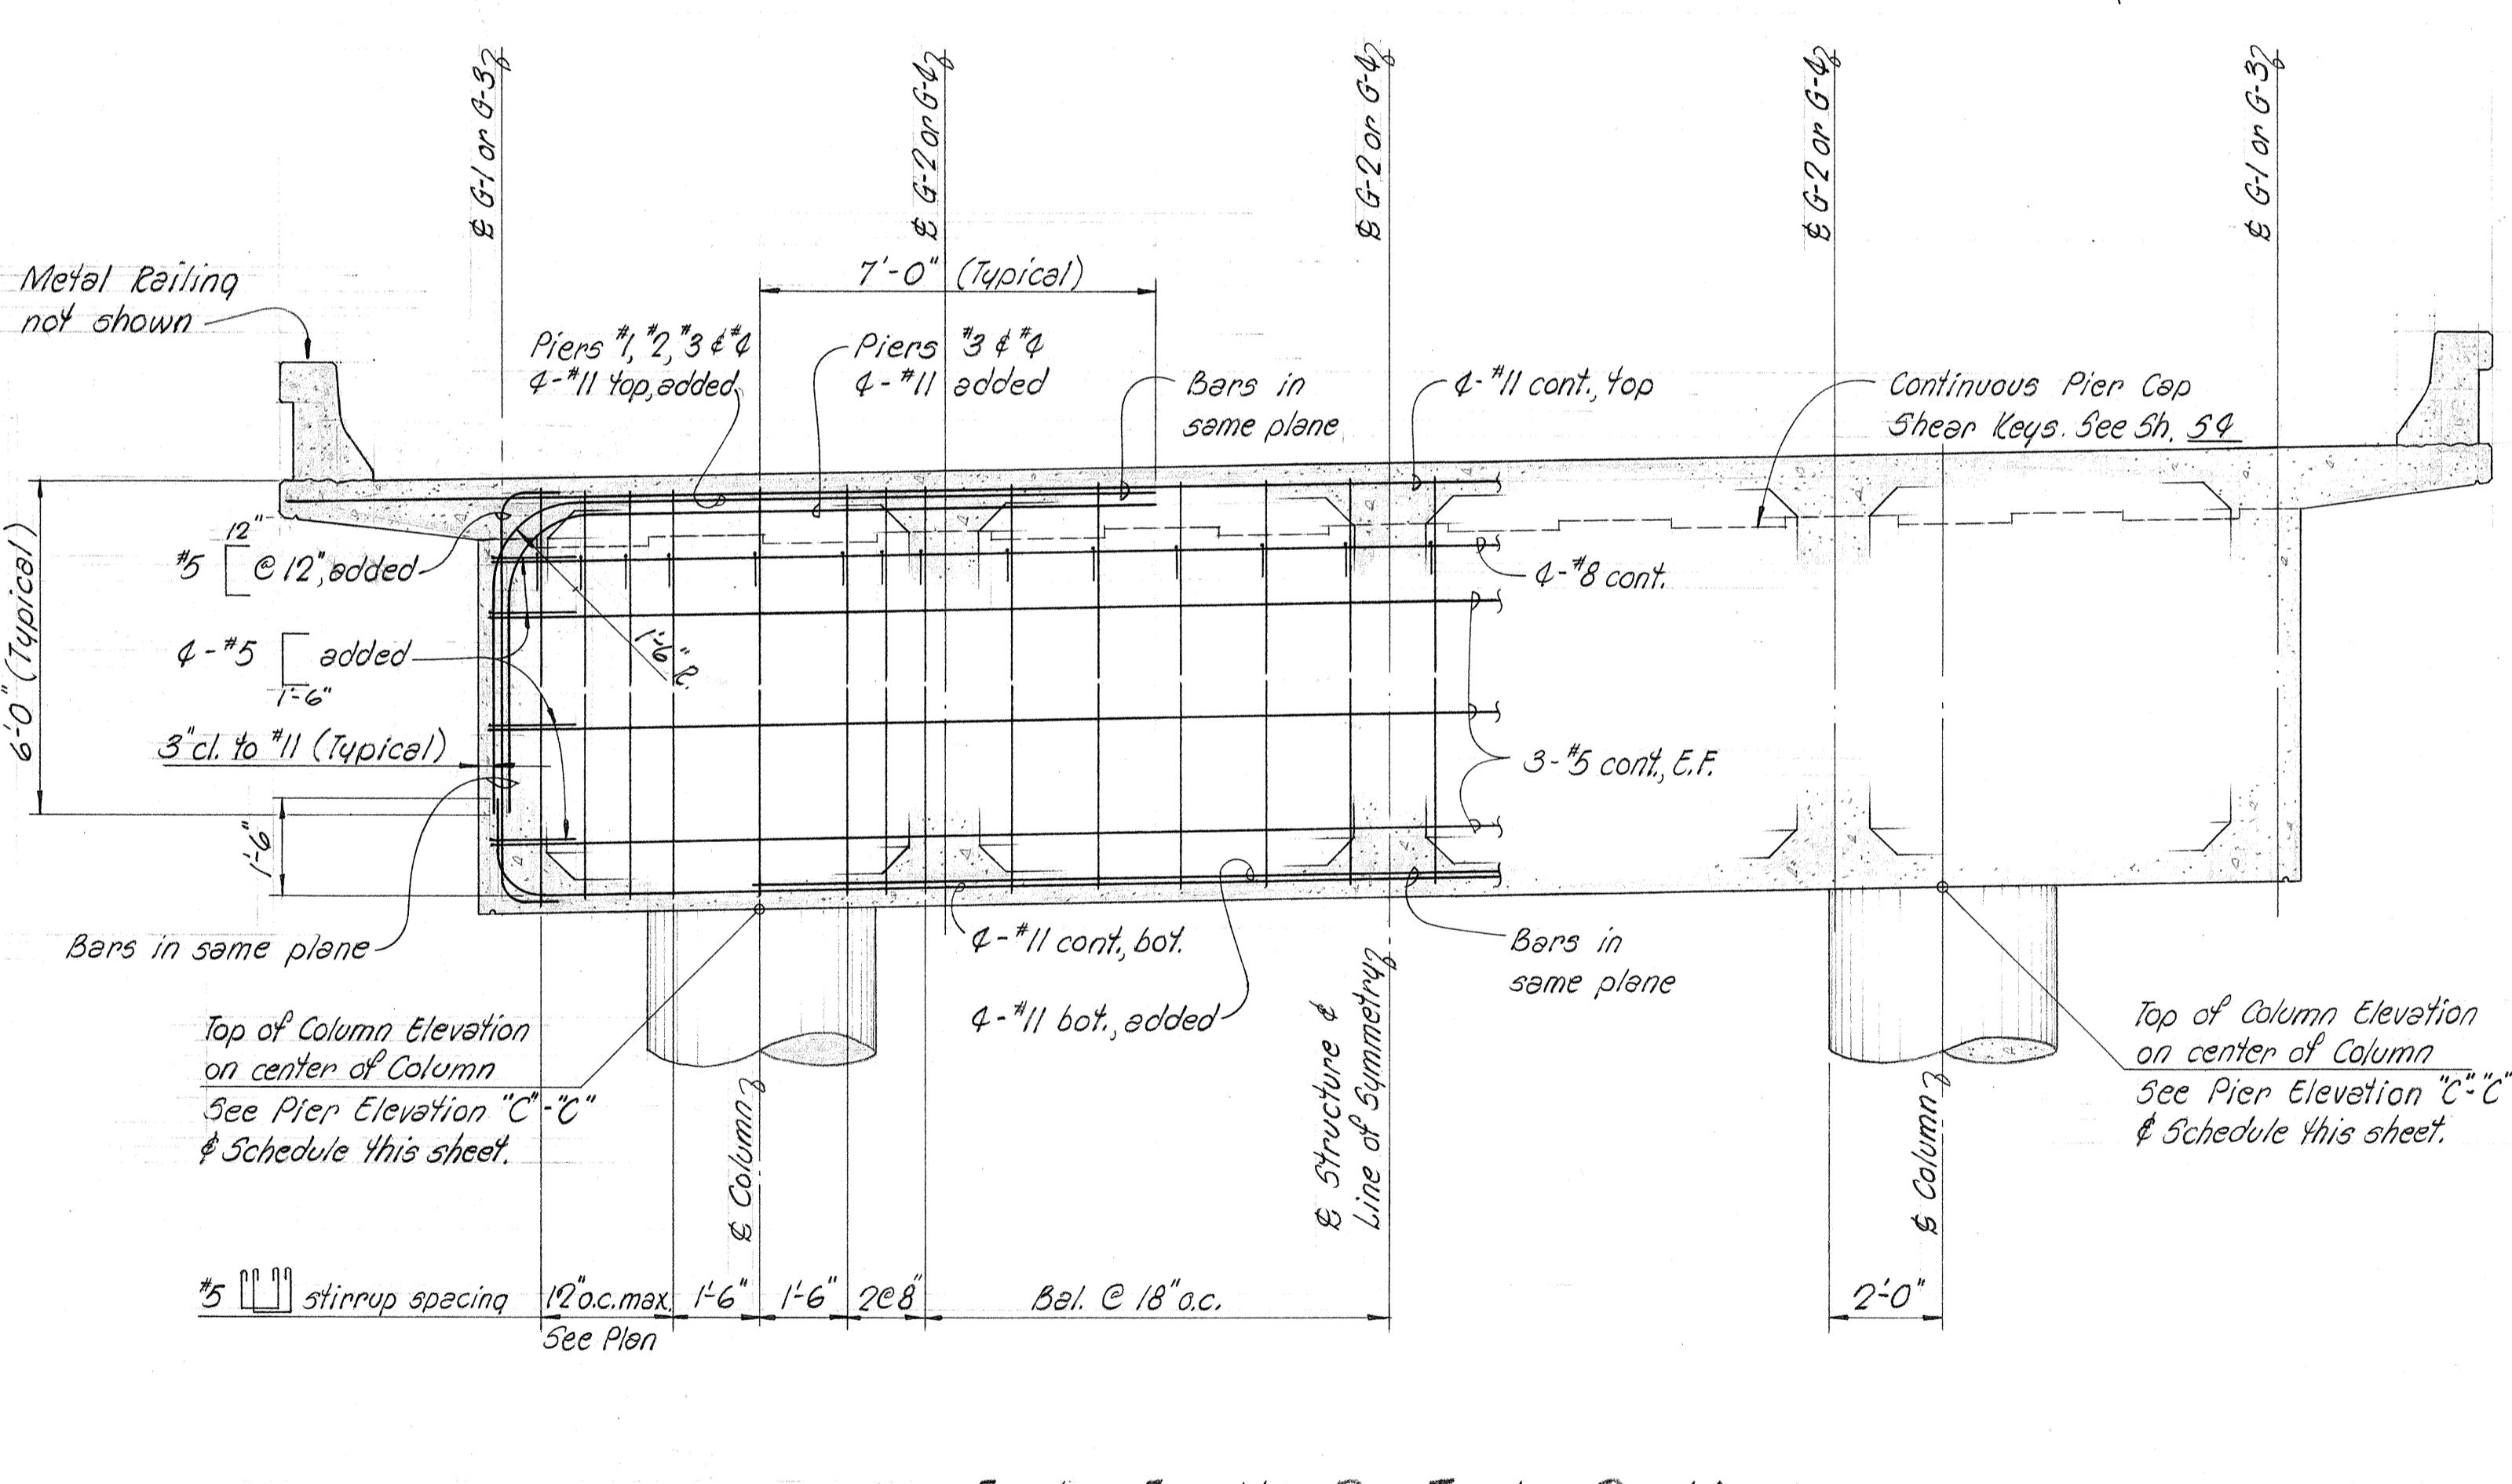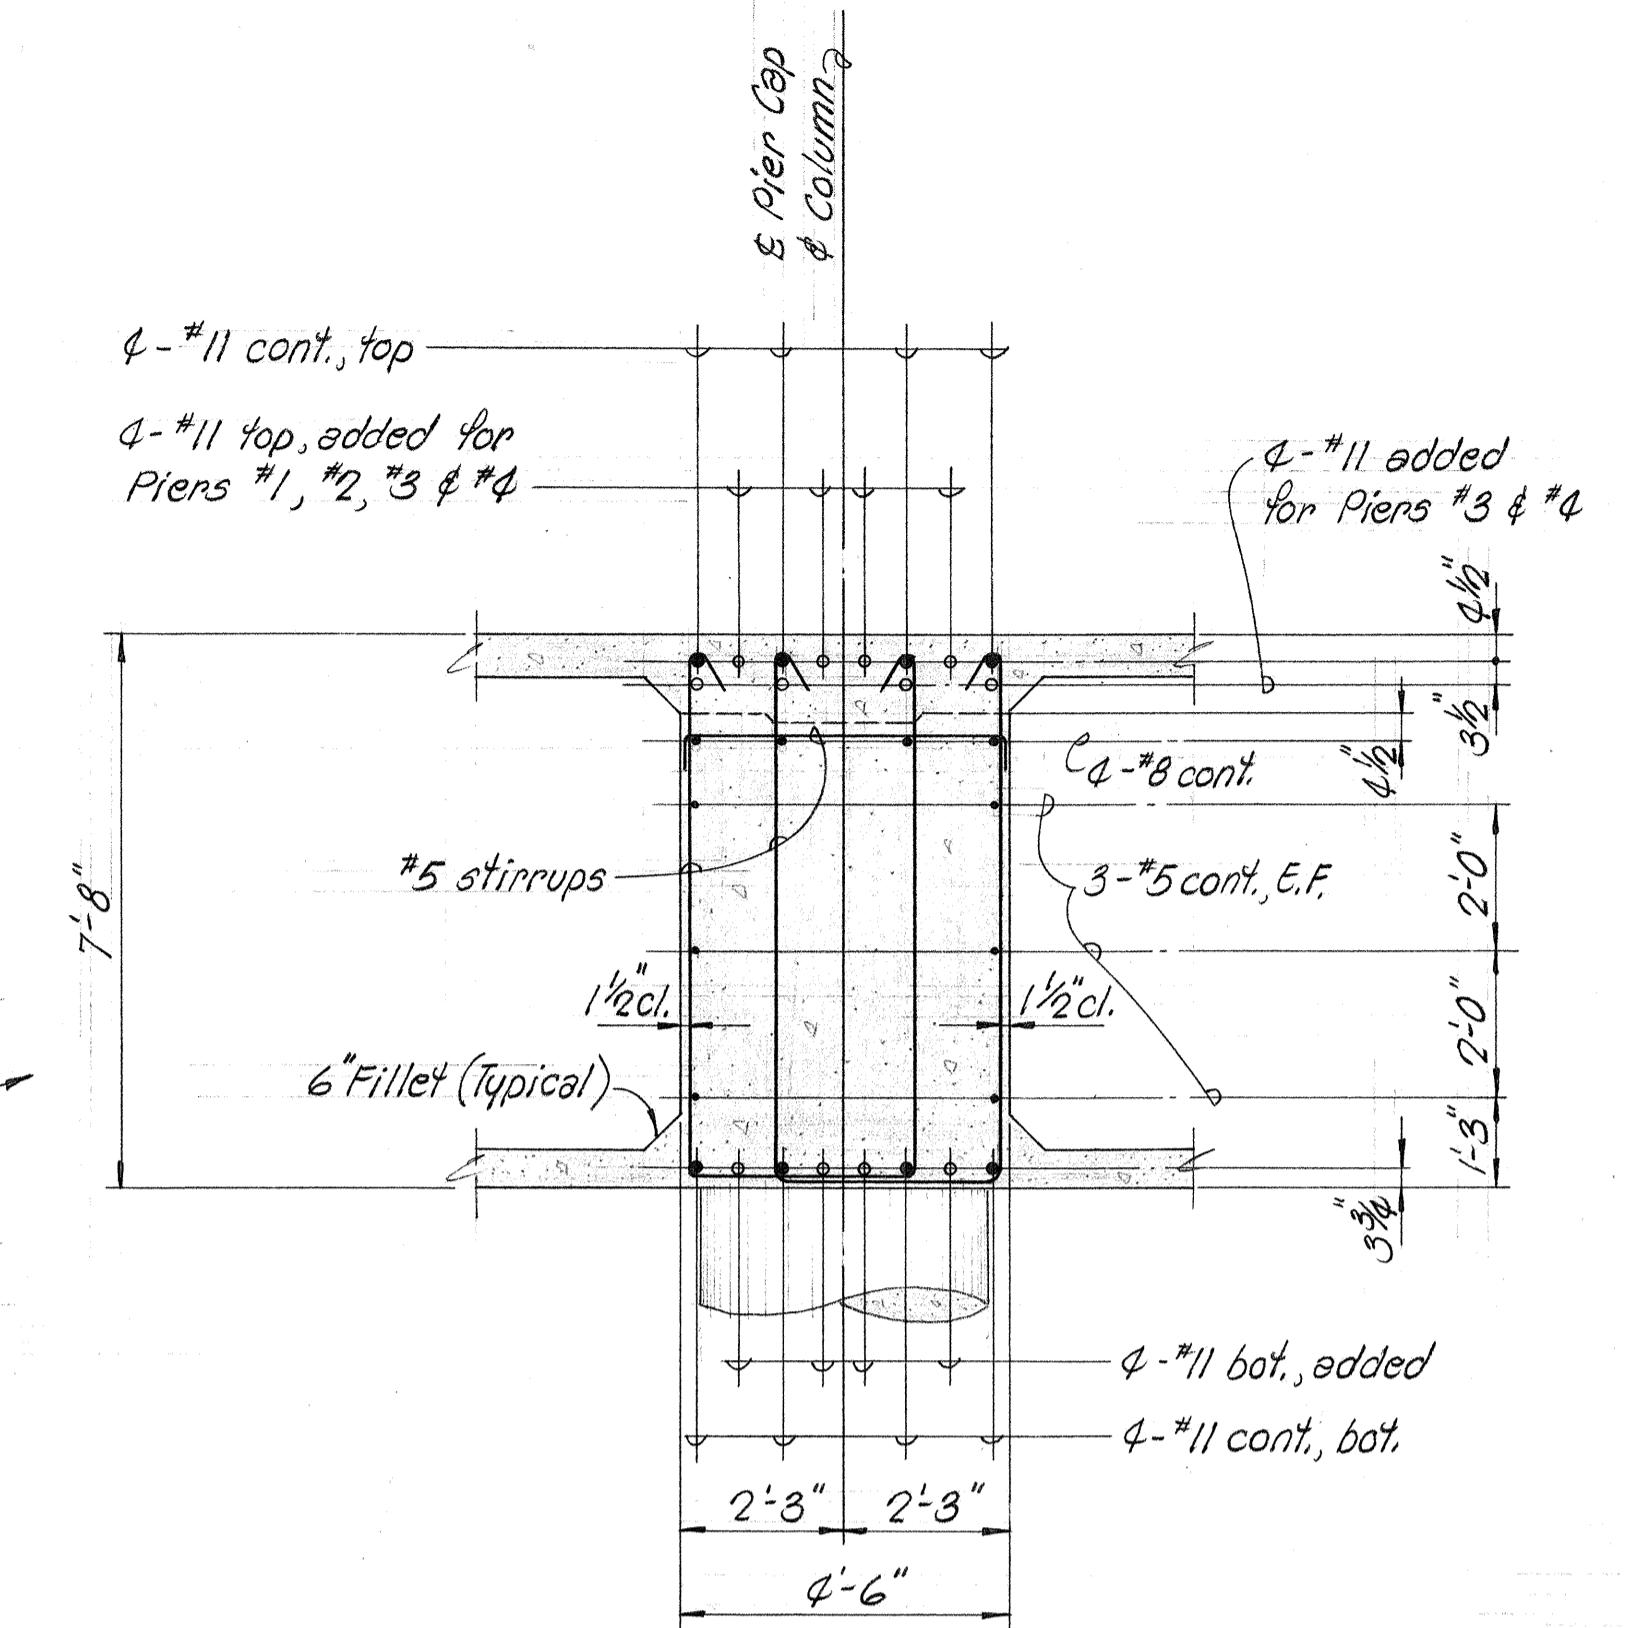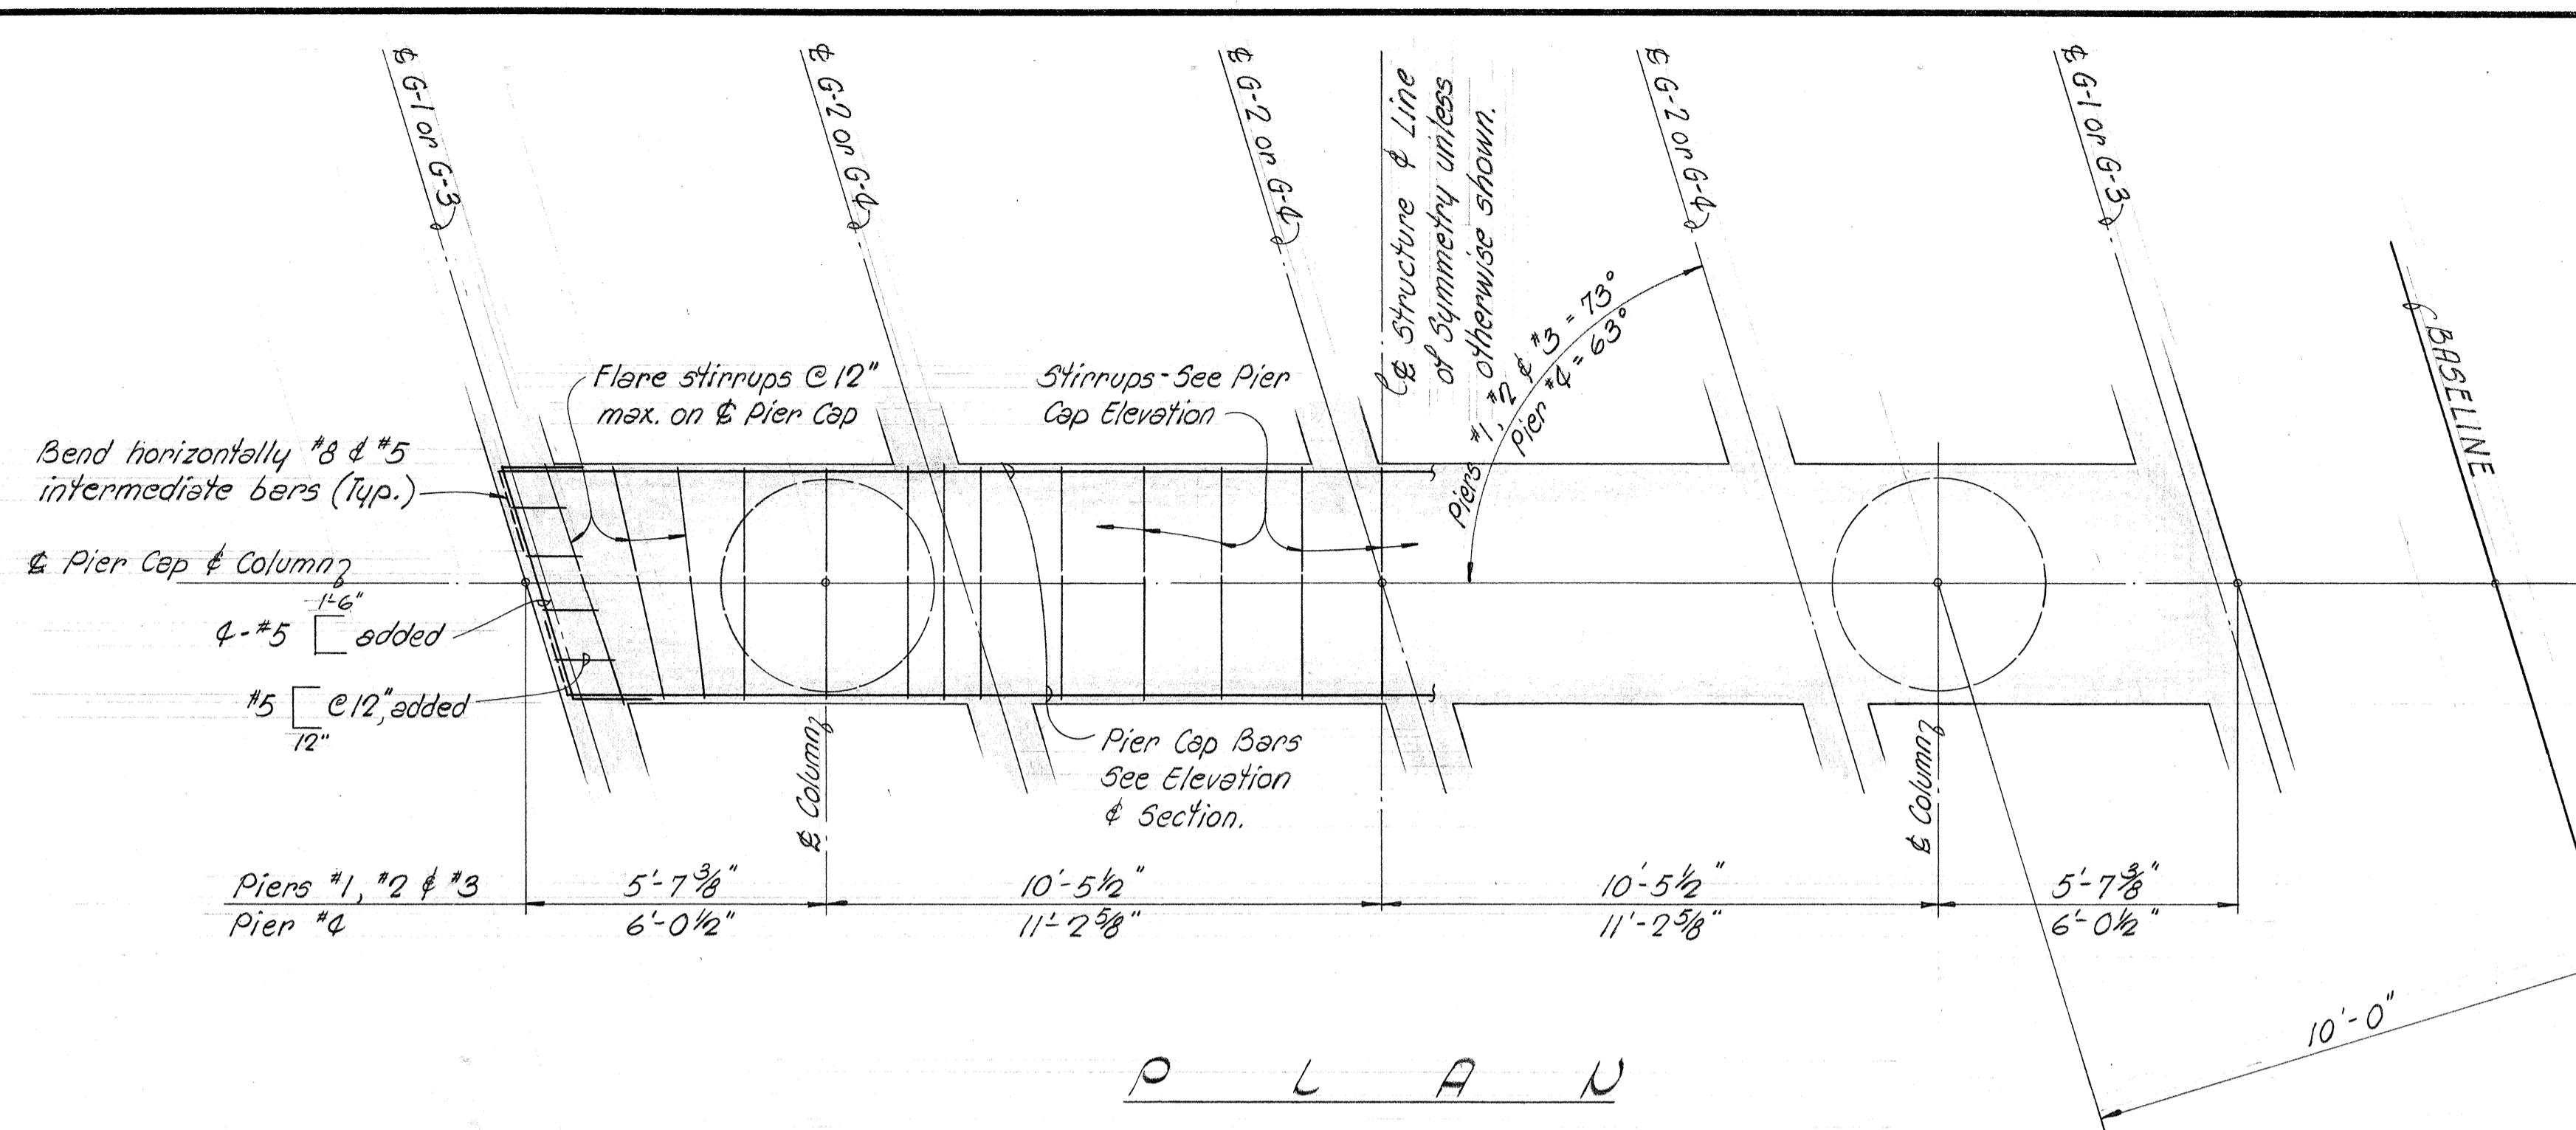


PIER ELEVATION "C" - "C"

Scale: 1/8" = 1'-0"

NOTE: Top of Column Elevations on center of Column.







TOP OF COLUMN & BOTTOM OF FOOTING ELEVATIONS									
Bridge No.	Pier No.	Top of Col. Elevation "A"	Top of Col. Elevation "B"	Bot. of Ftg. Elevation	Bridge No.	Pier No.	Top of Col. Elevation "C"	Top of Col. Elevation "D"	Bot. of Ftg. Elevation
4A	1	105.76	106.01	75.0	4B	1	105.96	105.63	75.0
	2	106.28	106.54	72.0		2	106.48	106.16	72.0
	3	106.85	107.10	58.0		3	107.05	106.72	58.0
	4	107.55	107.79	66.0		4	107.69	107.35	66.0

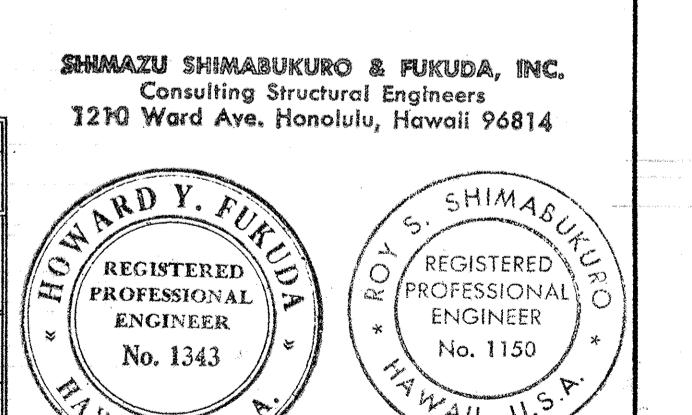

This work was prepared by me or under my supervision.
Howard Y. Fukuda

STATE OF HAWAII
DEPARTMENT OF TRANSPORTATION
HIGHWAYS DIVISION
WAIANA INTERCHANGE
STRUCTURE No. 4A & 4B
F.A.I. P20d No. I-HI-1 (36)8
Scale: As Shown Date:
SHEET No. B6 OF 25 SHEETS

FED. ROAD DIST. NO.	STATE PROJ. NO.	FED. AID. YEAR	FISCAL YEAR	SHET NO.	TOTAL SHEETS
HAWAII	HAW. I-HM/368	1967	71	124	

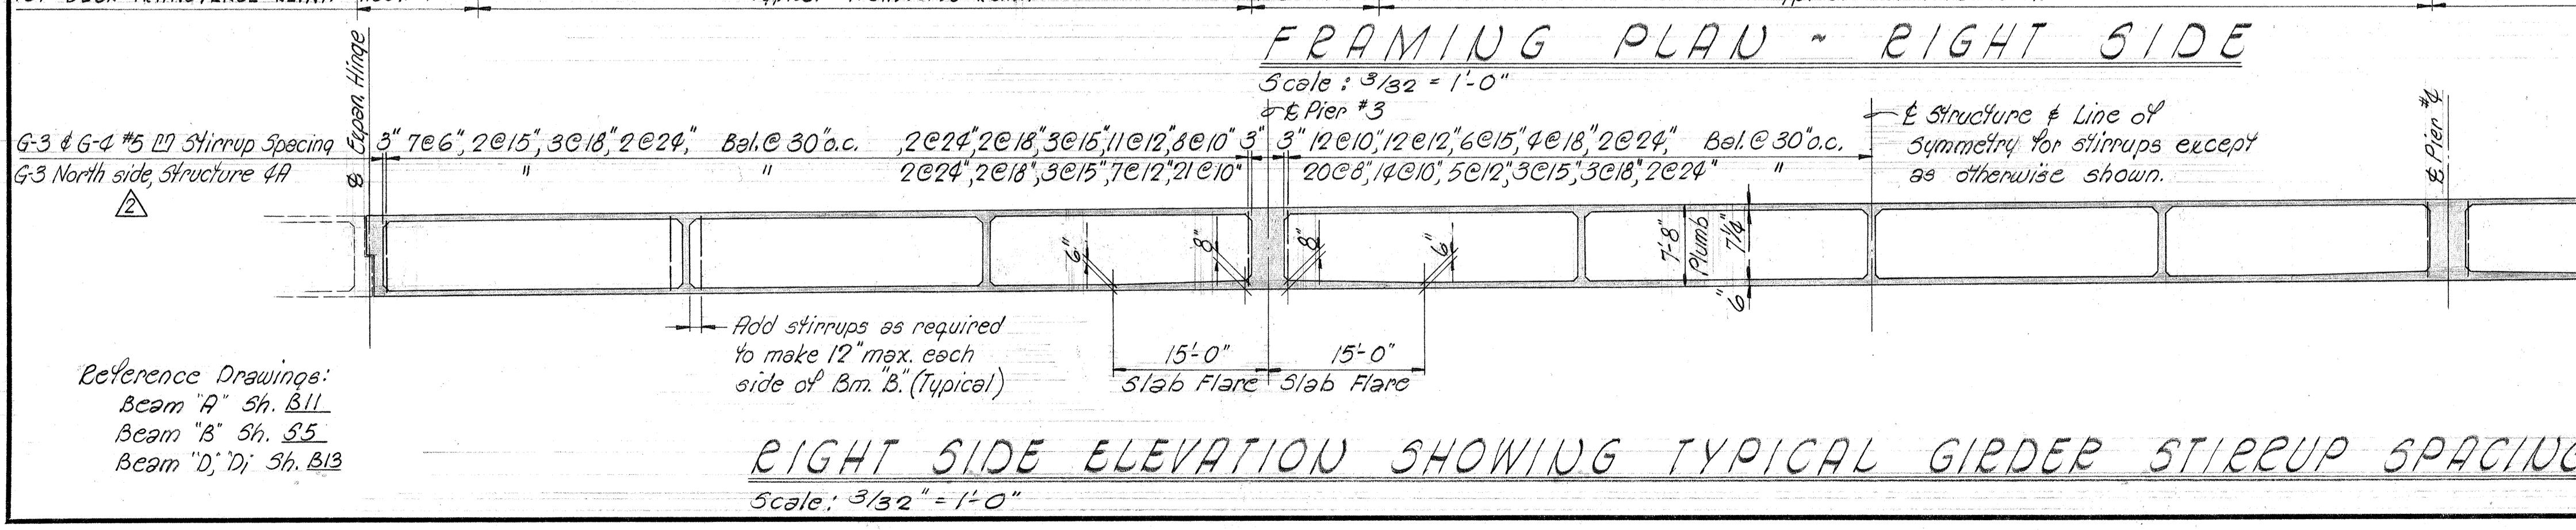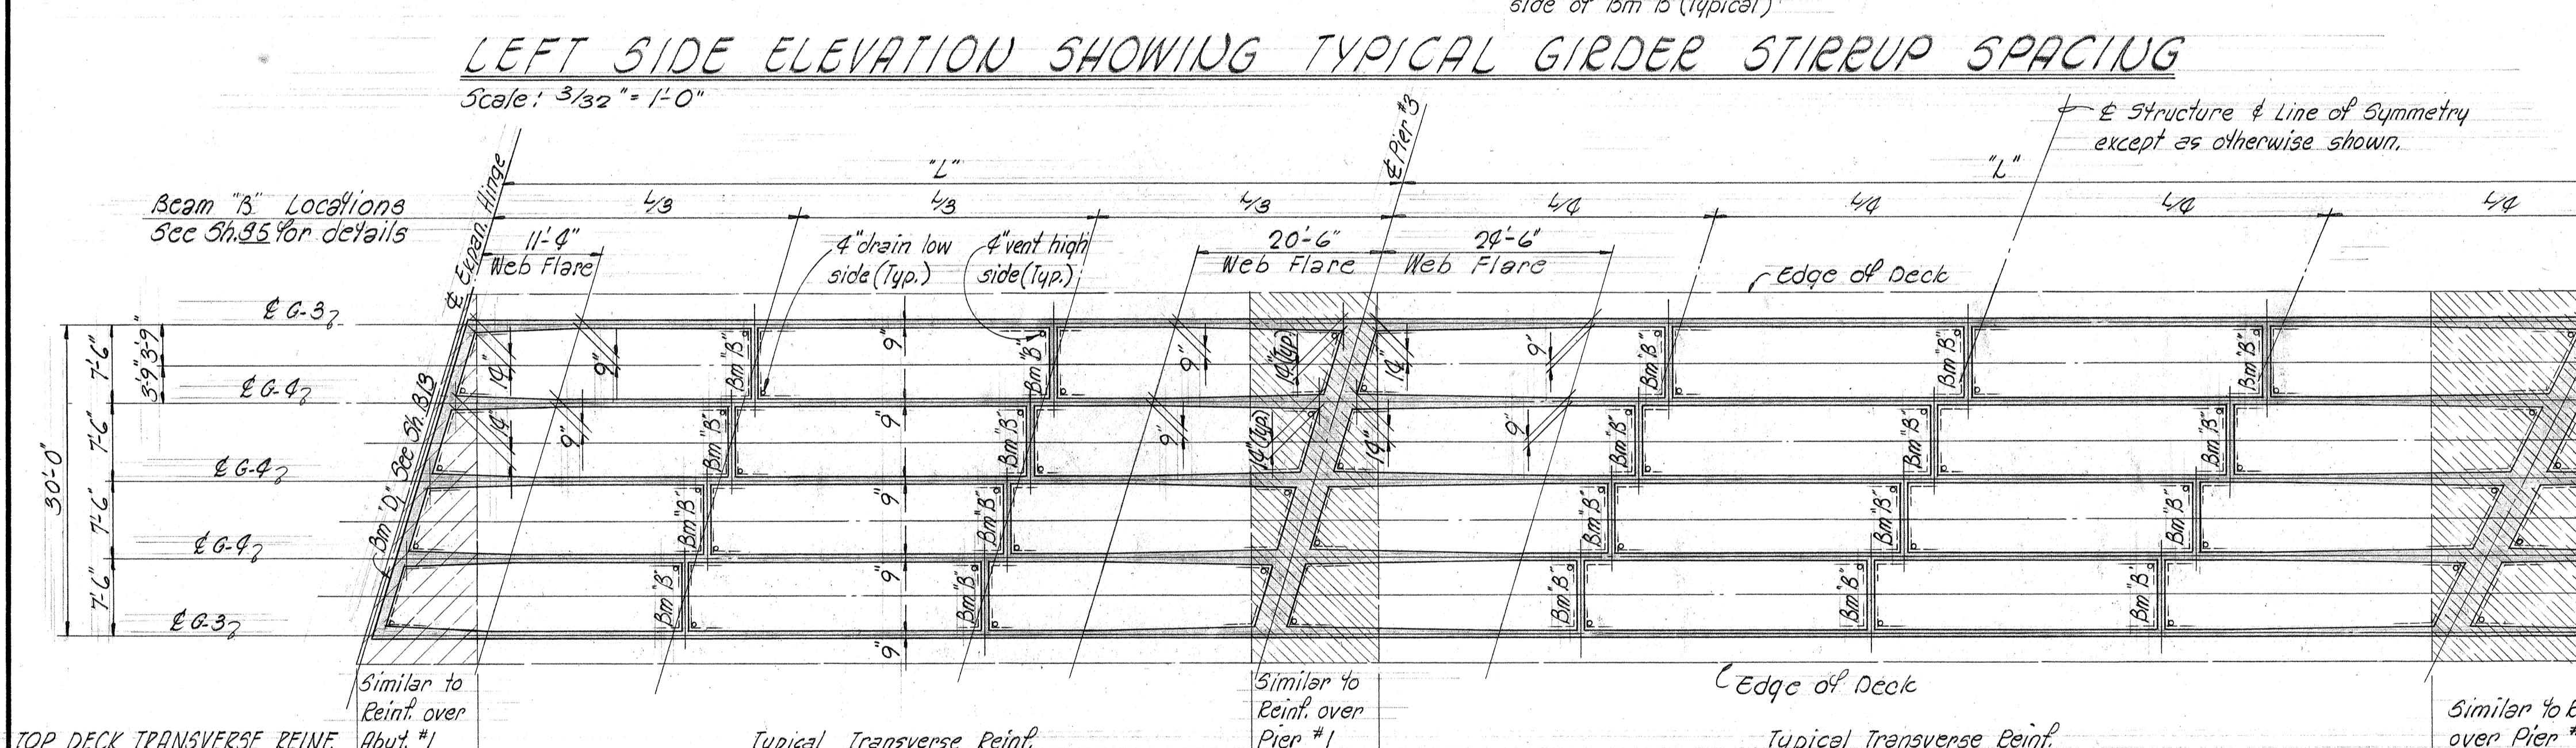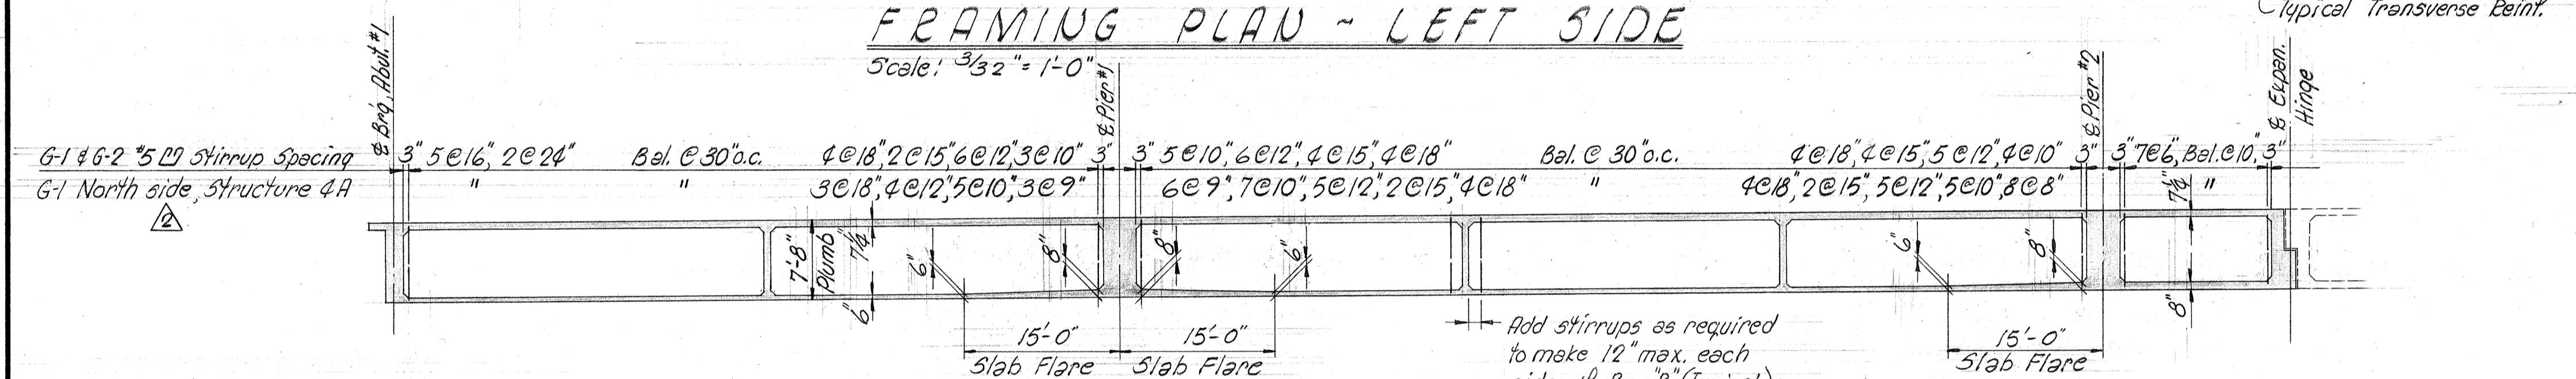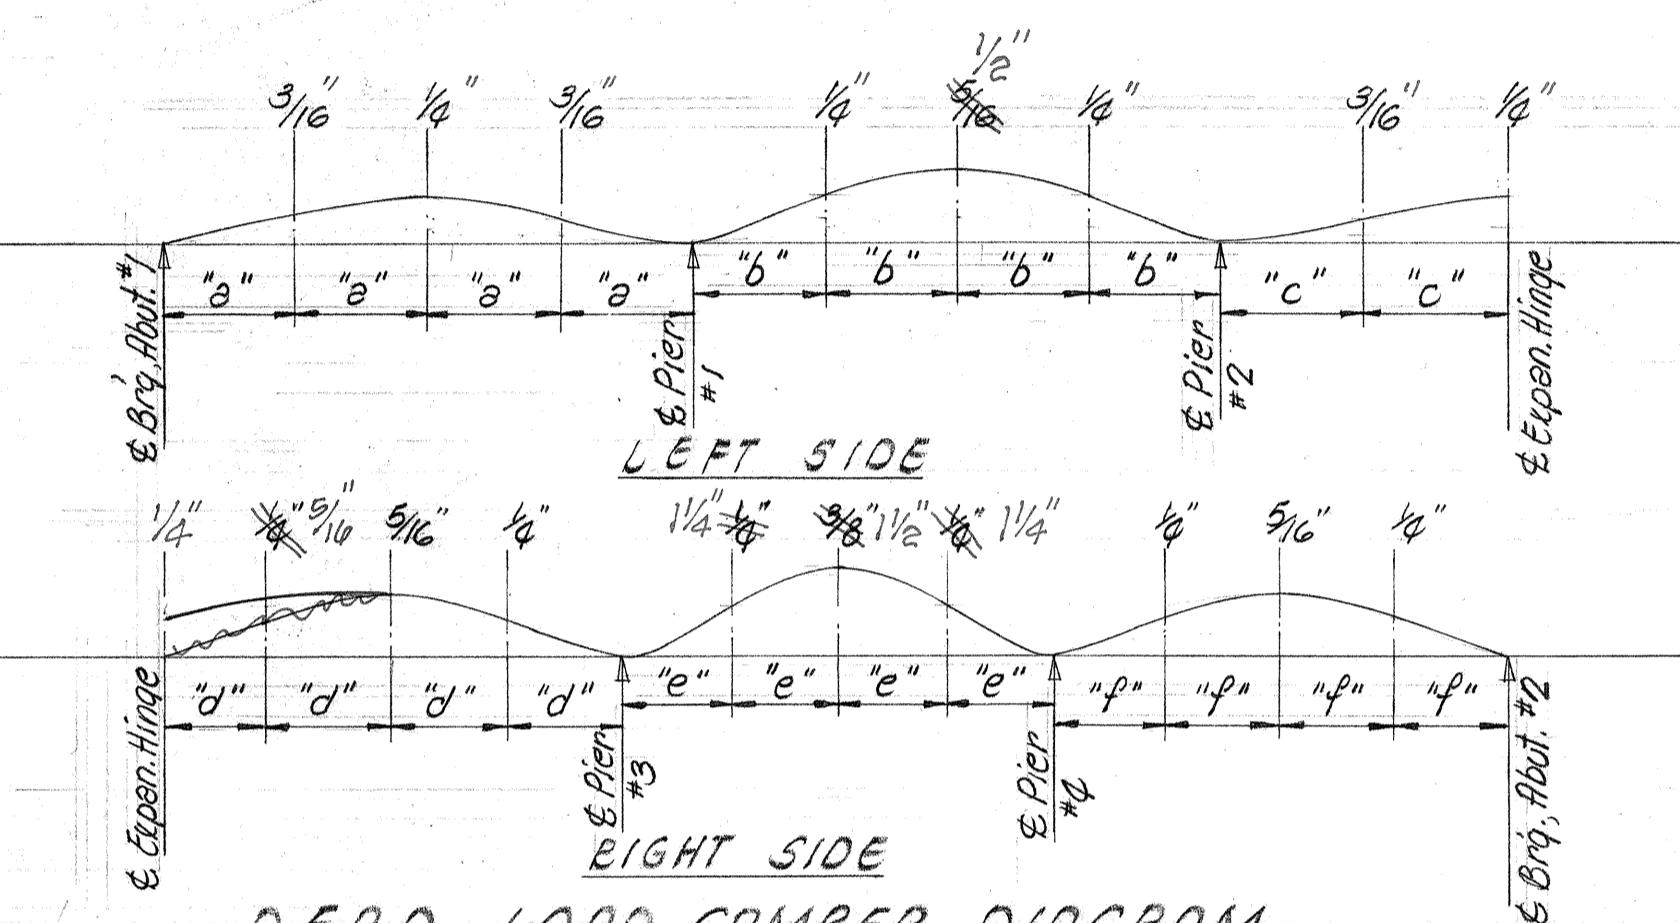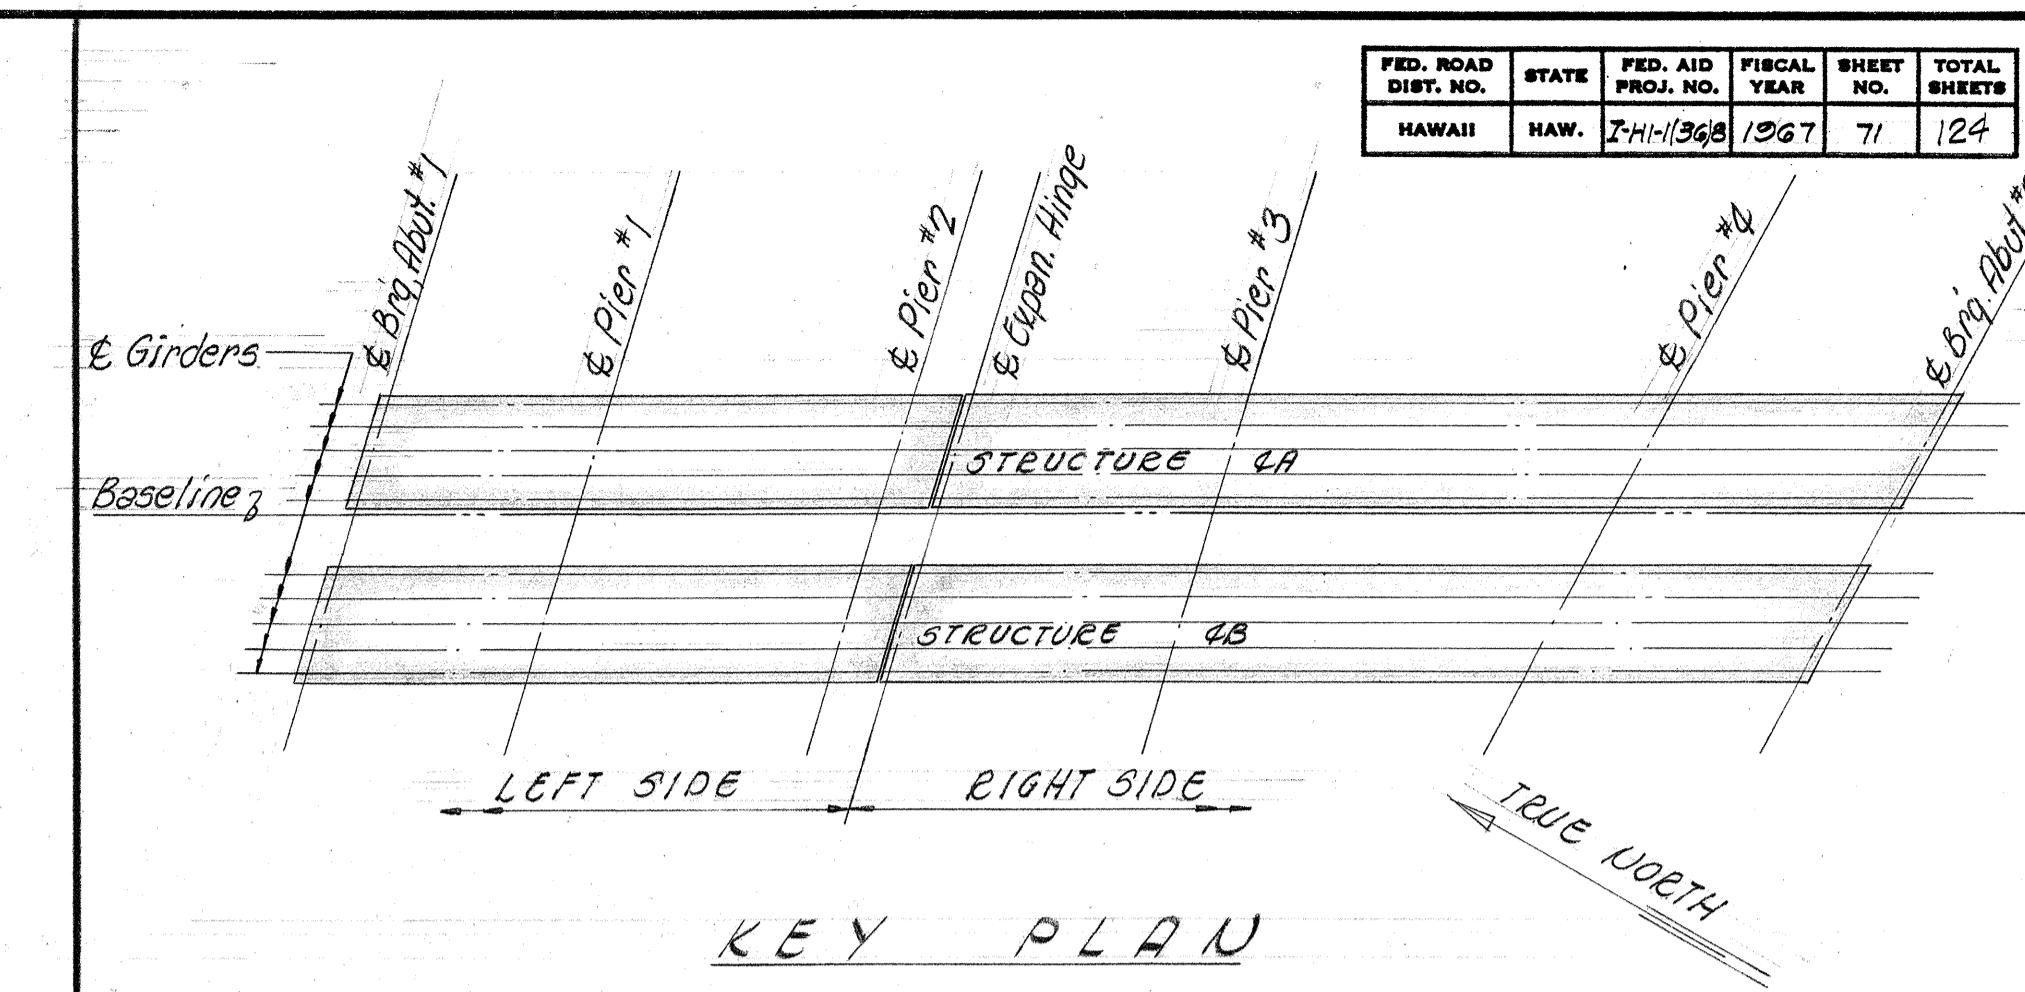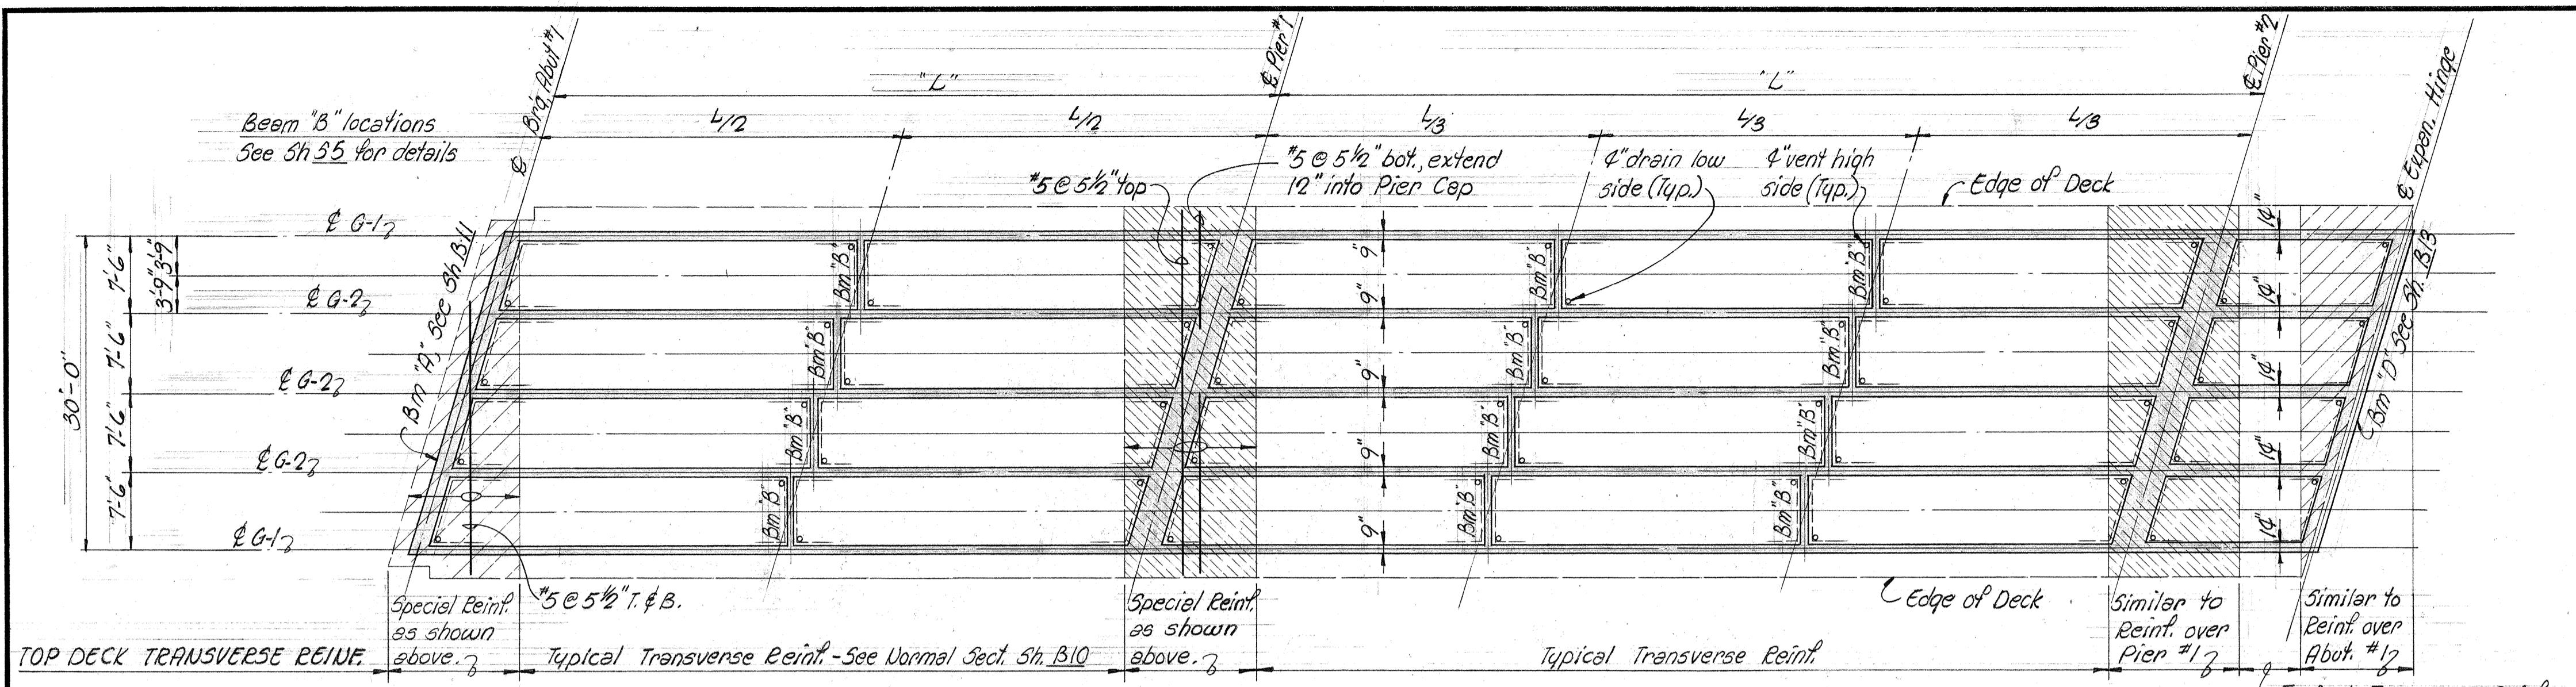

11/31/68 214 Revised exterior girder G-1 & G-3 North side, Structure 4A, stirrup spacing to carry telephone ducts.

STATE OF HAWAII
DEPARTMENT OF TRANSPORTATION
HIGHWAYS DIVISION

WAIANEA INTERCHANGE
STRUCTURE No. 4A & 4B


F.A.I. PEOJ. No. I-HI-1 (3G)8

Scale: As shown Date:

SHEET No. 87 OF 25 SHEETS

(C) 71

FED. ROAD DIST. NO.	STATE	FED. AID PROJ. NO.	FISCAL YEAR	HEET NO.	TOTAL SHEETS
HAWAII	HAW.	I-HI-368	1967	72	124

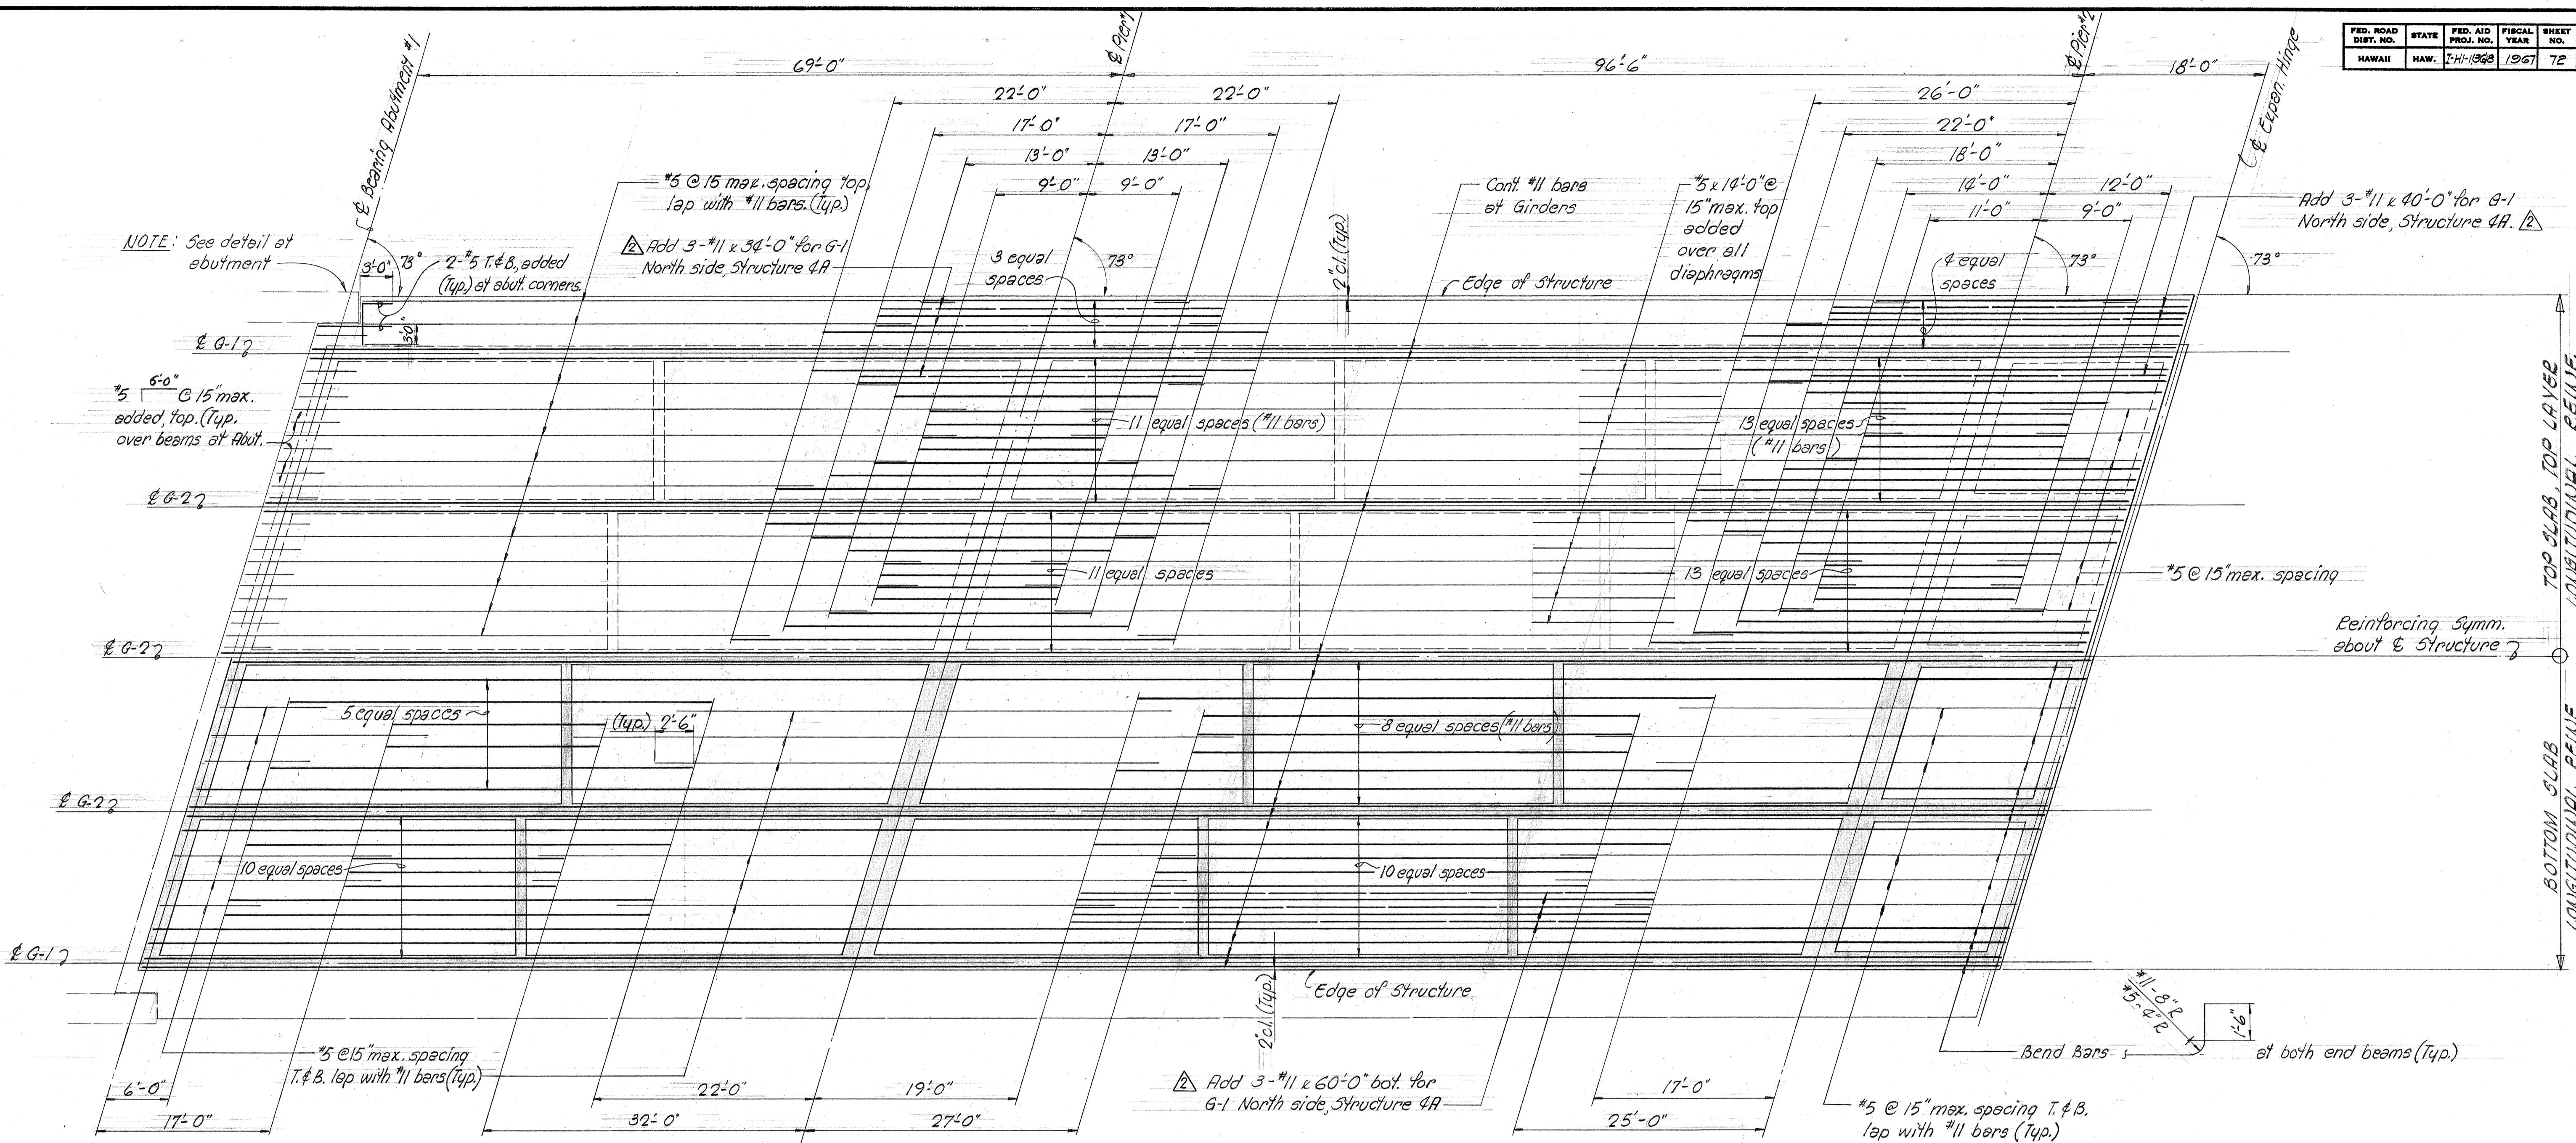


LEFT SIDE PLAN ~ TYPICAL ARRANGEMENT OF TOP SLAB, TOP LAYER & BOTTOM SLAB LONGITUDINAL DECK REINFORCEMENT



Scale: Horiz. = 1/8" = 1'-0", Vert. = 1/8" = 1'-0"

NOTES

- Except as otherwise noted all slab bars to be #11 bars.
- All #5 bars at 15" maximum spacing shall be extended and lapped a minimum of 2'-6" with adjacent #11 bars as shown.
- Longitudinal deck reinforcement to follow curvature of girder & deck slab where curvatures occur.
- For special deck reinforcement details and arrangement, see Sh. B7.
- All vertical dimensions are measured plumb.
- Transverse bars not shown, see normal section Sh. B10.

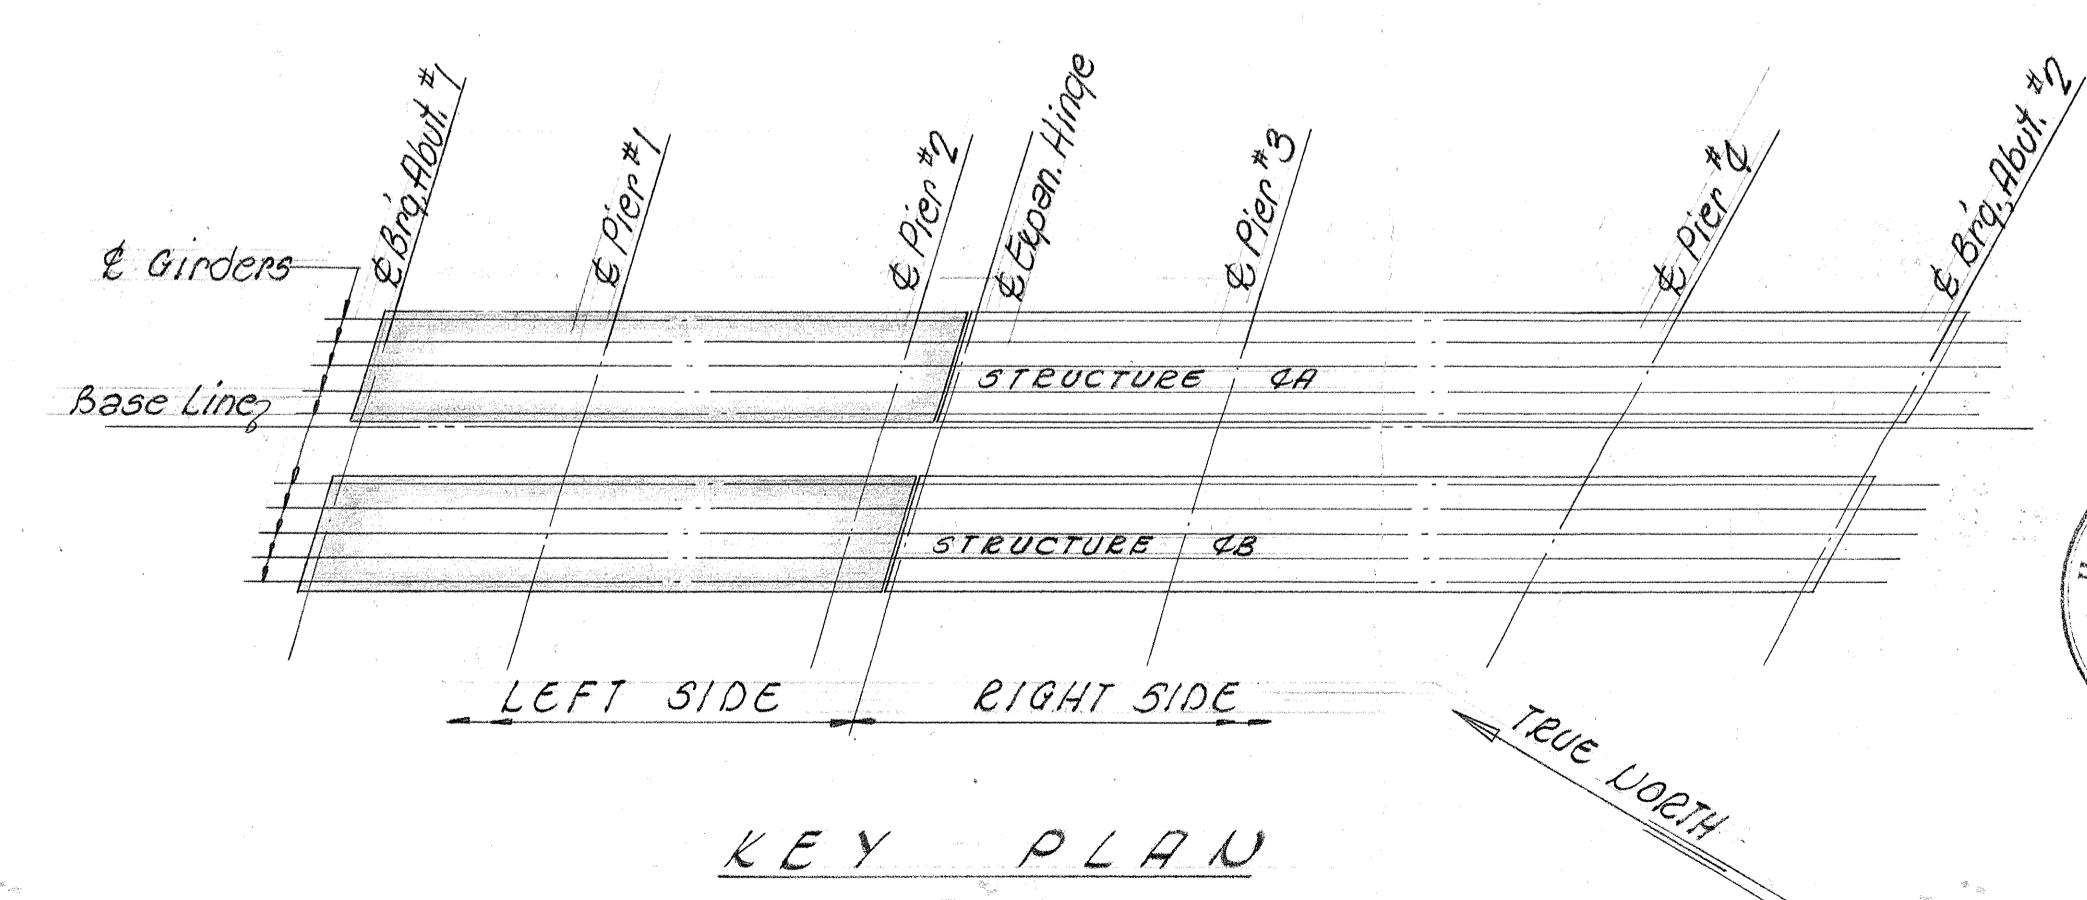


② Added to top & bot. slab longitudinal deck reinforcement #11 bars as shown on plan. 1/31/68 AF.

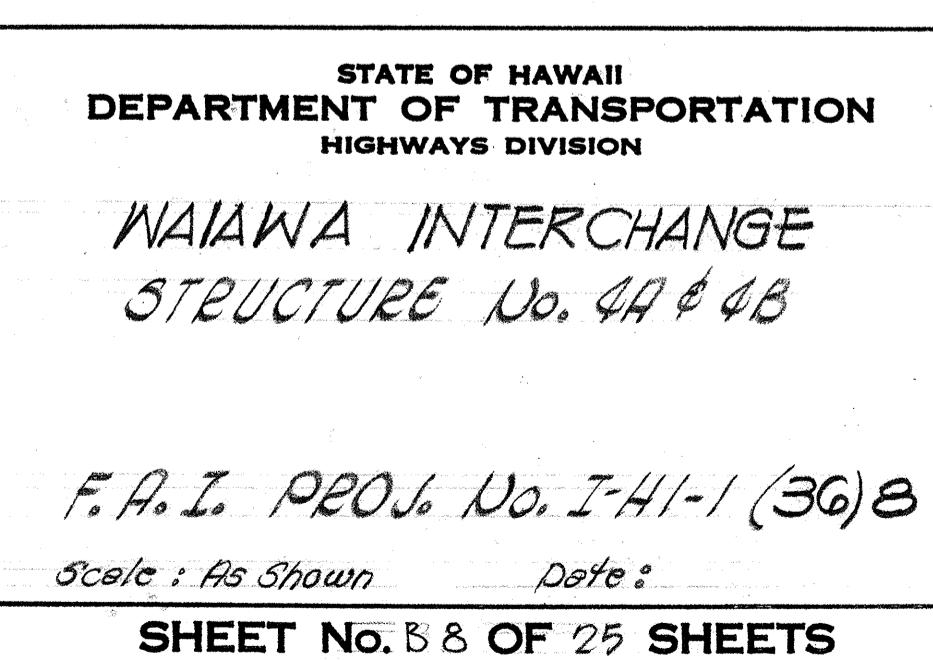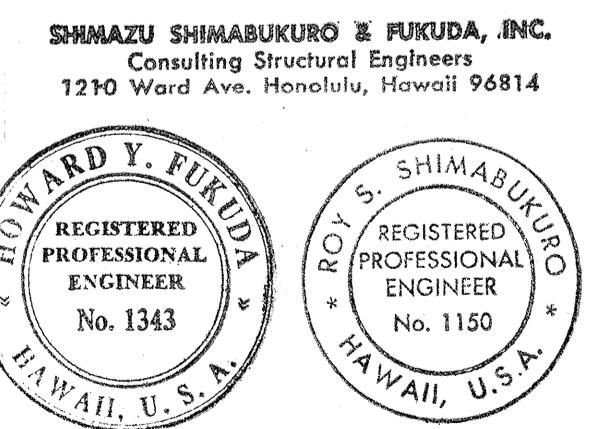

This work was prepared by
me or under my supervision.
Howard Y. Fukuda

(C) 72

FED. ROAD DIST. NO.	STATE	FED. AID PROJ. NO.	FISCAL YEAR	SHEET NO.	TOTAL SHEETS
HAWAII	HAW.	IH-1968	1967	75	124

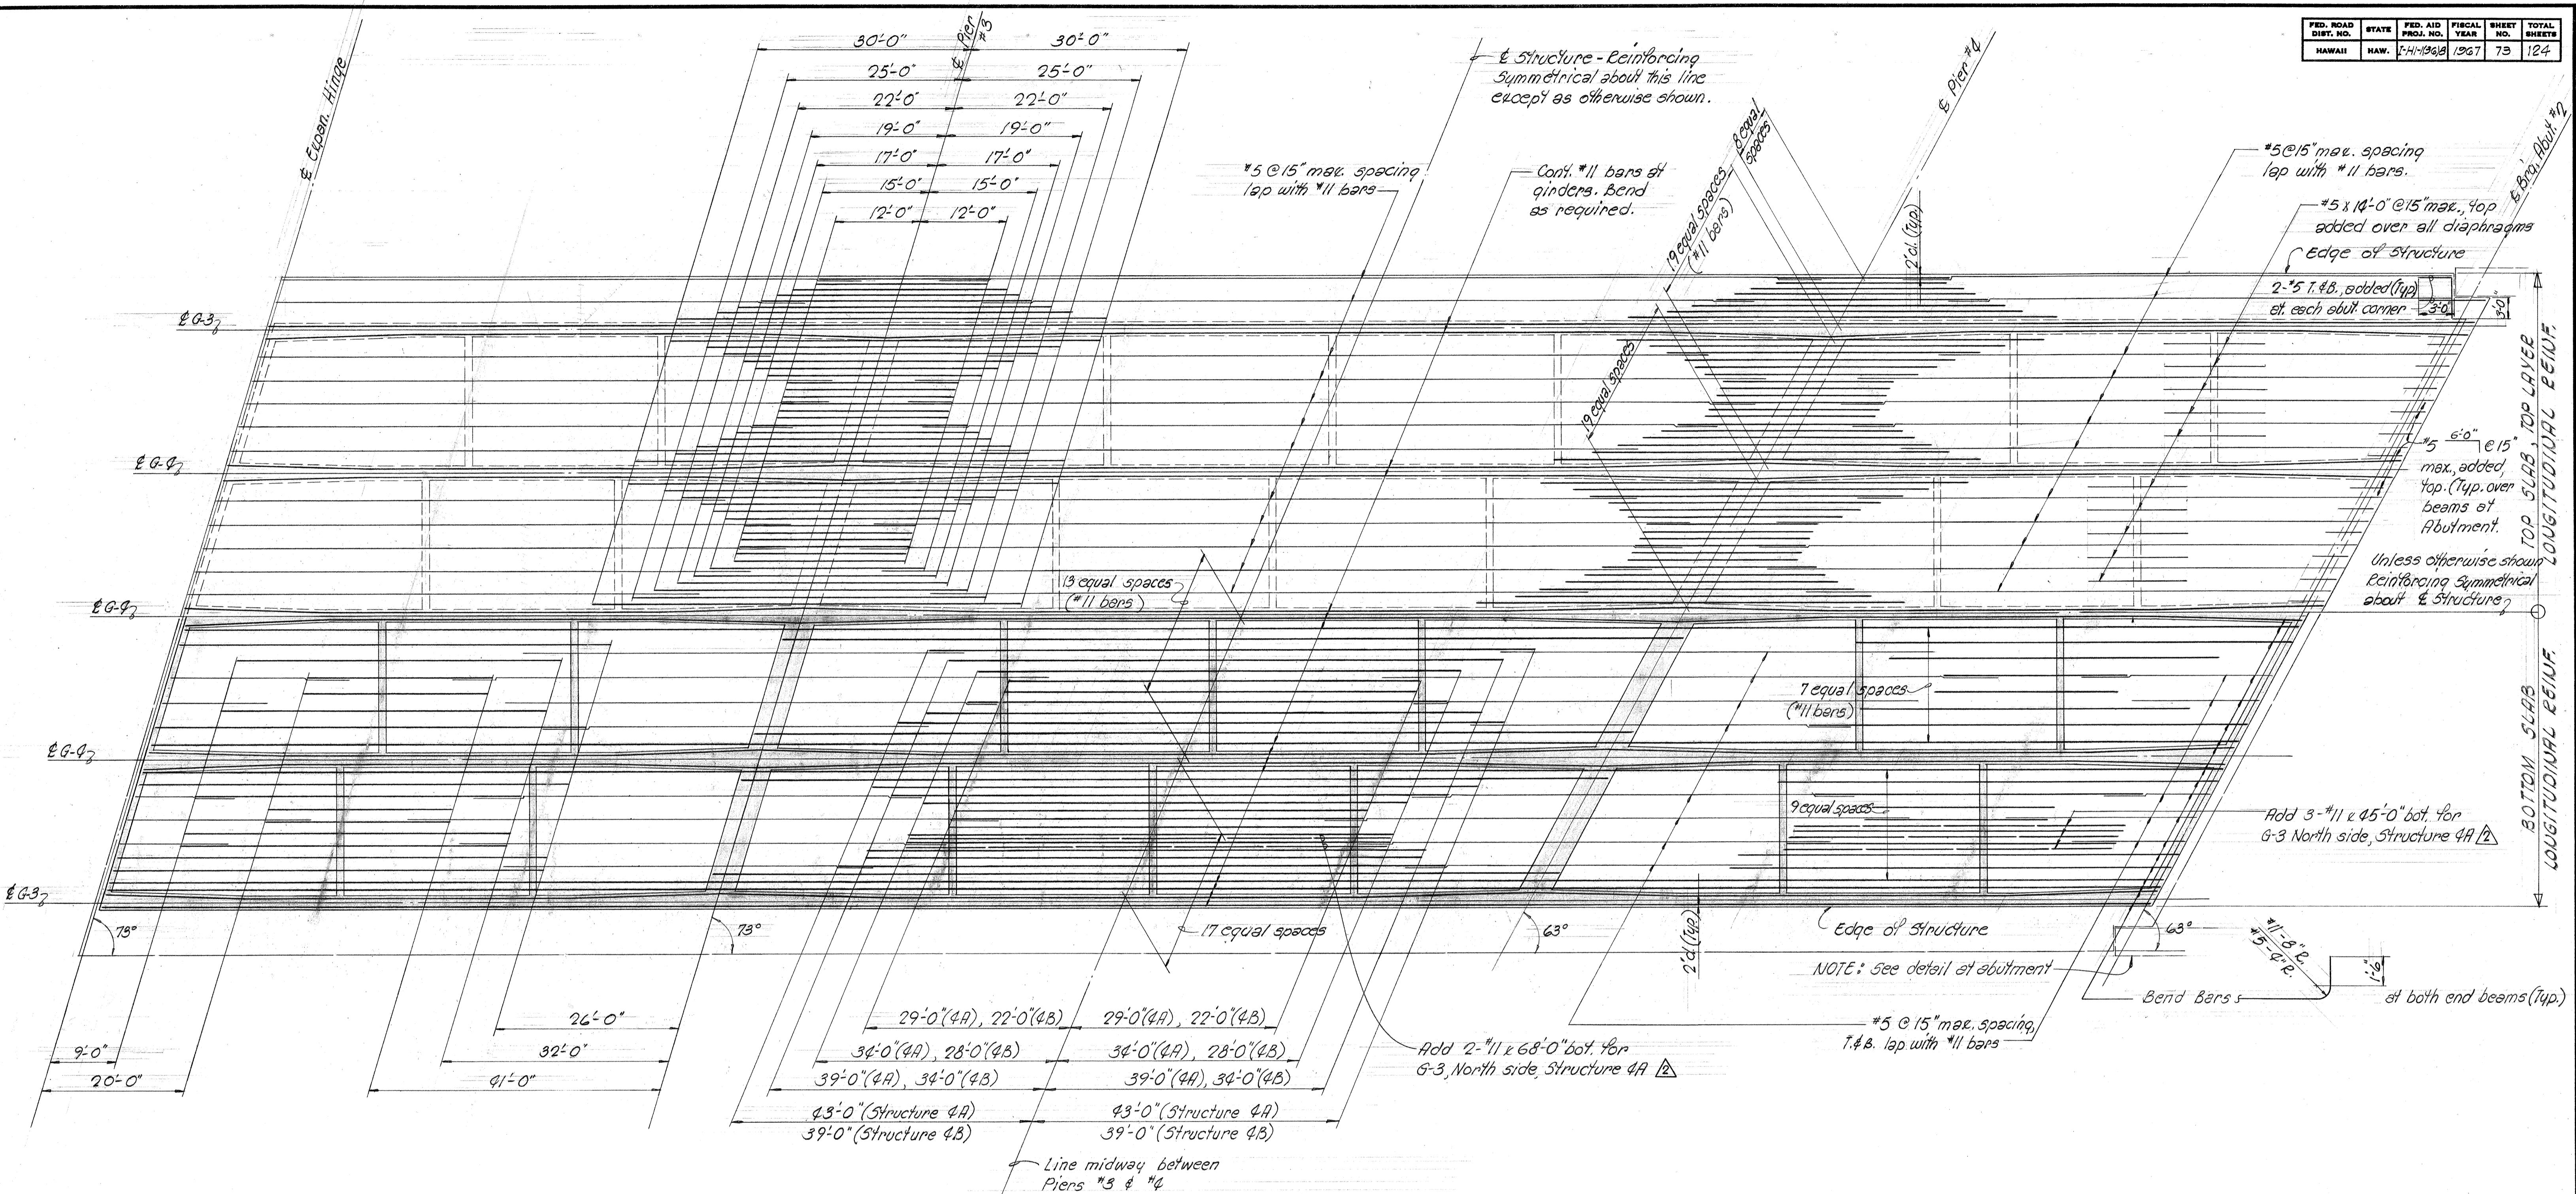


RIGHT SIDE PLAN ~ TYPICAL ARRANGEMENT OF TOP SLAB, TOP LAYER & BOTTOM SLAB LONGITUDINAL DECK REINFORCEMENT

Scale: Horiz. = $\frac{1}{32}$ = 1'-0", Vert. = $\frac{1}{4}$ " = 1'-0"

NOTES

1. Except as otherwise noted all slab bars typ. be #11 bars
2. See Notes Sh. B8

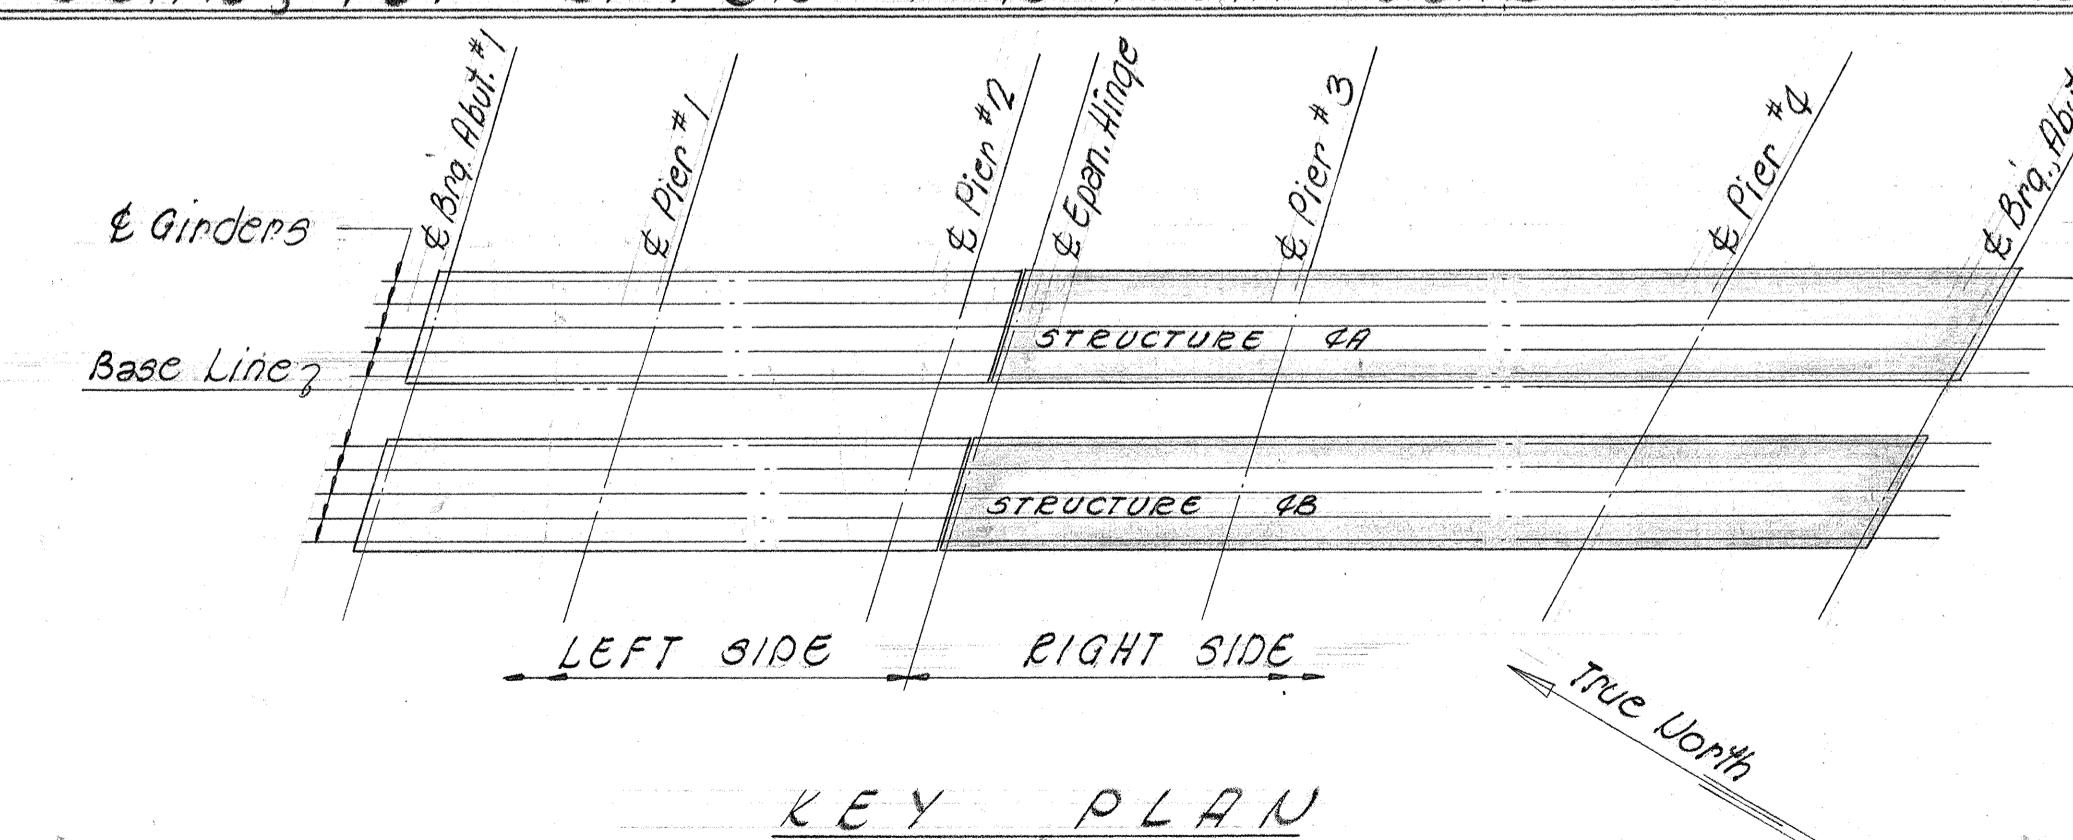


② Added to bot. slab longitudinal deck reinforcement #11 bars as shown on plan.
1/31/68 AF

STATE OF HAWAII
DEPARTMENT OF TRANSPORTATION
HIGHWAYS DIVISION

WAIAWA INTERCHANGE
STRUCTURE No. G-4A & G-4B

F.A.I. PROJ. No. I-HI-1 (36)8


Scale: As Shown Date:

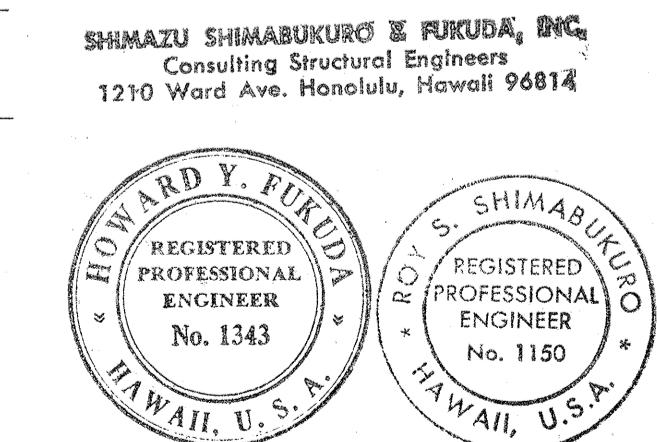

This work was prepared by
me or under my supervision.
Howard Y. Fukuda
SHEET No. B9 OF 25 SHEETS


(C) (D) 73

FED. ROAD DIST. NO.	STATE	FED. AID PROJ. NO.	FISCAL YEAR	SHED. NO.	TOTAL SHEETS
HAWAII	HAW.	I-HI-1(36)8	1967	74	124

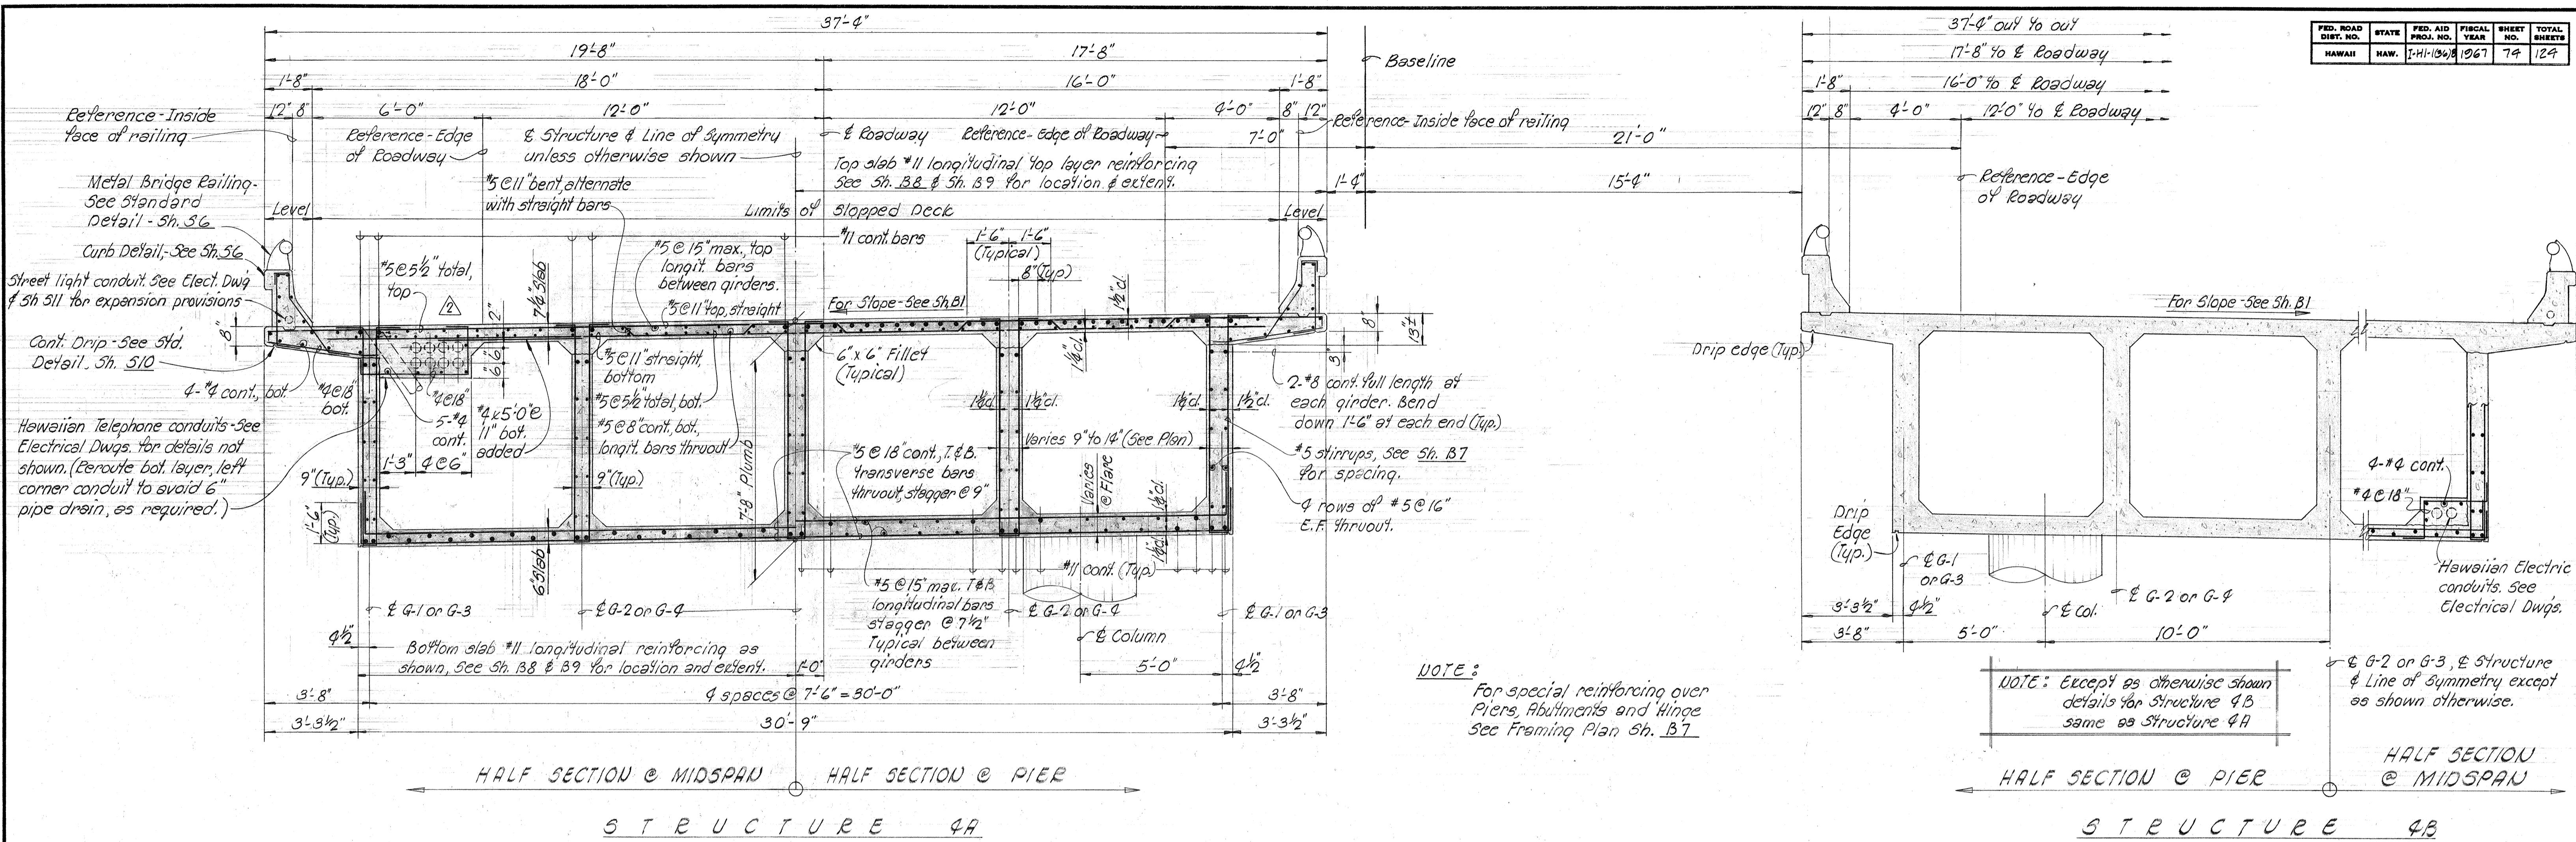

(2) Revised Hawaiian Telephone duct jacket & steel layout in that area. Added #4, 5'-0" C11 bot. 1/31/68 HF.

APPROVED:
R. Henderson
HAWAIIAN ELECTRIC CO., INC. DATE
J. A. Field
HAWAIIAN TELEPHONE CO., LTD. DATE

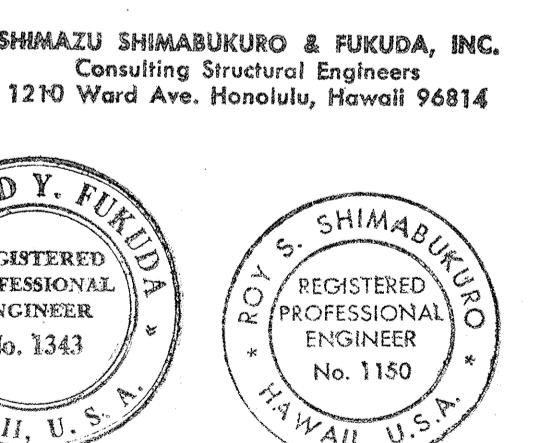


This work was prepared by me or under my supervision.
Howard Y. Fukuda

STATE OF HAWAII
DEPARTMENT OF TRANSPORTATION
HIGHWAYS DIVISION
WAIANA INTERCHANGE
STRUCTURE No. 4A & 4B

F.A.I. PROJ. No. I-HI-1 (36)8
Scale: As Shown Date: 10/18/67
SHEET No. B10 OF SHEETS


(C) (D) 74

ORIGINAL PLAN	DATE
SURVEY PLOTTED BY	
TRANSFERRED BY	
DESIGNED BY	
QUANTITIES BY	
CHECKED BY	
No. _____	

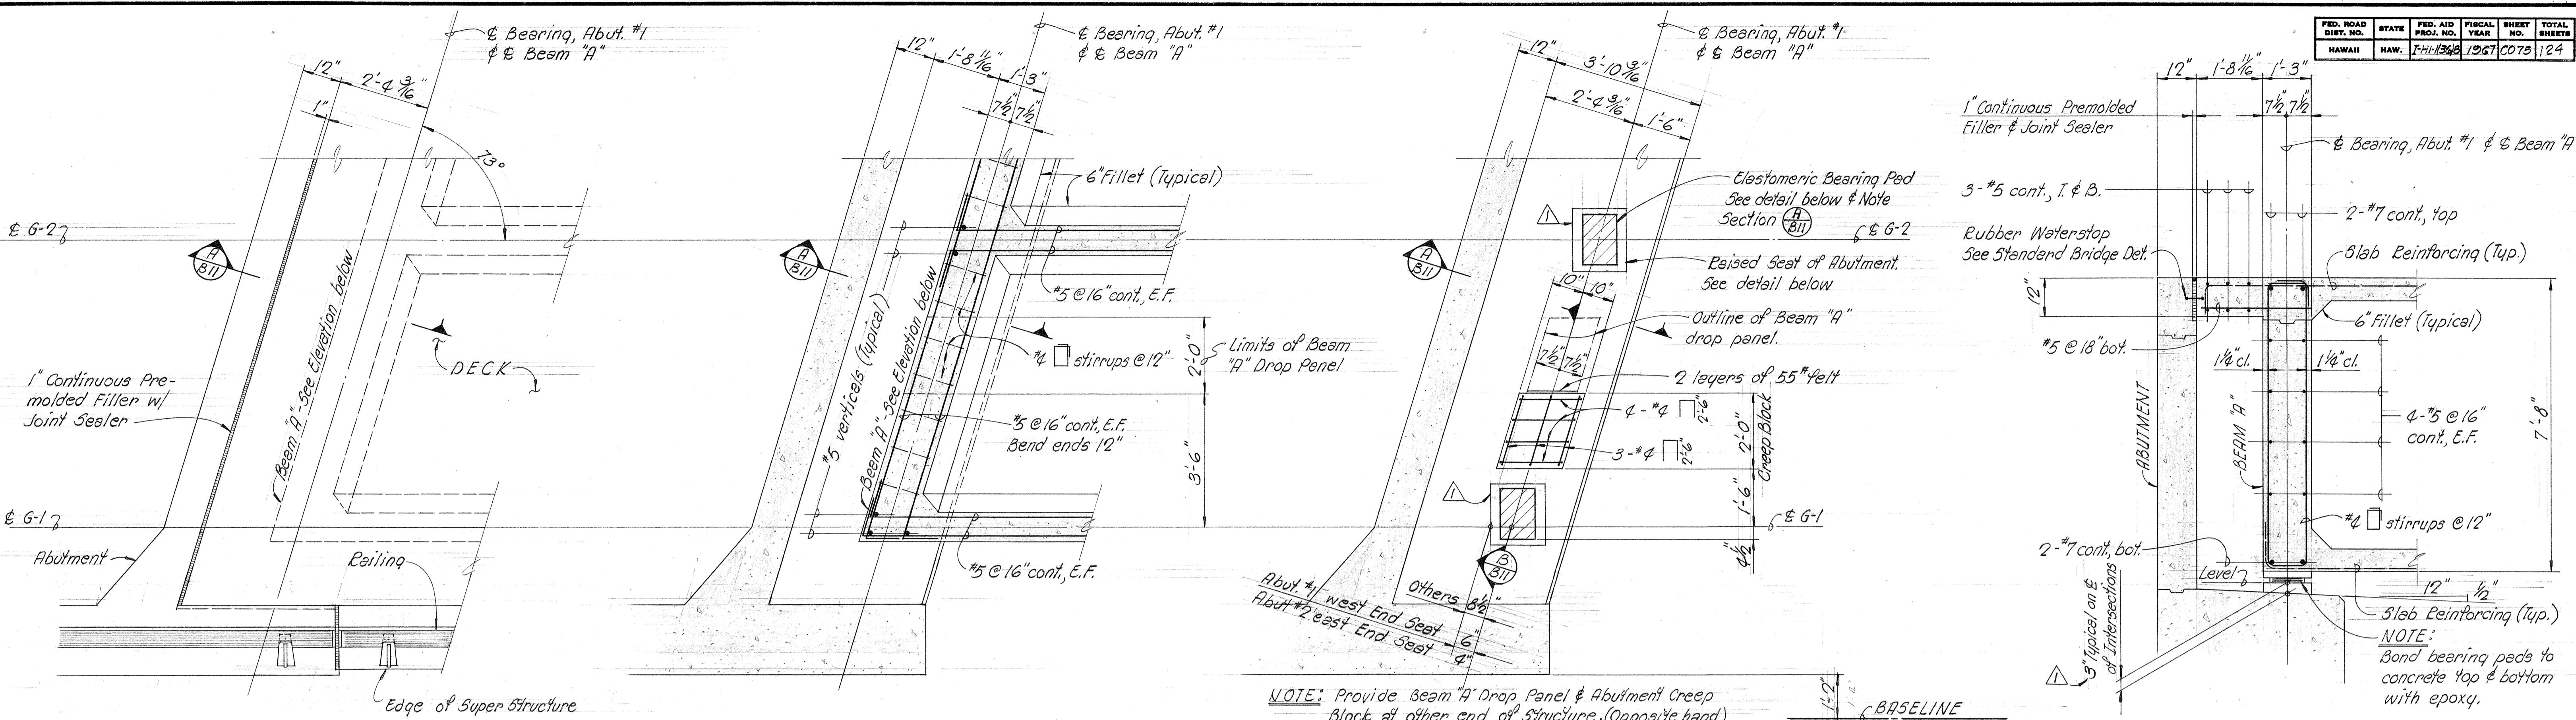

DECK PLAN ~ ABUTMENT #1

Scale: $\frac{1}{2}$ " = 1'-0"

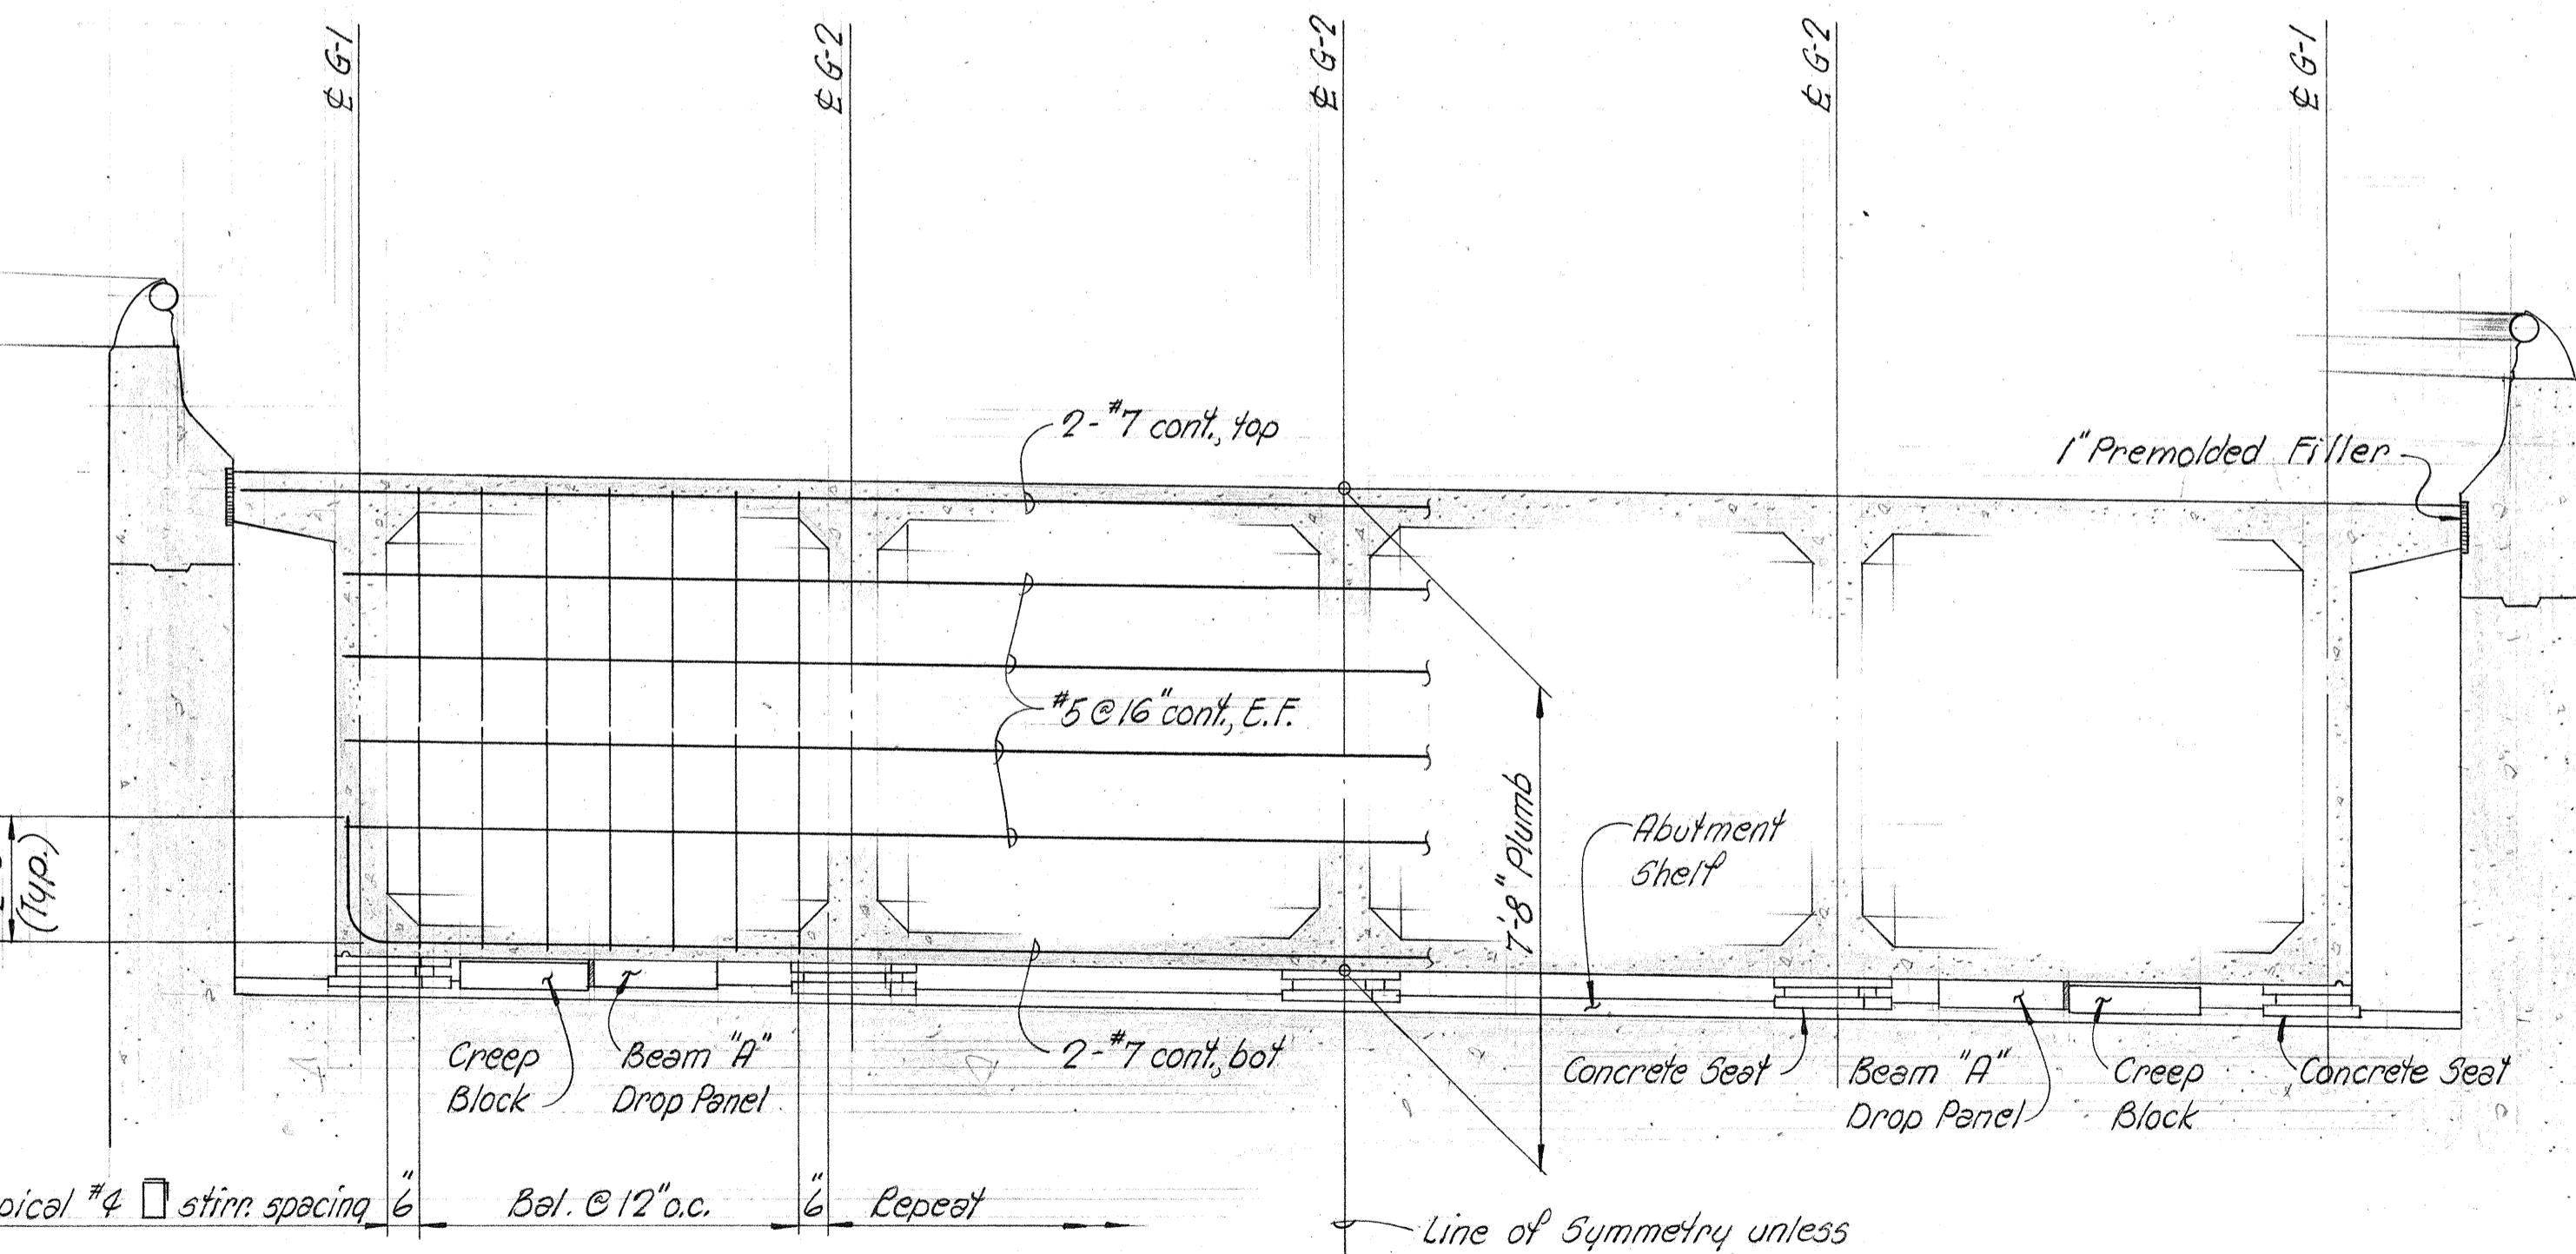

BEAM "A" ELEVATION ~ ABUTMENT #1

Scale: $\frac{3}{8}$ " = 1'-0"

ISOMETRIC SECTION ELASTOMERIC BEARING PAD DETAIL

Scale: $\frac{1}{2}$ " = 1'-0"


This work was prepared by me or under my supervision.
Howard Y. Fukuda

F.A.T. PROJ. No. I-HI-1(36)8
Scale: As Shown Date:
SHEET No. BII OF 25 SHEETS

C 075

PLAN ~ ABUTMENT #1 SHELF SHOWING BEARING DETAILS

Scale: $\frac{1}{2}$ " = 1'-0"

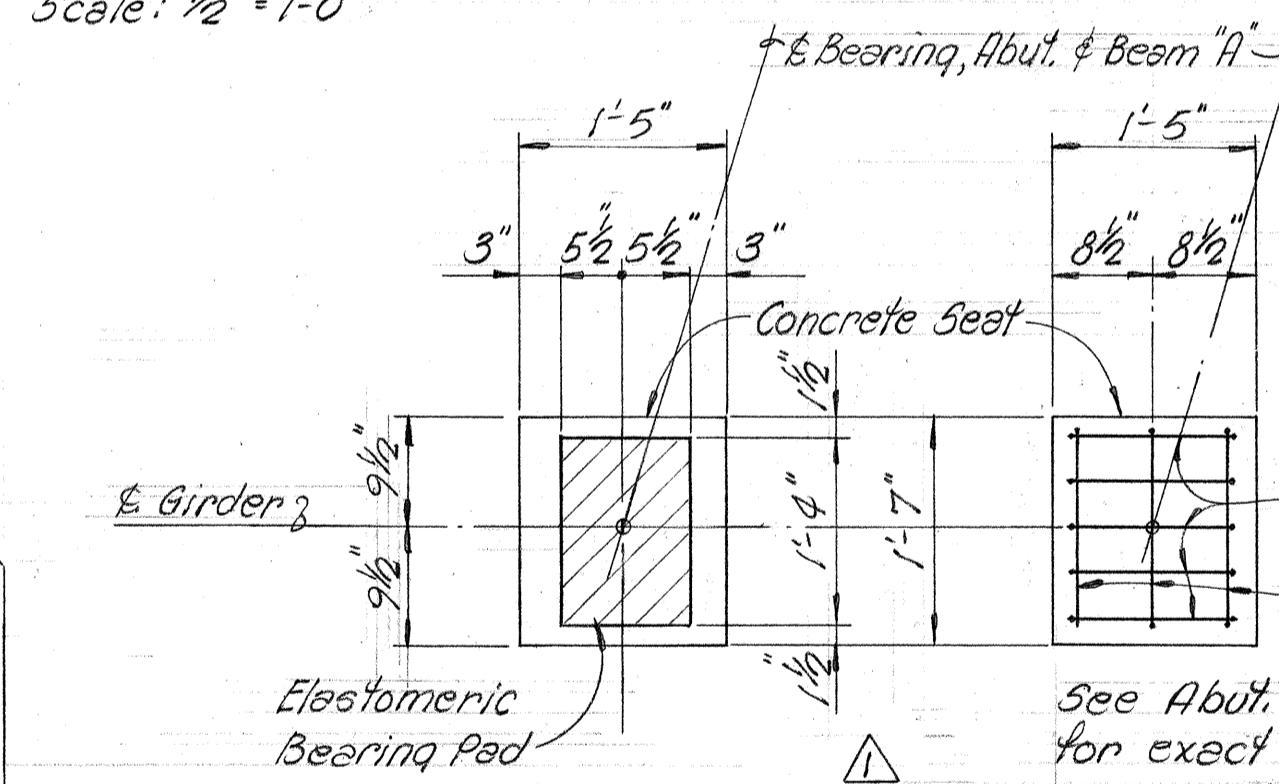


DIMENSIONS PLANS REINFORCING

TYPICAL CONCRETE SEAT DETAILS



ABUTMENTS #1 & #2

Scale: $\frac{3}{4}$ " = 1'-0"

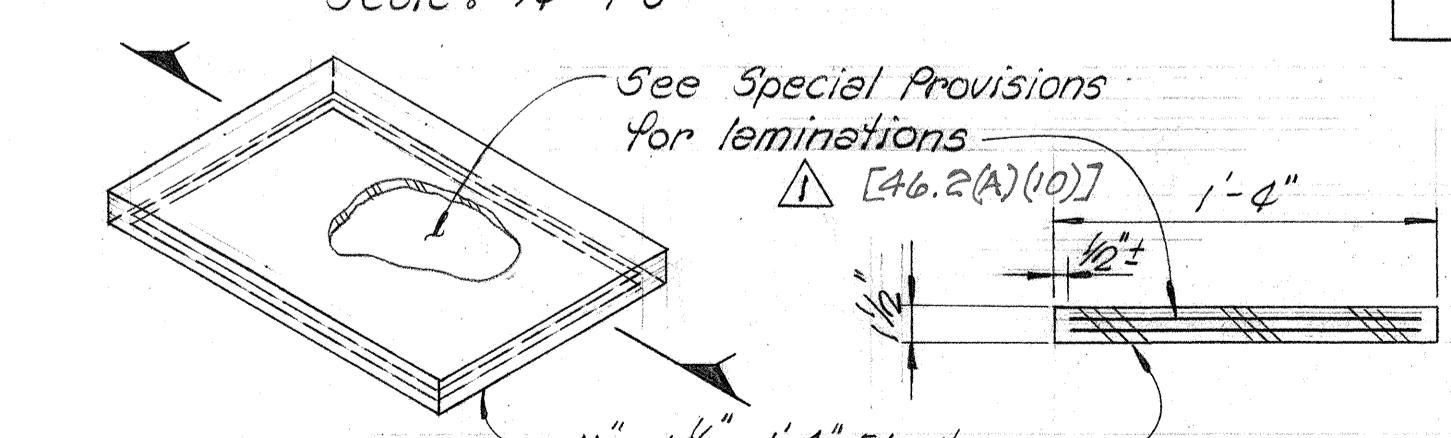

Revision #1 = Lowered Abutment Shelf & revised Elastomeric Pad.

DRAWINGS SHOWN ARE FOR STRUCTURE #A. STRUCTURE #B SIMILAR.

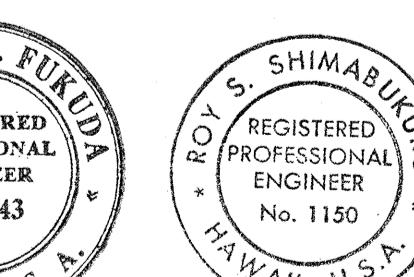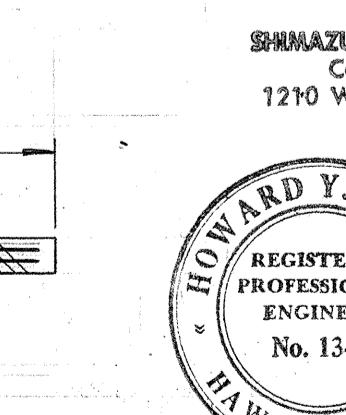






STATE OF HAWAII
DEPARTMENT OF TRANSPORTATION
HIGHWAYS DIVISION

WAIAWA INTERCHANGE
STRUCTURE No. 4A & 4B

F.A.T. PROJ. No. I-HI-1(36)8
Scale: As Shown Date:

SHEET No. BII OF 25 SHEETS

FED. ROAD DIST. NO.	STATE	FED. AID PROJ. NO.	FISCAL YEAR	SHEET NO.	TOTAL SHEETS
HAWAII	HAW.	IHI-1(36)8	1968	CO 4	4

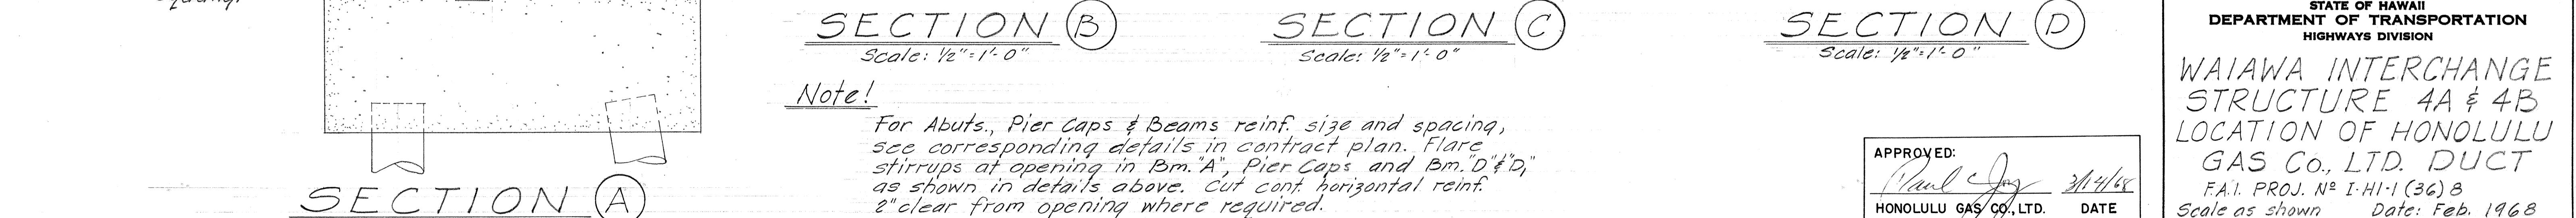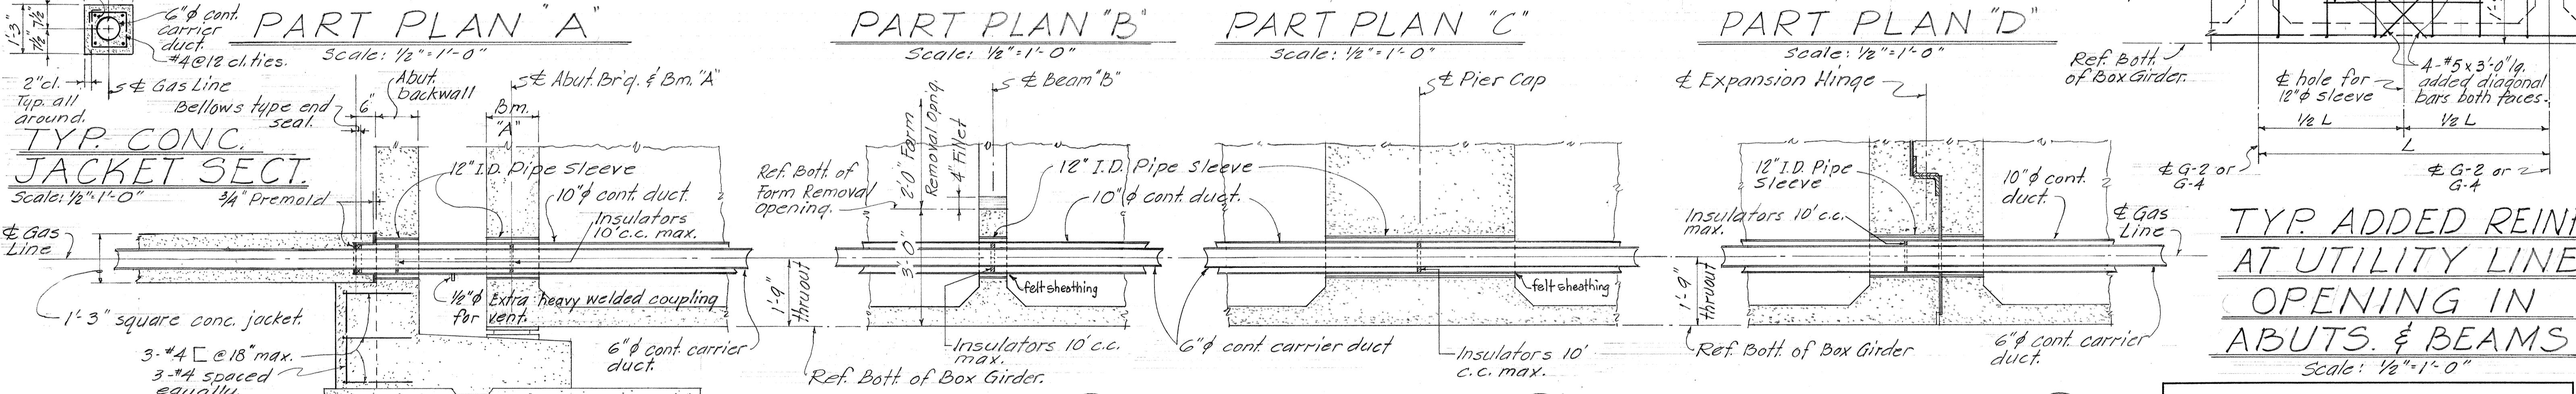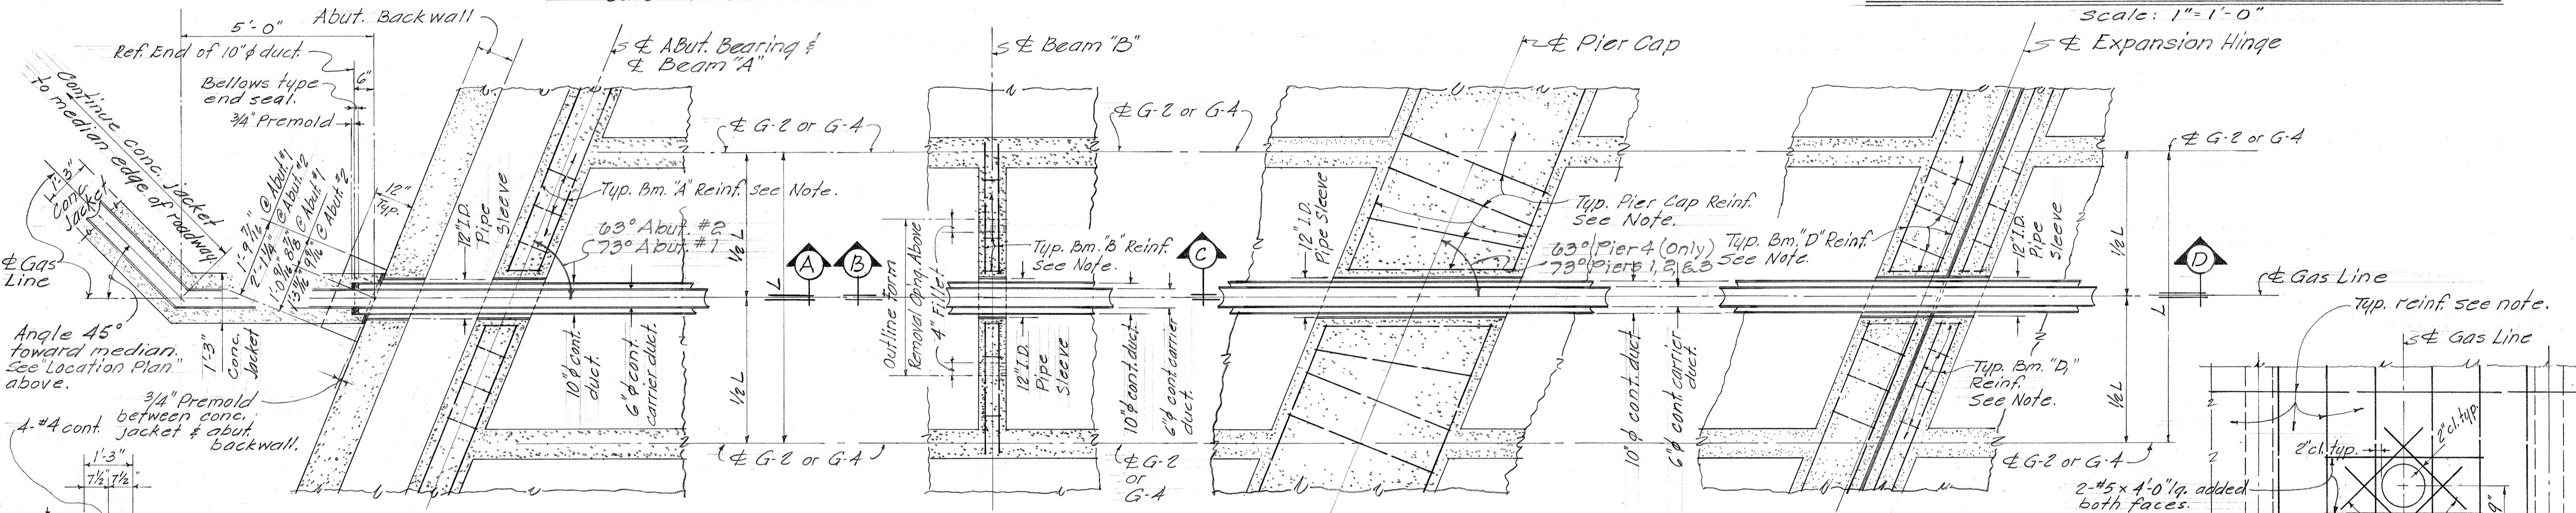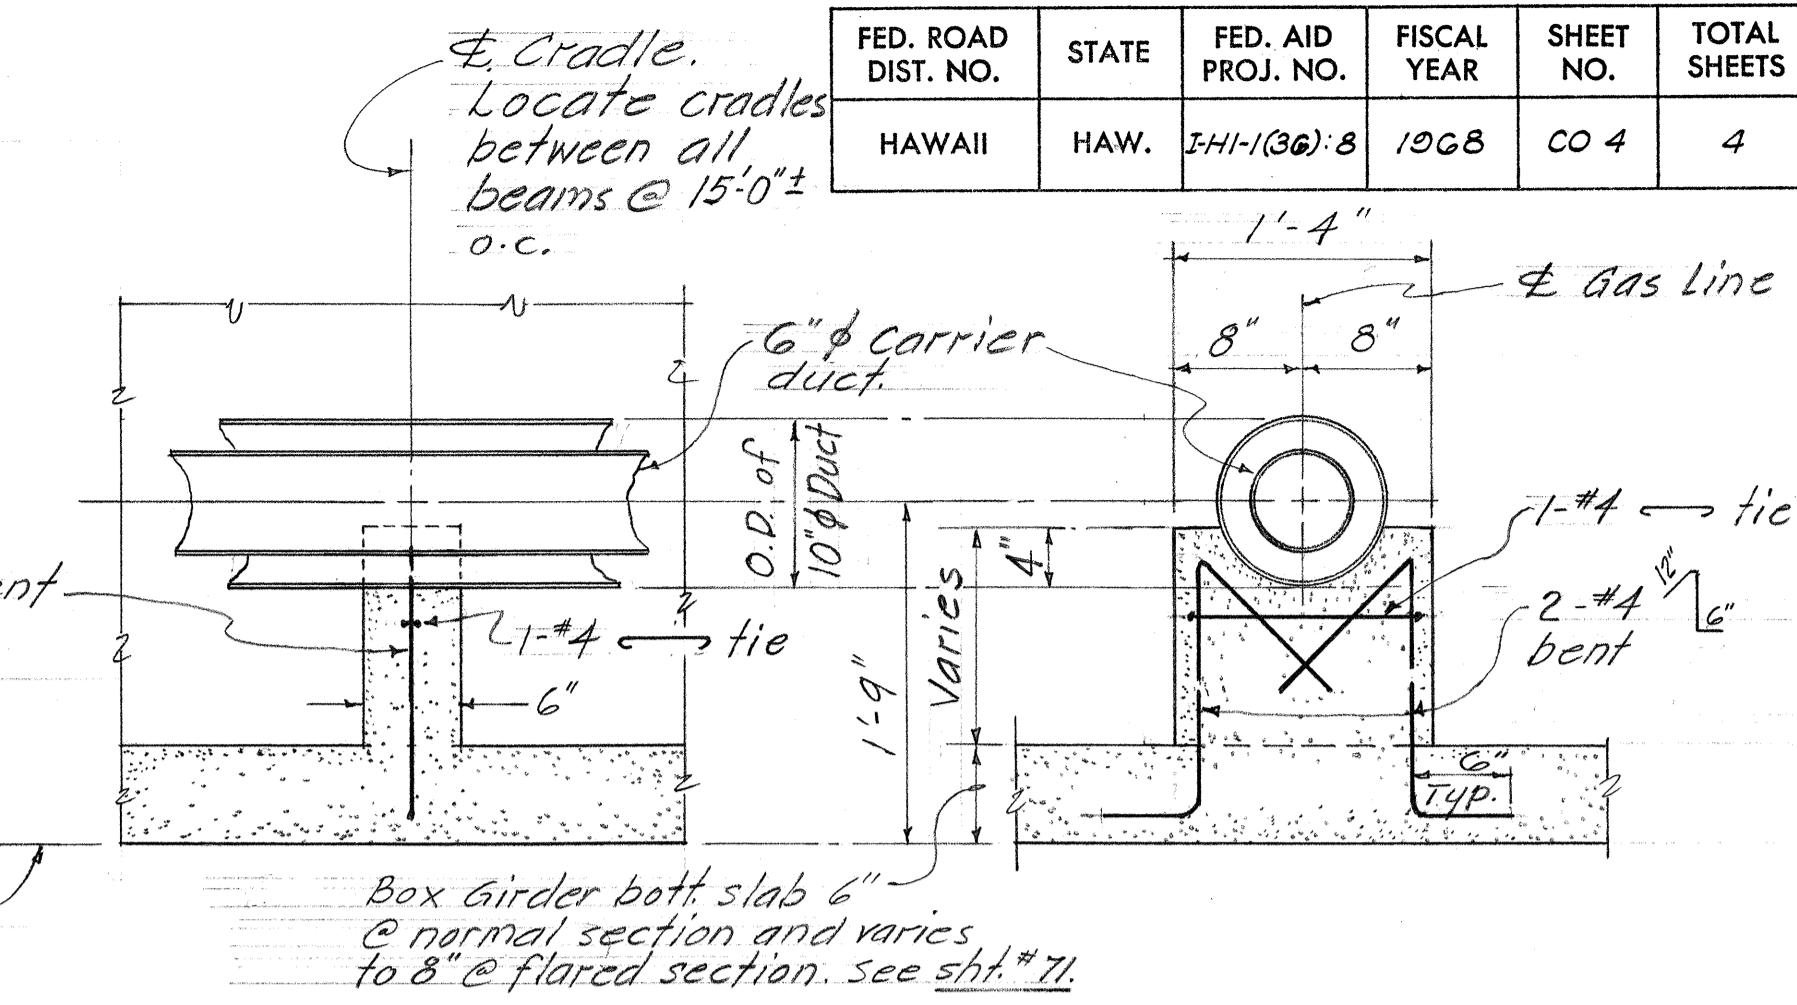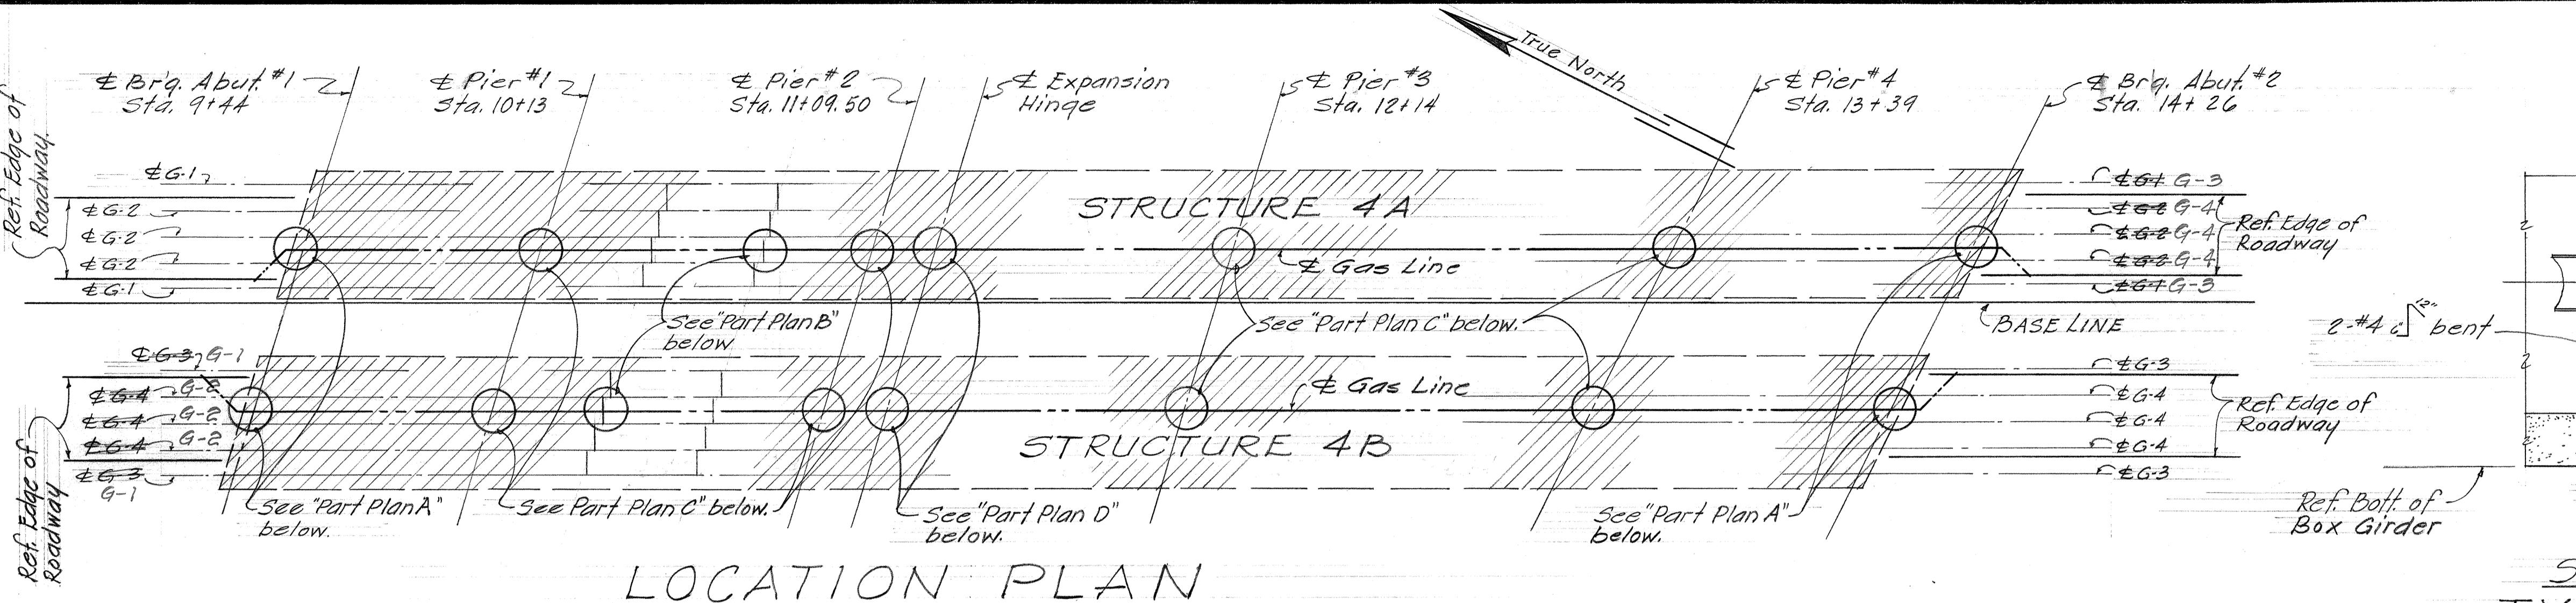

Note!

For Abuts., Pier Caps & Beams reinf. size and spacing, see corresponding details in contract plan. Flare stirrups at opening in Bm. "A", Pier Caps and Bm. "D" & "D", as shown in details above. Cut cont. horizontal reinf. 2" clear from opening where required.


APPROVED:
Paul C. Jay
HONOLULU GAS CO., LTD. DATE
3/14/68

STATE OF HAWAII
DEPARTMENT OF TRANSPORTATION
HIGHWAYS DIVISION

WAIWAIA INTERCHANGE
STRUCTURE 4A & 4B
LOCATION OF HONOLULU
GAS CO., LTD. DUCT
F.A.T. PROJ. N° I-HI-1(36)8
Scale as shown Date: Feb. 1968

SHEET NO. 4 OF 4 SHEETS

FED. ROAD DIST. NO.	STATE	FED. AID PROJ. NO.	FISCAL YEAR	SHEET NO.	TOTAL SHEETS
HAWAII	HAW.	I-HI-368	1967	0076	124

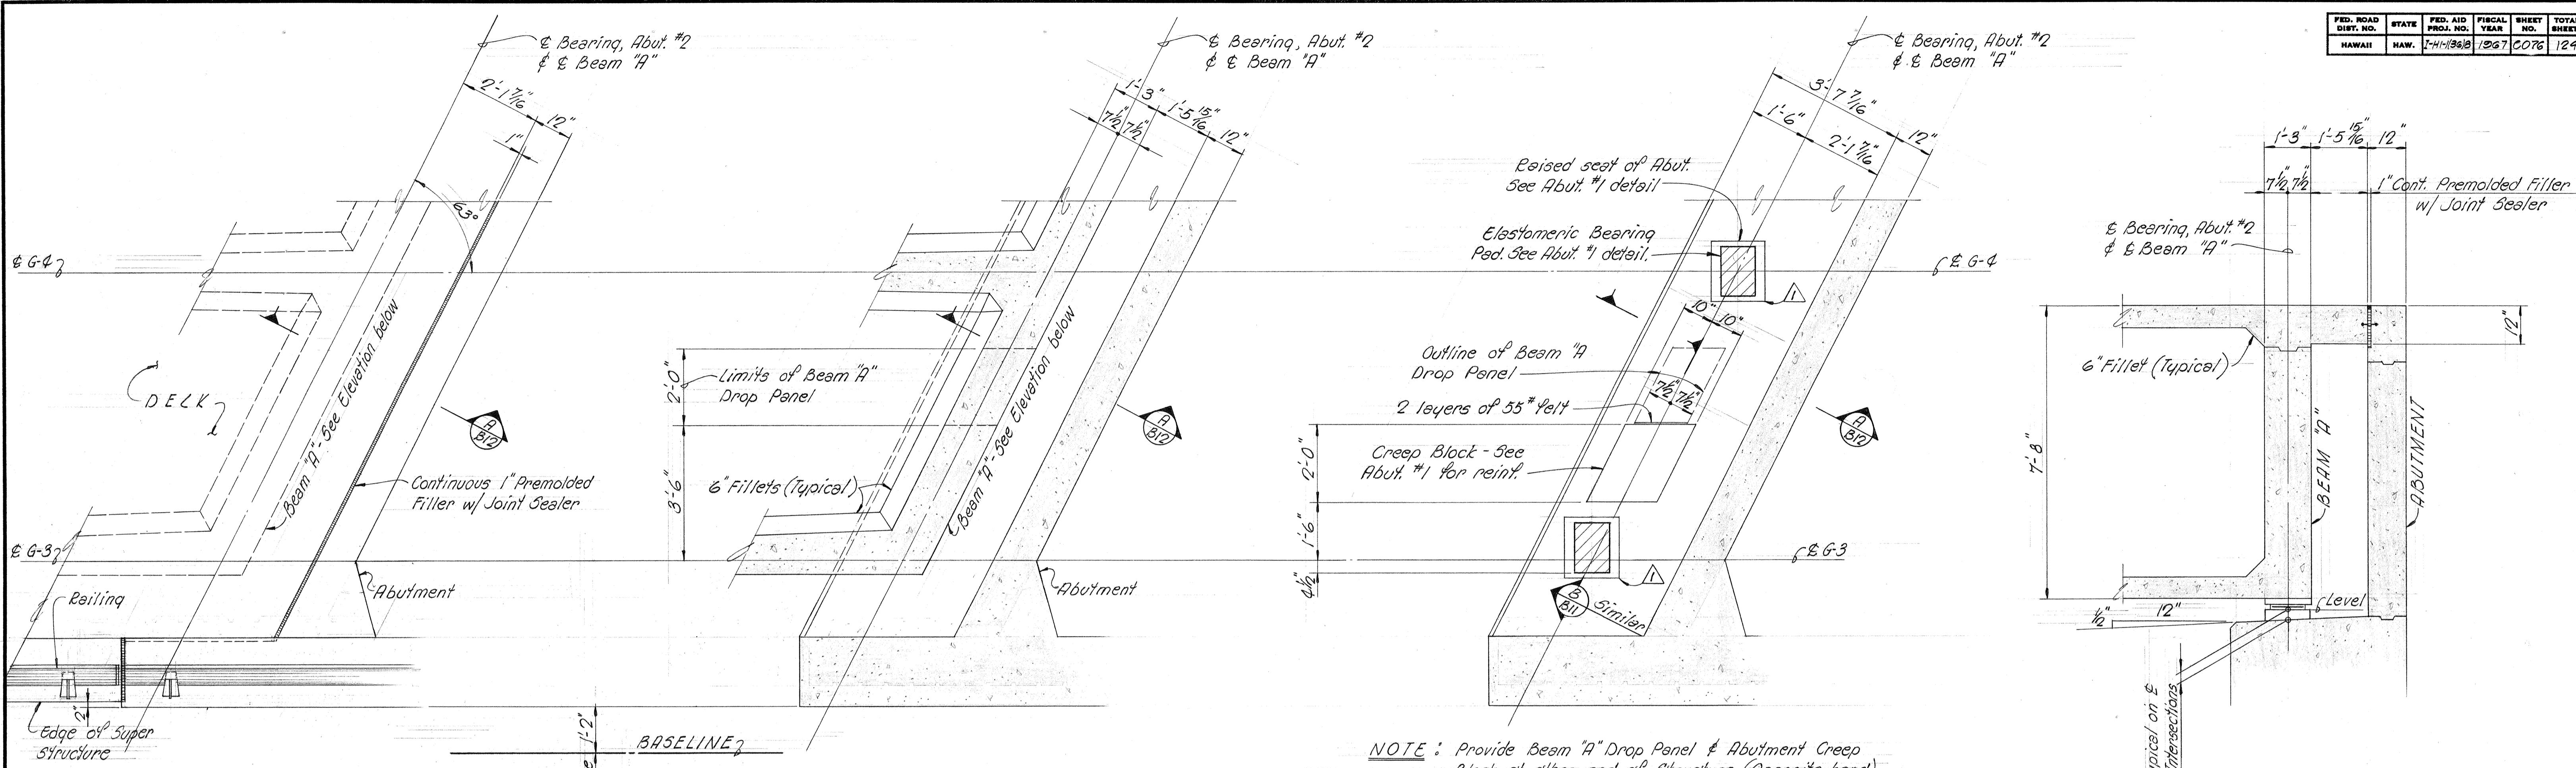

DECK PLAN ~ ABUTMENT #2

Scale: $\frac{1}{2"} = 1'-0"$

MID-DEPTH PLAN SECTION
OF DECK ~ ABUTMENT #2


Scale: $\frac{1}{2"} = 1'-0"$

PLAN ~ ABUTMENT #2 SHELF
SHOWING BEARING DETAILS

Scale: $\frac{1}{2"} = 1'-0"$

SECTION A

Scale: $\frac{1}{2"} = 1'-0"$

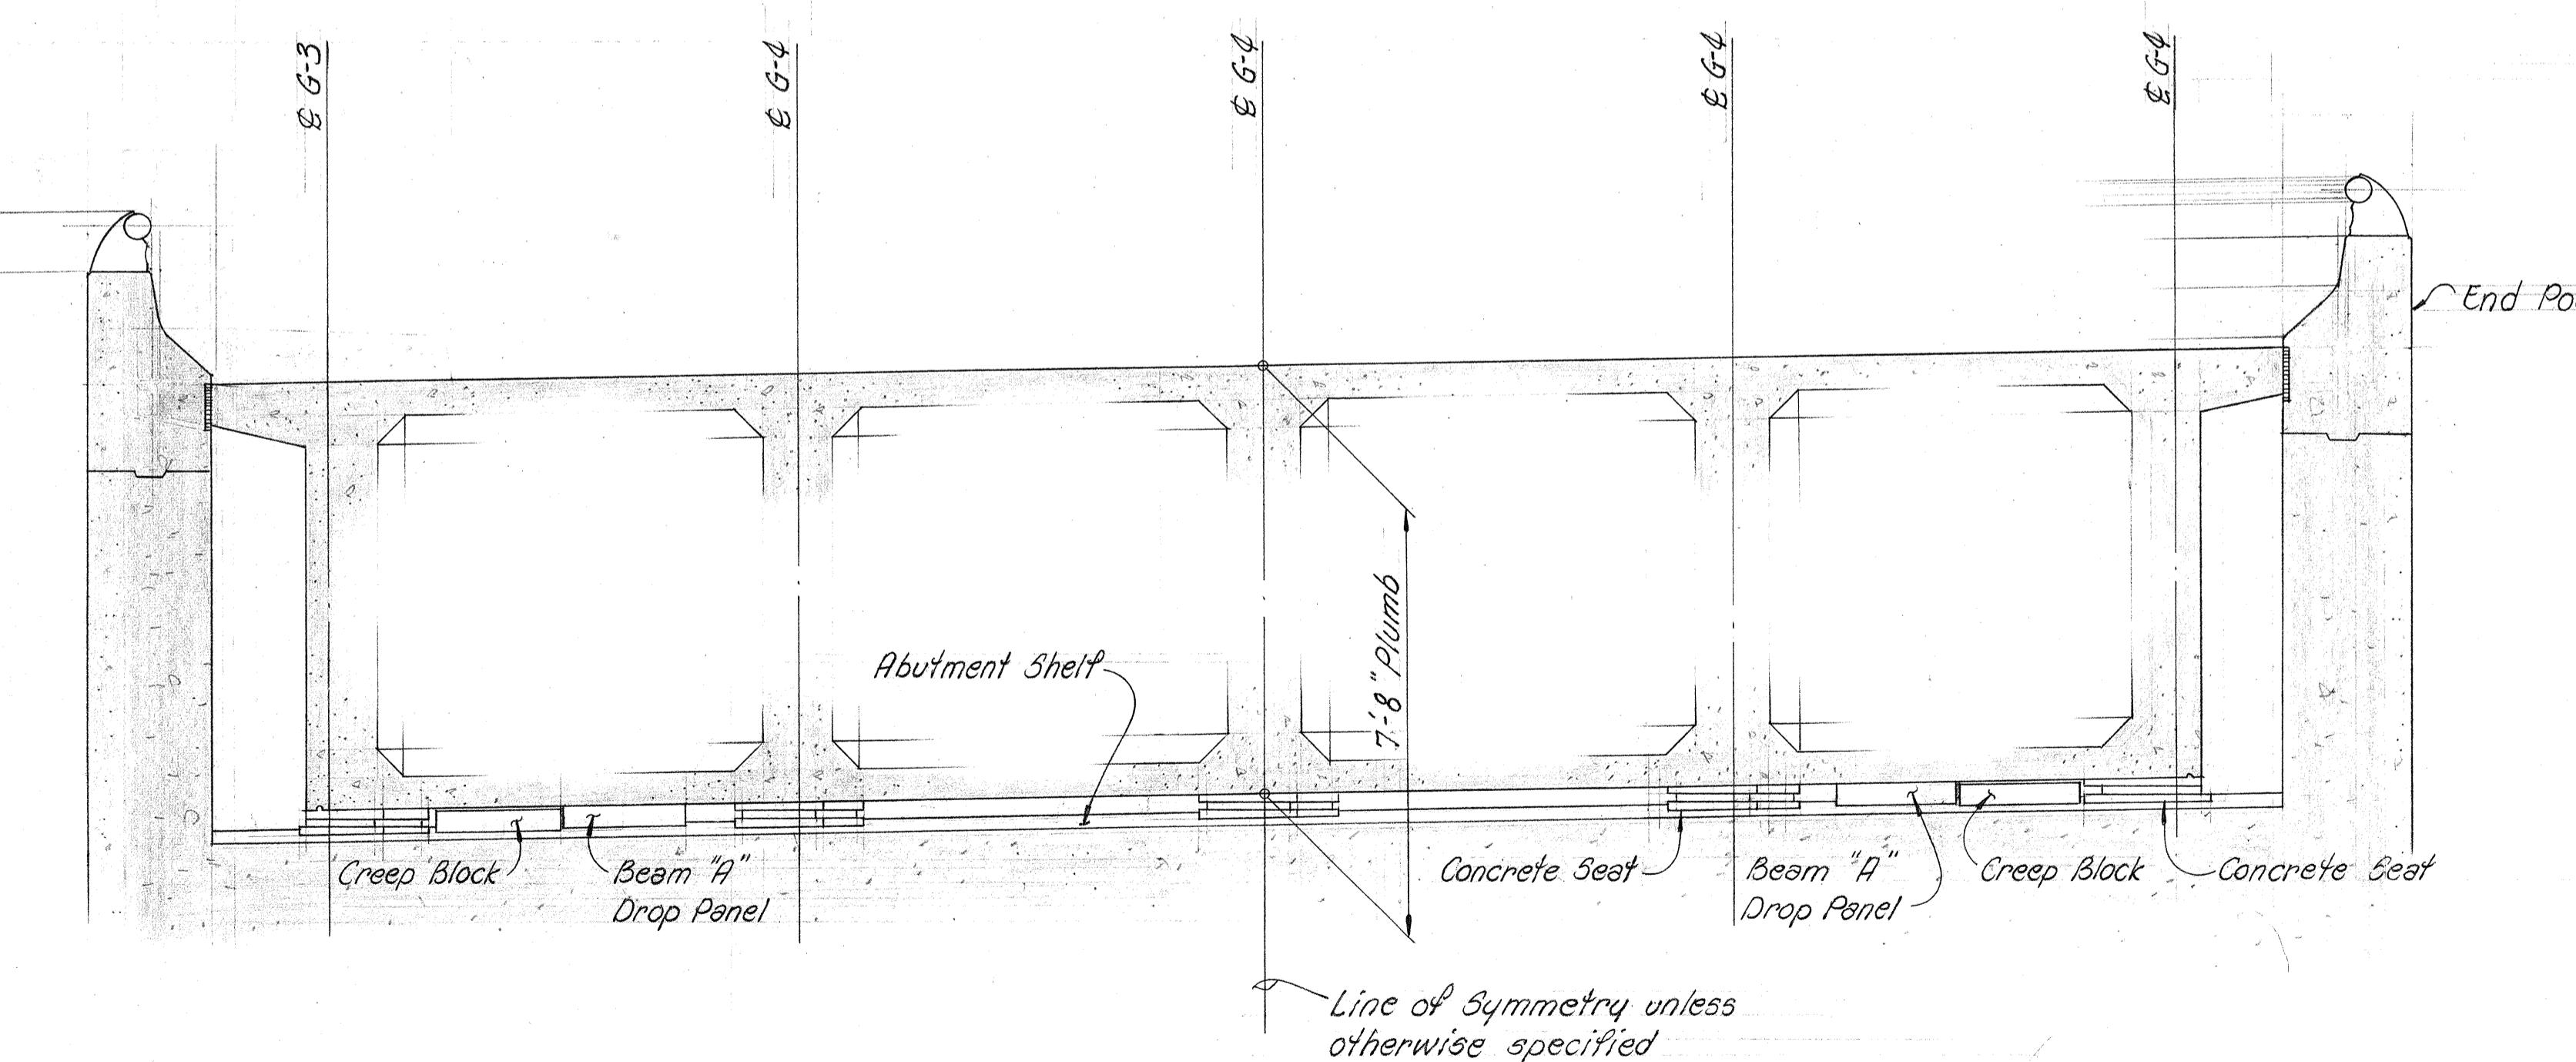



BEAM "A" ELEVATION ~ ABUTMENT #2

Scale: $\frac{3}{8"} = 1'-0"$

NOTE: Unless otherwise shown, Beam "A" & Abutment Shelf bearing details same as Abutment #1.

Revision #1 = Lowered Abutment Shelf & revised Elastomeric Pad

DRAWINGS SHOWN ARE FOR STRUCTURE 4A. STRUCTURE 4B SIMILAR.

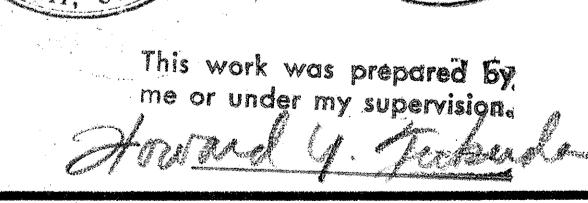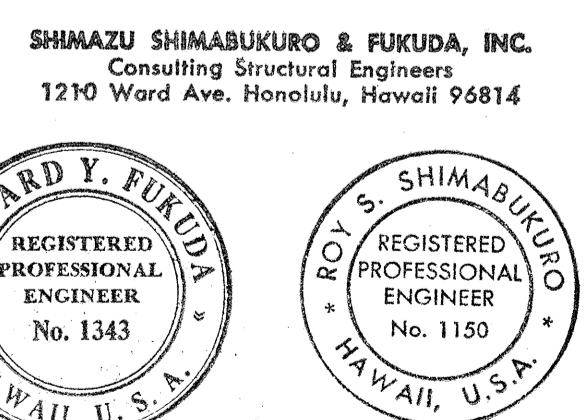

This work was prepared by
me or under my supervision.
Howard Y. Fukuda




STATE OF HAWAII
DEPARTMENT OF TRANSPORTATION
HIGHWAYS DIVISION
WAIWAIA INTERCHANGE
STRUCTURE No. 4A & 4B

F.A.I. PROJ. No. I-HI-1(36)8
Scale: As Shown Date:
Howard Y. Fukuda




SHEET No. B12 OF 25 SHEETS

(C) 076

FED. ROAD DIST. NO.	STATE	FED. AID PROJ. NO.	FISCAL YEAR	HEET NO.	TOTAL SHEETS
HAWAII	HAW.	IHM-308	1967	77	124

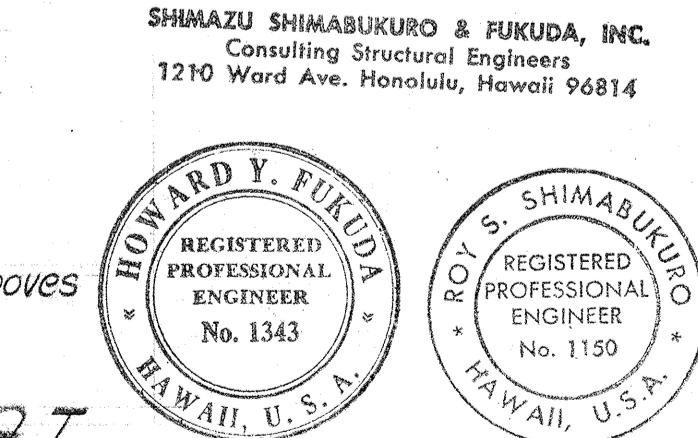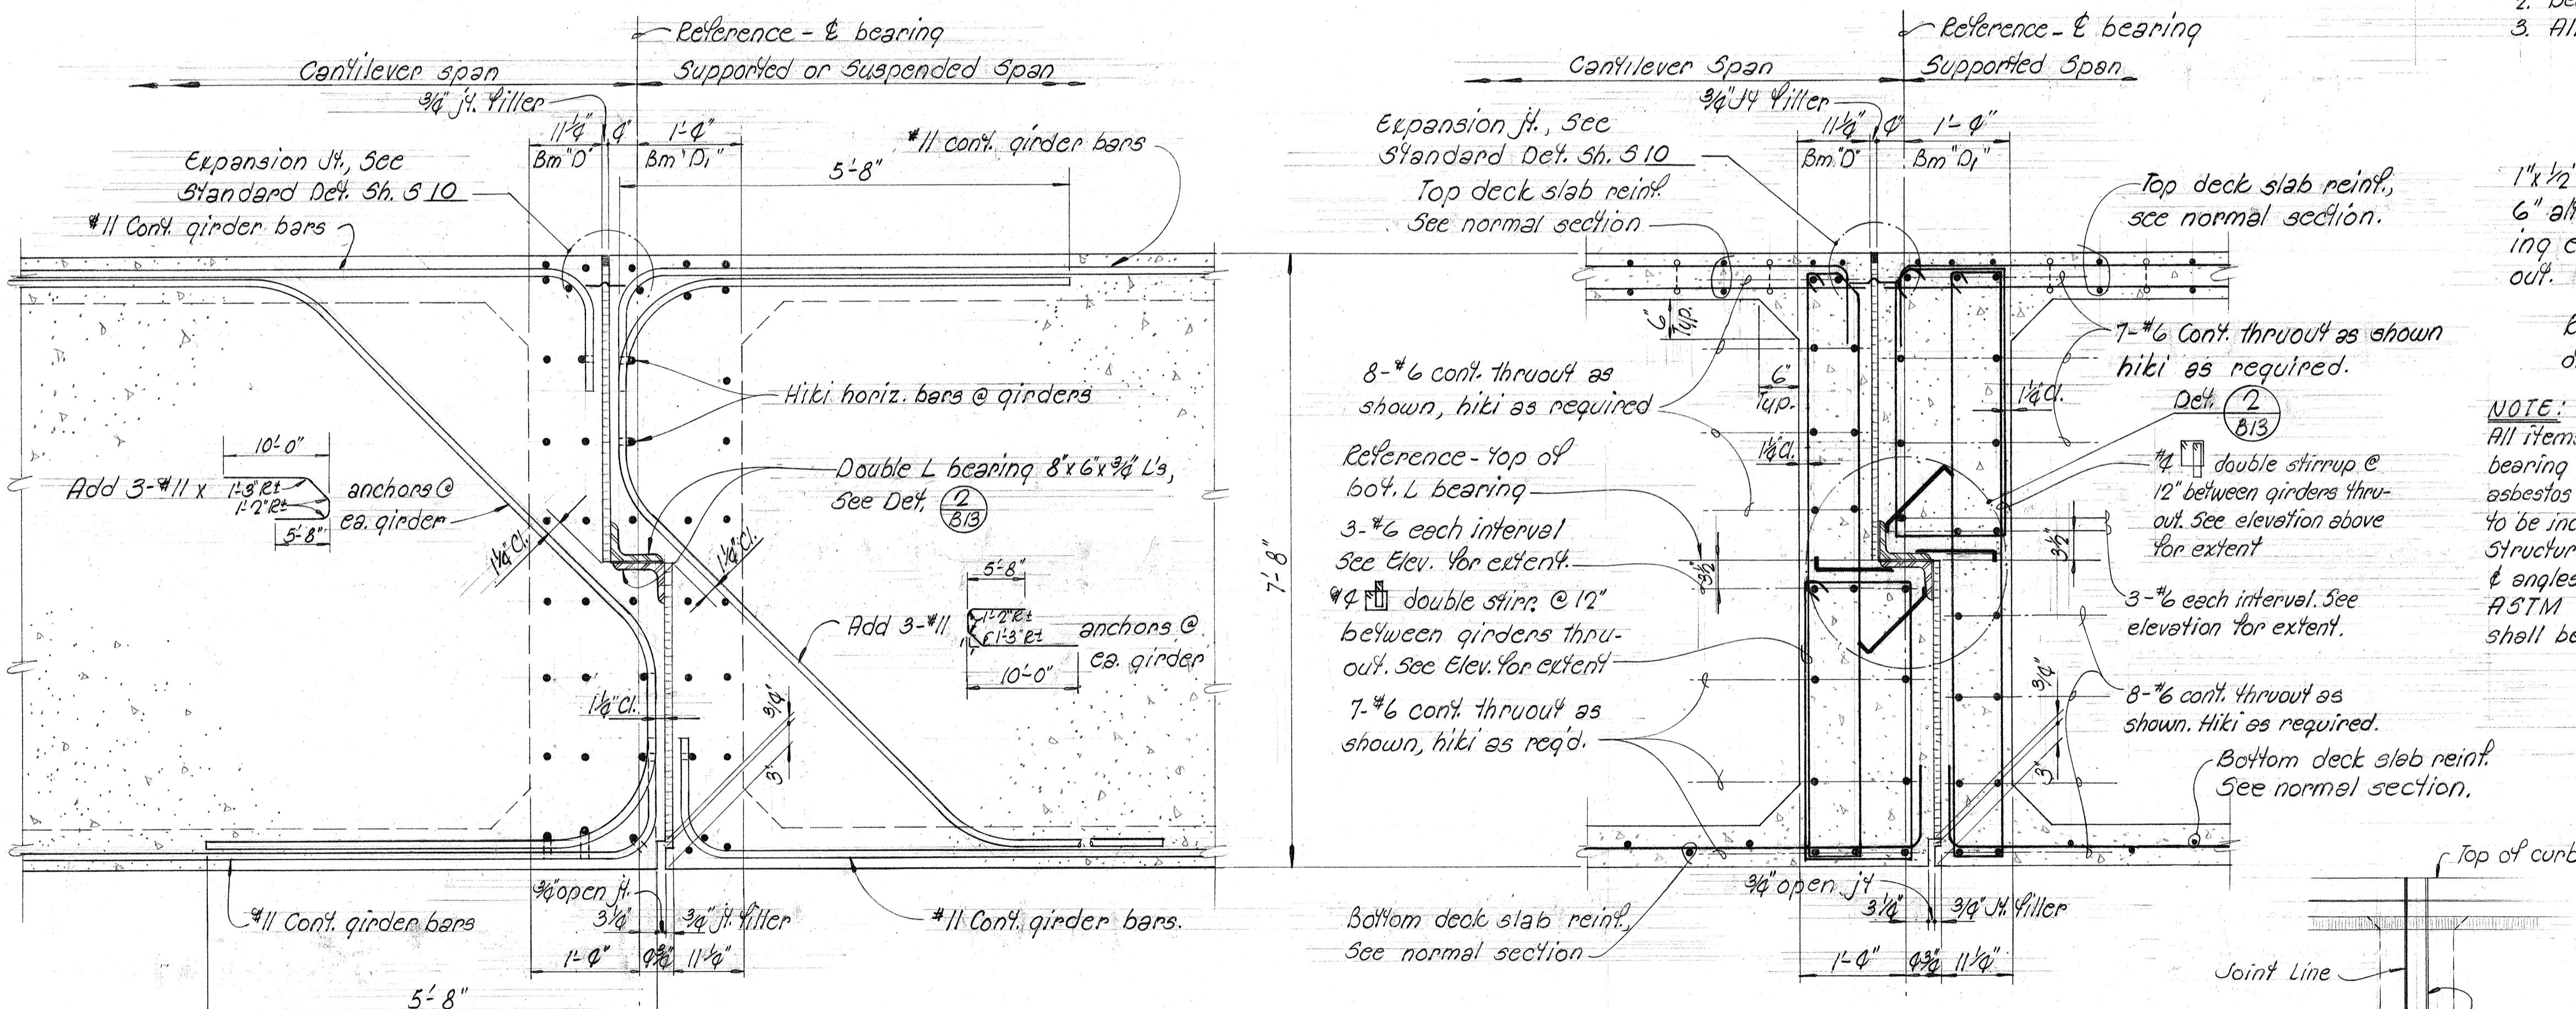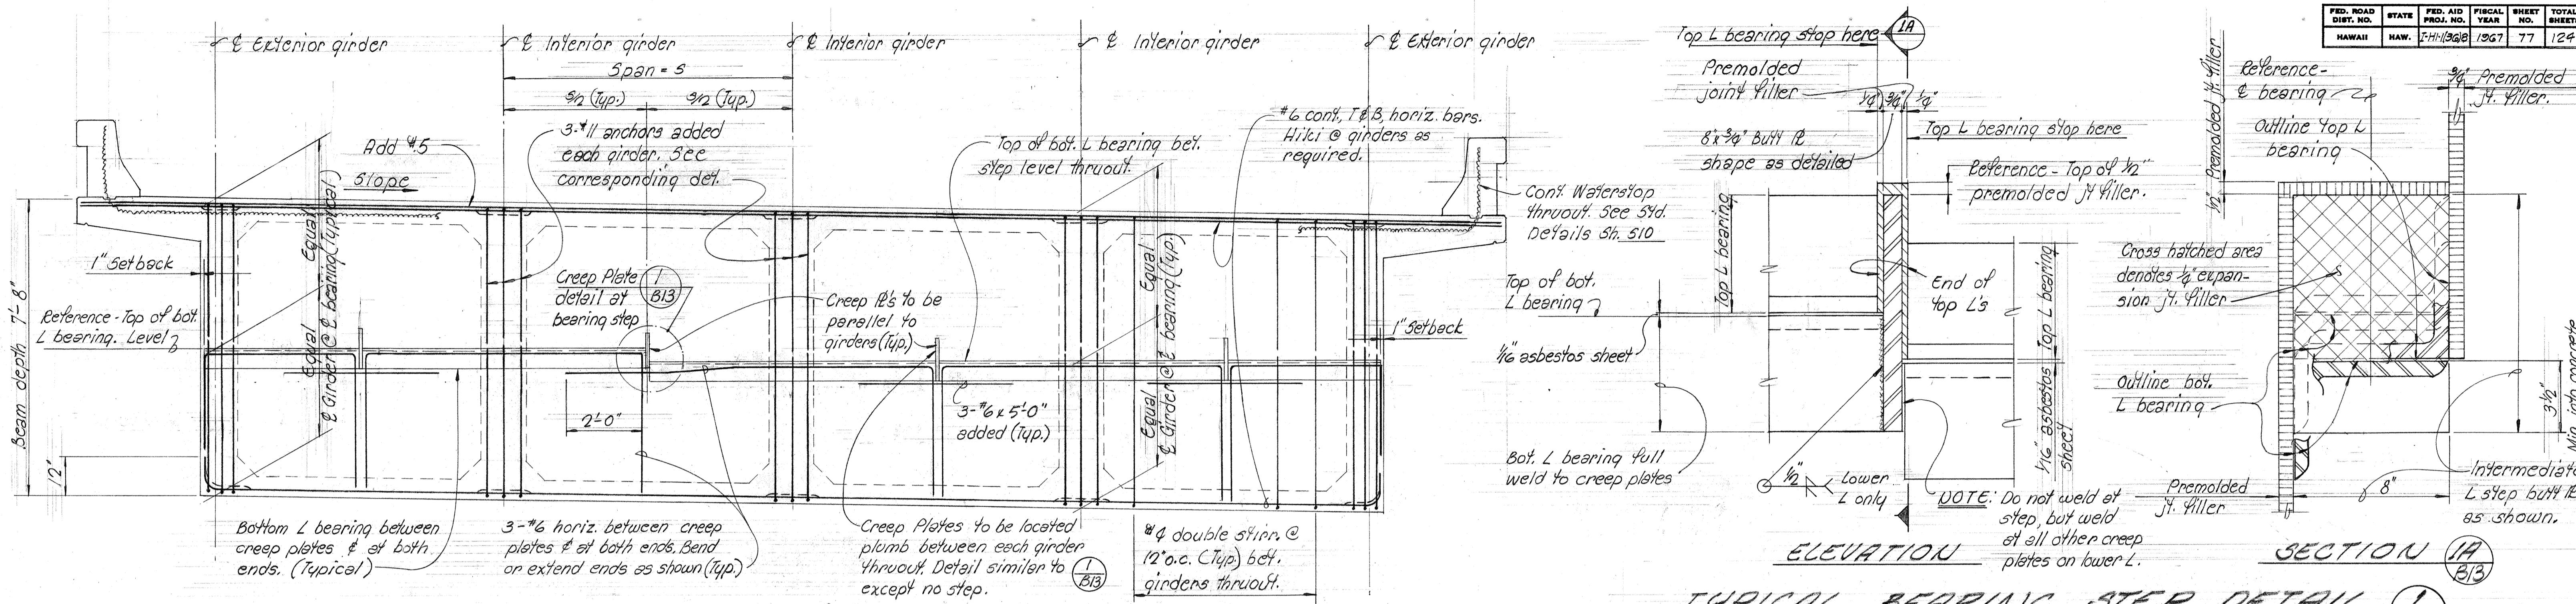


STATE OF HAWAII
DEPARTMENT OF TRANSPORTATION
HIGHWAYS DIVISION
WAIAWA INTERCHANGE
STRUCTURE No. 9A & 9B
F.A.I. DEOJ. No. I-HI-1 (3G)8
Scale: As Shown Date:
SHEET No. B13 OF 25 SHEETS

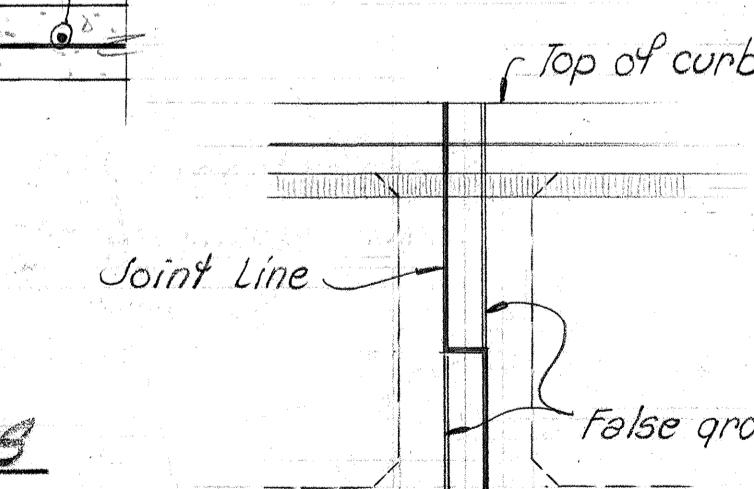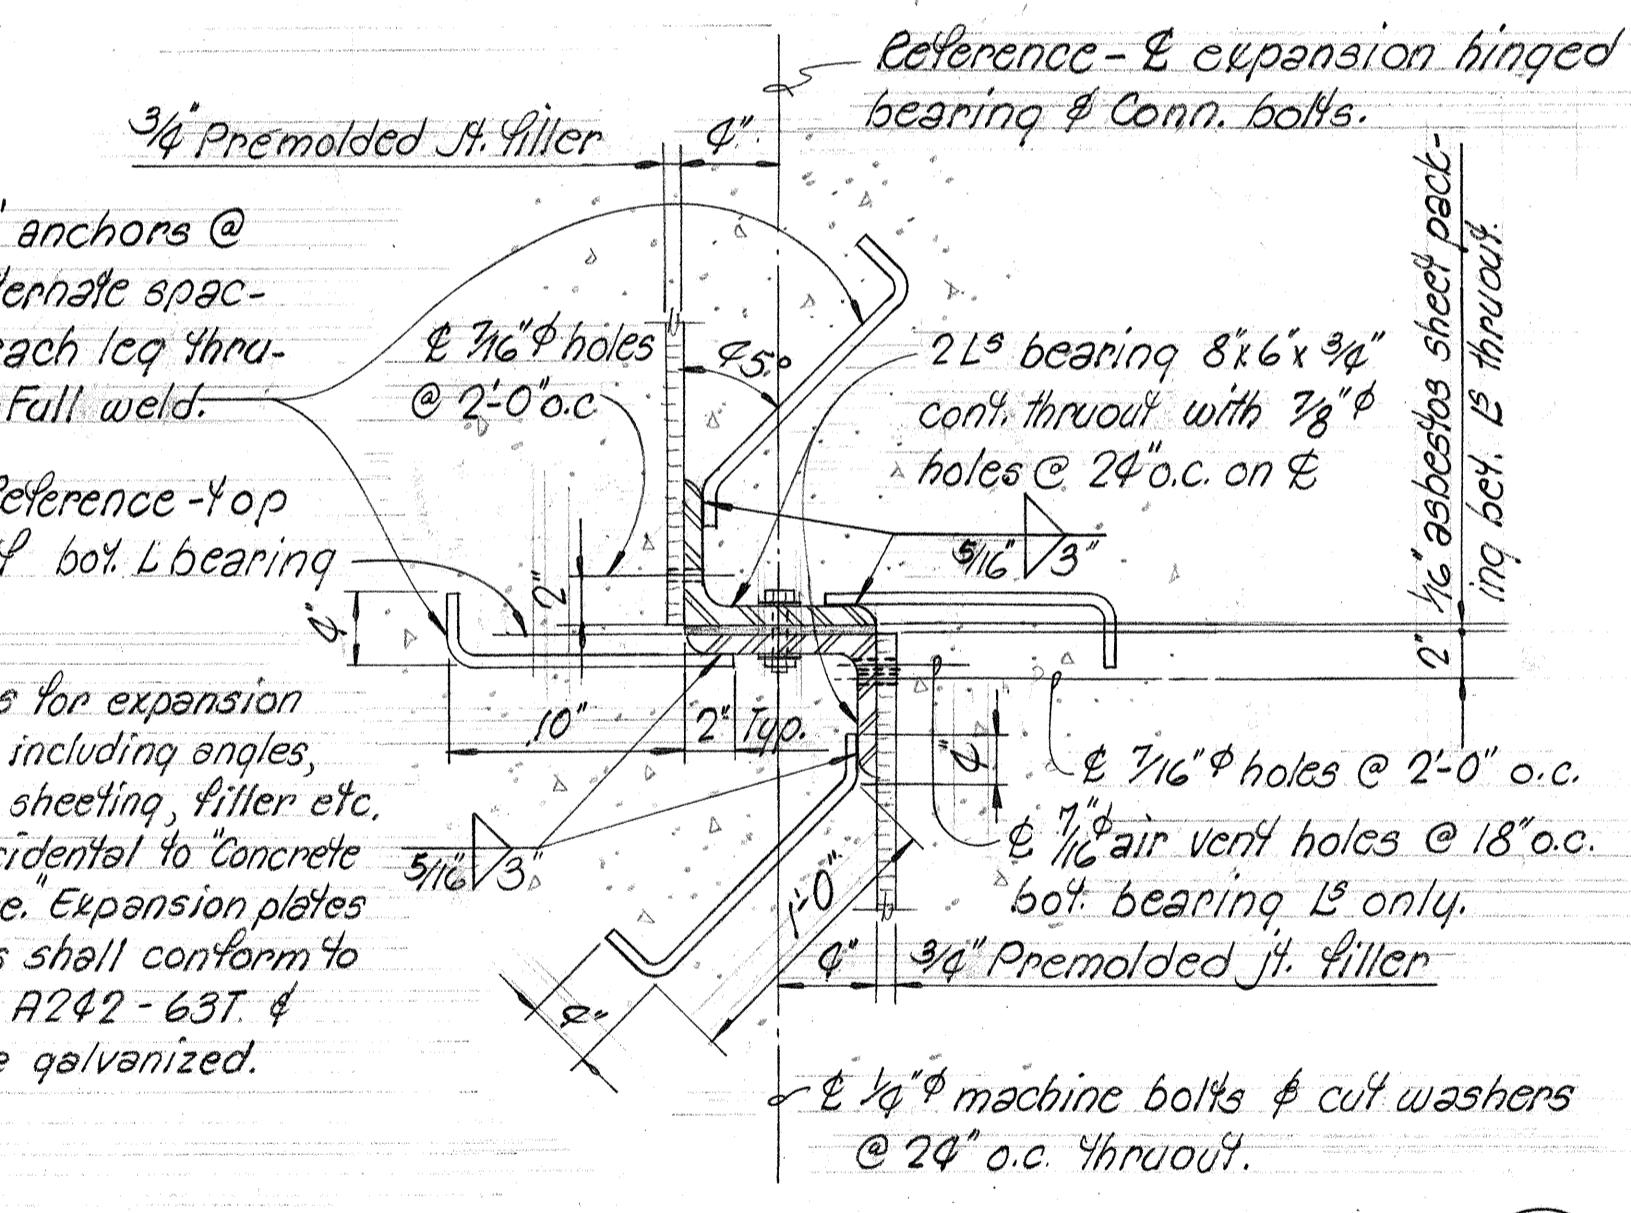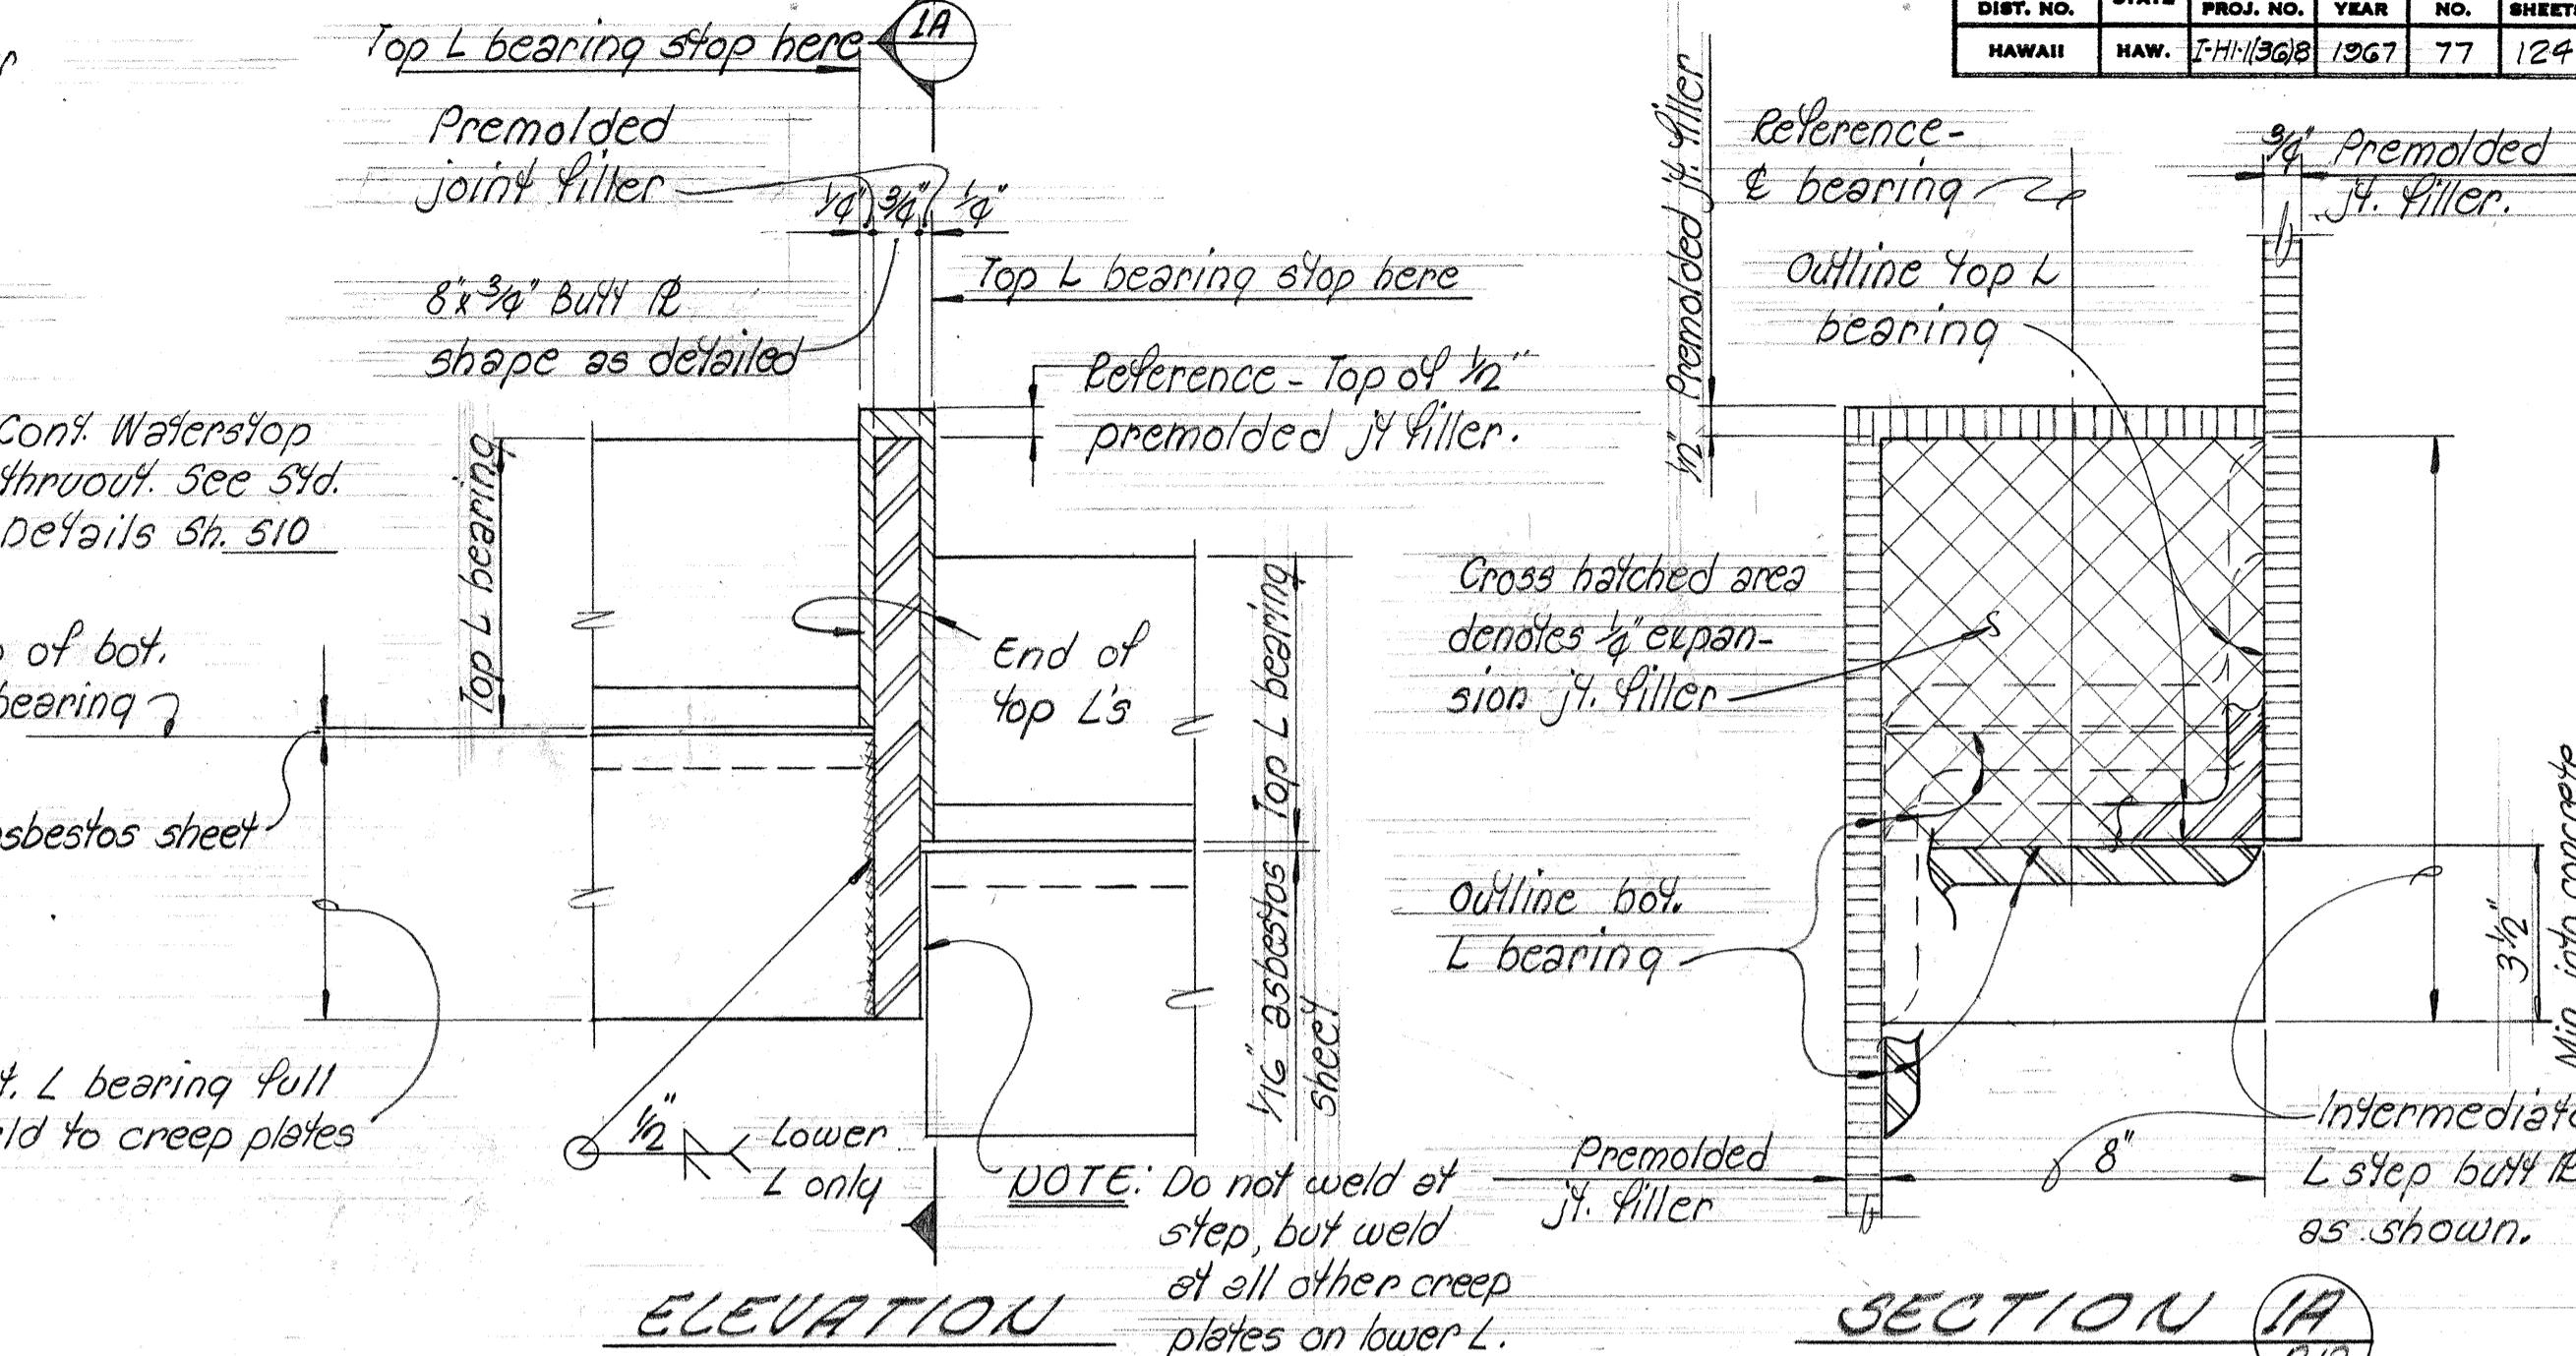


This work was prepared by
me or under my supervision.
Howard Y. Fukuda

FED. ROAD DIST. NO.	STATE PROJ. NO.	FED. AID FISCAL YEAR	SHEET NO.	TOTAL SHEETS
HAWAII	HAW. I-HI(3G)	1967	78	124

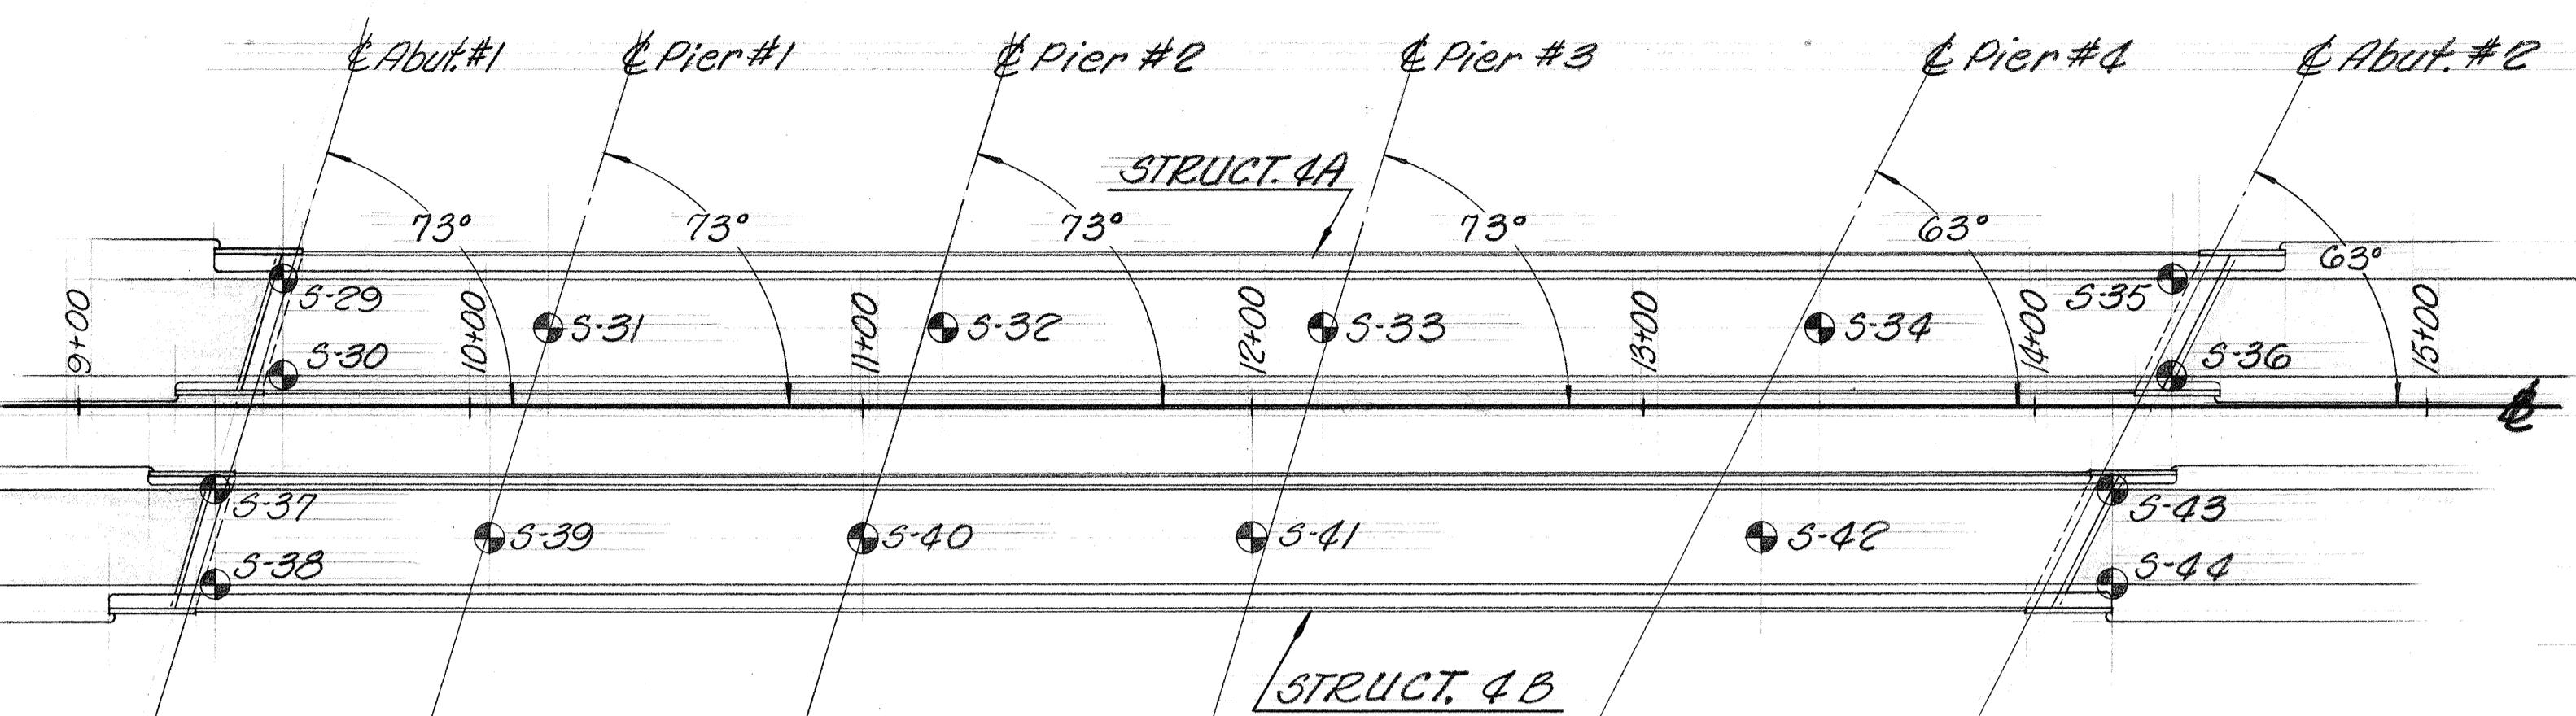



BORING PLOT PLAN

1" = 40'-0"

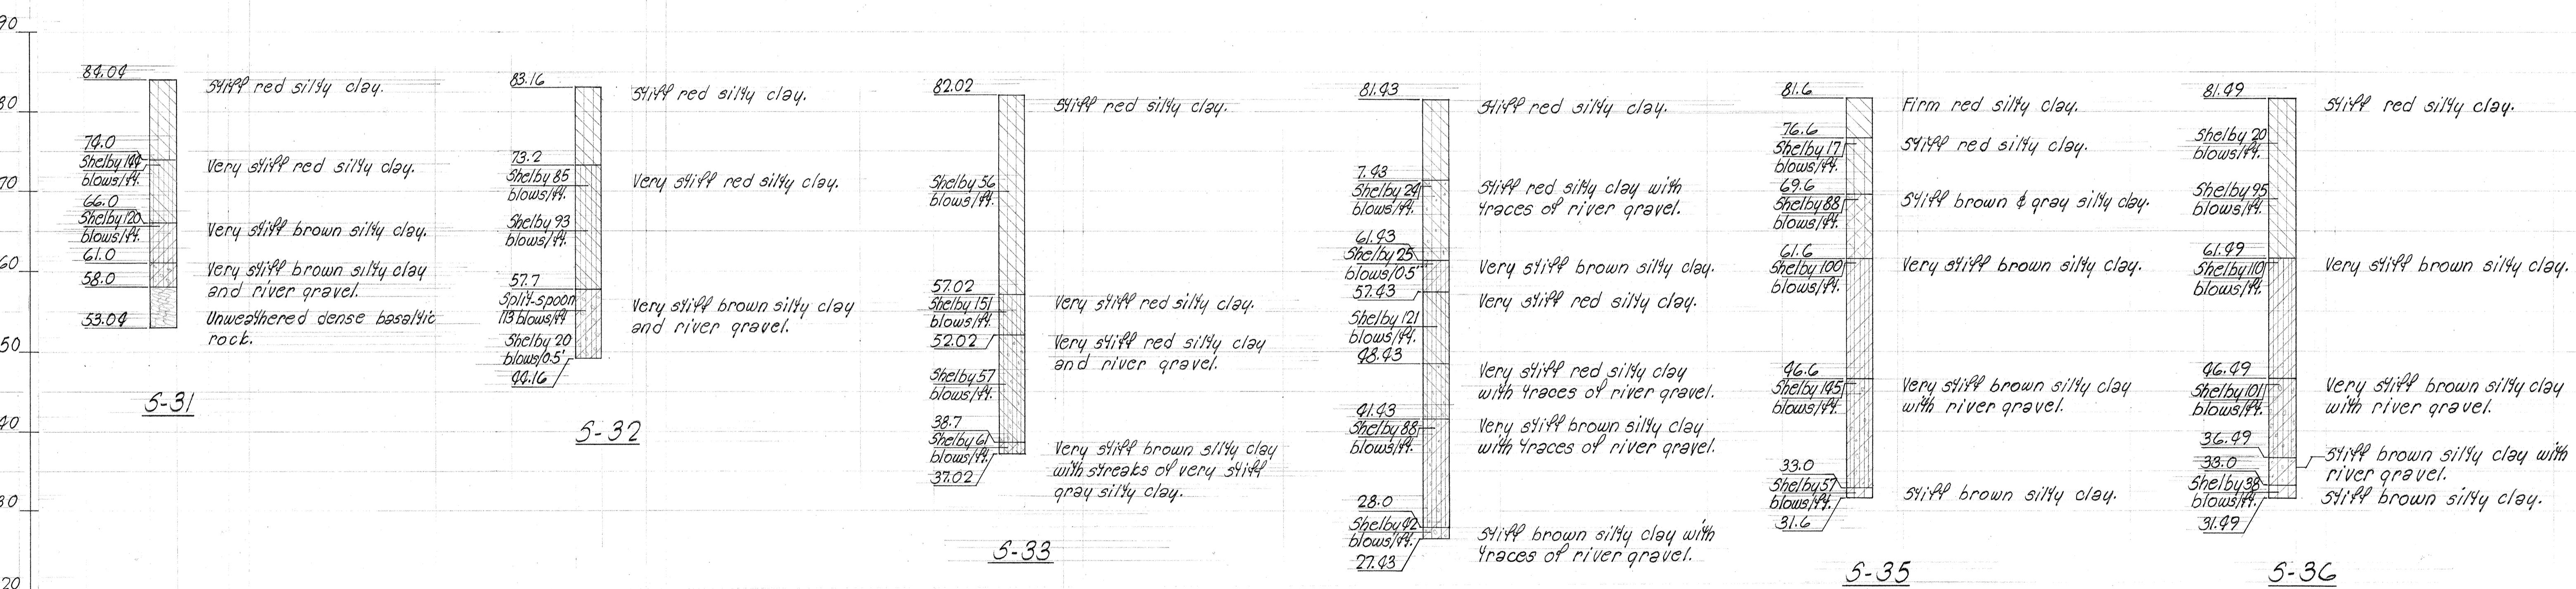

BORING LOGS FOR STRUCTURE 4A

SHIMAZU SHIMABUKURO & FUKUDA, INC.
Consulting Structural Engineers
1210 Ward Ave. Honolulu, Hawaii 96814

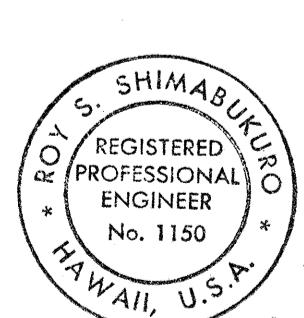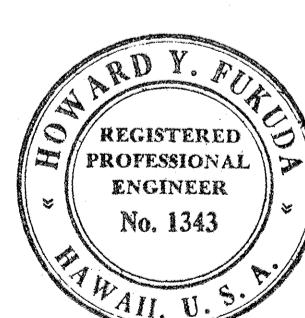

This work was prepared by
me or under my supervision.
Howard Y. Fukuda

STATE OF HAWAII
DEPARTMENT OF TRANSPORTATION
HIGHWAYS DIVISION



WAIAWA INTERCHANGE
STRUCTURE NO. 4A & 4B

F.A.I. PROJ. NO. I-HI-1(3G)8


Scale: As shown Date:

SHEET NO. B14 OF 25 SHEETS

FED. ROAD DIST. NO.	STATE PROJ. NO.	FED. AID YEAR	FISCAL NO.	SHEET TOTAL SHEETS
HAWAII	HAW.	I-4/H(34)B	1967	79 124

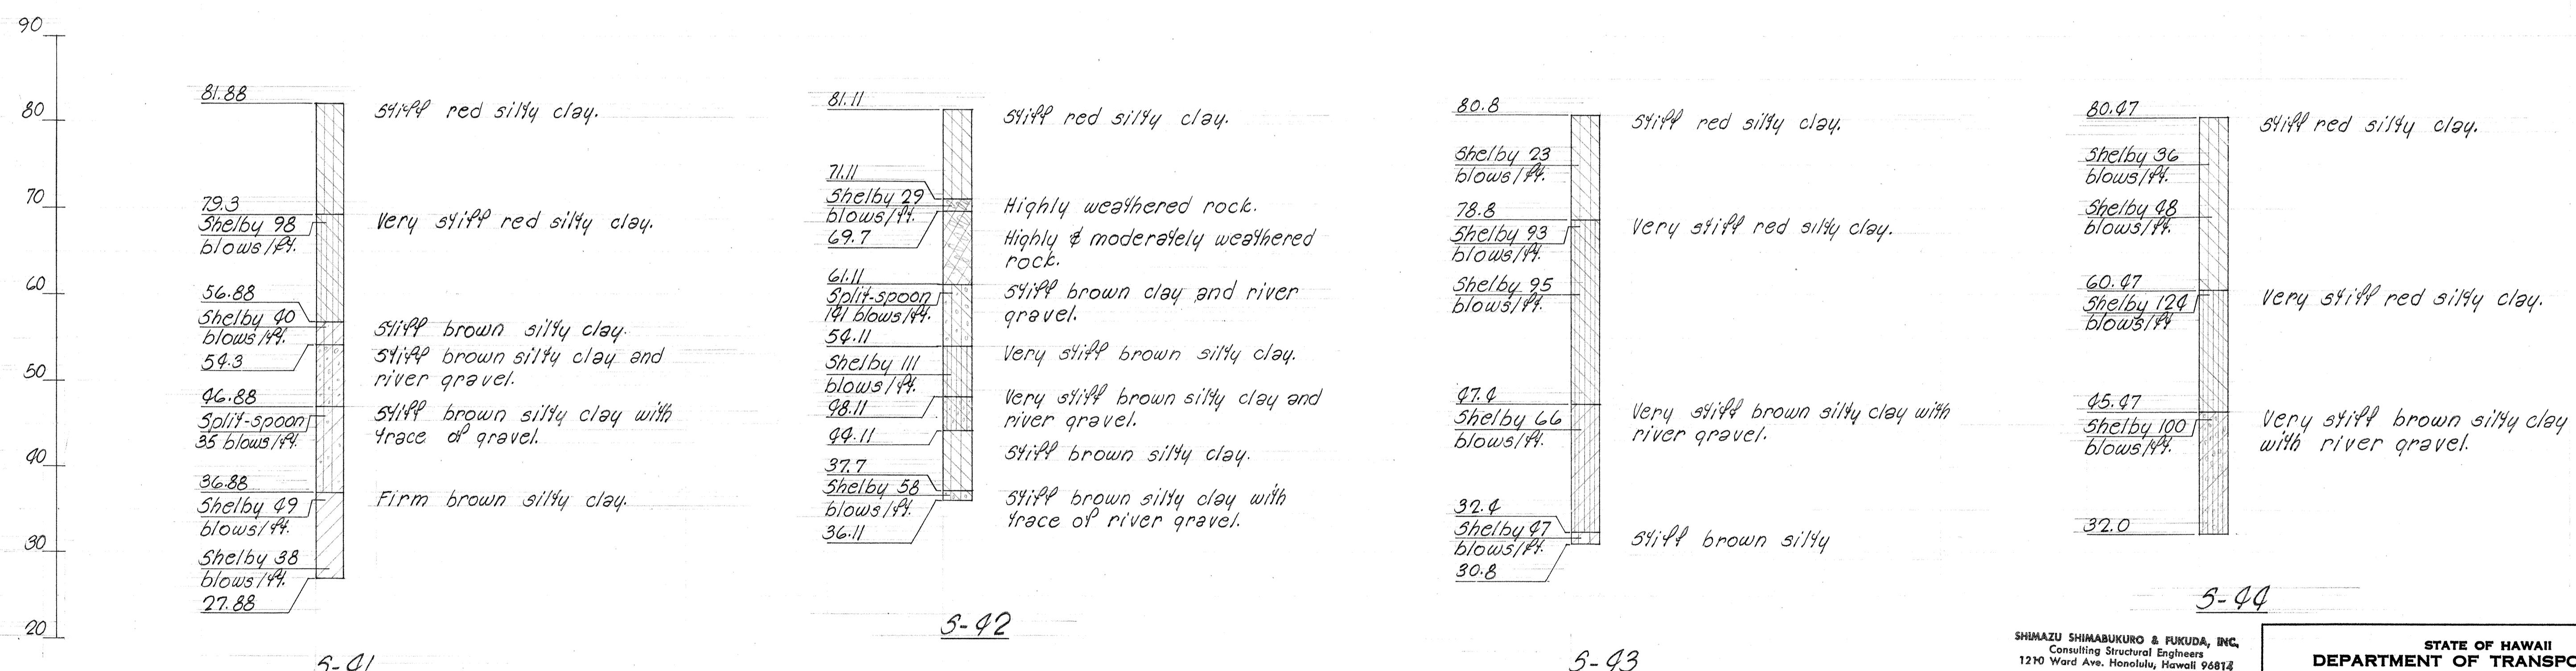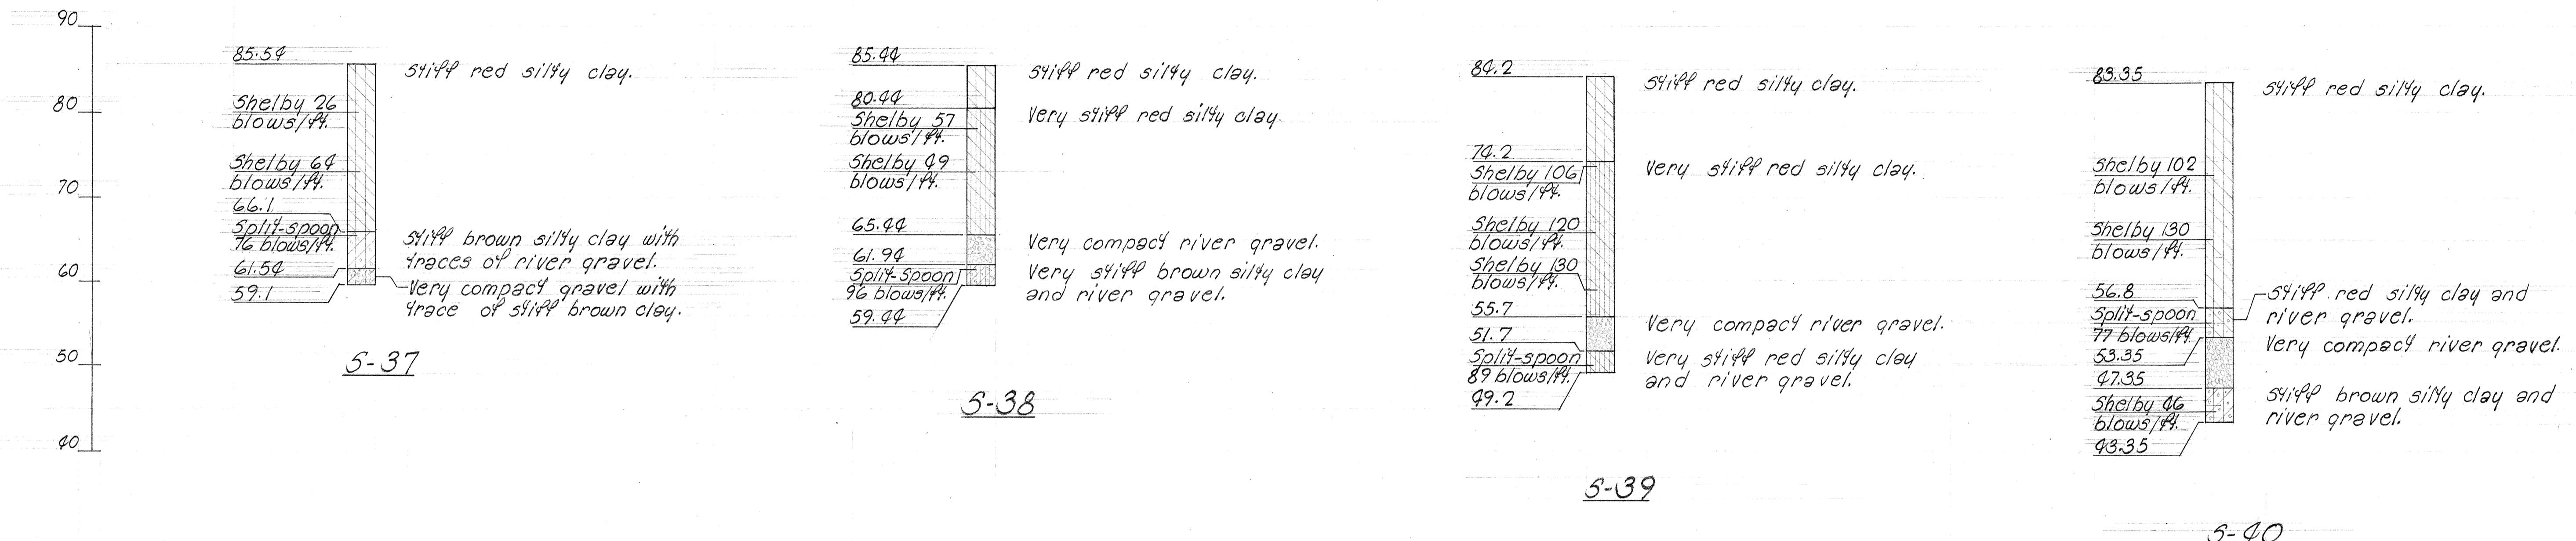

BORING LOGS FOR STRUCTURE #8

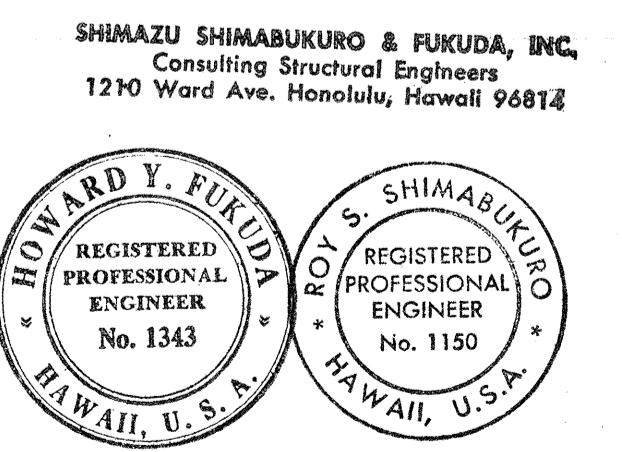

SHIMAMU SHIMABUKURO & FUKUDA, INC.
Consulting Structural Engineers
1210 Ward Ave. Honolulu, Hawaii 96814

HOWARD Y. FUKUDA
REGISTERED PROFESSIONAL ENGINEER
No. 1343
HAWAII, U.S.A.

ROY S. SHIMABUKURO
REGISTERED PROFESSIONAL ENGINEER
No. 1150
HAWAII, U.S.A.

This work was prepared by
me or under my supervision.
Howard Y. Fukuda

STATE OF HAWAII
DEPARTMENT OF TRANSPORTATION
HIGHWAYS DIVISION
WAIAWA INTERCHANGE
STRUCTURE No. I-4a & 4b
F.A.I. PROJ. No. I-HI-1(36)8
Scale: As Shown Date:
SHEET No. B15 OF 25 SHEETS
79