



FED. ROAD DIST. NO.	STATE	FED. AID PROJ. NO.	FISCAL YEAR	SHEET NO.	TOTAL SHEETS
HAWAII	HAW.	F-099-1(2)	1968	4	10

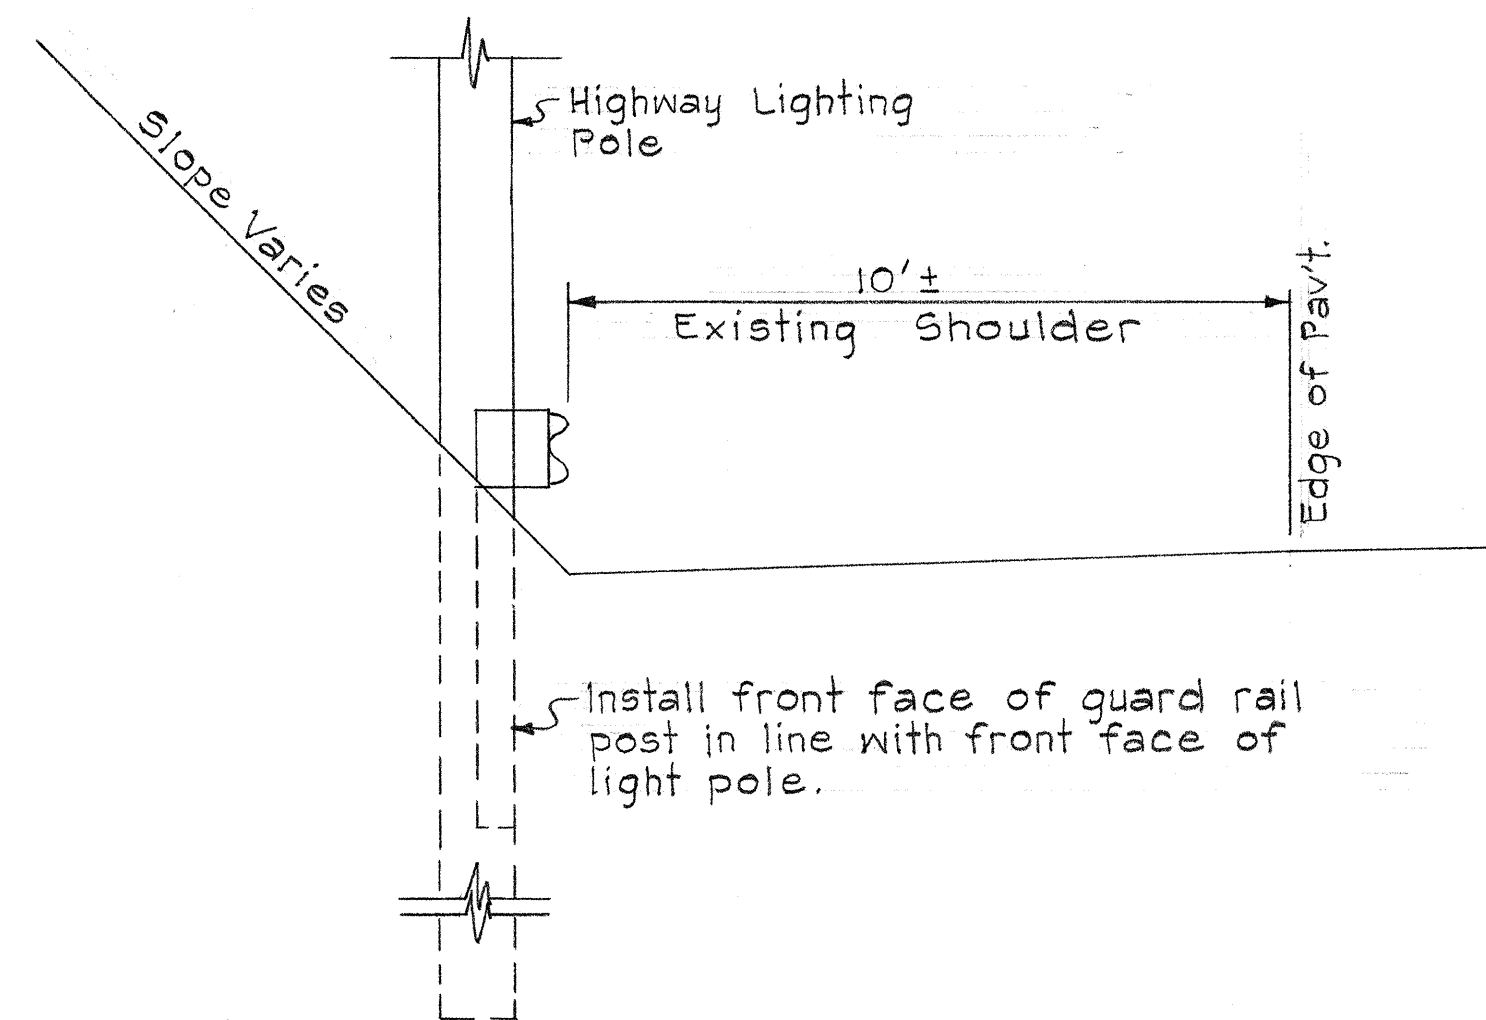


TYPICAL SECTION

STA. 8+00 TO STA. 21+00 LEFT SIDE
STA. 32+00 TO STA. 35+00 LEFT SIDE
STA. 51+07 TO STA. 55+82 LEFT SIDE

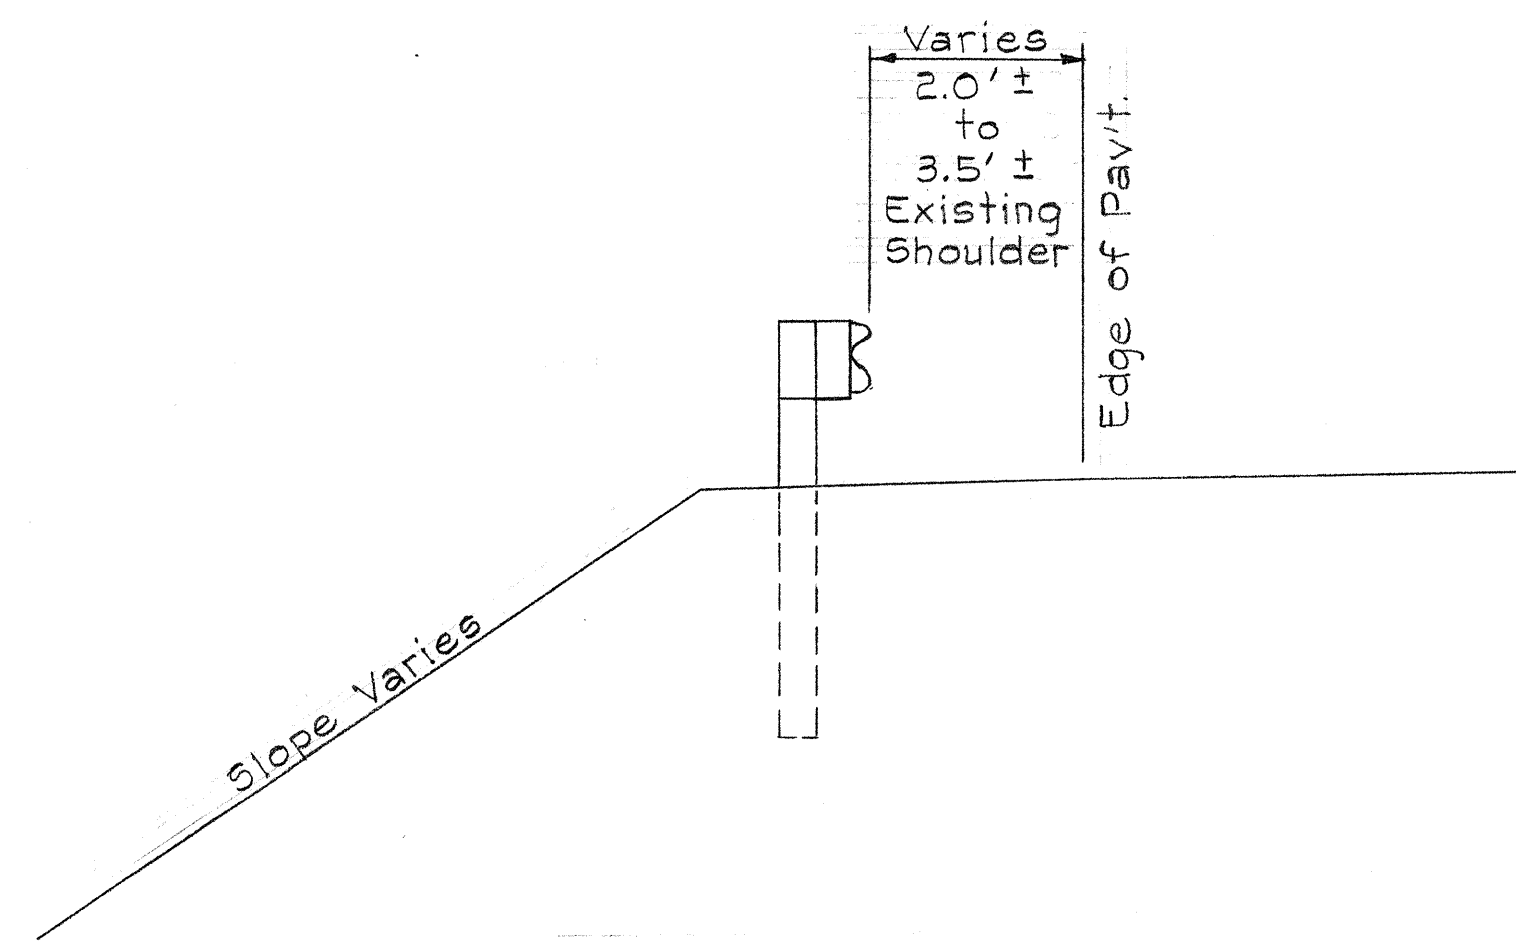


TYPICAL SECTION

STA. 21+00 TO STA. 32+00 LEFT SIDE

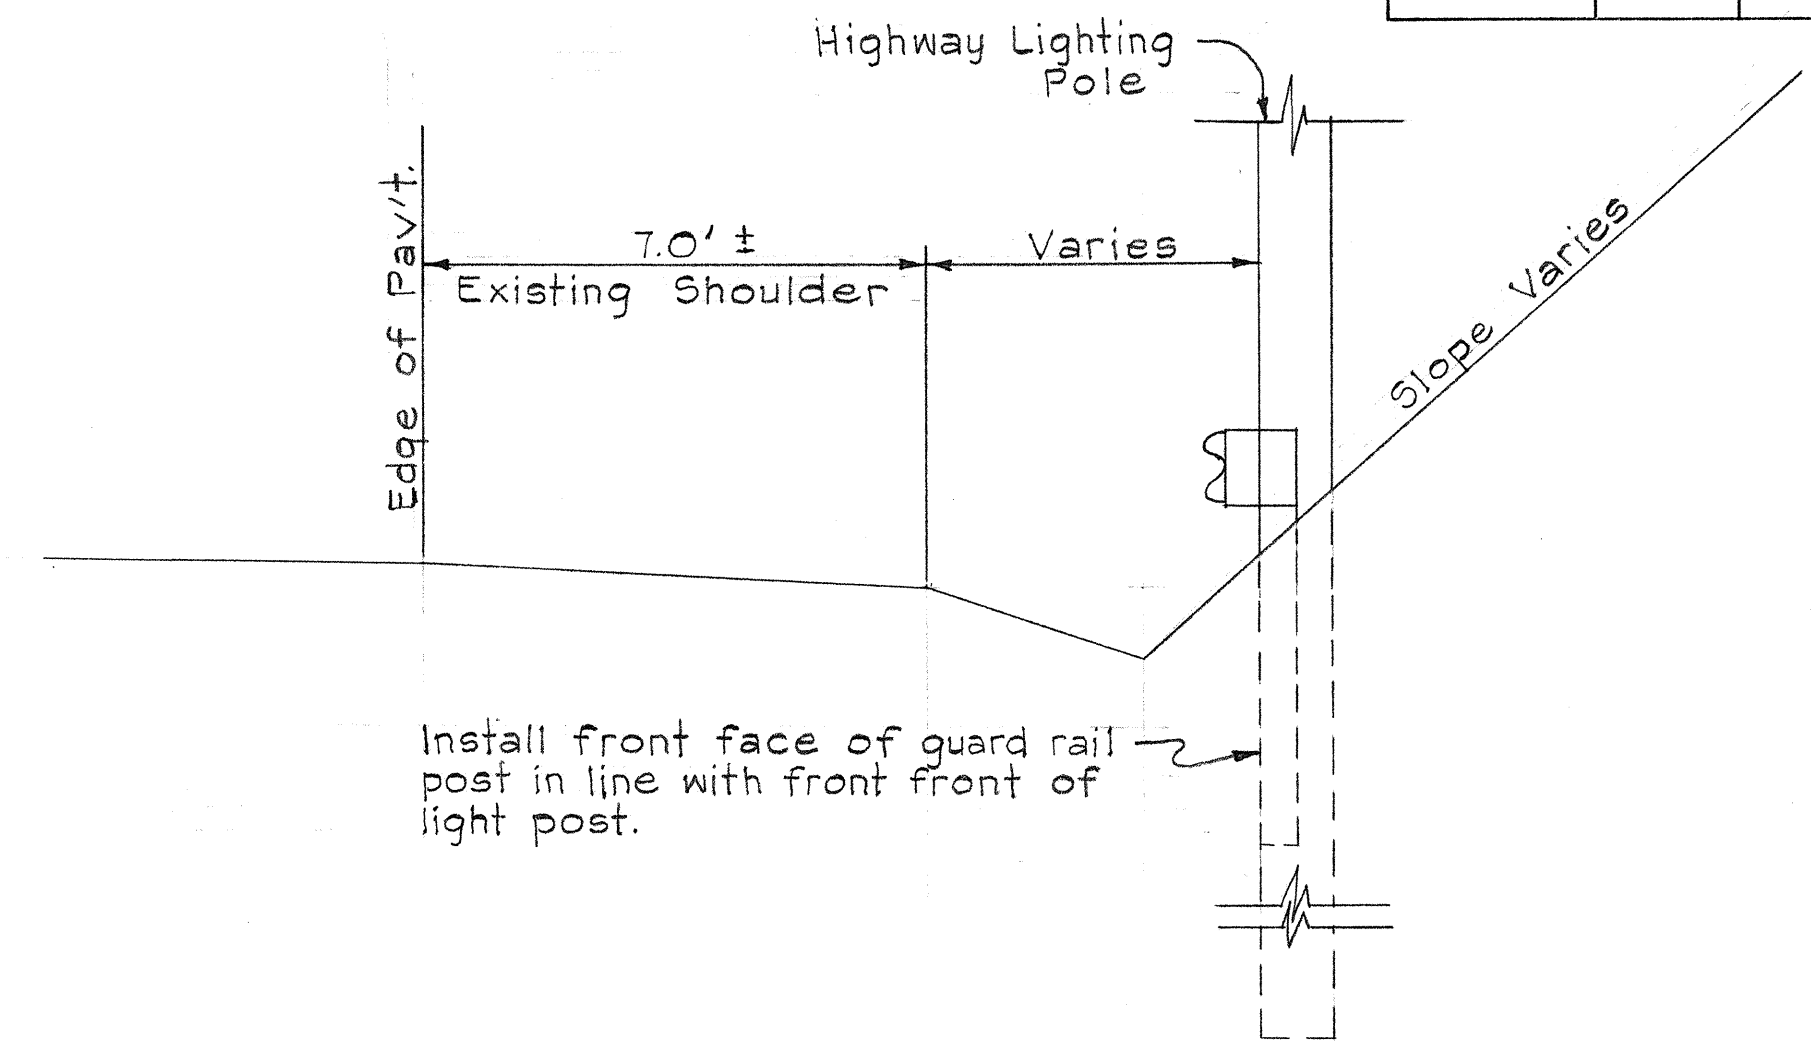


TYPICAL SECTION

STA. 21+75 TO STA. 29+75 RIGHT SIDE

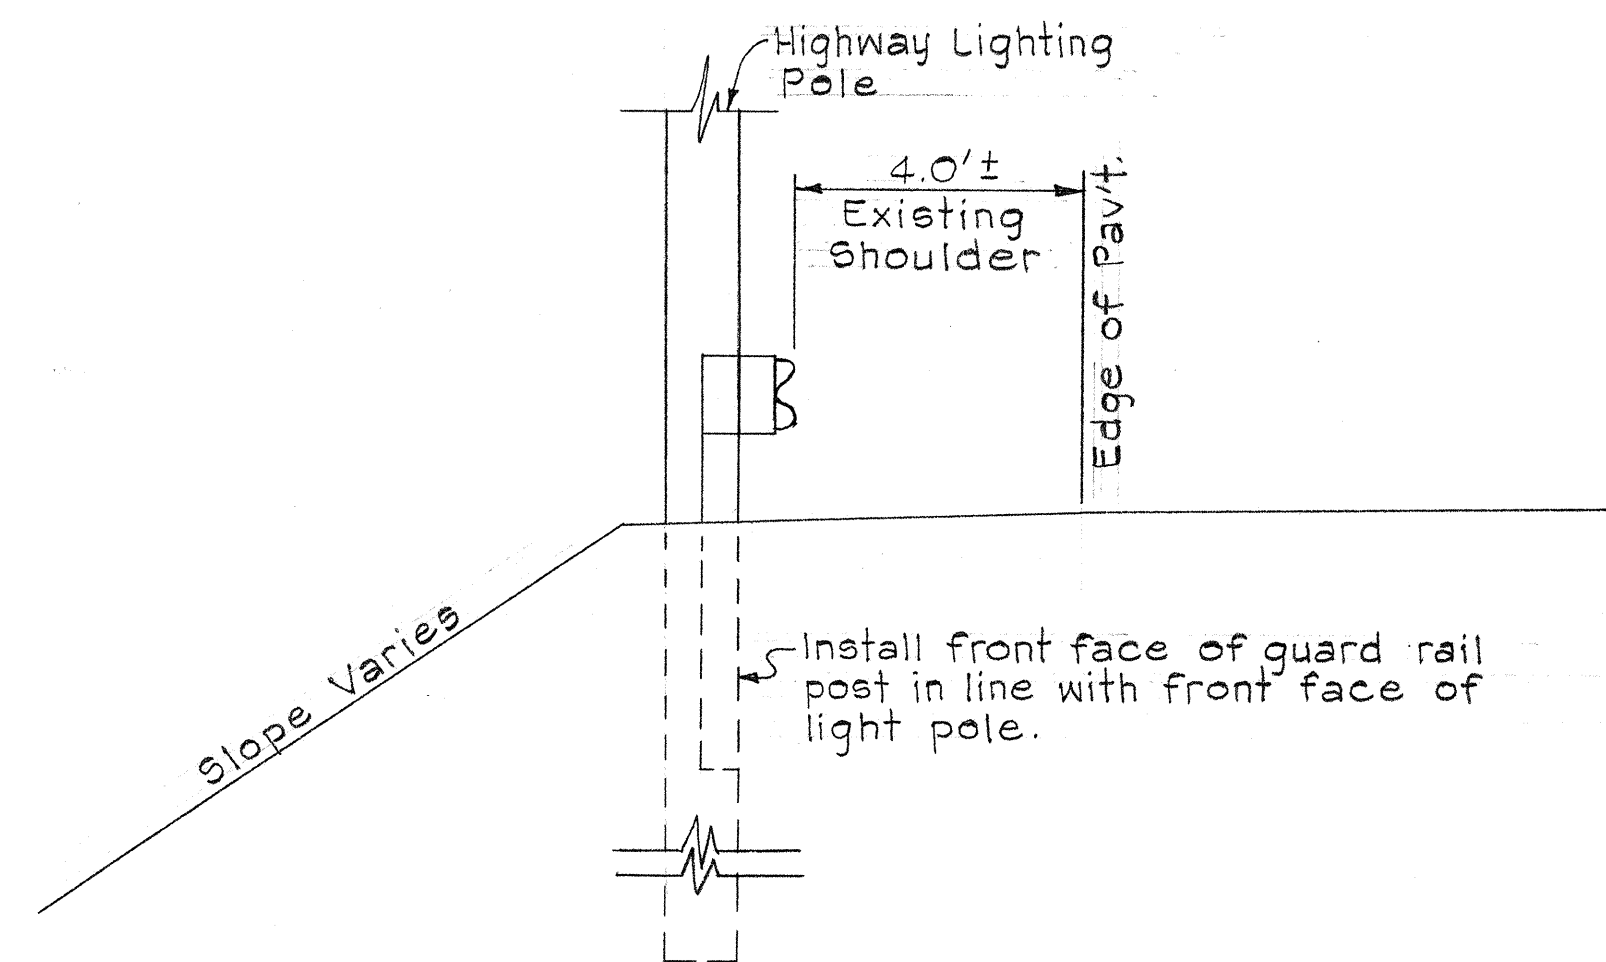

TYPICAL SECTION

STA. 41+45 TO STA. 49+30 LEFT SIDE

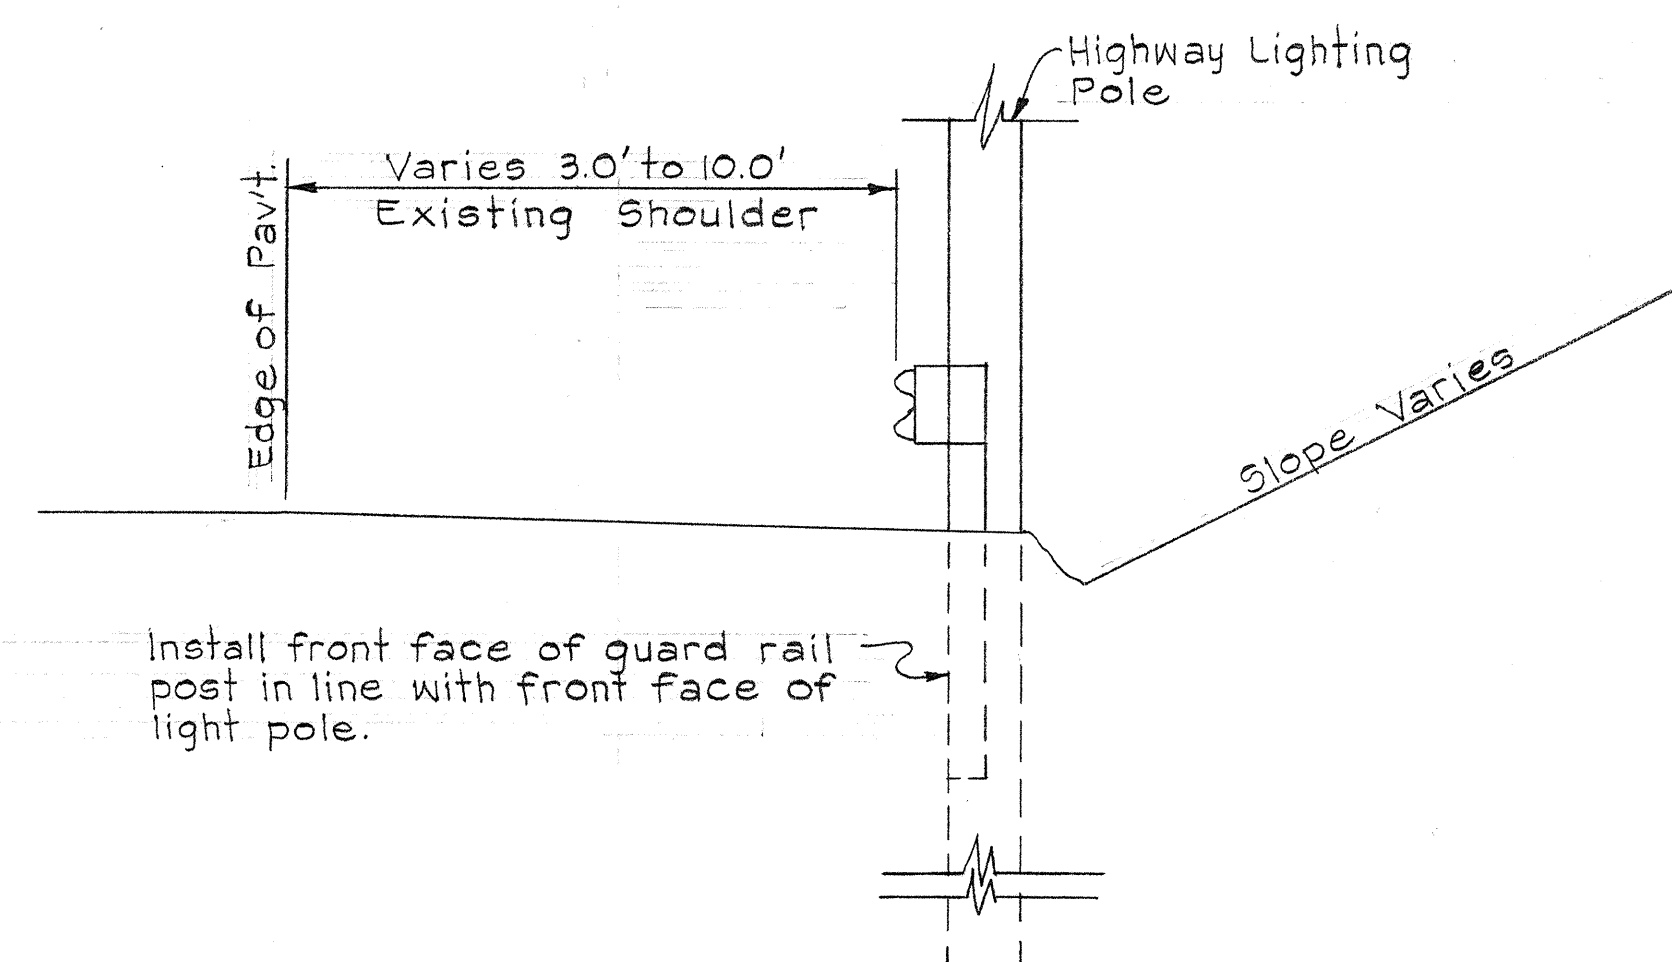

TYPICAL SECTION

STA. 59+60 TO STA. 63+10 RIGHT SIDE

ORIGINAL PLAN	DATE
SURVEY PLOTTED BY	
DRAWN BY	
DESIGNED BY	
NOTED BY	
CHECKED BY	

STATE OF HAWAII
DEPARTMENT OF TRANSPORTATION
HIGHWAYS DIVISION

TYPICAL SECTIONS

KAMEHAMEHA HIGHWAY
Mililani Park to Vicinity of Roosevelt Bridge
PROJECT No. F-099-1(2)

SCALE: $\frac{3}{8}" = 1'-0"$ DATE: MARCH, 1968

SHEET No. 4 OF 7 SHEETS