




| FED. ROAD DIST. NO. | STATE | FED. AID PROJ. NO. | FISCAL YEAR | SHEET NO. | TOTAL SHEETS |
|---------------------|-------|--------------------|-------------|-----------|--------------|
| HAWAII              | HAW.  | F-070-1(14)        | 1968        | 22        | 24           |

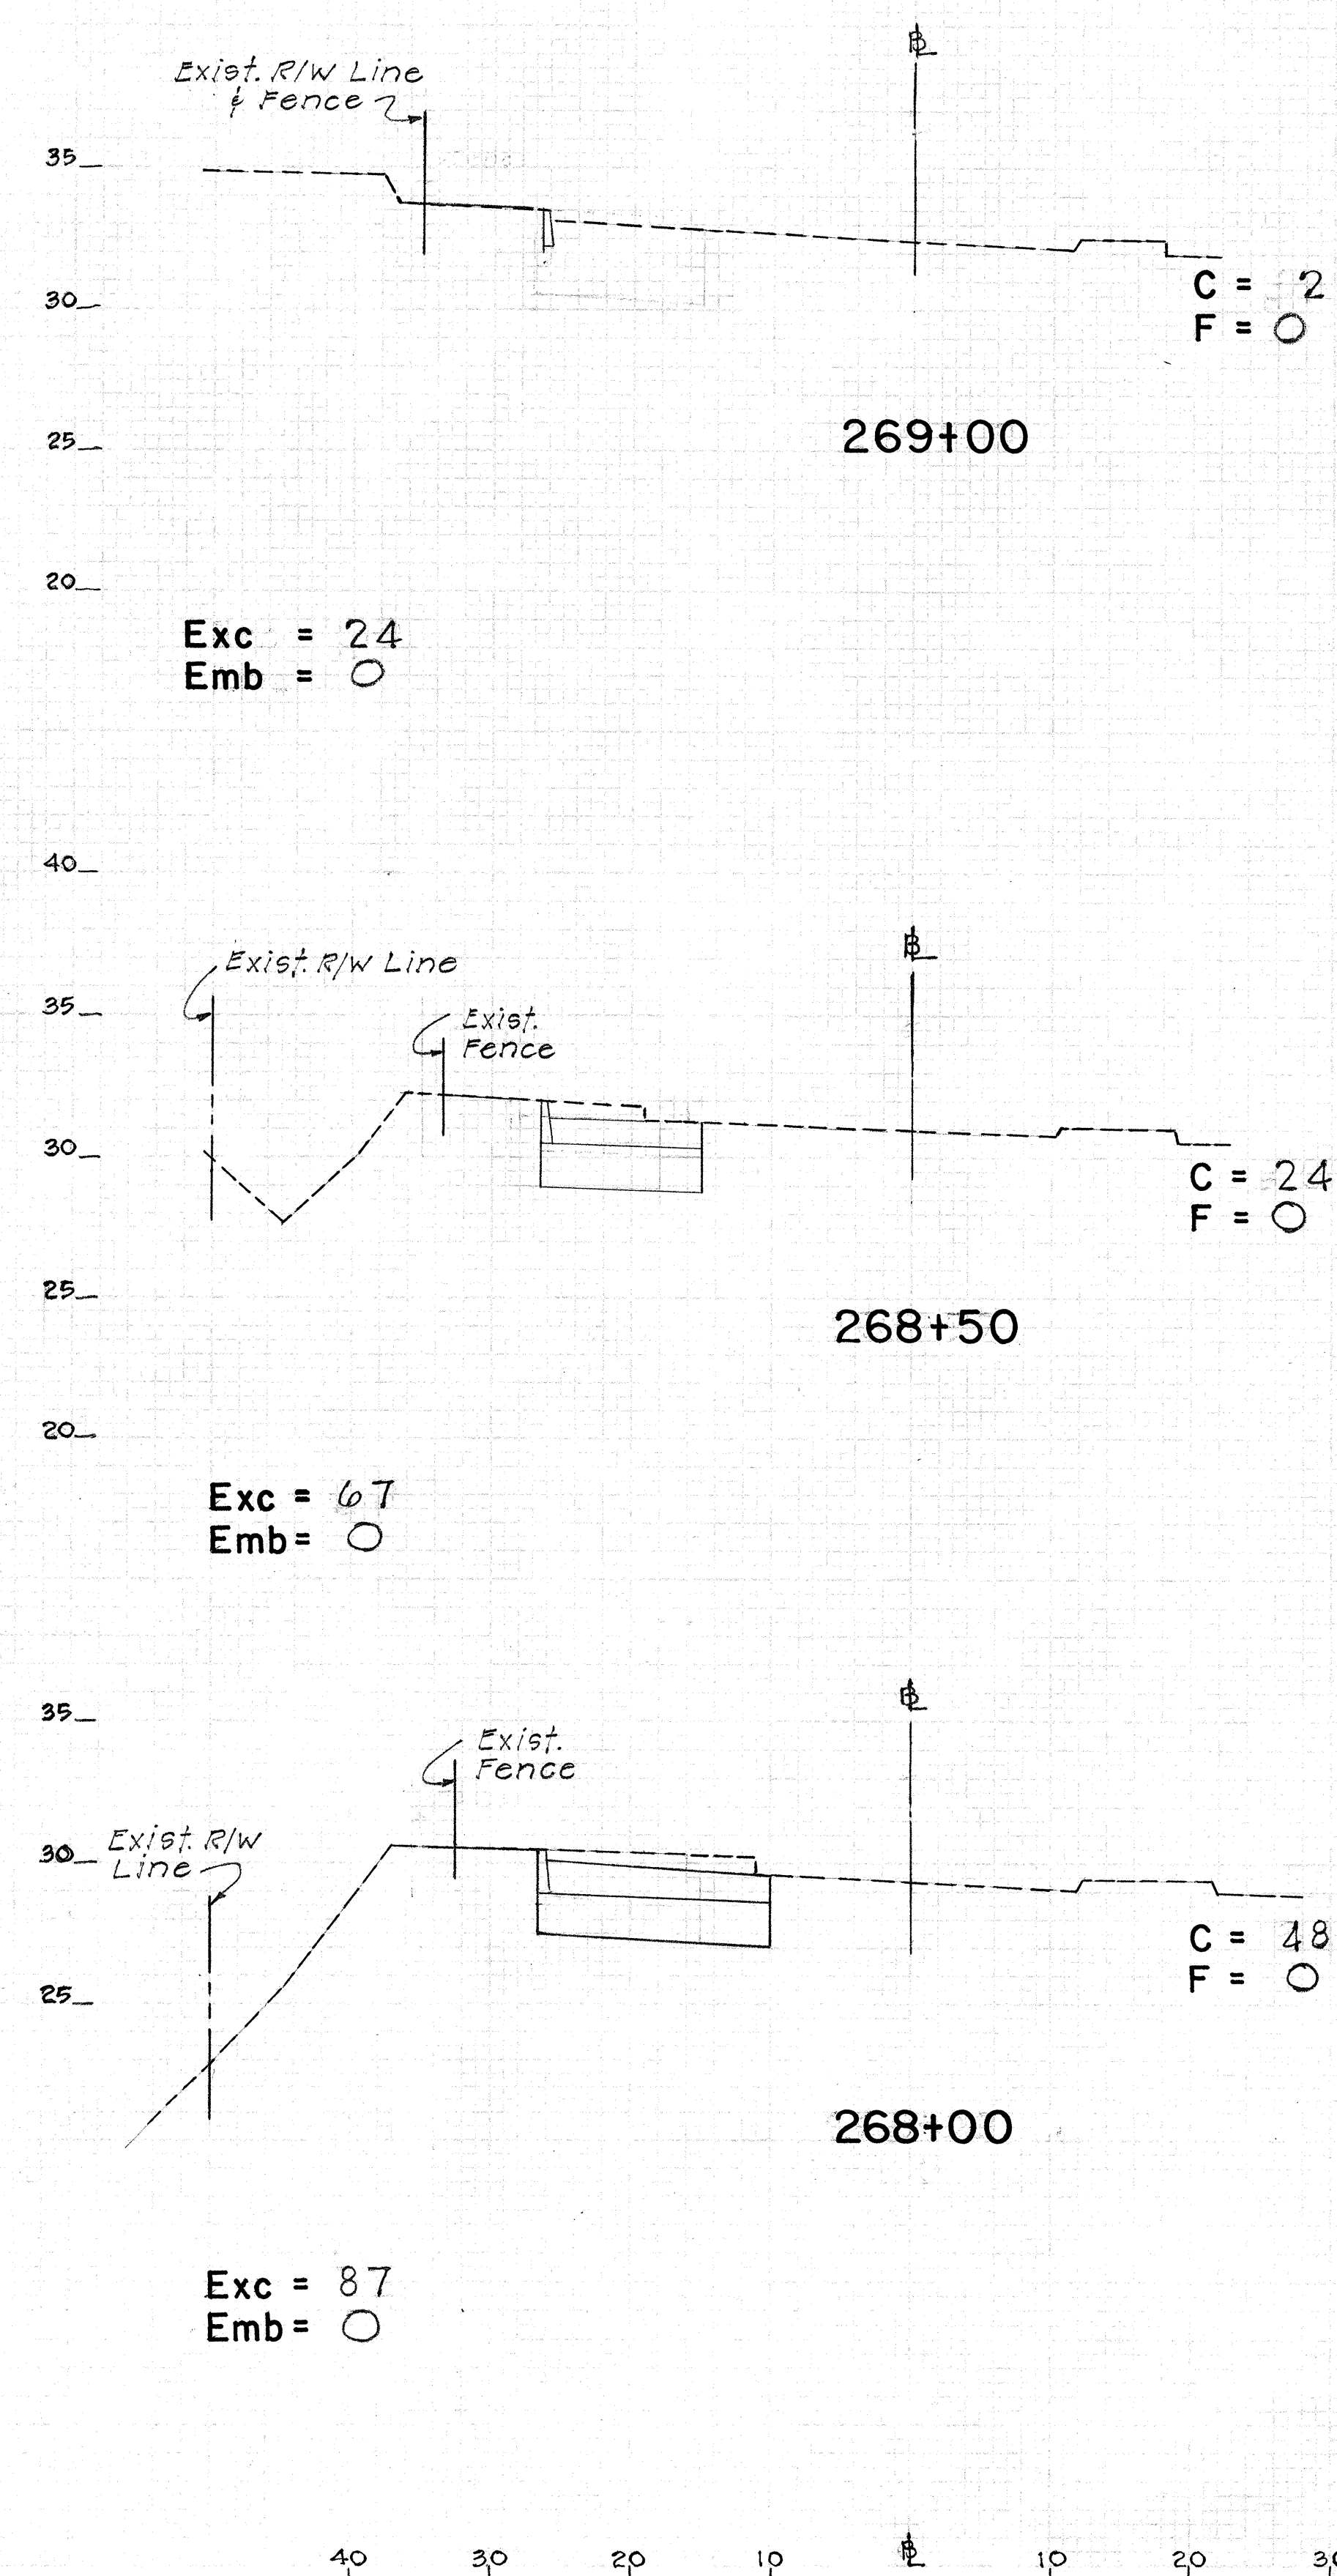


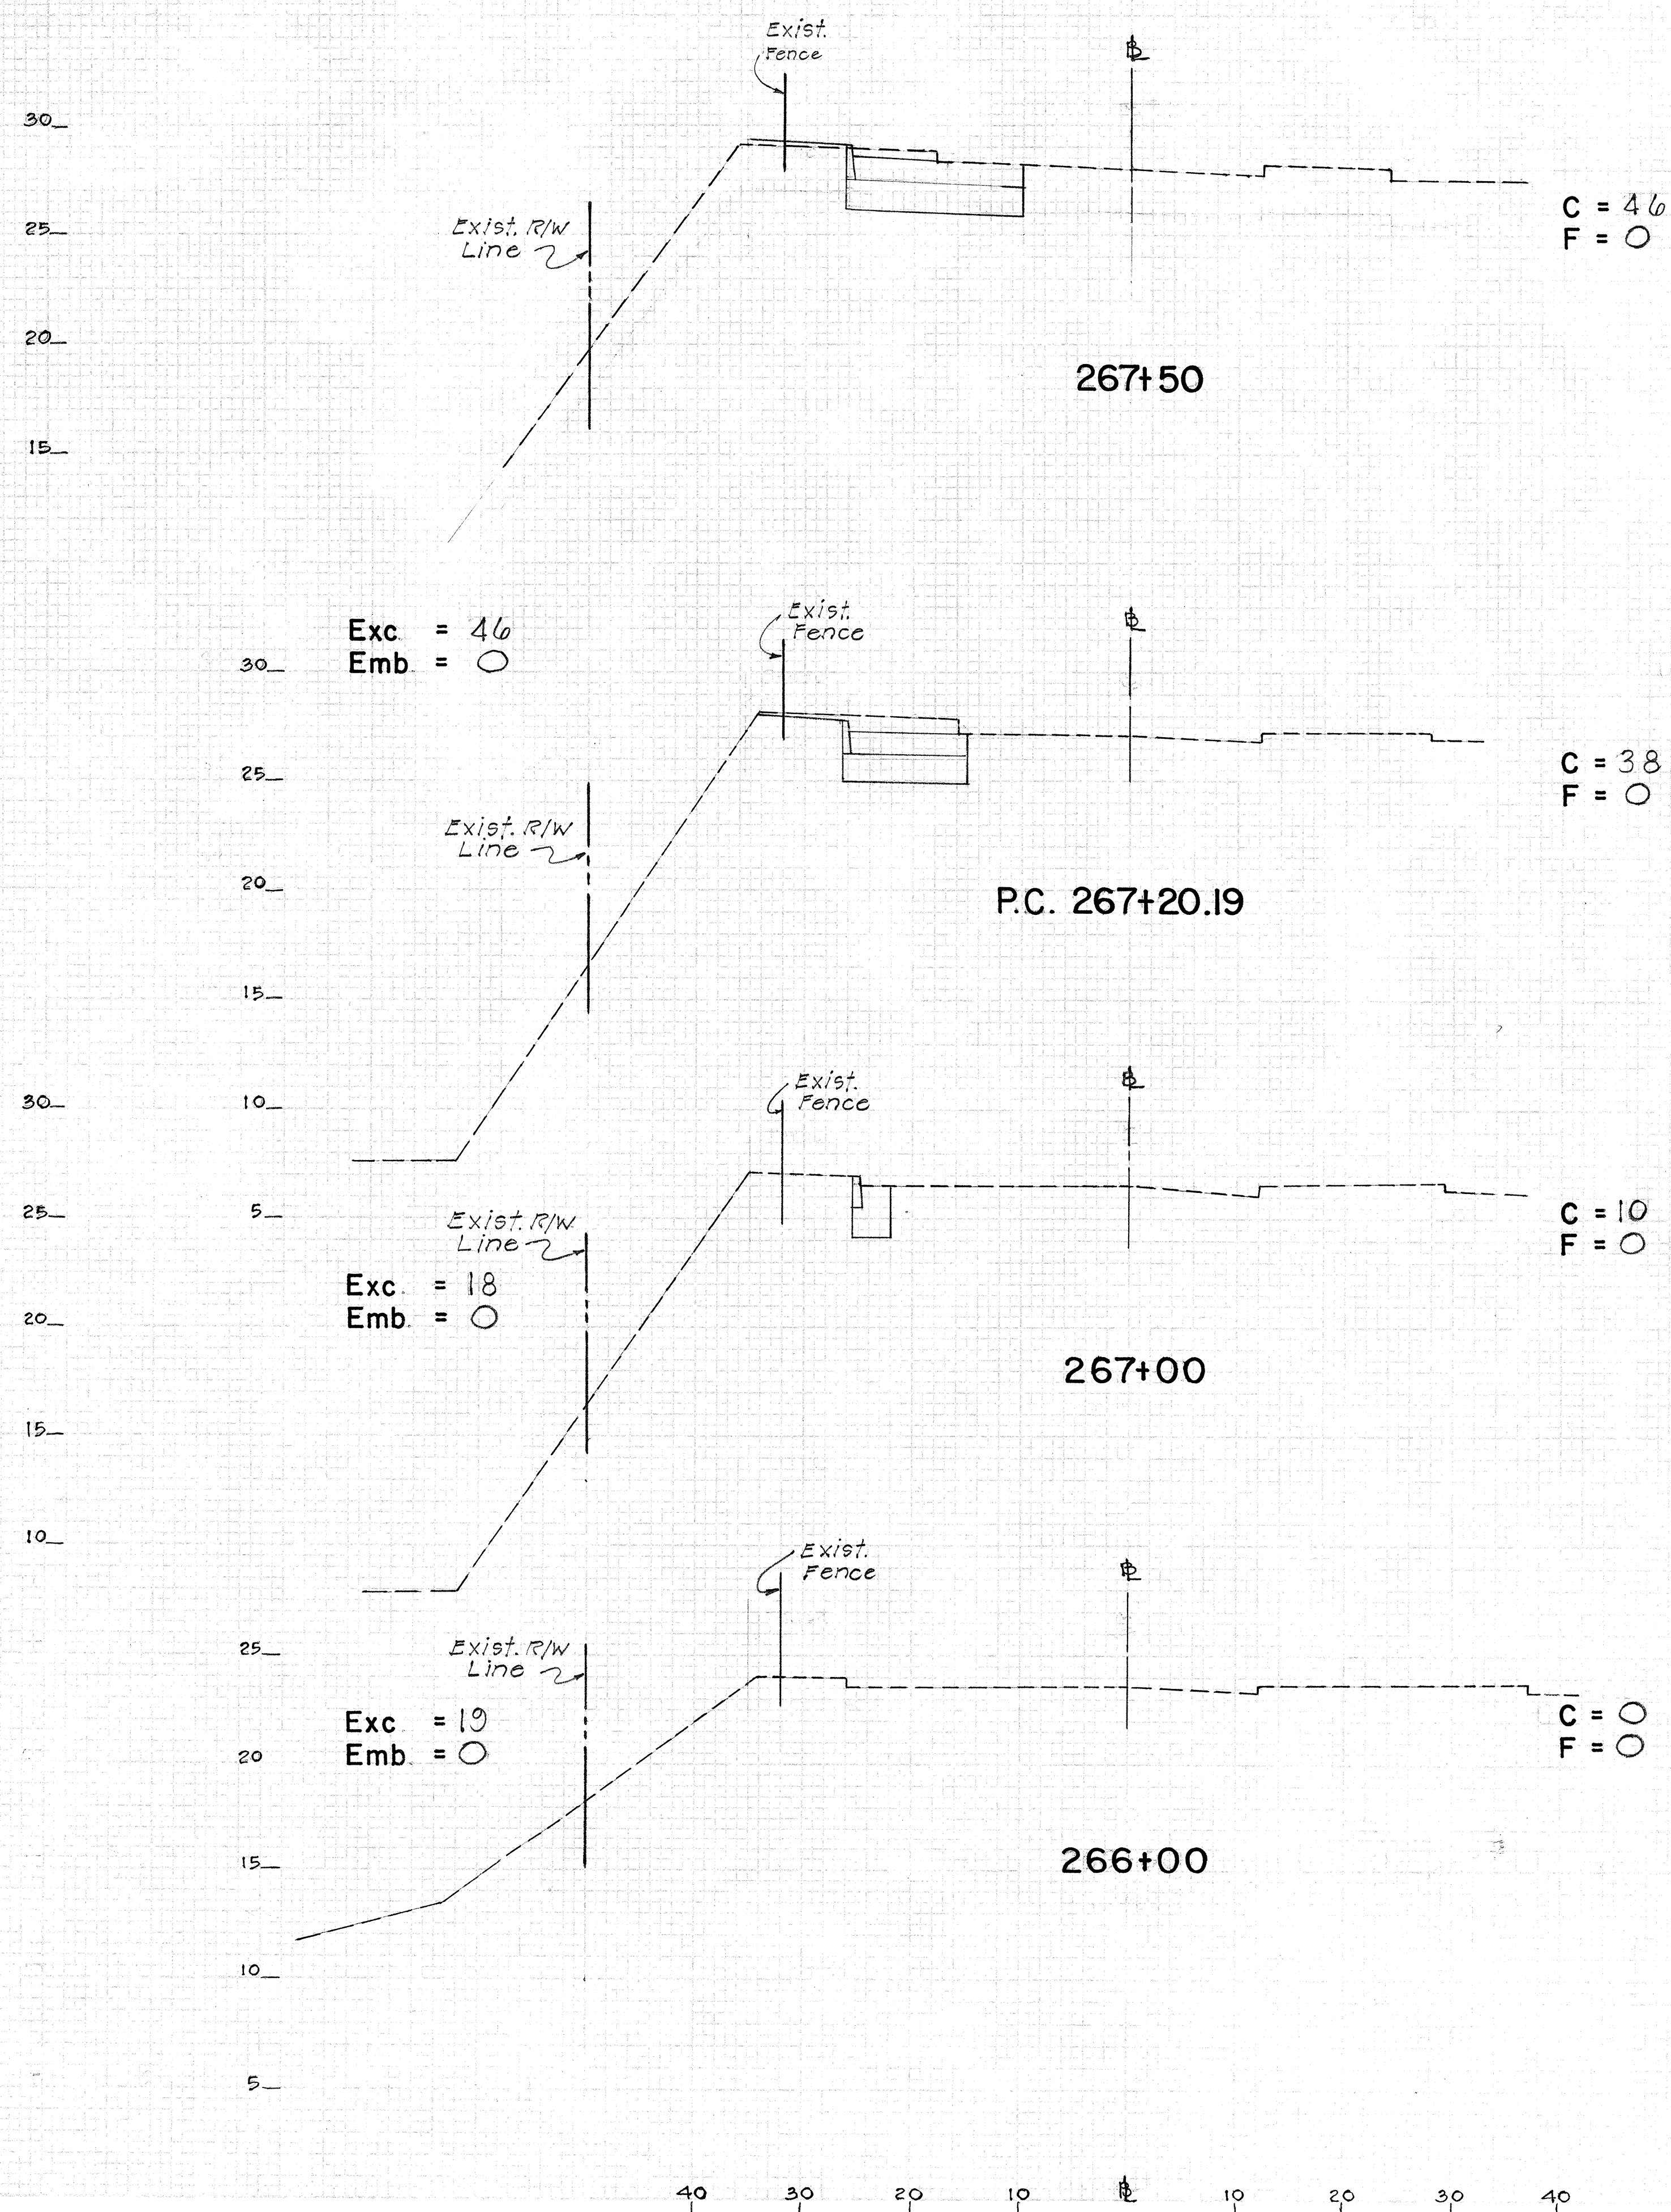


| FED. ROAD DIST. NO. | STATE | FED. AID PROJ. NO. | FISCAL YEAR | SHEET NO. | TOTAL SHEETS |
|---------------------|-------|--------------------|-------------|-----------|--------------|
| HAWAII              | HAW.  | F-070-1(14)        | 1968        | 23        | 24           |

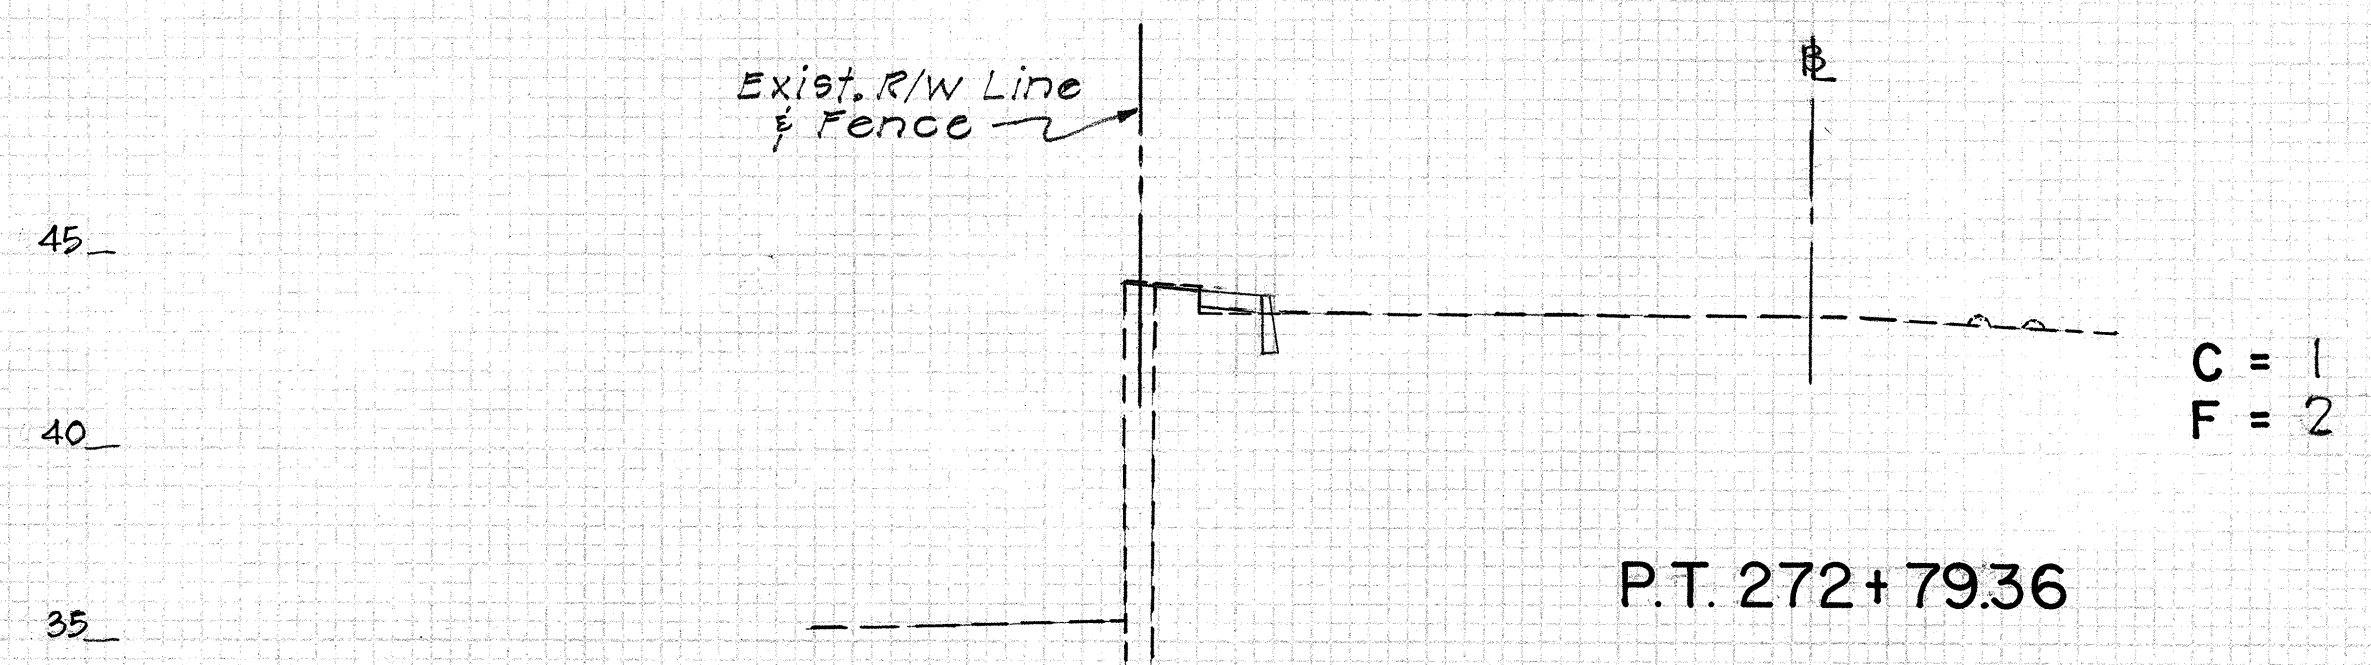


Exc = 37  
Emb = 3

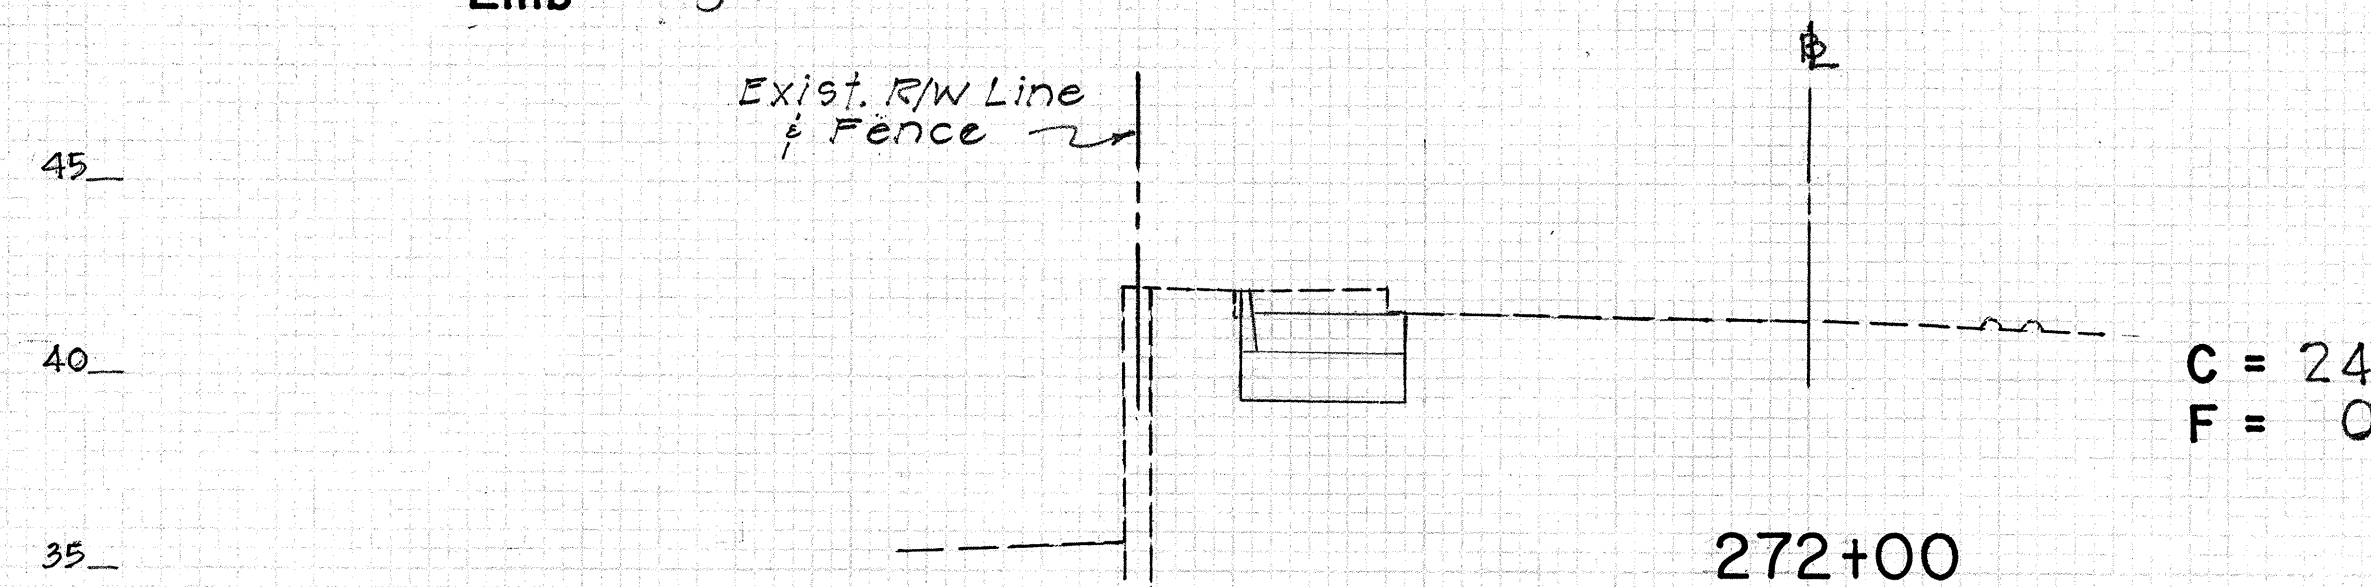


Exc = 128  
Emb = 0

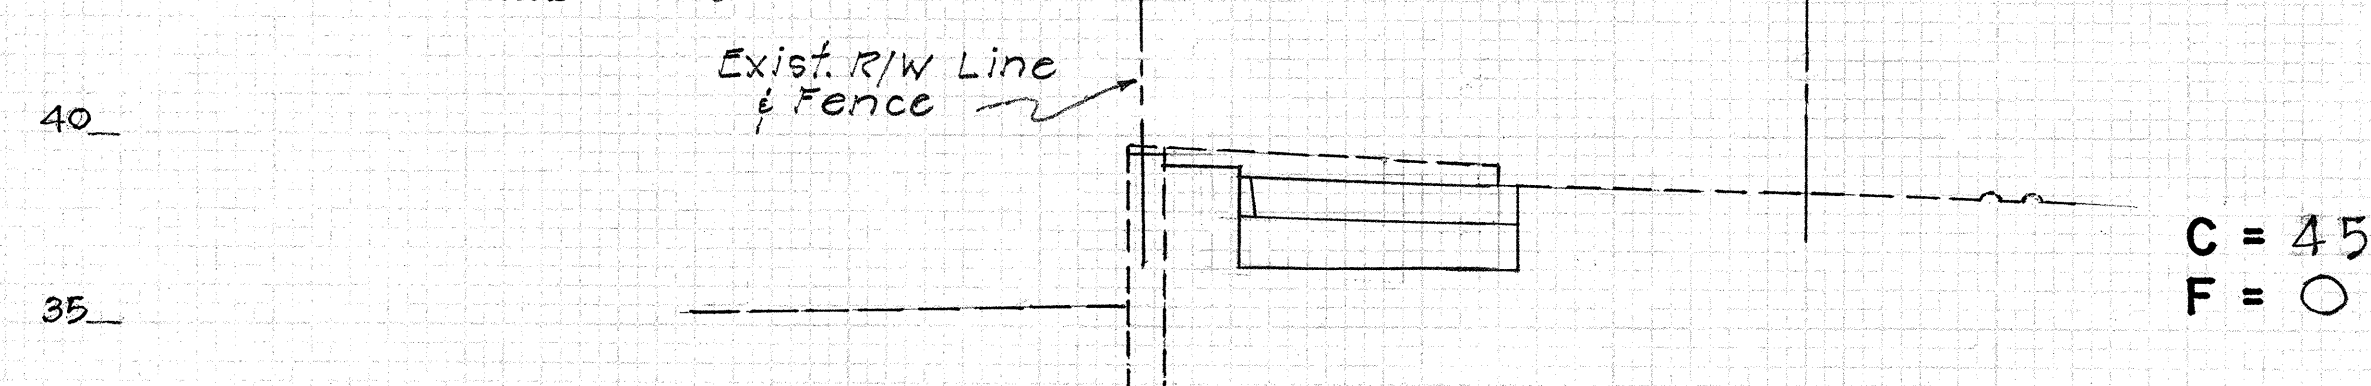


Exc = 69  
Emb = 1

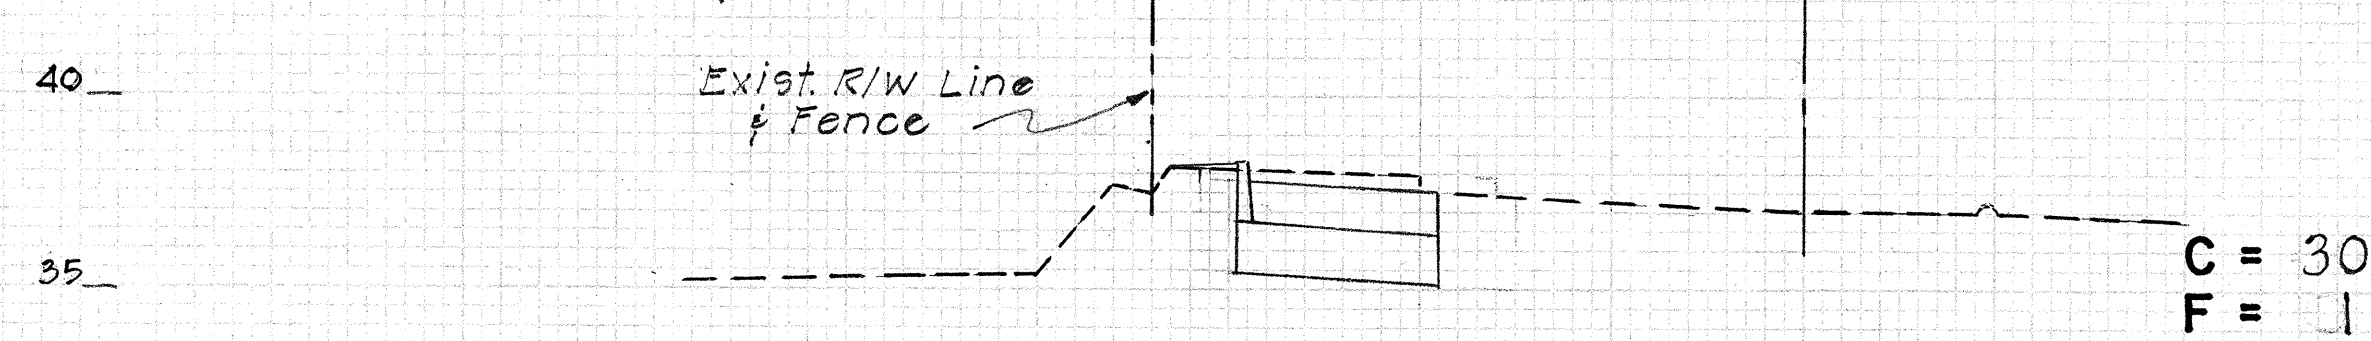


Exc = 30  
Emb = 1

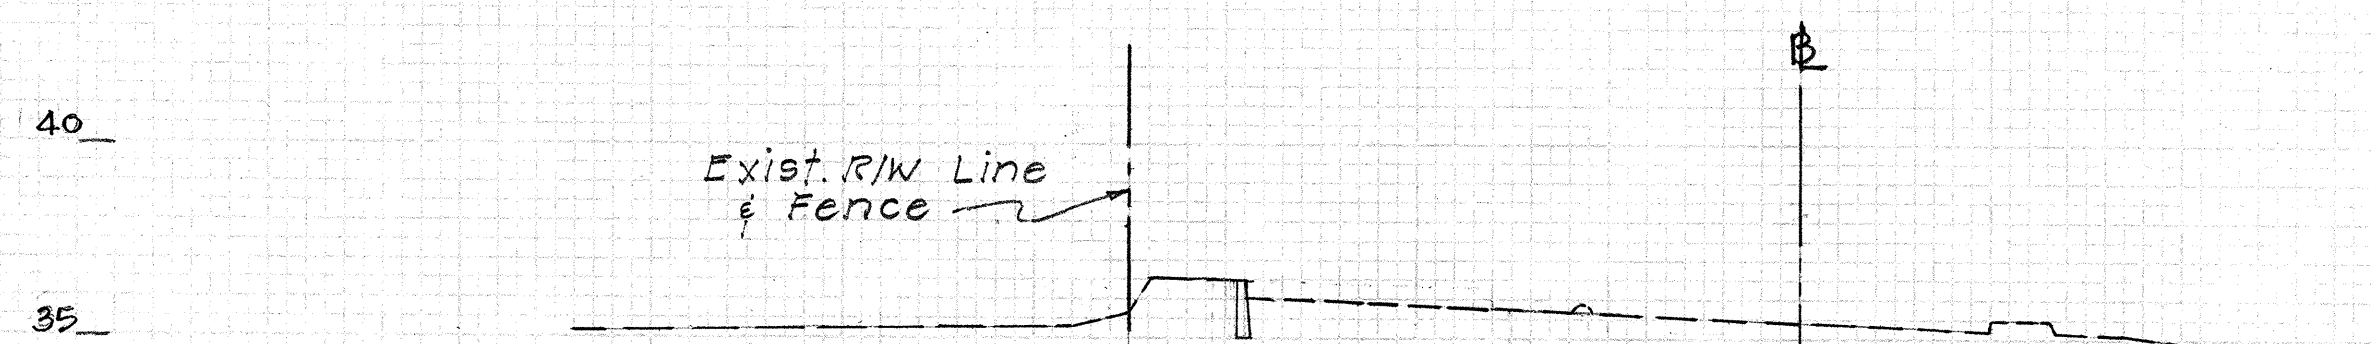


Exc = 7  
Emb = 0

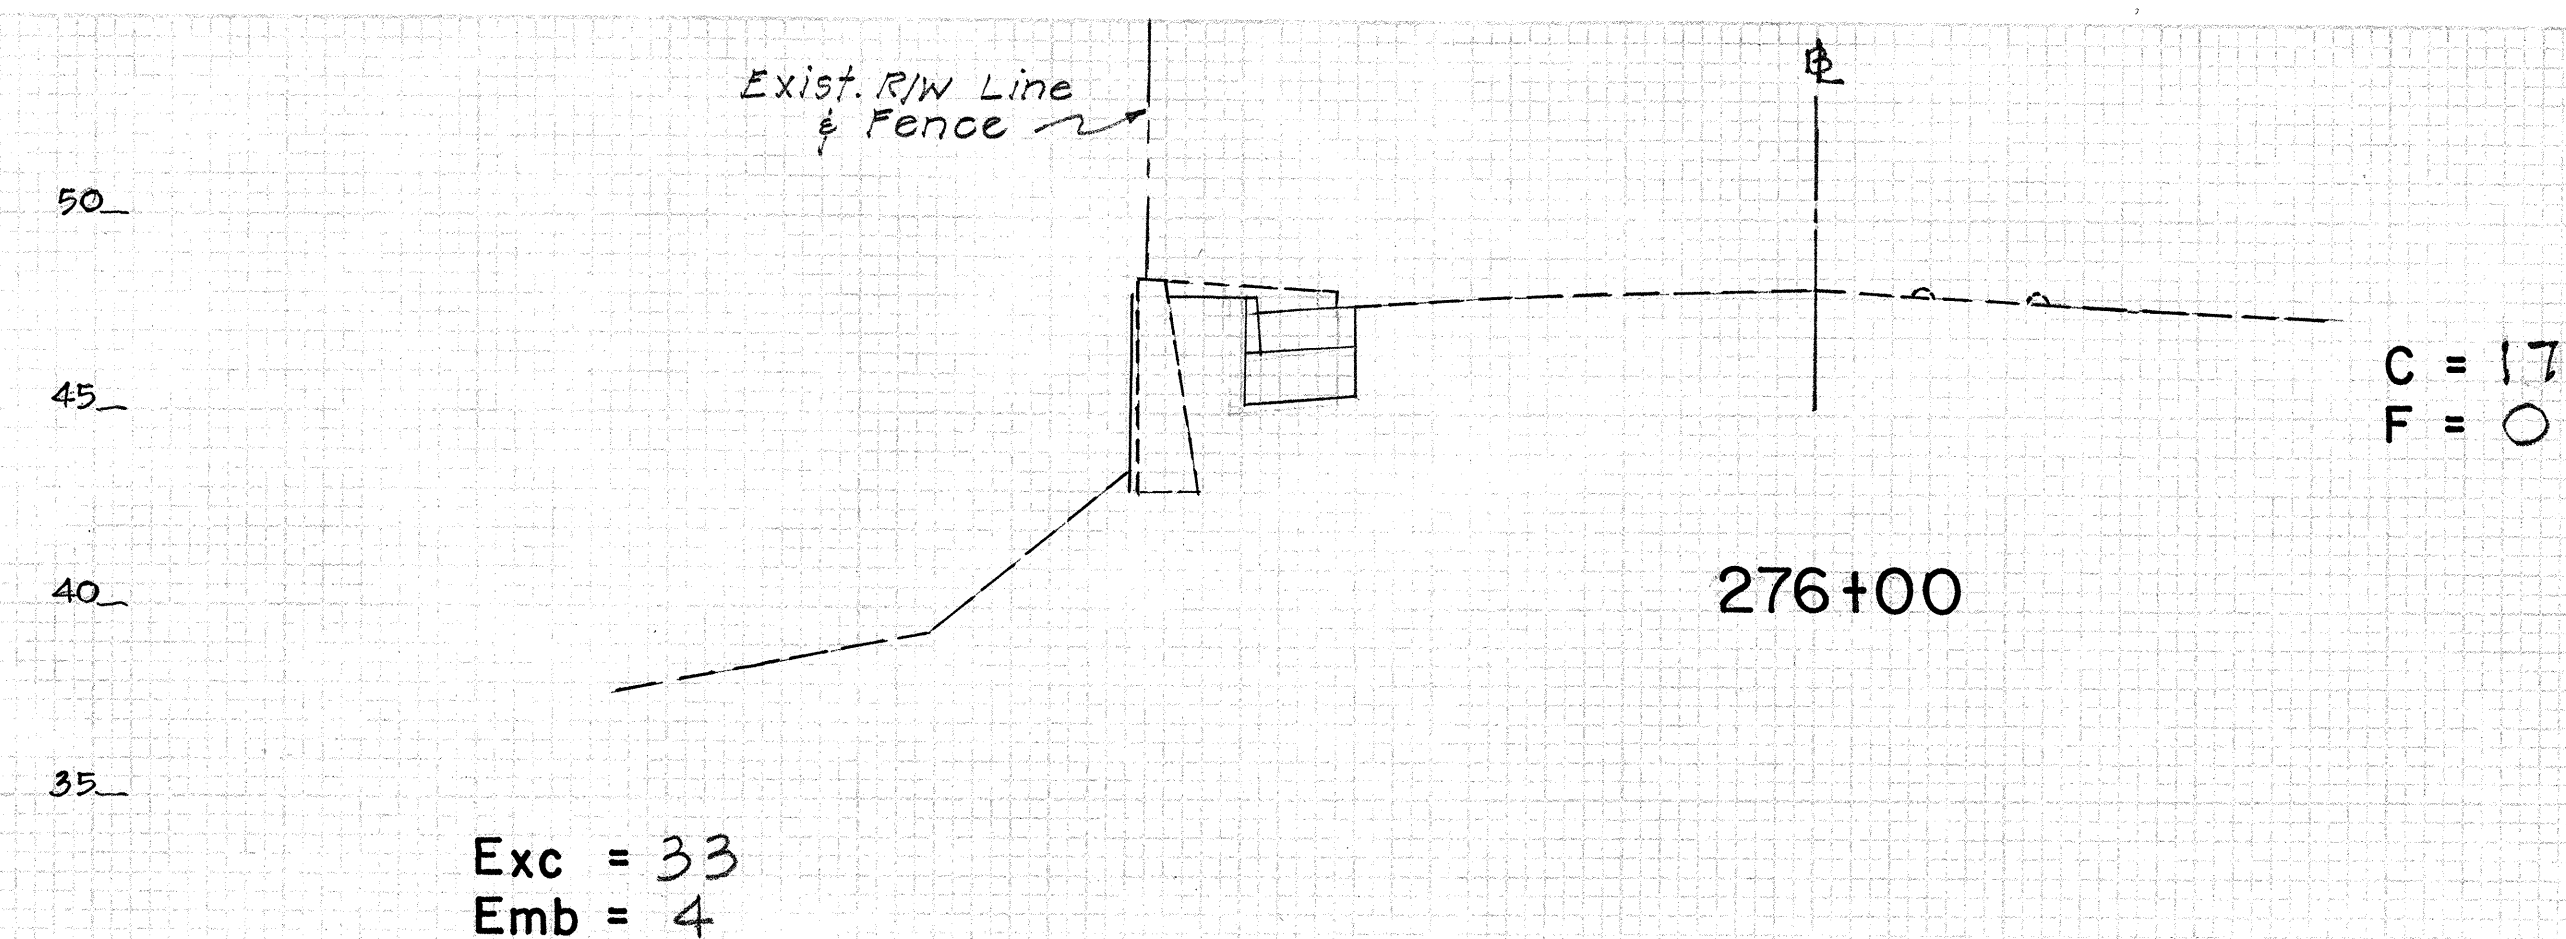


Exc = 33  
Emb = 4

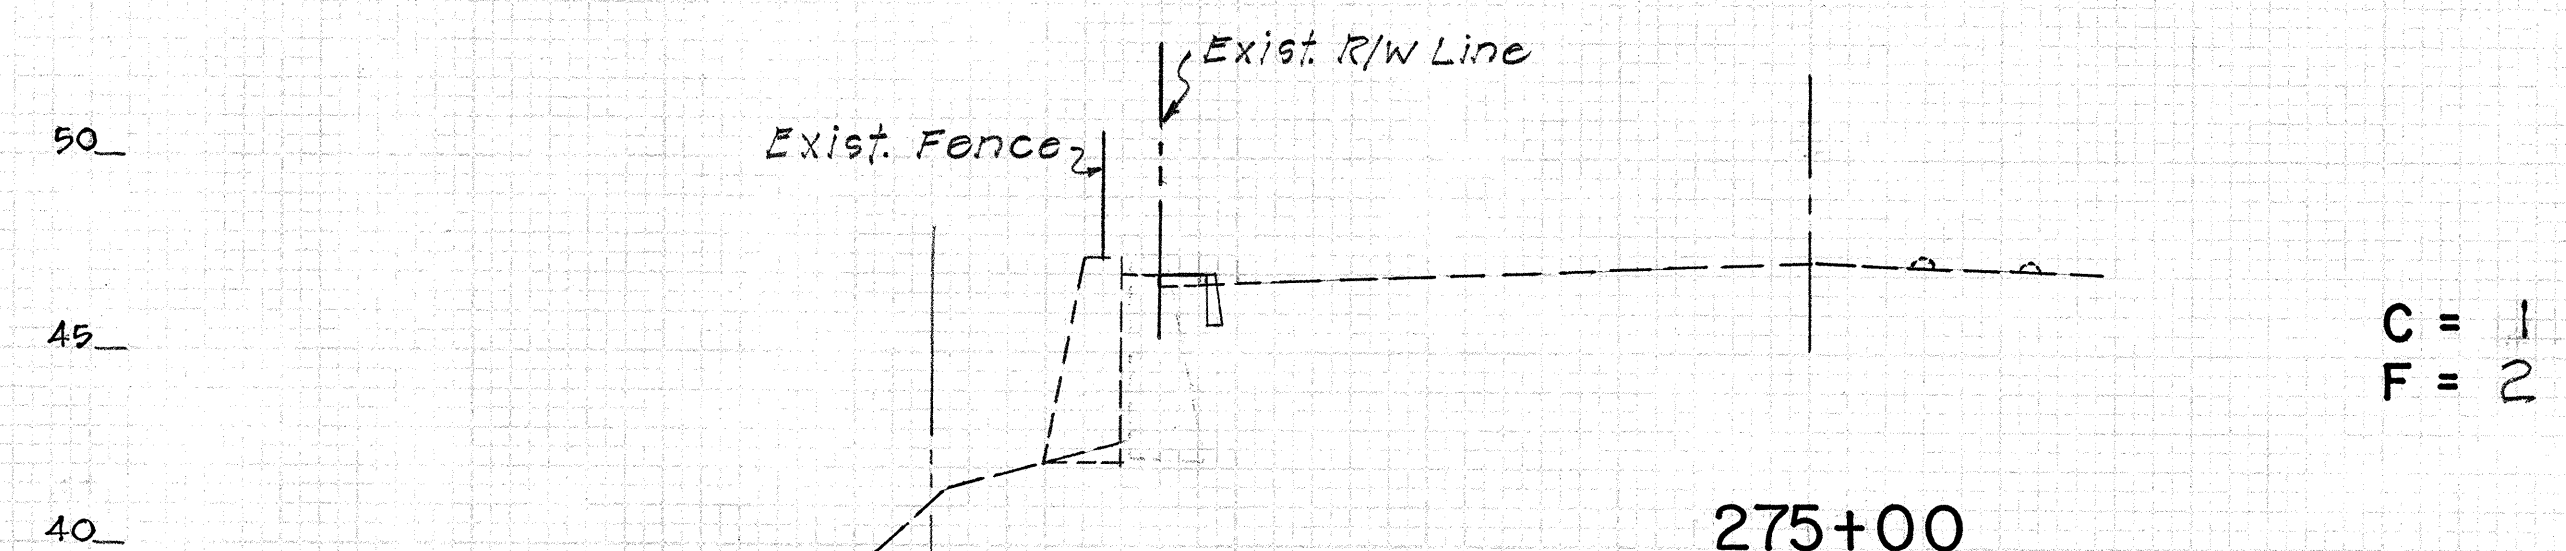


Exc = 83  
Emb = 13

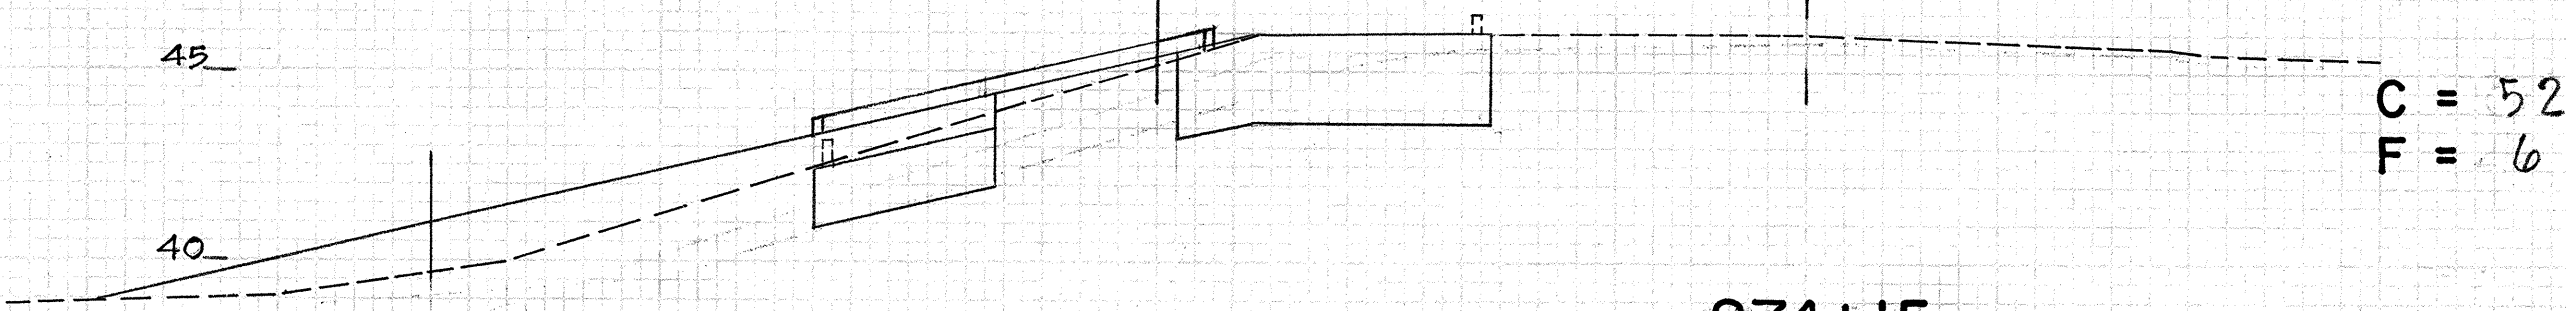

Exc = 79  
Emb = 10

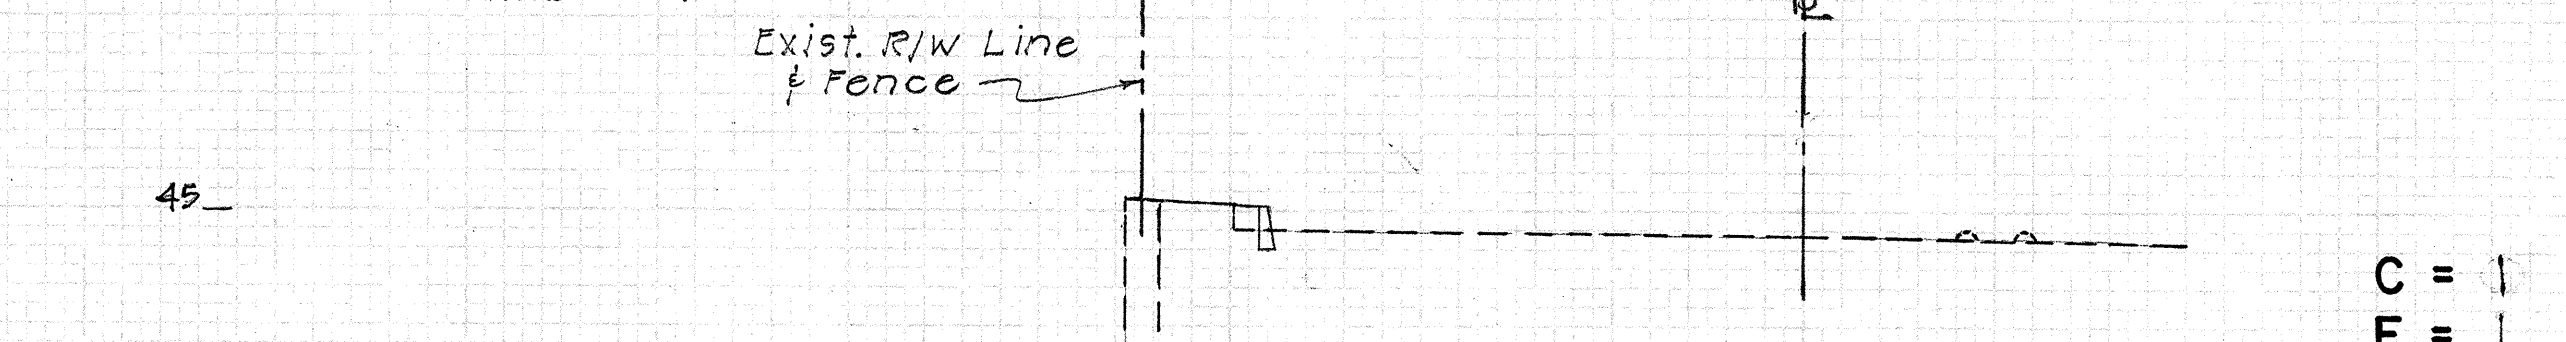


Exc = 1  
Emb = 2

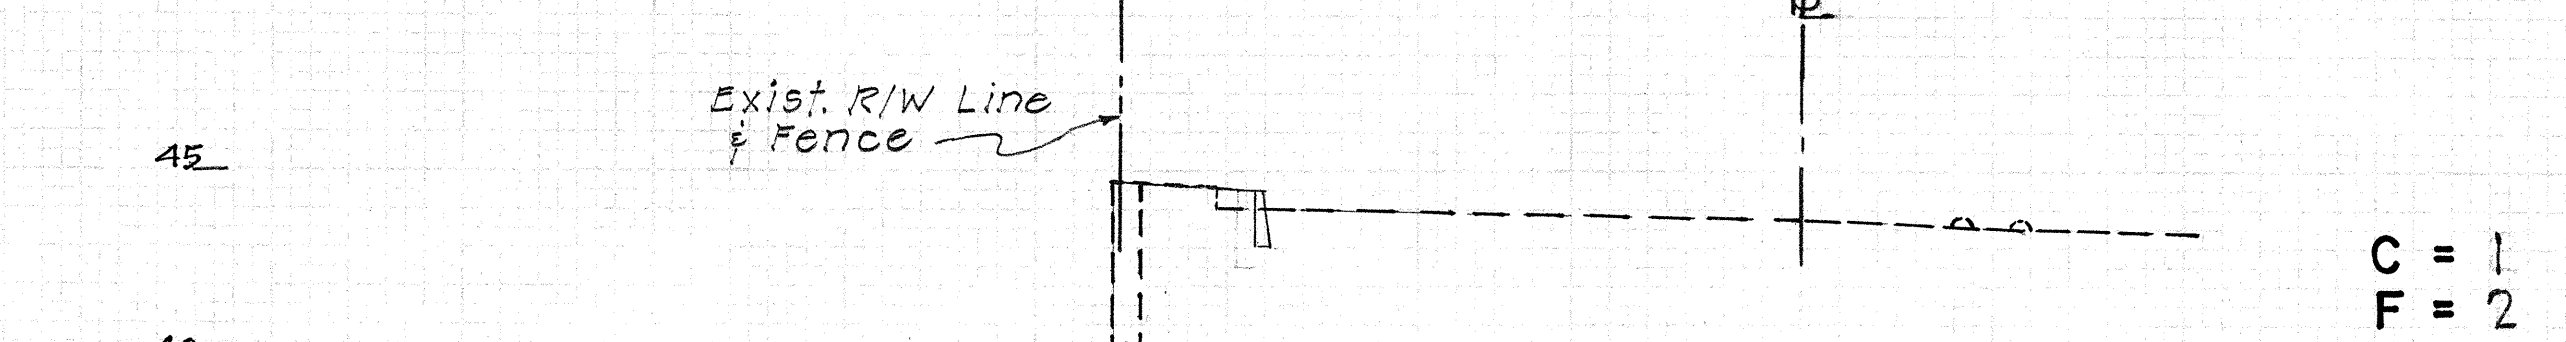

Exc = 1  
Emb = 2




| FED. ROAD DIST. NO. | STATE | FED. AID PROJ. NO. | FISCAL YEAR | SHEET NO. | TOTAL SHEETS |
|---------------------|-------|--------------------|-------------|-----------|--------------|
| HAWAII              | HAW.  | F-070-1(14)        | 1968        | 24        | 24           |

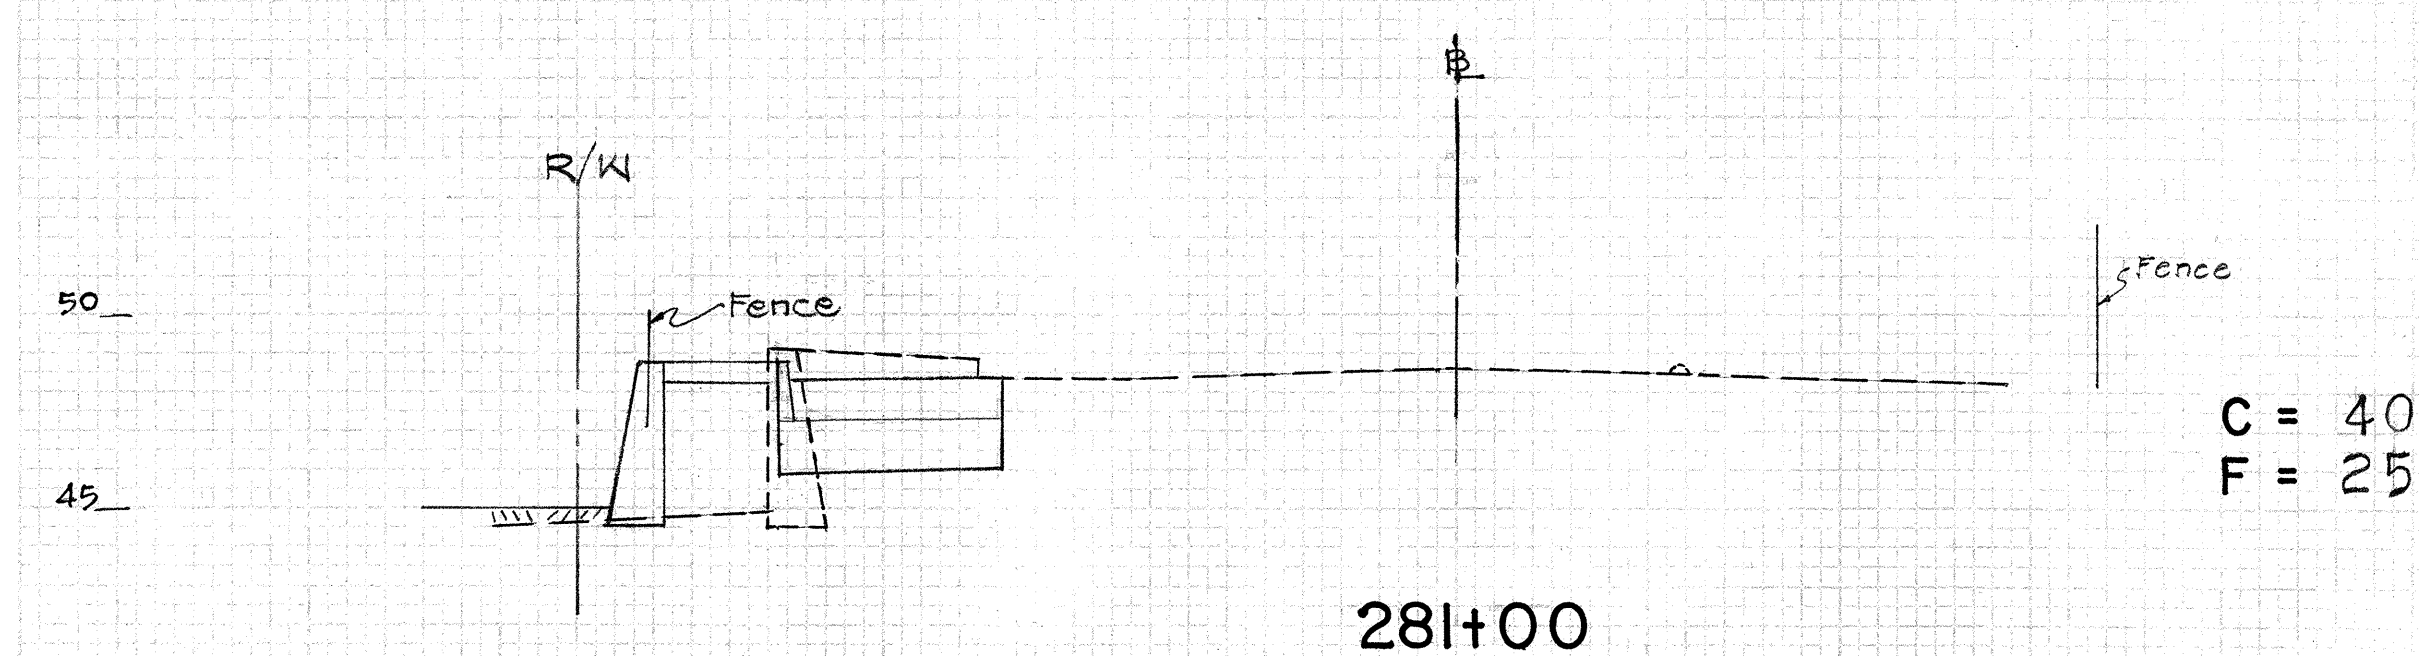


Exc = 170  
Emb = 100

C = 40  
F = 25

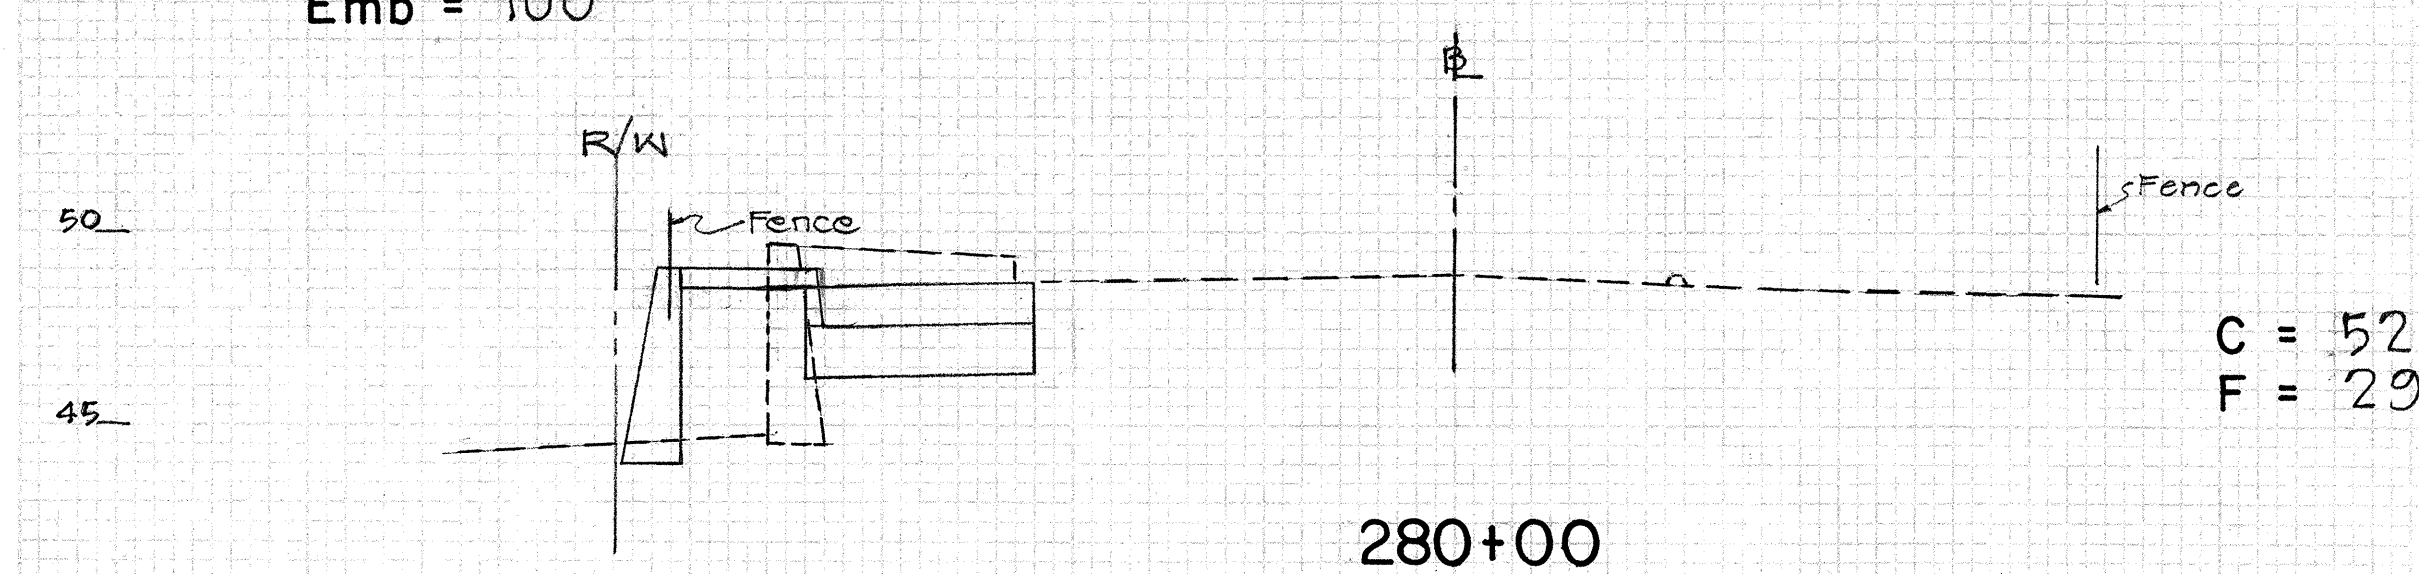


Exc = 189  
Emb = 91

C = 52  
F = 29

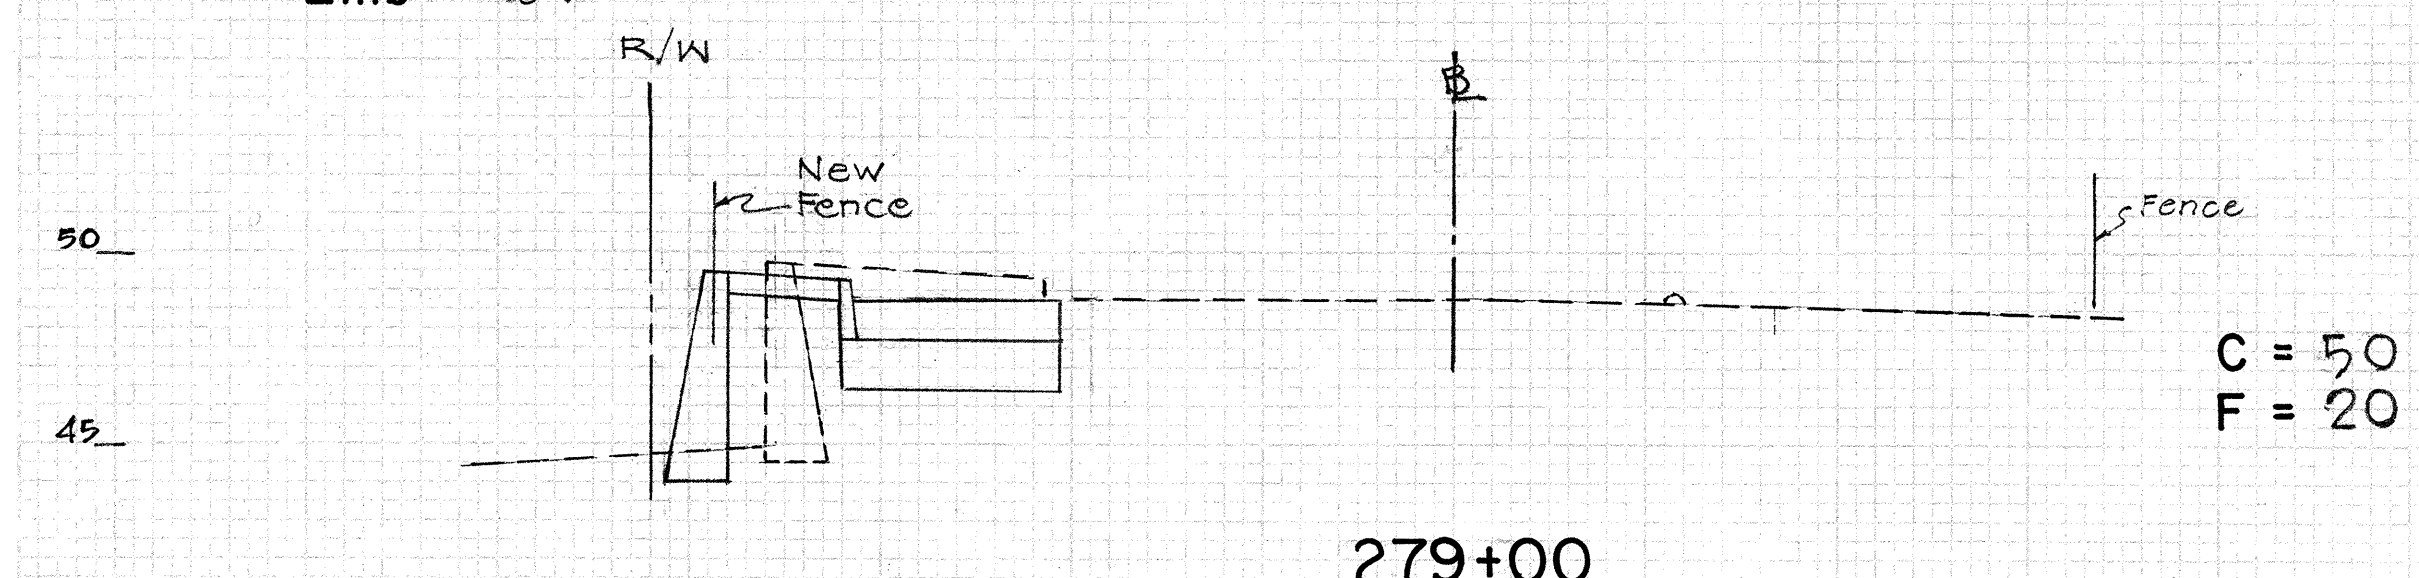


Exc = 159  
Emb = 37

C = 50  
F = 20

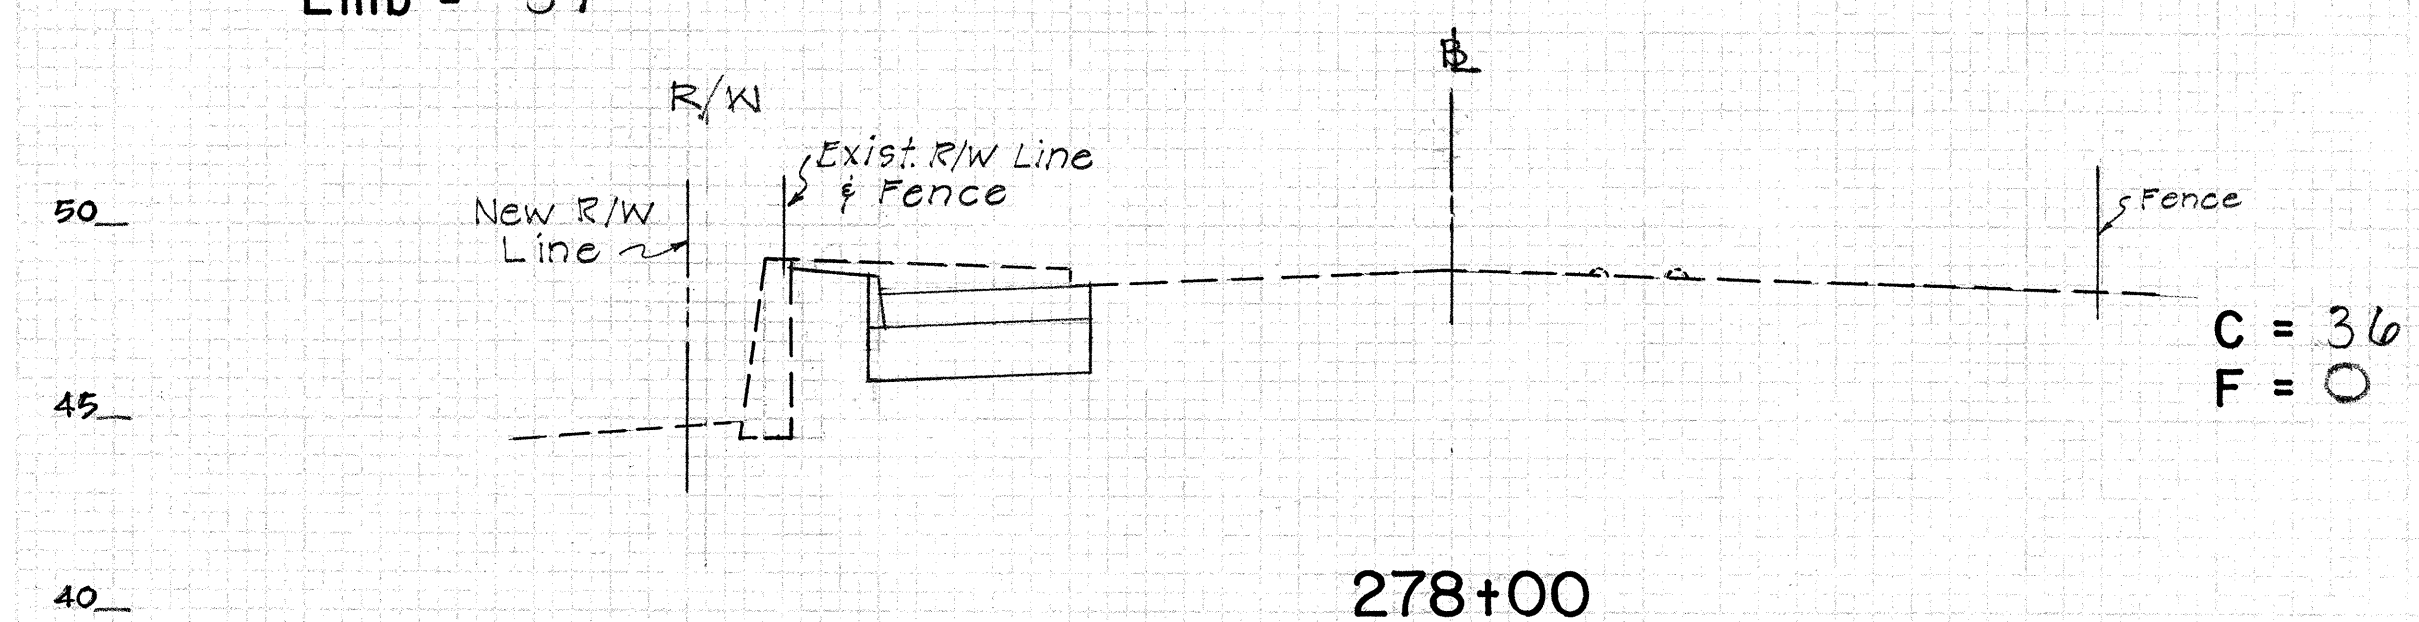


Exc = 139  
Emb = 0

C = 36  
F = 0

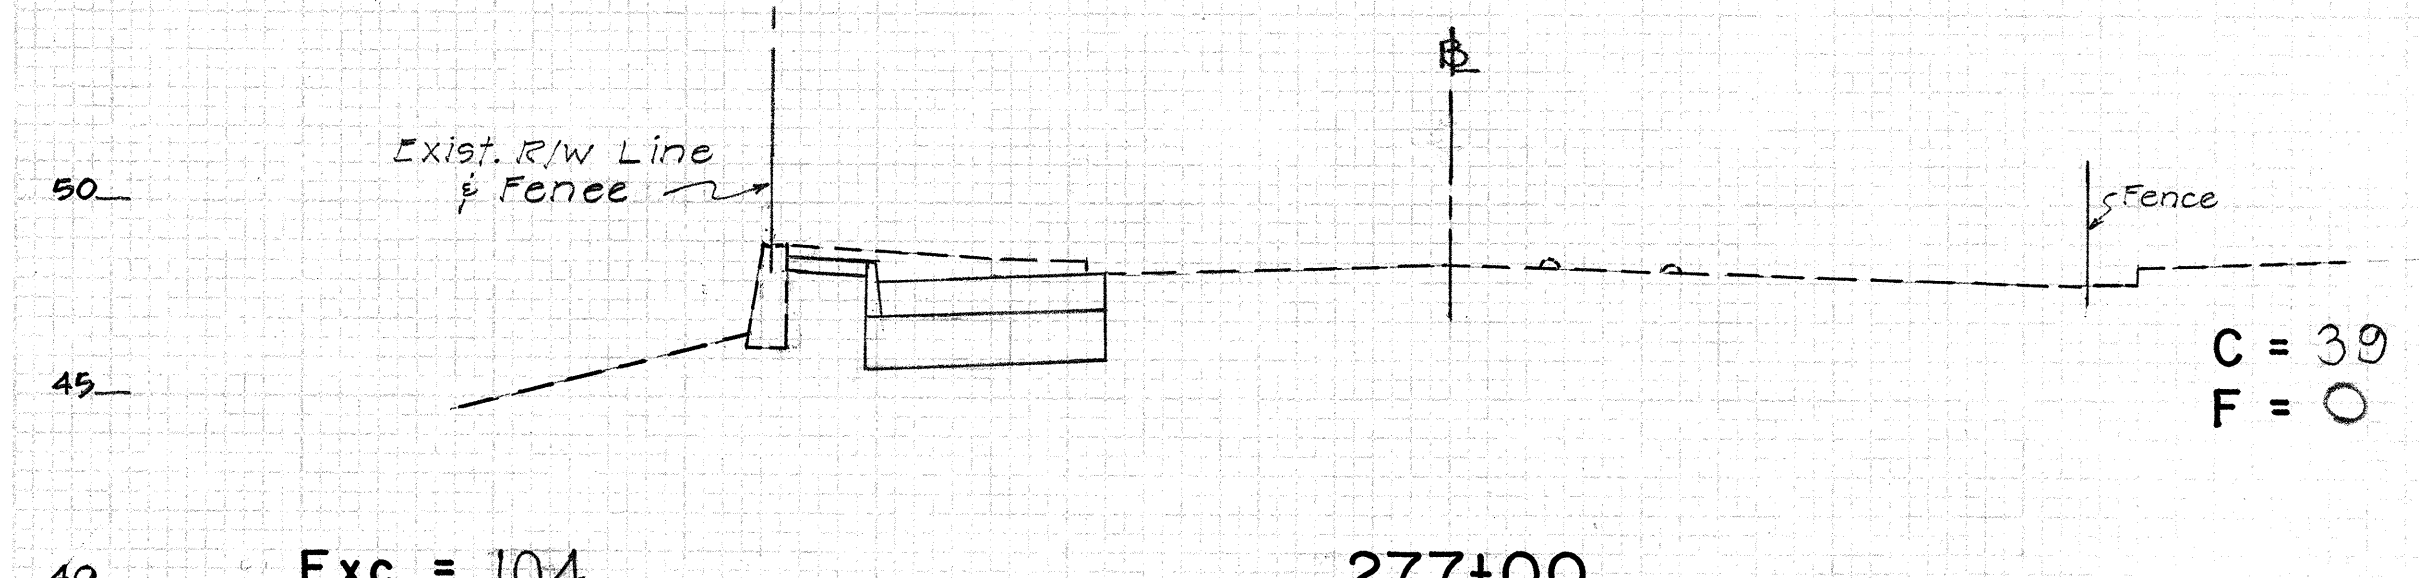


Exc = 104  
Emb = 0

C = 39  
F = 0

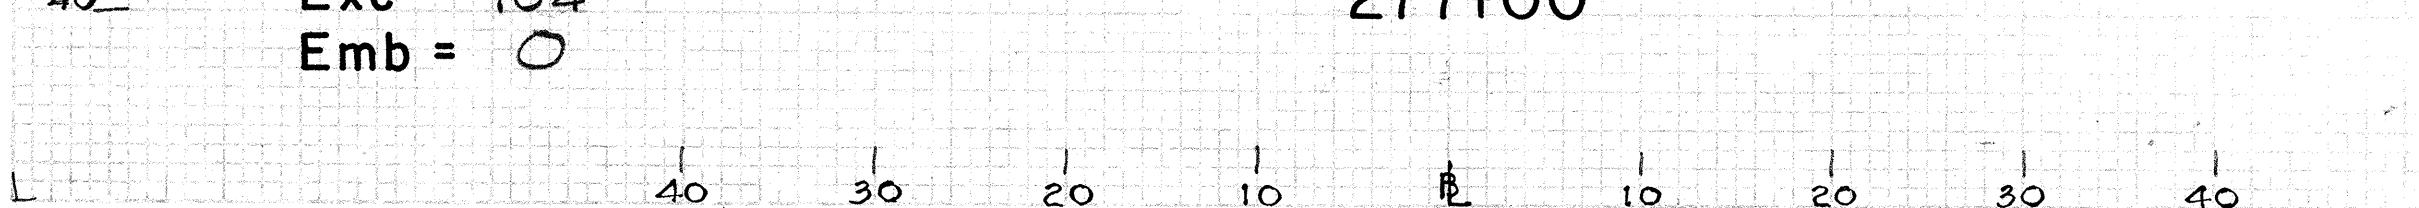


Exc = 0  
Emb = 0

C = 0  
F = 0

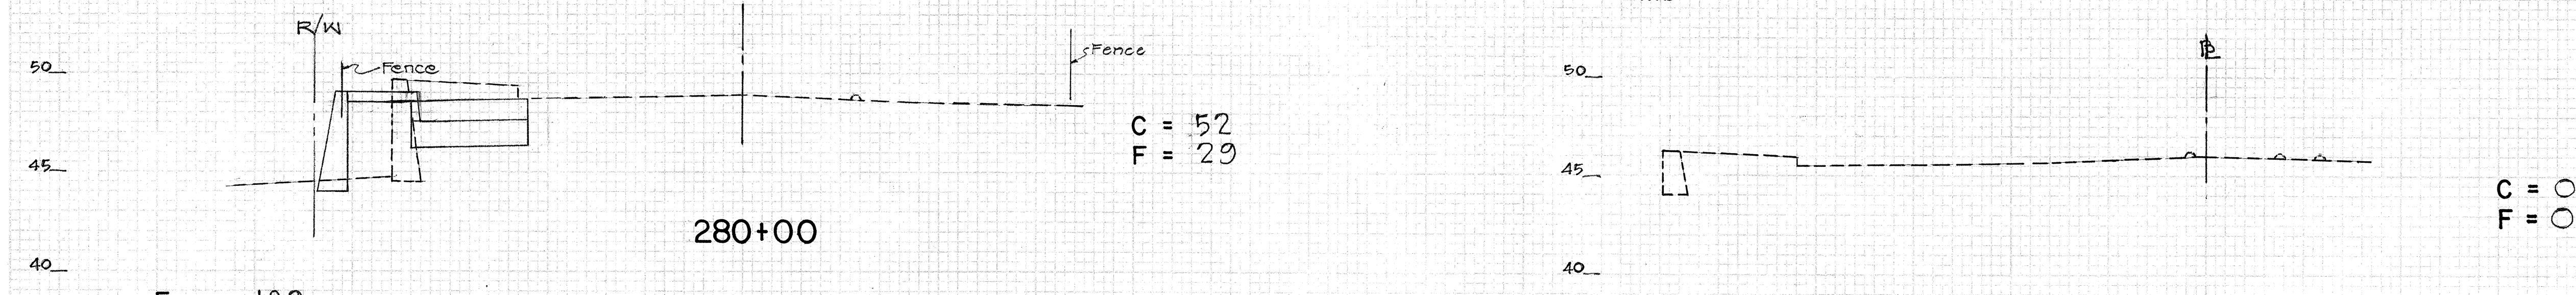


Exc = 57  
Emb = 9

C = 31  
F = 5

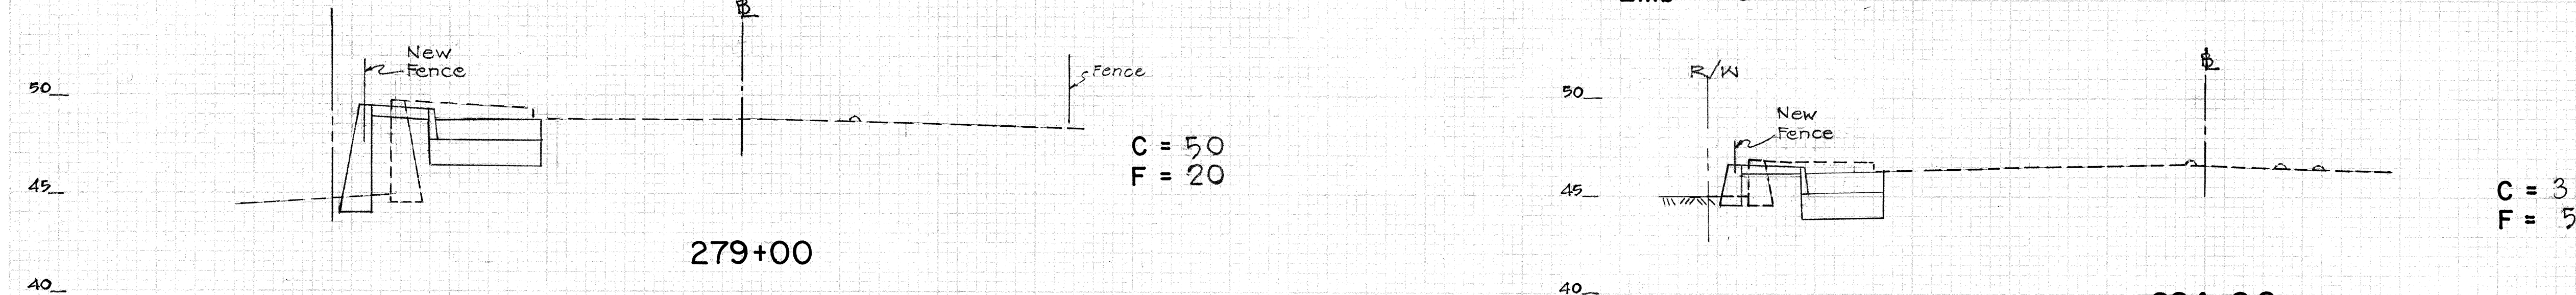


Exc = 119  
Emb = 33

C = 33  
F = 13

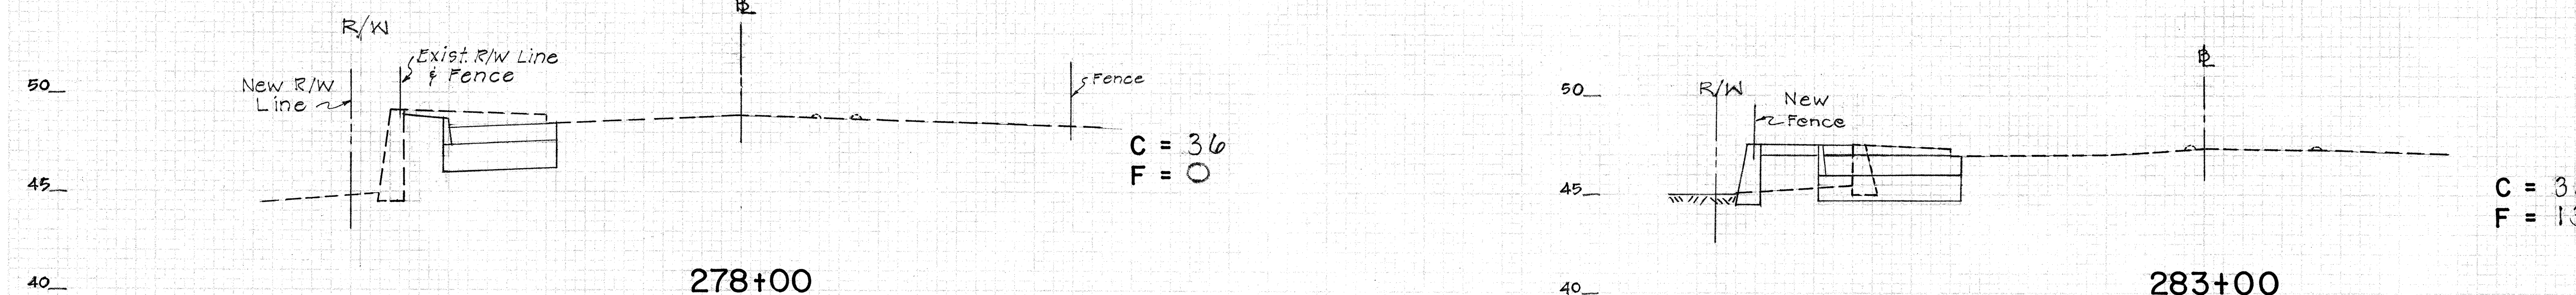

Exc = 128  
Emb = 50

C = 36  
F = 14

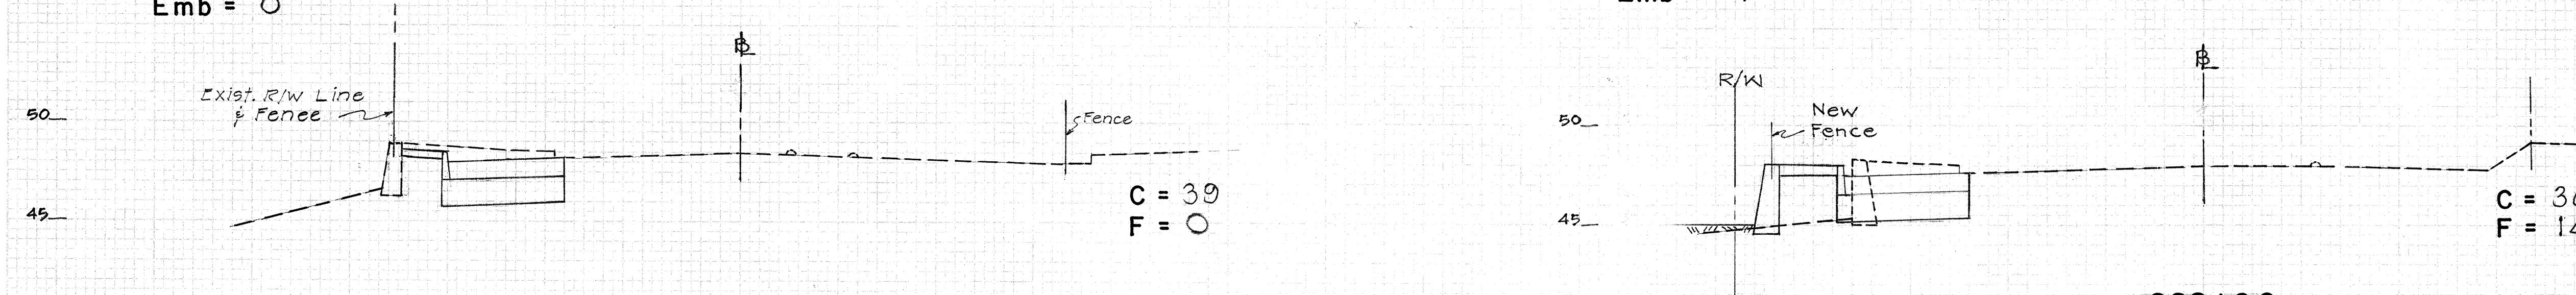

Exc = 141  
Emb = 72

