


INDEX TO DRAWINGS	
SHEET NO.	DESCRIPTION
1	TITLE SHEET
2	TYPICAL SECTIONS
3-4	PLAN AND PROFILE
5	DETAIL PLAN OF ROADWAY
6	STOCKPILE SITE FOR CHAIN LINK FENCE
7-8	RETAINING WALL AND RECONSTRUCTION OF PEDESTRIAN UNDERPASS
9	REVISED NAVY TELEPHONE MANHOLE
10-11	UTILITIES
12-21	STANDARD AND MISC. DETAILS
22-24	CROSS SECTIONS

STATE OF HAWAII  
DEPARTMENT OF TRANSPORTATION  
HIGHWAYS DIVISION  
HONOLULU, HAWAII  
  
"AS BUILT" PLANS OF  
KAMEHAMEHA HIGHWAY WIDENING  
FORD ISLAND FERRY LANDING ACCESS ROAD  
TO AIEA INTERCHANGE  
  
FEDERAL AID PROJECT NO. F-090-1 (14)

DISTRICT OF EWA  
ISLAND OF OAHU

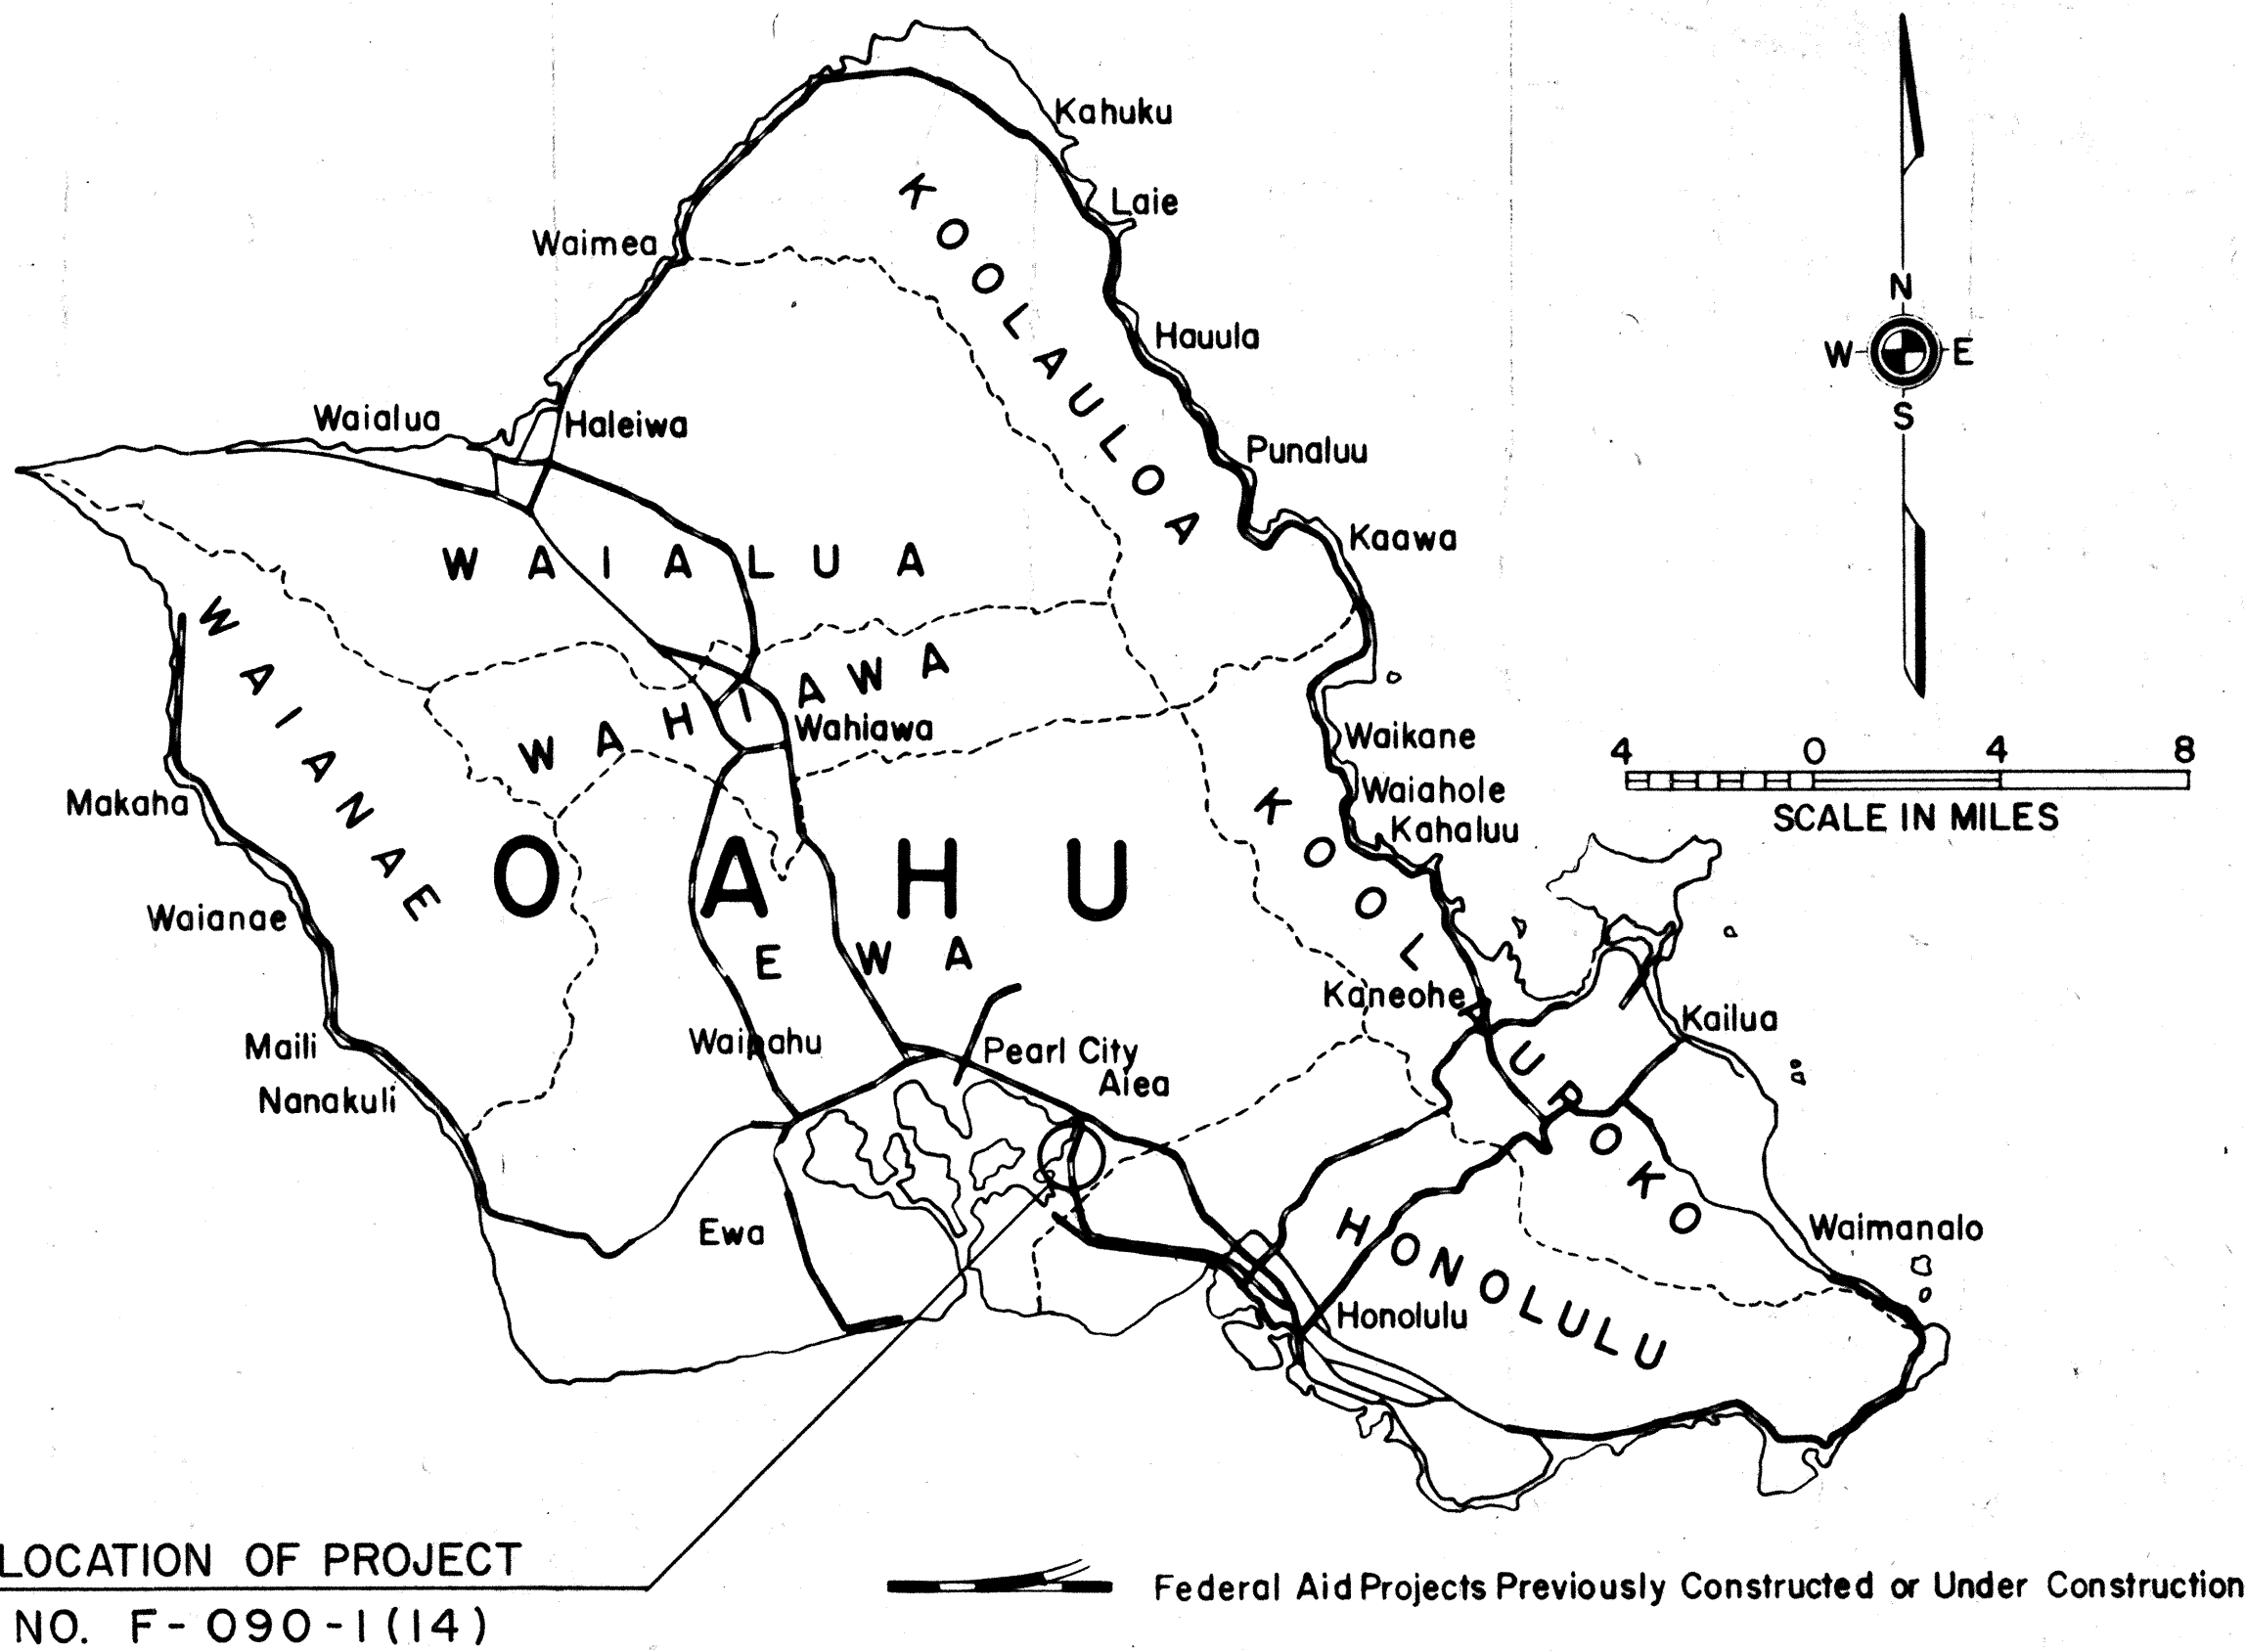


NOTE:  
ALL CHANGES MADE DURING CONSTRUCTION  
HAVE BEEN NOTED IN RED ON THESE TRACINGS  
AND CHECKED BY:

*Joseph S. Cabana*  
PROJECT ENGINEER

12/16/68  
DATE

DESIGN CLASSIFICATION	
CURRENT ADT (1967)	40,200
INTERIM ADT (1969)	76,600
DHV	8%
D	80/20
T	5%
T <sub>24</sub>	7%
V	50 M.P.H.

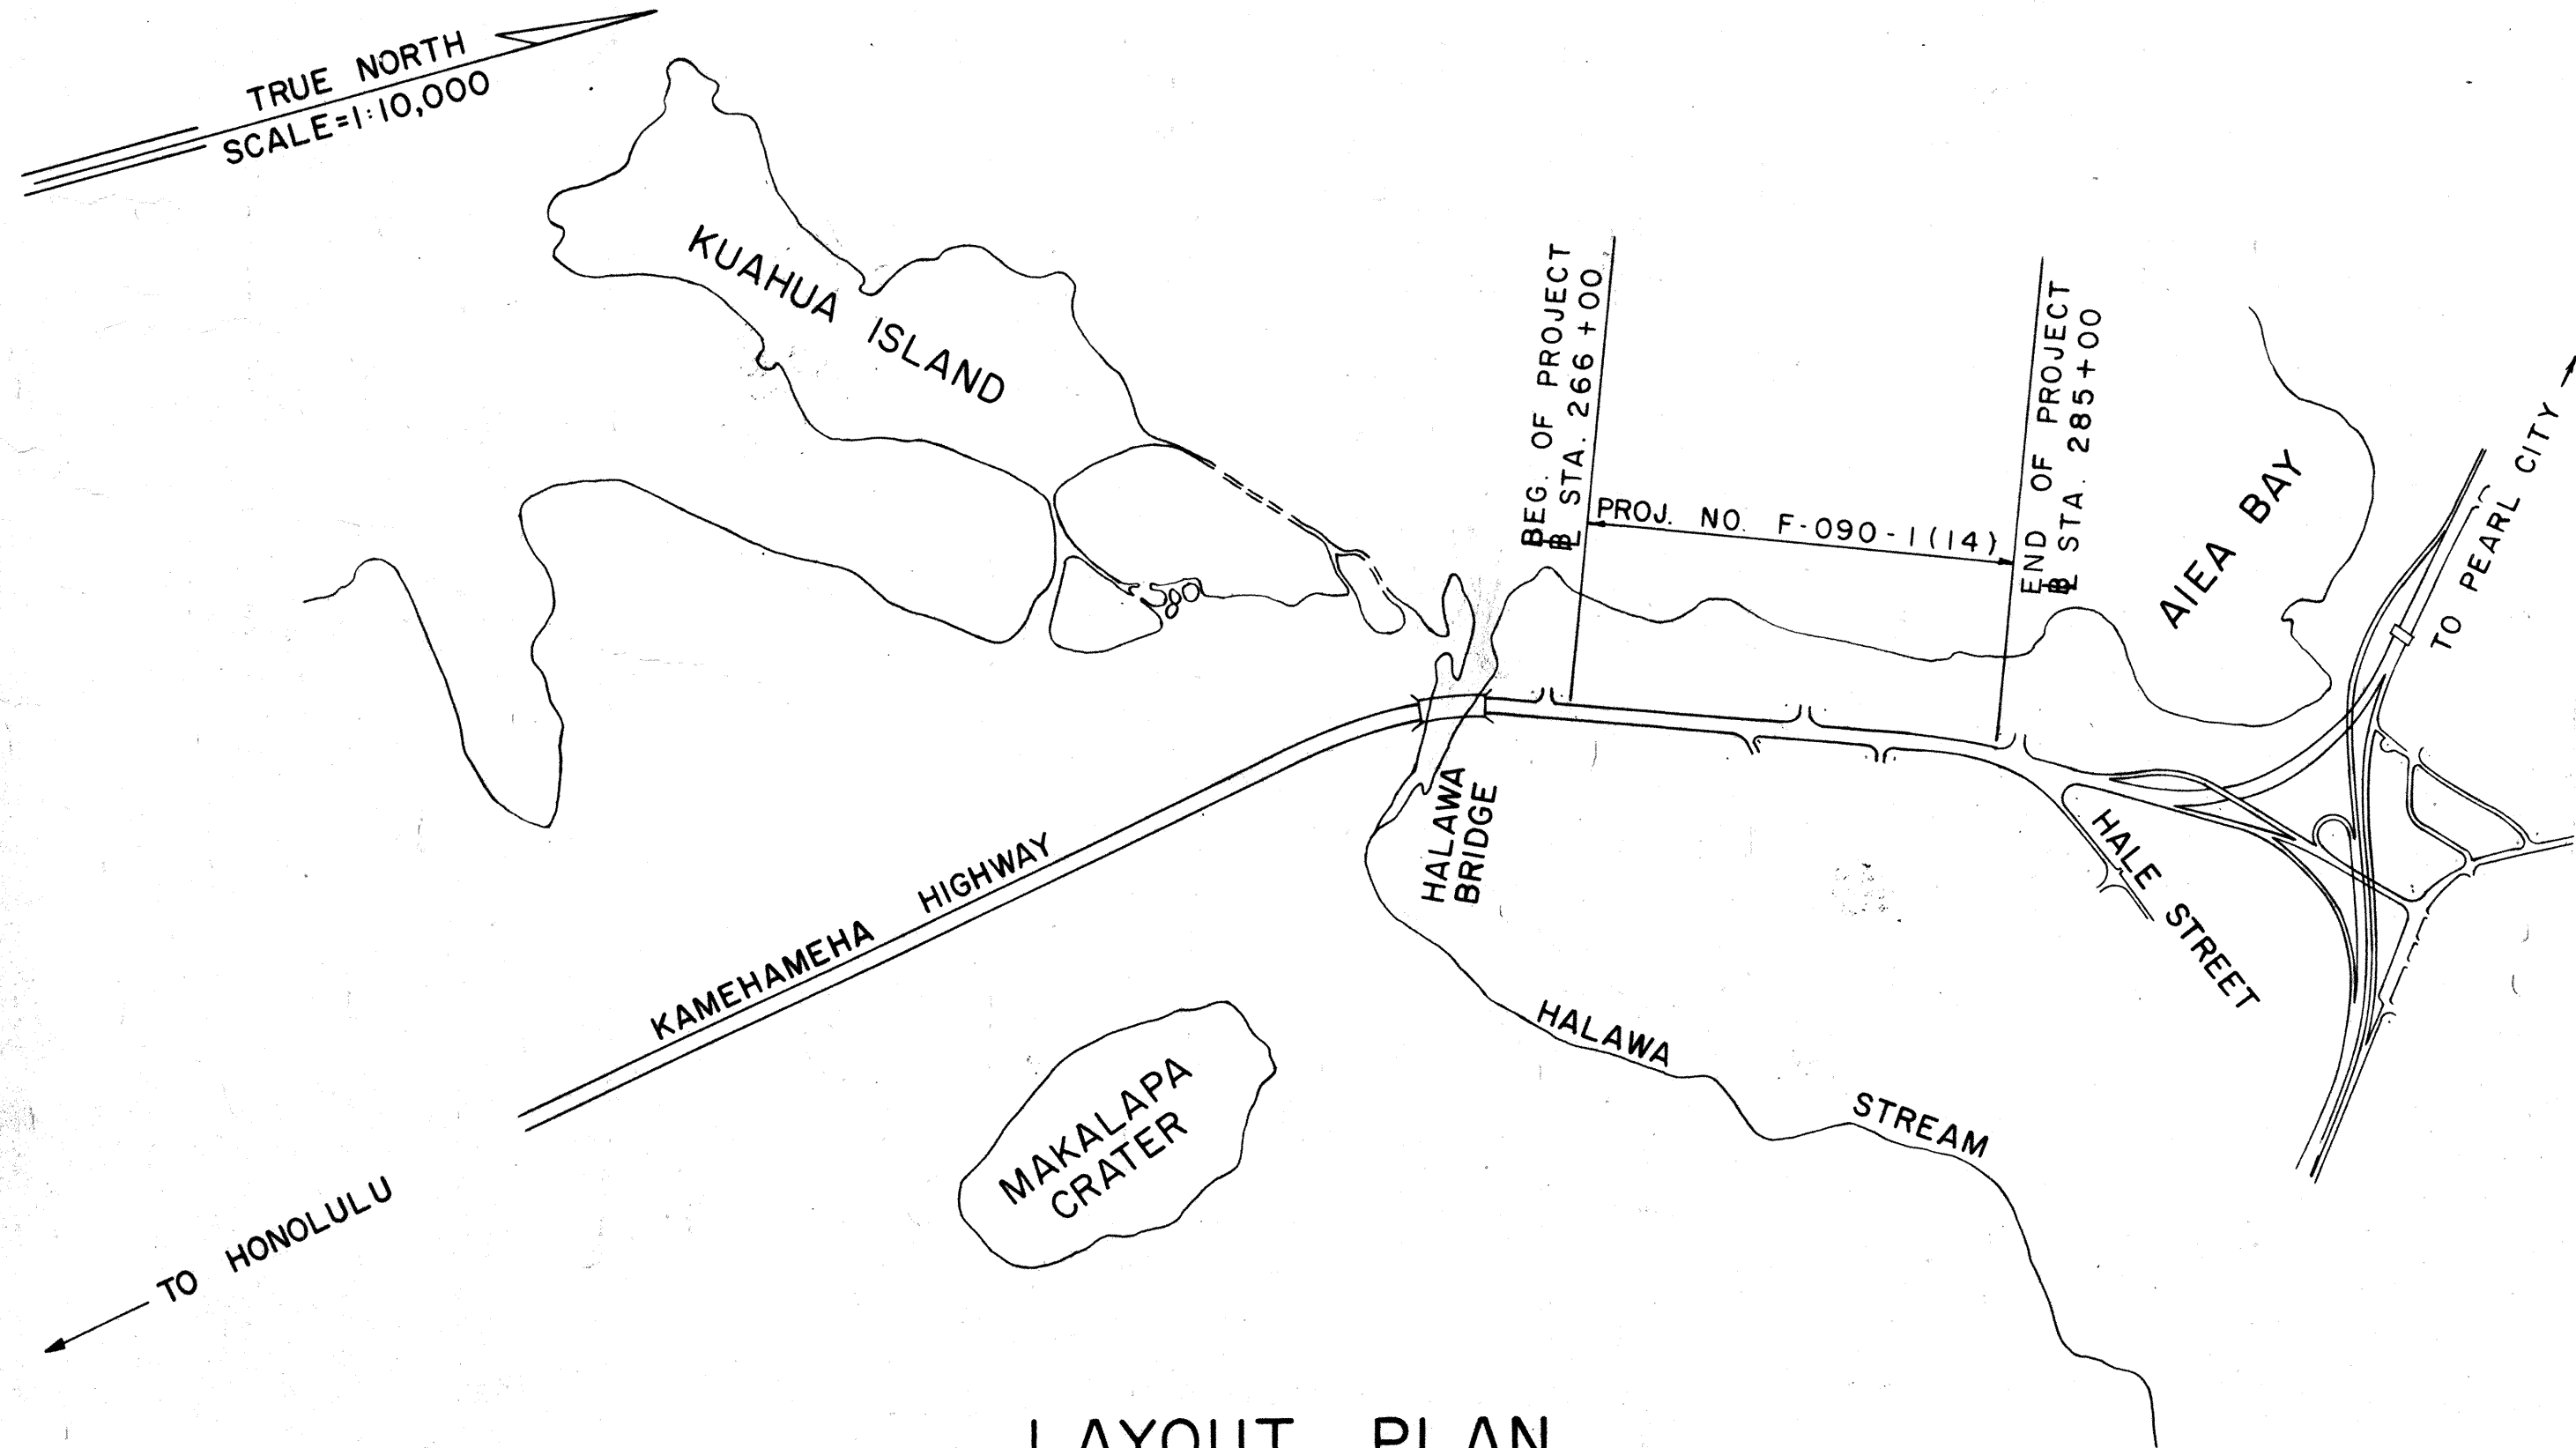

LAYOUT PLAN  
LENGTH OF PROJECT: 0.360 Mi.

DEPARTMENT OF TRANSPORTATION  
BUREAU OF PUBLIC ROADS  
APPROVED: *Neil Dillworth* 9-16-68  
FOR DIVISION ENGINEER DATE

DEPARTMENT OF TRANSPORTATION  
STATE OF HAWAII  
APPROVED: *Joseph S. Cabana* 9/28/68  
DIR. OF TRANSPORTATION DATE

K. WONG MARCH, 1968

DS-3-6