



GENERAL NOTES

- Existing concrete and asphalt curbs, including islands, that fall within the limits of new pavement shall be removed. This work shall be considered as incidental to "Roadway Excavation".
- 4-inch plain concrete for Traffic Island shall be measured and paid for as "Reinforced Concrete Sidewalk".
- Existing roads or areas paved with concrete or bituminous material which will underlie unpaved finished grade, or area called for sodding, or planting, shall be scarified. The cost of scarifying shall be considered as incidental to the item of "Roadway Excavation".
- The Contractor shall take every precaution not to damage existing underground utility pipe lines or duct lines during construction.


FED. ROAD DIST. NO.	STATE	FED. AID PROJ. NO.	FISCAL YEAR	SHEET NO.	TOTAL SHEETS
HAWAII	HAW.	F-090-1(14)	1968	2	24

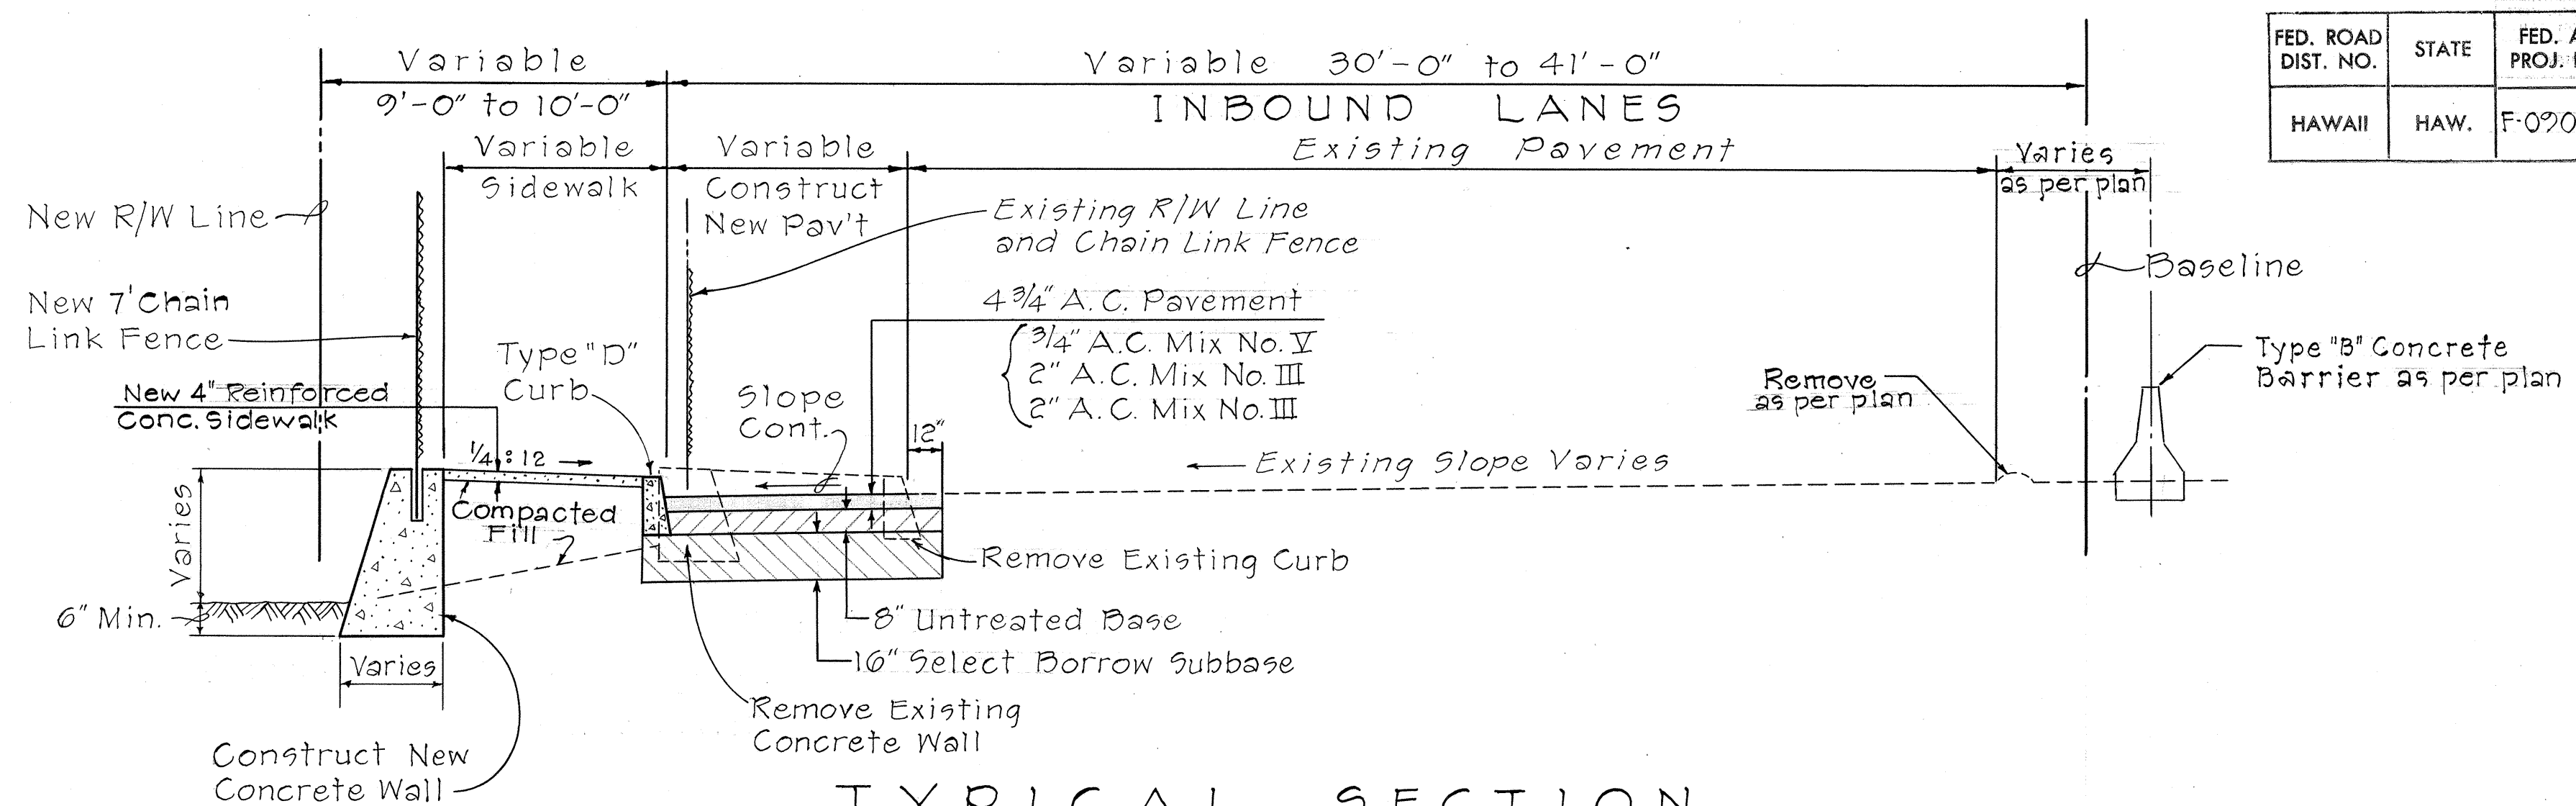


TYPICAL SECTION
 STA. 278+00 TO STA. 284+00
 Scale: 1/4" = 1'-0"

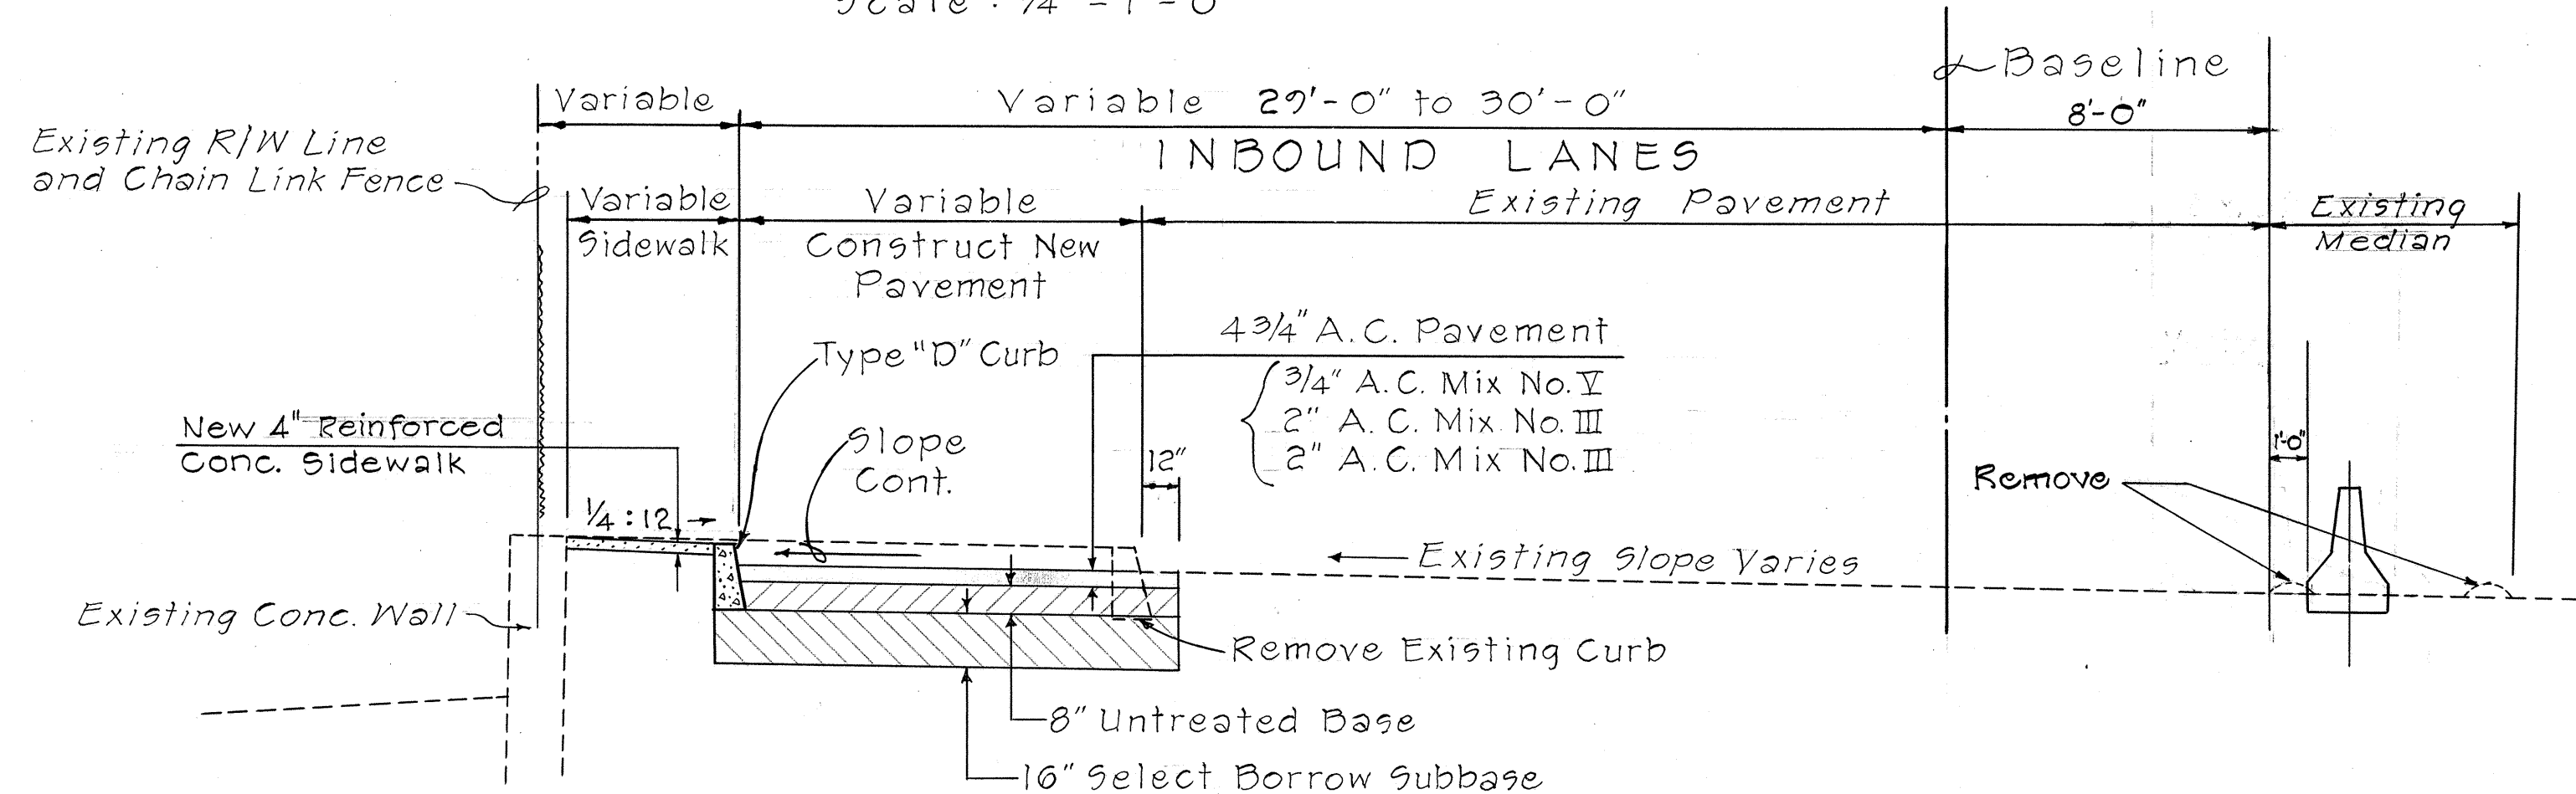


TYPICAL SECTION
 STA. 275+24.31 TO STA. 278+00
 Scale: 1/4" = 1'-0"

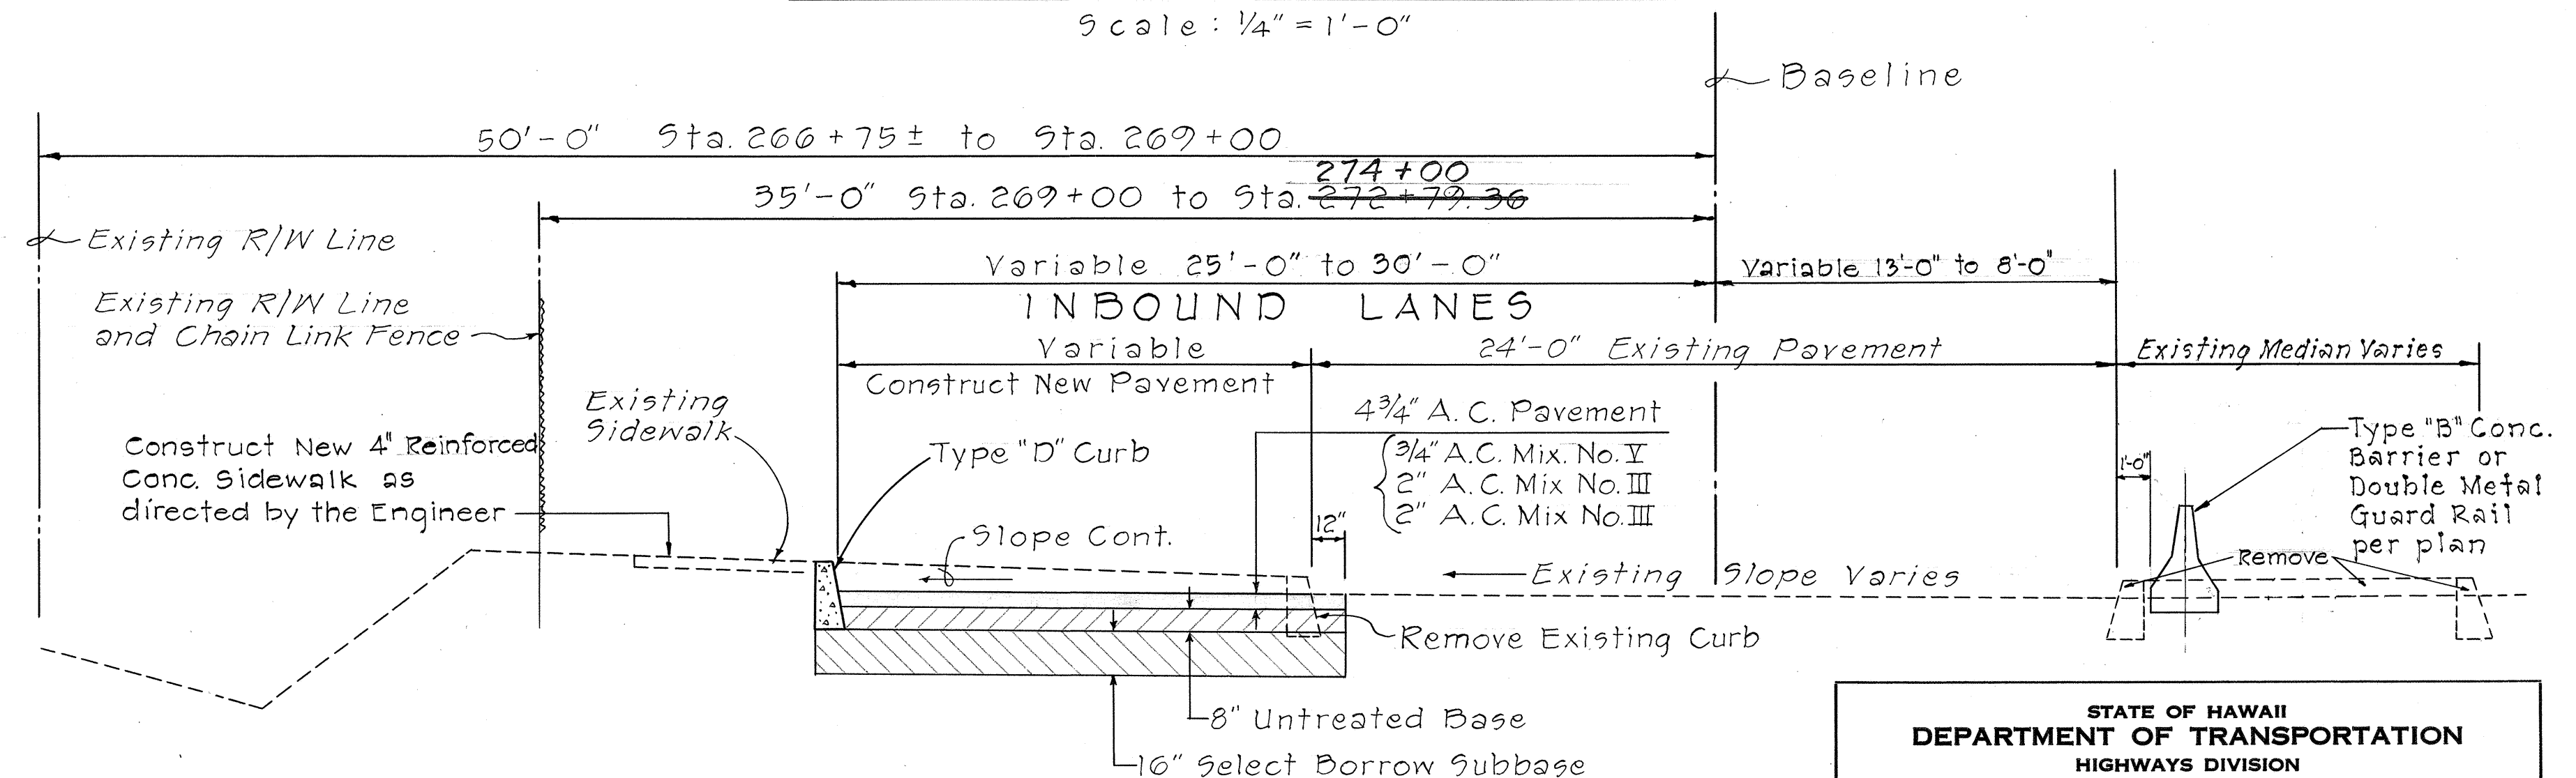

TYPICAL SECTION
 STA. 266+75± TO STA. 272+79.36
 Scale: 1/4" = 1'-0"

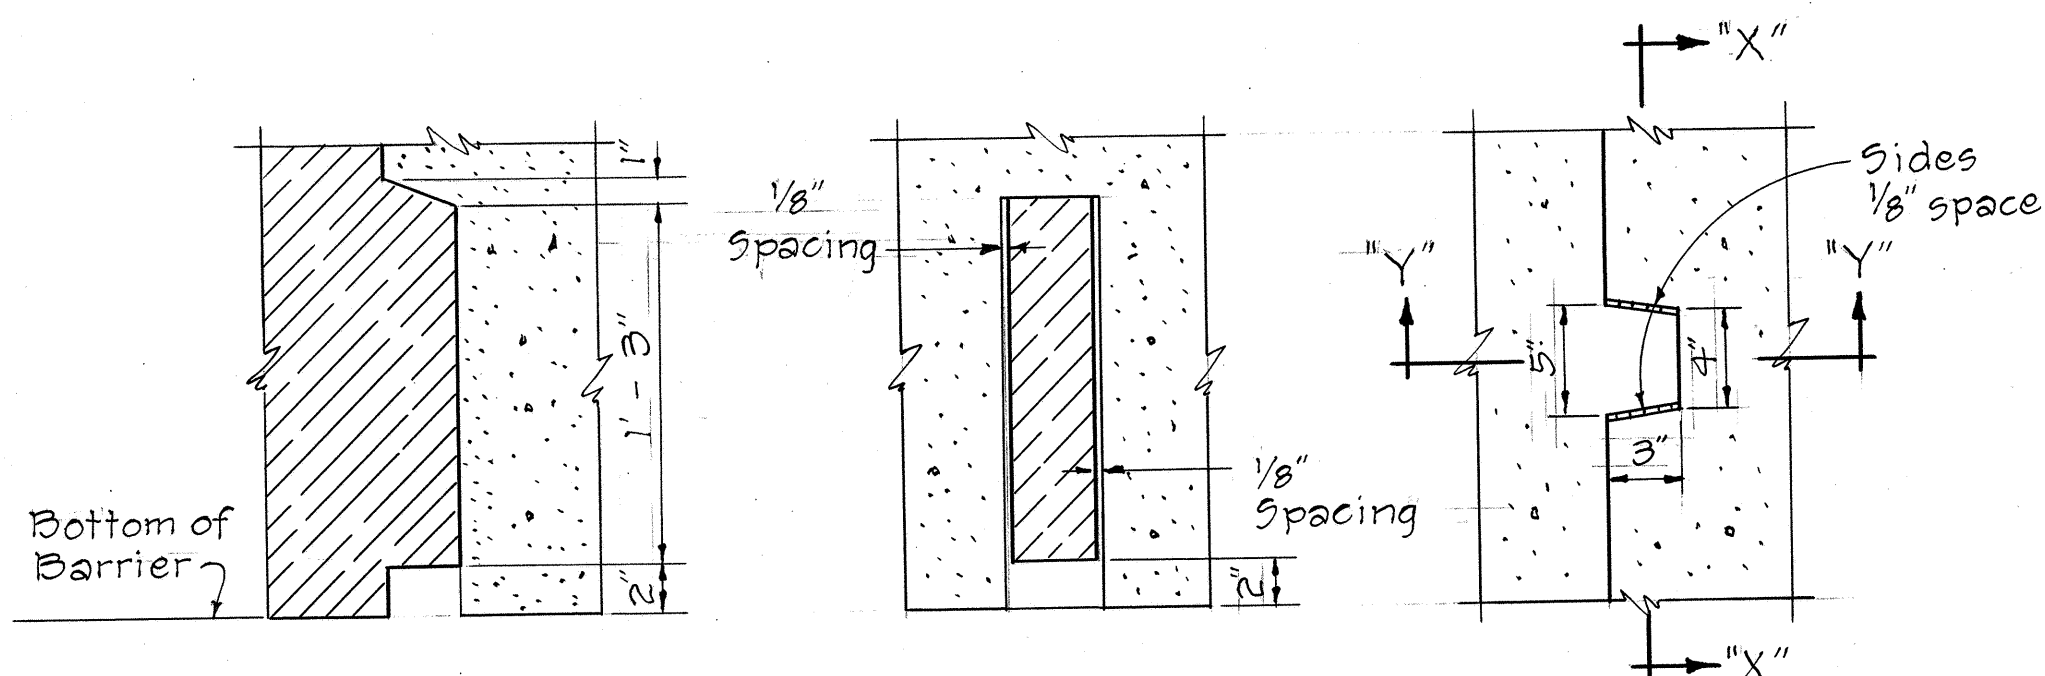

SECTION "Y-Y" SECTION "X-X" PLAN
TYPICAL CONSTRUCTION JOINT KEY
 Scale: 1 1/2" = 1'-0"

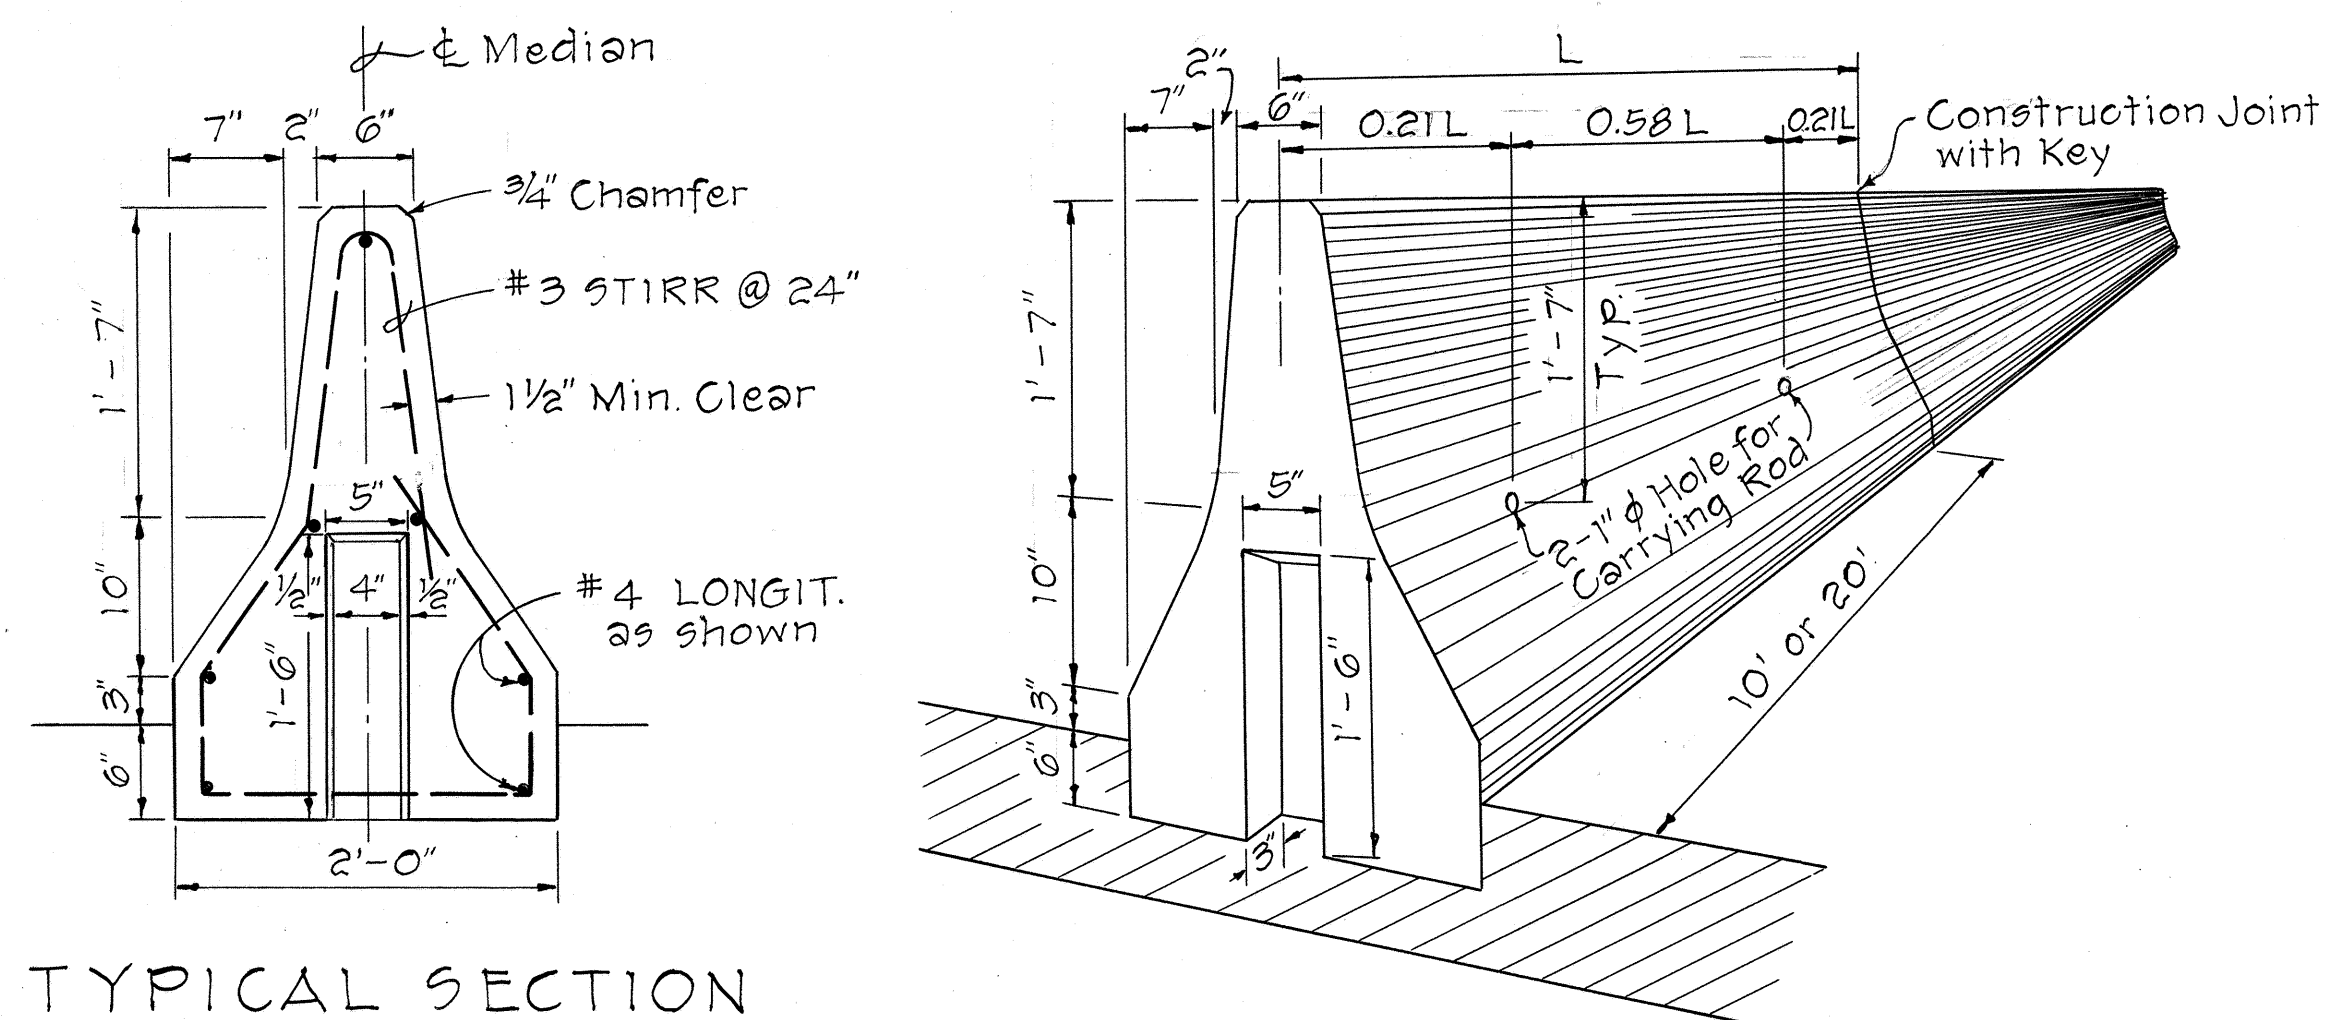

TYPICAL SECTION
 Scale: 1" = 1'-0"

NOTE:

Precast Type "B" Concrete Barrier may be installed as an option to Cast-in-place Type "B" Concrete Barrier. Precast Concrete Barrier in curved areas shall be constructed on chord with 10' sections only. Precast Concrete Barriers on tangent area may be constructed with either 10' or 20' sections.

DETAIL FOR PRECAST TYPE "B" CONCRETE BARRIER

STATE OF HAWAII DEPARTMENT OF TRANSPORTATION HIGHWAYS DIVISION	
TYPICAL SECTIONS	
KAMEHAMEHA HWY. WIDENING PROJECT NO. F-090-1(14)	
SCALE: As Noted	DATE: Oct. 1967
SHEET NO. 1 OF 1 SHEETS	