


[illegible]

STATE OF HAWAII
DEPARTMENT OF TRANSPORTATION
HIGHWAYS DIVISION
HONOLULU, HAWAII

CONSTRUCTION PLANS
FOR
KAMEHAMEHA HIGHWAY
IMPROVEMENTS AT WAIHAU STREET
FED. AID PROJECT NO. F-099-1(4)

DISTRICT OF EWA
ISLAND OF OAHU

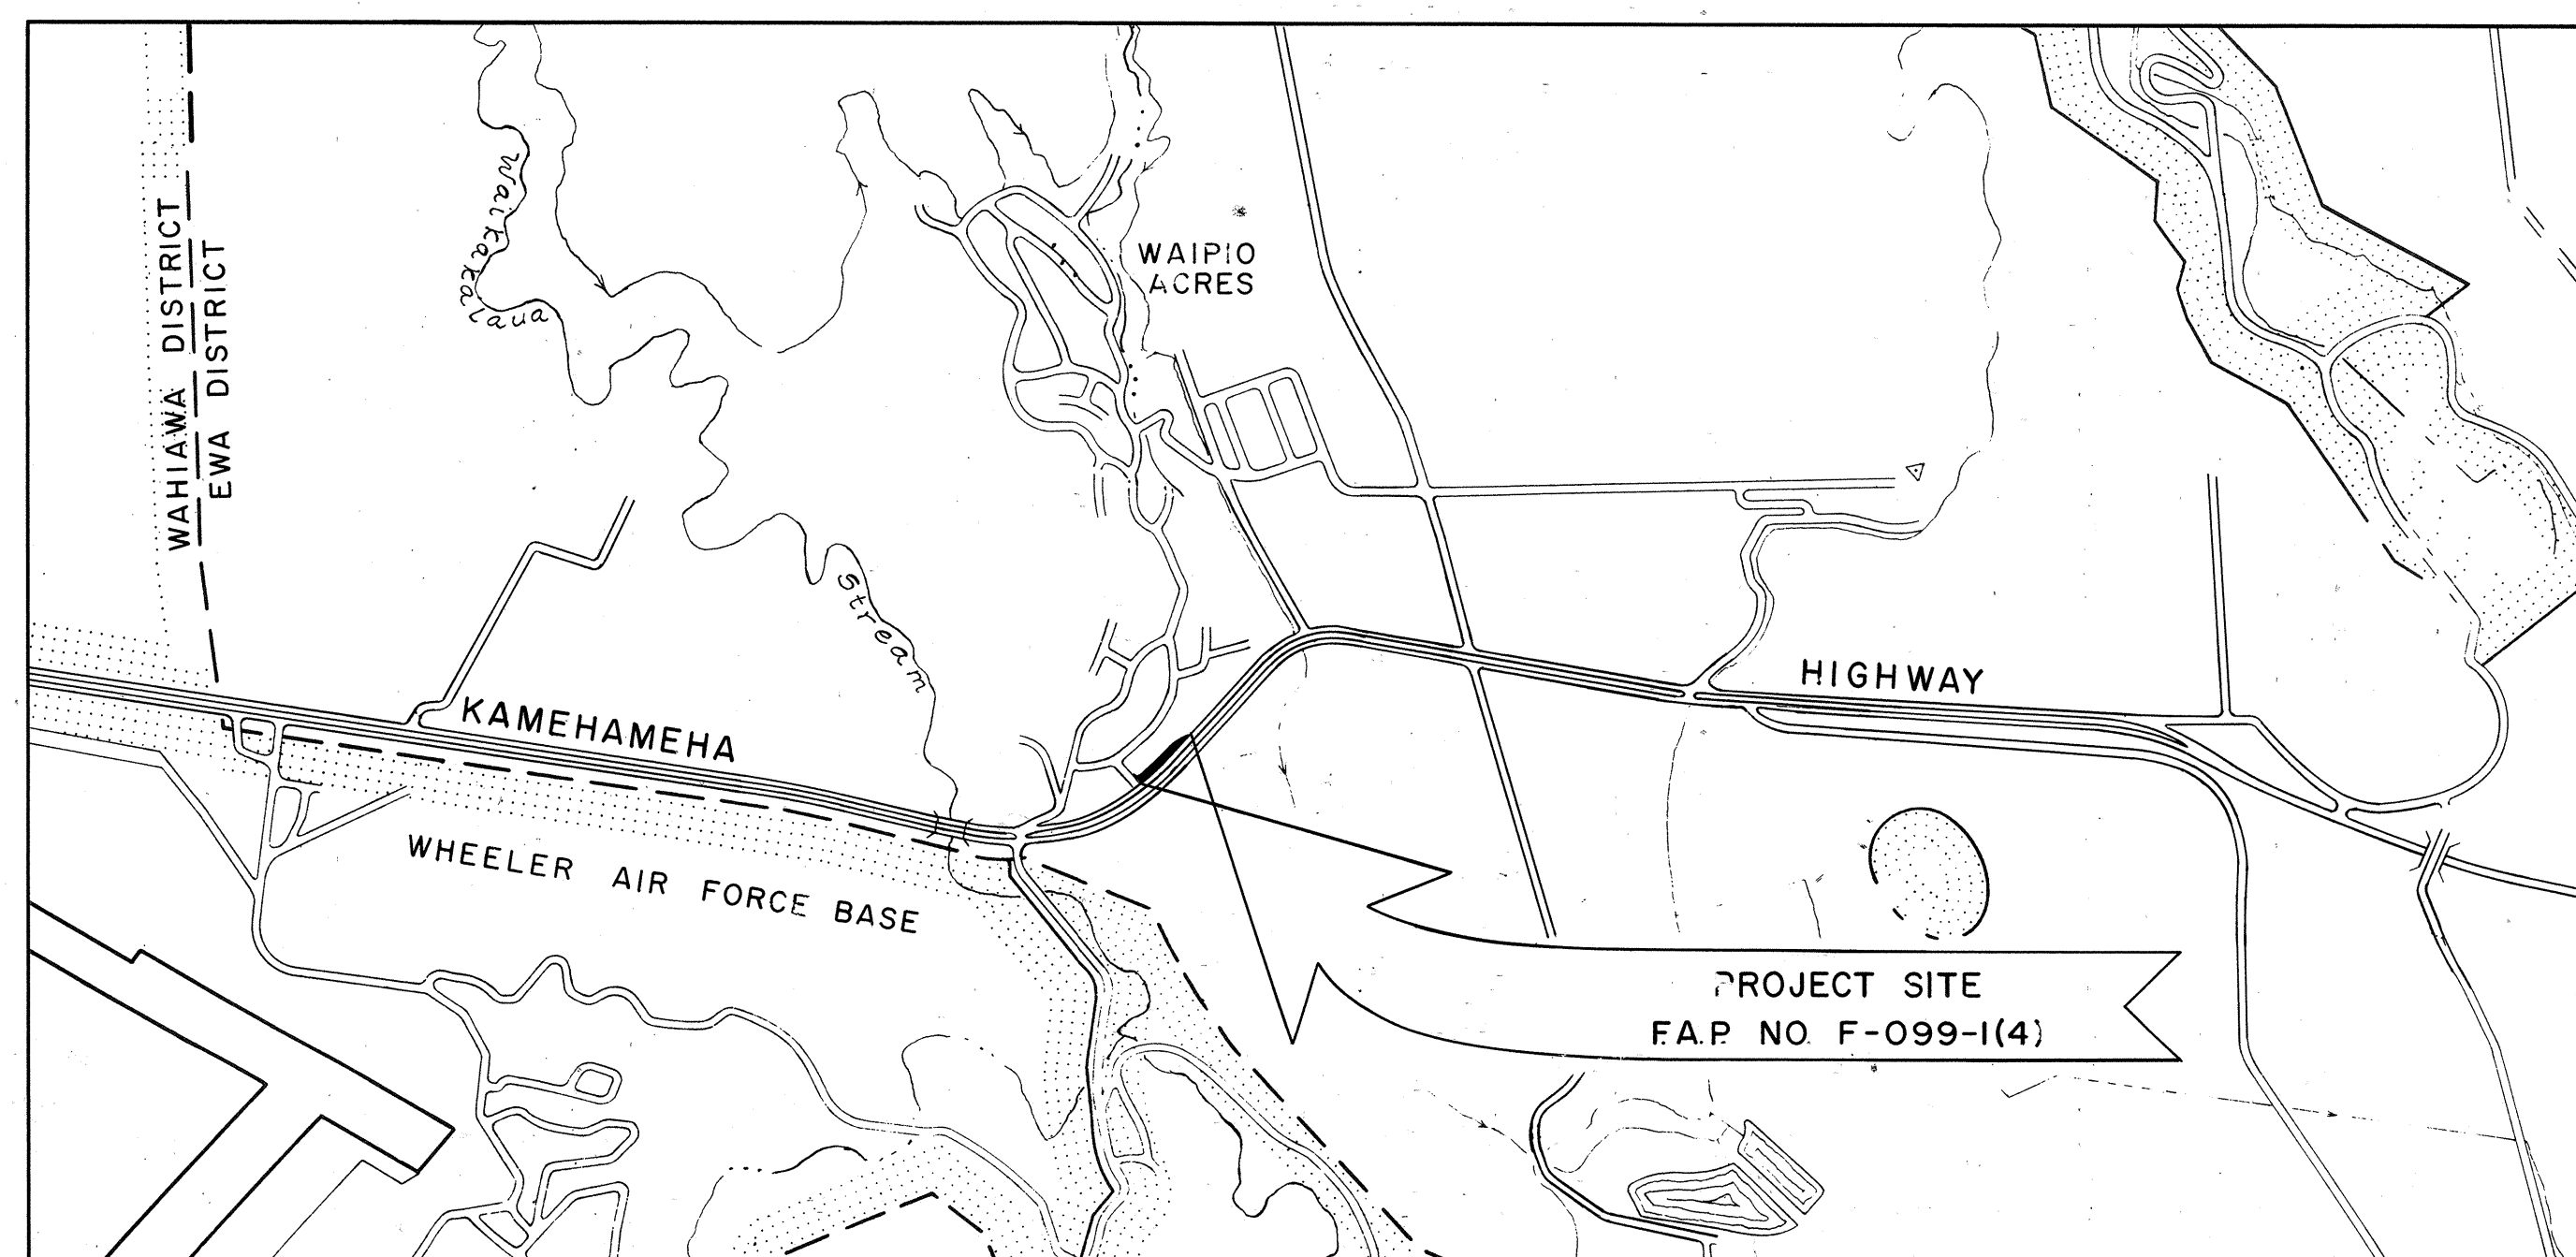


A horizontal scale bar with alternating black and white segments. It is marked with the numbers 0.0, 0.5, 1.0, and 2.0. Below the bar, the text "SCALE IN MILES" is centered.

LAYOUT PLAN

LENGTH OF PROJECT.....0.133 Mi.

FED. ROAD DIST. NO.	STATE	FED. AID PROJ. NO.	FISCAL YEAR	SHEET NO.	TOTAL SHEET
HAWAII	HAW.	F-099-1(4)	1968	1	9

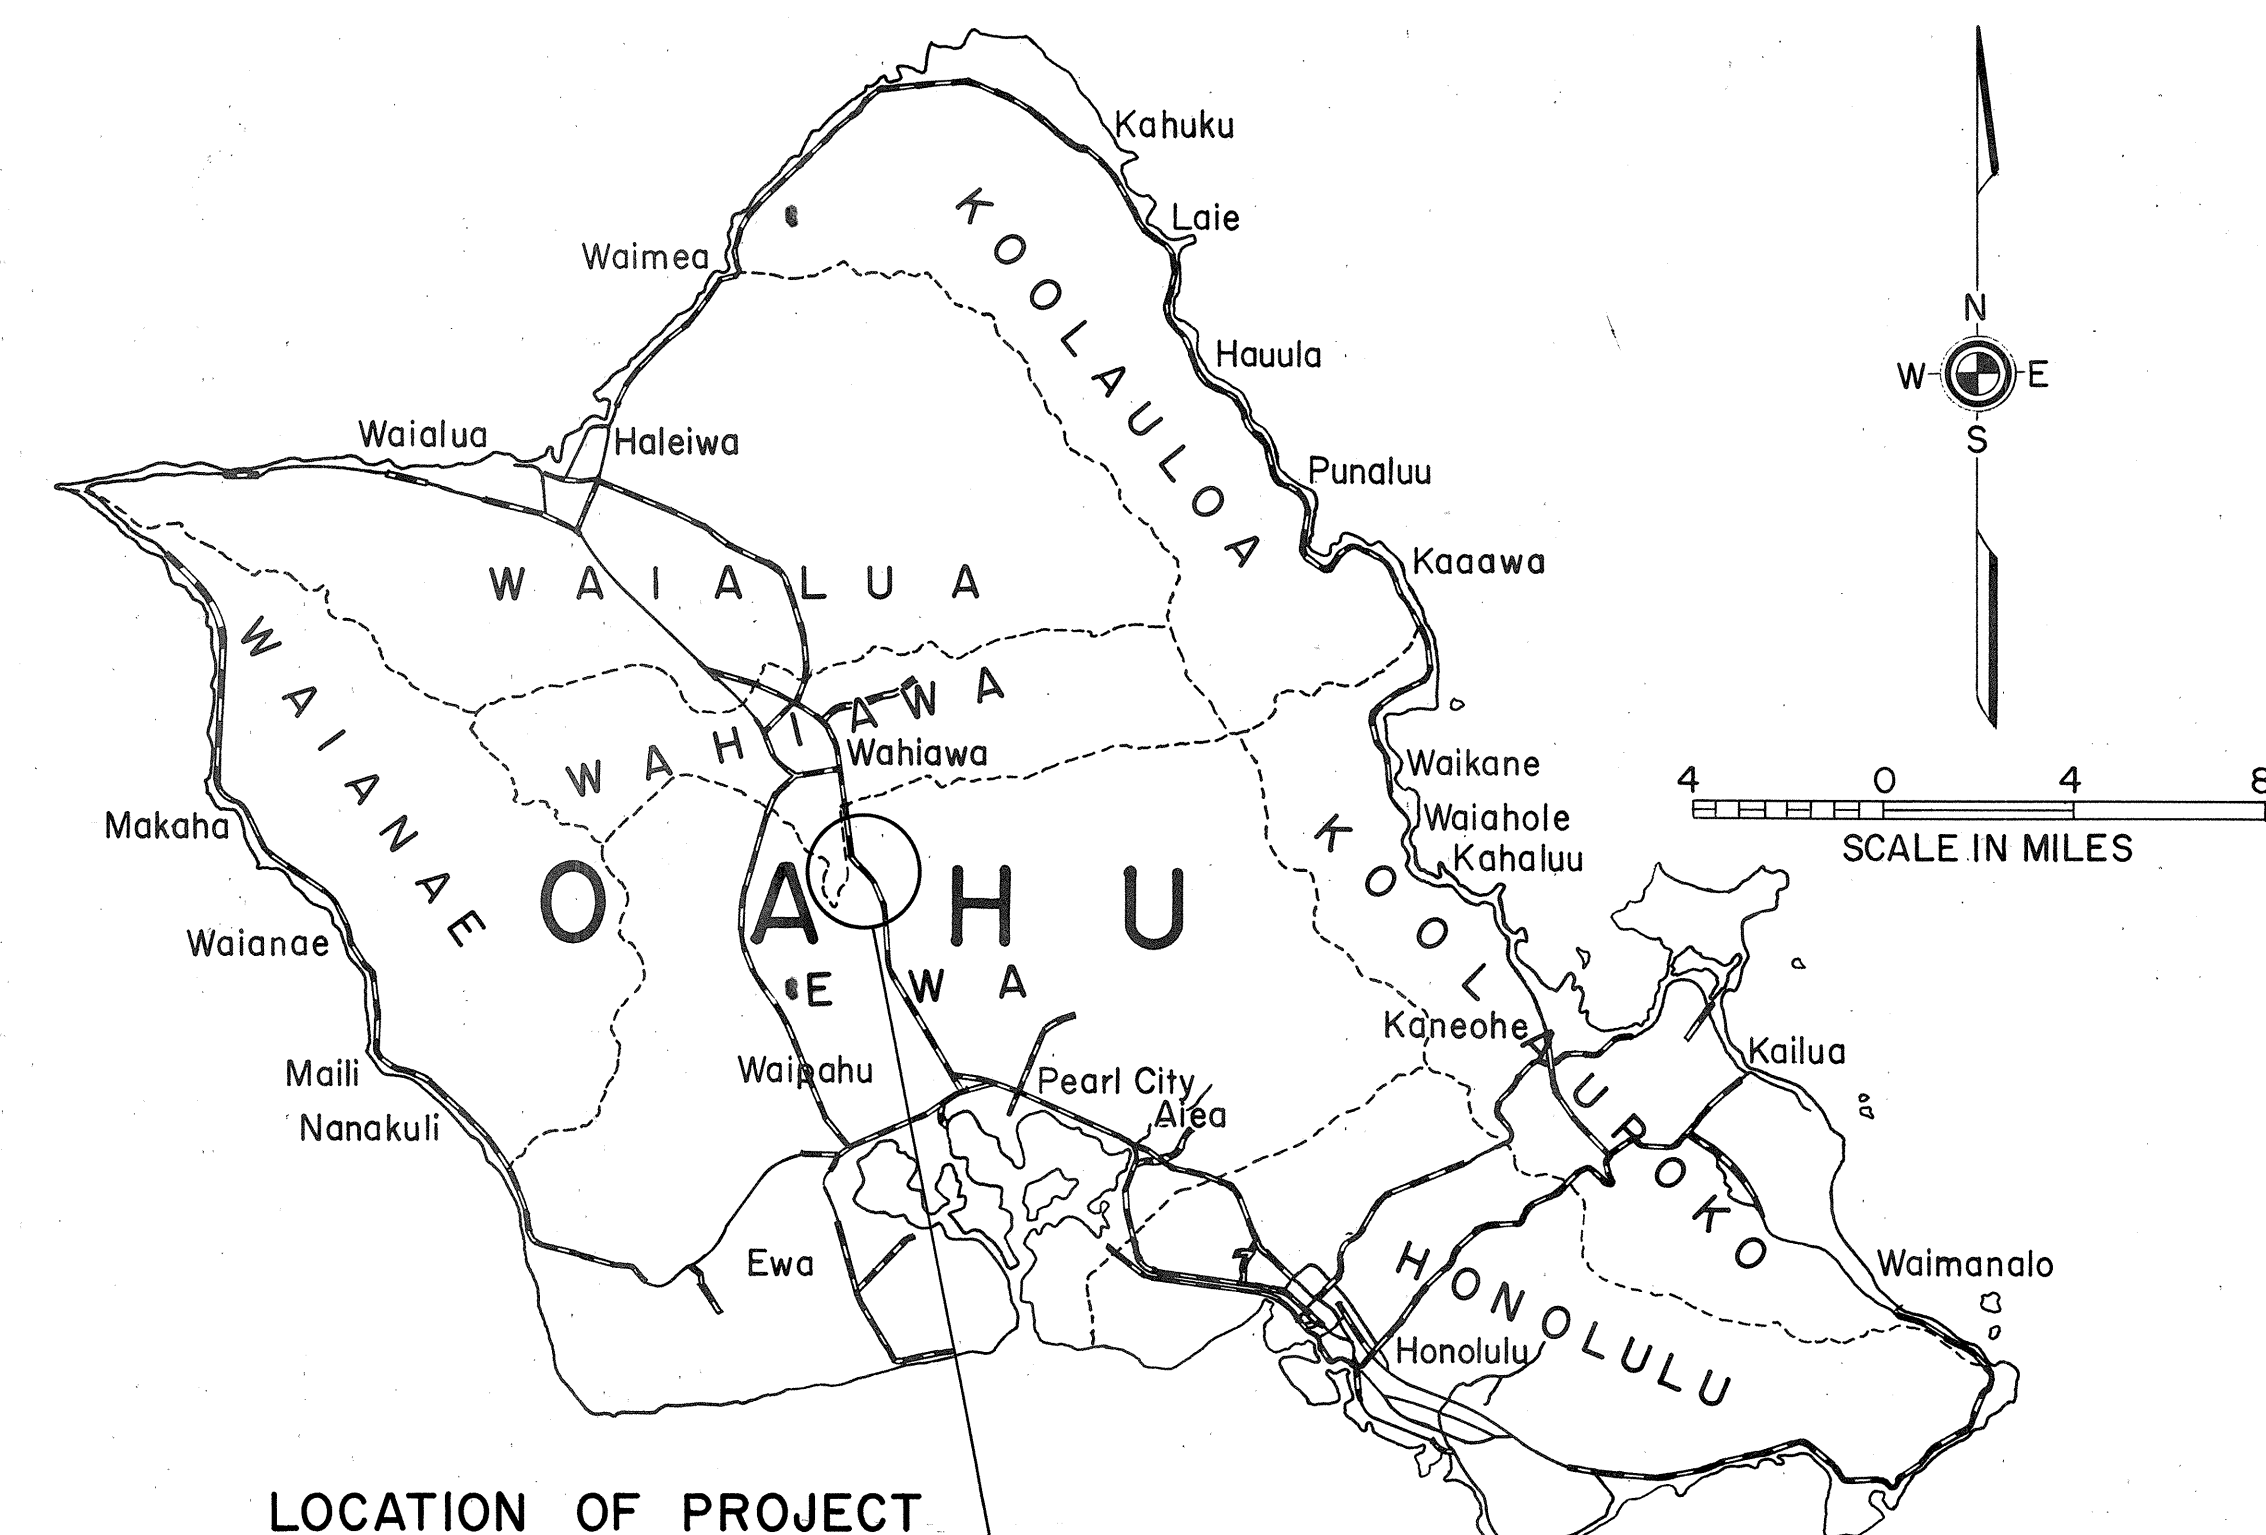 Federal Aid Projects Previously Constructed or Under Construction

NO AS-BUILT CHANGES

for R. T. Sorek 7-3-73
PROJECT ENGINEER DATE

DESIGN CLASSIFICATION

ADT 1967..... 19,100
V..... 50 M.P.H.

DEPARTMENT OF TRANSPORTATION
BUREAU OF PUBLIC ROADS

APPROVED:

FOR Nat. Delmonico 12-5-61
DIVISION ENGINEER DATE

DEPARTMENT OF TRANSPORTATION
STATE OF HAWAII

APPROVED:

John McQuinn 5/23/6
DIR. OF TRANSPORTATION DATE