

CURVE DATA (H-1 Outbound to H-2 Outbound)
 $\Delta = 41^\circ 23' 00''$
 $\Delta/2 = 20^\circ 44' 00''$
 $R = 1524'$
 $T = 576.89'$
 $L_c = 1102.96'$
 $Ch = 1079.05'$

DESIGN CRITERIA

- Loads = H520-44 or Interstate Loading.
 Specifications = Standard Specifications for Highway Bridges, AASHTO, 9th Edition.
 Design Stresses:
- P.C. Beams & slabs - See also AASHTO Specifications & Special Provisions.
 $f'_c = 3,000$ p.s.i. concrete
 $f'_s = 20,000$ p.s.i. reinf. steel
 - Prestressed Girders - See Sh. 3
 - Pile Capacity = 45 tons for Abut. #2.
 Allowable Foundation Pressure = 12,000 p.s.f. for Abut. #1.

REFERENCE DRAWINGS


- For grading & drainage requirements not shown, See Civil Drawings.
- See also, Electrical Drawings for items not shown.

NOTES:


- For General Notes, See Sh. 99.
- In general, bridge superstructure shall be constructed to follow the finished roadway.
- Construction Methods:
 - Sides of footing shall be excavated to neat lines when called for on Plans. Over excavation below excavations indicated on Plans for bottom of footings shall be backfilled with a minimum of Class D concrete as directed by the Engineer at the Contractor's expense.
 - Backfill behind abutments and behind wingwalls shall be filled up to bottom of girder before construction of the superstructure.
 - Backfill against abutments and wingwalls shall be carried out in such a manner that the differential of soil on each side of the wall shall not exceed 2'-0" whenever applicable.
 - Portion of the wingwalls above the roadway surface may be constructed along with the bridge concrete railing.

SEQUENCE OF CONSTRUCTION FOR PILE DRIVING

- Pre-load soil as indicated in diagram at left to attain settlement as specified in SUGGESTED CONSTRUCTION PHASING PLAN on Civil Sheet 9.
- After completion of Step ①, pre-drill through embankment down to existing grade. (Holes shall be 6" larger than pile diameter)
- Drive piles to minimum depths indicated on plans.
- Fill void around piles with loose dry sand meeting the grading requirements of 47.2 (D) FINE AGGREGATE.

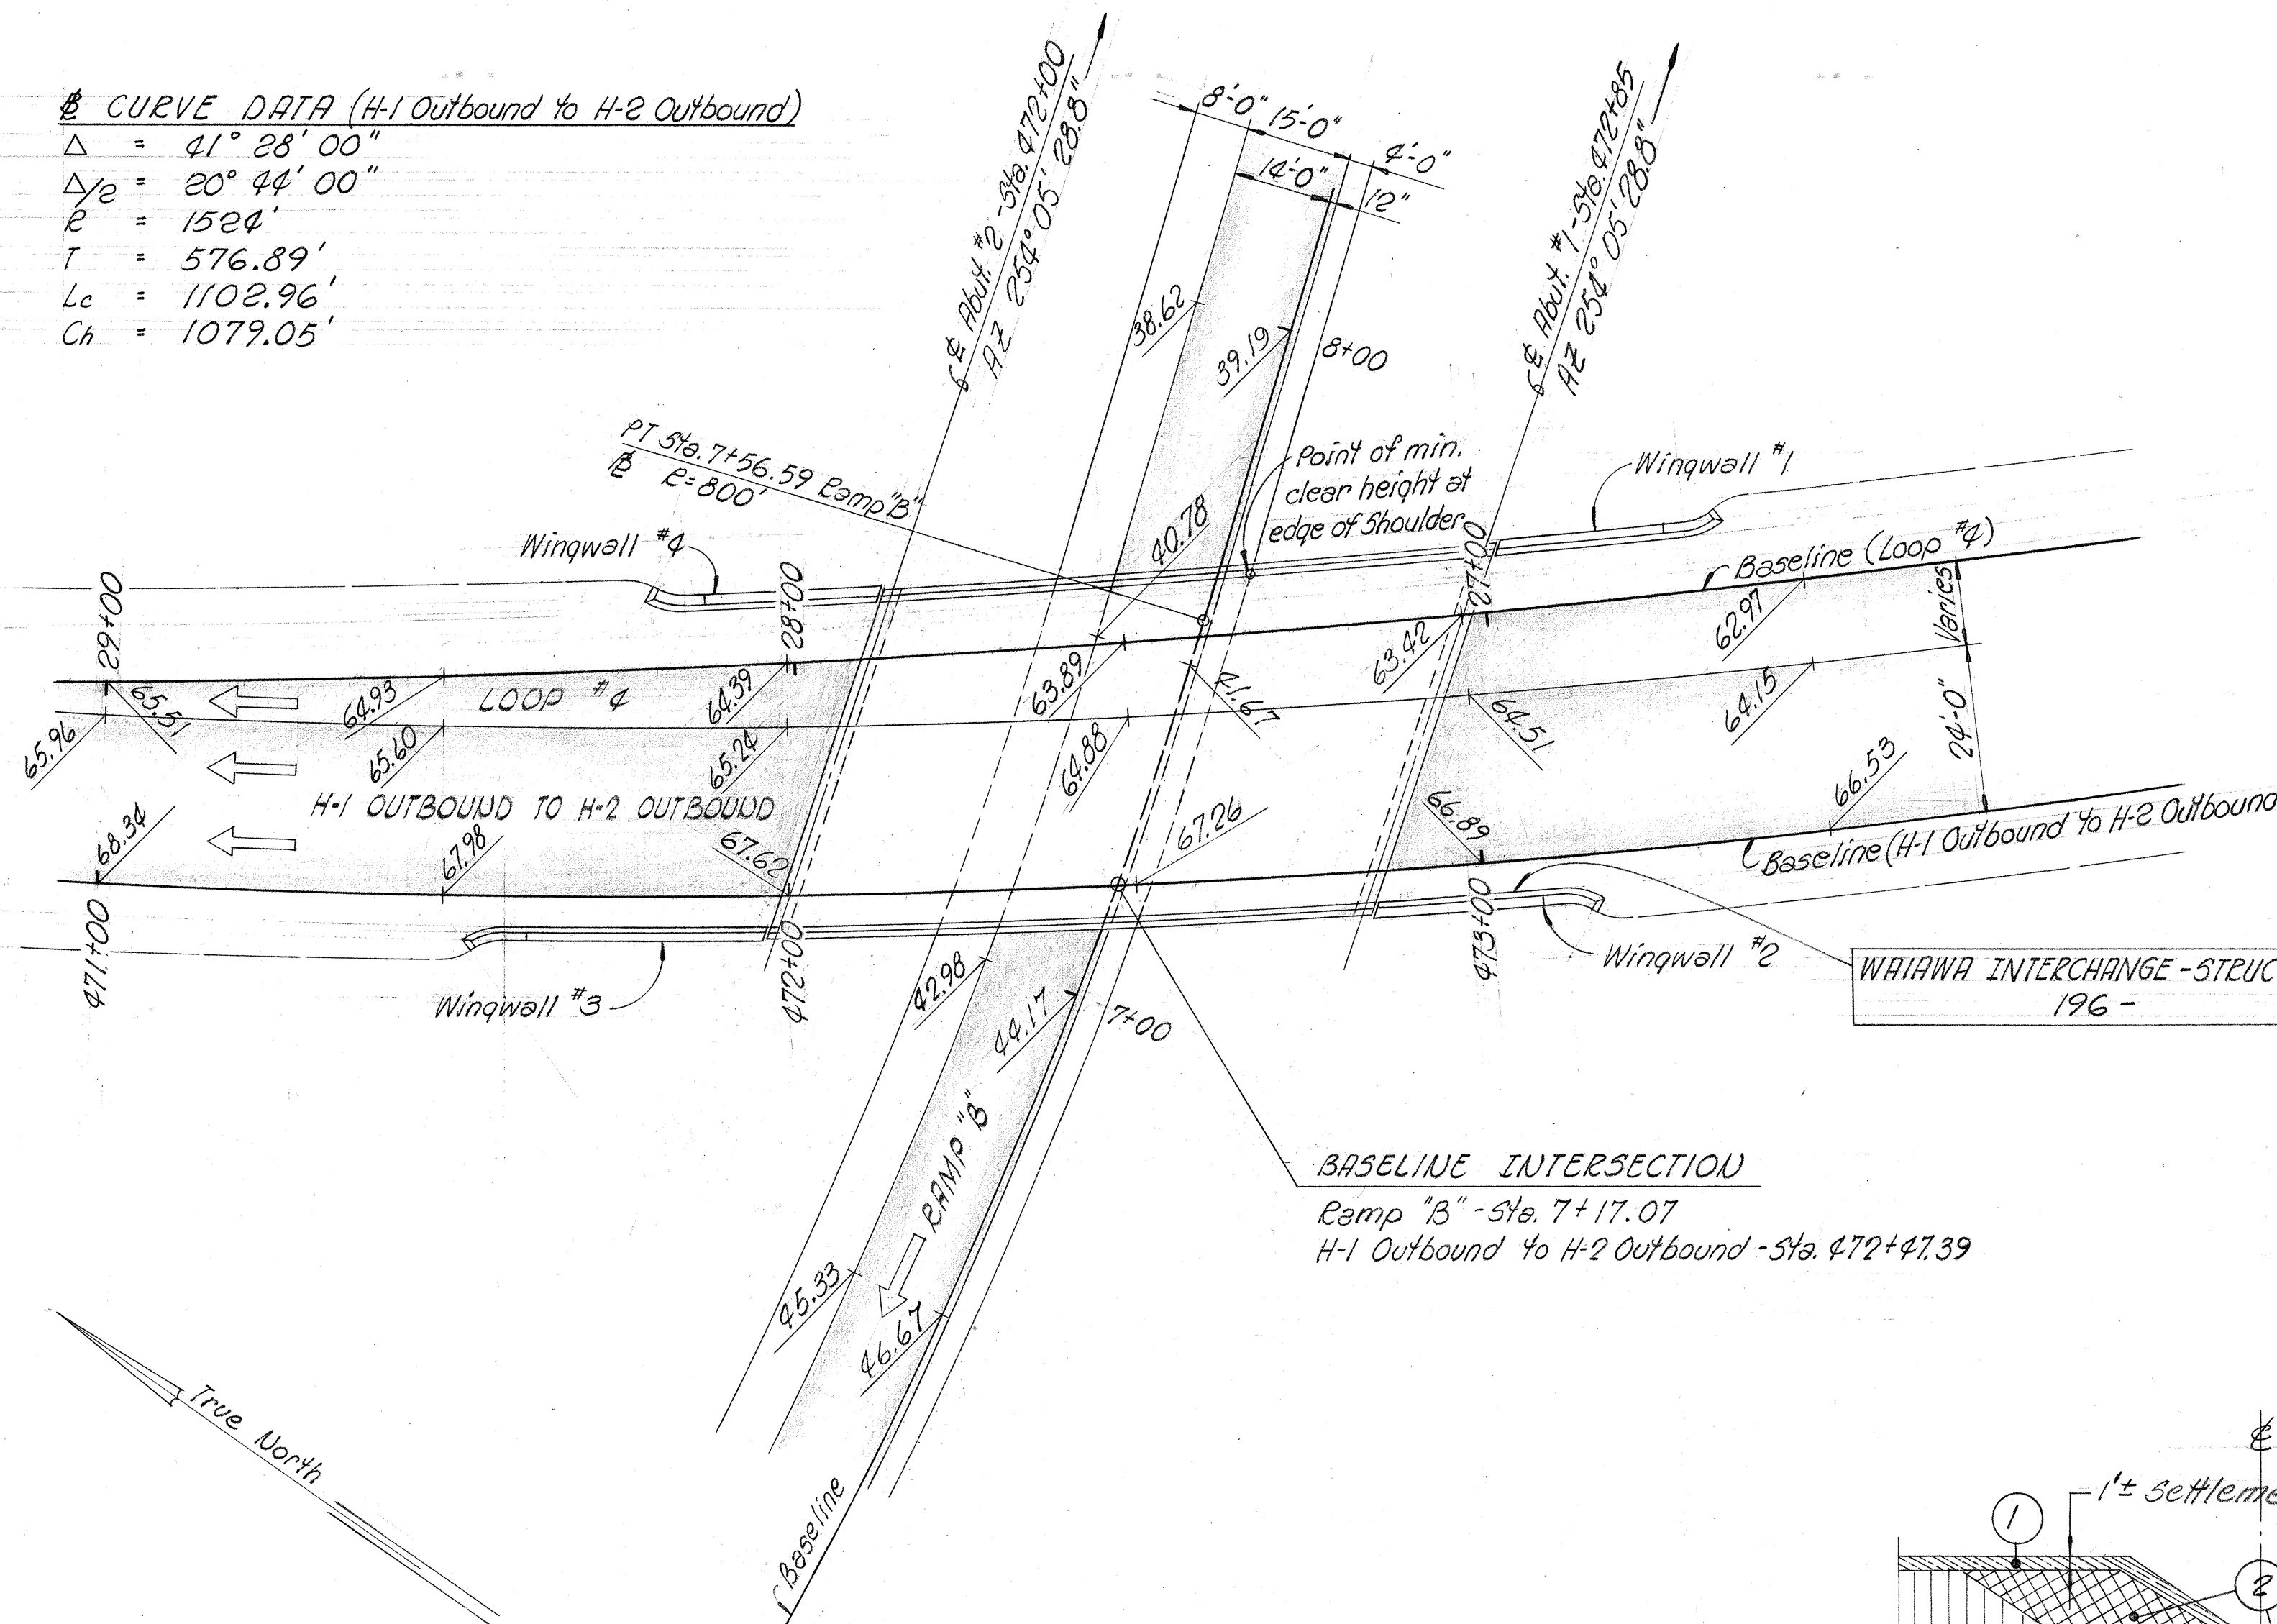


PLAN
 Scale = 1" = 20'-0"

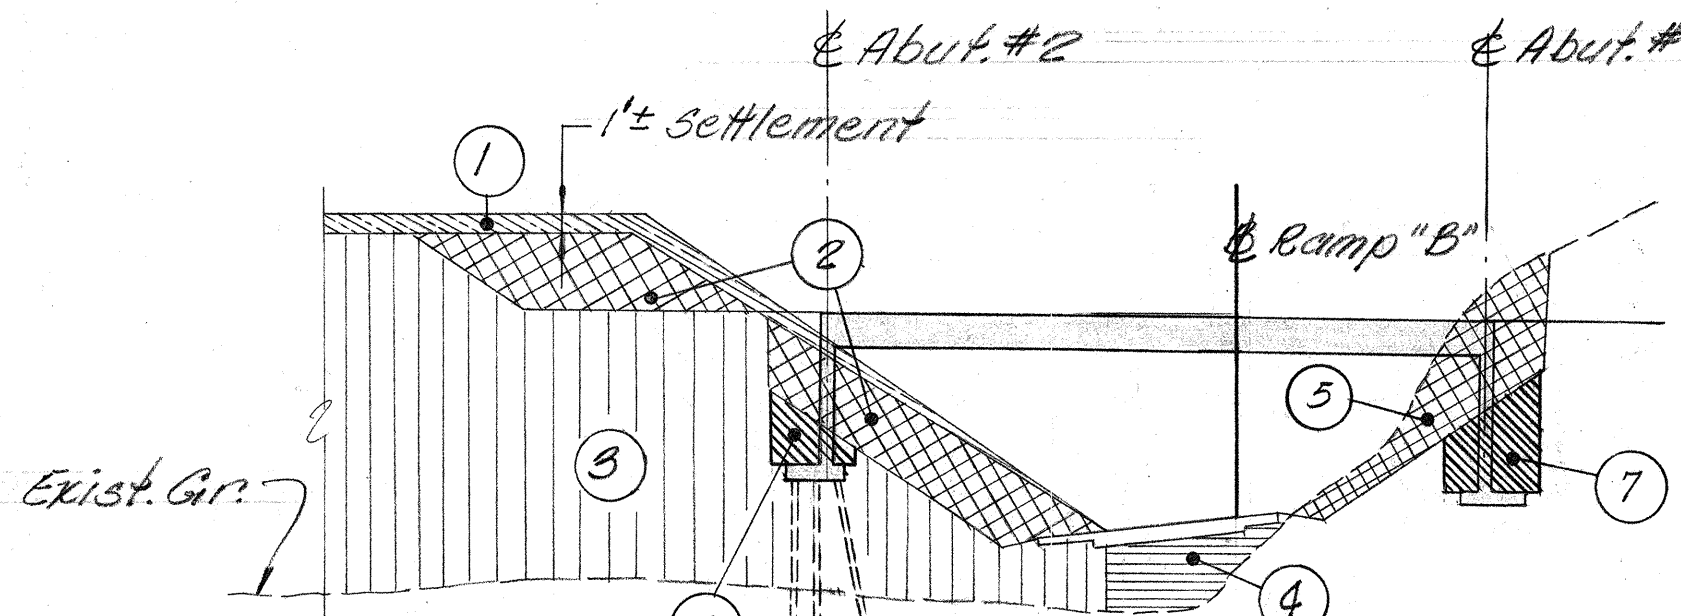

PRELOADING & STRUCTURAL EXCAVATION DIAGRAM



- ①, ② & ③ Emb. for H-1 Outb. to H-2 Outb. (By Roadway Contractor)
- ② & ⑤ Exc. for Ramp "B" (By Roadway Contractor)
- ④ Emb. for Ramp "B" (By Roadway Contractor)
- ⑥ & ⑦ Structural Exc. for Abut. Ftgs.

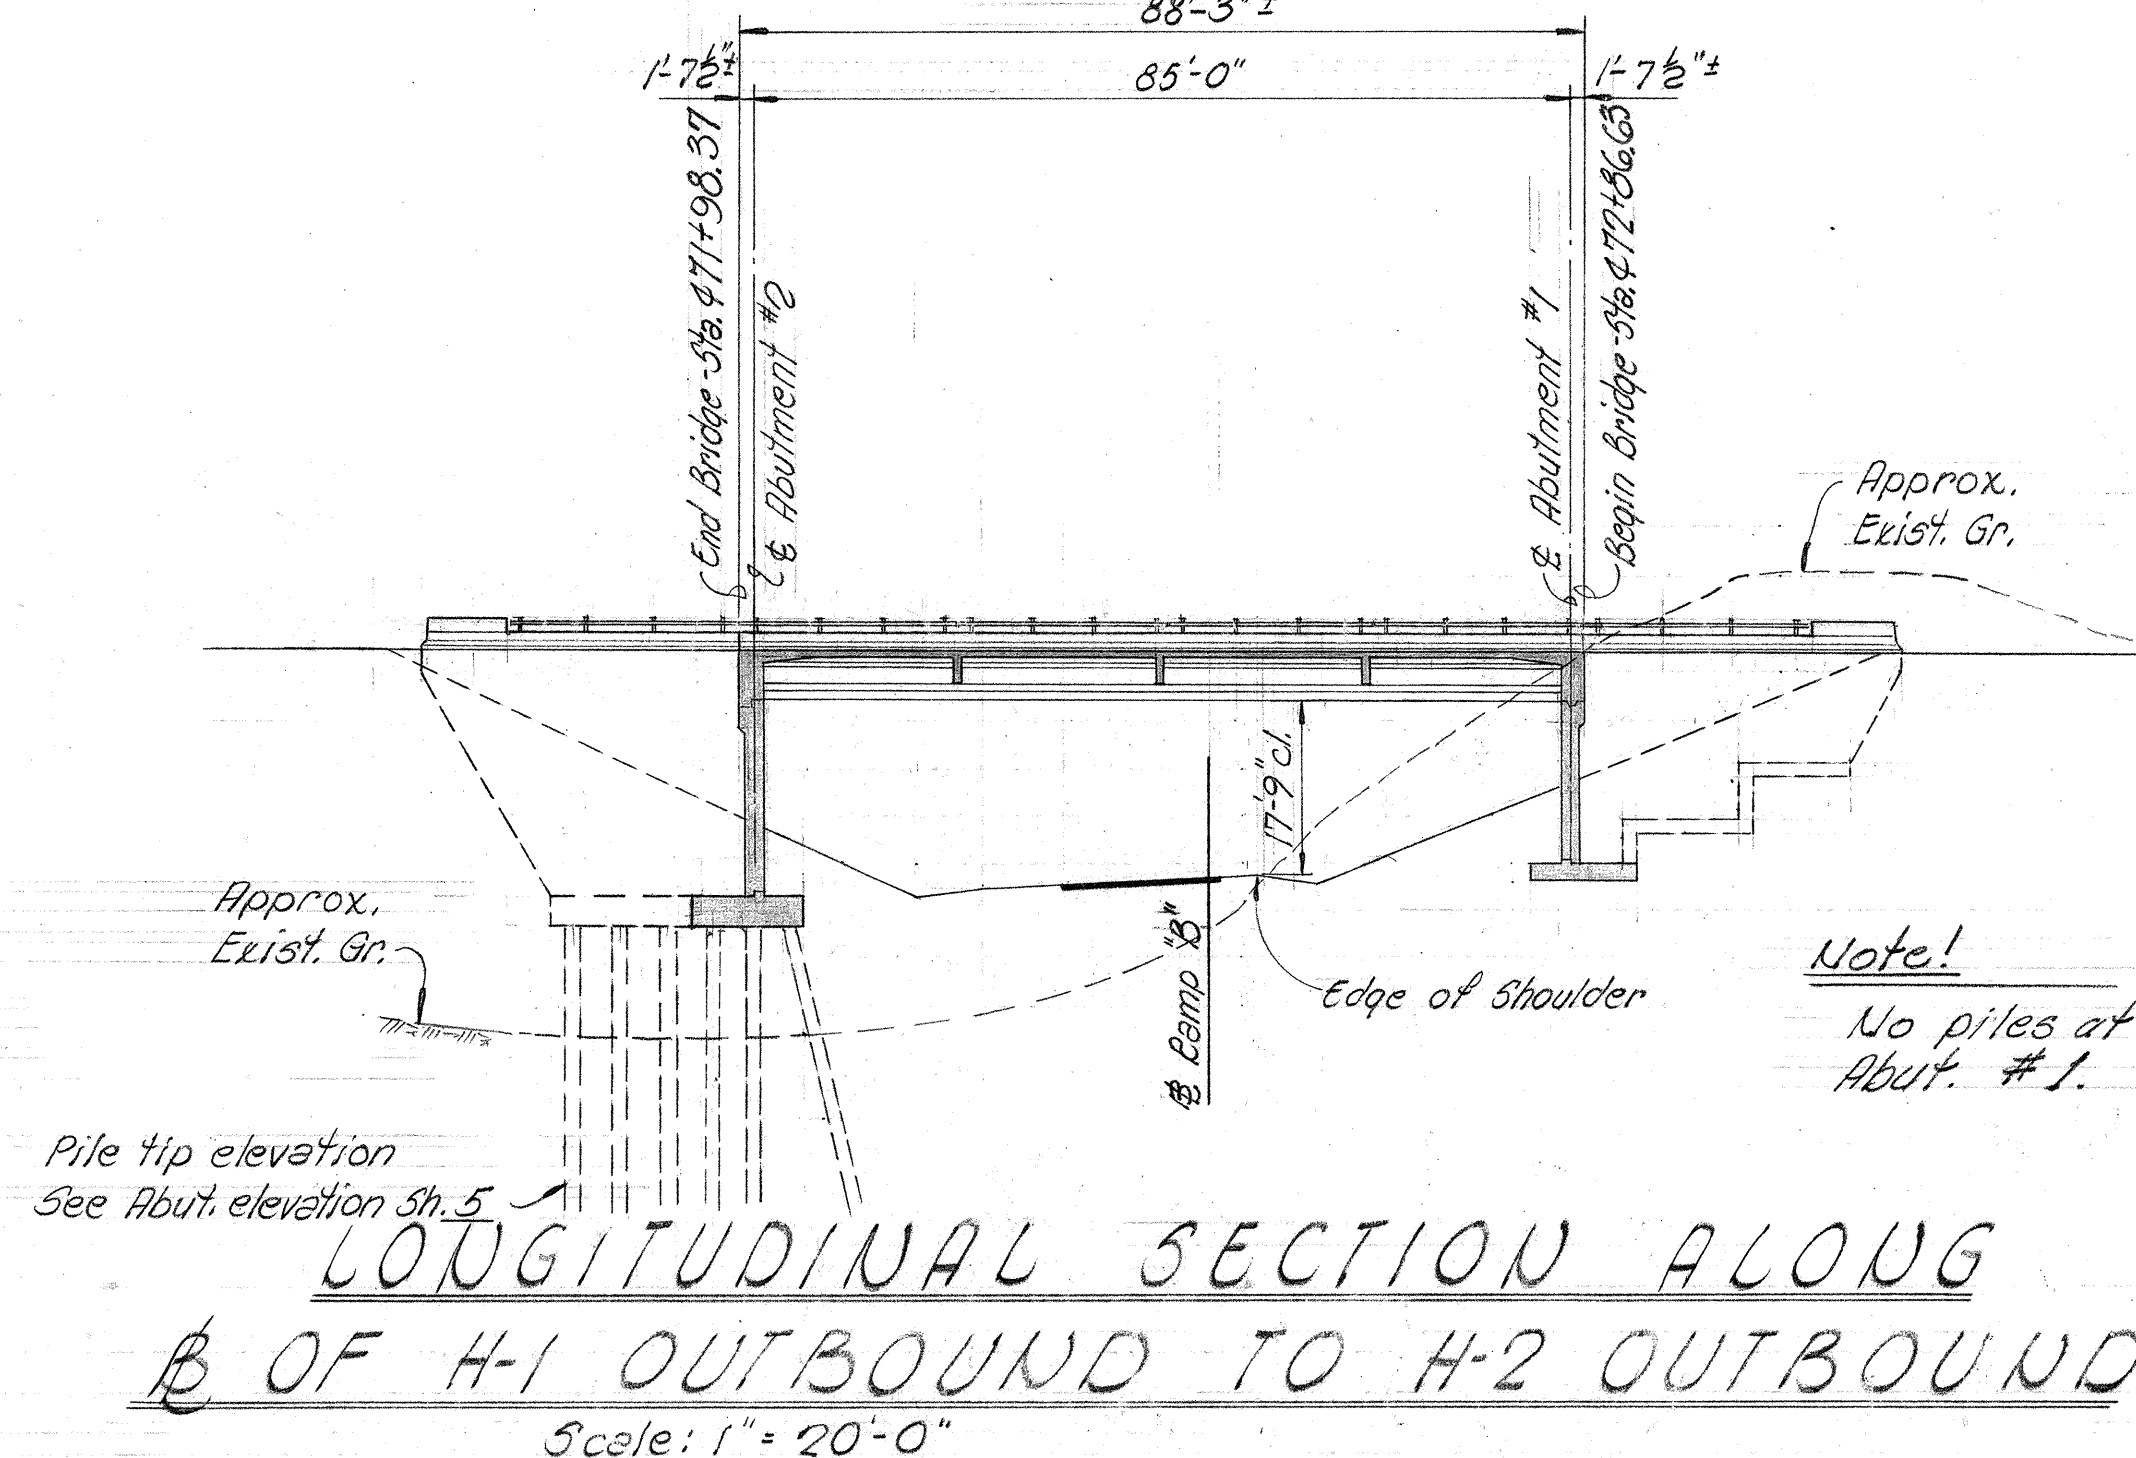

LONGITUDINAL SECTION ALONG
 C/L OF H-1 OUTBOUND TO H-2 OUTBOUND
 Scale: 1" = 20'-0"

BRIDGE QUANTITY ESTIMATE			
ITEM NO.	ITEM	UNIT	QUANTITY
14.60	Structural Excavation for Bridge	C.Y.	1,242
46.060	Concrete in Bridge	L.S.	441 C.Y.
46.061	Concrete in Bridge Footings	L.S.	195 C.Y.
46P.14	Prestressed Concrete Girders Type IV	L.F.	680 L.F.
48.60	Reinforcing Steel in Bridge	L.S.	84,700 LBS
51.62	Furnishing Type I Prestressed Concrete Piles	L.F.	2,240
51.63	Driving Type I Prestressed Concrete Piles	L.F.	2130
52.01	Filter Material for Structure	C.Y.	112
55.10	Metal Bridge Rail	L.F.	319
55.50	Concrete Bridge Parapet, including End Posts	L.F.	319

SHIMAZU SHIMABUKURO & FUKUDA, INC.
 Consulting Structural Engineers
 1210 Ward Ave. Honolulu, Hawaii 96814

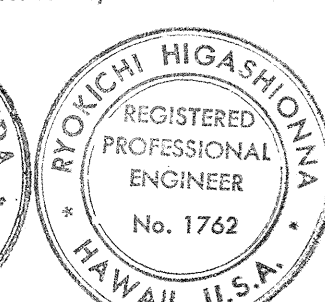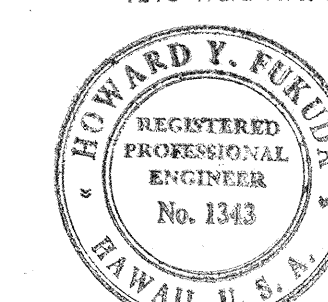

This work was prepared by me or under my supervision.

Howard Y. Fukuda



STATE OF HAWAII
 DEPARTMENT OF TRANSPORTATION
 HIGHWAYS DIVISION

STRUCTURE No. 6
 LAYOUT PLAN

WAIKAWA INTERCHANGE
 F.A.I. Proj. No. I-HI-1(63)-8




Scale: As shown Date: OCT. 1968
 SHEET No. 1 OF 9 SHEETS

FED. ROAD DIST. NO.	STATE	FED. AID PROJ. NO.	FISCAL YEAR	SHEET NO.	TOTAL SHEETS
HAWAII	HAW.	I-HI-1(62)B	1968	92	144

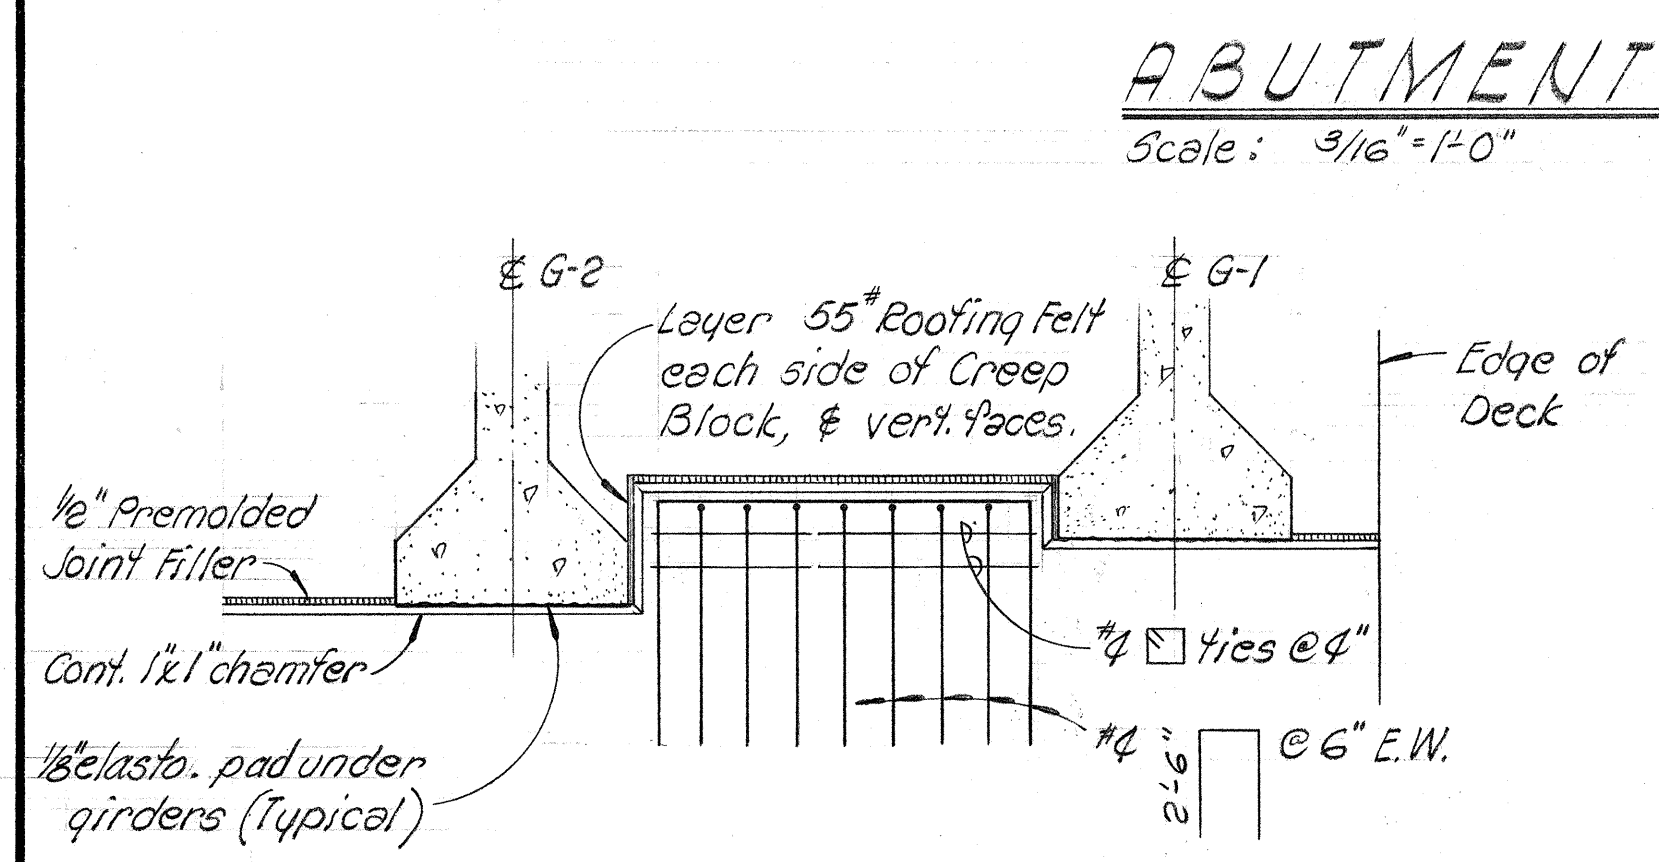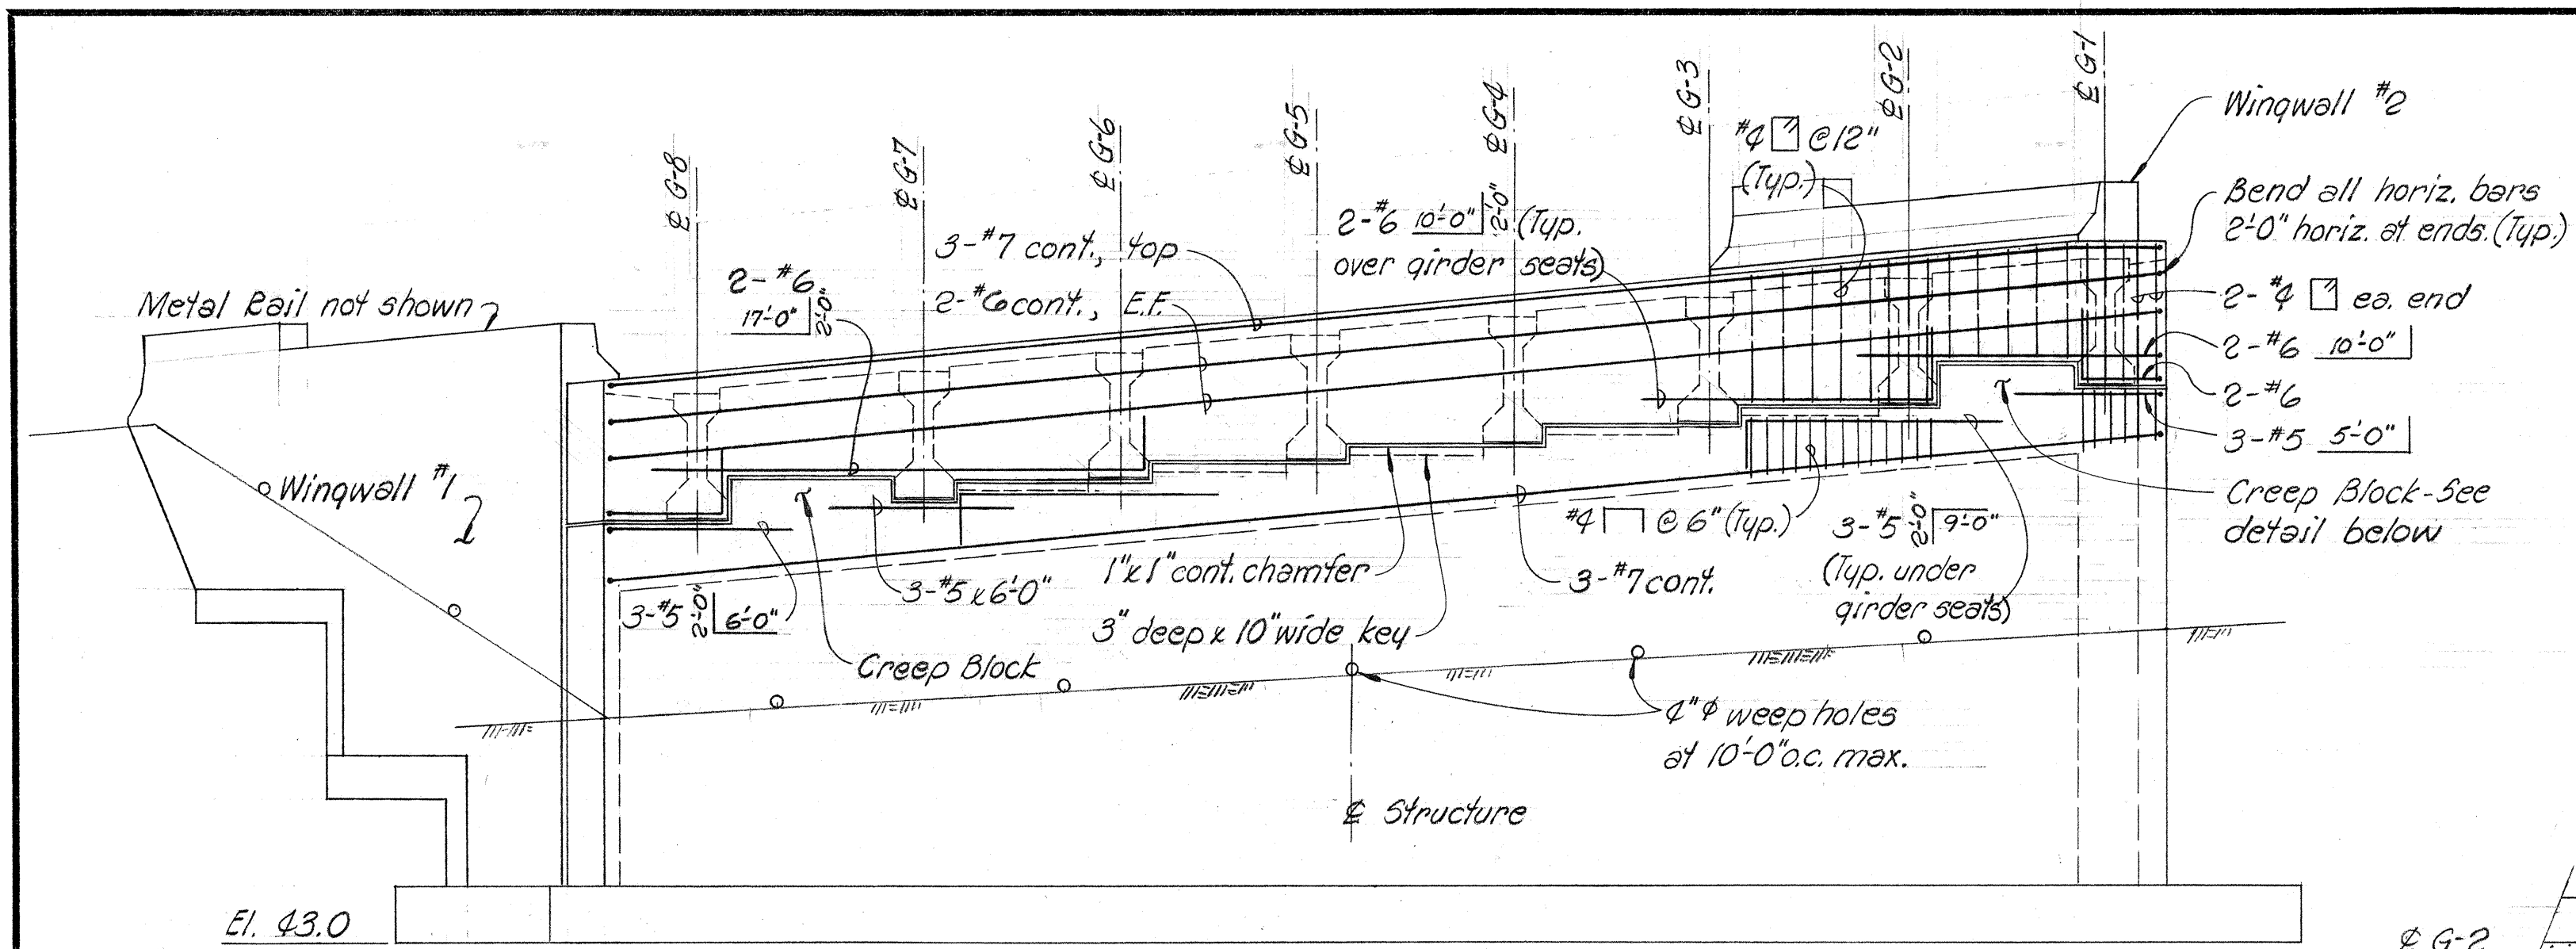


ABUTMENT #1 ELEVATIONS		
Girder	Top of Deck	Bot of Girders
1	67.38	62.10
2	66.73	61.45
3	66.08	60.81
4	65.44	60.16
5	64.79	59.52
6	64.15	58.87
7	63.50	58.22
8	62.75	57.48

NOTE: Elevations given are along E of Abut.

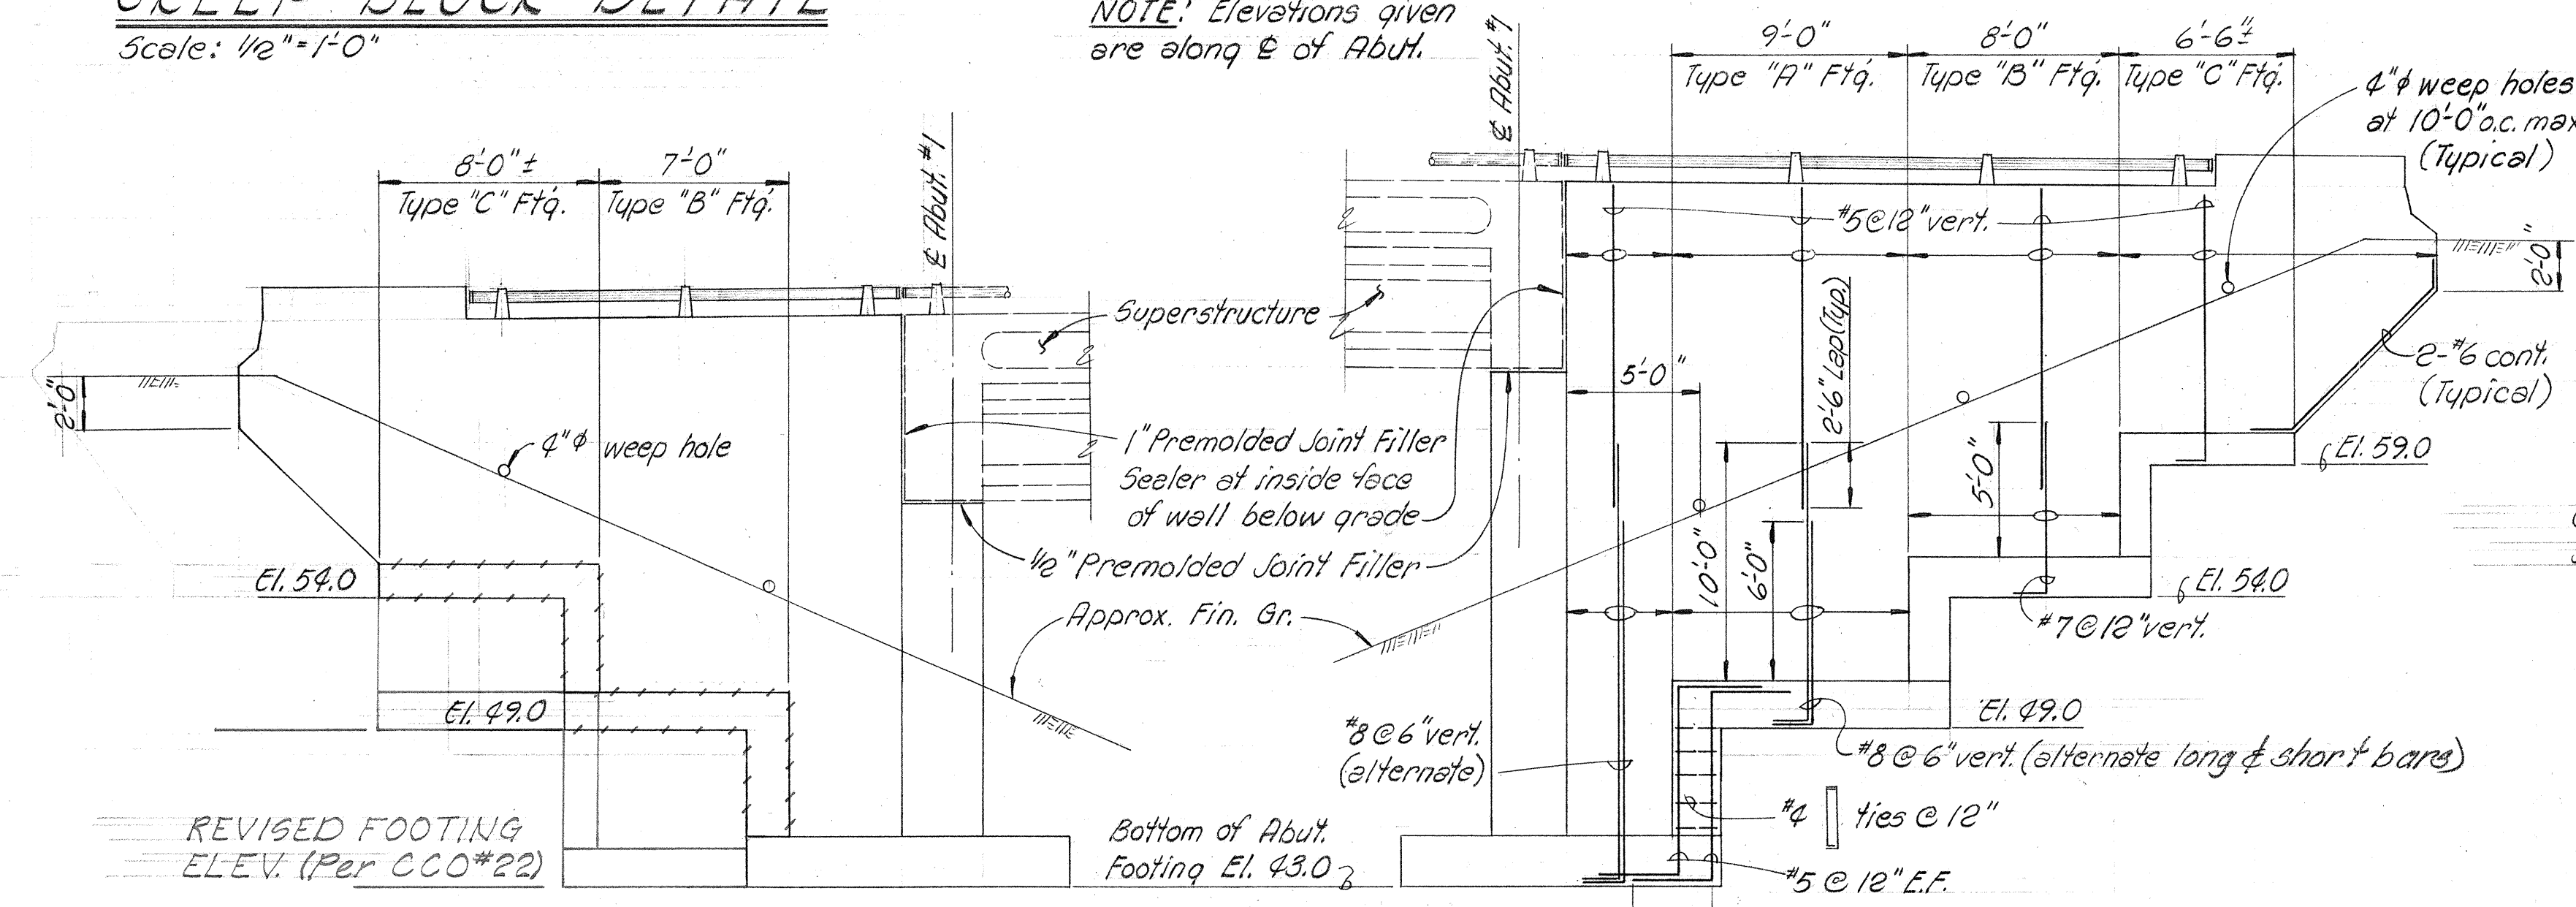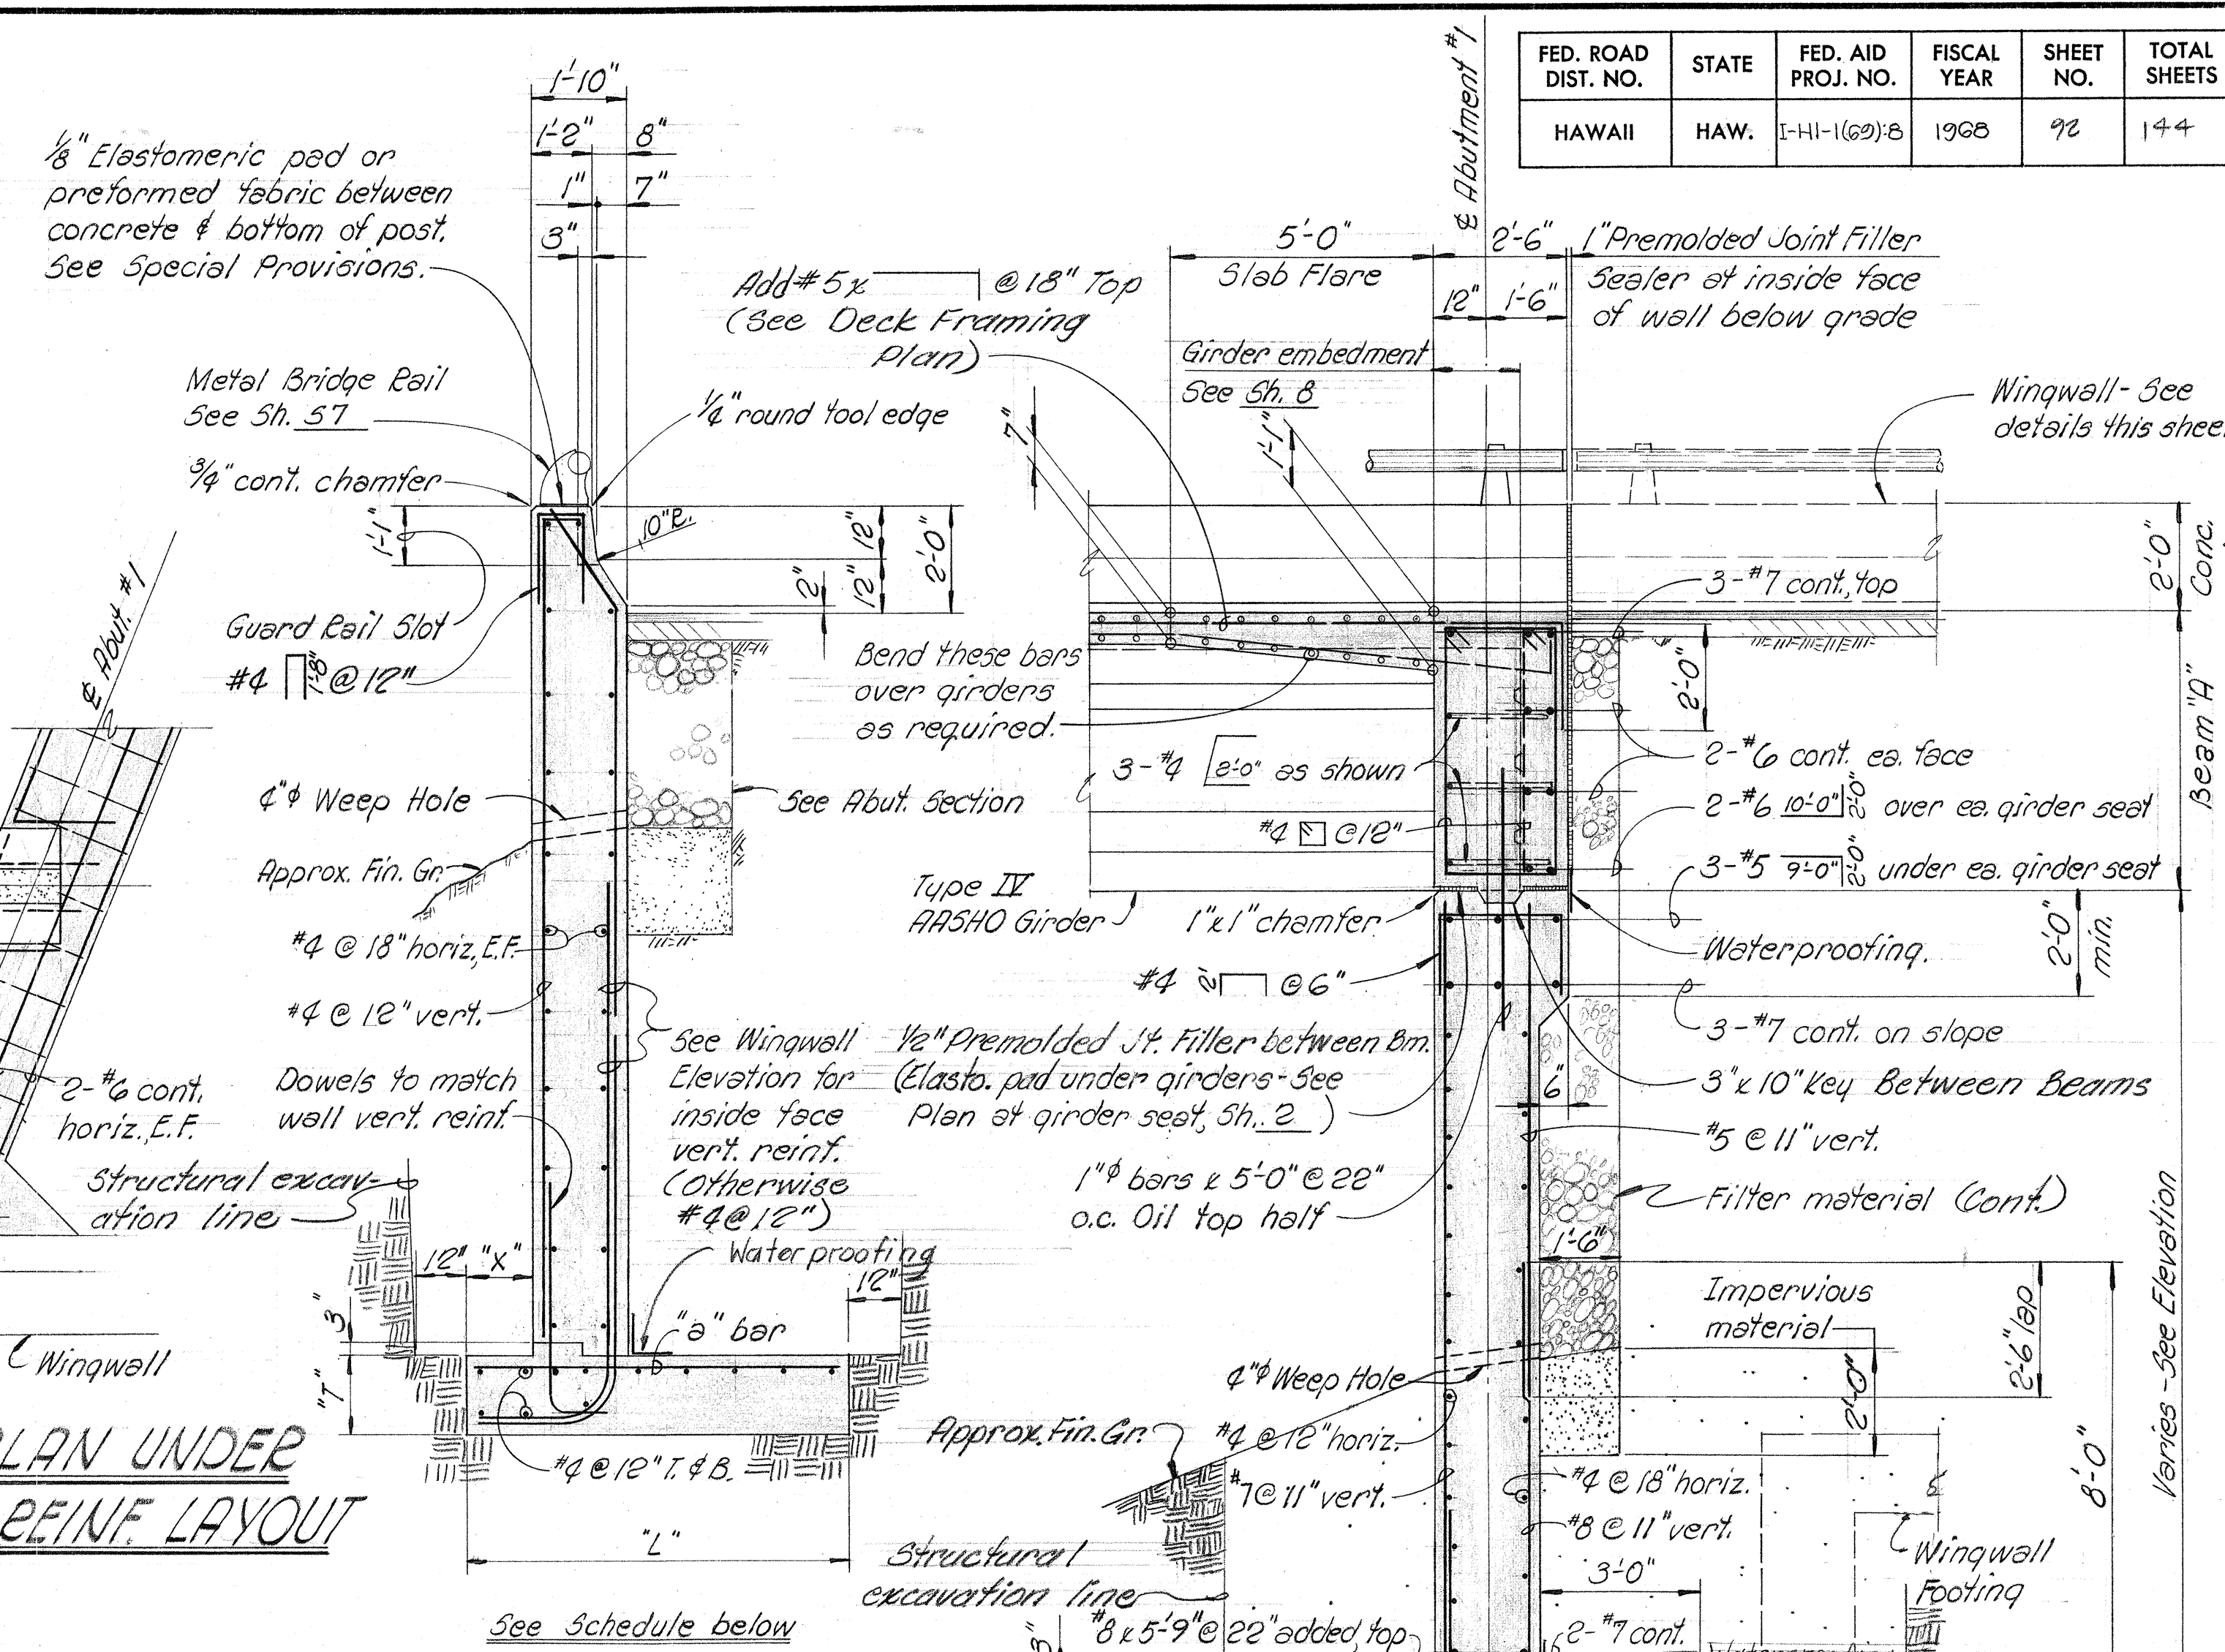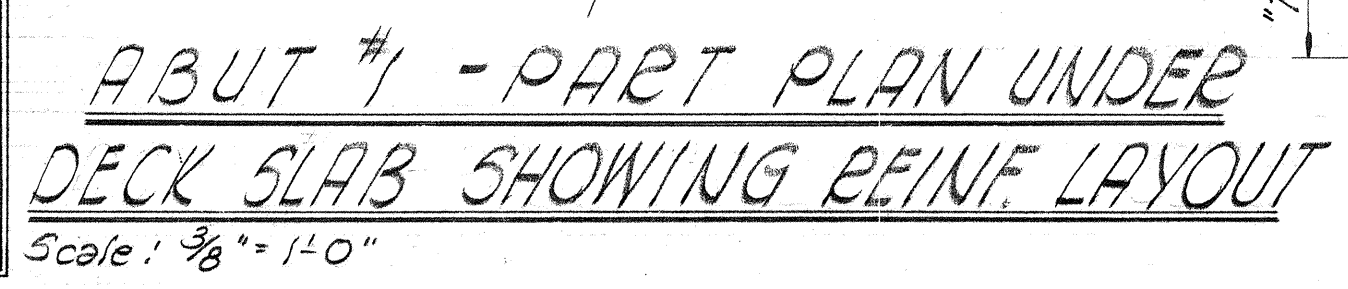

NOTE: Details shown for Wingwall #2 applies to Wingwall #1 unless otherwise shown. Wall reinf. shown are inside face vert. wall reinf. See Typical Section for balance. For footing details, see schedule & typical wall section.

FOOTING SCHEDULE WINGWALLS #1 & #2			
Type	"A"	"B"	"C"
"X"	2'-0"	1'-0"	1'-0"
"T"	1'-9"	1'-6"	1'-2"
"L"	9'-3"	6'-9"	4'-6"
"a" bar	"7C6"	"6C9#"	"4C11"

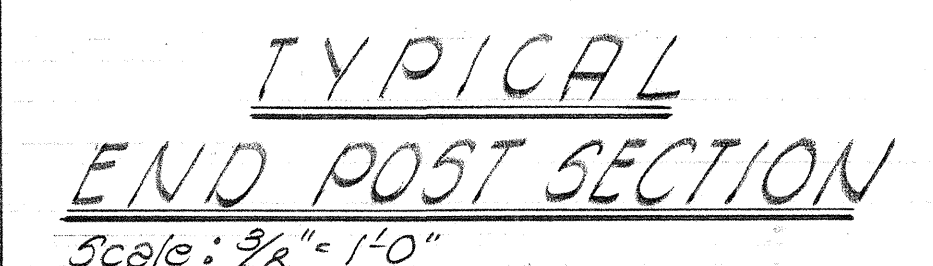

SHIMAZU SHIMABUKURO & FUKUDA, INC.
Consulting Structural Engineers
1210 Ward Ave., Honolulu, Hawaii 96814

HOWARD Y. FUKUDA
REGISTERED PROFESSIONAL ENGINEER
No. 1343
HAWAII, U.S.A.

ICHI HIGASHIONA
REGISTERED PROFESSIONAL ENGINEER
No. 1762
HAWAII, U.S.A.

This work was prepared by me or under my supervision.
Howard Y. Fukuda

STATE OF HAWAII
DEPARTMENT OF TRANSPORTATION
HIGHWAYS DIVISION


STRUCTURE No. 6
ABUTMENT #1 & WINGWALLS #1 & #2
SECTIONS & DETAILS

WAIKAWA INTERCHANGE
F.A.I. Proj. No. I-HI-1(62)B

Scale: As shown Date: OCT. 1968
SHEET No. 3 OF 9 SHEETS

DATE
DRAWN BY
CHECKED BY
DESIGNED BY
NOTED BY
ORIGINAL PLAN
NOTE BOOK
No.

ORIGINAL PLAN	SURVEY FLAILED BY.....	DATE.....
	DRAWN BY.....	
NOTE BOOK	TRACED BY.....	
	DESIGNED BY.....	
	QUANTITIES BY.....	
	CHECKED BY.....	
No.....		

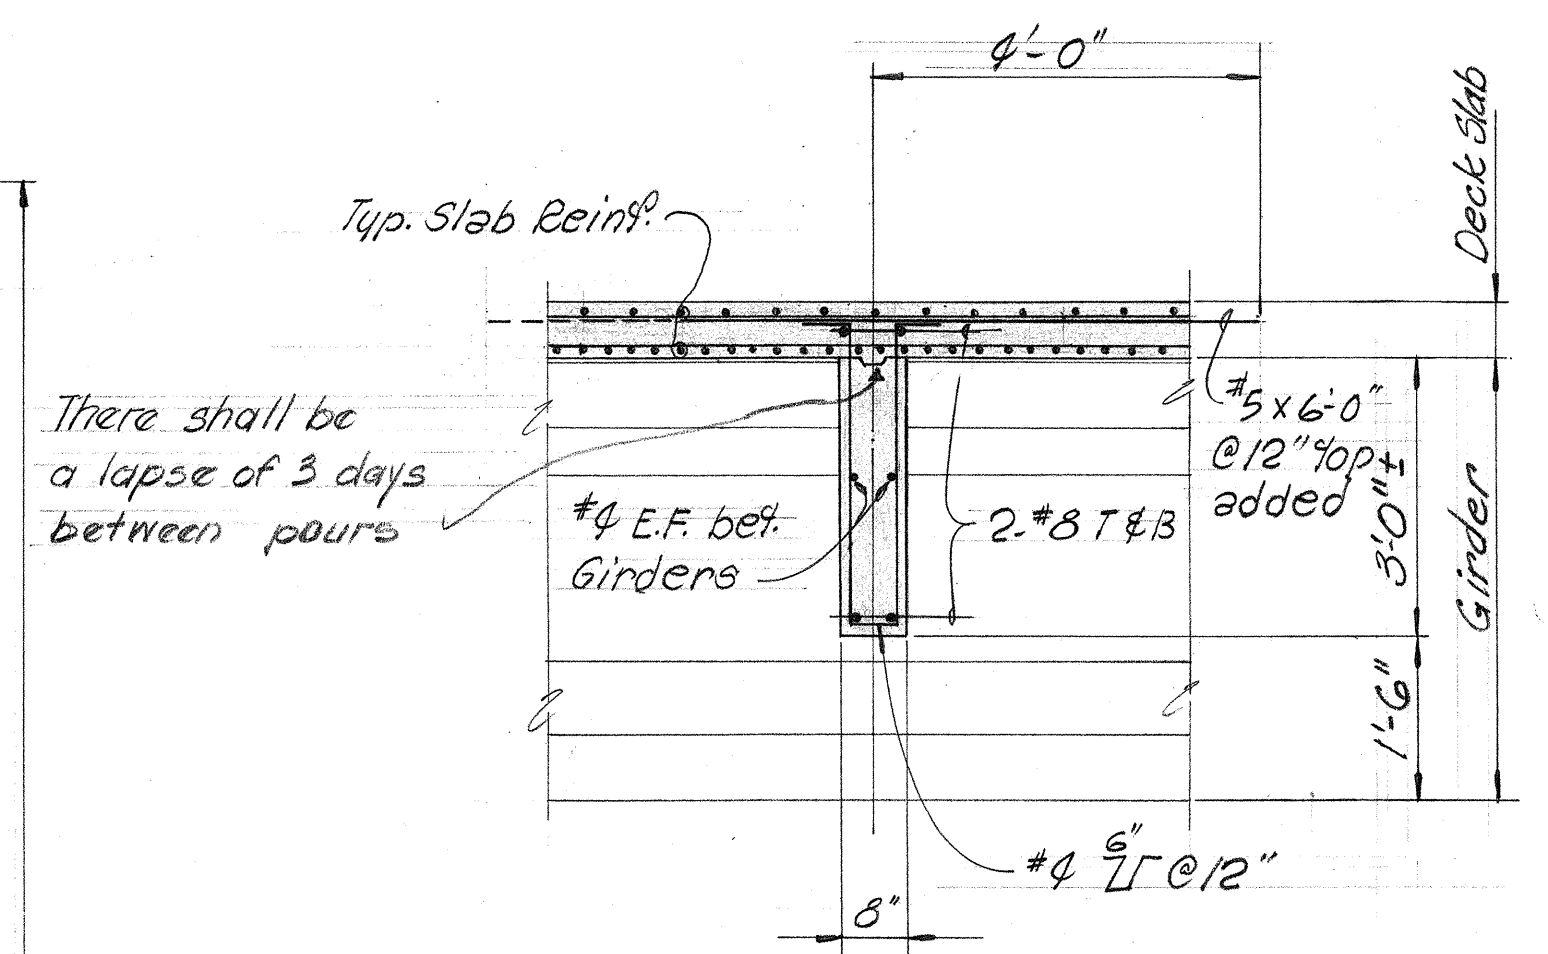

BEAM "B"
TYPICAL SECTION
Scale: 1/2" = 1'-0"

Scale: $3/16" = 1' - 0"$

Note! Pour Deck & Beam "A" as one pour.




This work was prepared by me or under my supervision.

Howard G. Fukuda

Scale : As shown Date: OCT. 1968


SHEET No. 6 OF 9 SHEETS

FED. ROAD DIST. NO.	STATE	FED. AID PROJ. NO.	FISCAL YEAR	SHEET NO.	TOTAL SHEETS
HAWAII	HAW.	I-HI-1(69)-8	1968	76	144

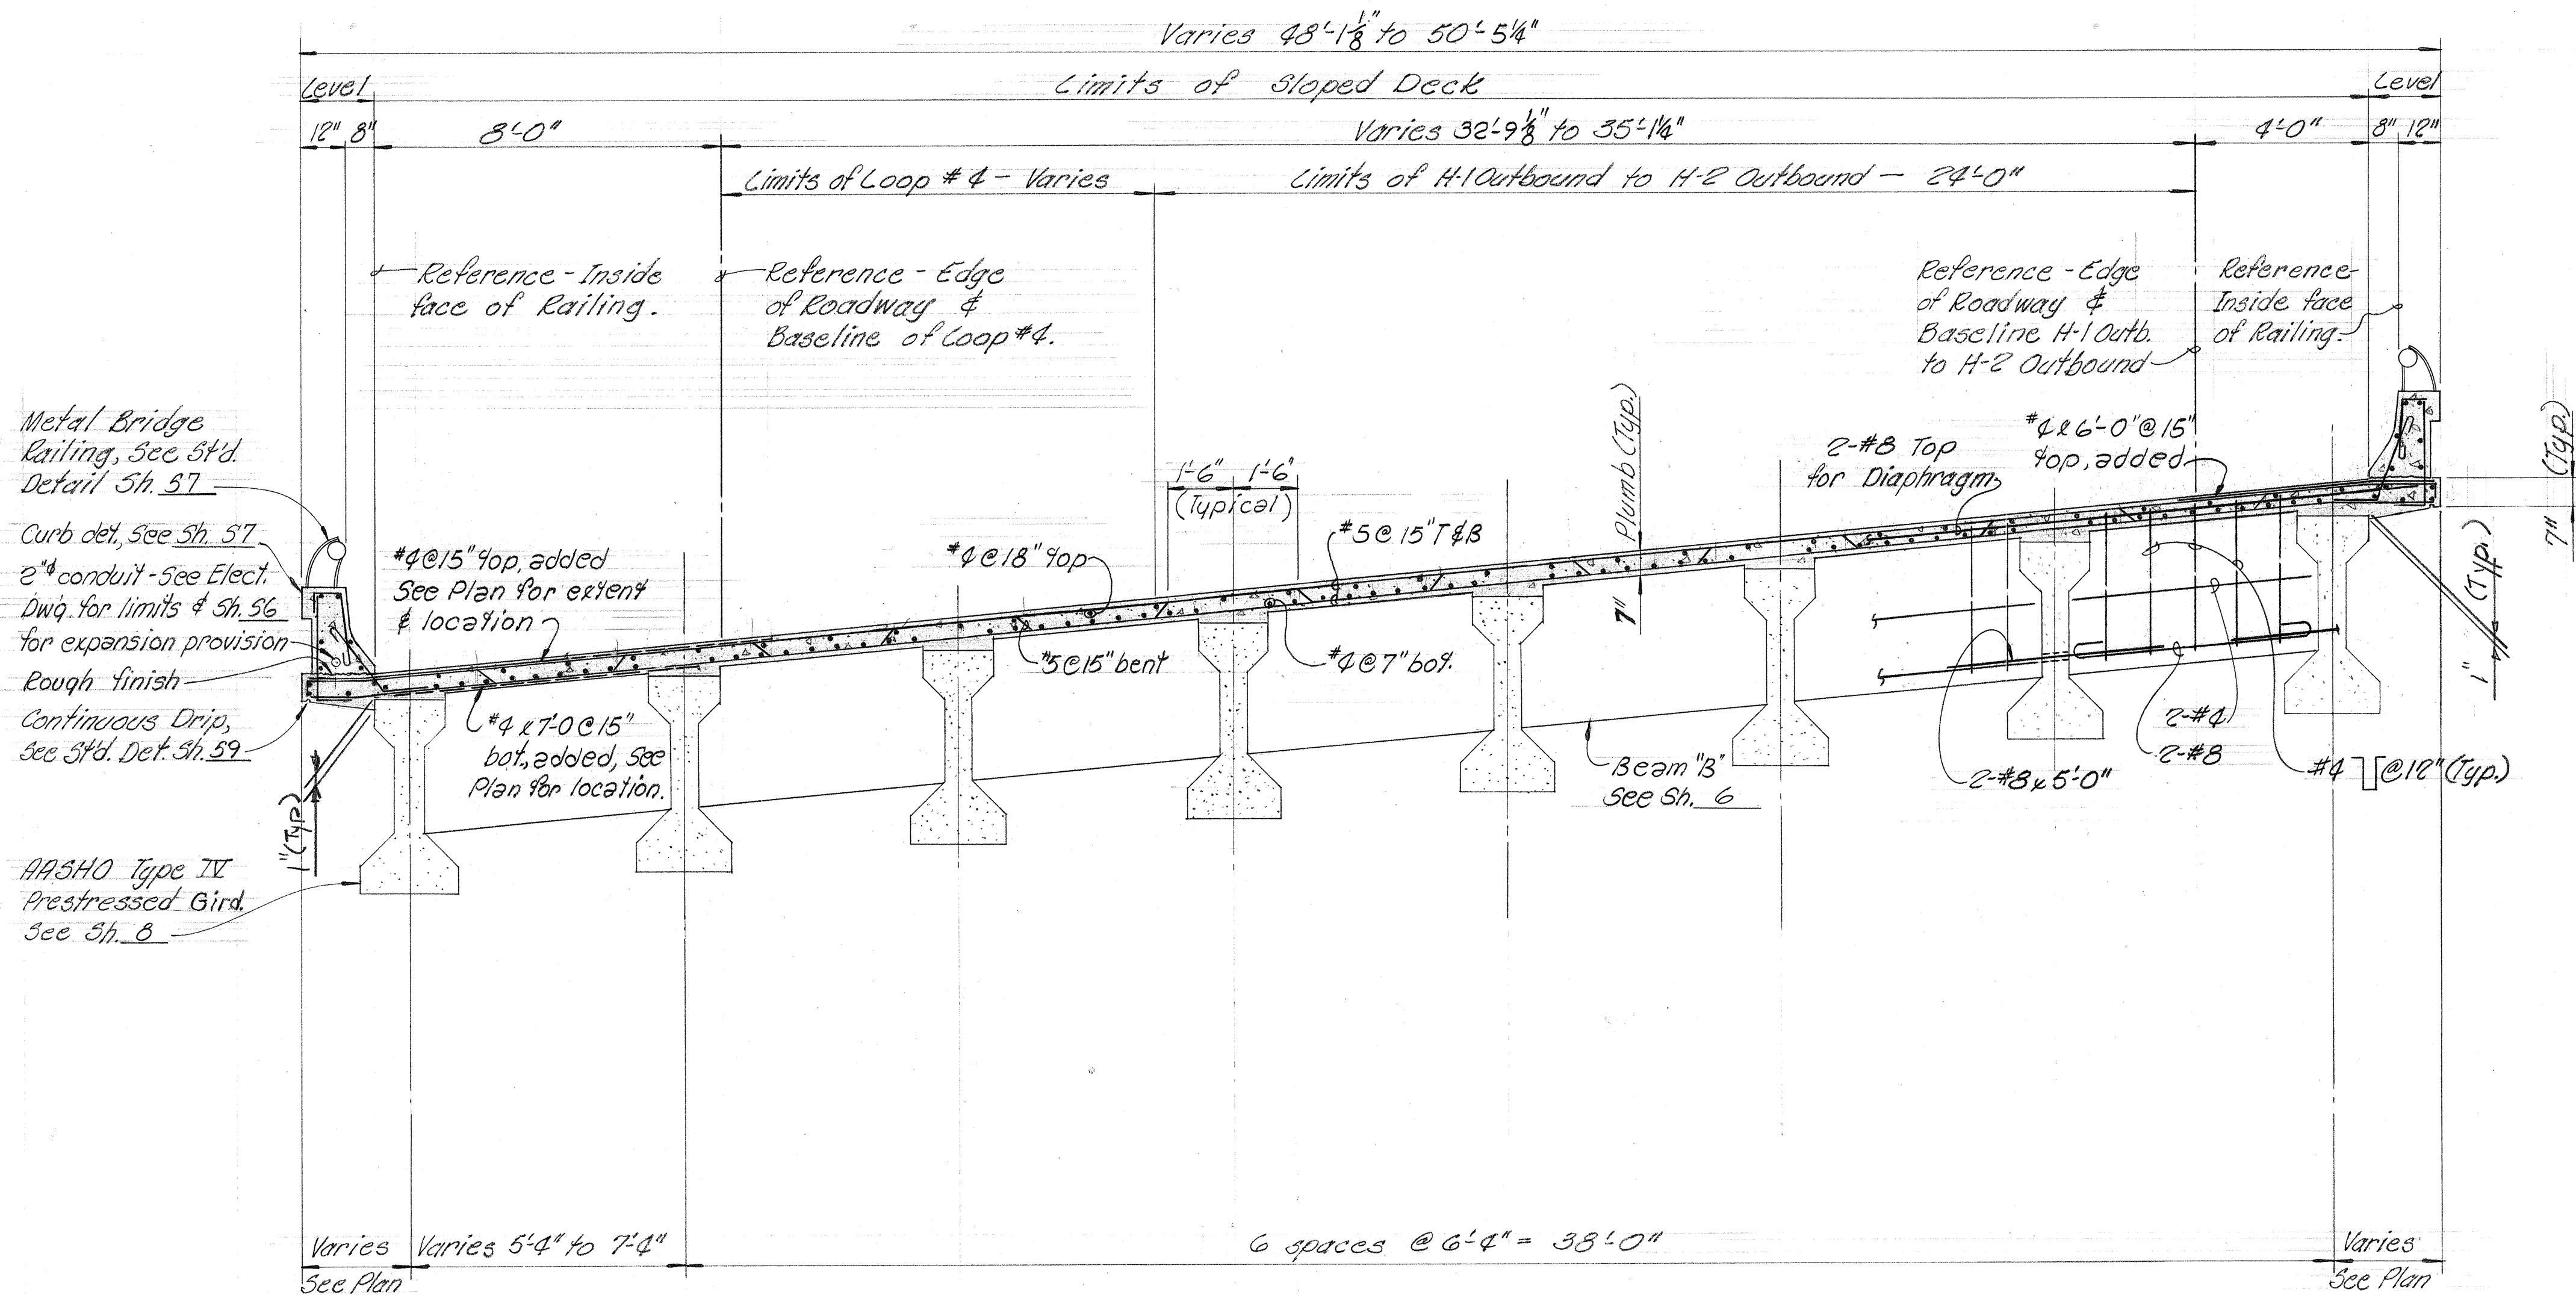

TYPICAL NORMAL DECK SECTION


3/8" = 1'-0"

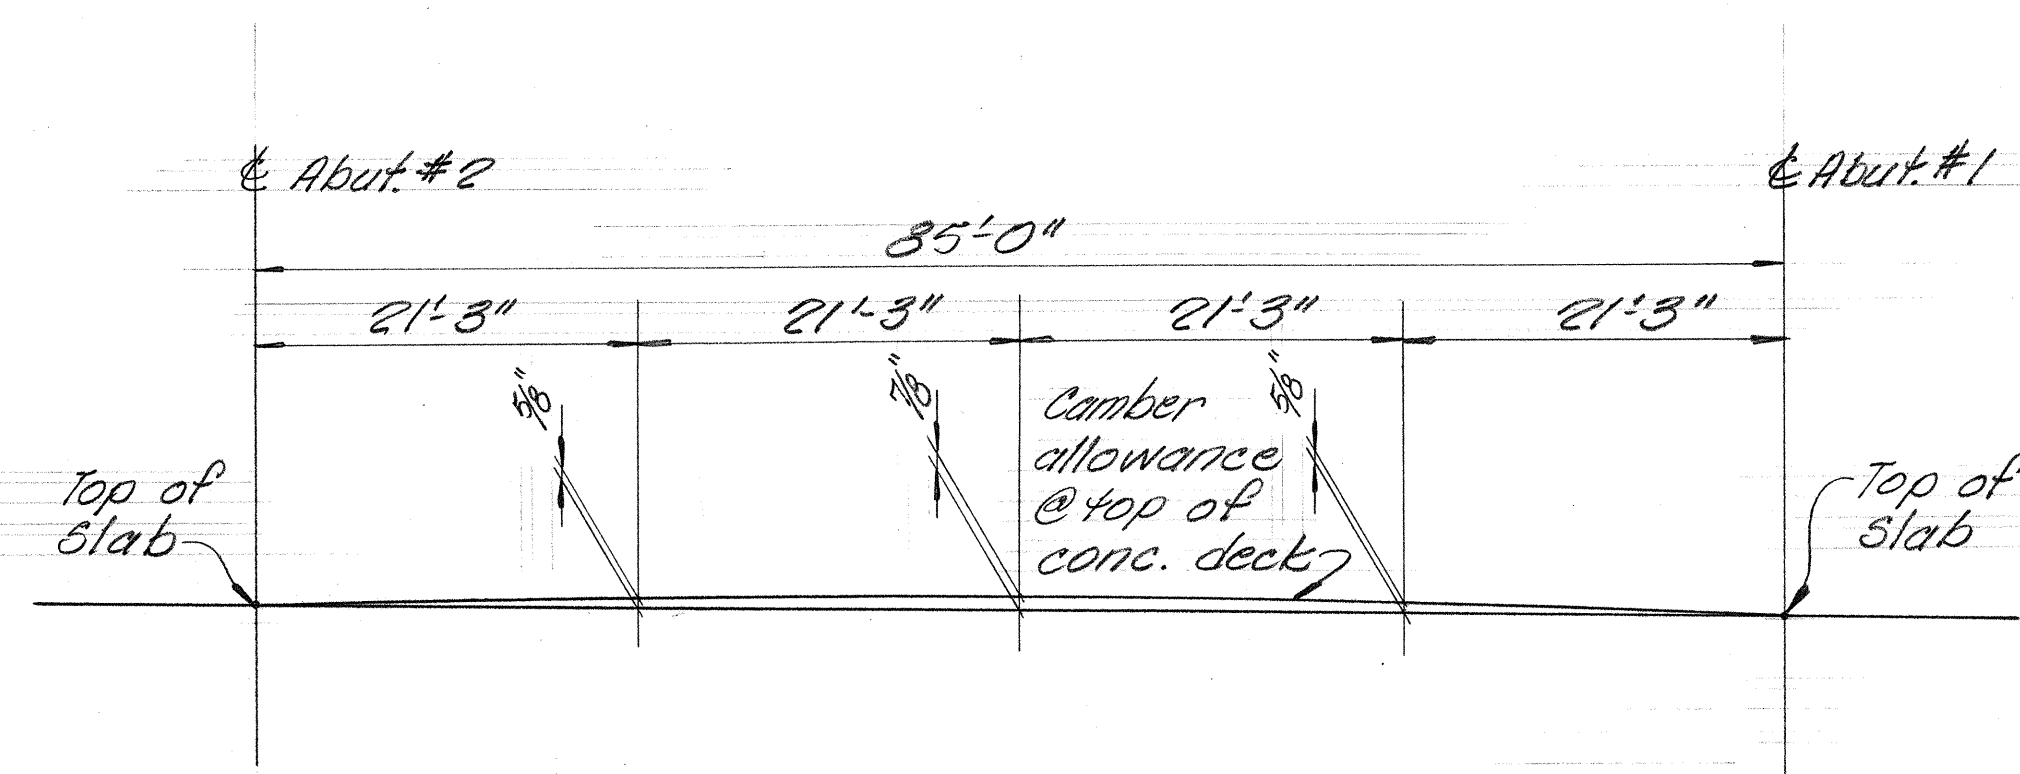

CAMBER DIAGRAM FOR TOP OF SLAB ALONG AASHTO GIRDERS

Note!

Top of concrete deck directly above girder shall be cambered according to the diagram shown above to allow for girder deflection due to wet concrete & formwork.
Note that the girder shall be supported at the abutments only and no shoring is permitted anywhere else.

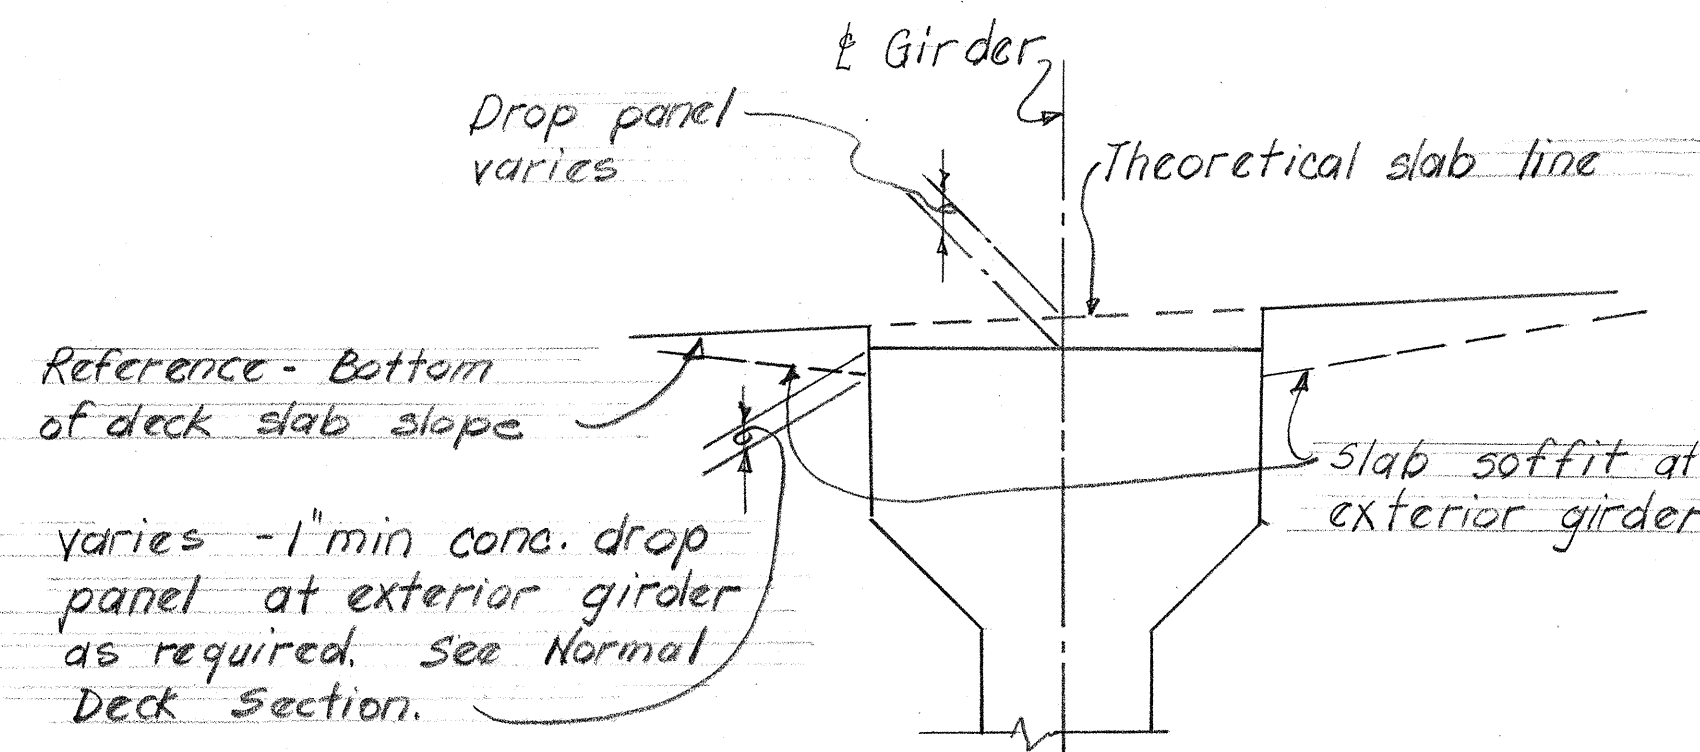

PRESTRESSED GIRDER DROP PANEL DETAIL

(NOT TO SCALE)


BUNDLING OF PRESTRESSING REINFORCEMENT

ARRANGEMENT AND CLEARANCE FOR POST TENSIONED UNITS



1. Horizontal clearance between units equals 2" min.
2. Units may be bundled vertically in groups of 3 max.
3. Vertical clearance between bundled units equal 3" min.
4. Approval of the Engineer is required for deviation.

ARRANGEMENT AND CLEARANCE FOR PRETENSIONED STRANDS

1. Strands may be bundled in groups as shown or in groups consisting of a maximum of 6 strands, and separated at the ends.
2. The minimum distance "S" between groups or individual strands is 2" for 1/2" strands.
3. "S" is measured between centers of adjacent strands.
4. Approval of the Engineer is required for deviation.

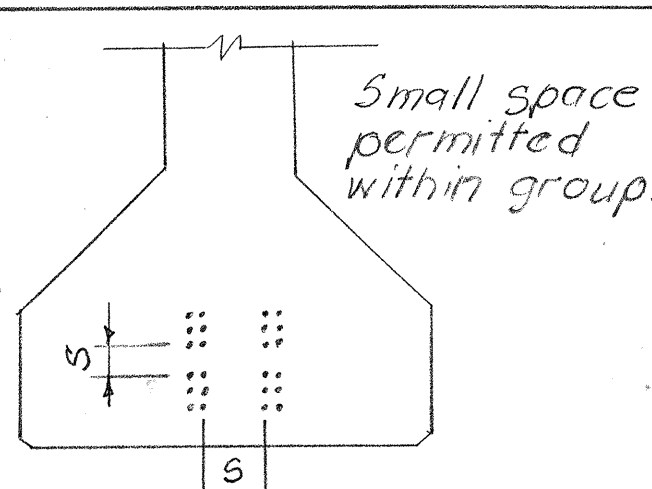

SHIMAZU SHIMABUKURO & FUKUDA, INC.
Consulting Structural Engineers
1210 Ward Ave. Honolulu, Hawaii 96814

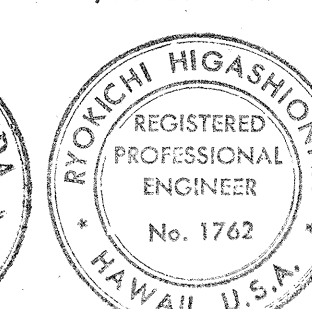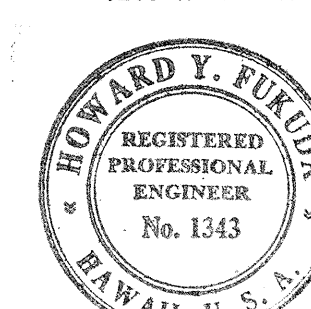

This work was prepared by me or under my supervision.

Howard Y. Fukuda

STATE OF HAWAII
DEPARTMENT OF TRANSPORTATION
HIGHWAYS DIVISION


STRUCTURE NO. 6

TYPICAL DECK SECTION


WAIKAWA INTERCHANGE
F.A.I. Proj. No. I-HI-1(69)-8

Scale: As shown Date: OCT. 1968

SHEET No. 7 OF 9 SHEETS

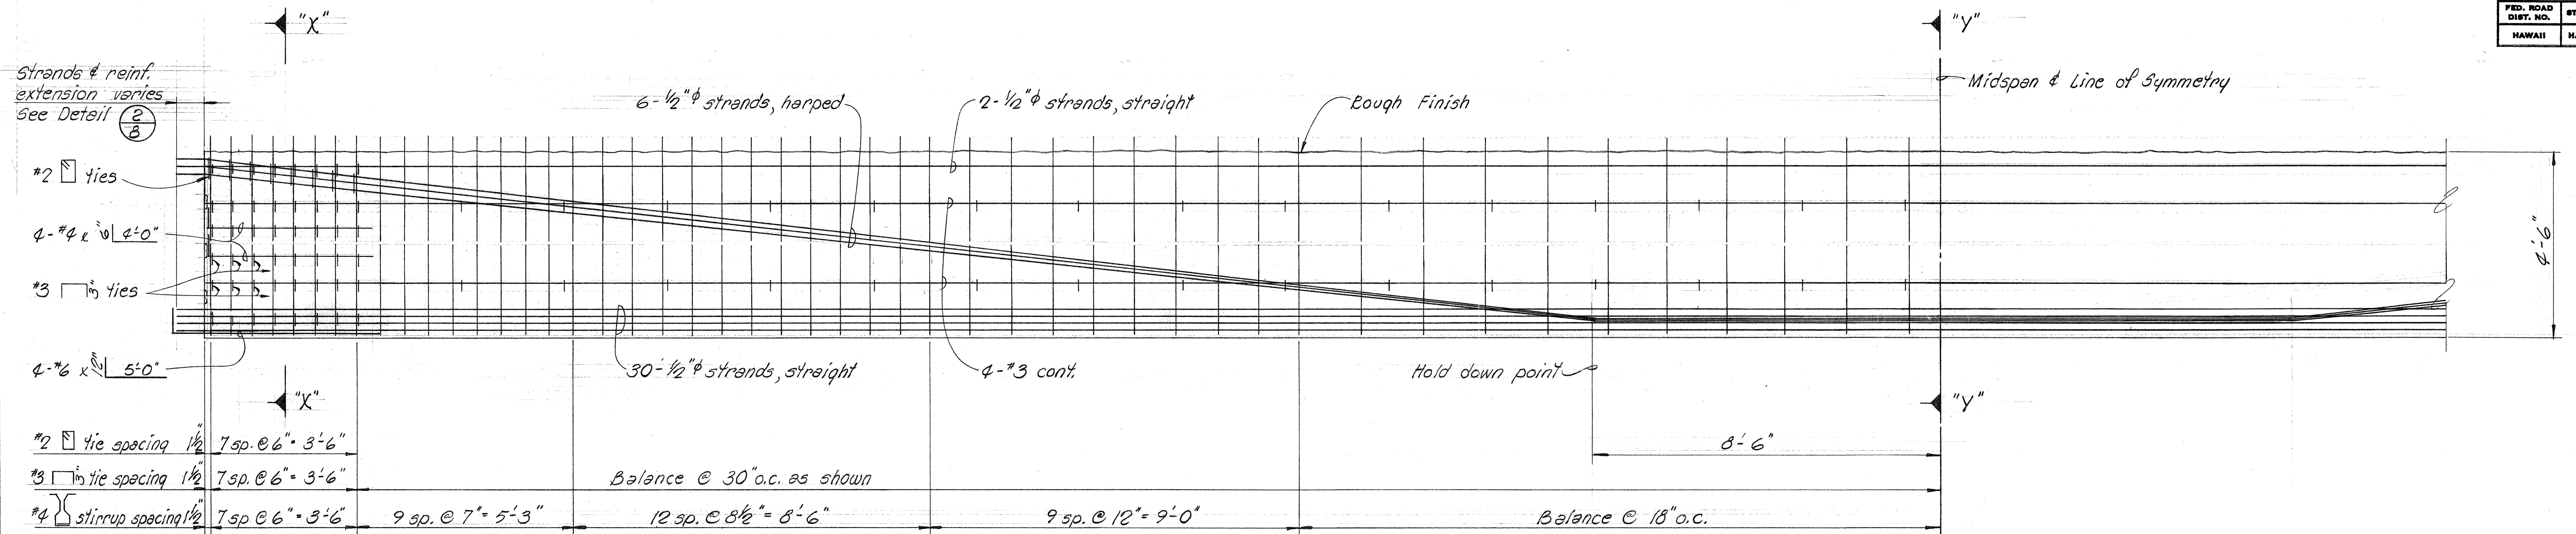


PART ELEVATION
Scale: 1/2" = 1'-0"

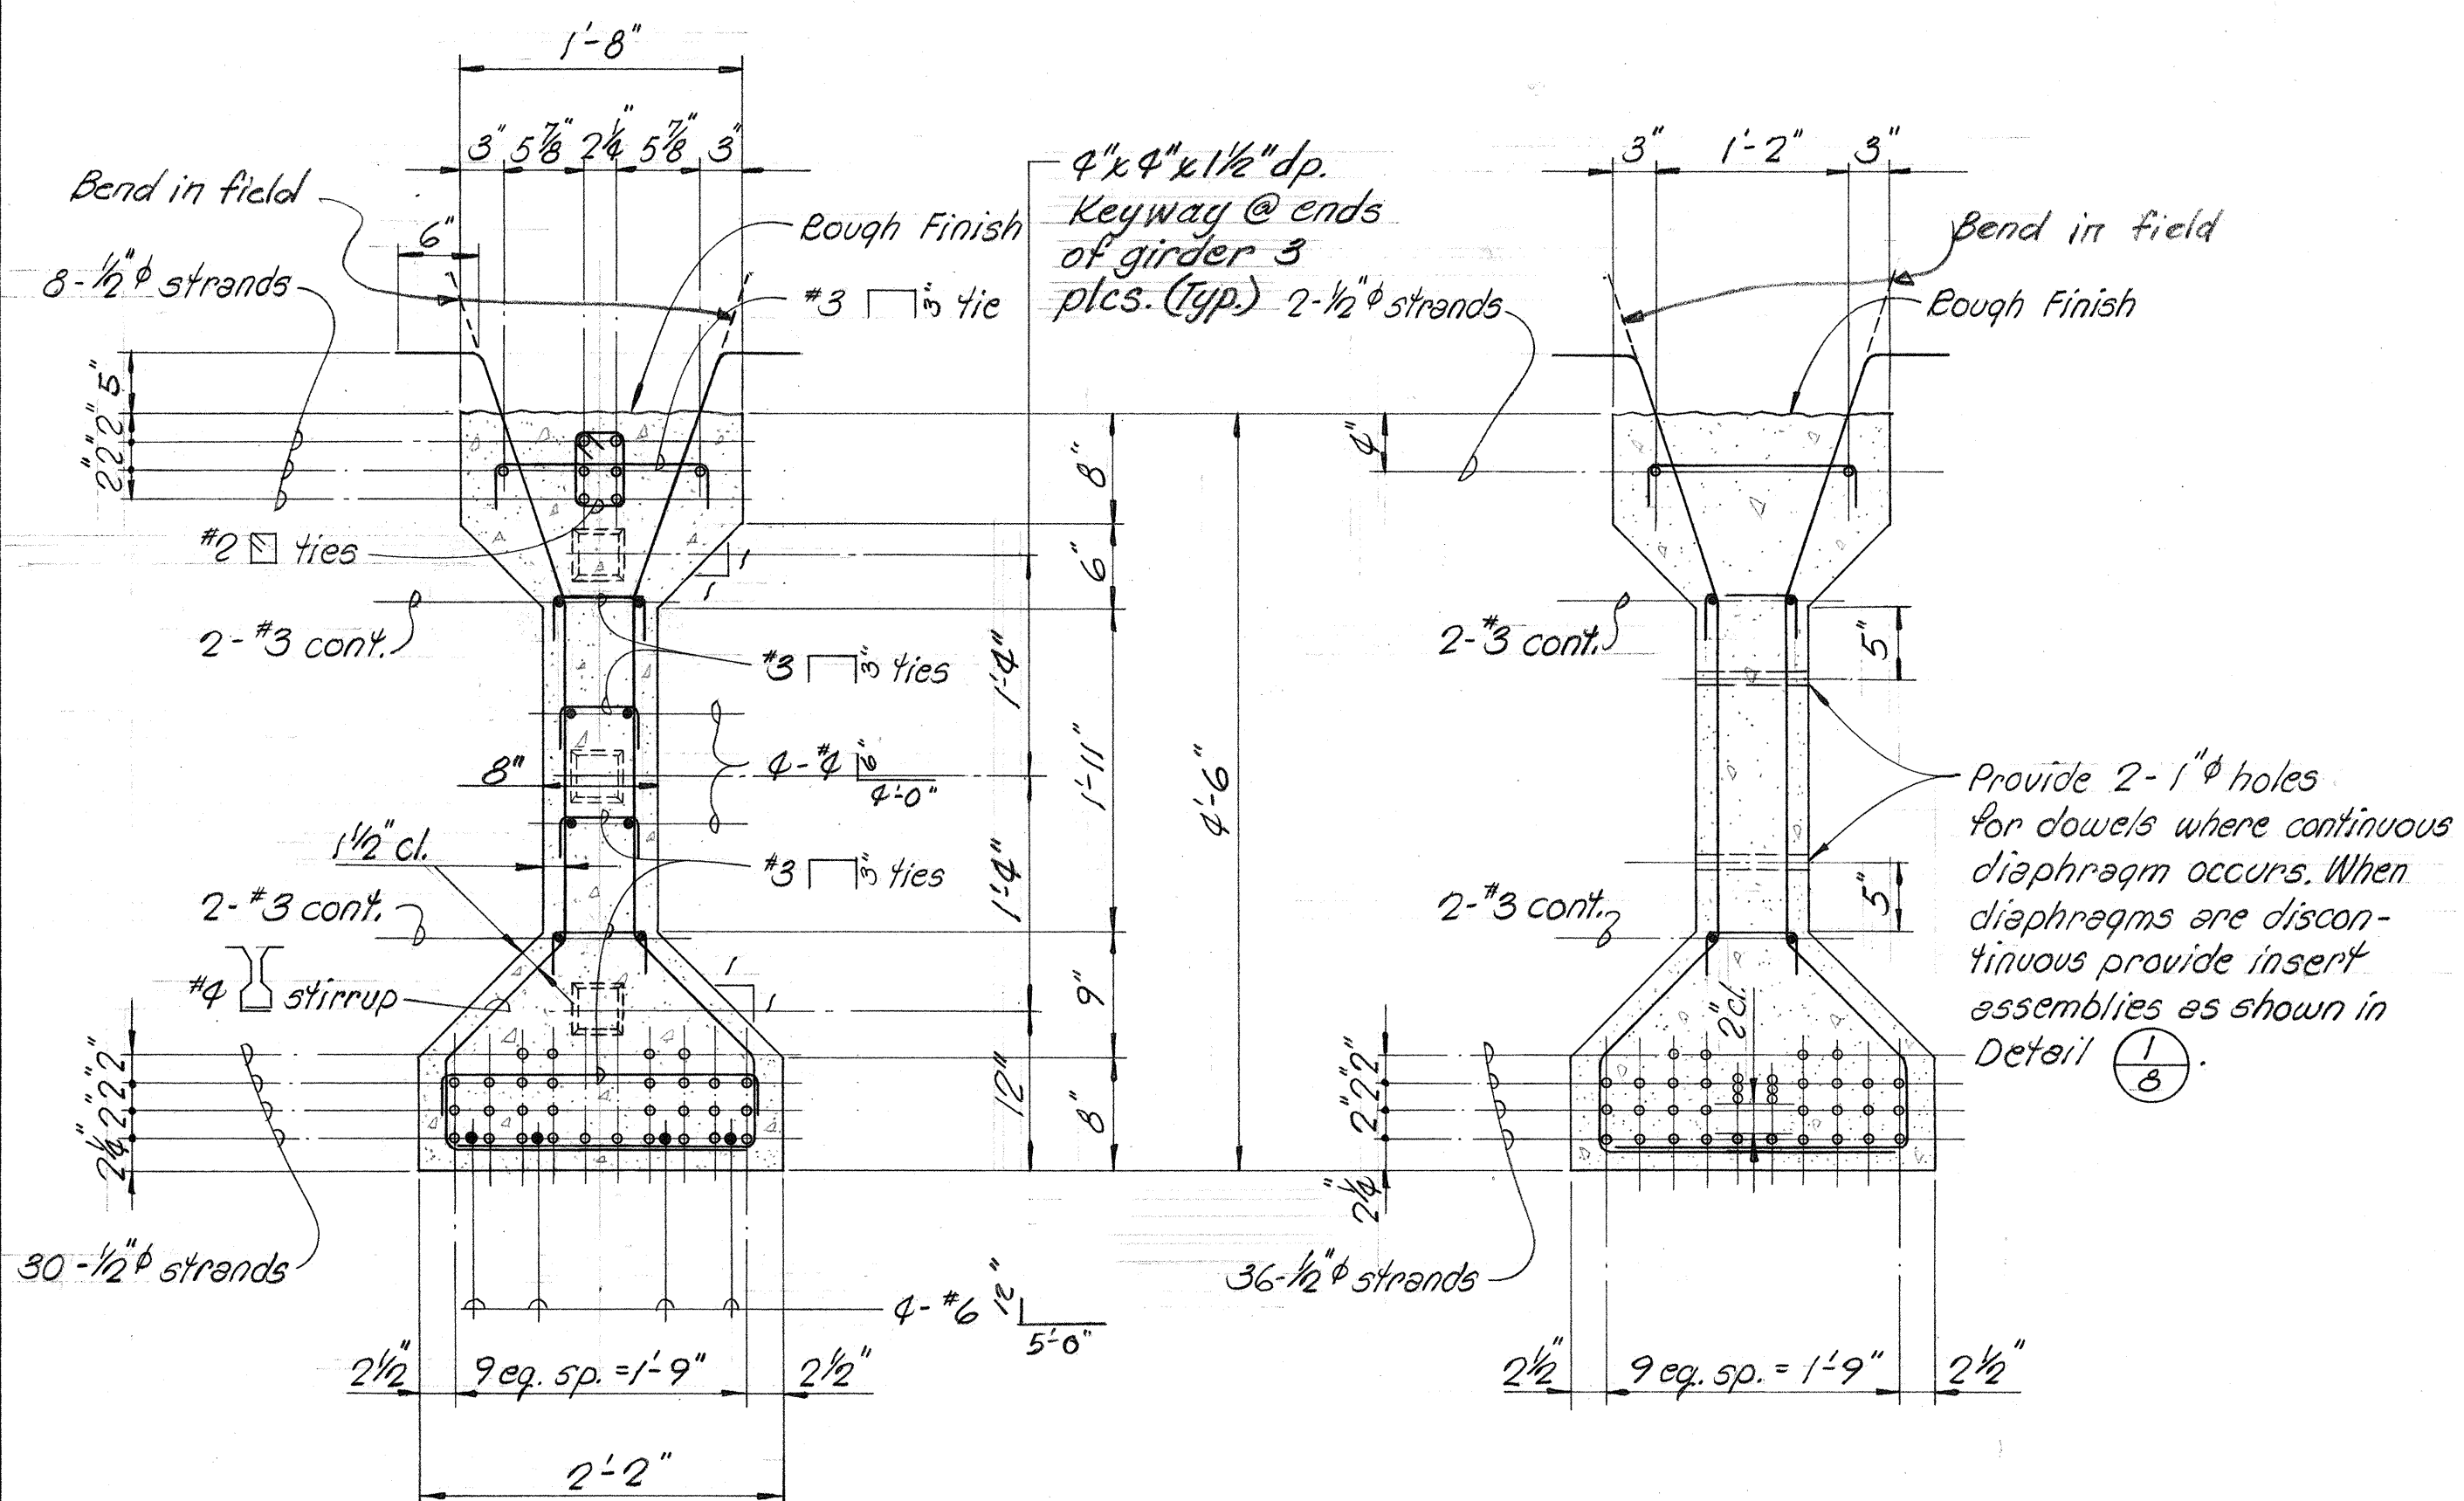


SECTION "X"-"X"
Scale: 1" = 1'-0"

SECTION "Y"-"Y"
Scale: 1" = 1'-0"

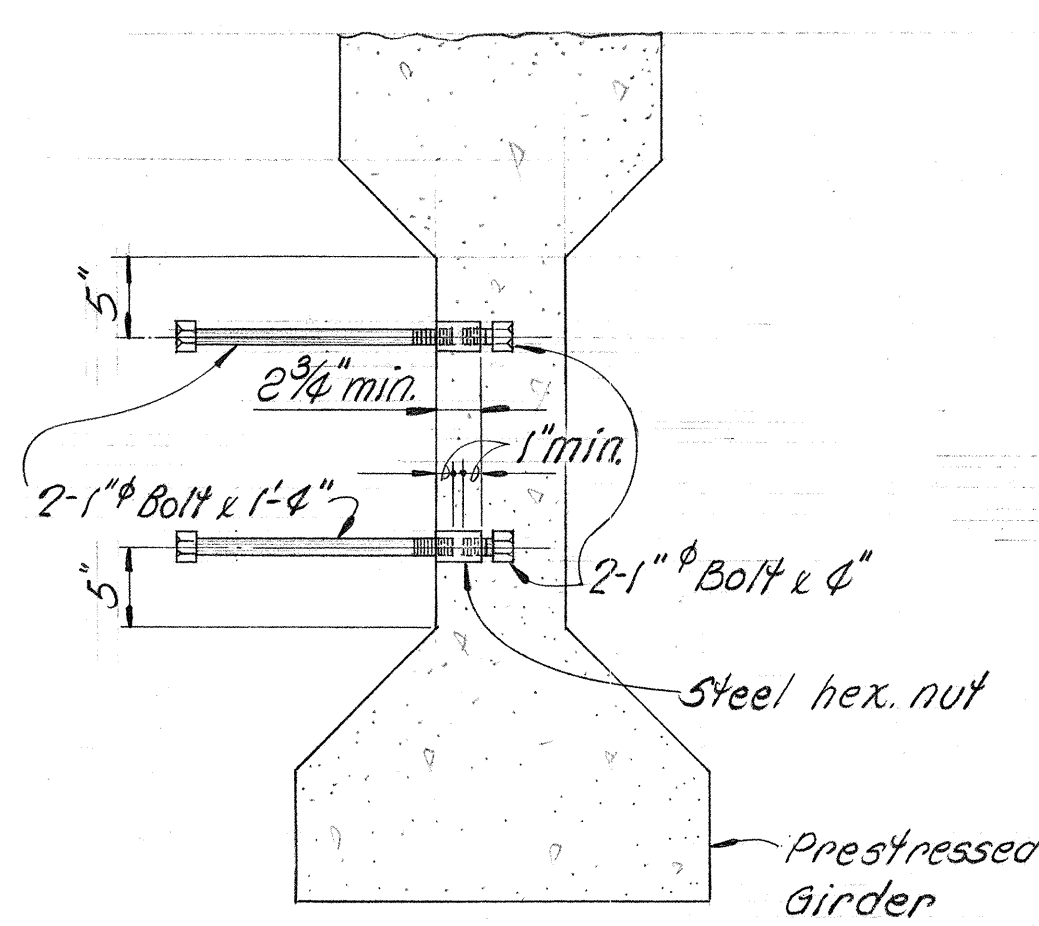

DETAIL 1
Scale: 1" = 1'-0"

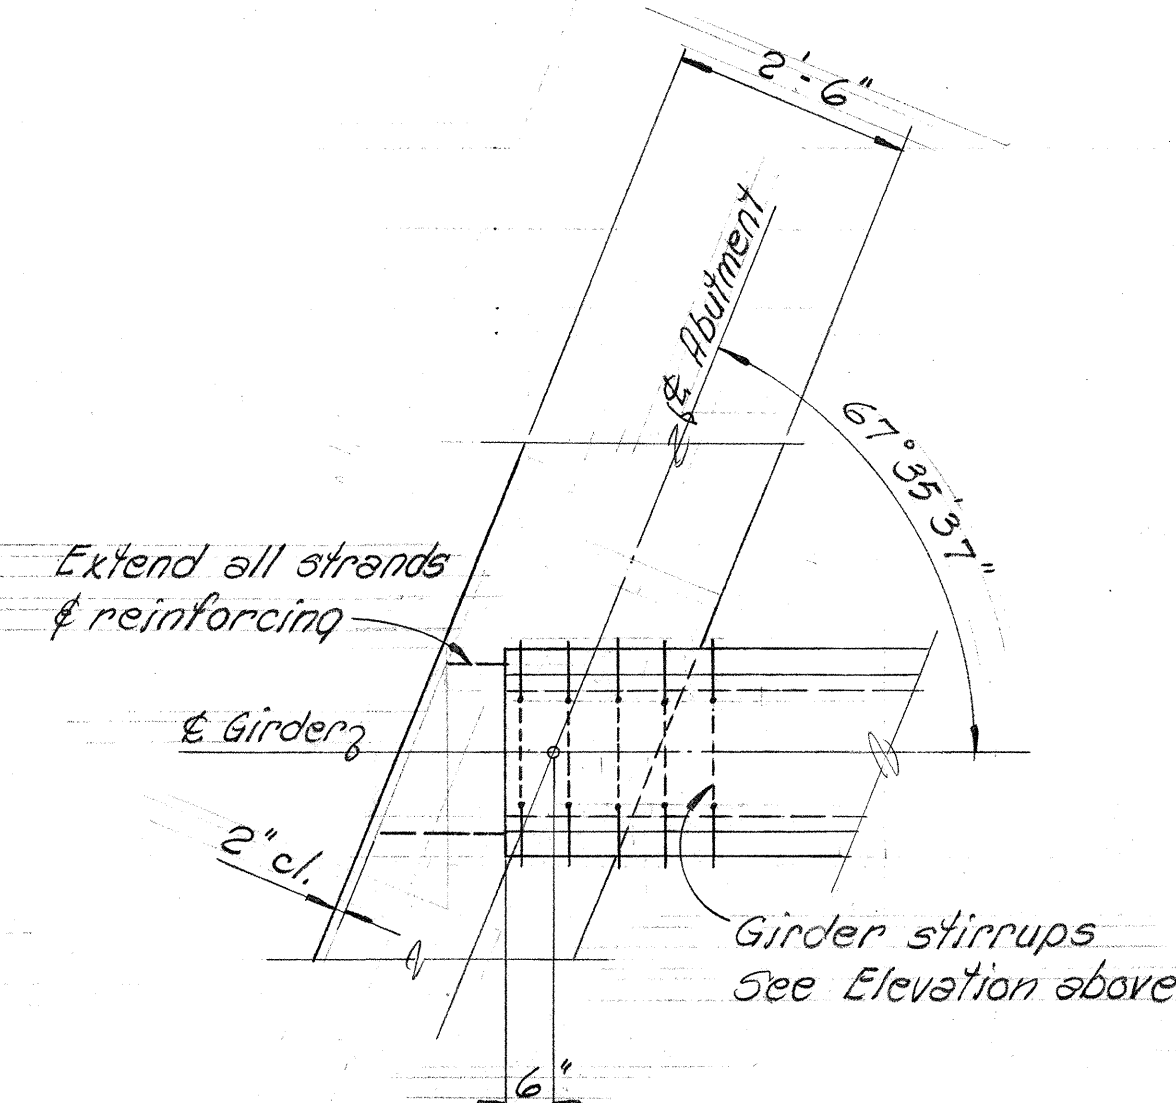


PLAN - GIRDER END DETAIL 2
Scale: 1/2" = 1'-0"

- SPECIAL NOTES**
- Concrete compressive strength at 28 days: 5,500 psi
 - Concrete strength at stress transfer: 4,000 psi
 - Prestressing steel shall be 250 ksi ultimate strength, 7-wire stress relieved strands.
 - All girders shall be aged at least 7 days from stress transfer before deck slab can be poured.

PRESTRESSED AASHO GIRDER No. IV DETAILS

SHIMAZU SHIMABUKURO & FUKUDA, INC.
Consulting Structural Engineers
1210 Ward Ave. Honolulu, Hawaii 96814

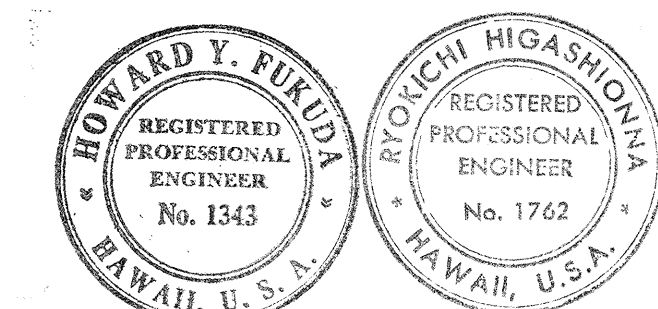

This work was prepared by me or under my supervision.

Howard Y. Fukuda






STATE OF HAWAII
DEPARTMENT OF TRANSPORTATION
HIGHWAYS DIVISION

STRUCTURE No. 6
GIRDER DETAILS

WAIKAWA INTERCHANGE
F.A.I. Proj. No. I-HI-1(69):8

Scale: As shown Date: OCT. 1968

SHEET No. 8 OF 9 SHEETS

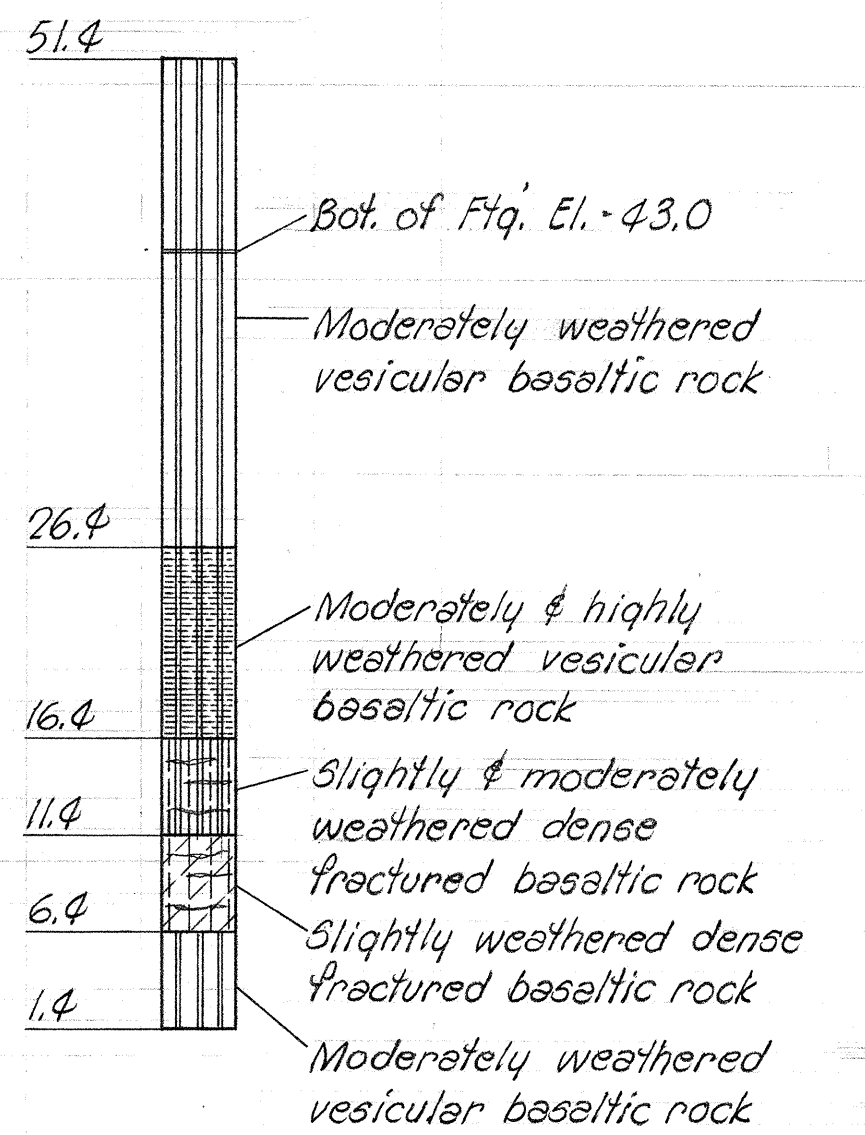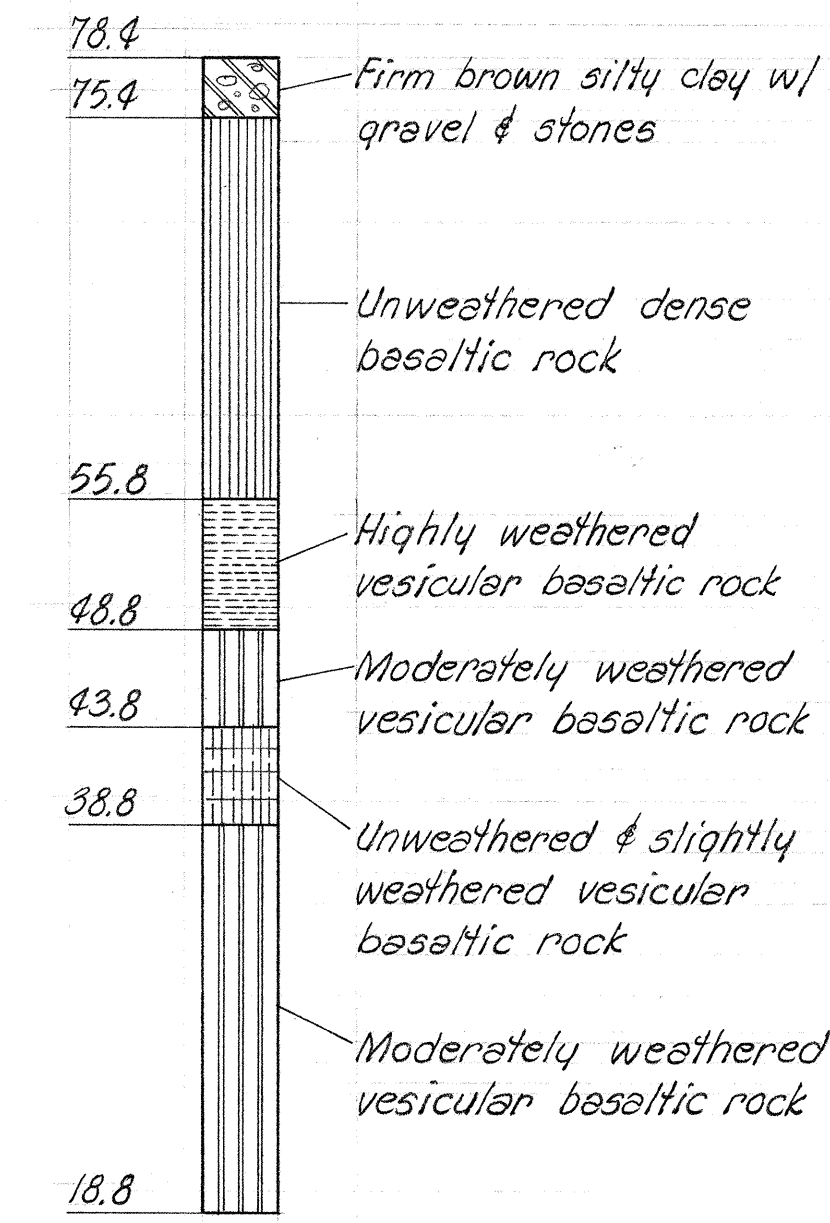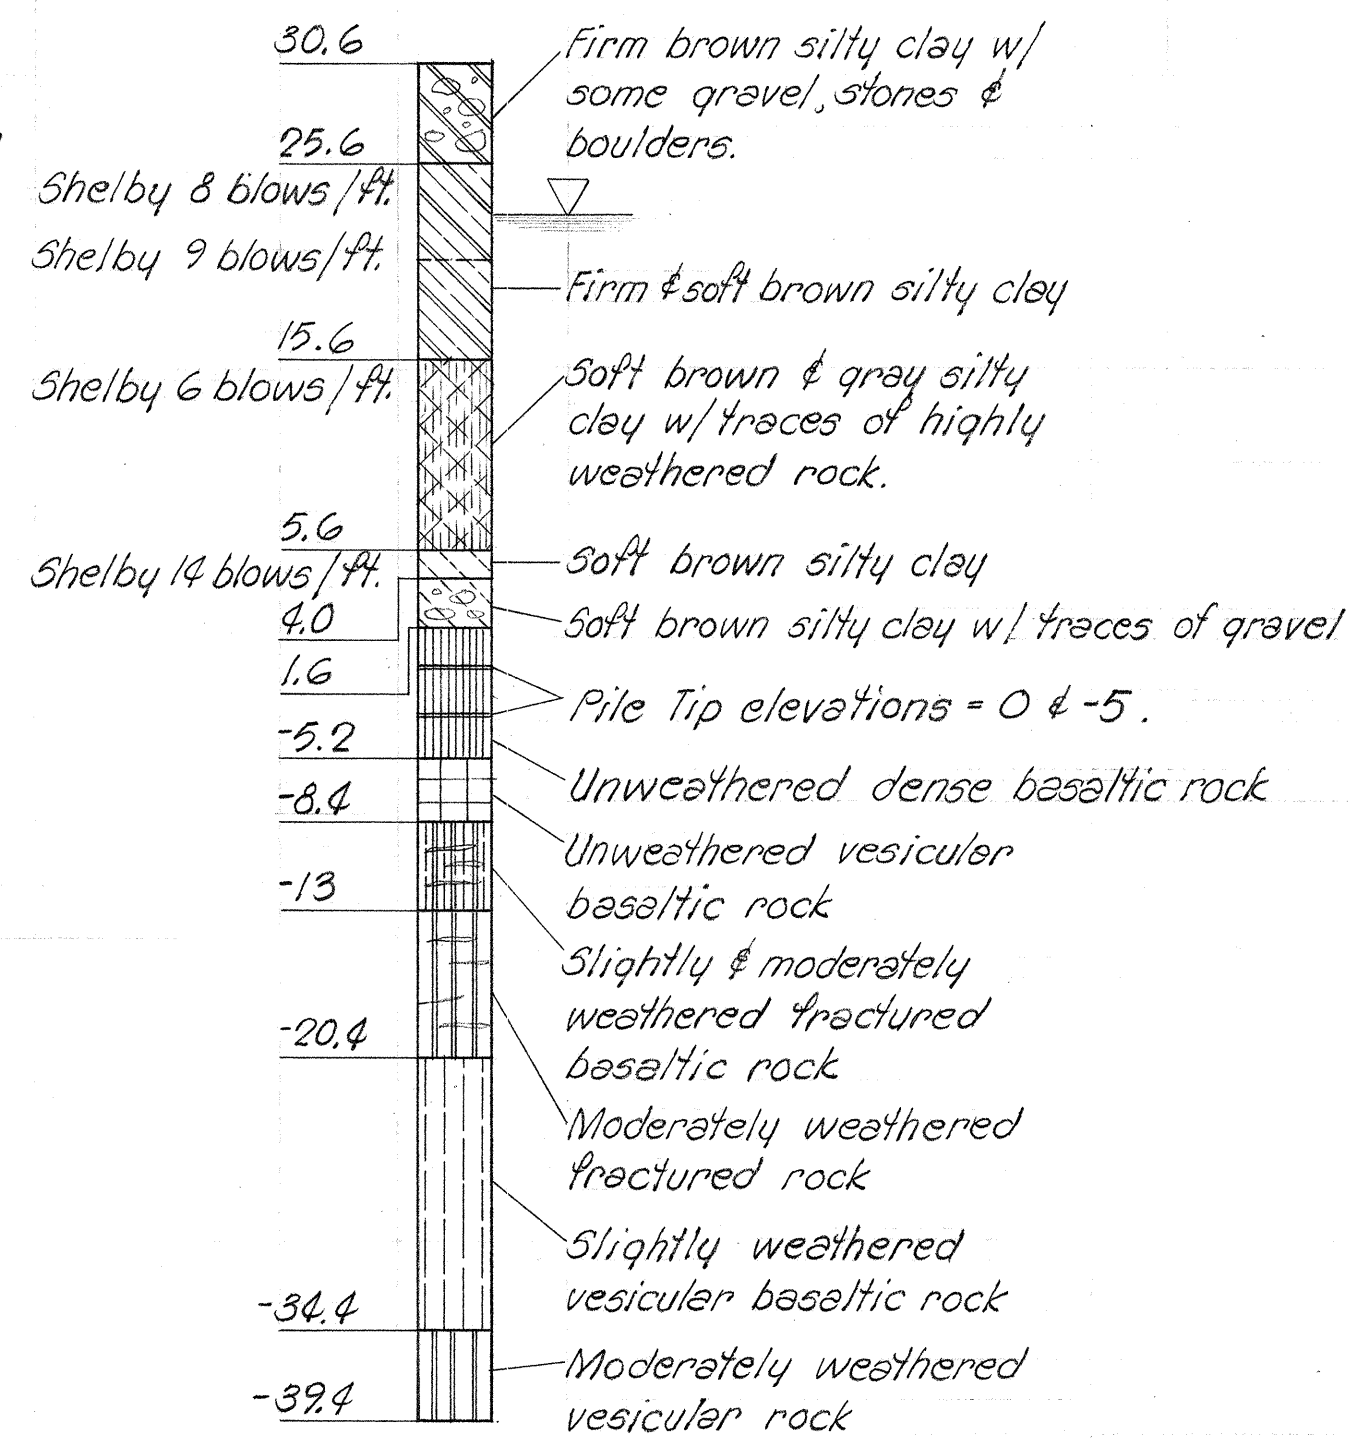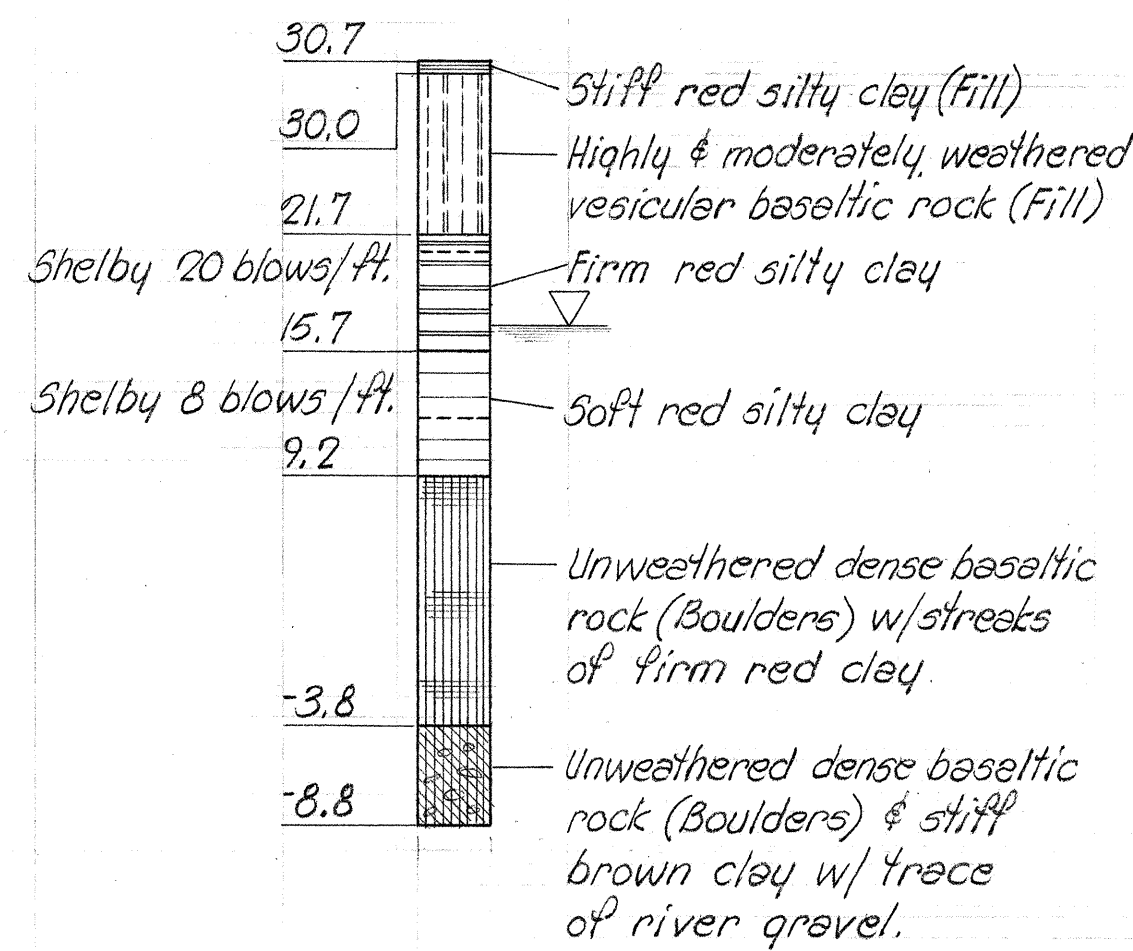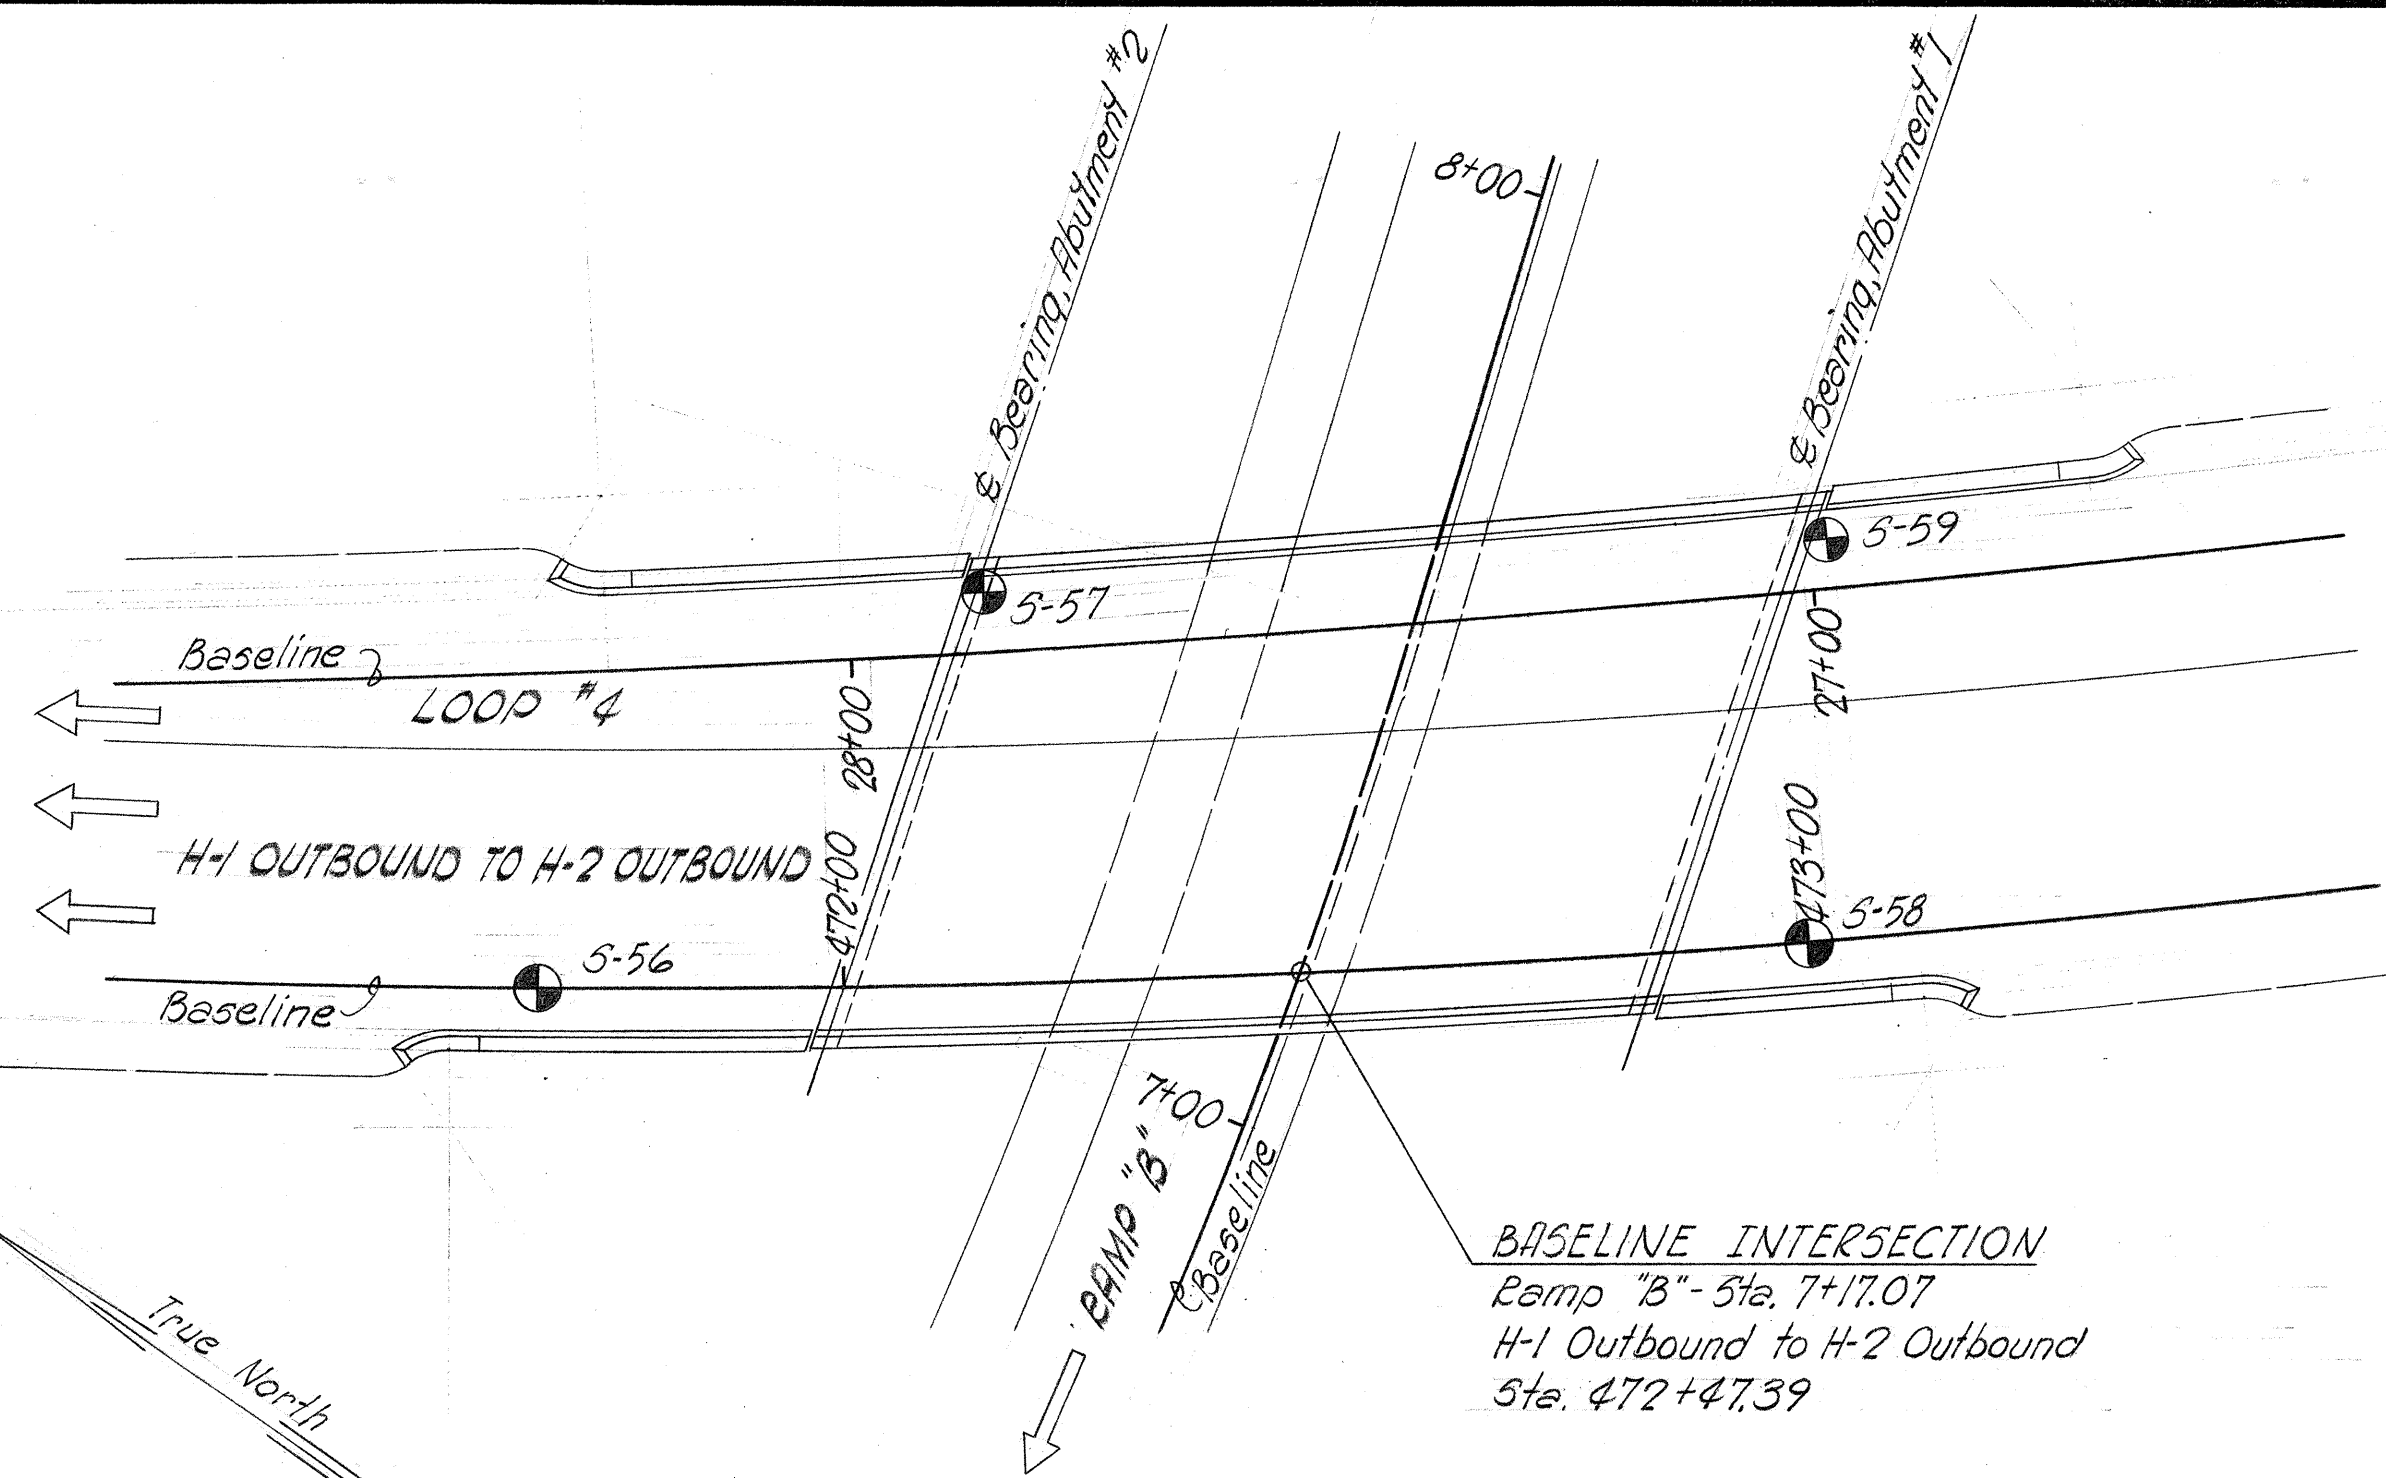

BORING LOGS FOR STRUCTURE 6