

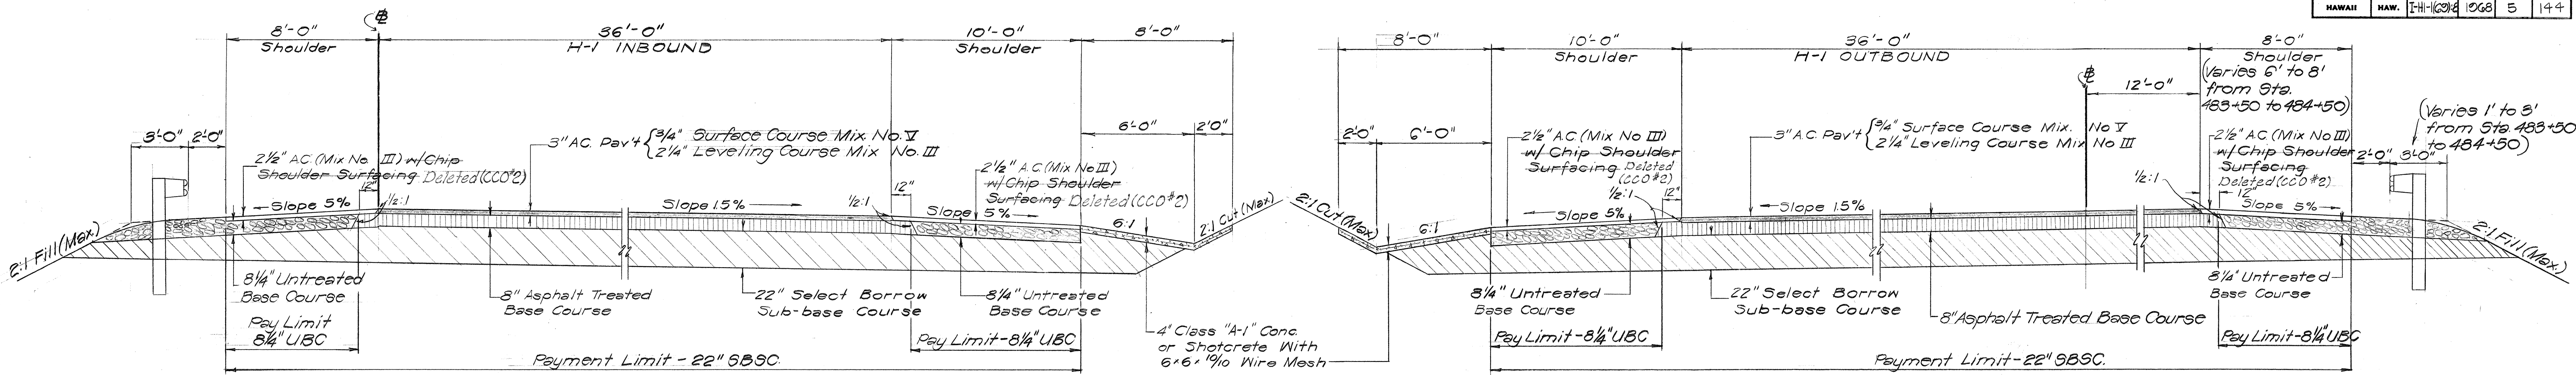


FED. ROAD DIST. NO.	STATE	FED. AID PROJ. NO.	FISCAL YEAR	SHEET NO.	TOTAL SHEETS
HAWAII	HAW.	I-11-1624	1968	5	144

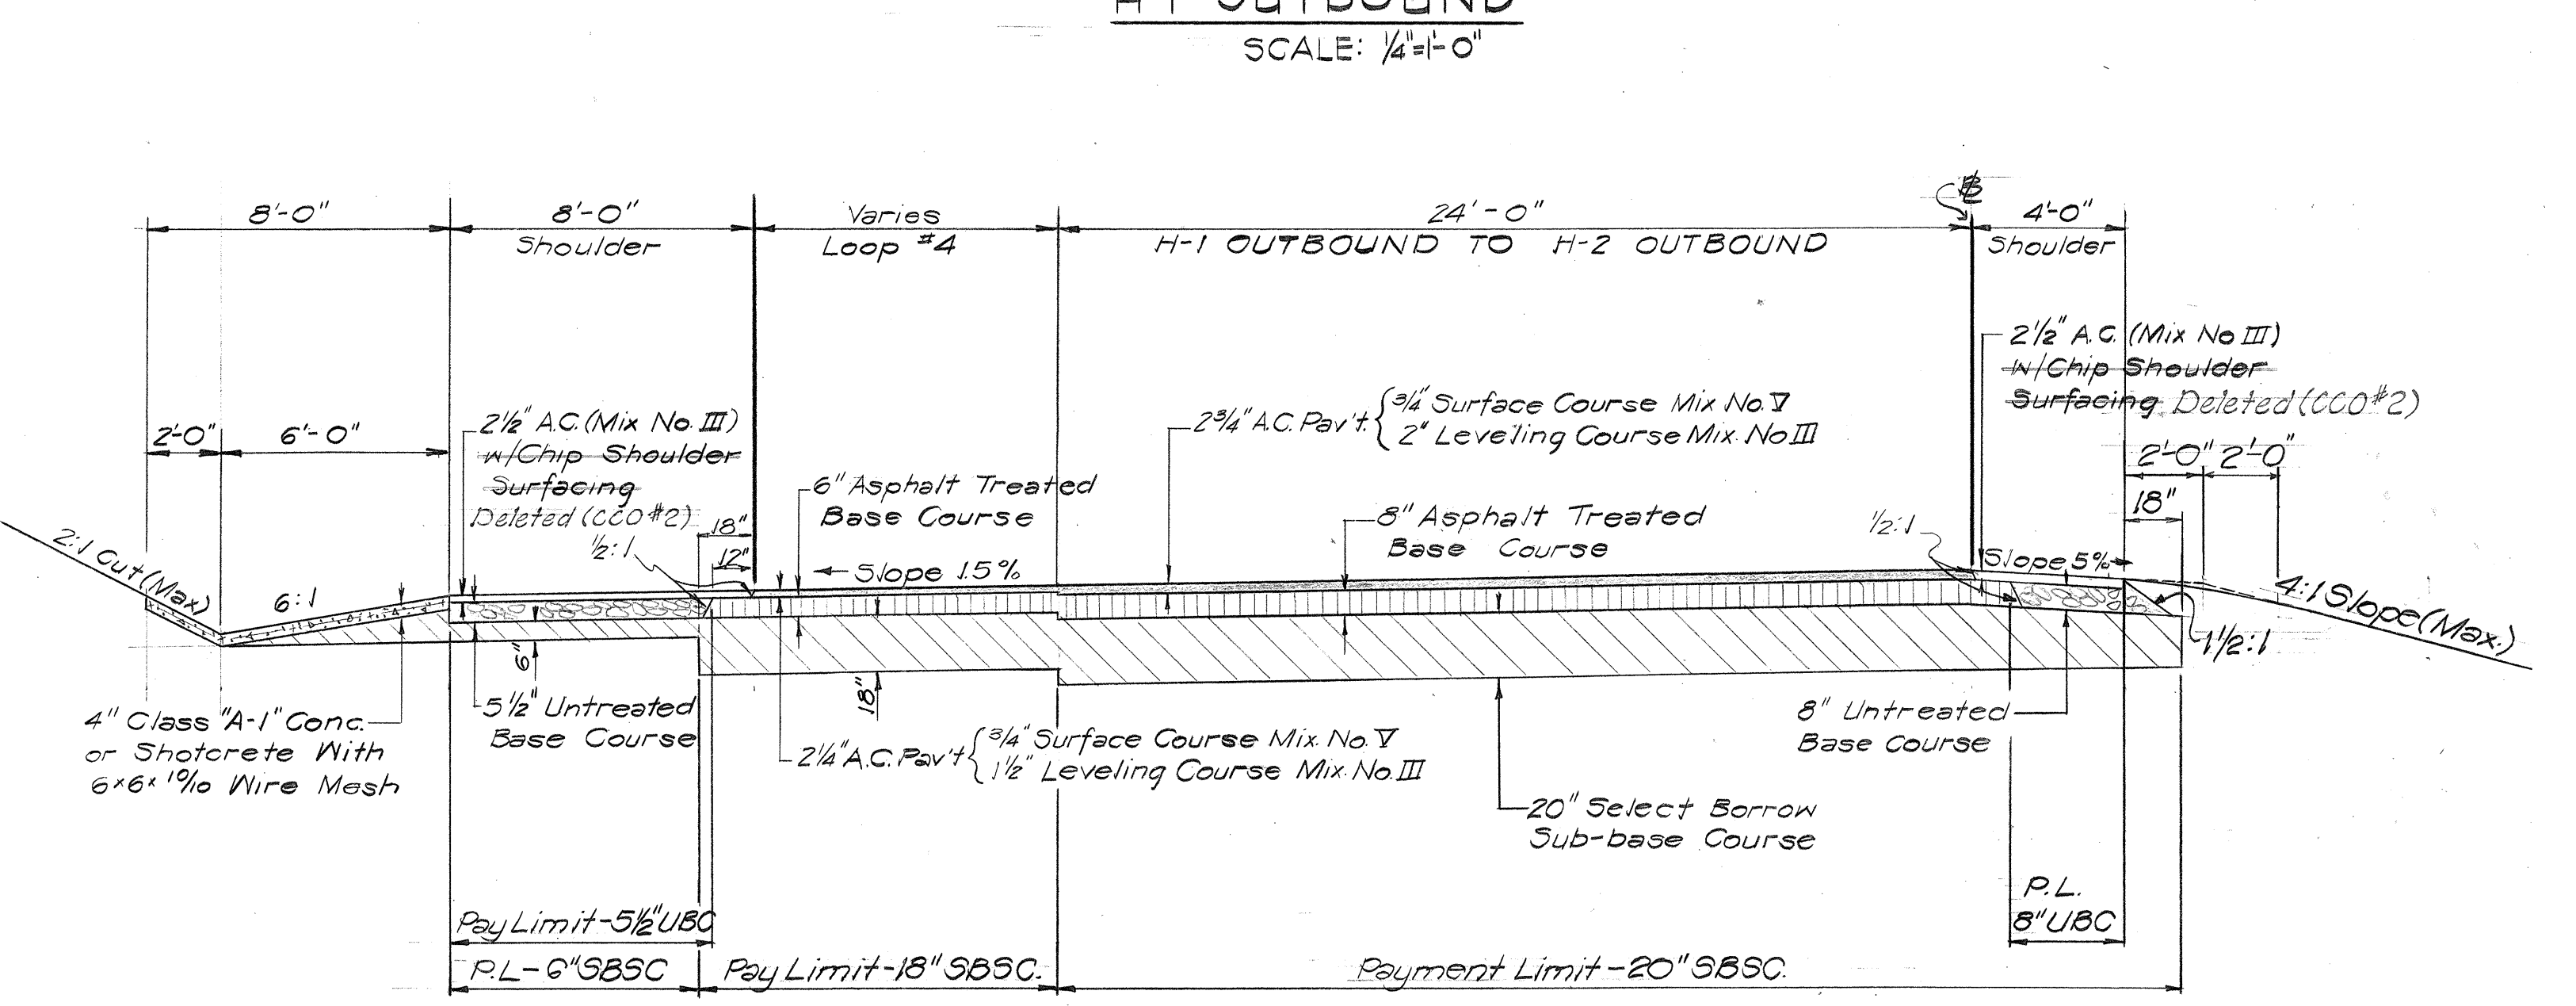


SEE BELOW FOR SHOULDER DETAIL AT RETAINING WALL AND STRUCTURE #8

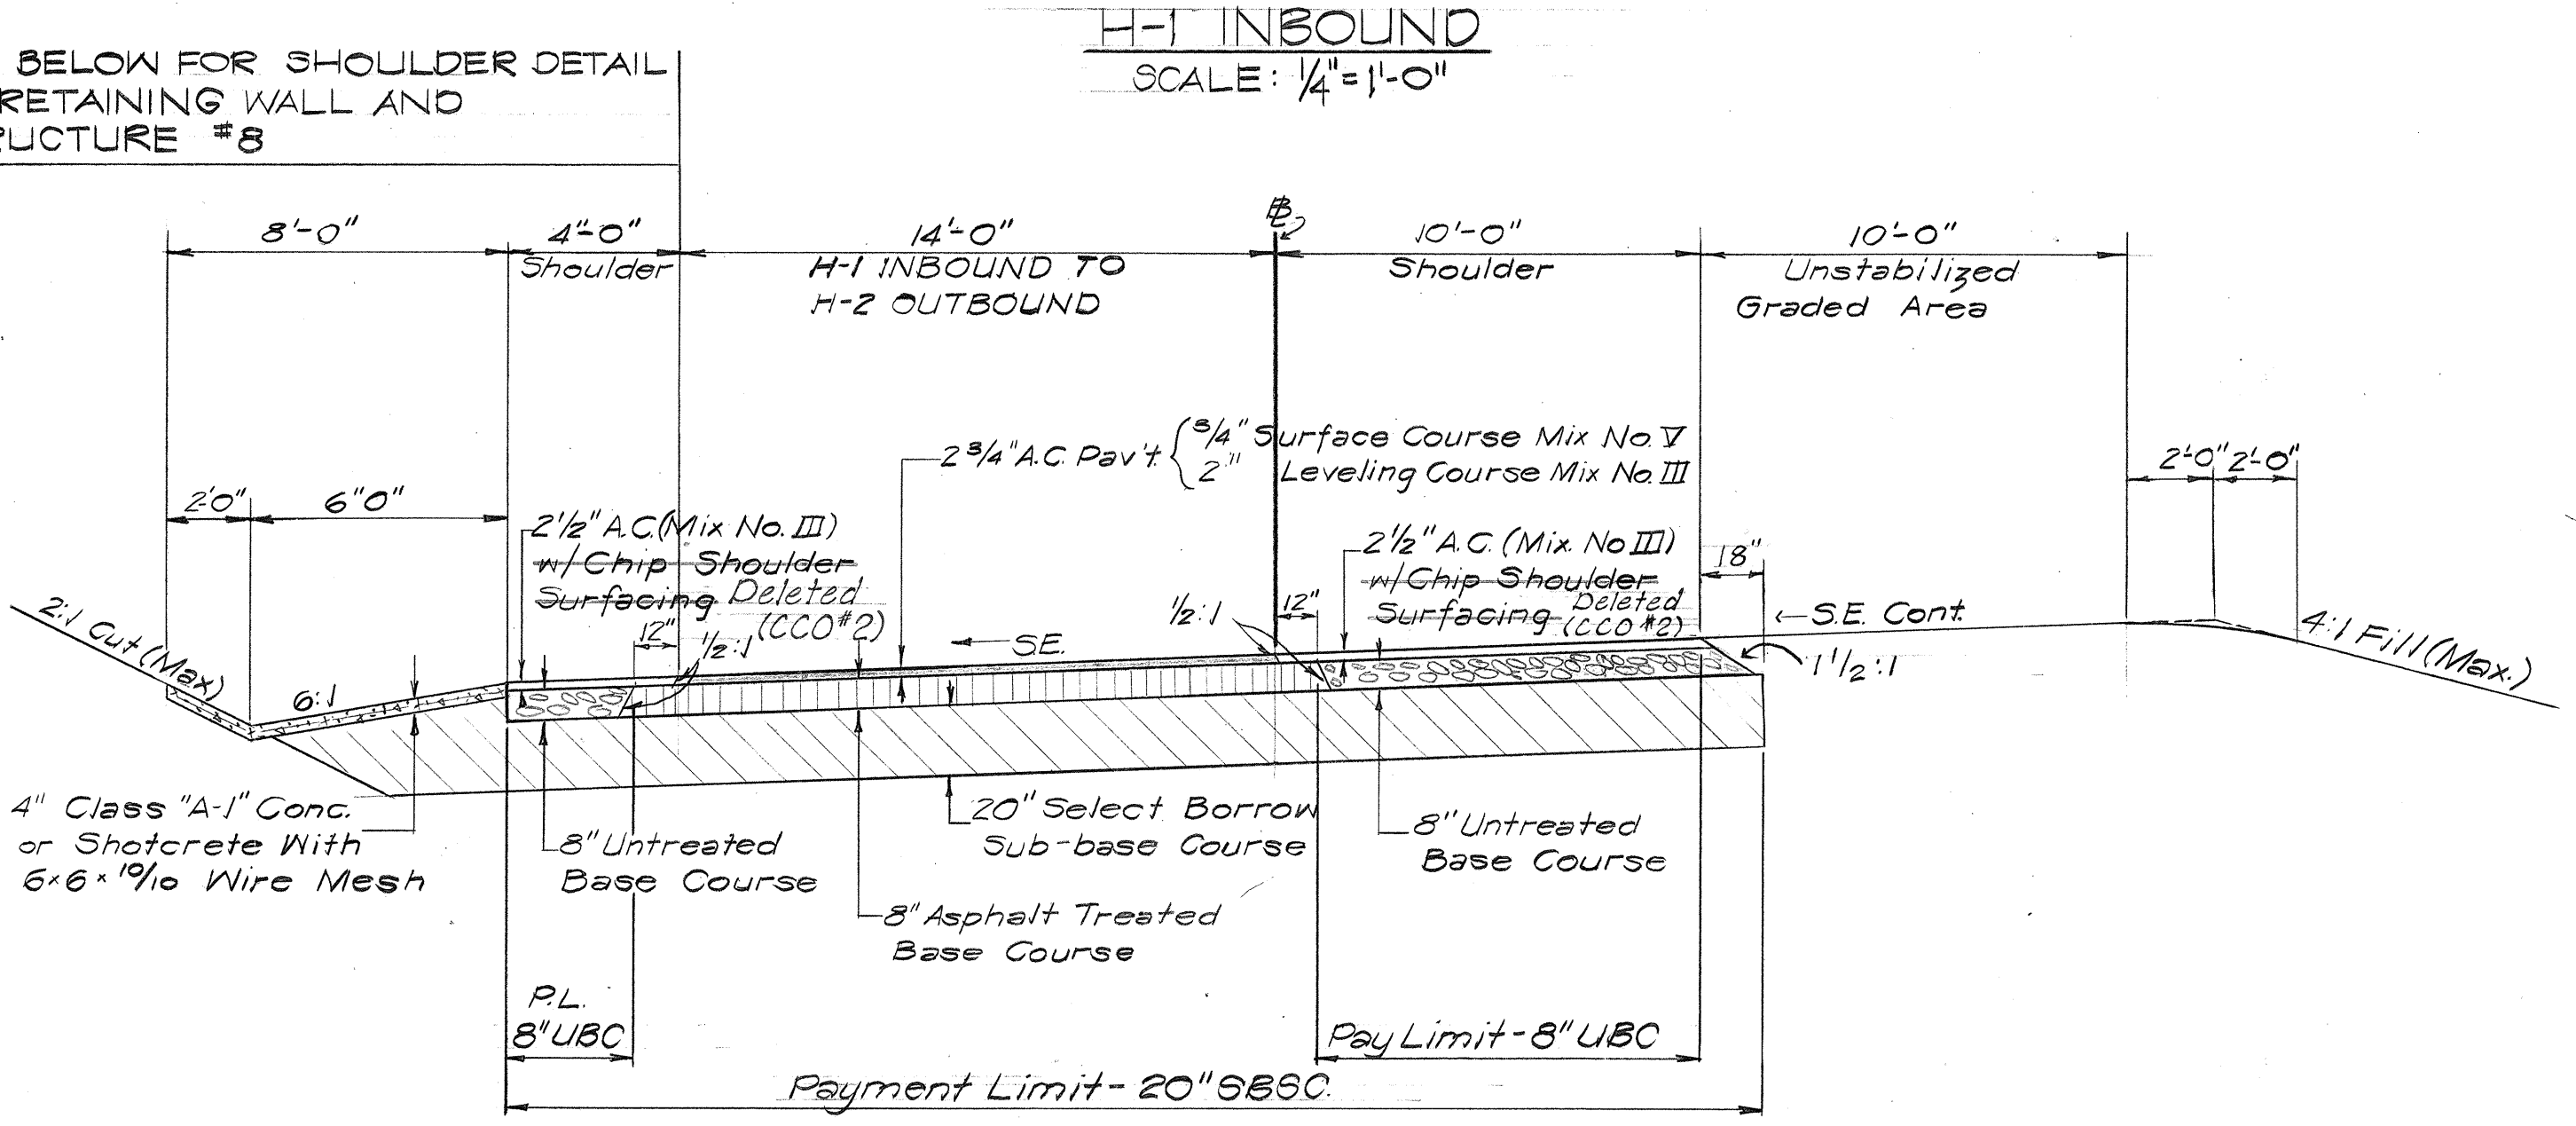


H-1 INBOUND TO H-2 OUTBOUND
SCALE: 1/4"=1'-0"


H-1 OUTBOUND TO H-2 OUTBOUND
SCALE: 1/4"=1'-0"

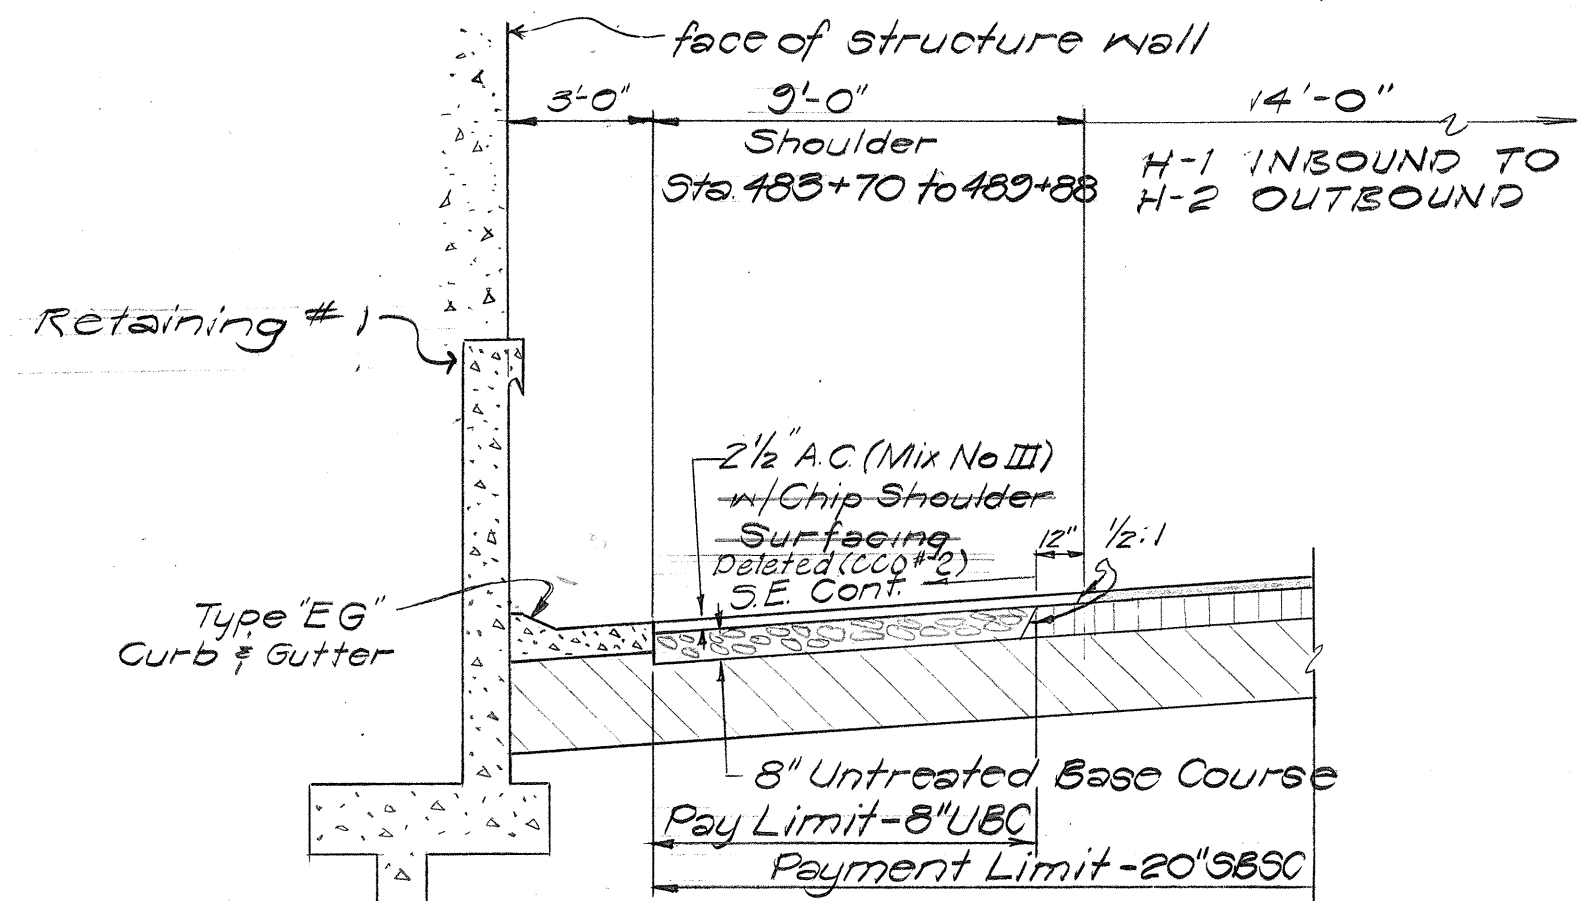

SHOULDER DETAIL AT
RETAINING WALL AND STRUCTURE #8
SCALE: 1/4"=1'-0"

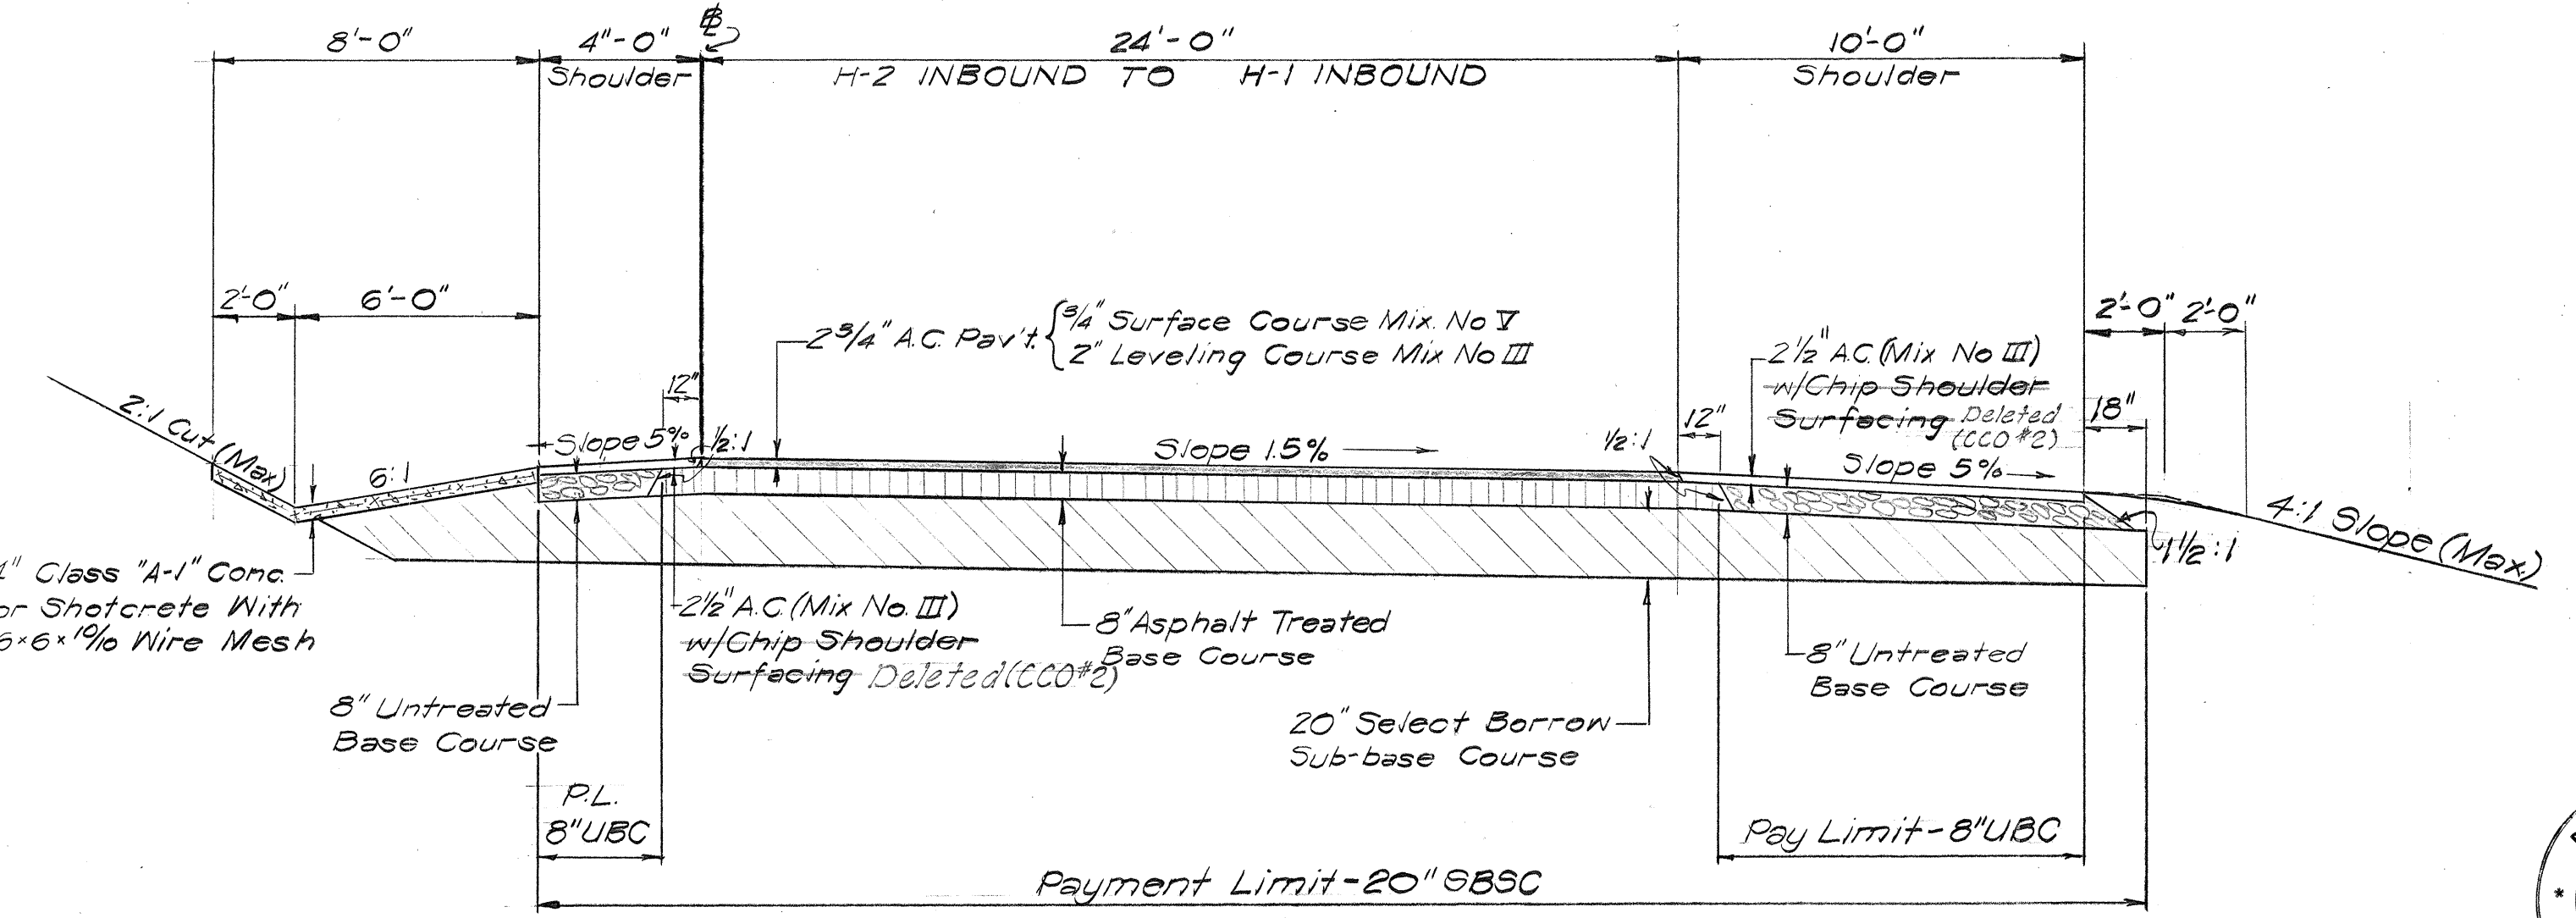

H-2 INBOUND TO H-1 INBOUND
SCALE: 1/4"=1'-0"

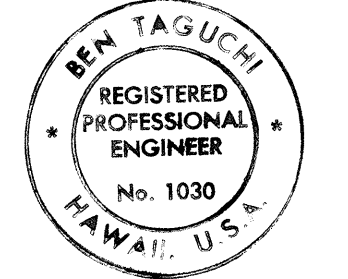

THIS WORK WAS PREPARED BY ME
OR UNDER MY SUPERVISION.
Ben Taguchi

STATE OF HAWAII
DEPARTMENT OF TRANSPORTATION
HIGHWAYS DIVISION



TYPICAL ROADWAY SECTIONS

WAIAWA INTERCHANGE
F.A.I. Proj. No. I - H1 - (69) 8

Scale As shown Date OCT. 1968

SHEET No. 1 OF 2 SHEETS






FED. ROAD DIST. NO.	STATE	FED. AID PROJ. NO.	FISCAL YEAR	SHEET NO.	TOTAL SHEETS
HAWAII	HAW.	I-H-1(69)-8	1968	6	144

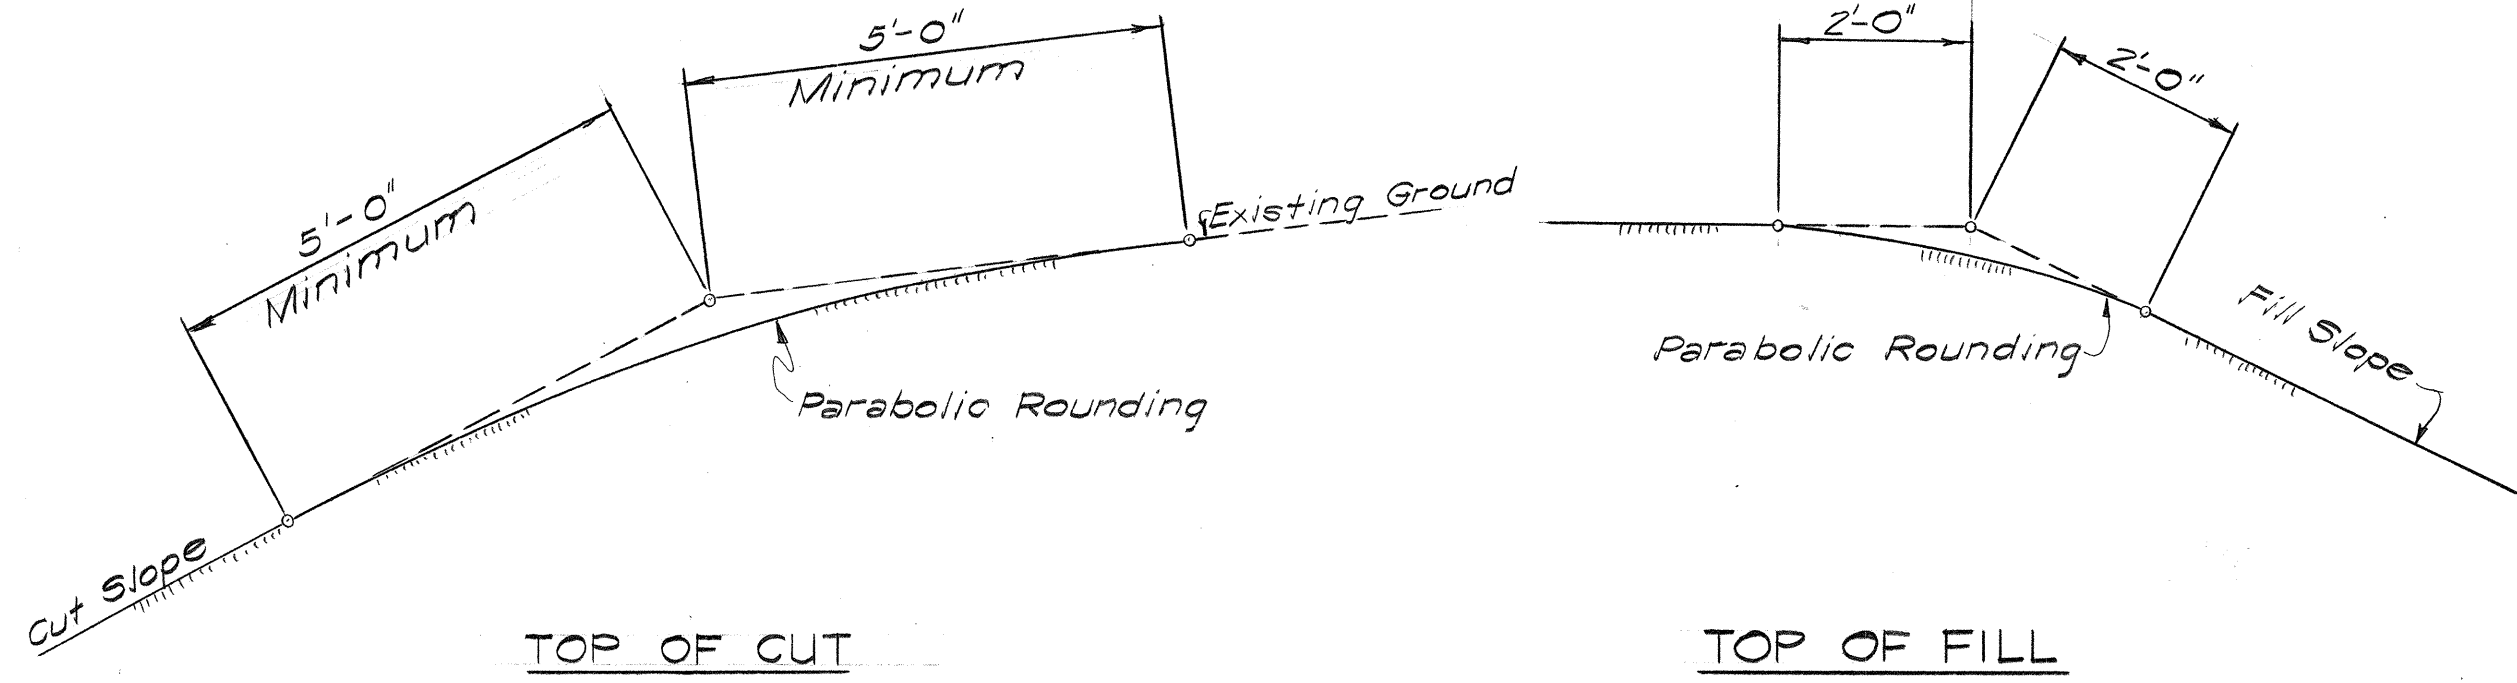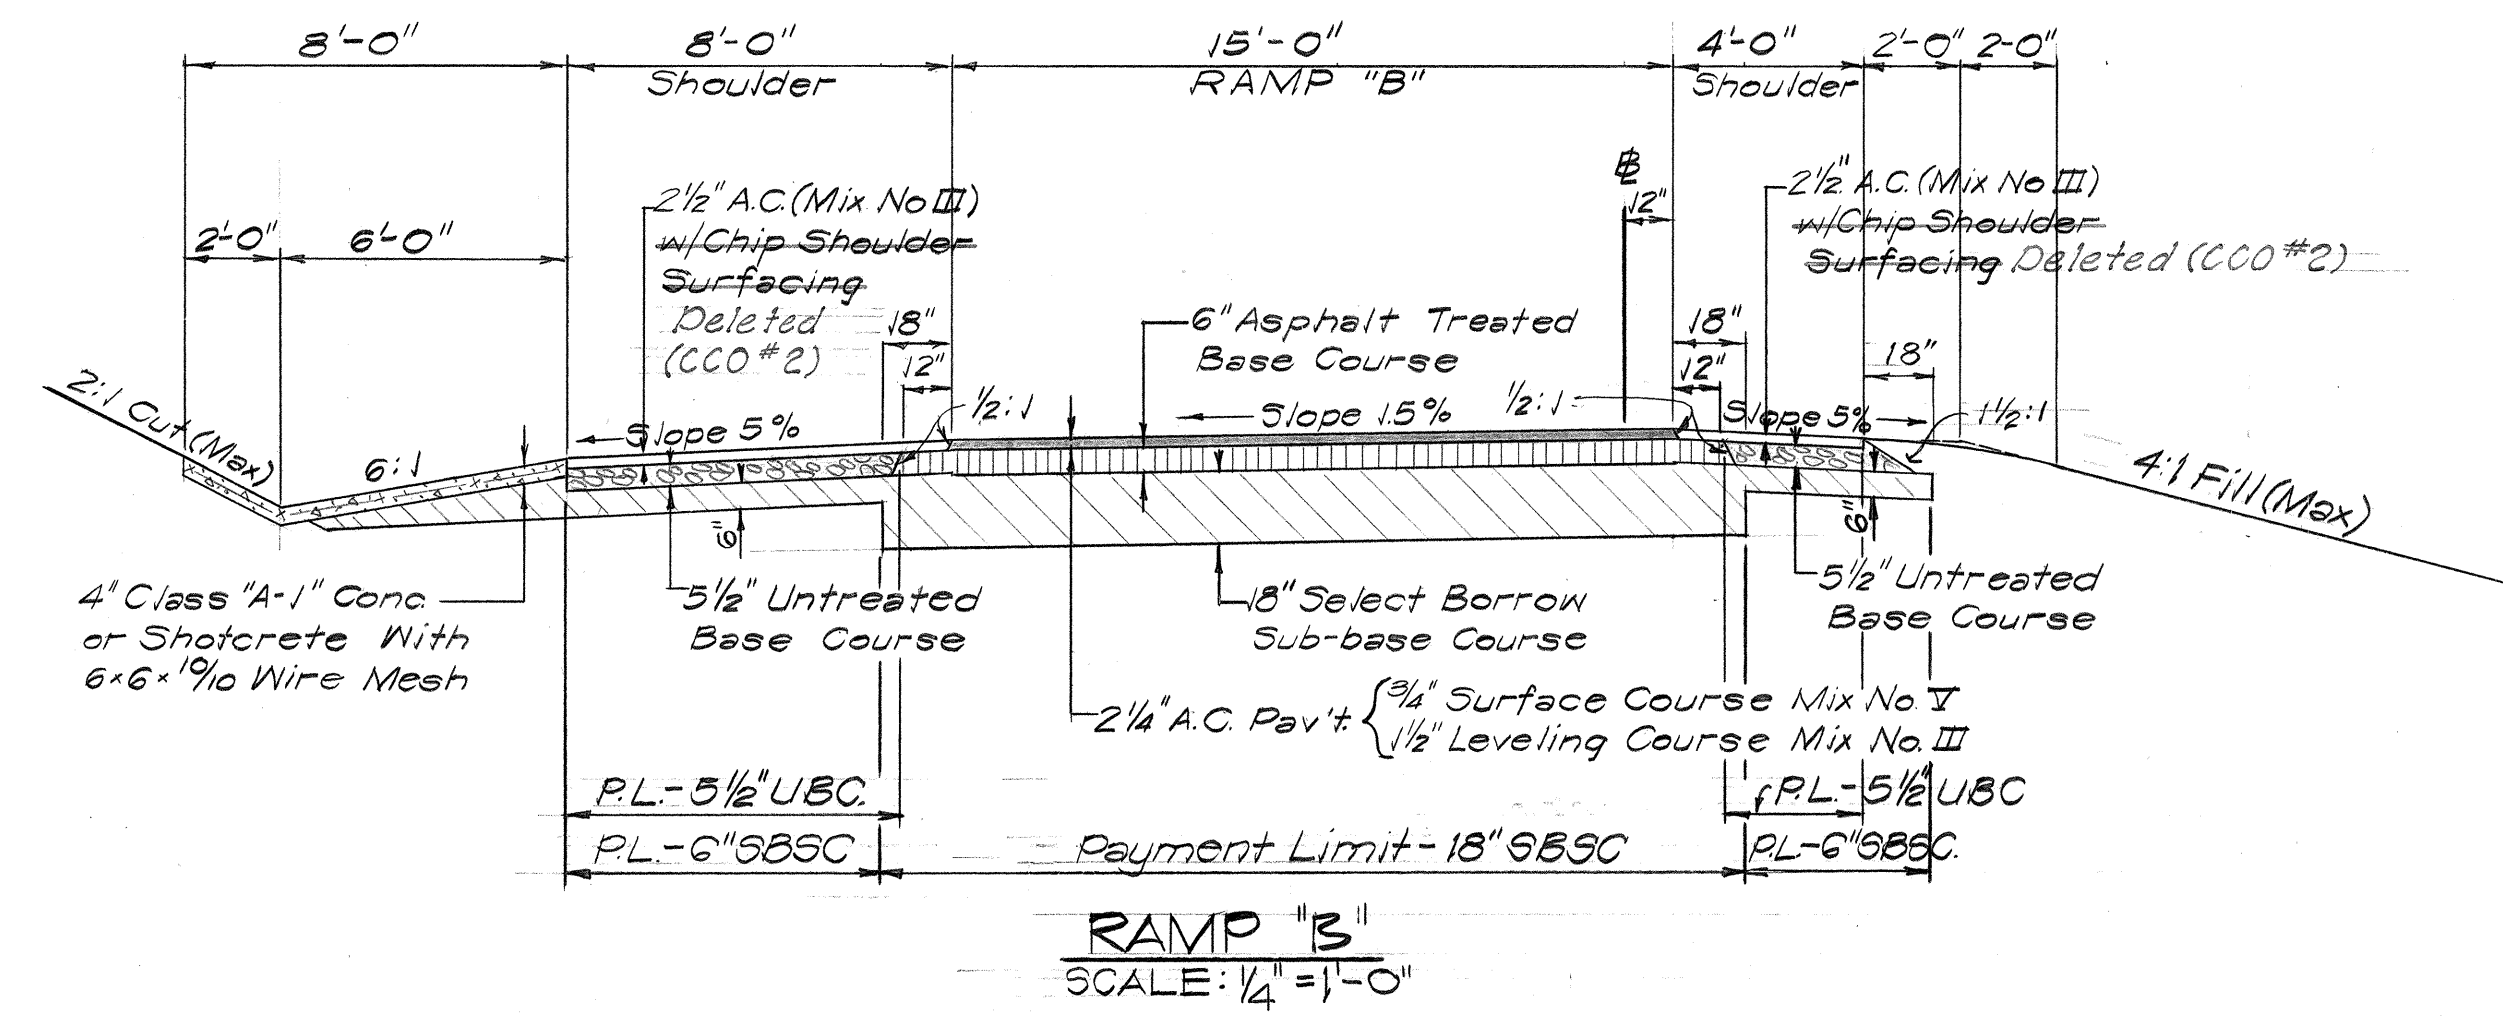

NOTE:
Rounding limits at top of cut shall be increased to 10' as directed by the Engineer.

GENERAL NOTES:

- All typical sections shown are in the direction of lane stationing.
- The pavement super-elevation shall continue through the shoulders only when the algebraic difference in cross slope at the pavement edge exceeds 6.5% or when the pavement super-elevation sloping down to the shoulder exceeds 5%. The transition for changes in shoulder slope shall be accomplished in 50 feet.
- The thickness specified for Asphaltic Concrete with Chip Shoulder Surfacing is the thickness for the Asphaltic Concrete which shall be 1/4" below the top of the roadway pavement to allow for the Chip Shoulder Surfacing.
- All quantities outside of the Payment Limit lines as shown in these typical sections shall be incidental to the respective items of work.

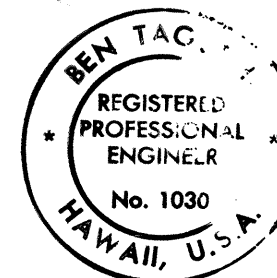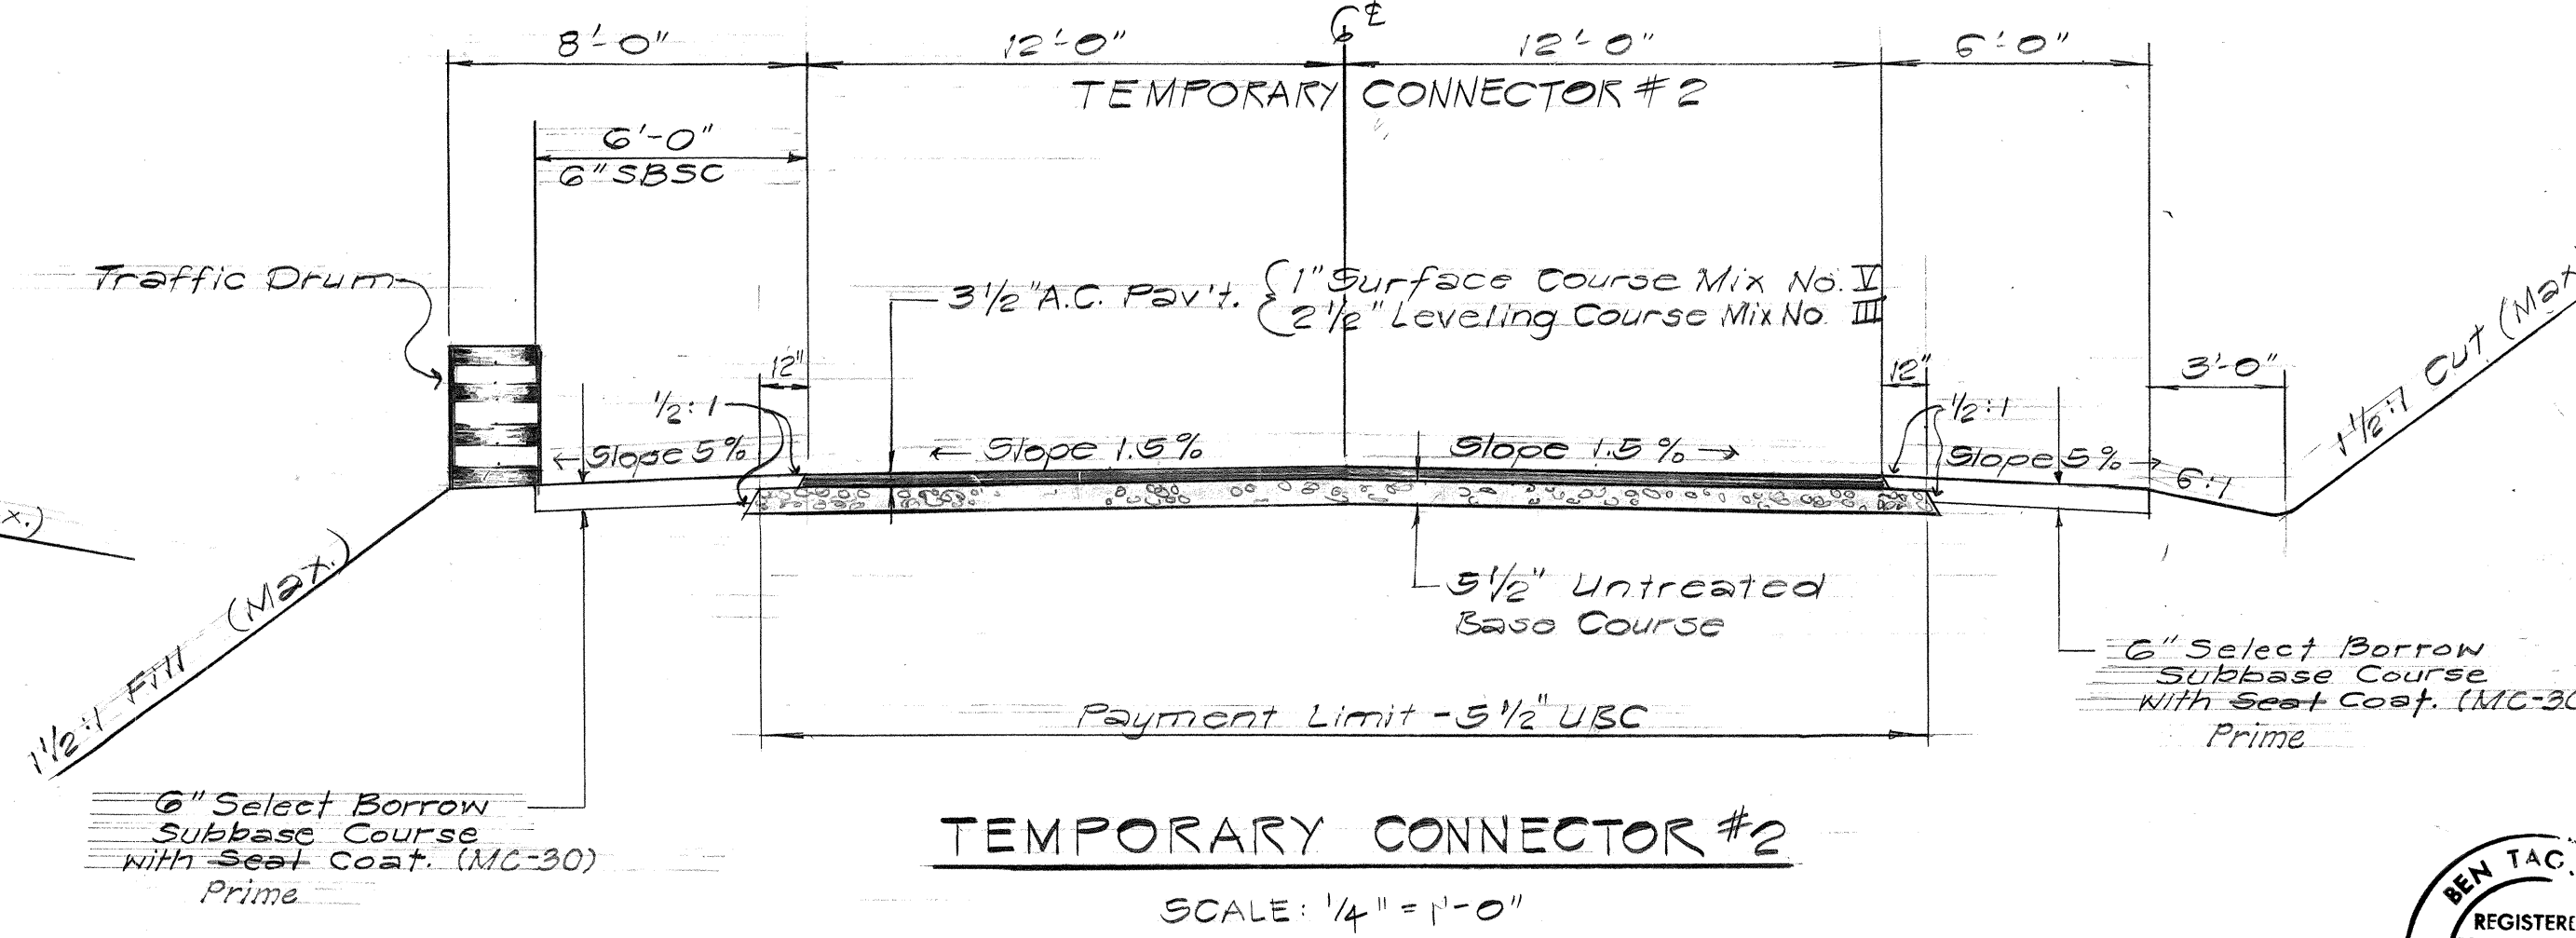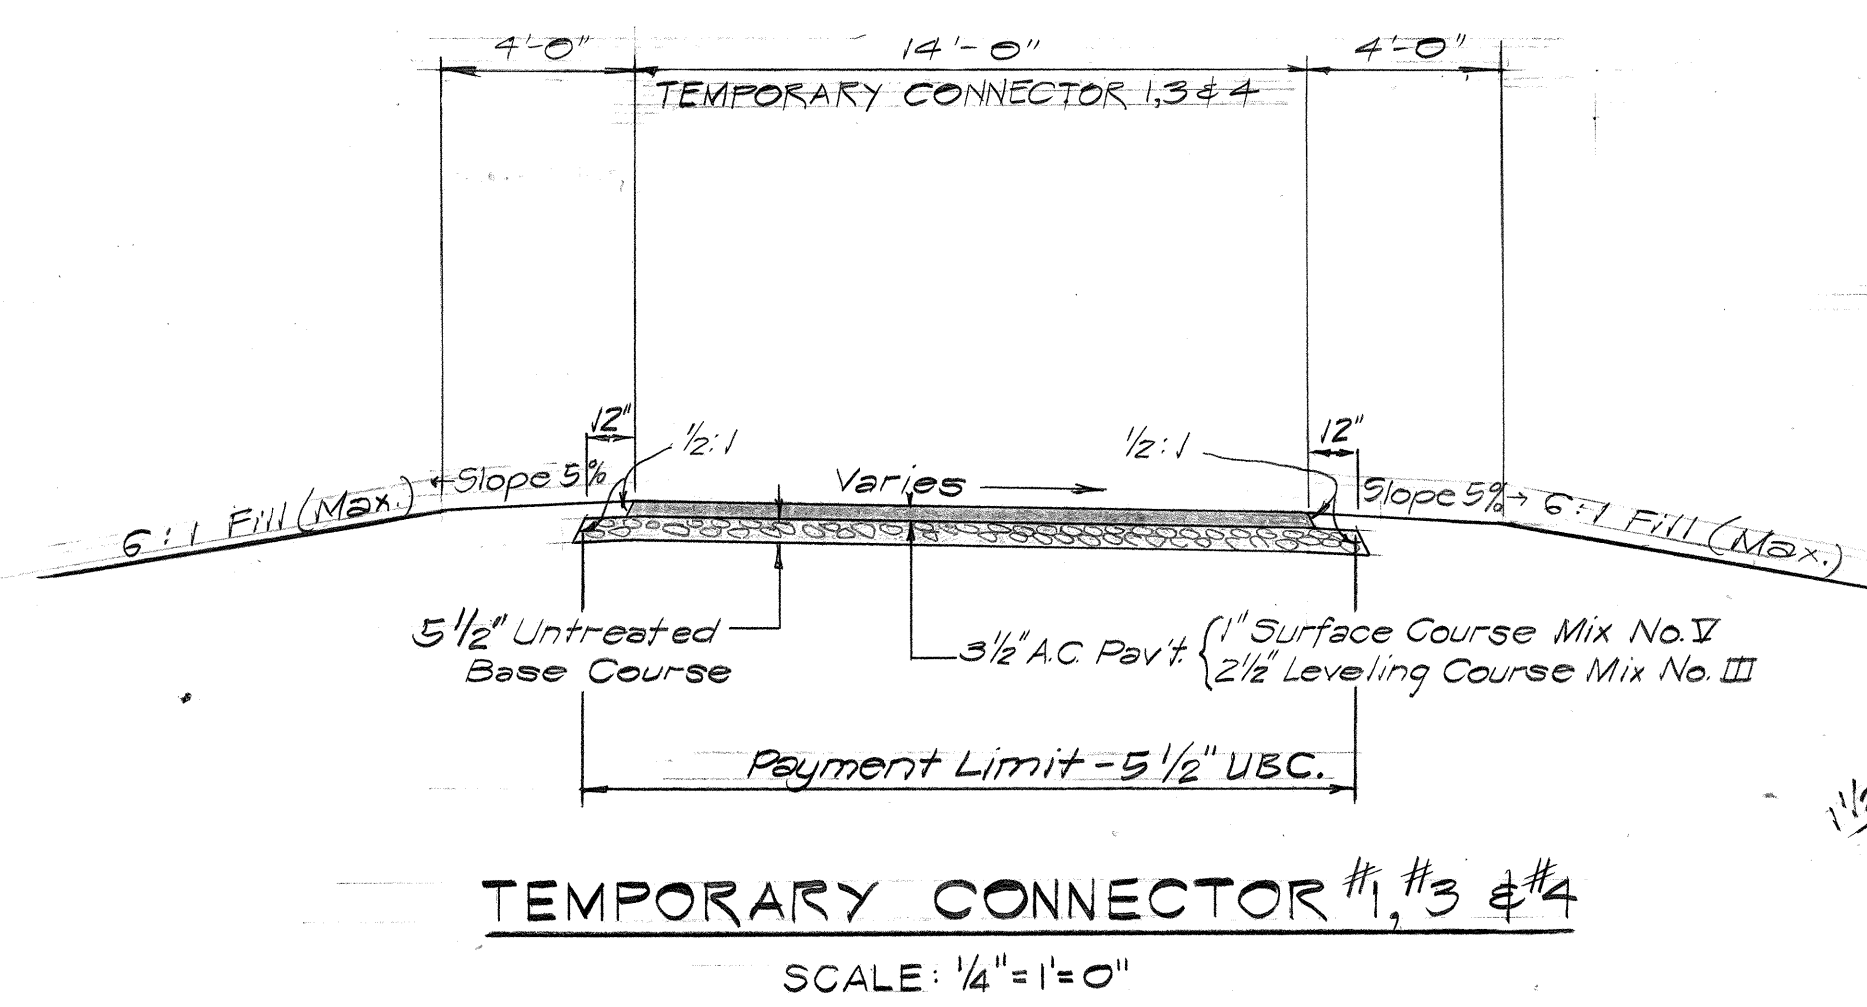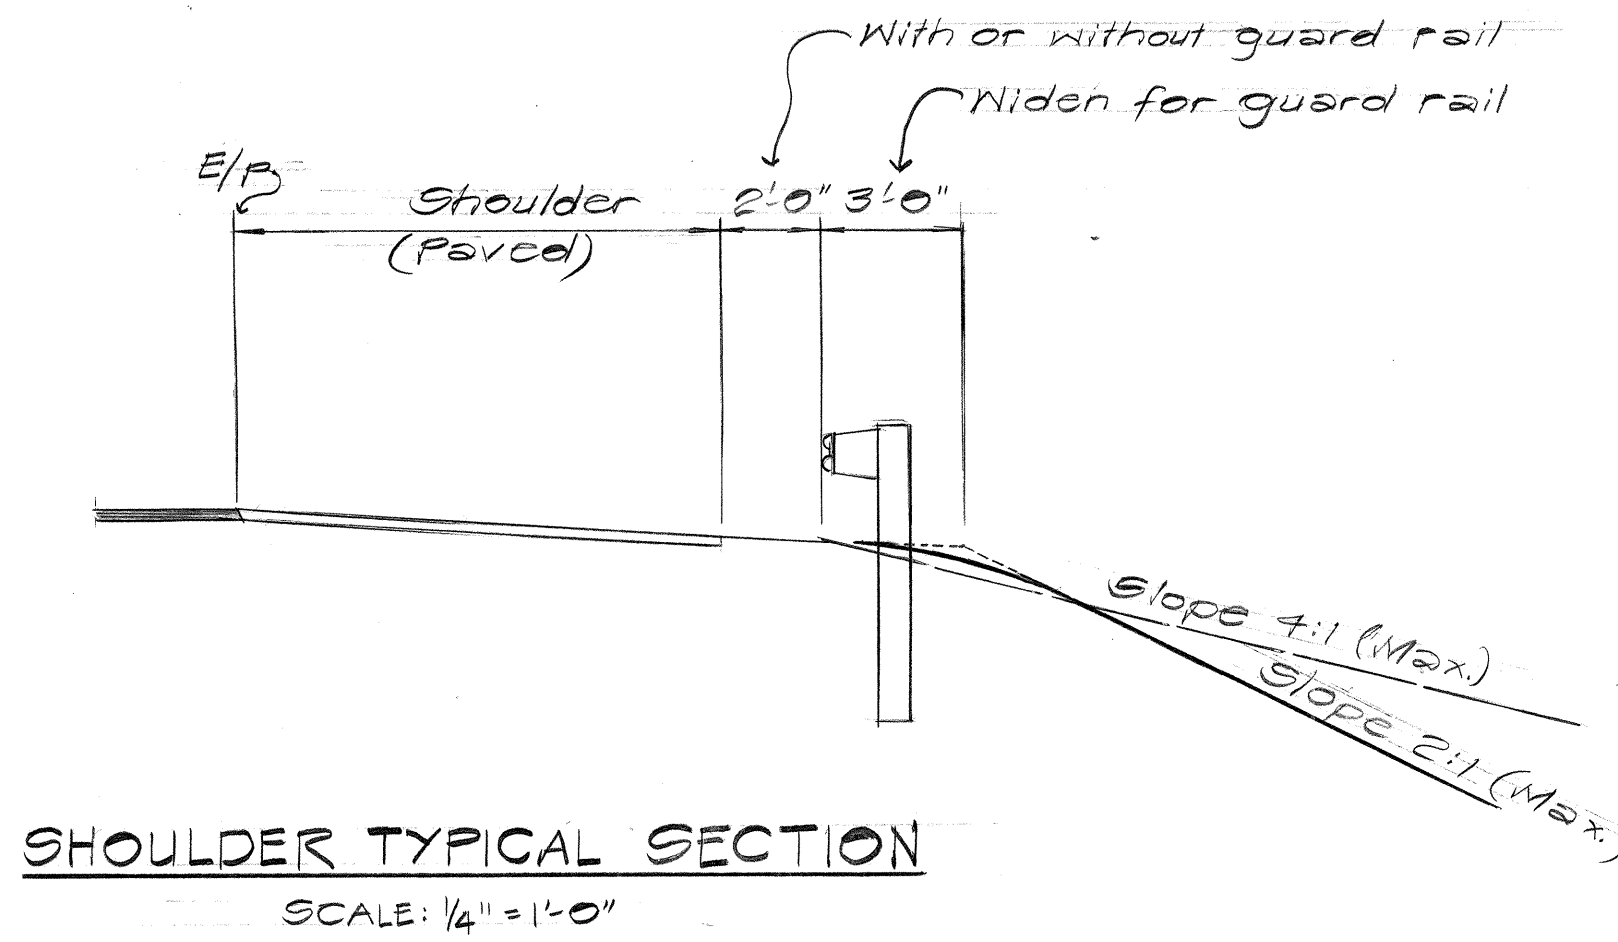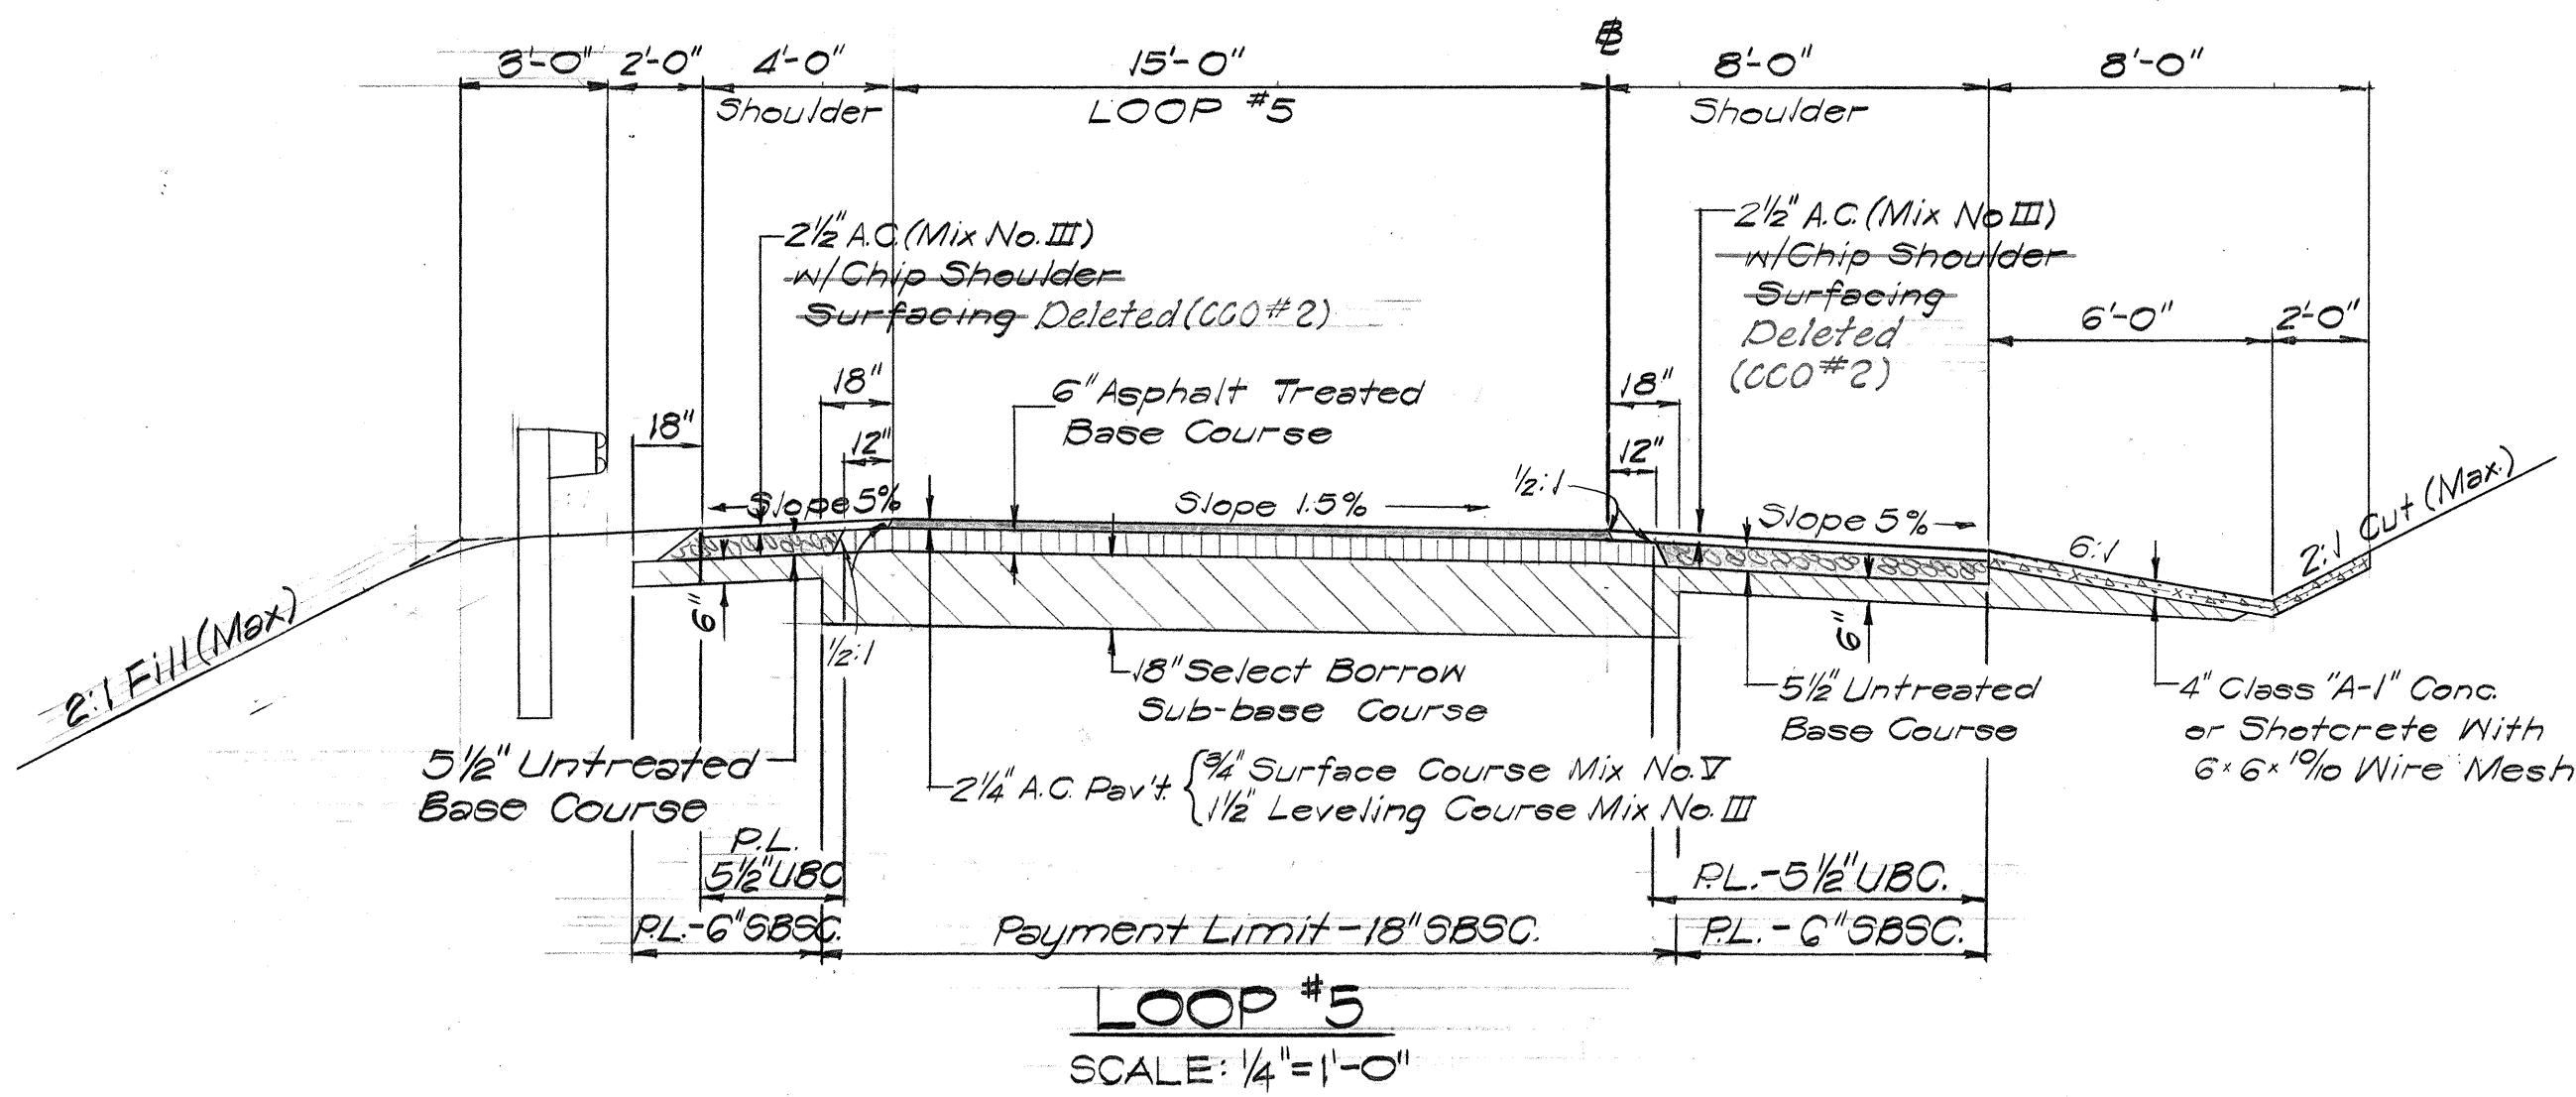

THIS WORK WAS PREPARED BY ME
OR UNDER MY SUPERVISION:
Ben T. C.

STATE OF HAWAII
DEPARTMENT OF TRANSPORTATION
HIGHWAYS DIVISION

TYPICAL ROADWAY SECTIONS

WAIAWA INTERCHANGE
F.A.I. Proj. No. I - H-1 - (169)-8

Scale: As shown Date: OCT. 1968

SHEET No. 2 OF 2 SHEETS

SURVEY PLOTTED BY	DATE
DESIGNED BY	
NOTED BY	
QUANTITIES BY	
CHECKED BY	