

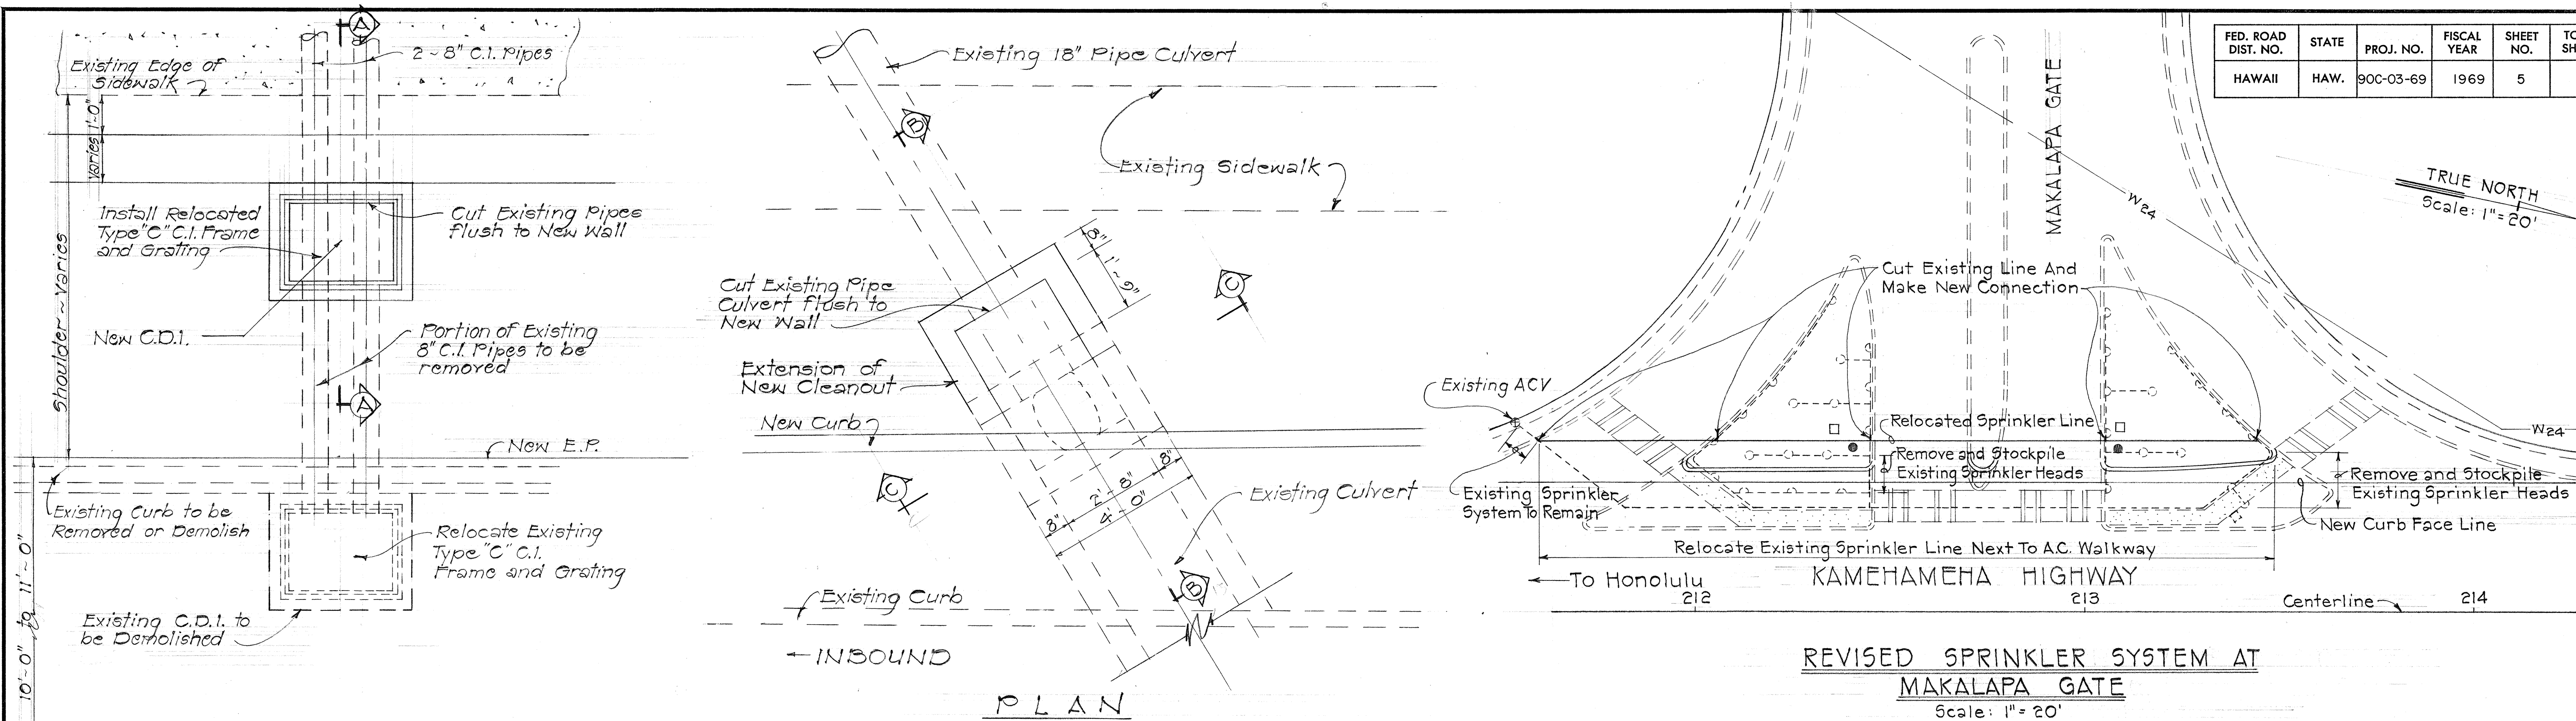


FED. ROAD DIST. NO.	STATE	PROJ. NO.	FISCAL YEAR	SHEET NO.	TOTAL SHEETS
HAWAII	HAW.	90C-03-69	1969	5	11

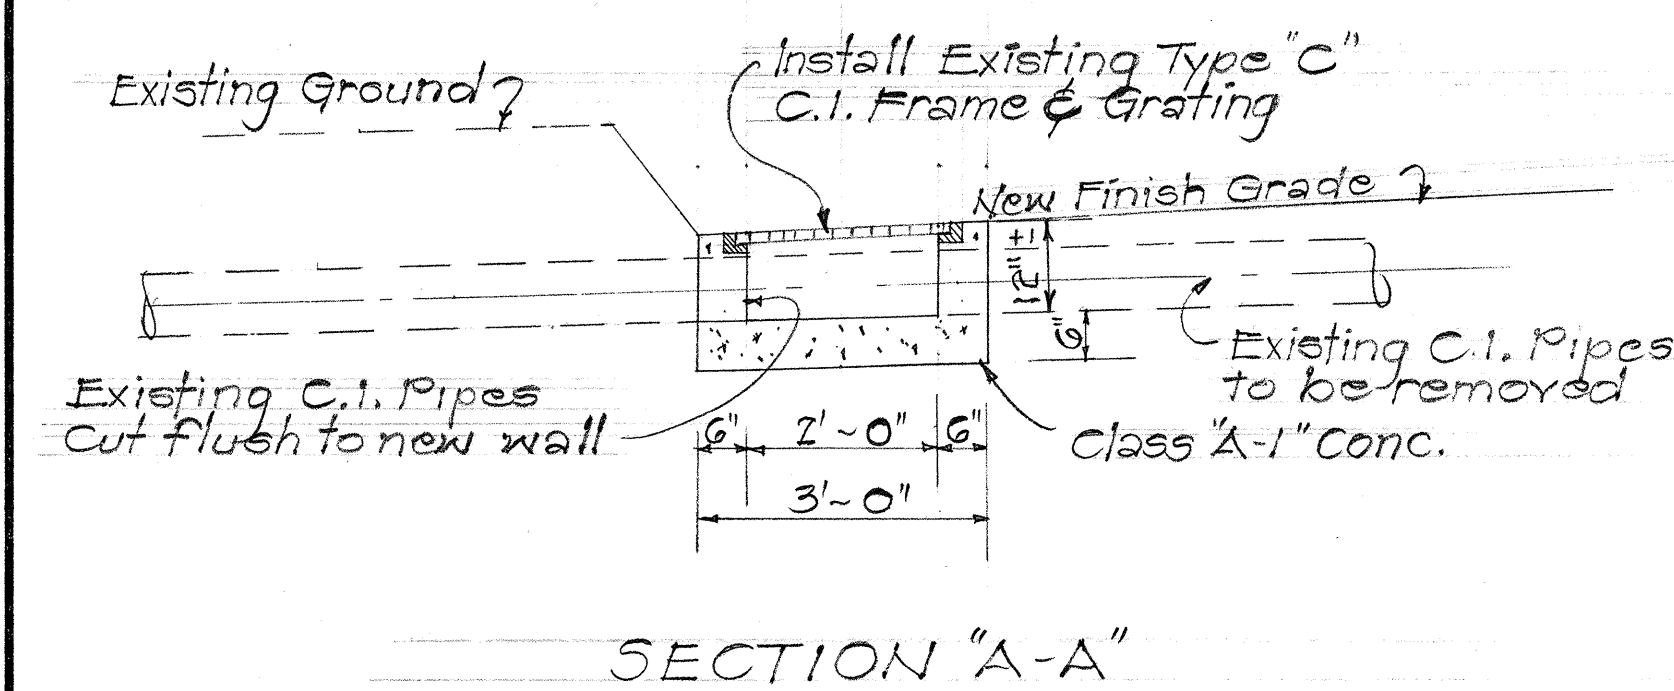


- GENERAL NOTES:
1. The Contractor shall verify all existing utilities prior to relocating the existing sprinkler line.
 2. The Contractor shall be responsible to retain as much landscaping as possible during the relocation of Sprinkler System.


	ESTIMATED QUANTITIES			
	STR. EXC. (C.Y.)	A-1 CONC. (C.Y.)	REINF. (LB.)	RELOCATION OF EXIST. SPRINKLER (L.F.)
CONC. DROP INTAKE (L.S.)	(1.0)	(0.5)	—	—
CONC. CLEAN- OUT (L.S.)	(6.0)	(1.5)	(45)	—
SPRINKLER SYSTEM (L.S.)	—	—	—	(185)

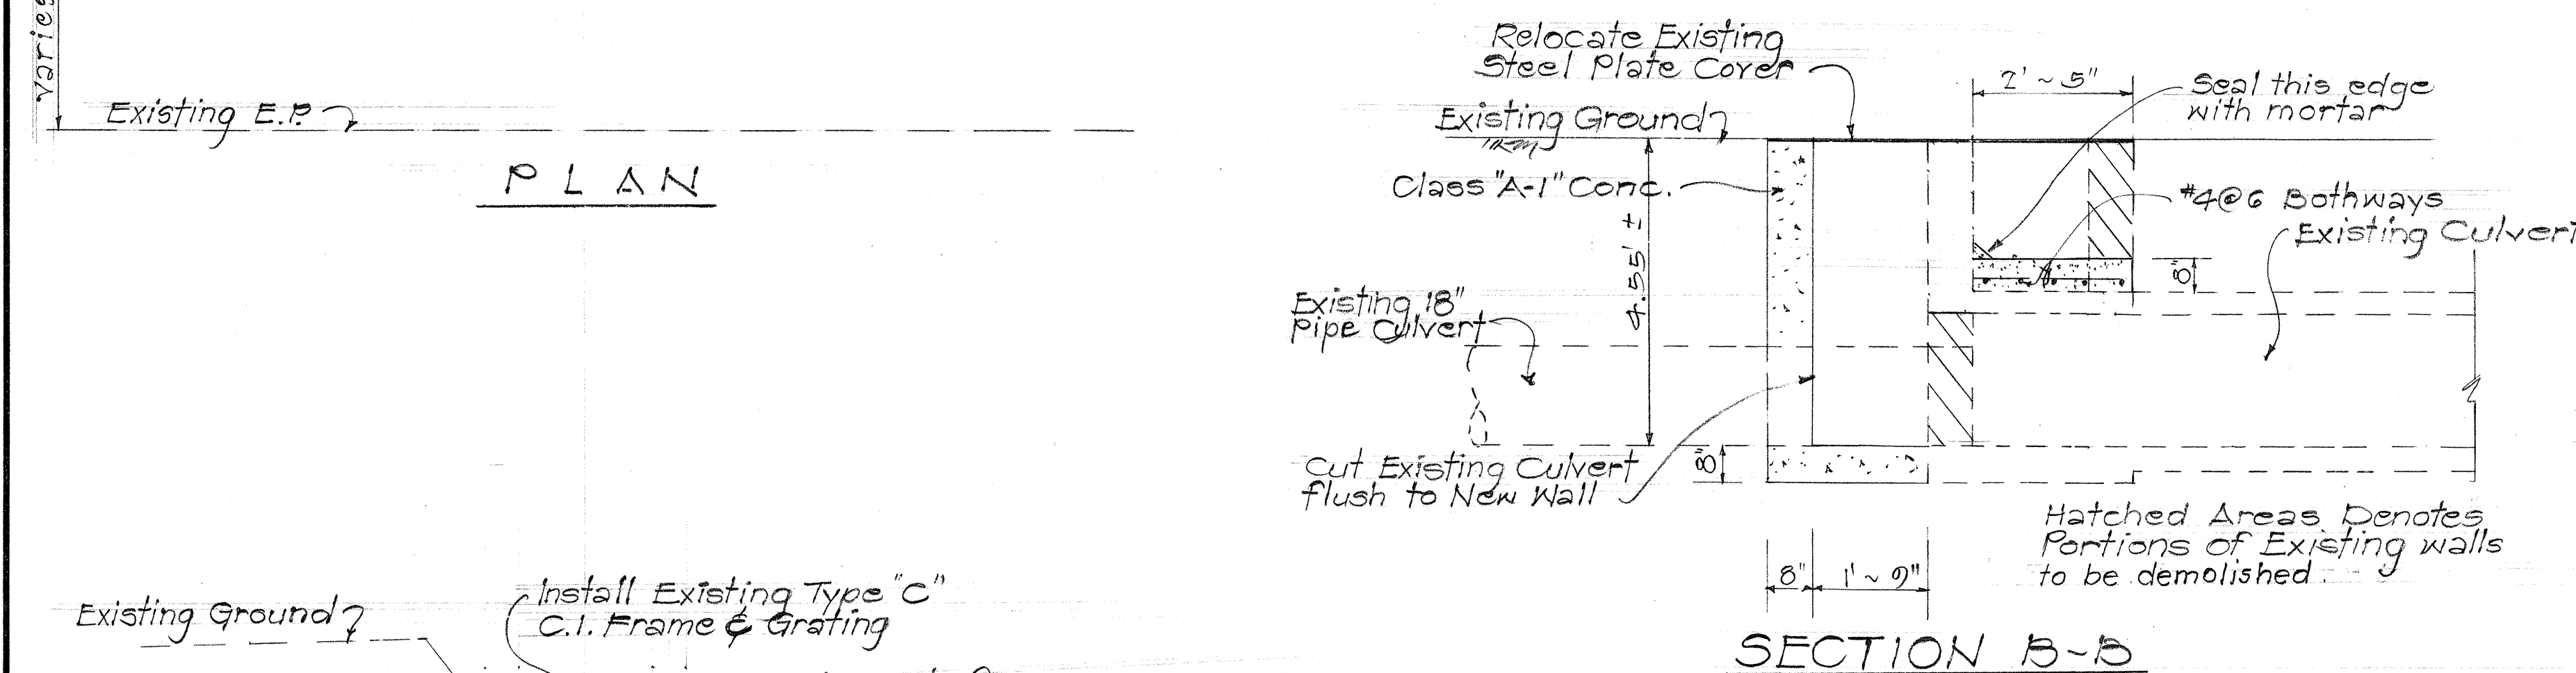

DETAIL OF C.D.I. @ STA. 182+11 (LT.)
Scale: 1/2" = 1'-0"

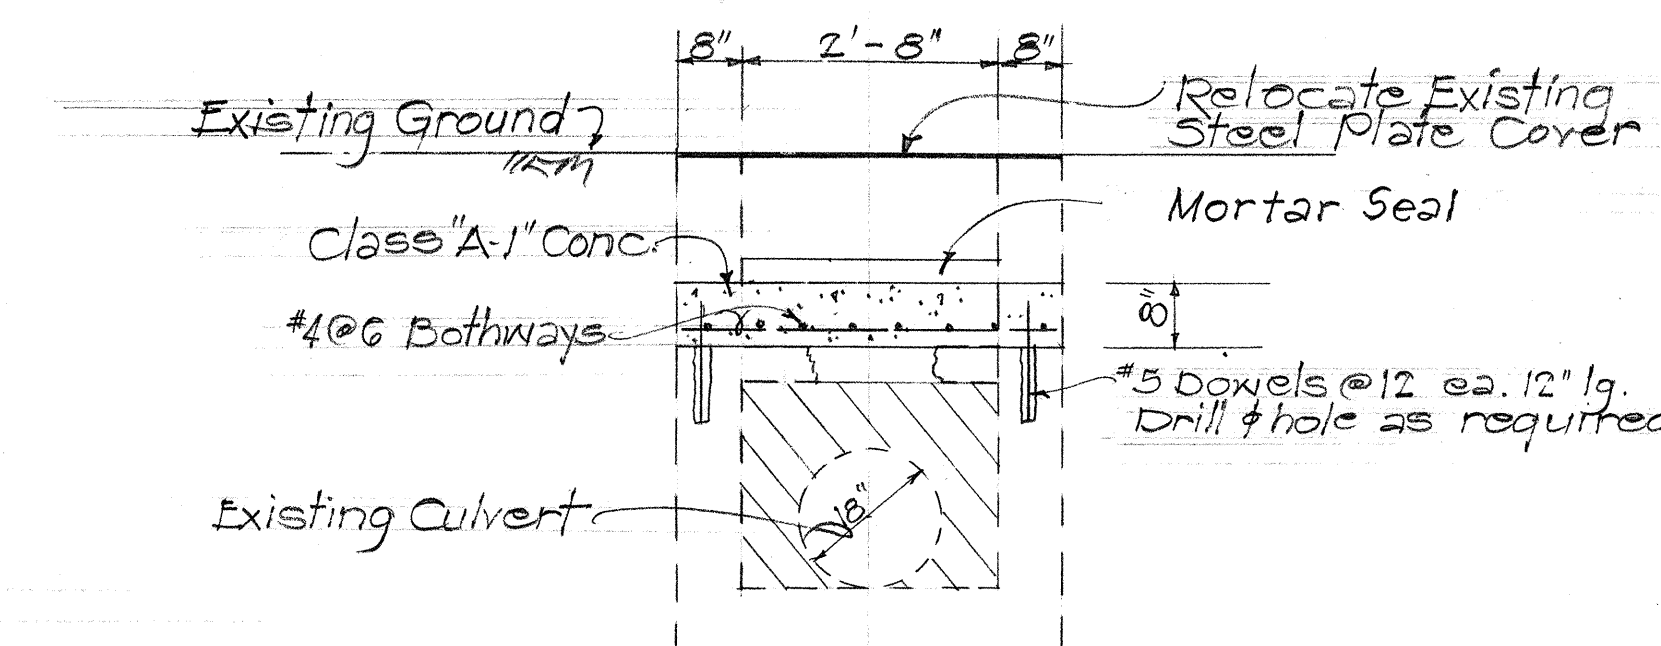

DETAIL OF NEW CLEANOUT @ STA. 194+28 (LT.)
Scale: 1/2" = 1'-0"

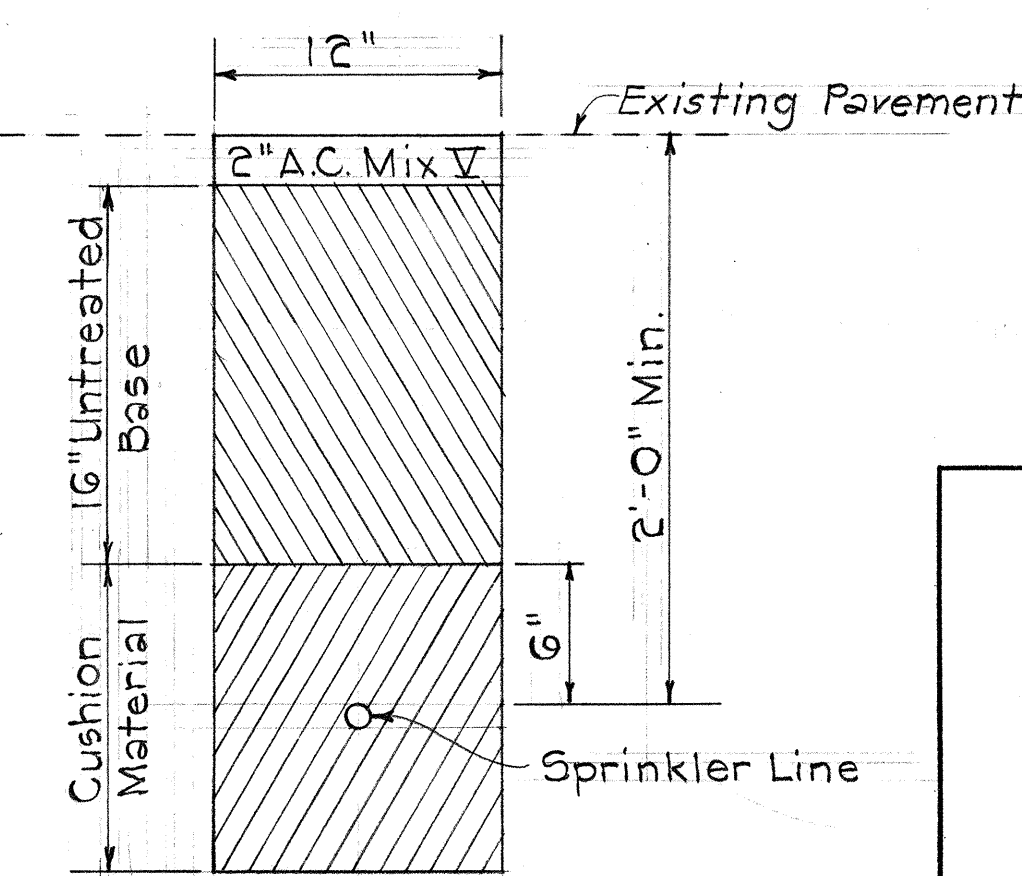

TYPICAL PAVEMENT RESTORATION SECTION
Scale: 1 1/2" = 1'-0"

STATE OF HAWAII

DEPARTMENT OF TRANSPORTATION

HIGHWAYS DIVISION

DRAINAGE AND SPRINKLER

DETAILS

Proj. No. 90C-03-69

Scale: As Shown Date: April, 1969

DD-2-6-7

SURVEY PLOTTED BY	DATE
DRAWN BY	
CHECKED BY	
NOTE BOOK	
No.	