

INDEX TO DRAWINGS	
SHEET NO.	DESCRIPTION
1	TITLE SHEET
2-3	TYPICAL SECTION & PLAN
4	INTERSECTION DETAILS
5	DRAINAGE AND SPRINKLER DETAILS
6-II	STANDARD DETAILS

STATE OF HAWAII

DEPARTMENT OF TRANSPORTATION

HIGHWAYS DIVISION

PLANS OF



KAMEHAMEHA HIGHWAY WIDENING

PEARL HARBOR SPUR TO MAKALAPA GATE

PROJECT NO. 90C-03-69

DISTRICTS OF HONOLULU AND EWA

ISLAND OF OAHU

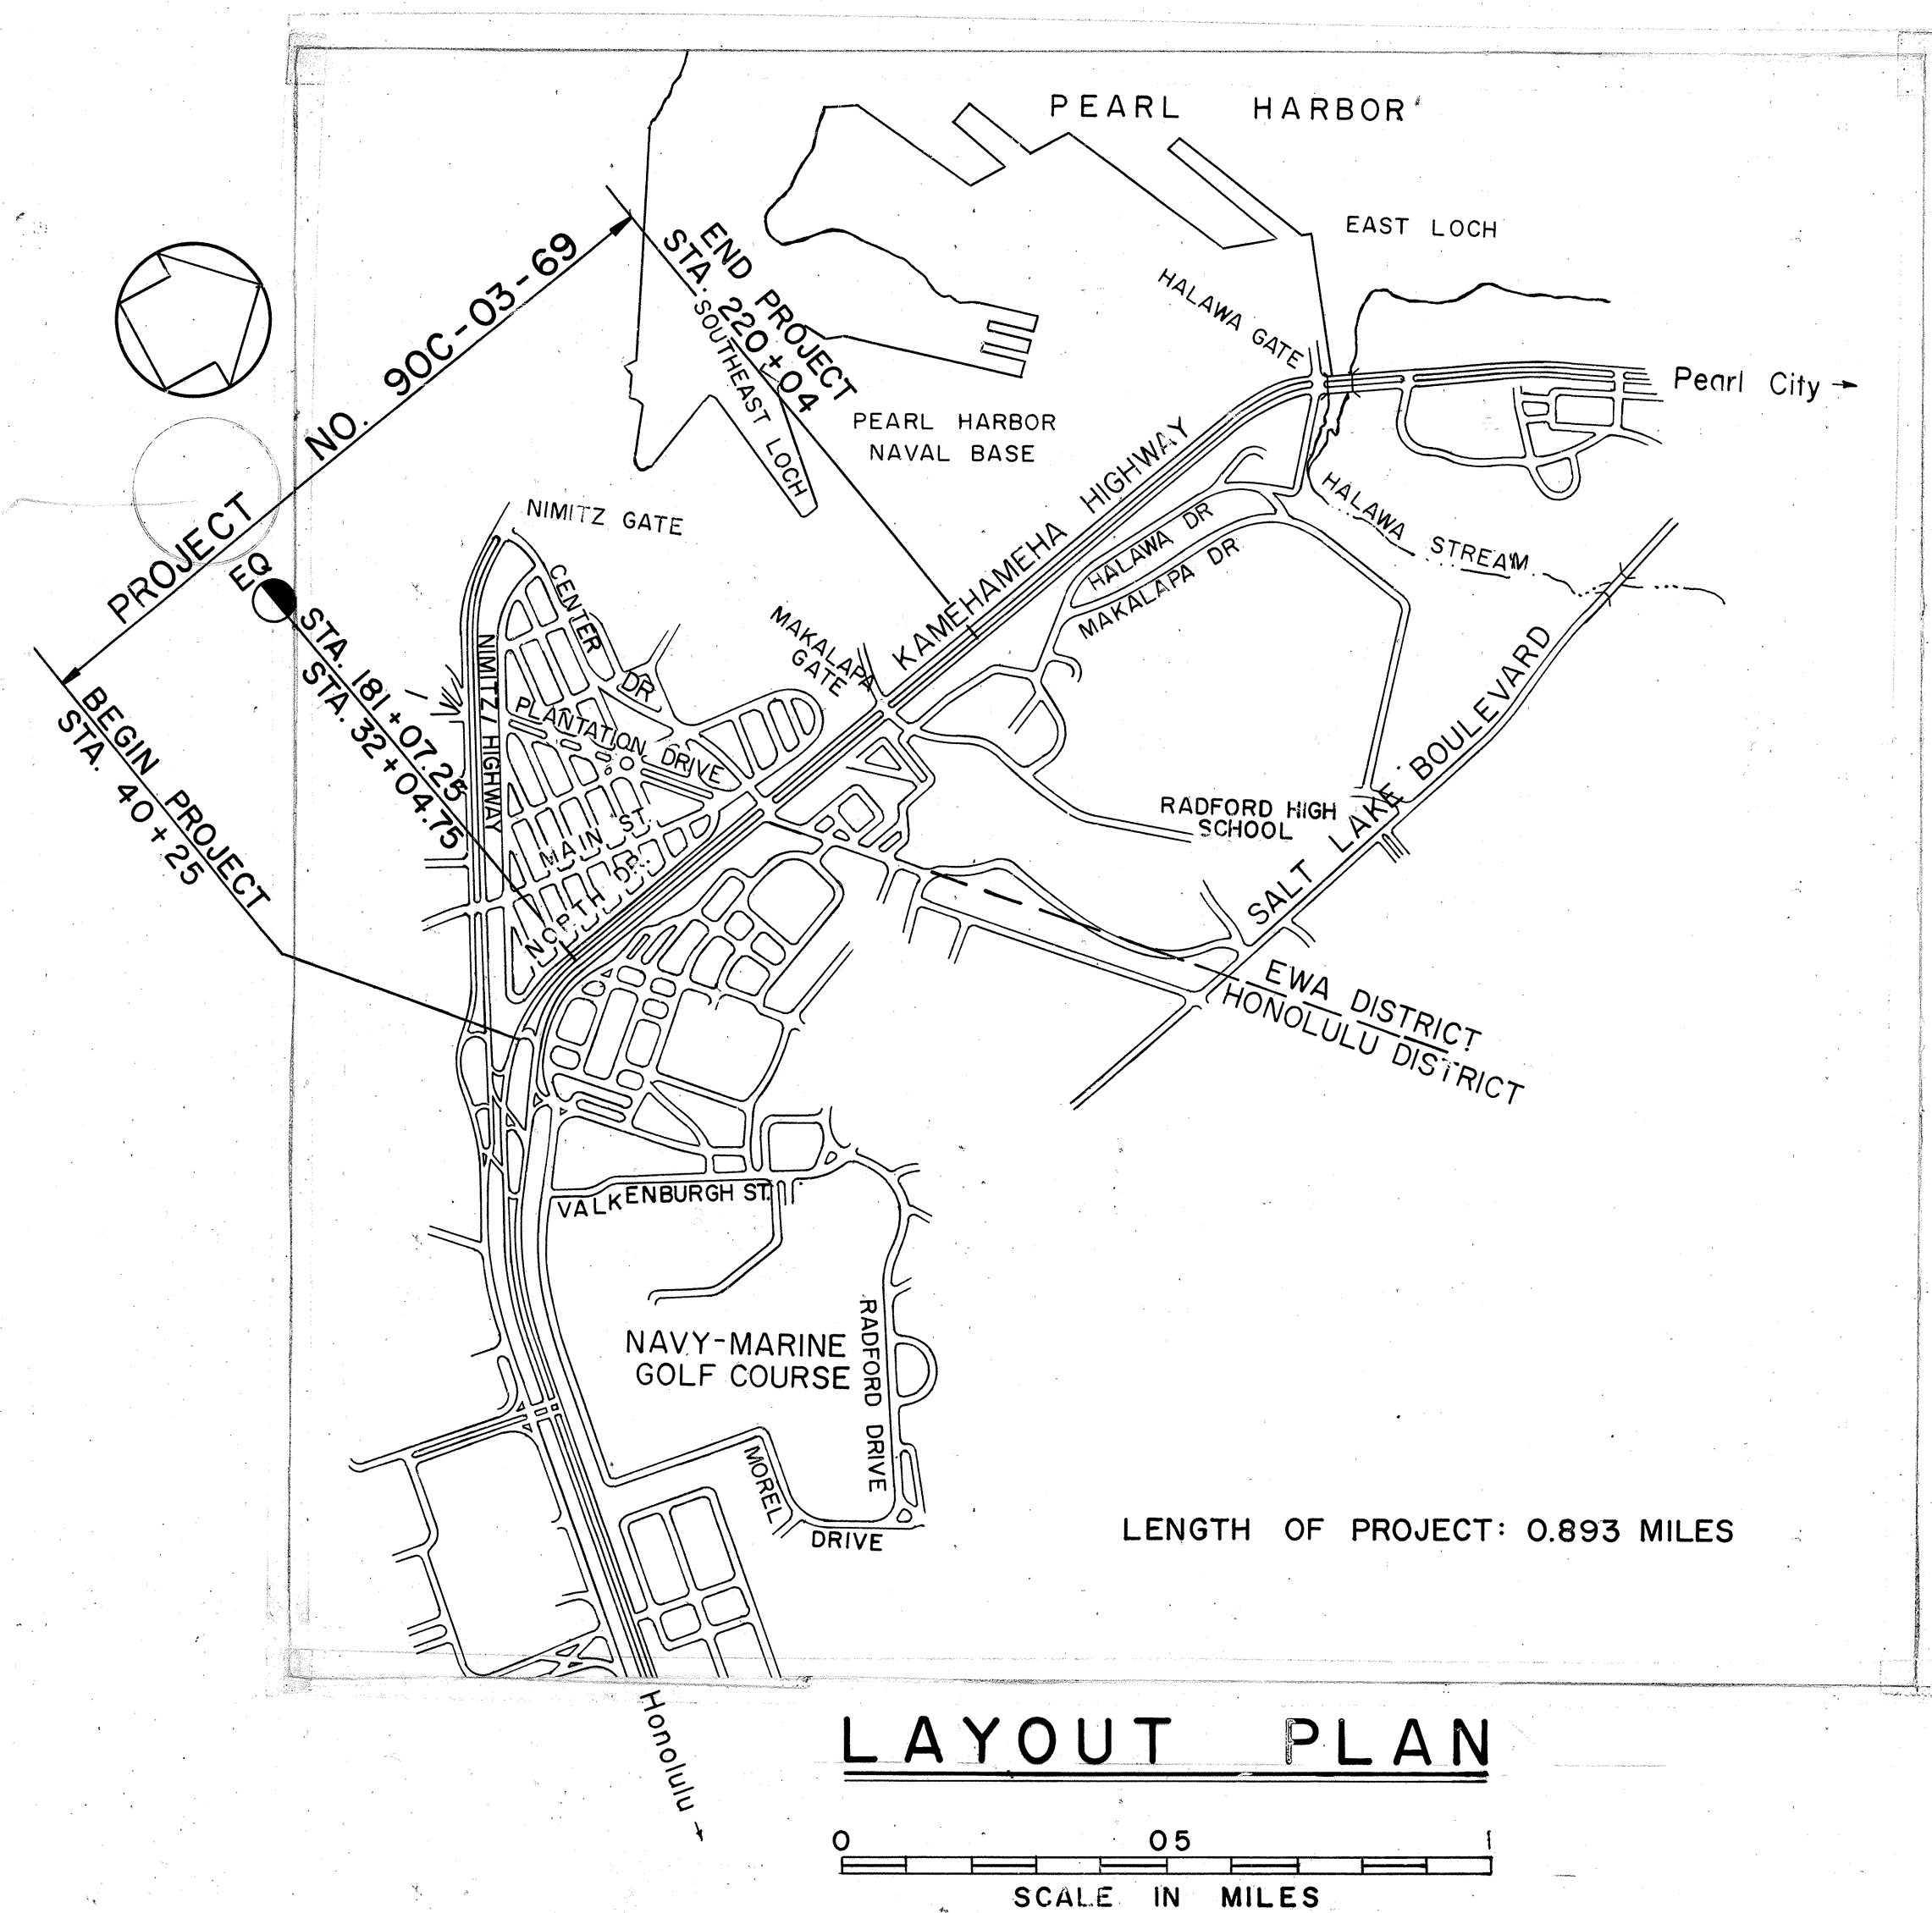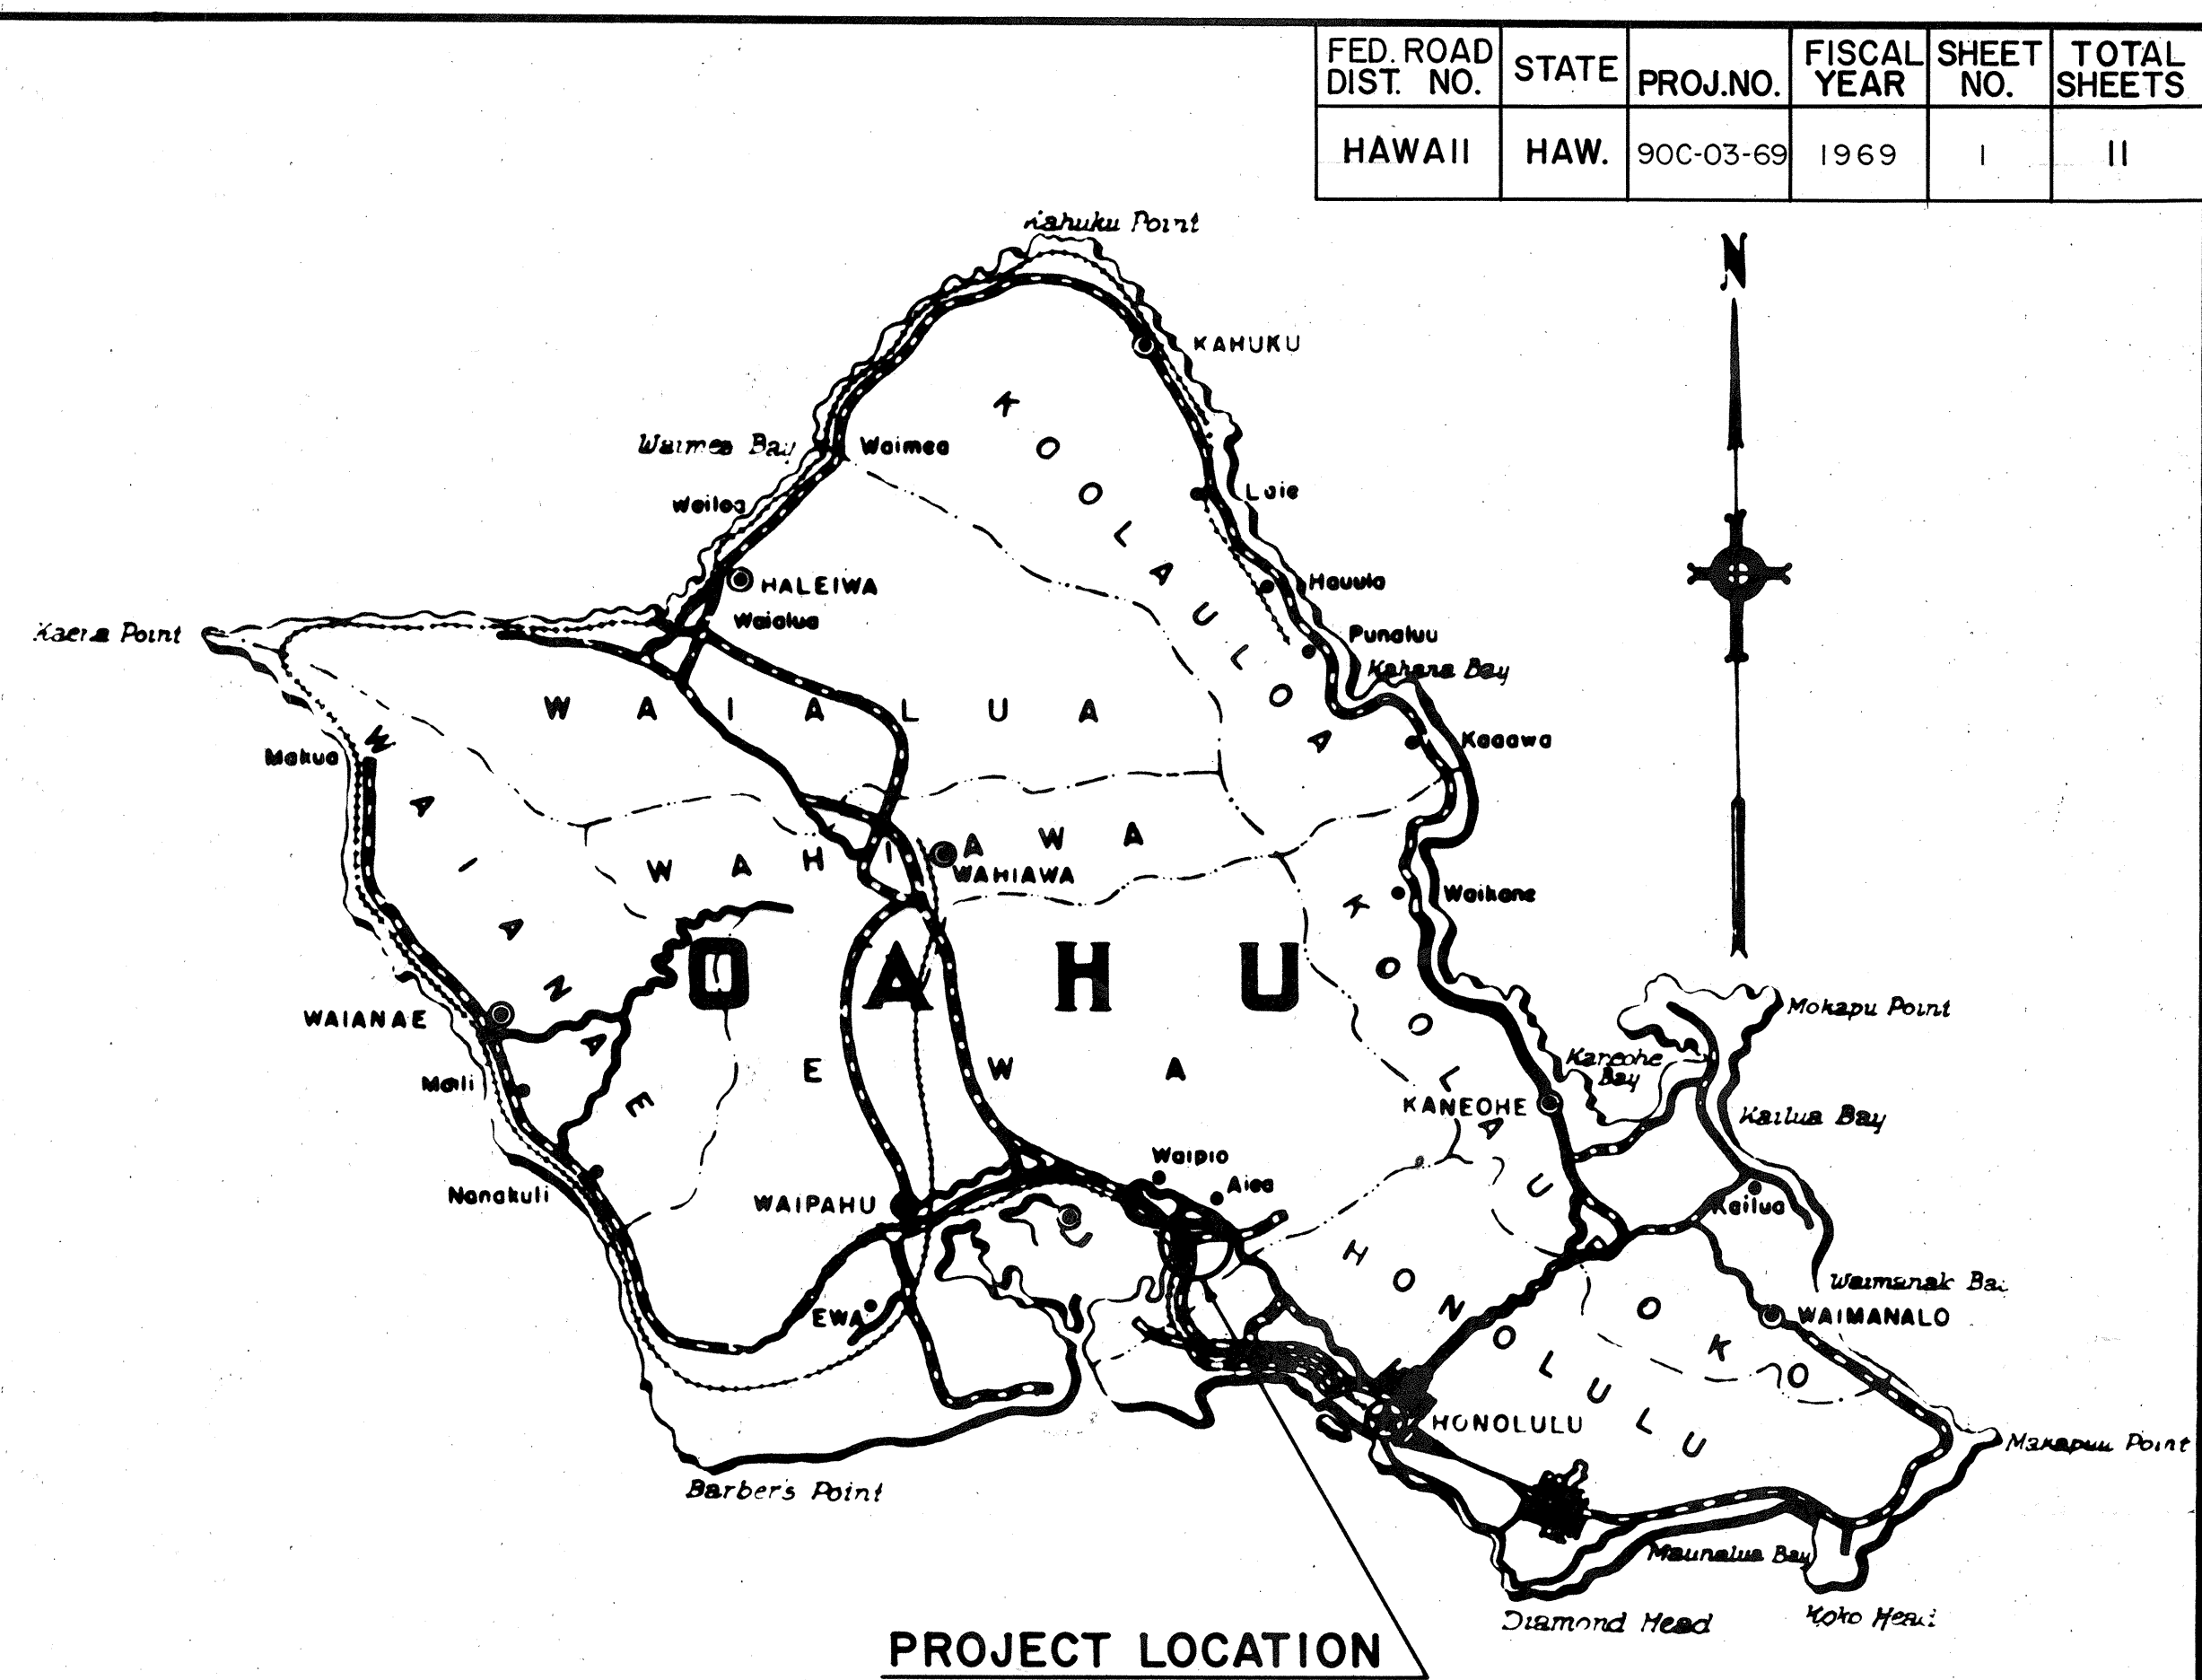

NO AS BUILT CHANGES

DEPARTMENT OF TRANSPORTATION

STATE OF HAWAII

APPROVED:

[Signature]

DIRECTOR OF TRANSPORTATION

DATE

DATE

APR 1969

SURVEY PLOTTED BY

R. MIKAMI

DRAWN BY

QUANTITIES CHECKED BY

NOTED

NOTED