
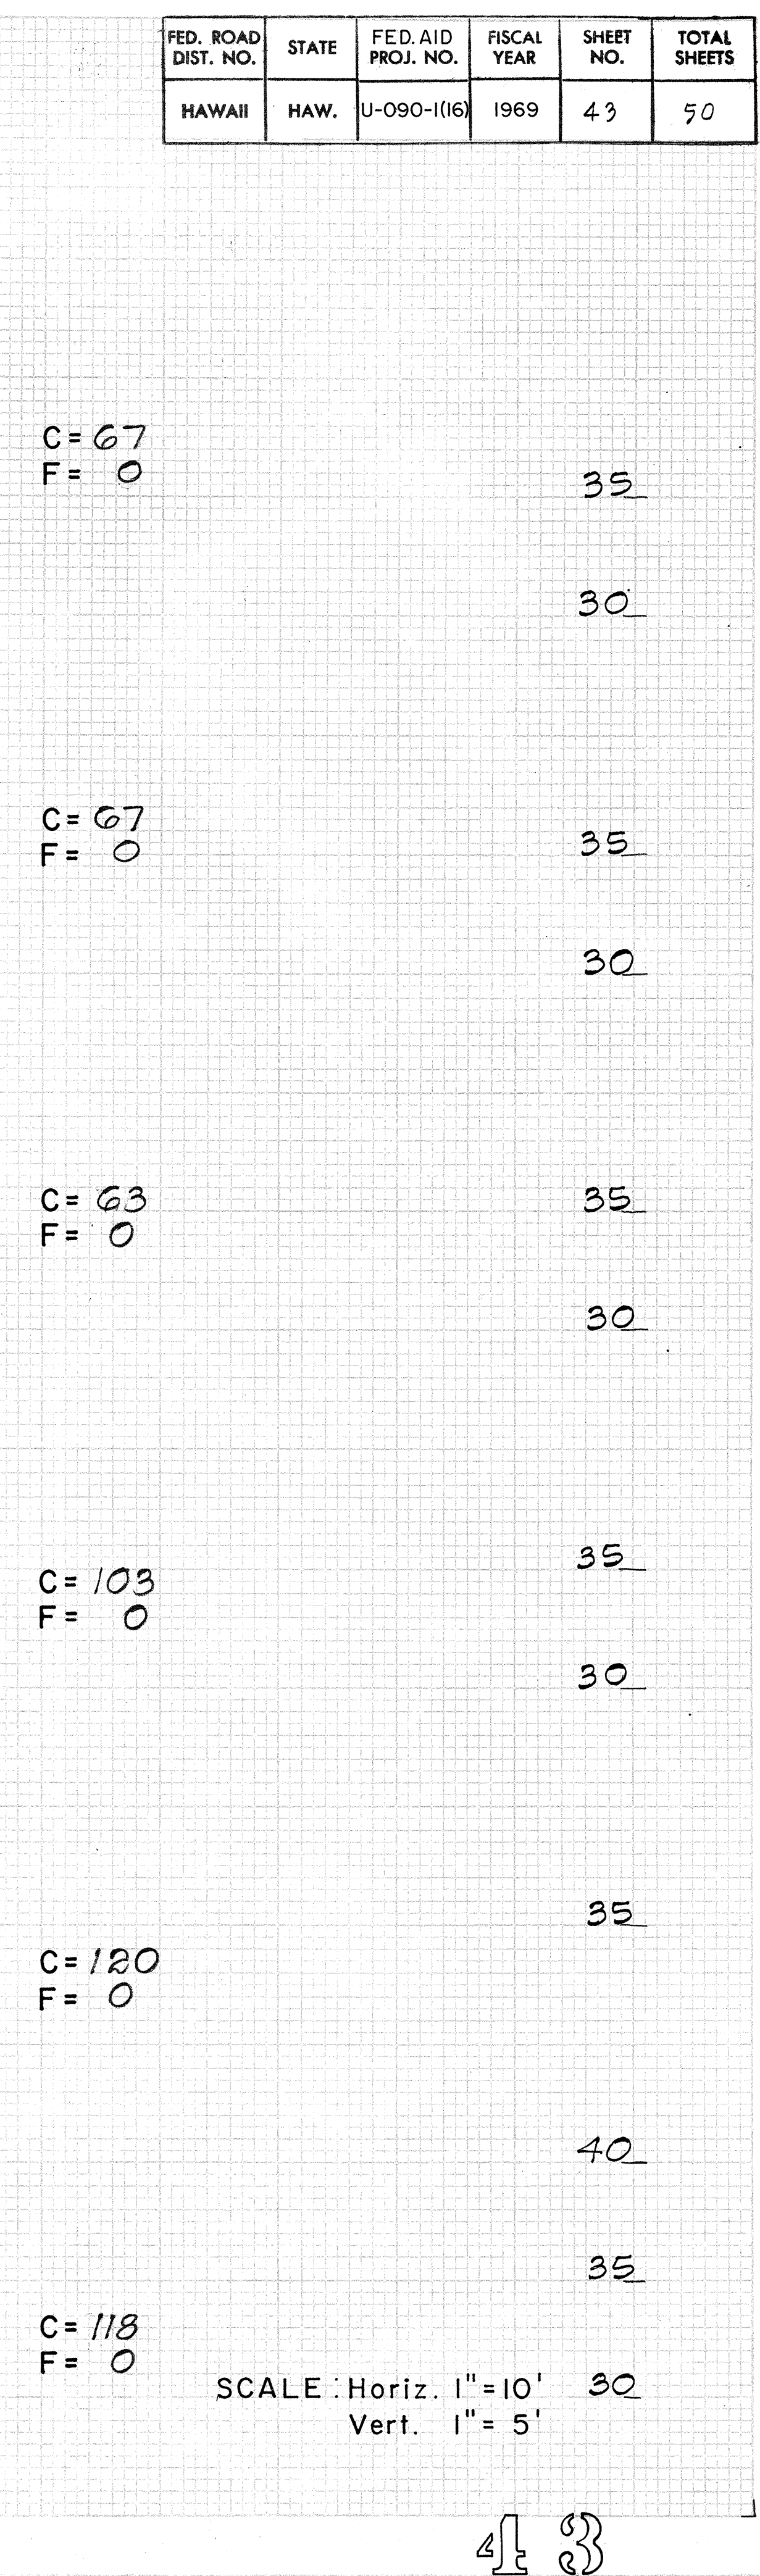
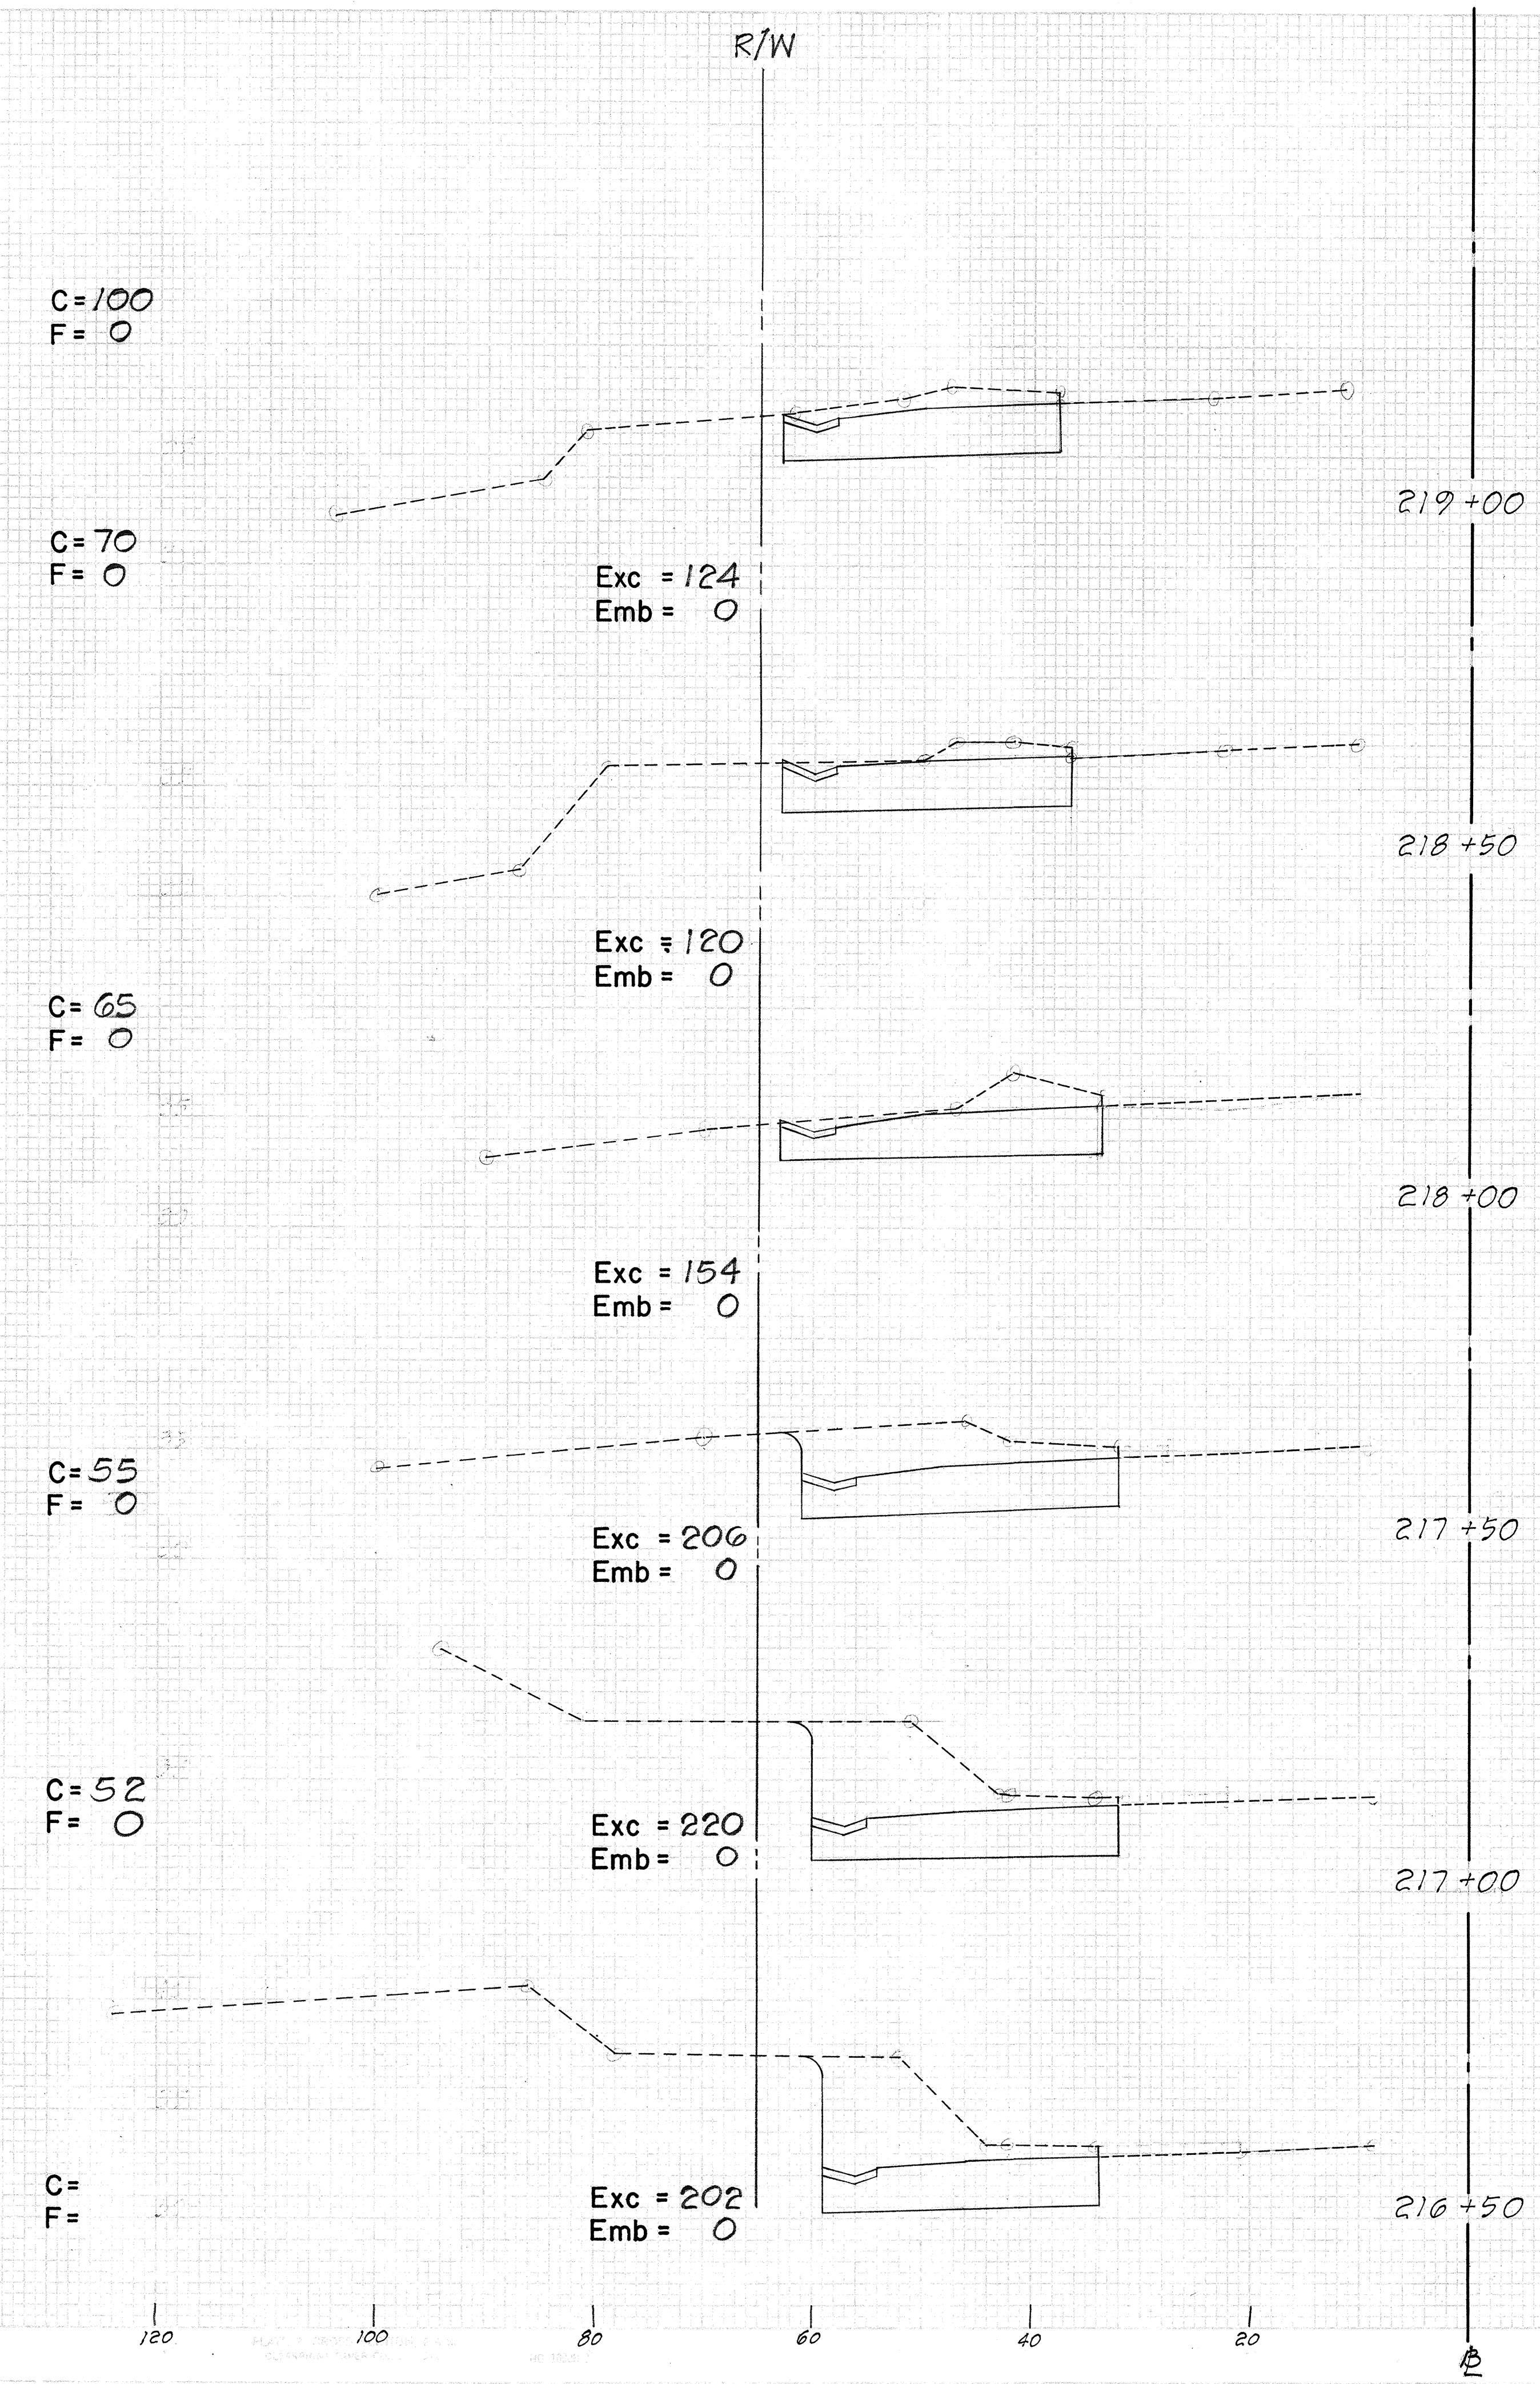


FED. ROAD DIST. NO.	STATE	FED. AID PROJ. NO.	FISCAL YEAR	SHEET NO.	TOTAL SHEETS
HAWAII	HAW.	U-090-1(16)	1969	43	50

ORIGINAL
 SURVEY
 PLANNING
 DESIGN
 CONSTRUCTION
 RECORDS
 DATE
 BY
 CHECKED
 DATE
 BY

ORIGINAL
 SURVEY
 PLANNING
 DESIGN
 CONSTRUCTION
 RECORDS
 DATE
 BY
 CHECKED
 DATE
 BY


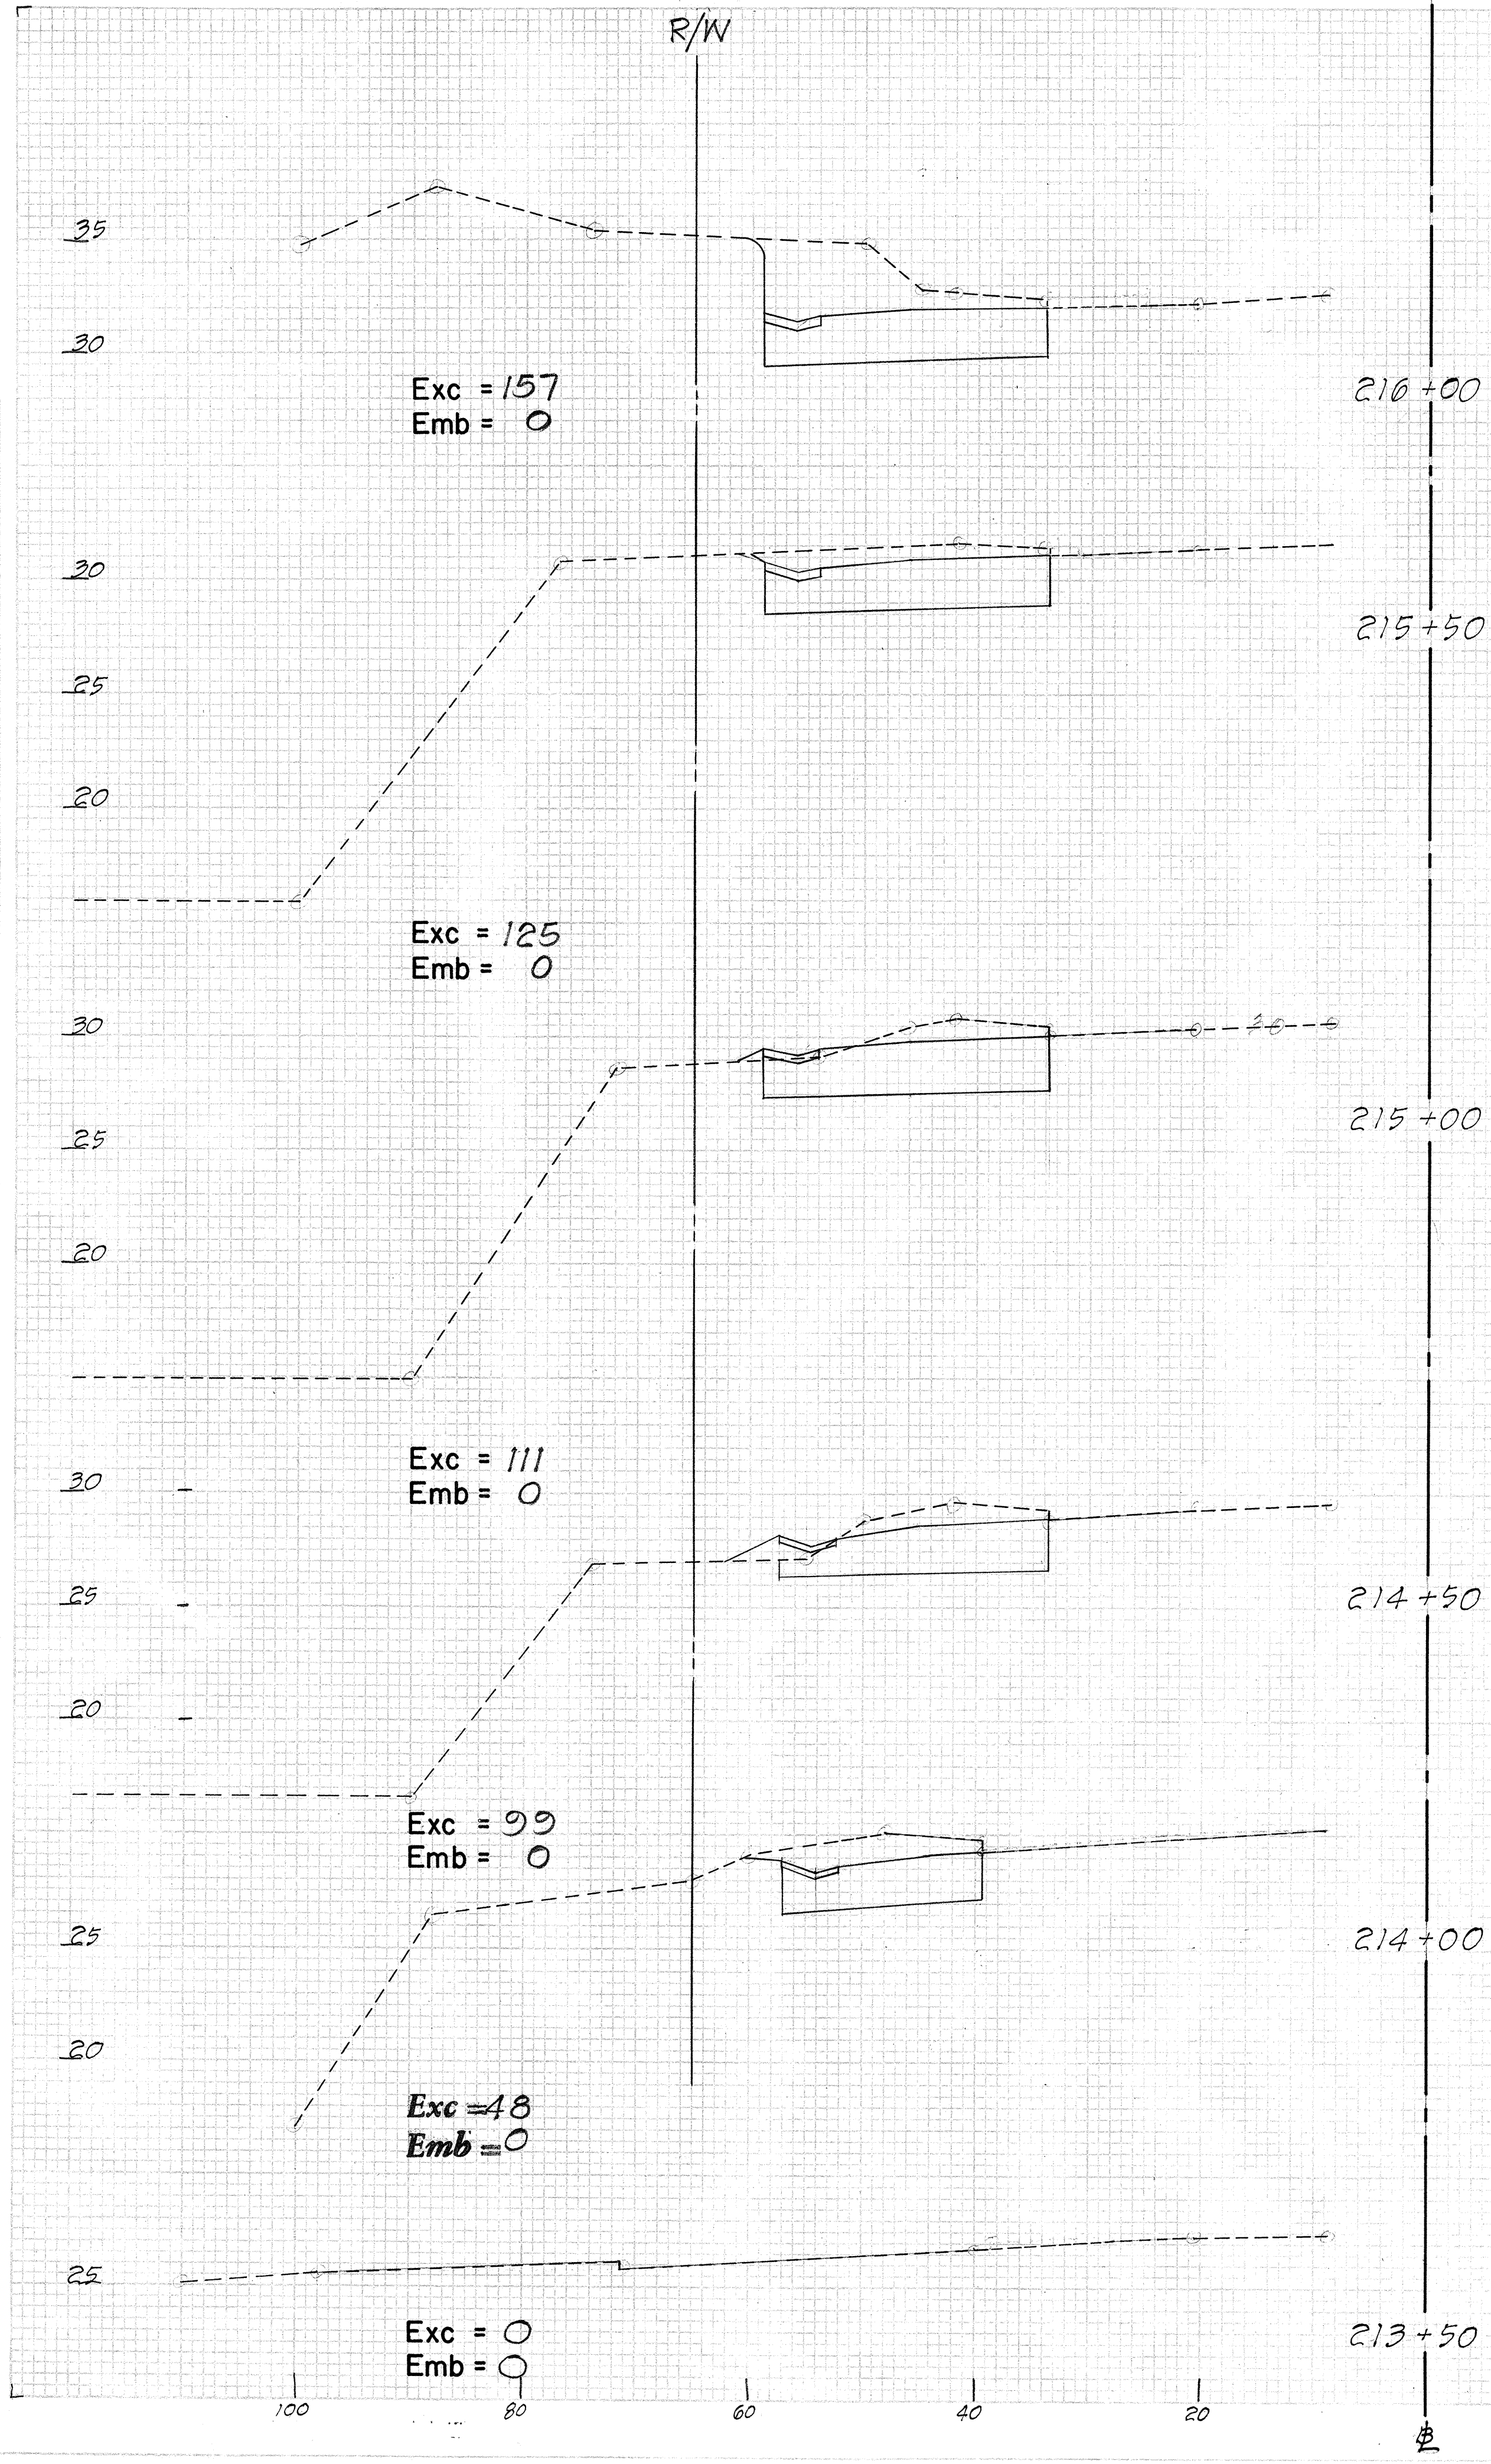


SCALE: Horiz. 1"=10'
 Vert. 1"=5'

FED. ROAD DIST. NO.	STATE	FED. AID PROJ. NO.	FISCAL YEAR	SHEET NO.	TOTAL SHEETS
HAWAII	HAW.	U-090-1(16)	1969	44	50

DATE	NO.
DESIGNED	
PLANNED	
NOTED	
AREA	

DATE	NO.
DESIGNED	
PLANNED	
NOTED	
AREA	

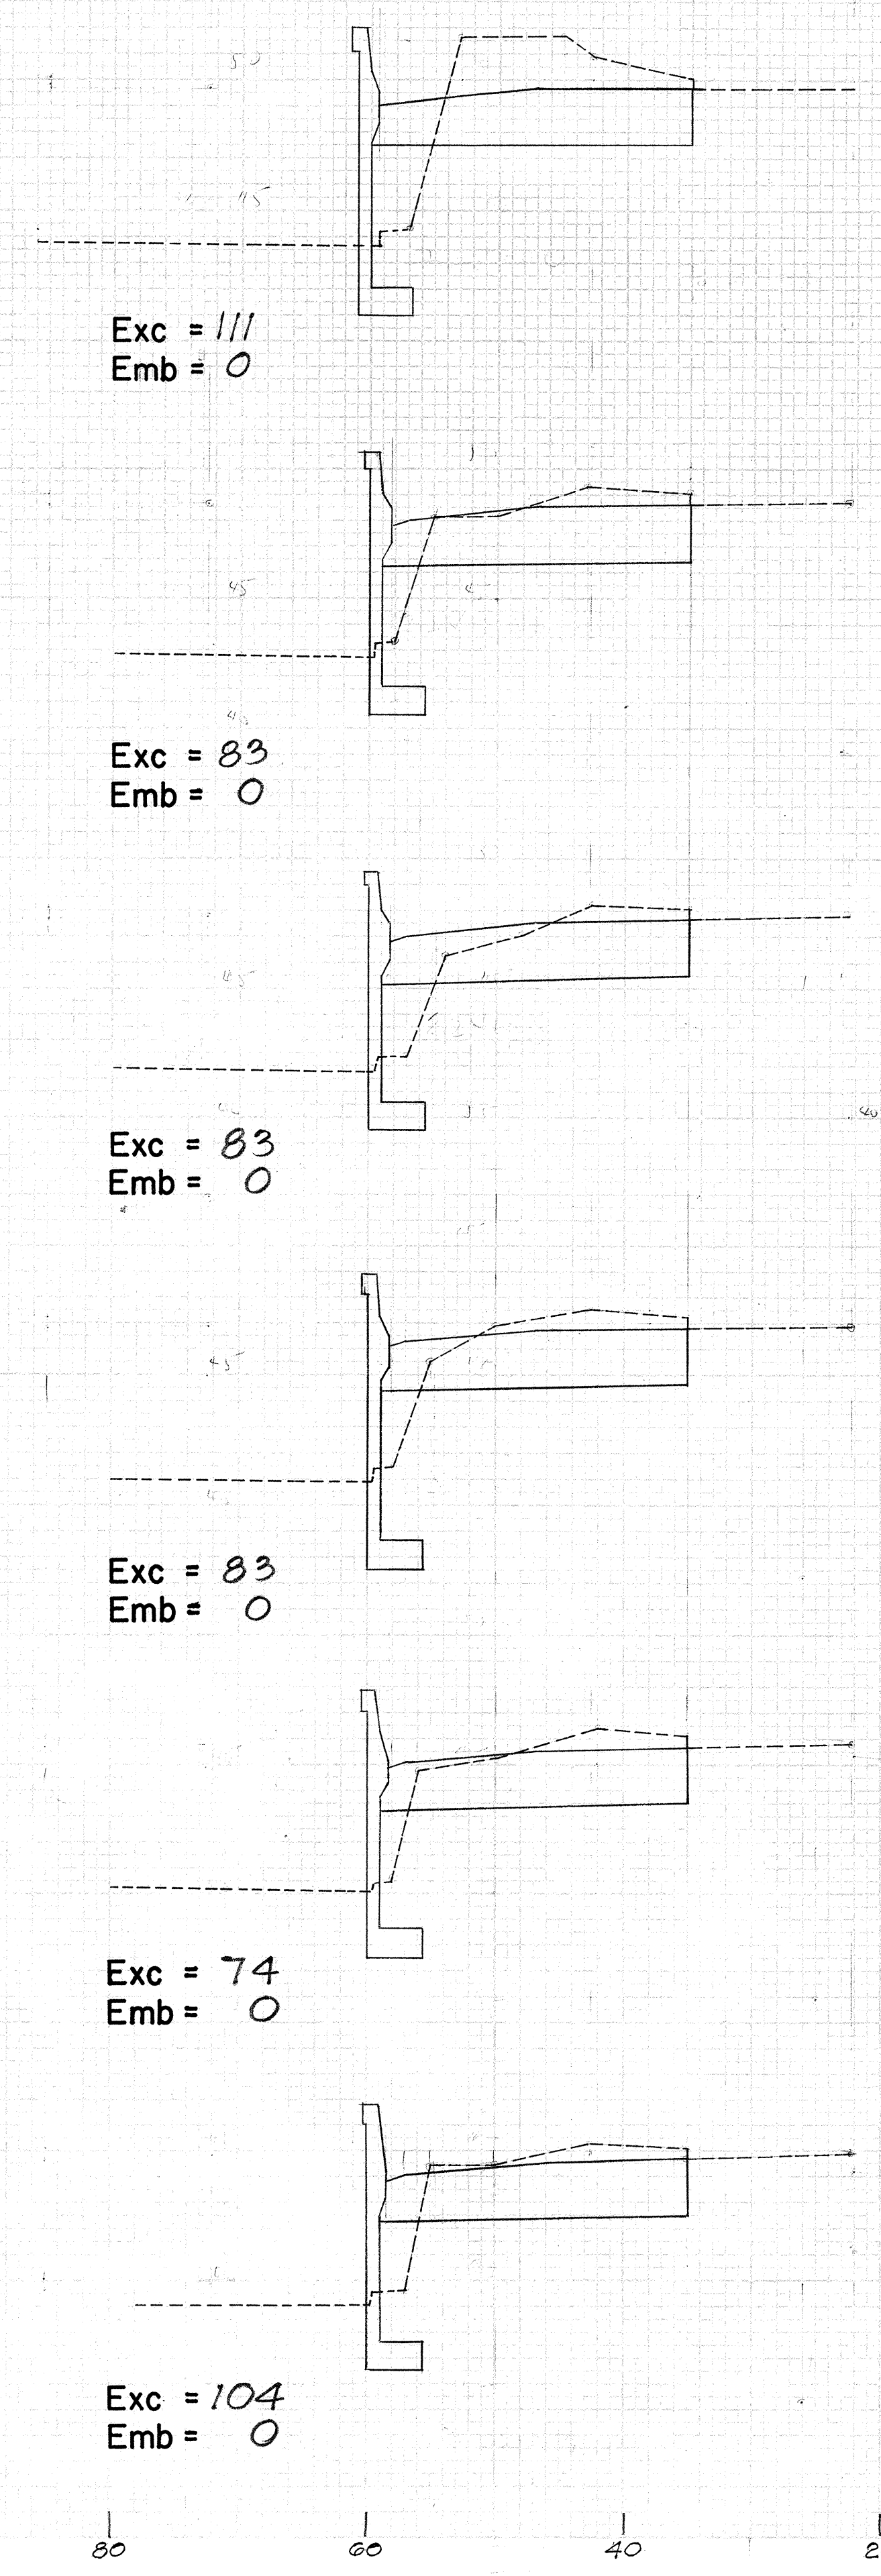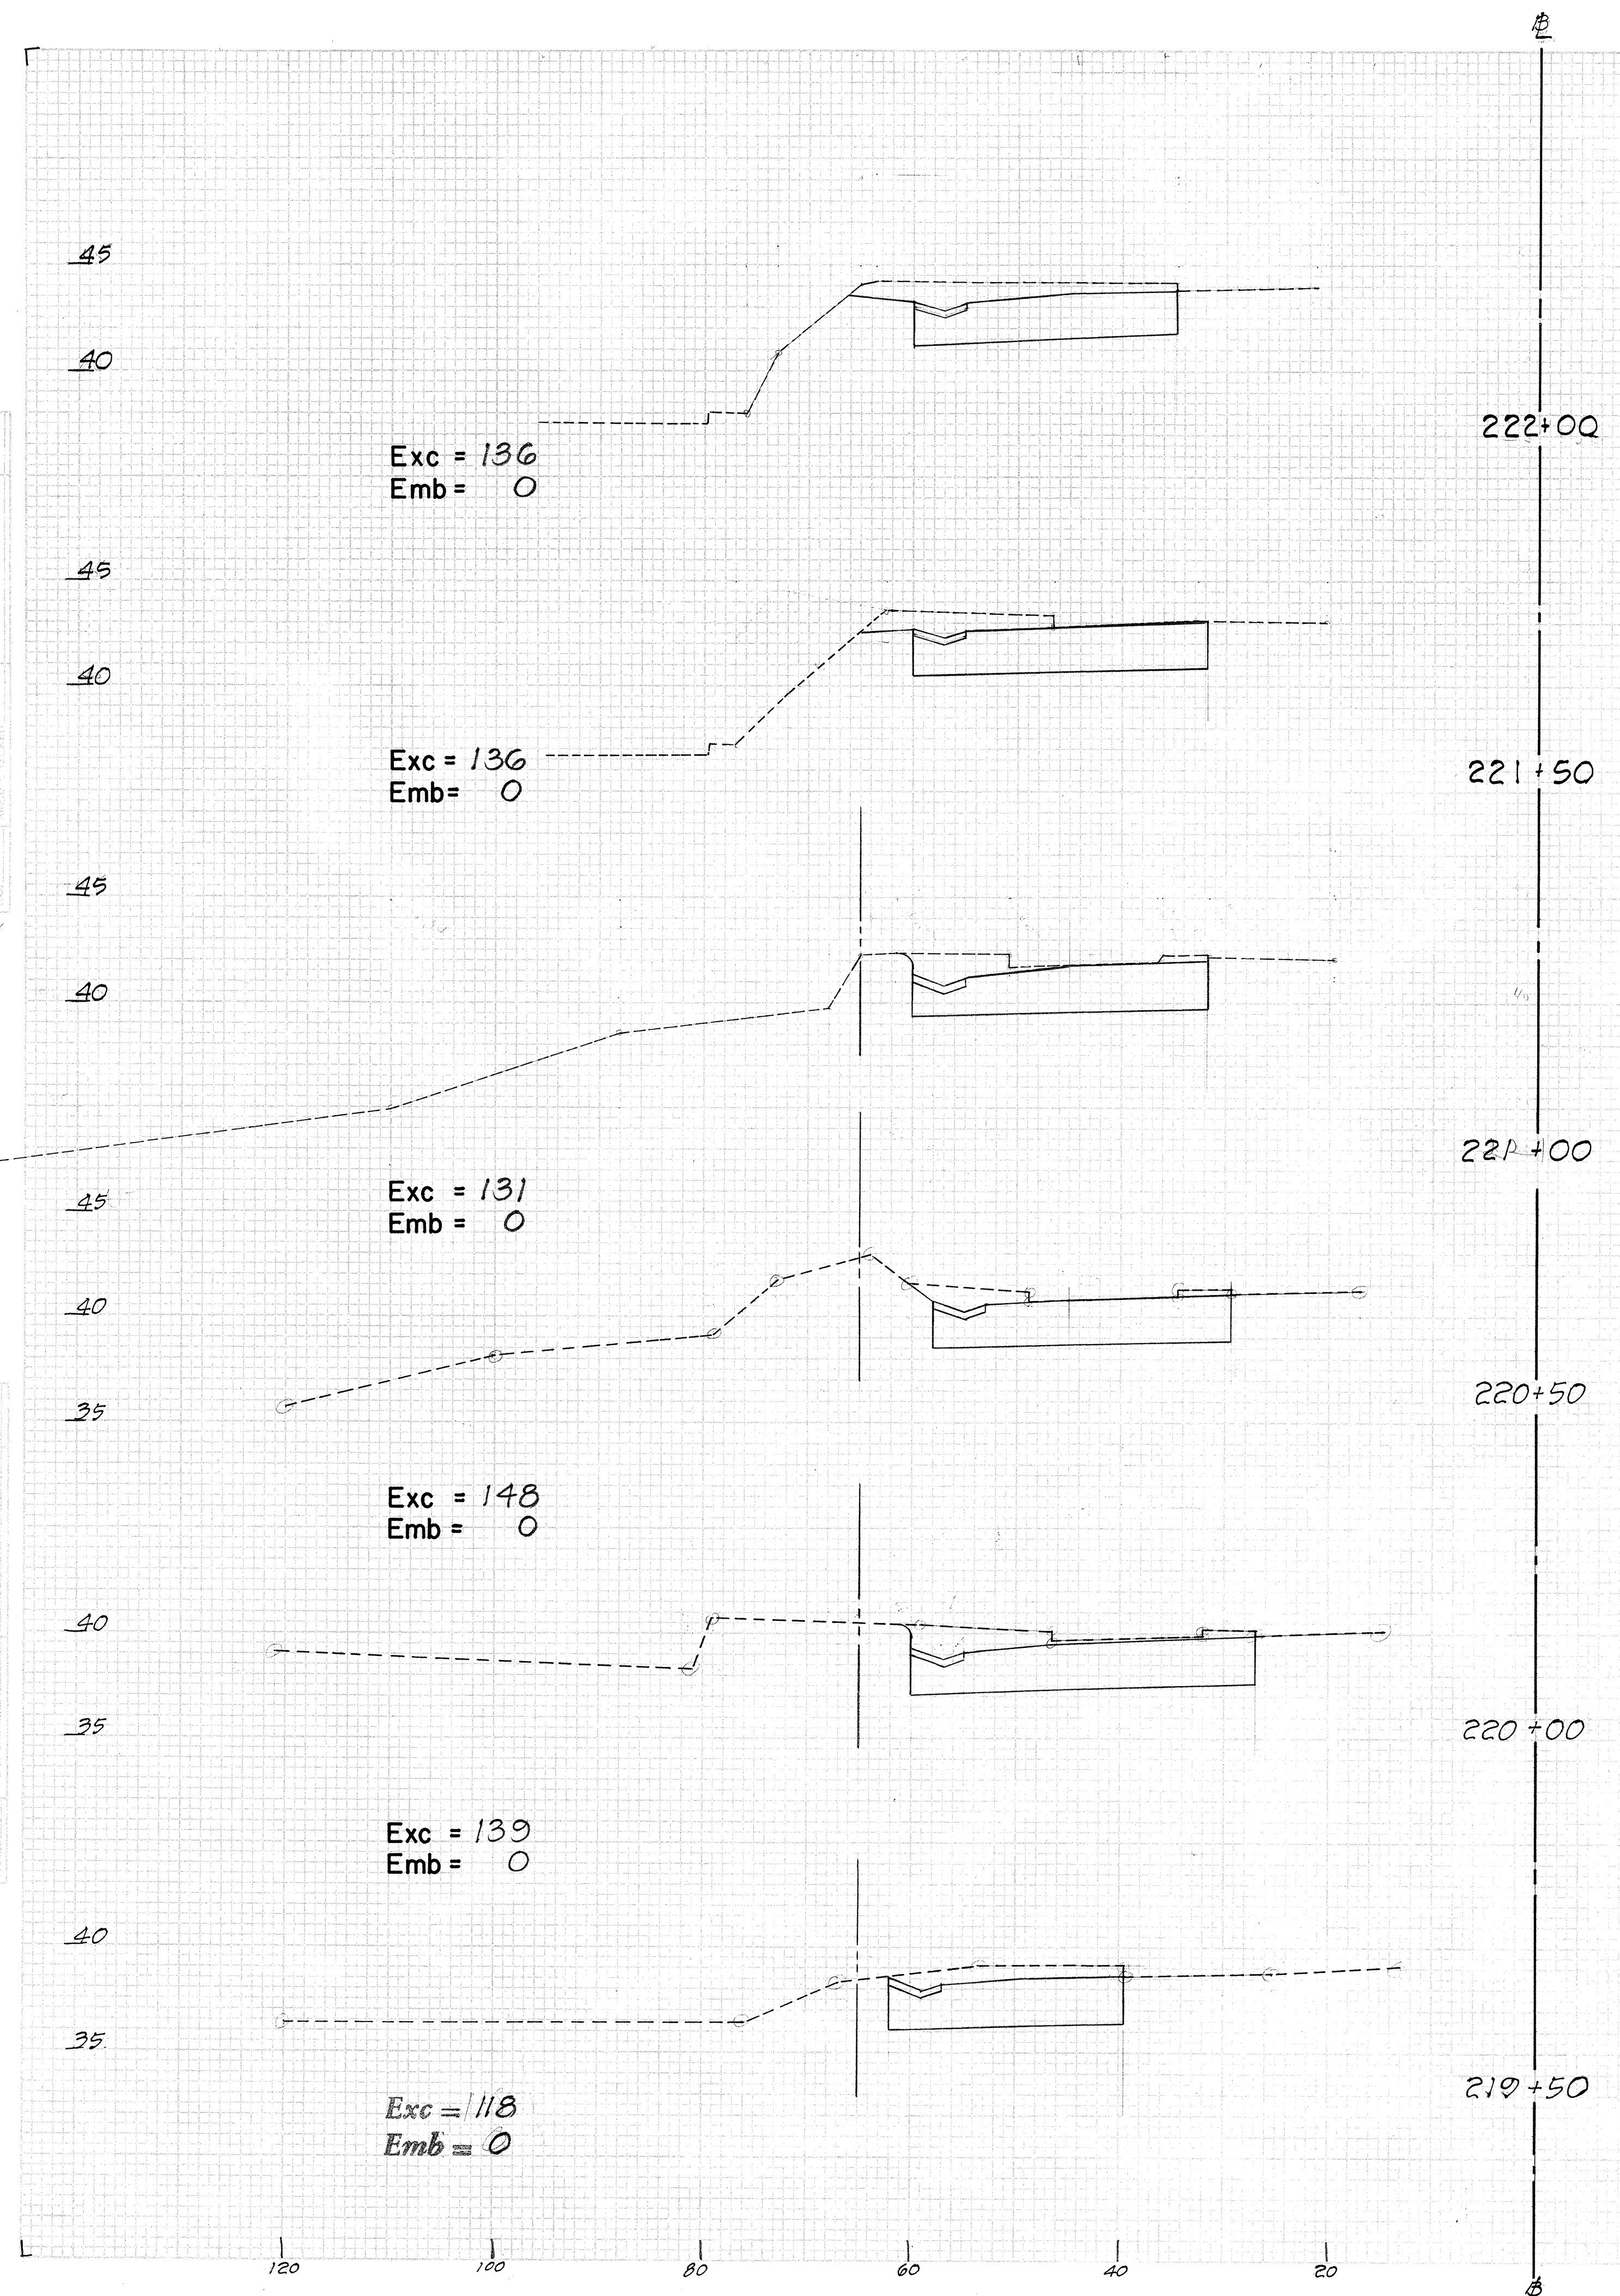


SCALE: Horiz. 1" = 10'
Vert. 1" = 5'

FED. ROAD DIST. NO.	STATE	FED. AID PROJ. NO.	FISCAL YEAR	SHEET NO.	TOTAL SHEETS
HAWAII	HAW.	U-090-1(16)	1969	45	50


DATE	BY	CHKD	APP'D
DESIGNED	DRAWN	CHECKED	APPROVED
NO.	NO.	NO.	NO.



DATE	BY	CHKD	APP'D
DESIGNED	DRAWN	CHECKED	APPROVED
NO.	NO.	NO.	NO.

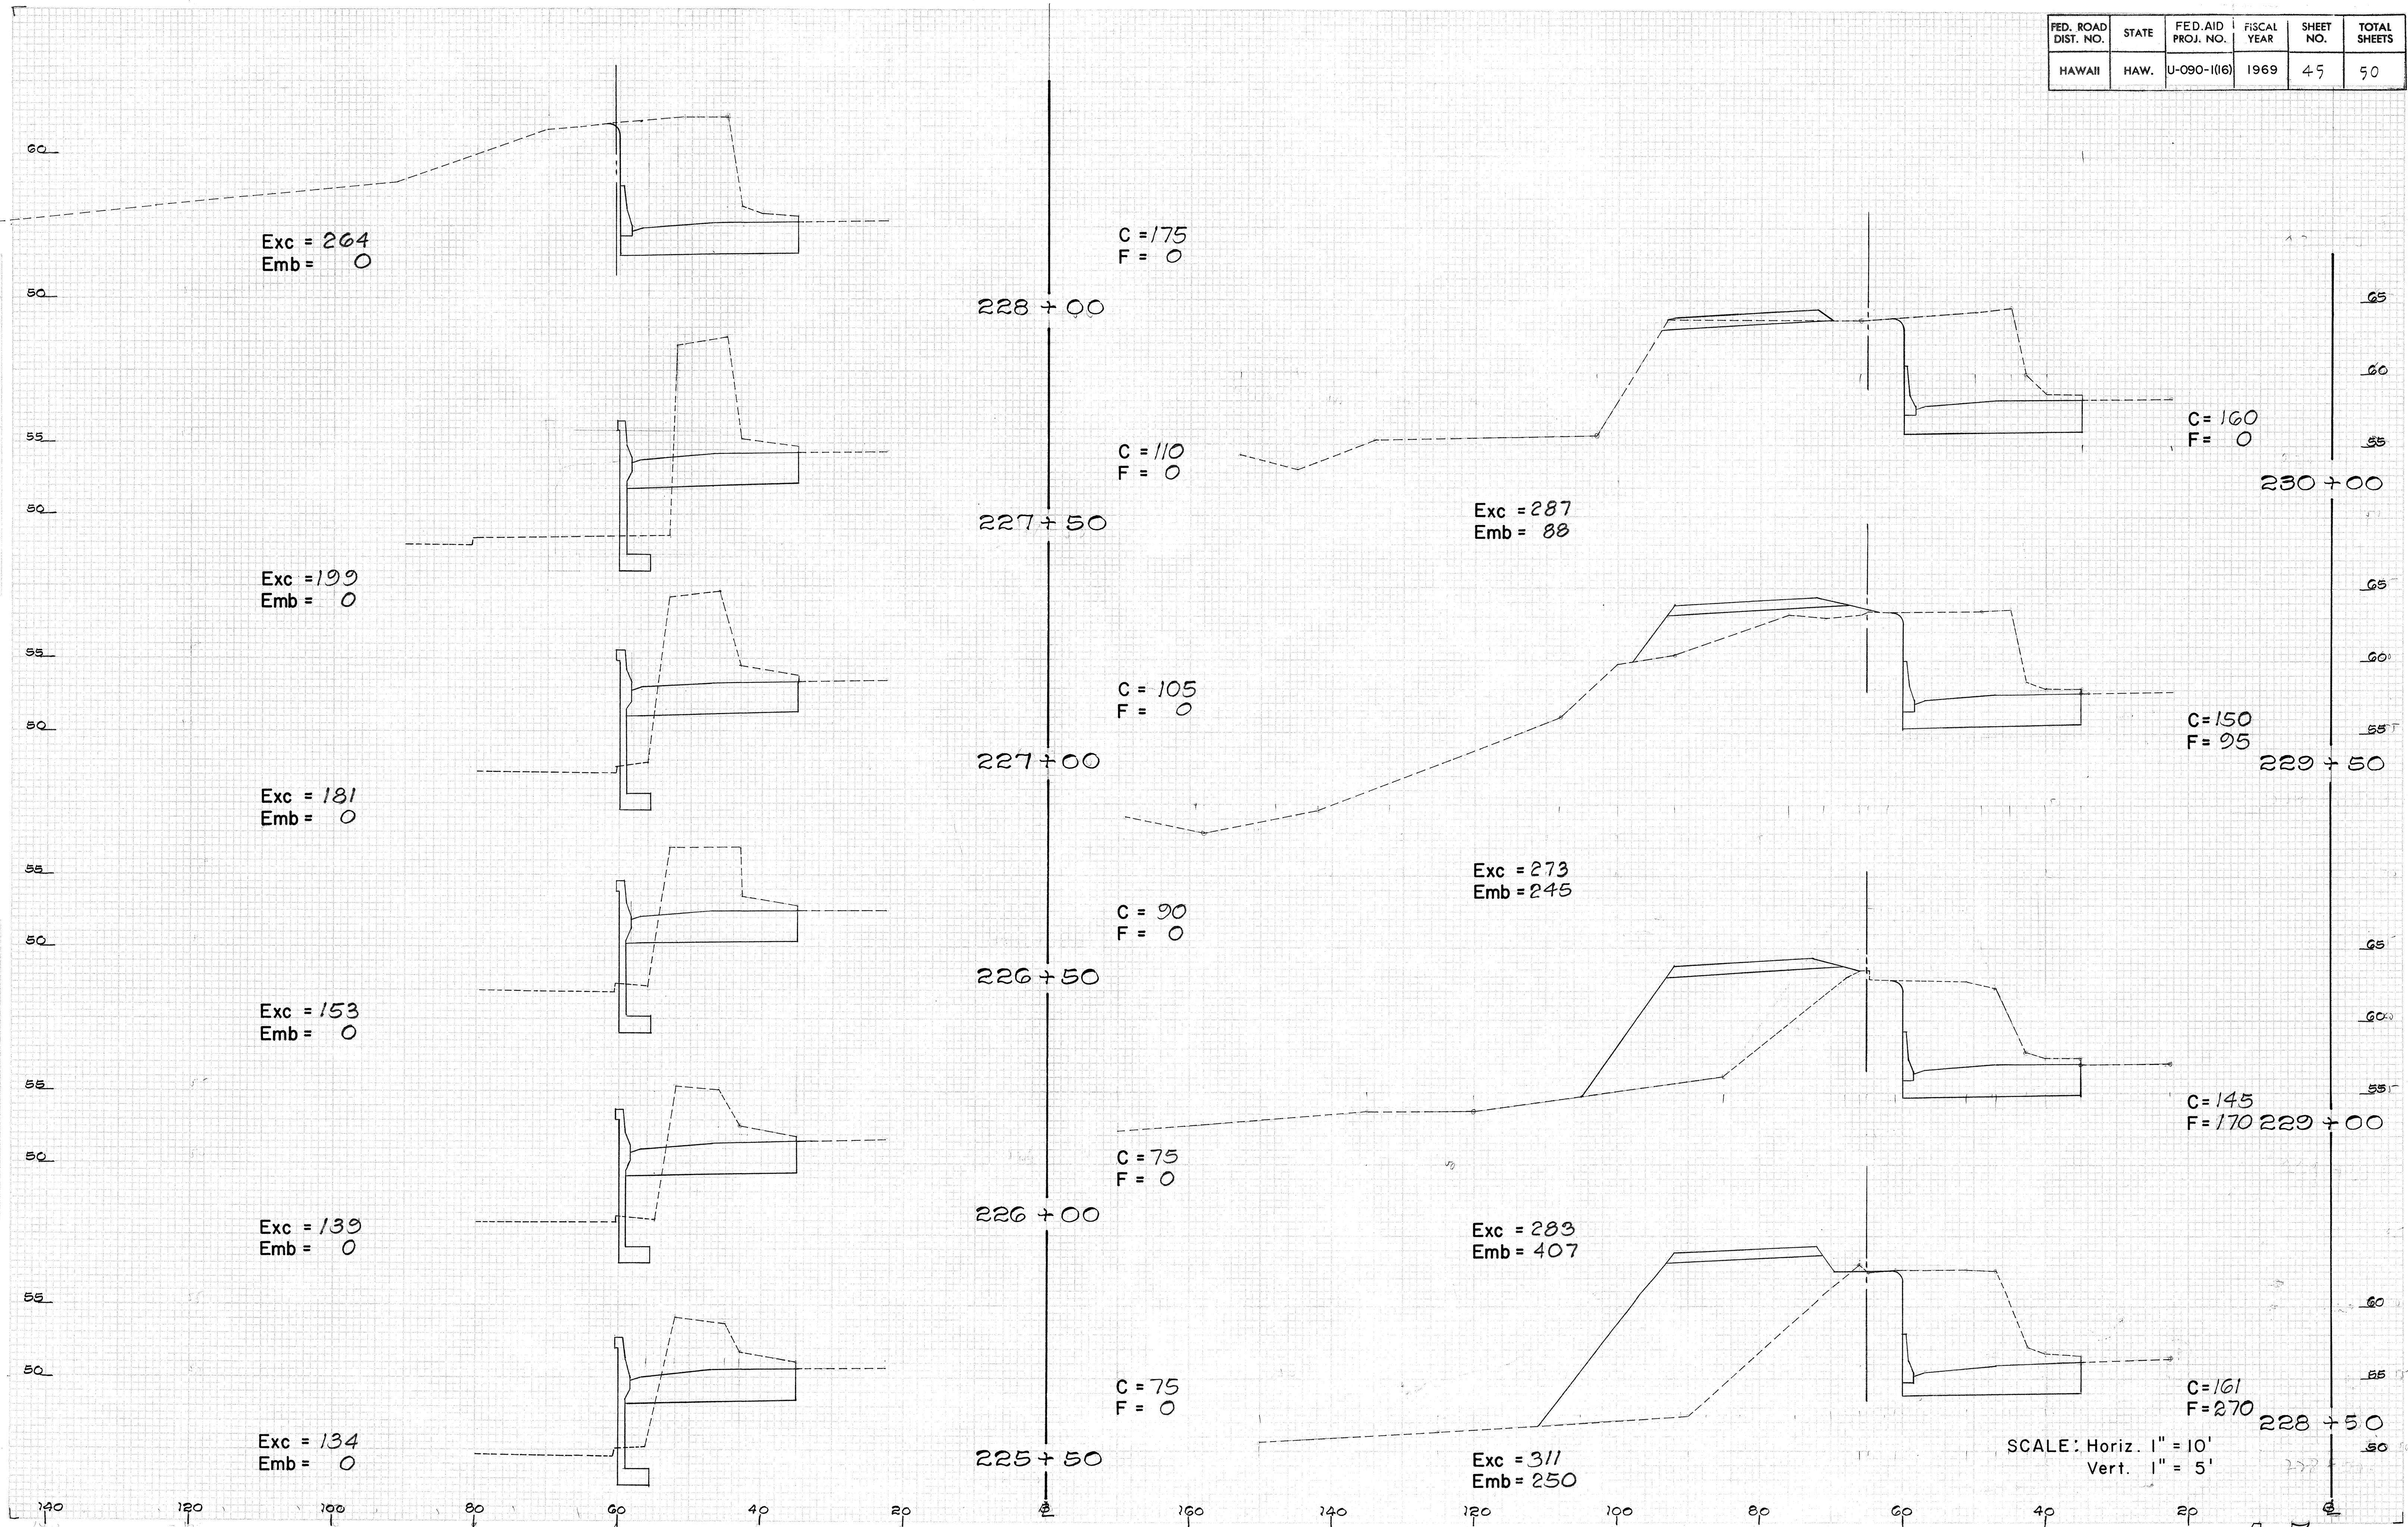


SCALE: Horiz. 1" = 10'
Vert. 1" = 5'

FED. ROAD DIST. NO.	STATE	FED. AID PROJ. NO.	FISCAL YEAR	SHEET NO.	TOTAL SHEETS
HAWAII	HAW.	U-090-1(16)	1969	46	50

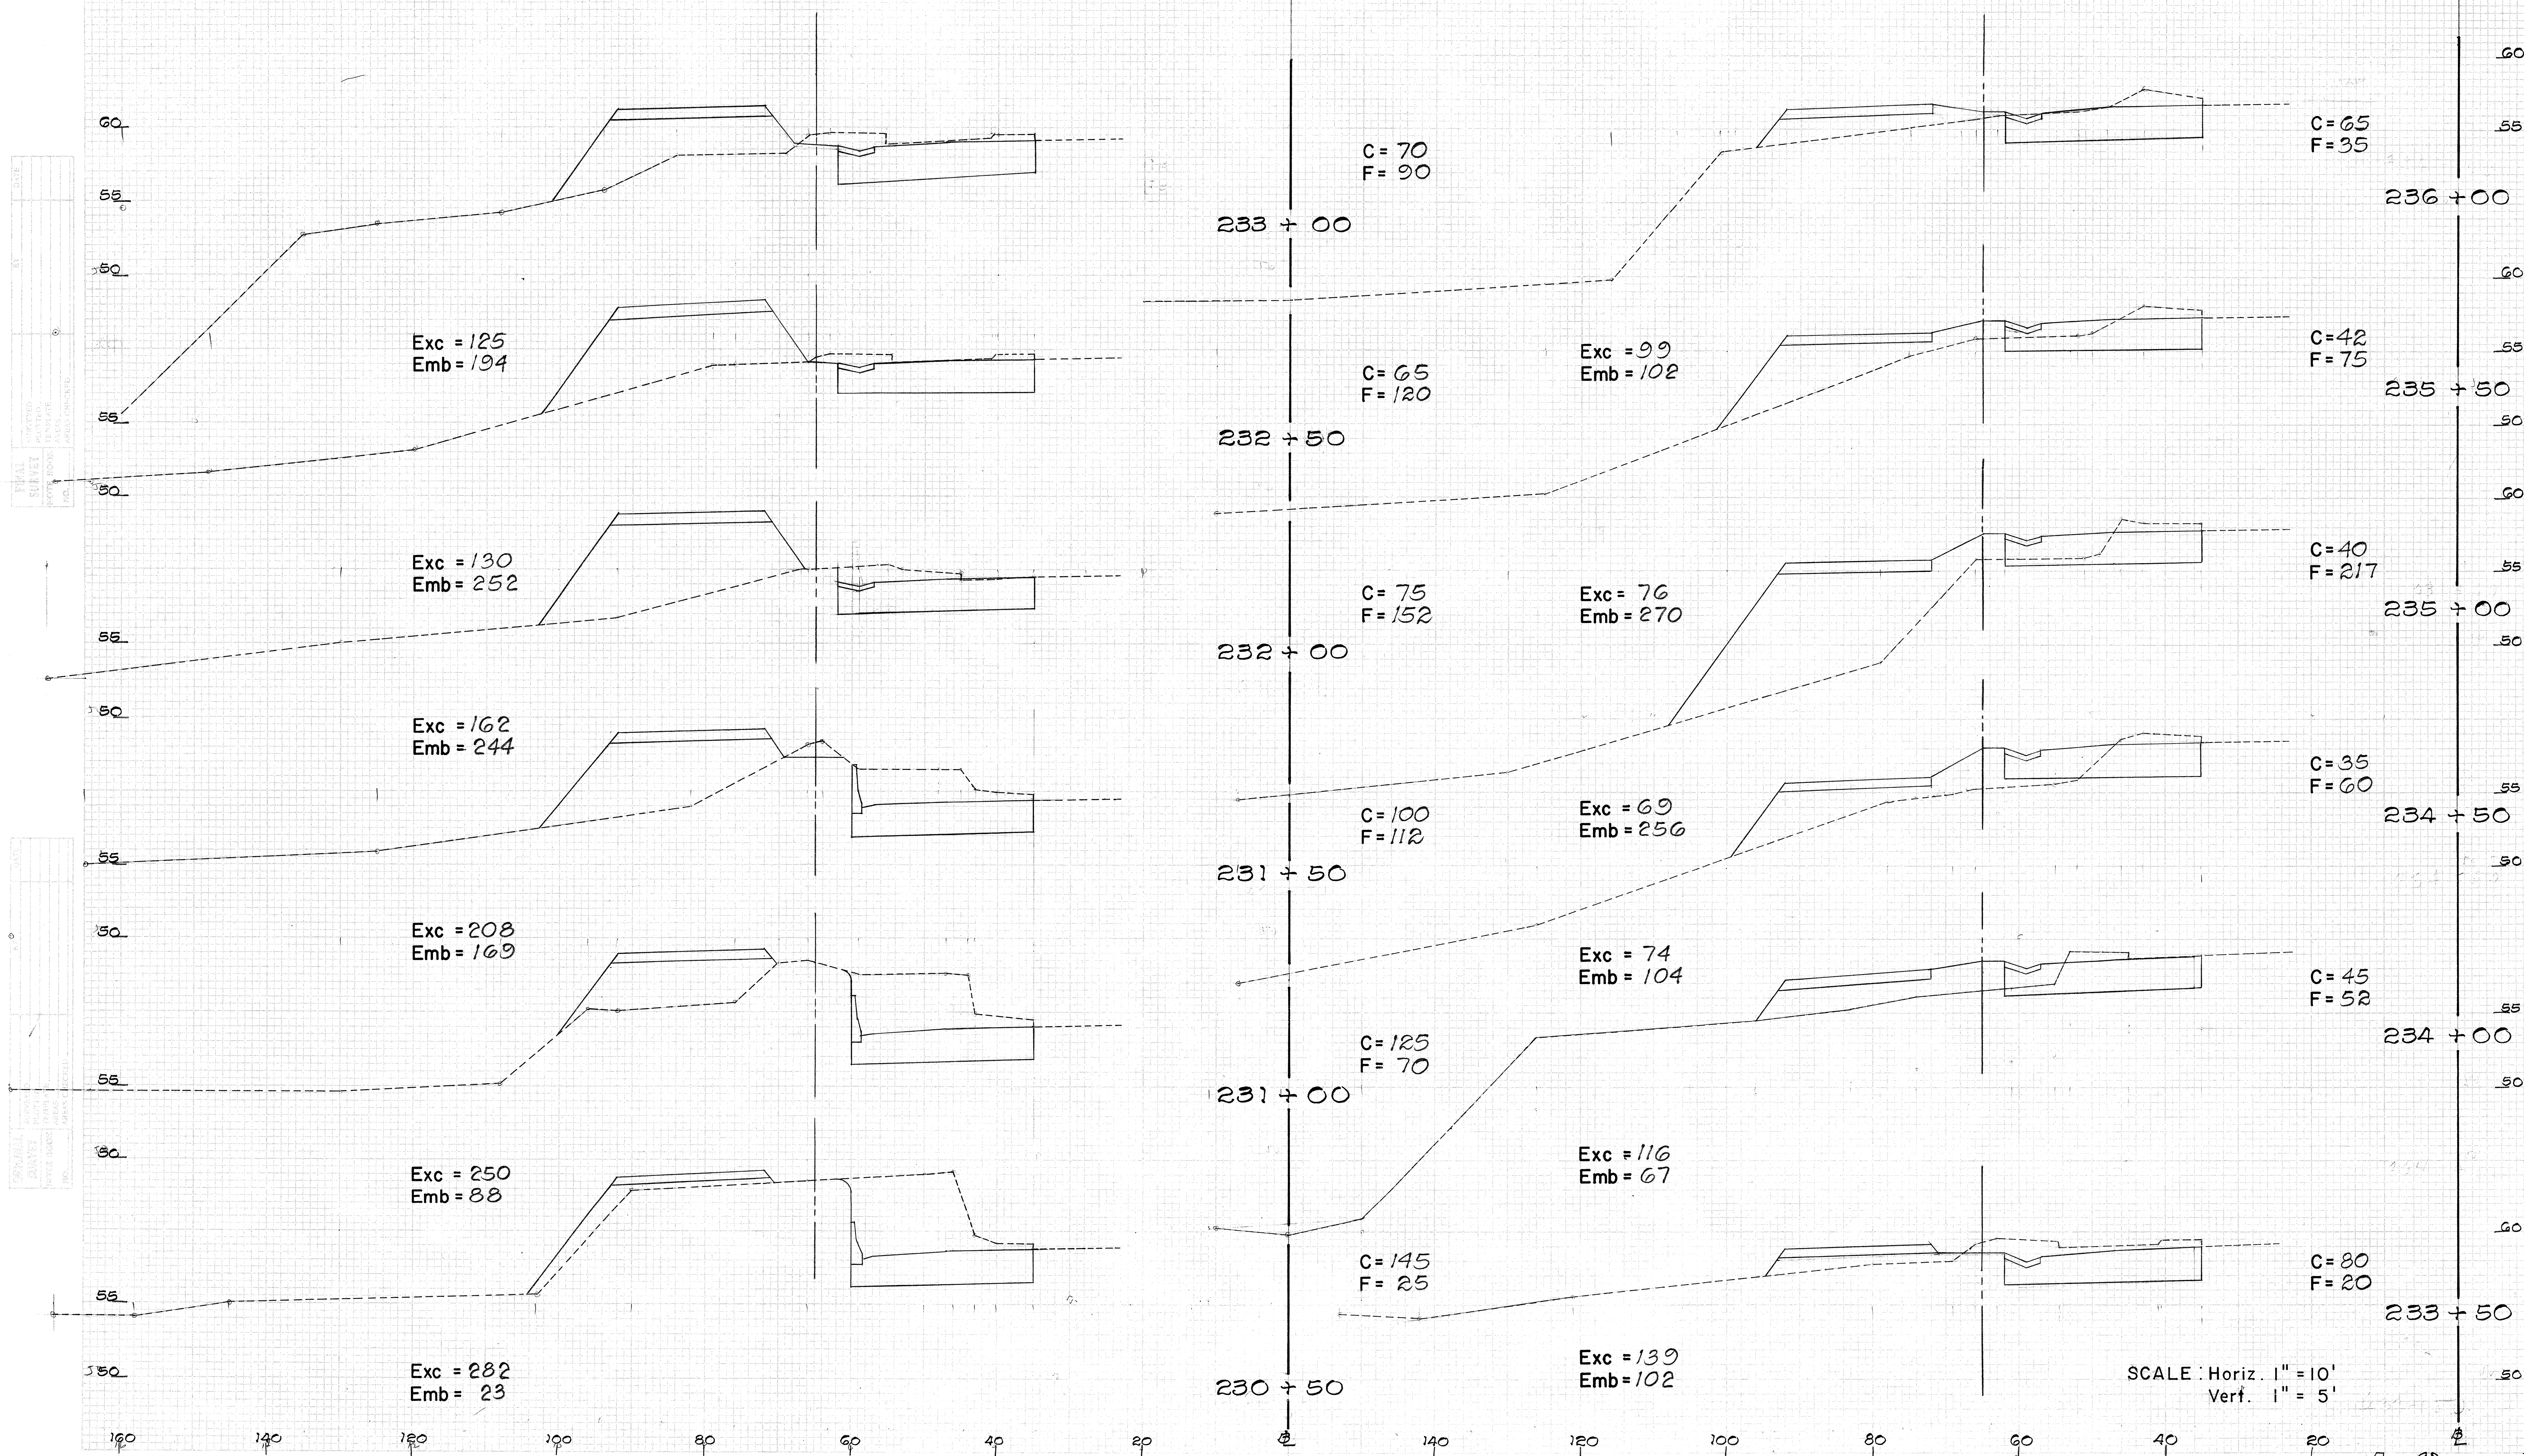

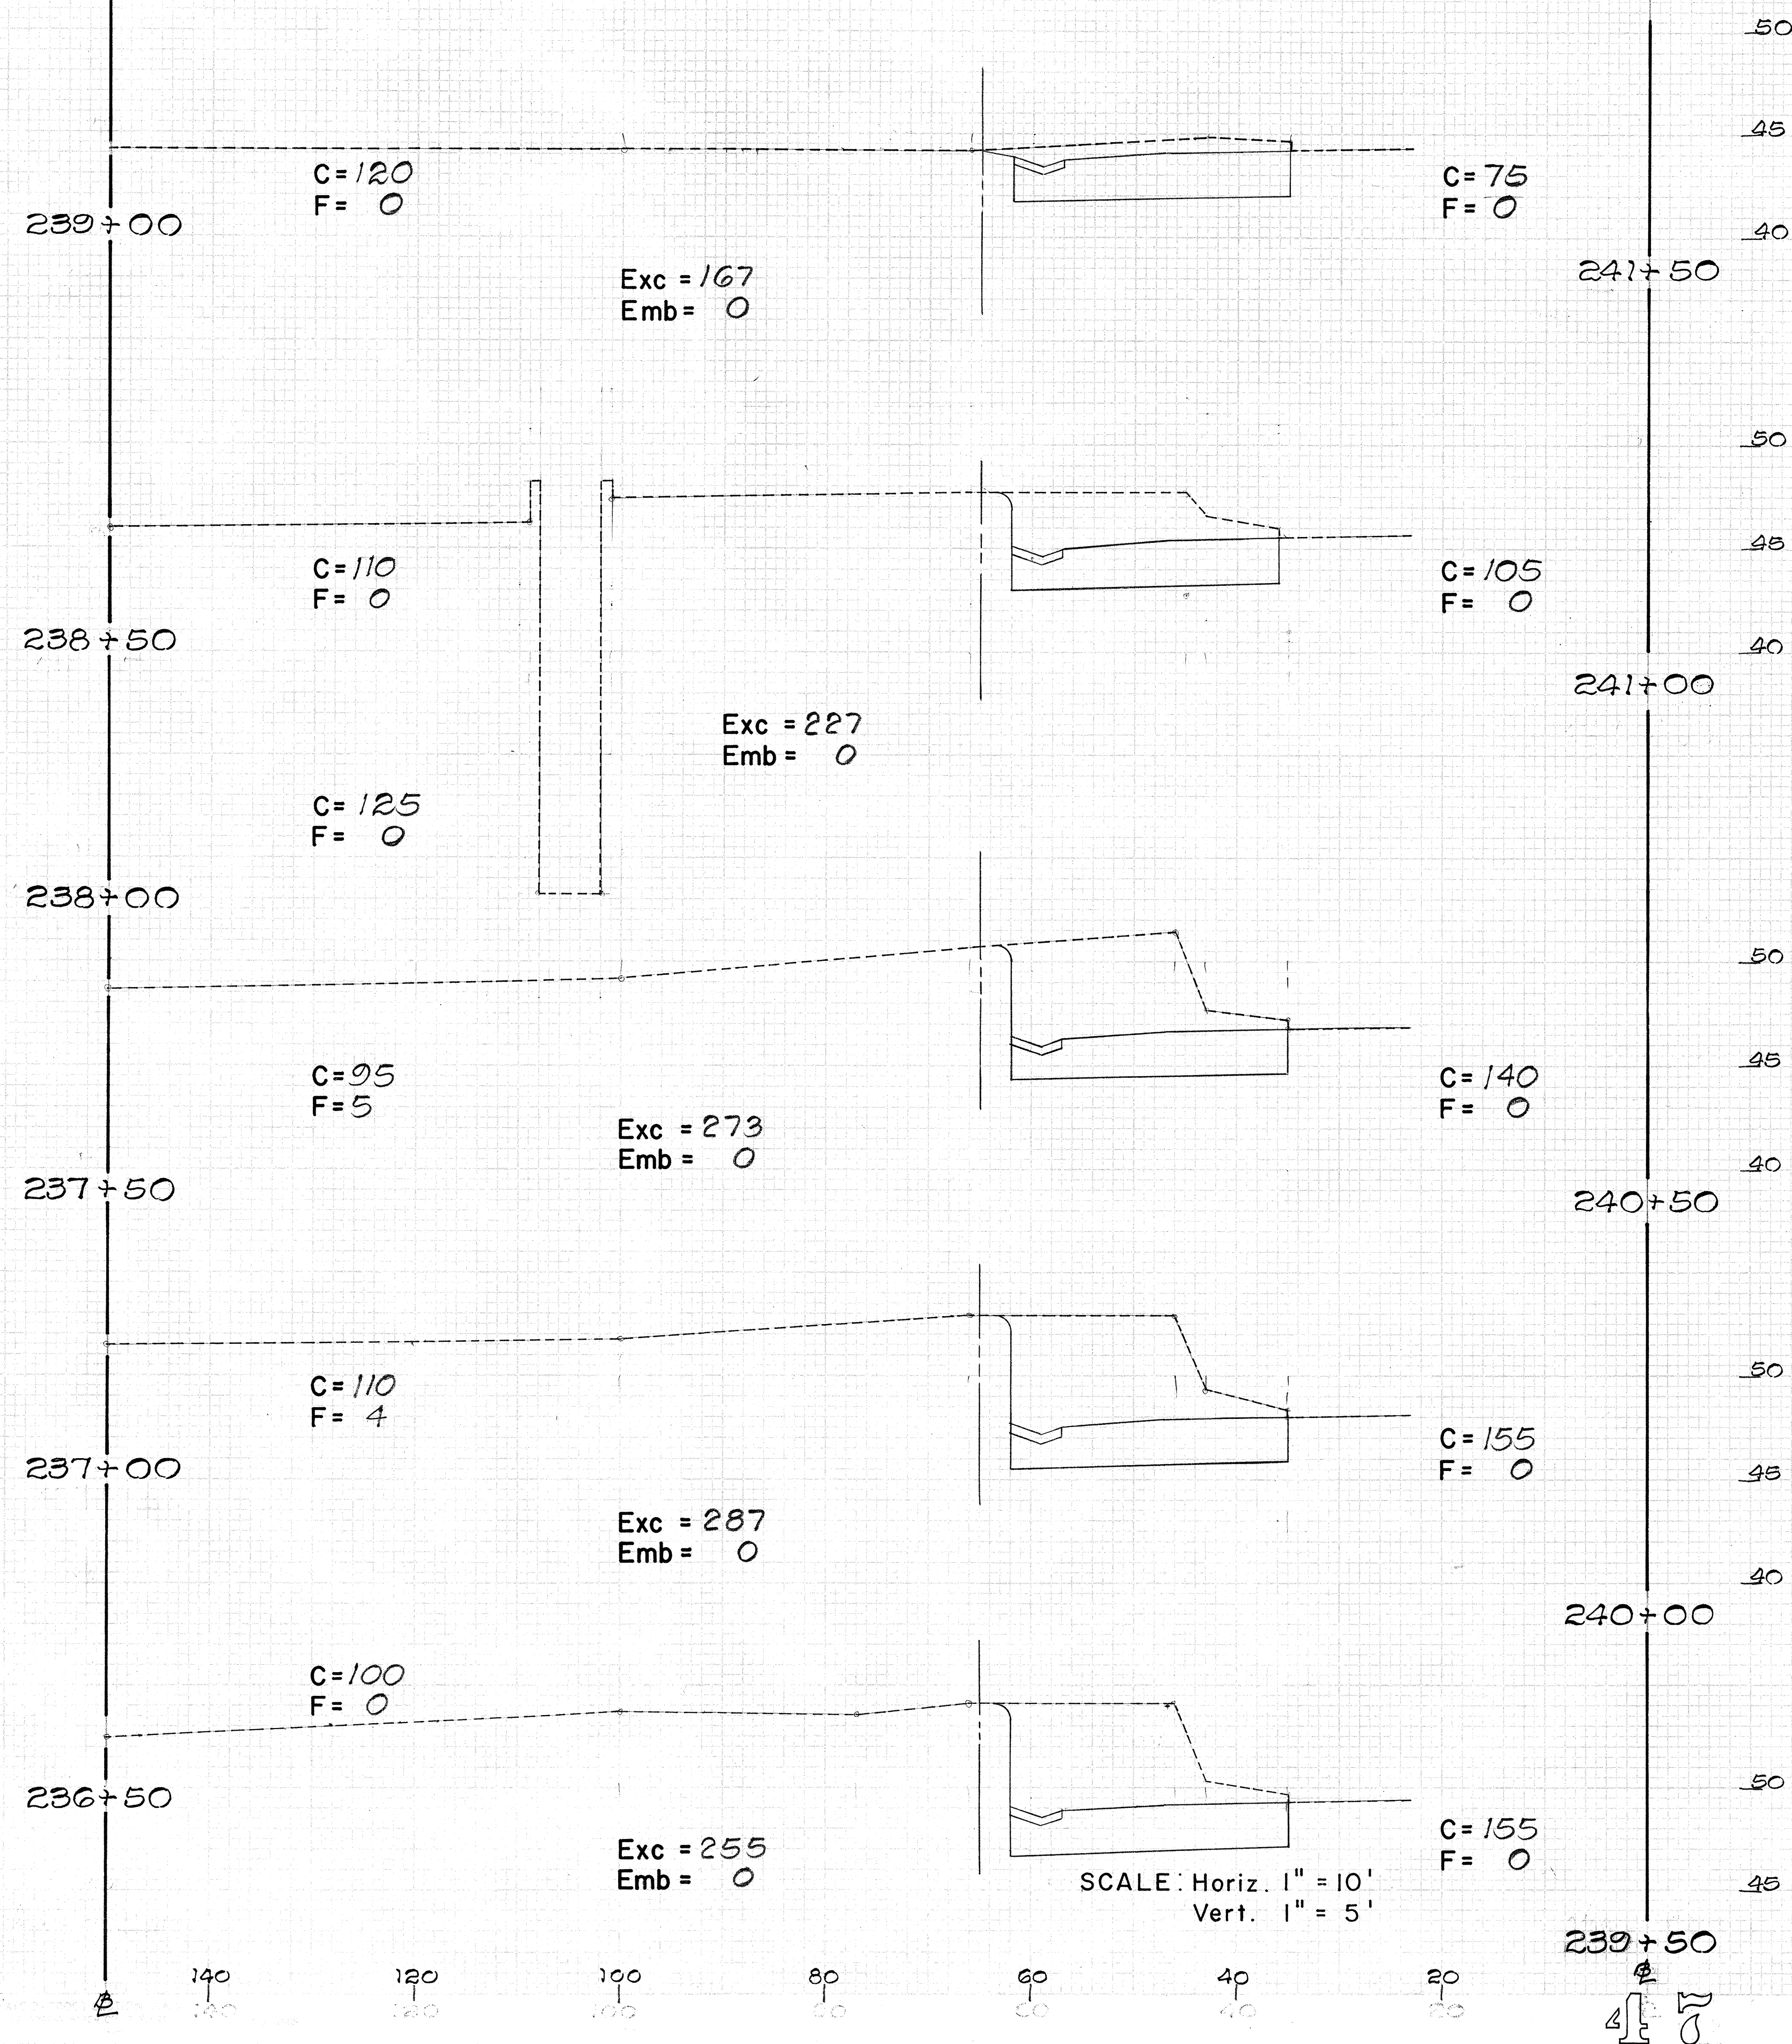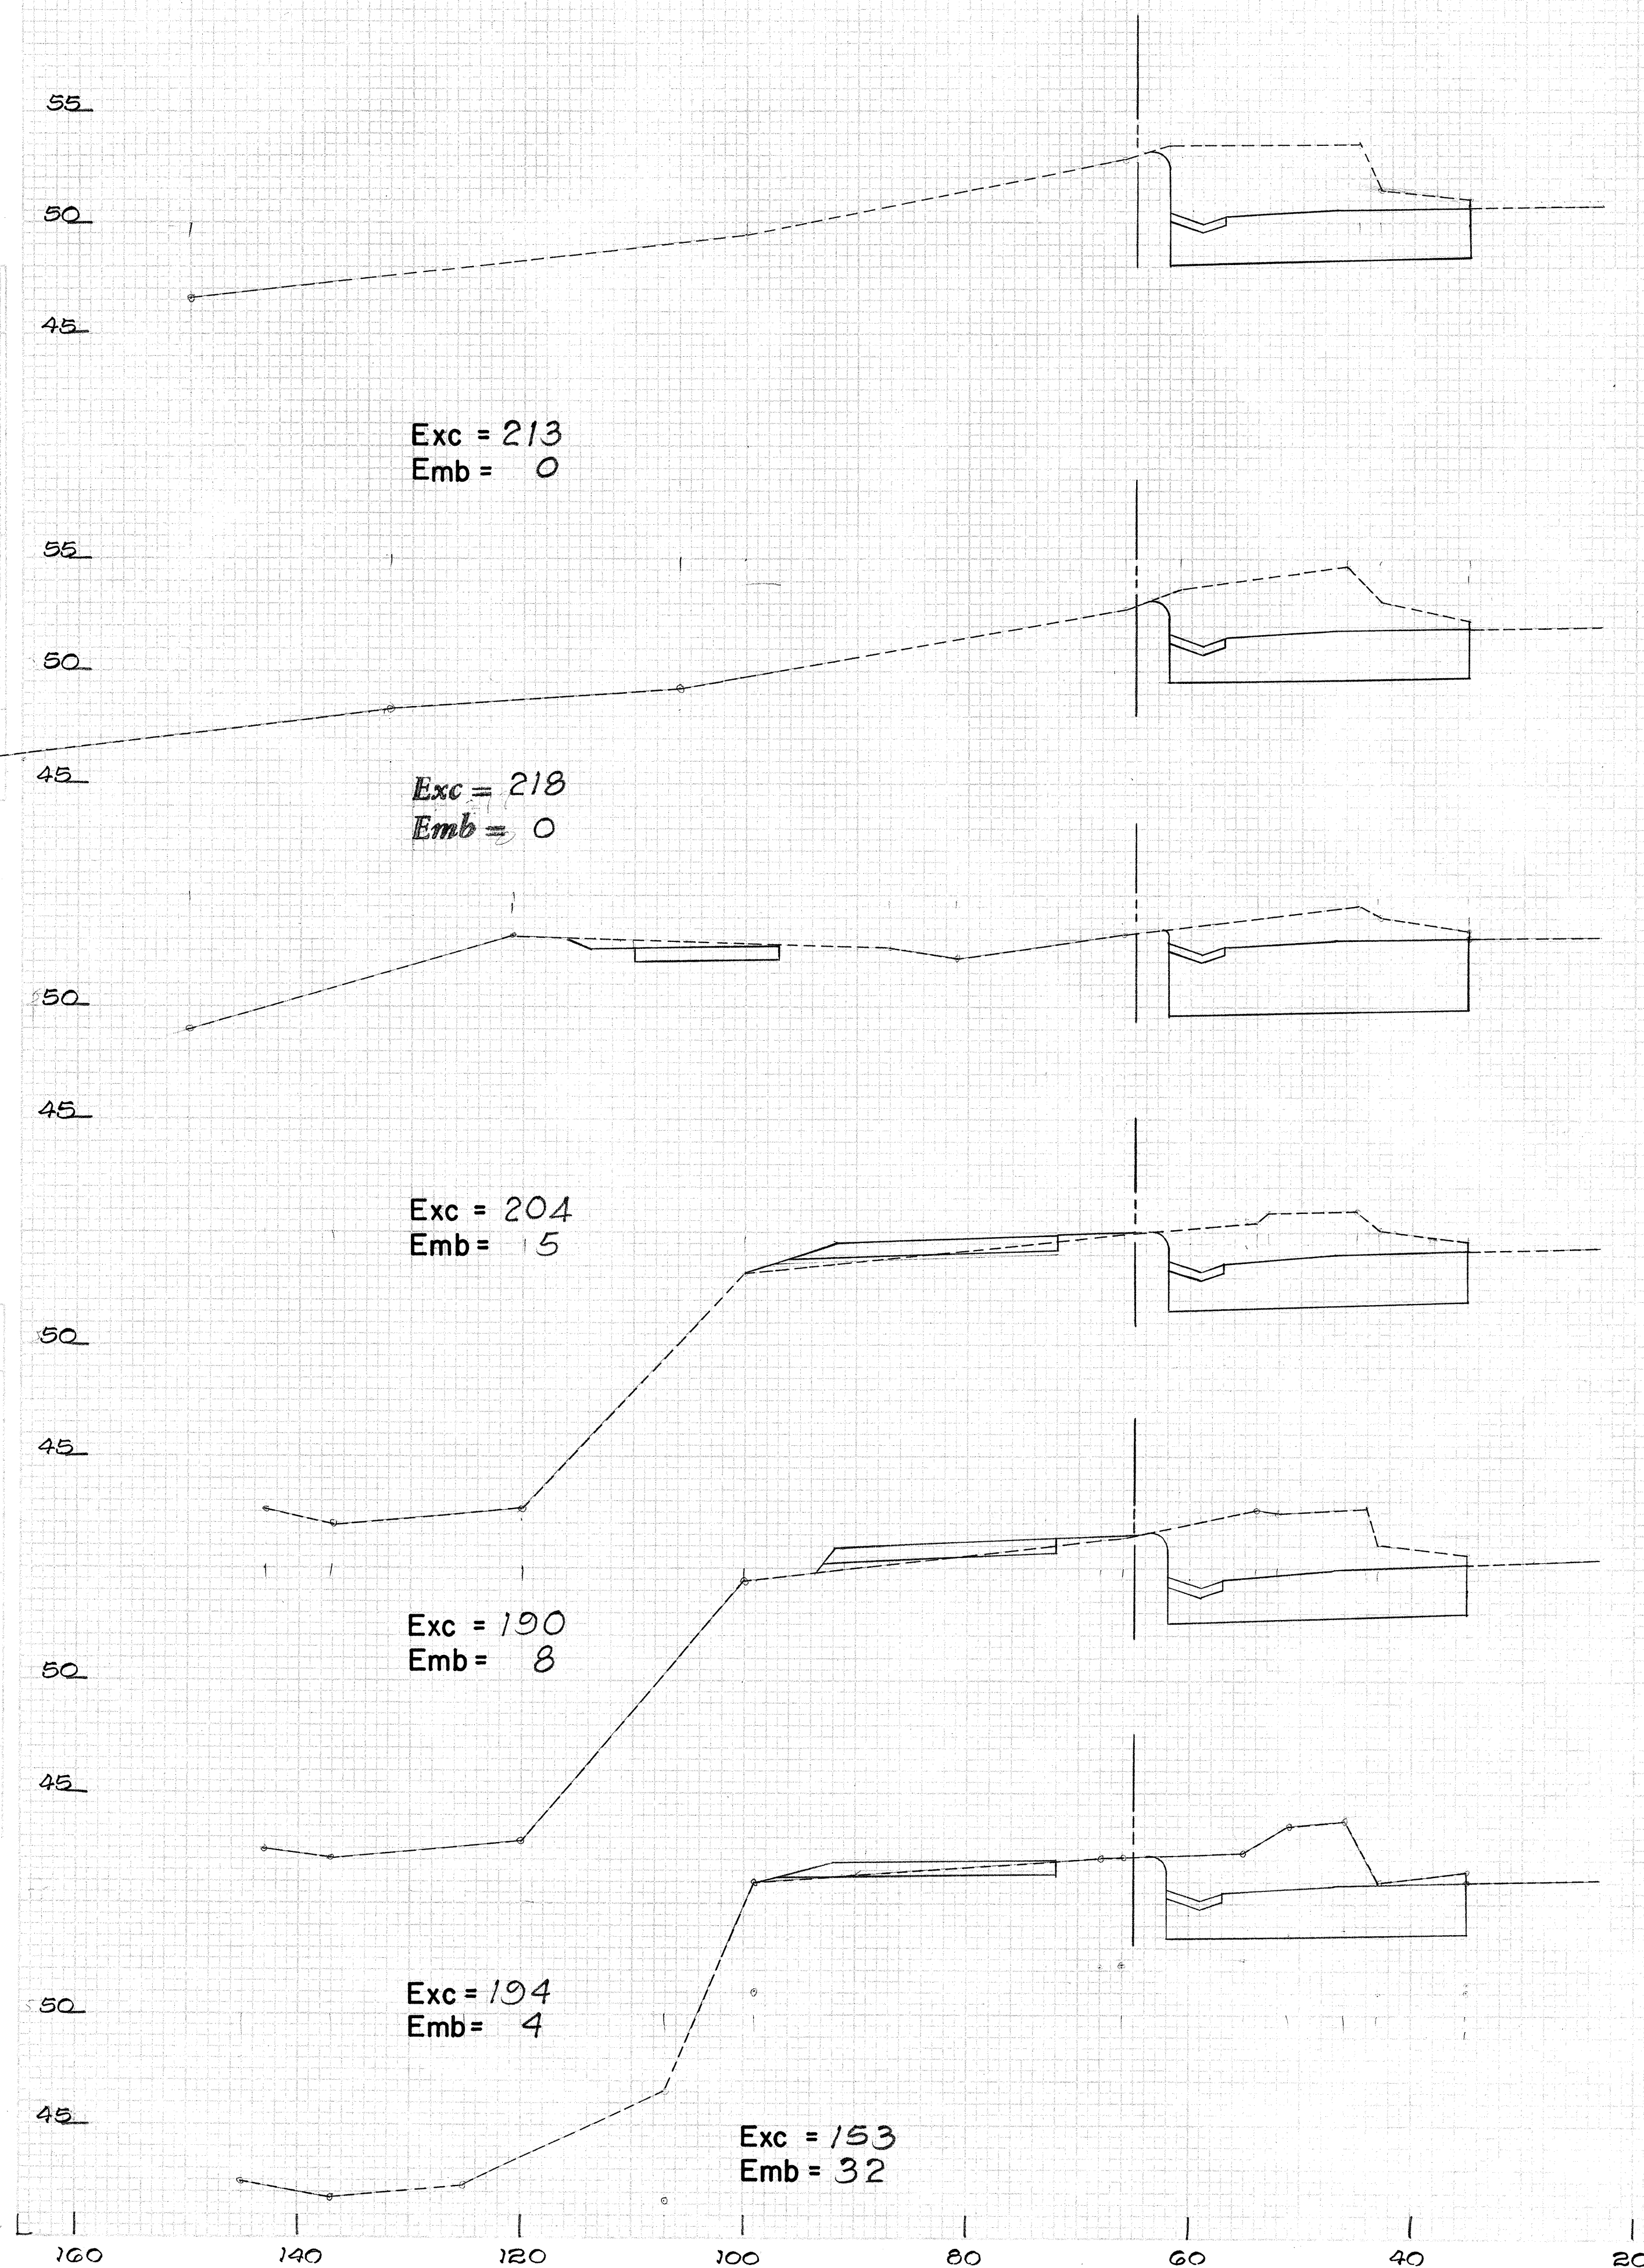

FED. ROAD DIST. NO.	STATE	FED. AID PROJ. NO.	FISCAL YEAR	SHEET NO.	TOTAL SHEETS
HAWAII	HAW.	U-090-1(16)	1969	49	50

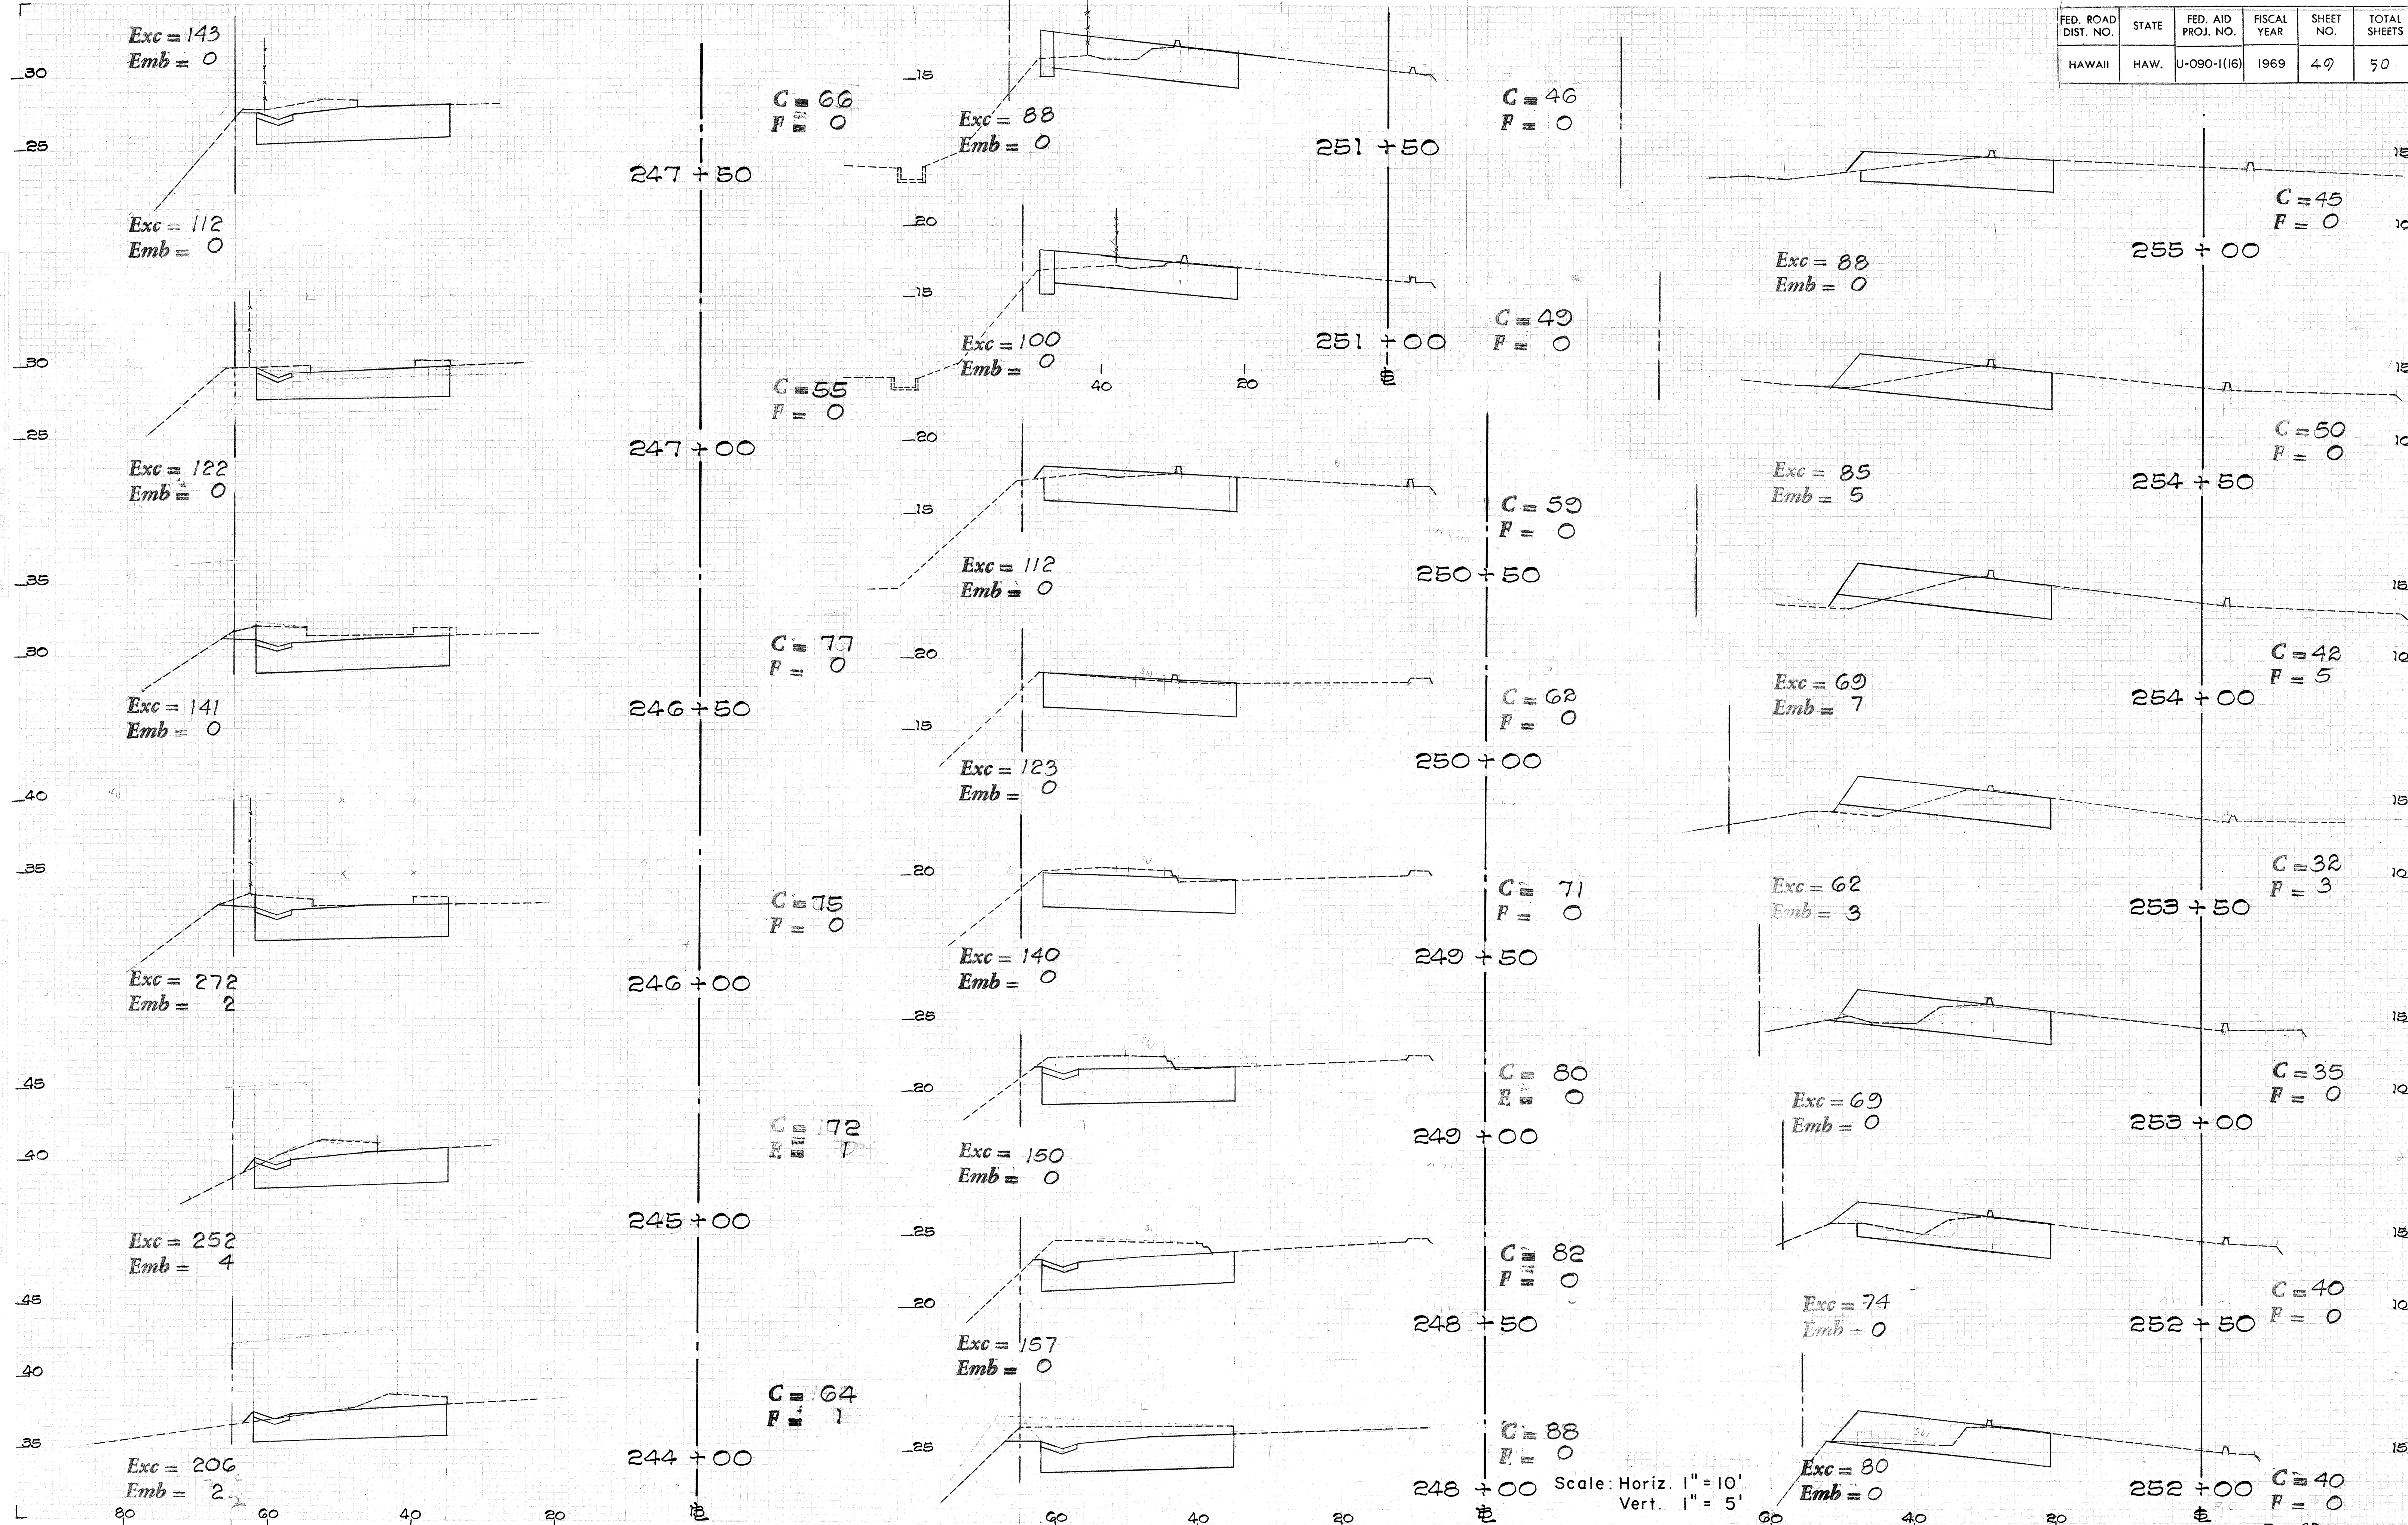

FED. ROAD DIST. NO.	STATE	FED. AID PROJ. NO.	FISCAL YEAR	SHEET NO.	TOTAL SHEETS
HAWAII	HAW.	U-090-1(16)	1969	50	50

