


FED. ROAD DIST. NO.	STATE	FED. AID PROJ. NO.	FISCAL YEAR	SHEET NO.	TOTAL SHEETS
HAWAII	HAW.	U-090-1(15)	1969	40	40

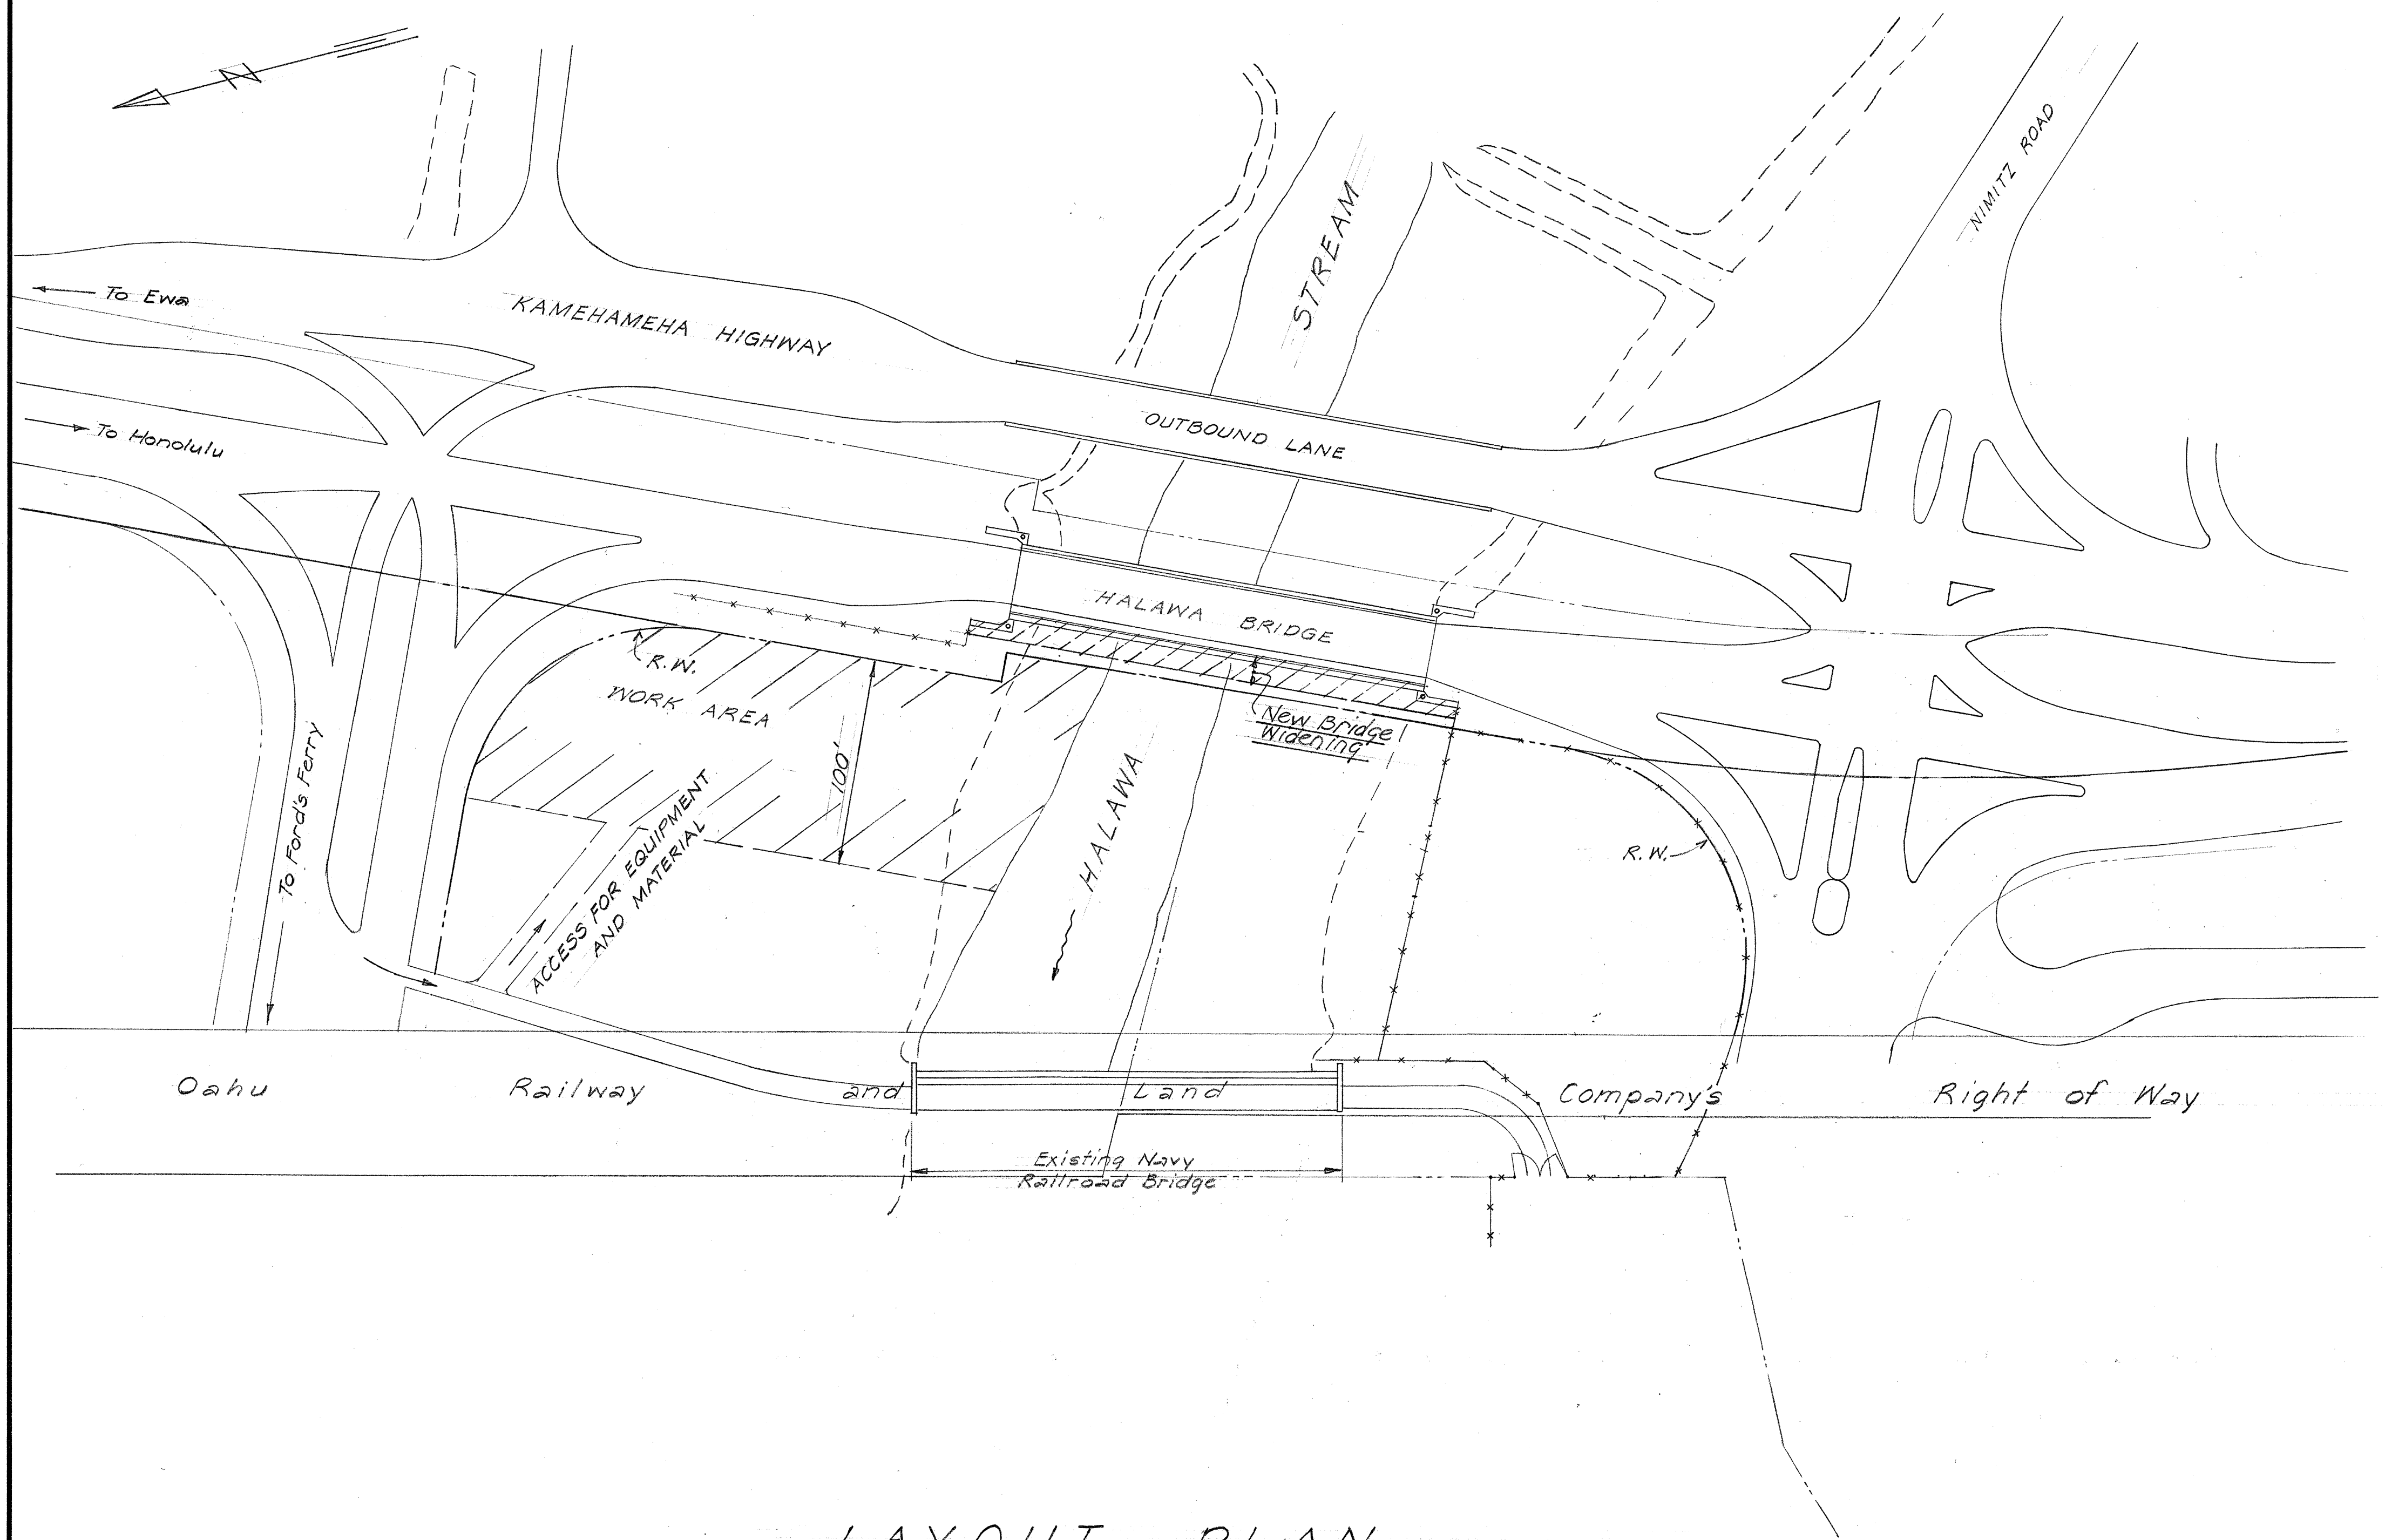

**LAYOUT PLAN**  
Scale: 1" = 50'-0"

STATE OF HAWAII  
DEPARTMENT OF TRANSPORTATION  
HIGHWAYS DIVISION

**HALAWA STREAM BRIDGE WIDENING**

Kamehameha Highway  
Project No. U-090-1(15) JULY 1969

SHEET No. / OF / SHEETS

DESIGNED BY	DATE
DRAWN BY	
CHECKED BY	
NOTED BY	
NO.	