

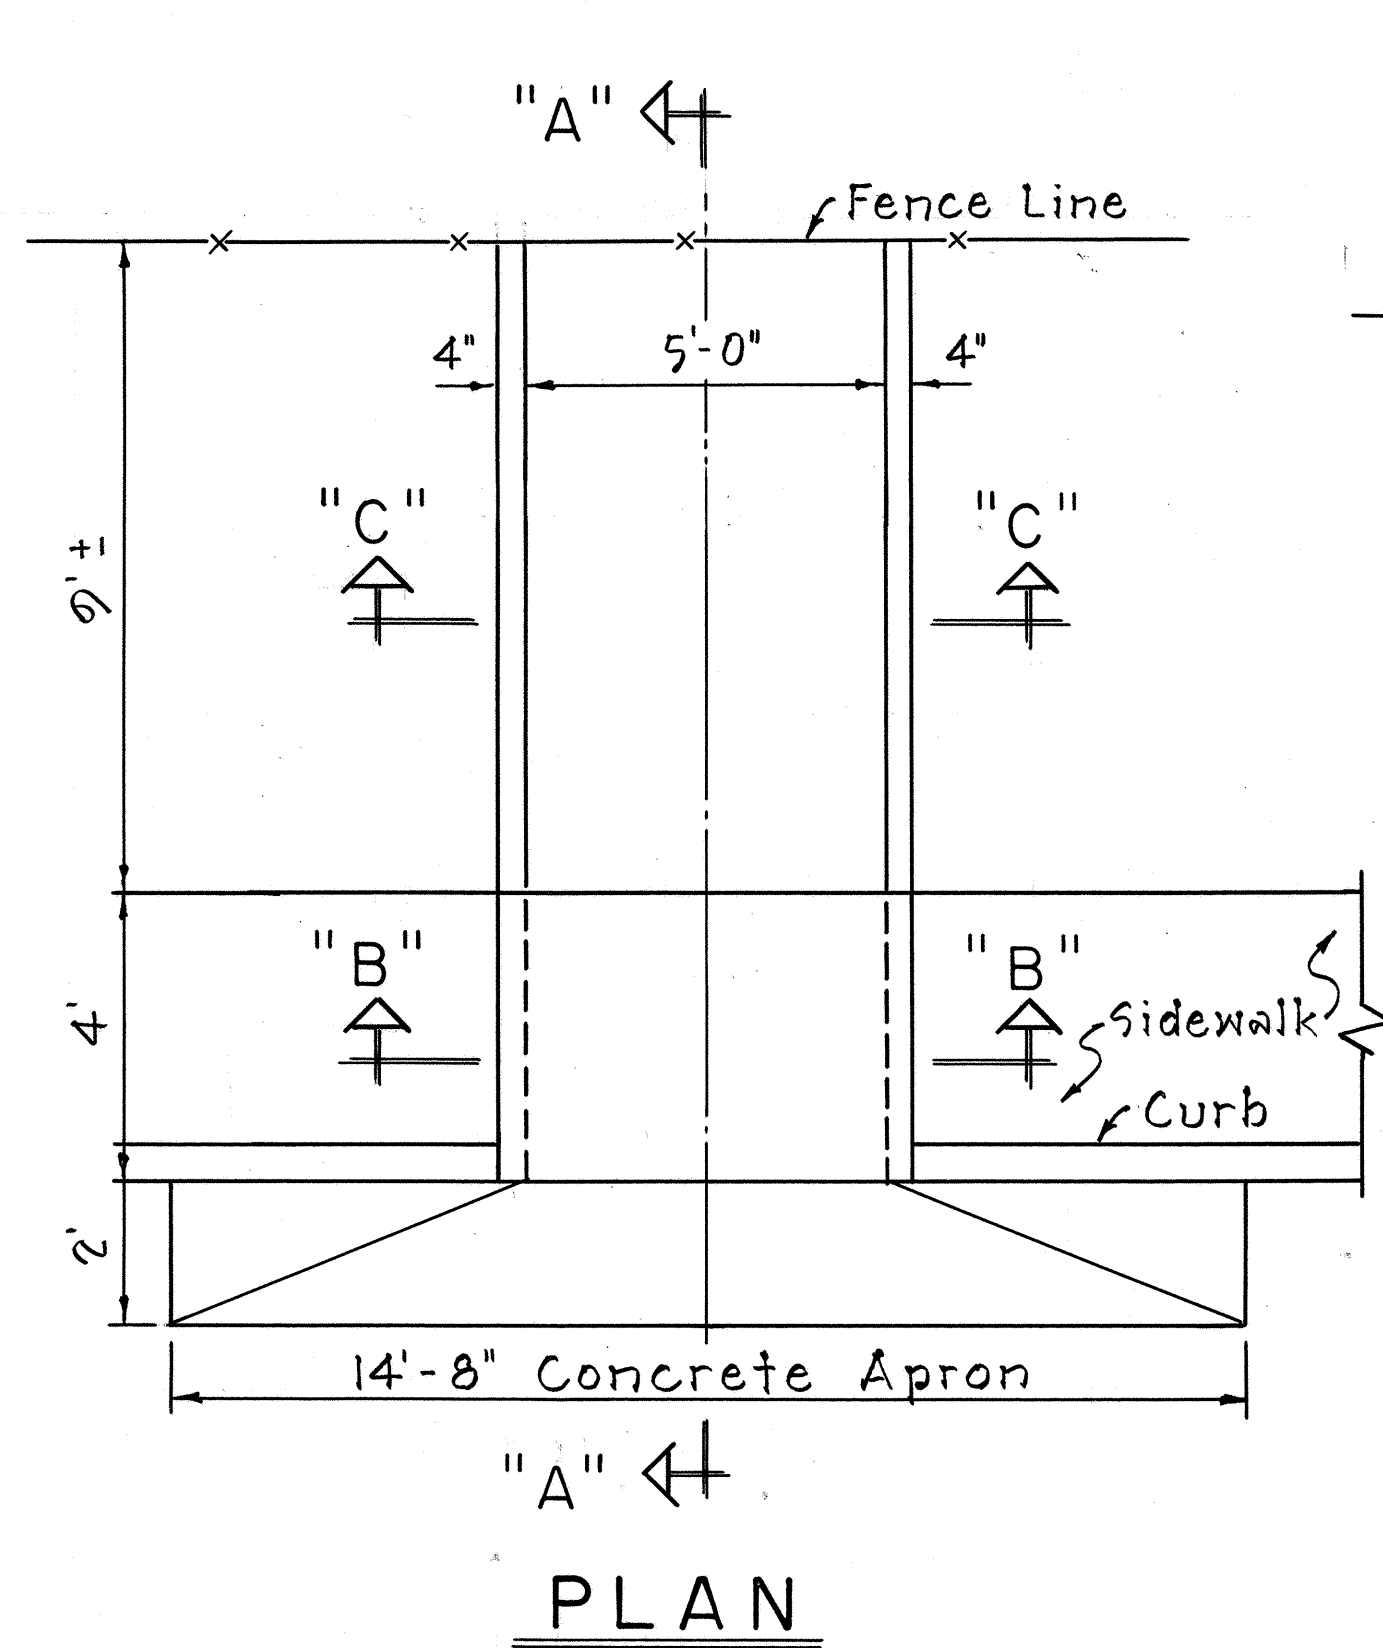
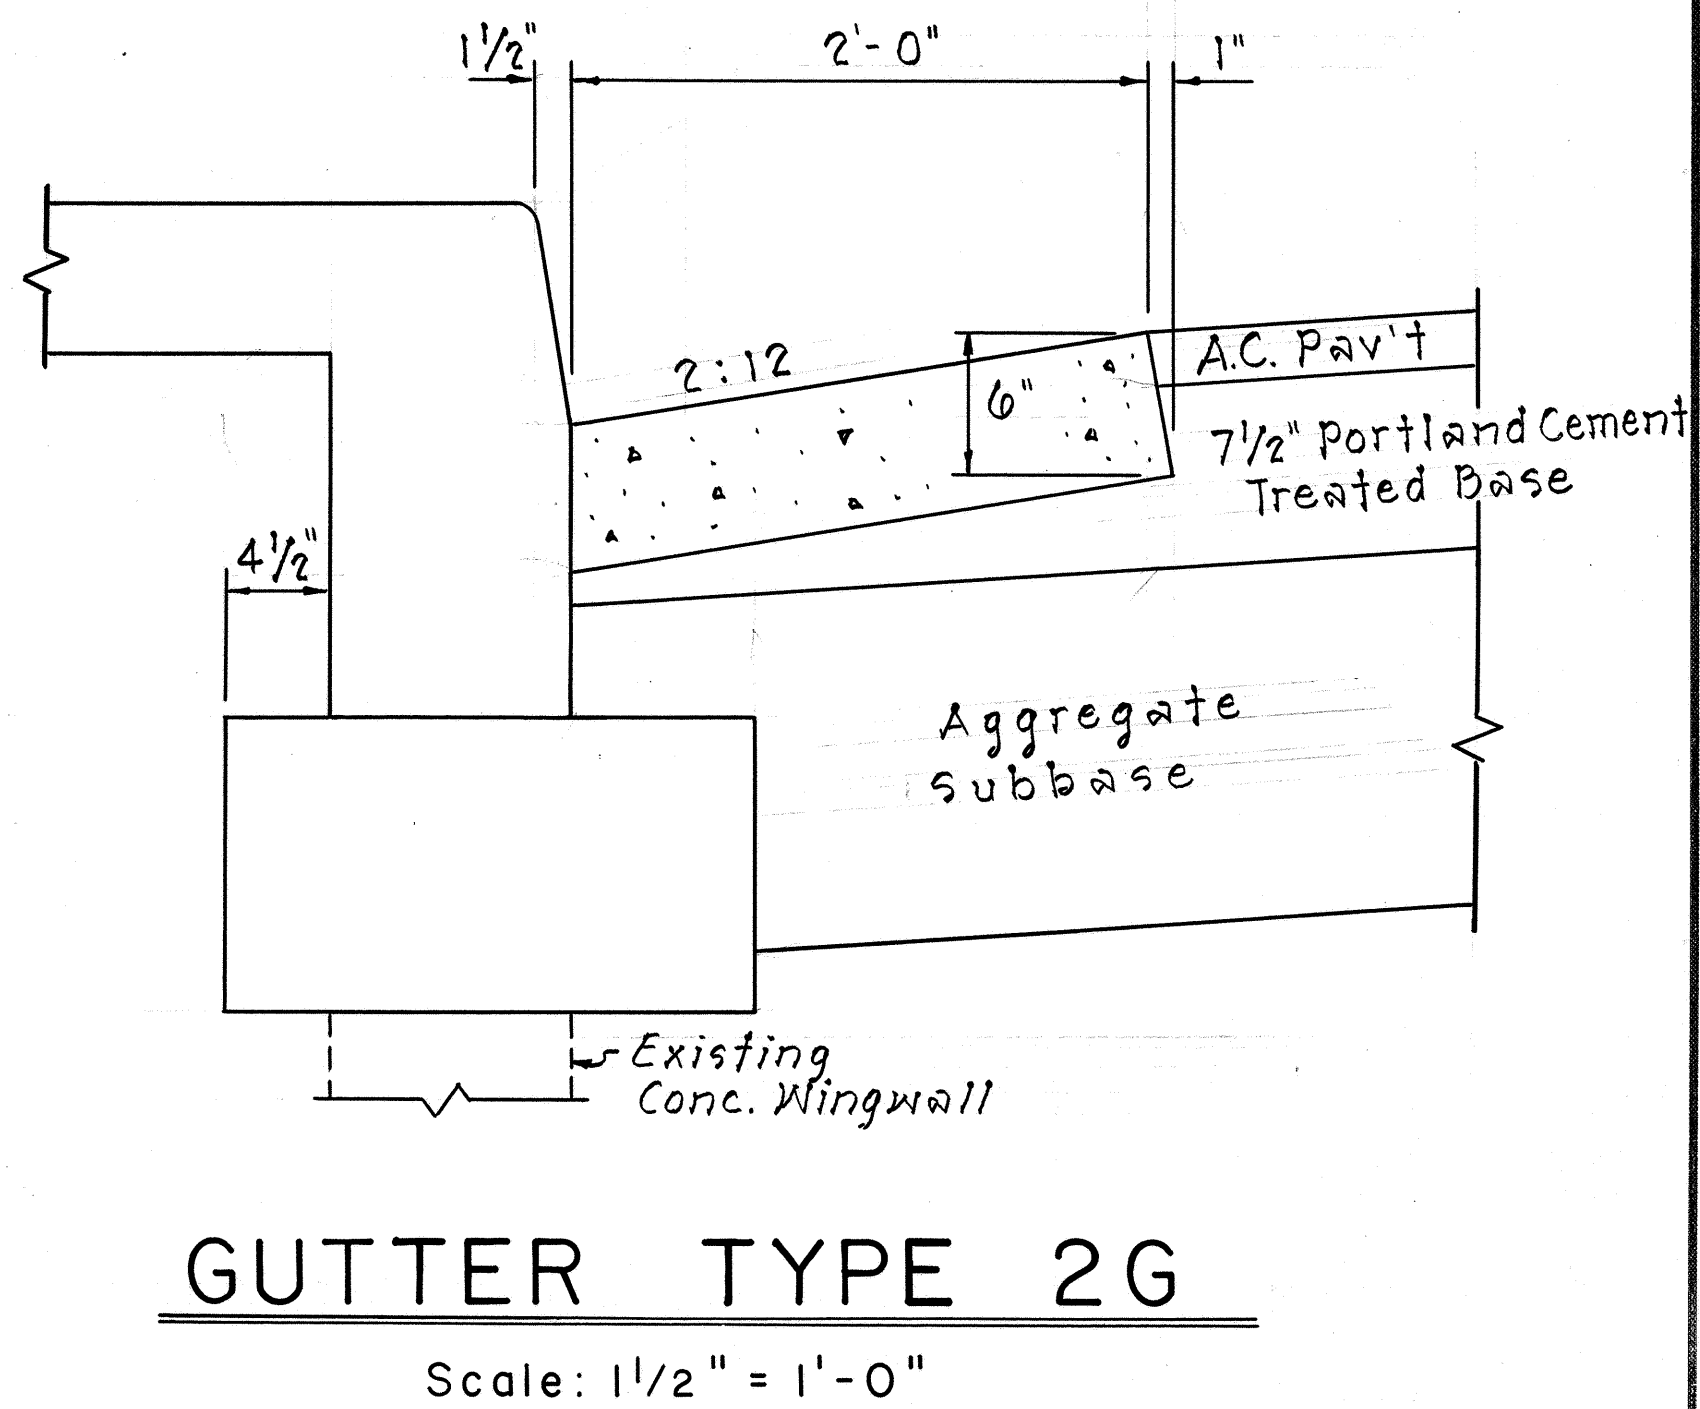
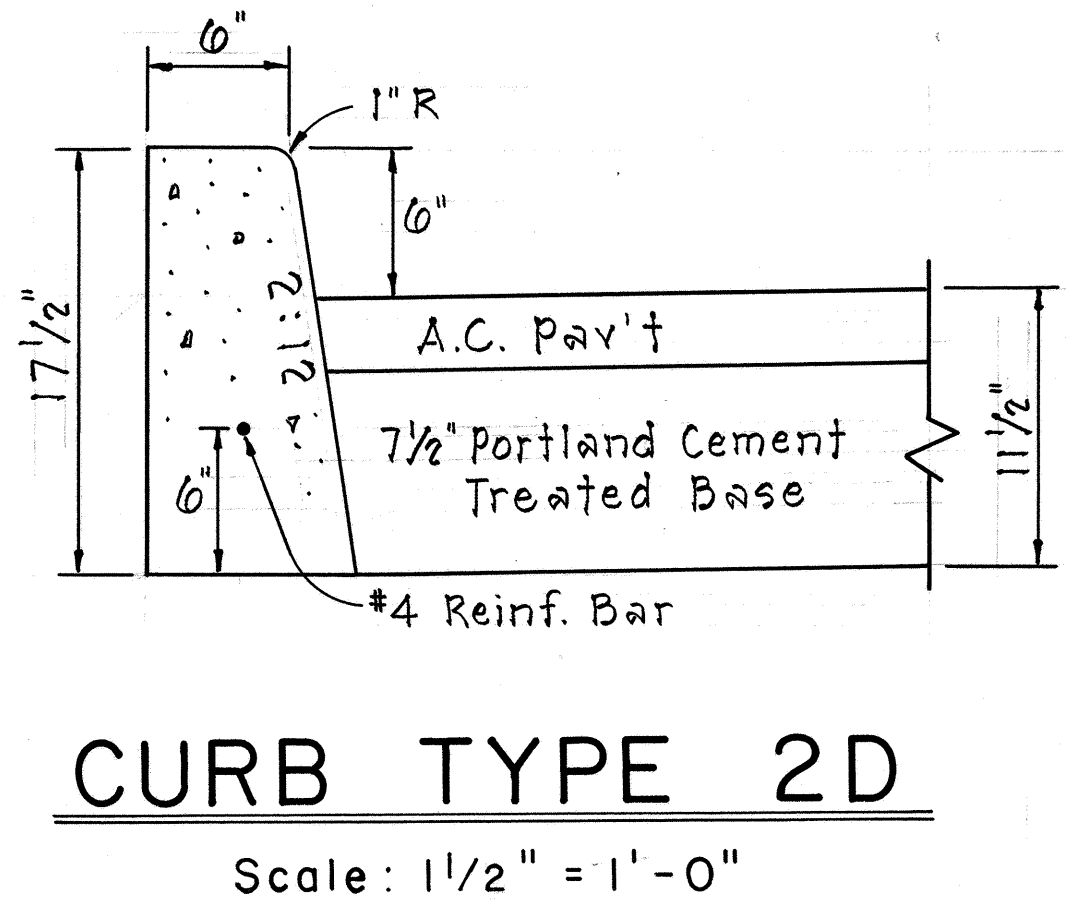


FED. ROAD DIST. NO.	STATE	FED. AID PROJ. NO.	FISCAL YEAR	SHEET NO.	TOTAL SHEETS
HAWAII	HAW.	U-090-1(15)	1967	3	40

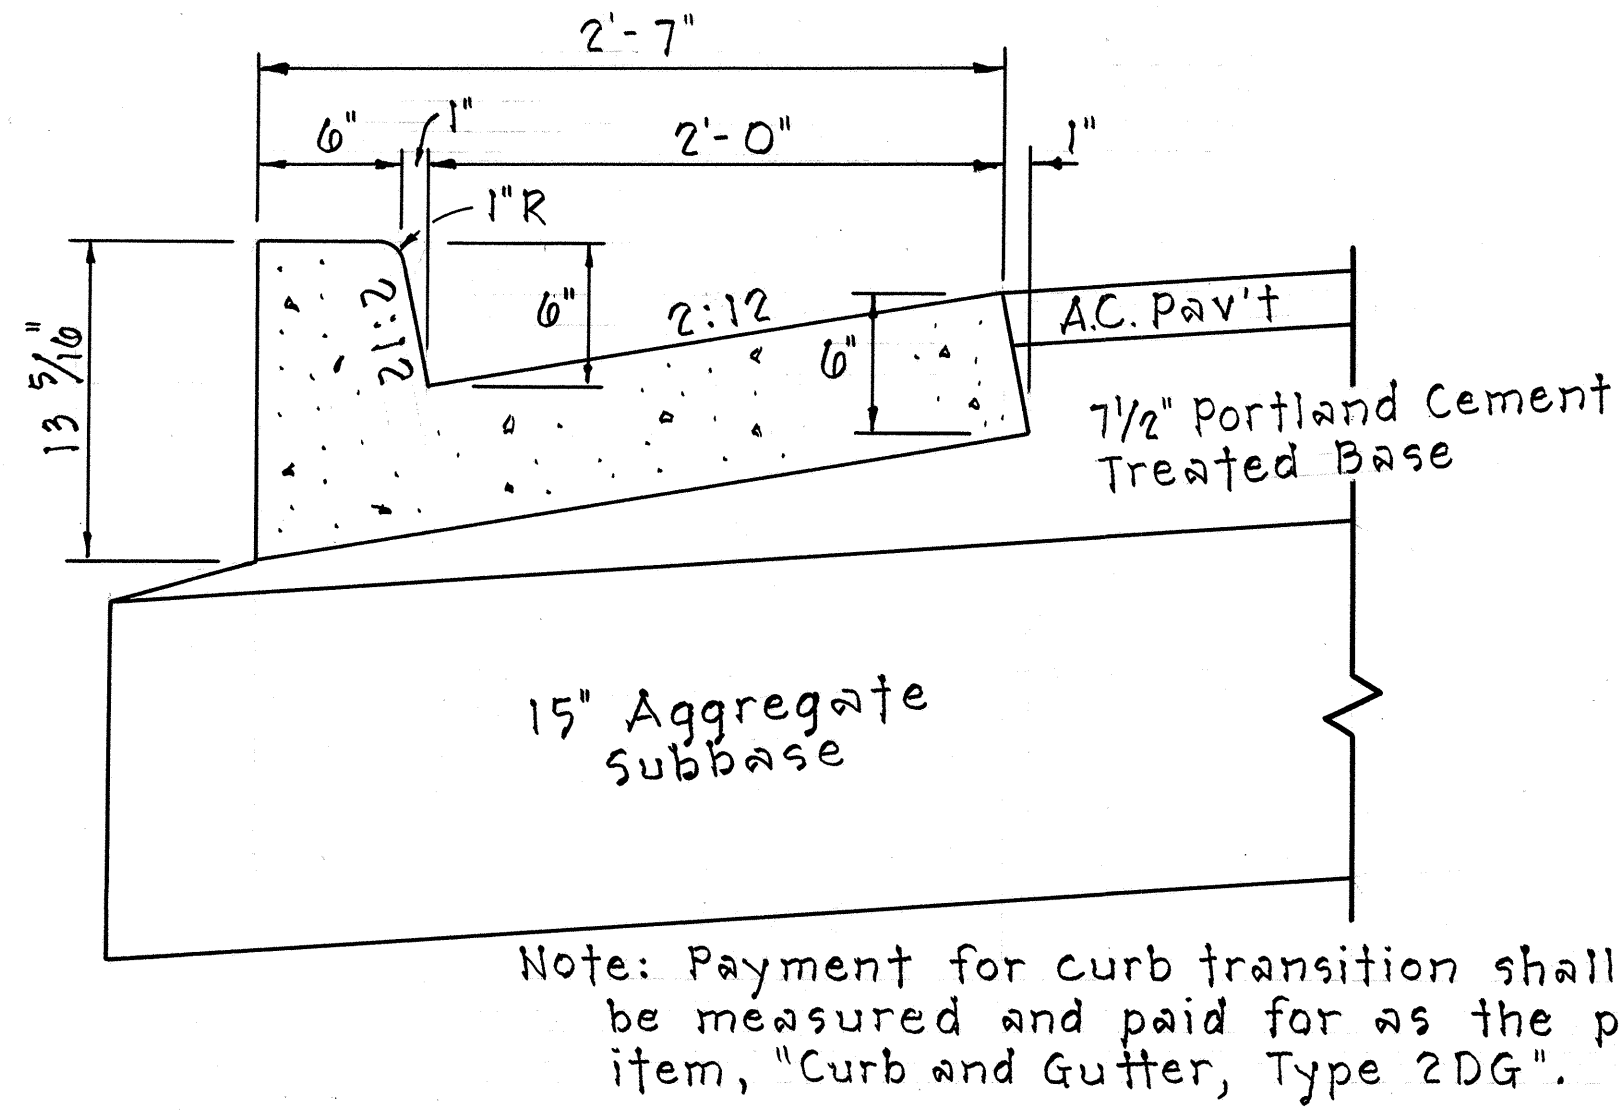

SPILLWAY DETAILS AT STA. 260+45 LT.
Scale: 3/8" = 1'-0"

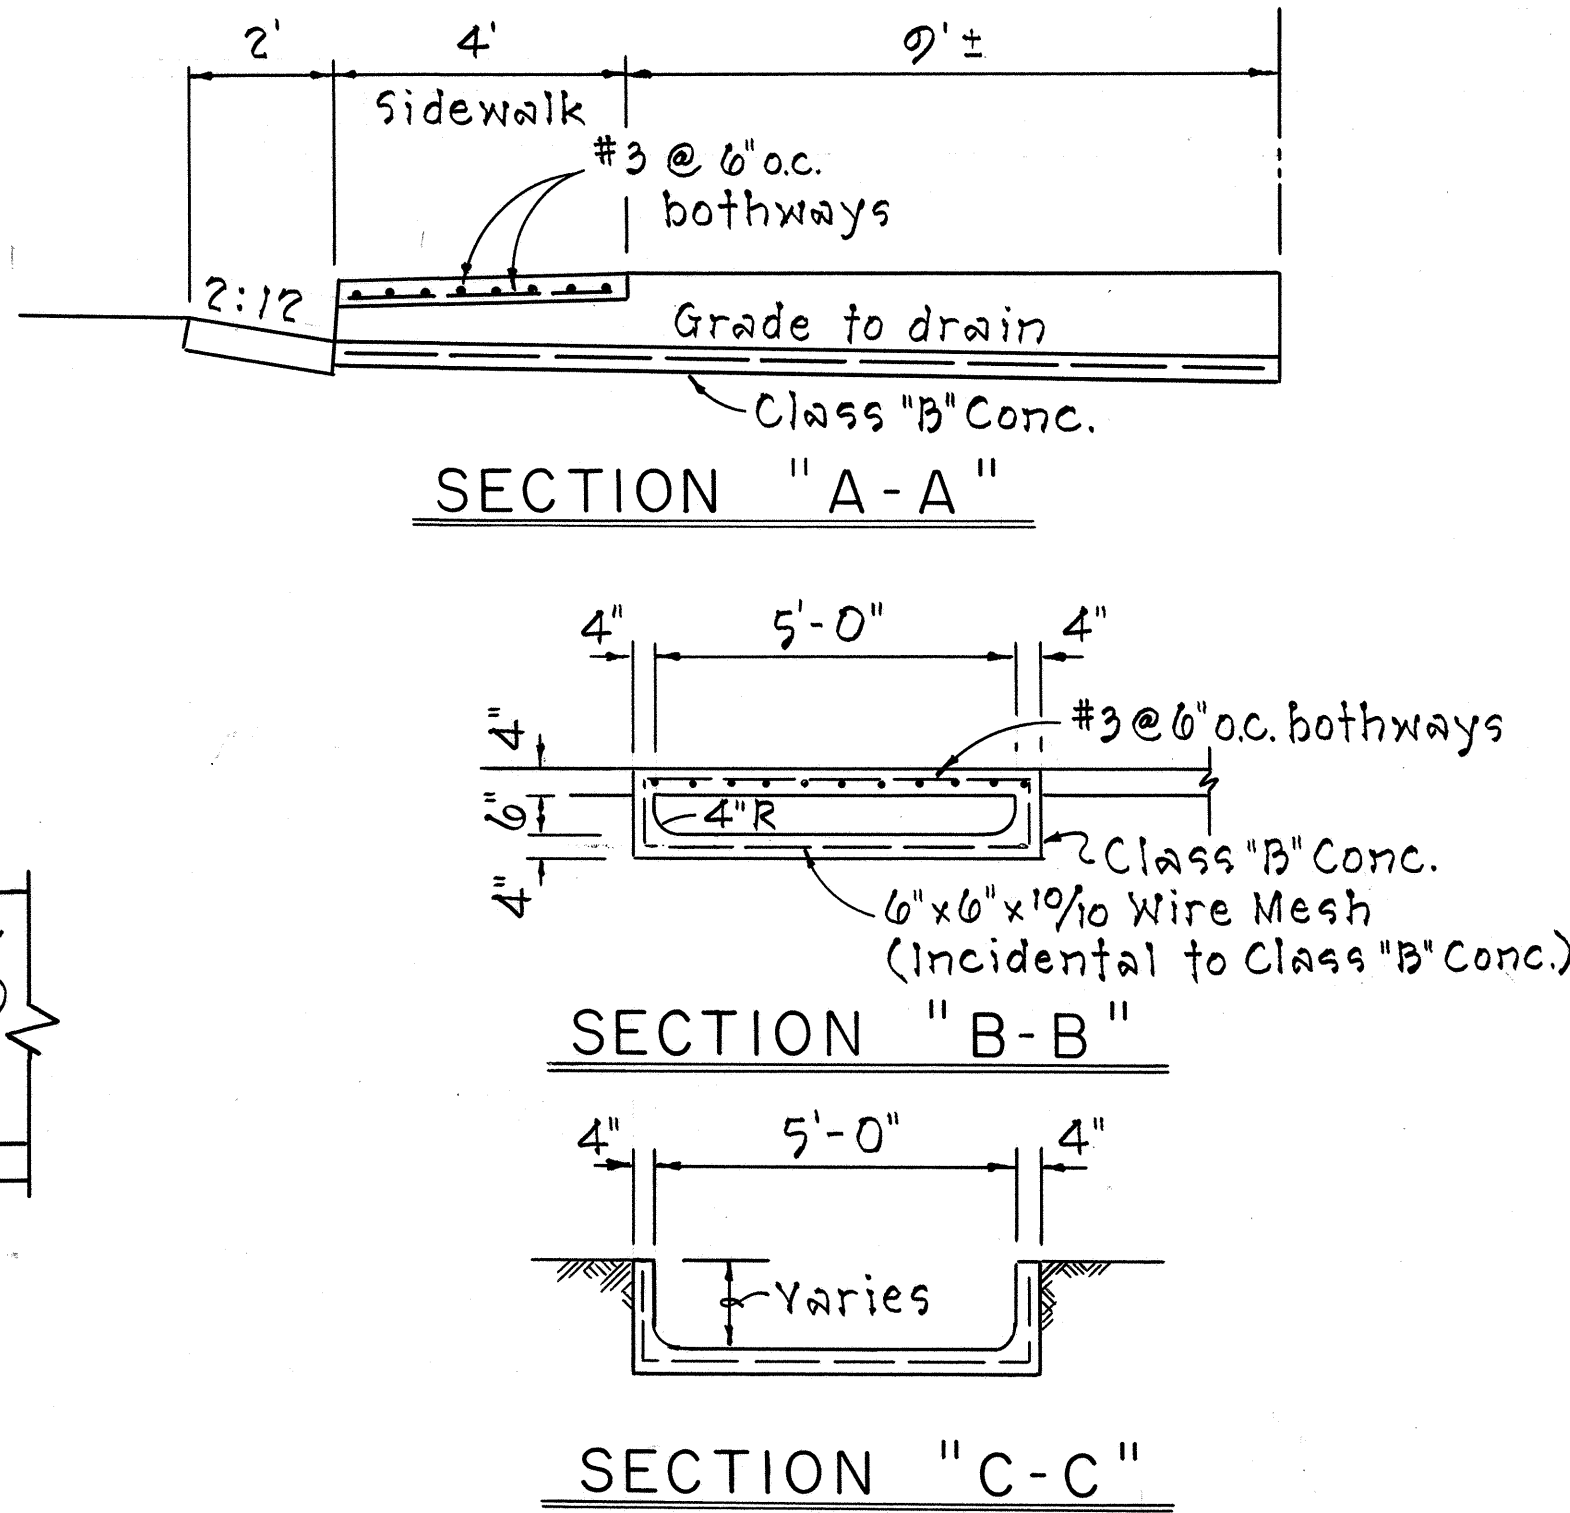

STATE OF HAWAII
DEPARTMENT OF TRANSPORTATION
HIGHWAYS DIVISION

MISCELLANEOUS DETAILS

PROJECT NO. U-090-1(15)
Scale: As Noted
SHEET No. 1 OF 8 SHEETS

ORIGINAL	DATE
PLAN	
NOTE BOOK	
NO.	

DESIGNED BY	DATE
TRACED BY	
QUANTITIES BY	
CHECKED BY	