
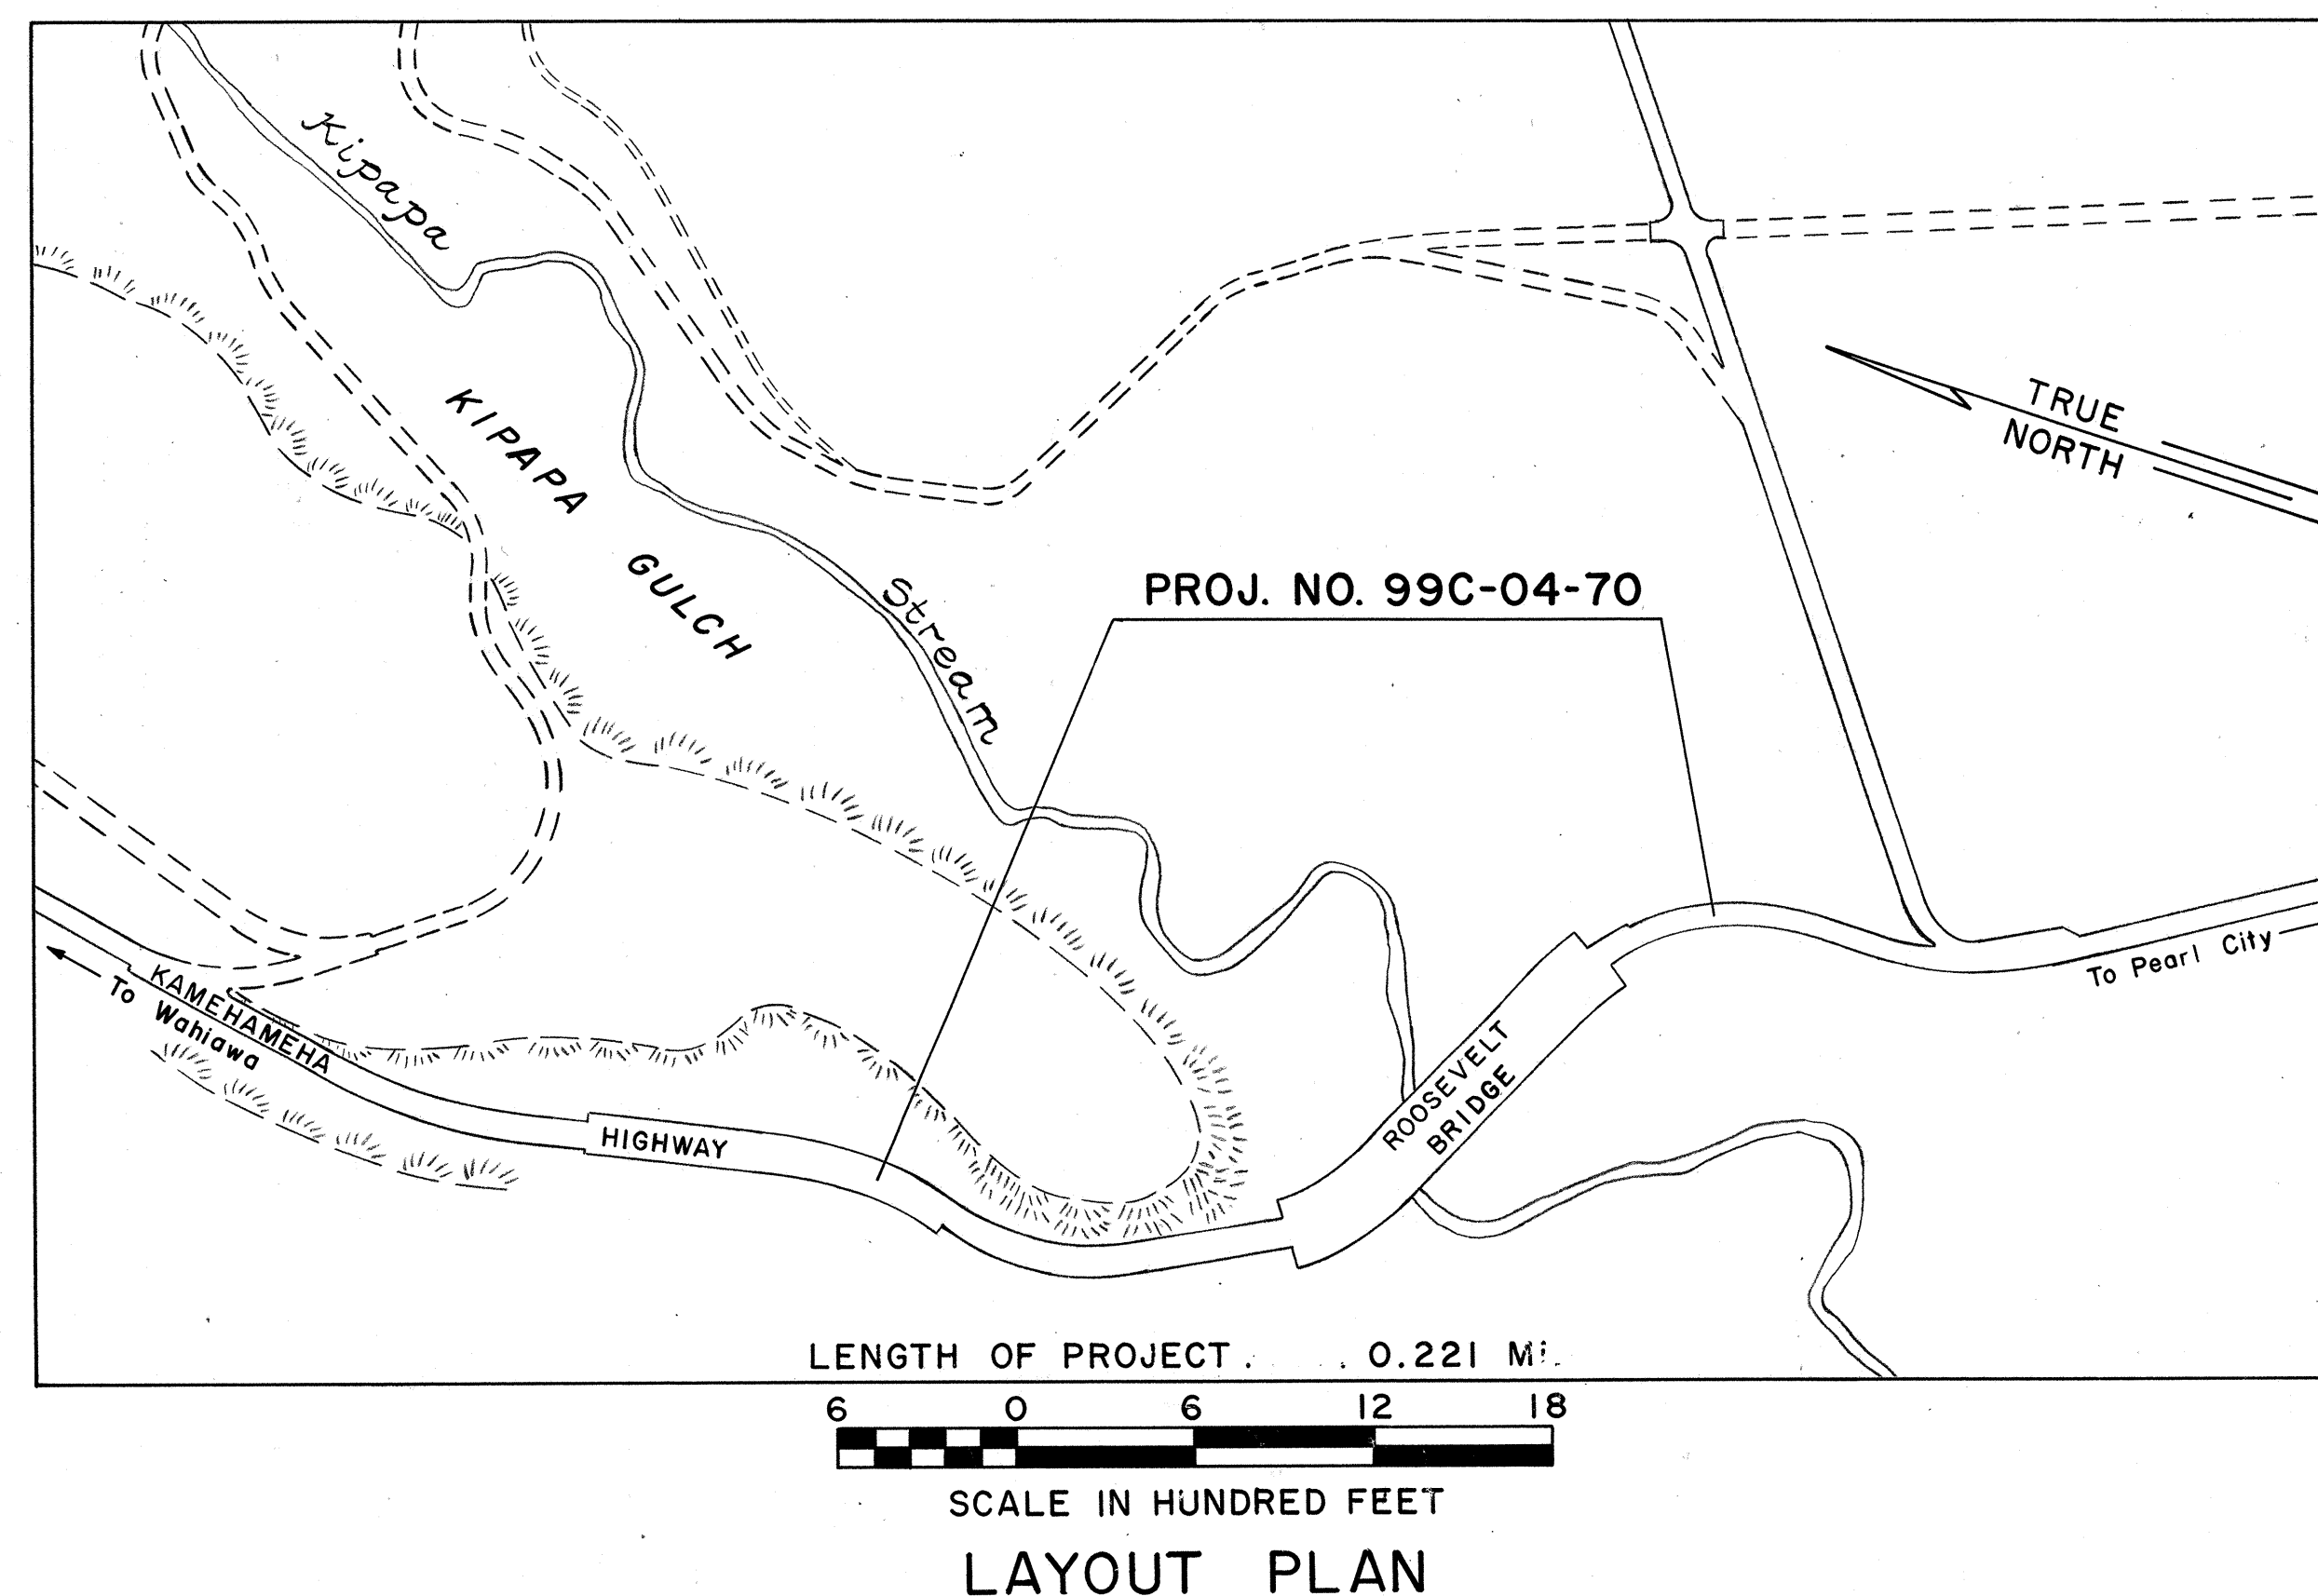


| INDEX TO DRAWINGS | |
|-------------------|--------------------|
| SHEET NO. | DESCRIPTION |
| 1 | TITLE SHEET |
| 2 | PLAN & DETAILS |
| 3-5 | ID. AND INFO SIGNS |
| | |
| | |
| | |

| FED. ROAD DIST. NO. | STATE | PROJ. NO. | FISCAL YEAR | SHEET NO. | TOTAL SHEETS |
|---------------------|-------|-----------|-------------|-----------|--------------|
| HAWAII | HAW. | 99C-04-70 | 1969 | 1 | 5 |

STATE OF HAWAII
DEPARTMENT OF TRANSPORTATION
HIGHWAYS DIVISION
HONOLULU, HAWAII
"AS BUILT"
PLANS FOR
REPLACEMENT OF CHAIN LINK FENCE
ALONG KAMEHAMEHA HIGHWAY
AT KIPAPA
PROJECT NO. 99C-04-70

DISTRICT OF EWA
ISLAND OF OAHU

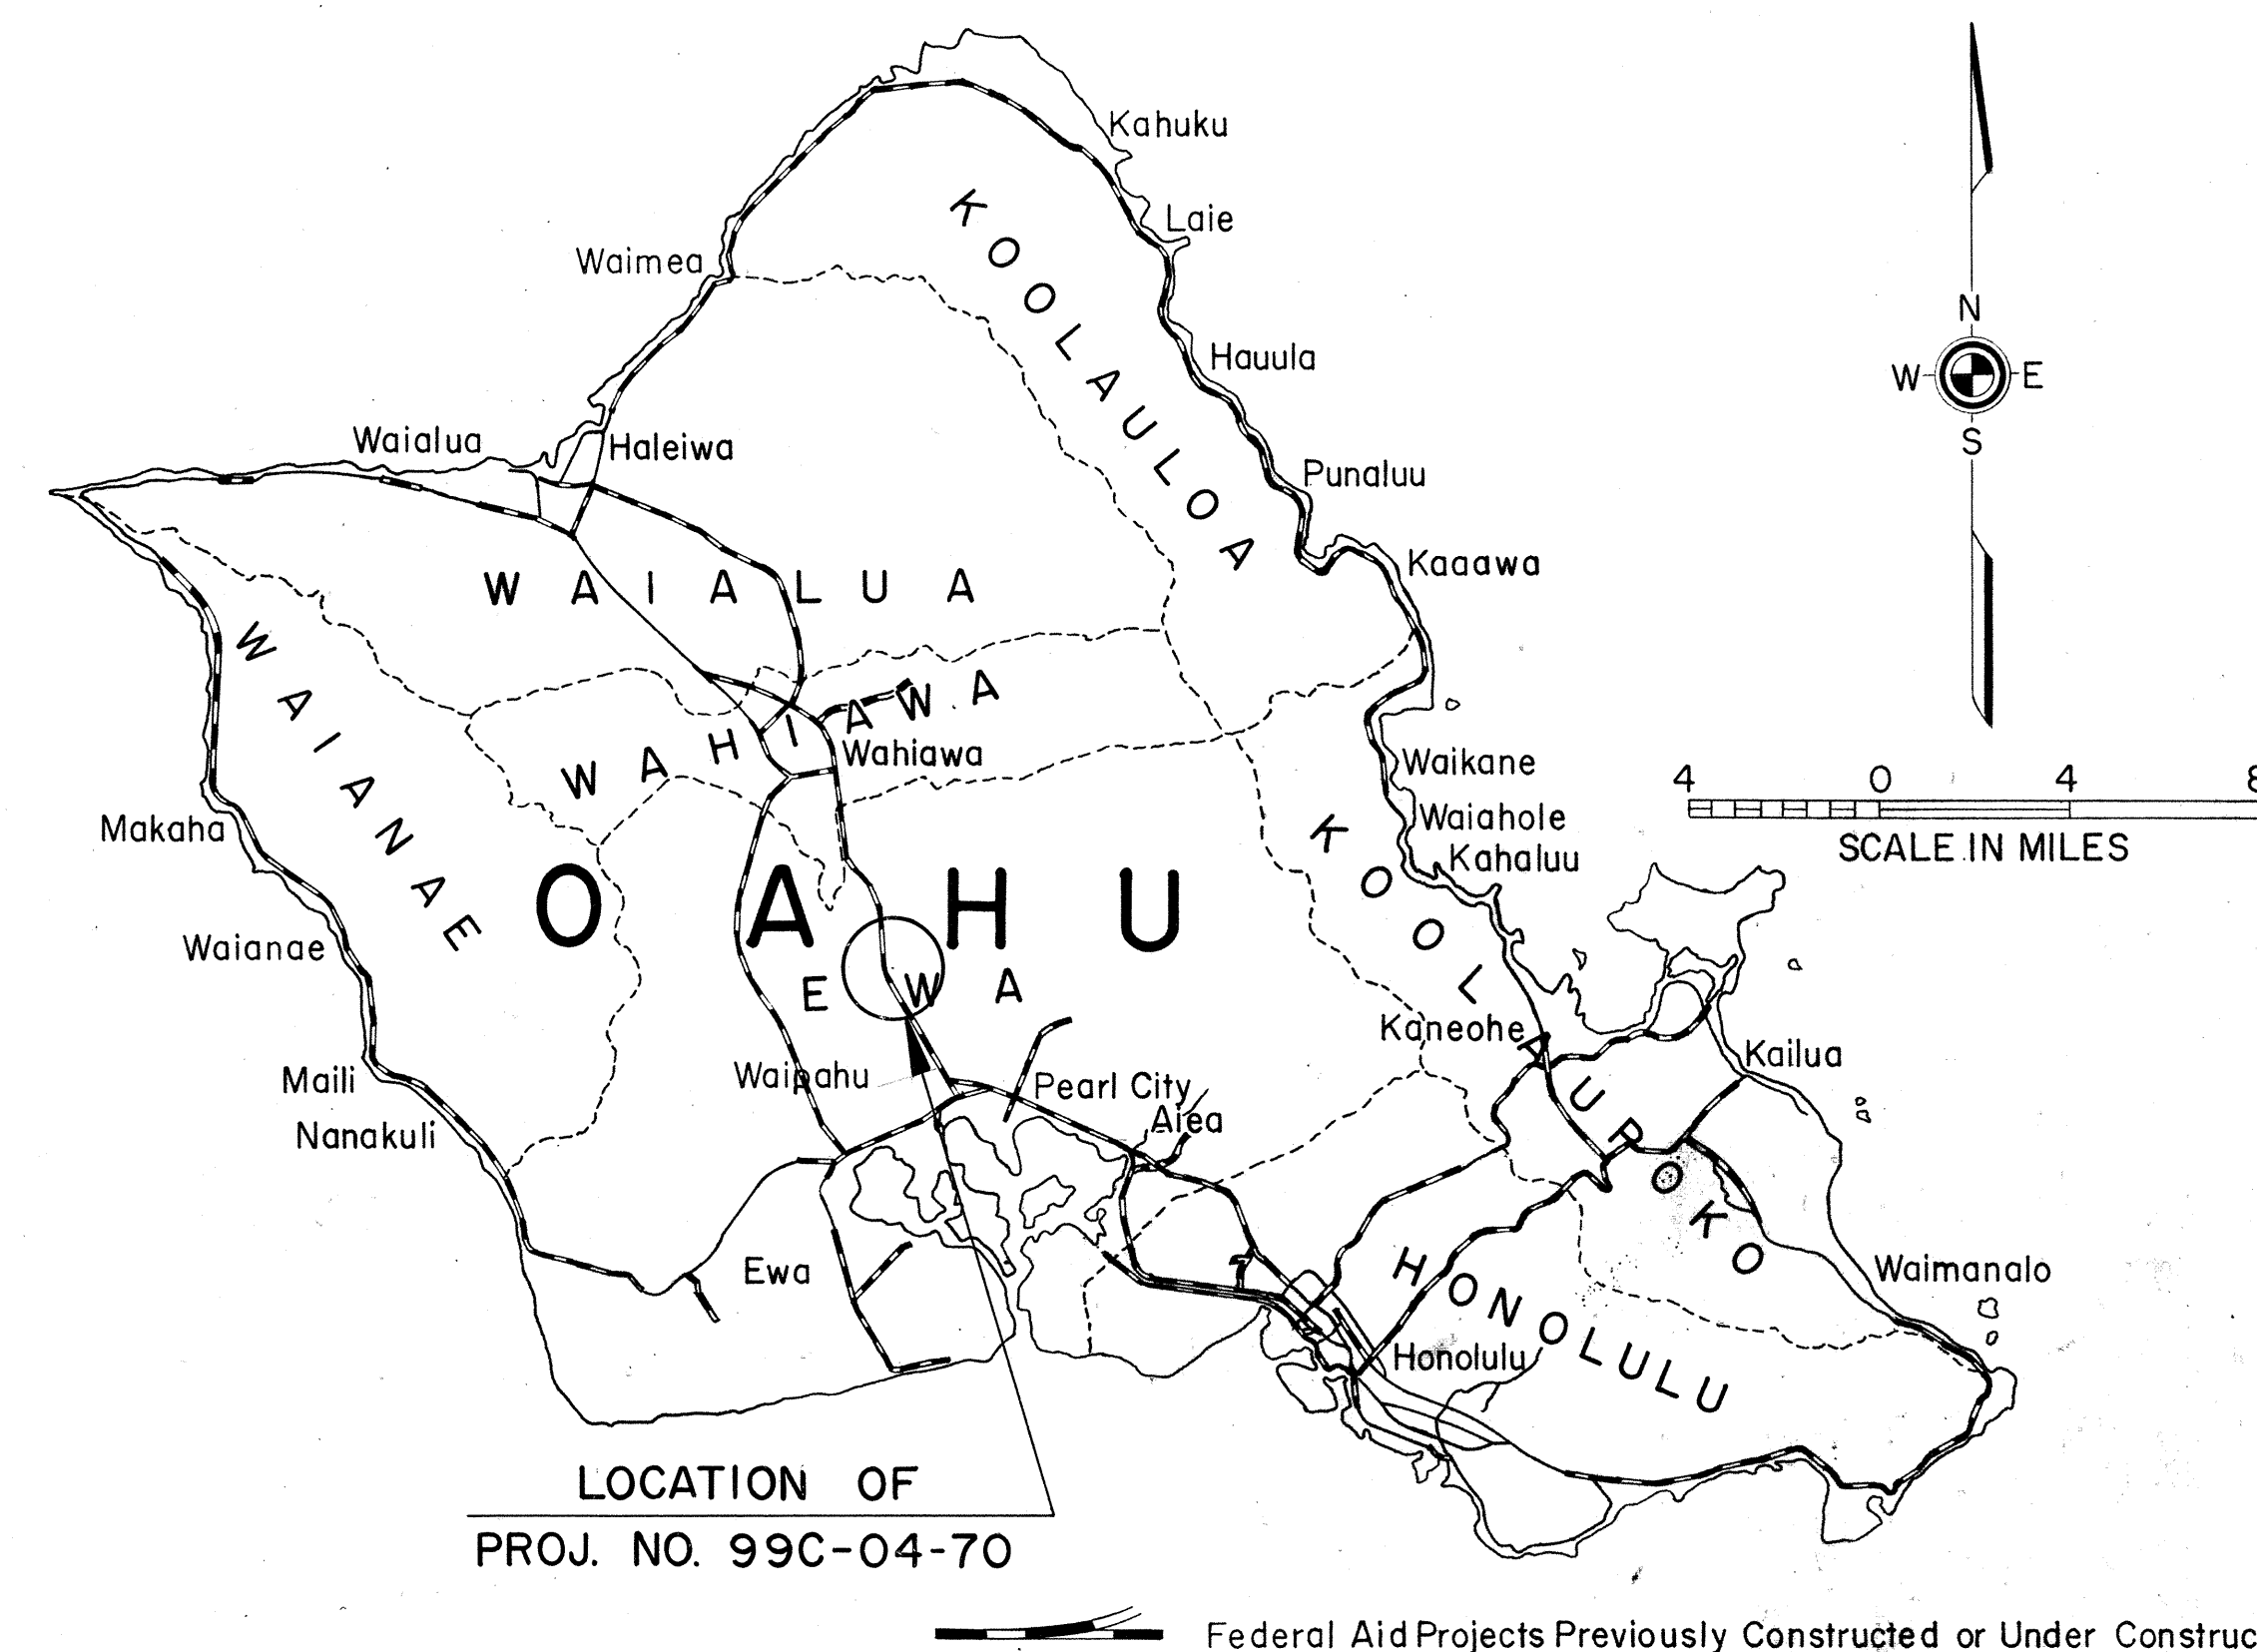

NOTE:

ALL CHANGES MADE DURING CONSTRUCTION HAVE BEEN NOTED IN RED ON THESE TRACINGS AND CHECKED BY

Thomas K. Lona 7/13/73
PROJECT ENGINEER DATE

DEPARTMENT OF TRANSPORTATION
STATE OF HAWAII
APPROVED:
E. Alvey Wright 2/16/70
for DIR. OF TRANSPORTATION DATE

Bridge Design Sect. DESIGNED BY: Ronald Tsuyuki PS&E BY: 5475-301 PHONE: Feb. 1970 DATE: