INDEX TO DRAWINGS	
SHEET NO.	DESCRIPTION
	TITLE SHEET
2	DETAIL ROADWAY PLAN
3	CONC. RETAINING WALL
4-9	STANDARD DETAILS
1.0	PROJ. INFORMATION SIGN



STATE OF HAWAII

DEPARTMENT OF TRANSPORTATION HIGHWAYS DIVISION

HONOLULU, HAWAII

"AS-BUILT"

FOR


CONSTRUCTION OF


FARRINGTON HIGHWAY

Inbound Right Turn Lane to Leeward College

PROJECT NO. 90A - 01 - 72

DISTRICT OF EWA

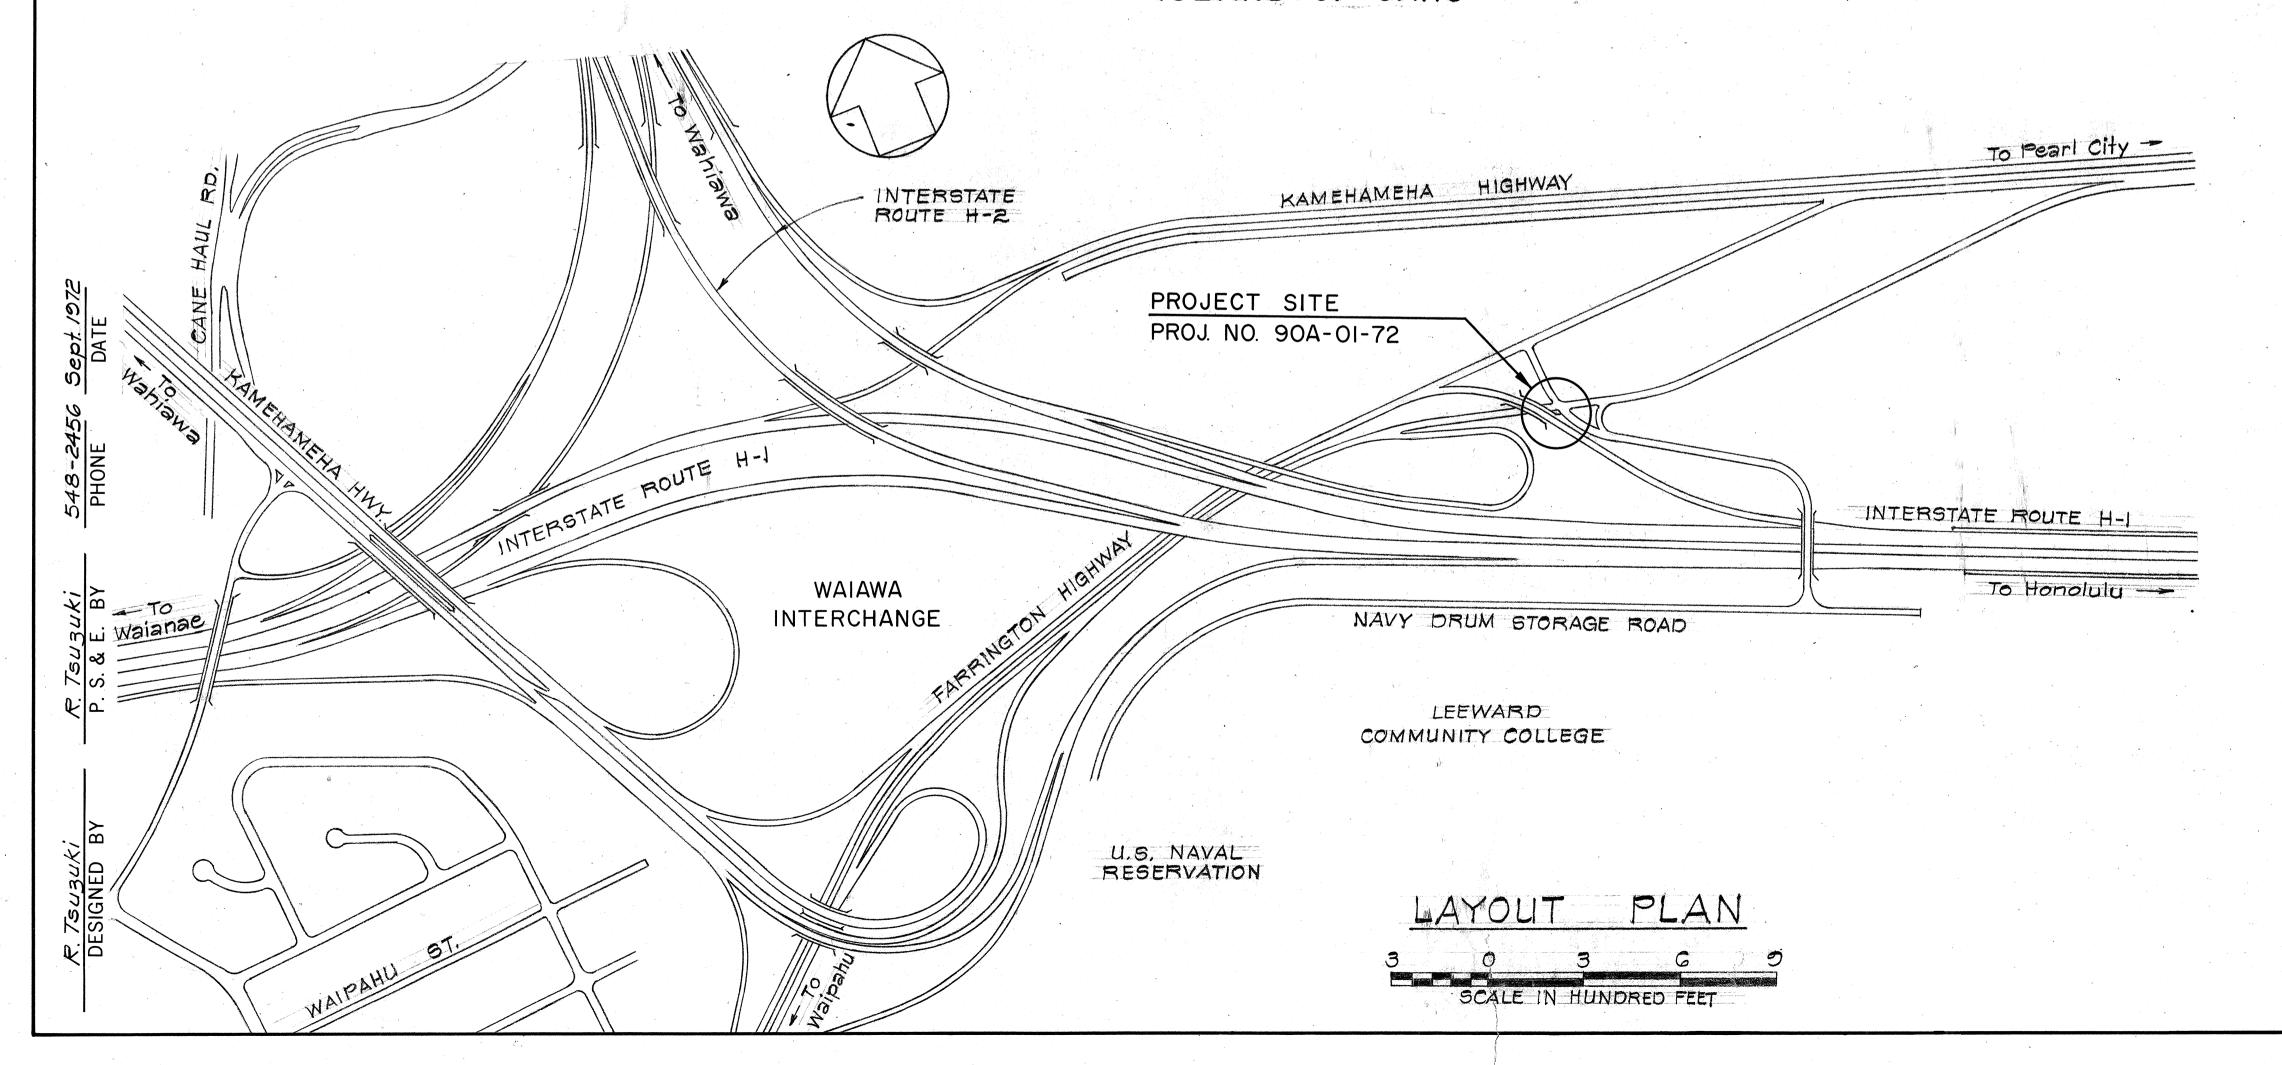

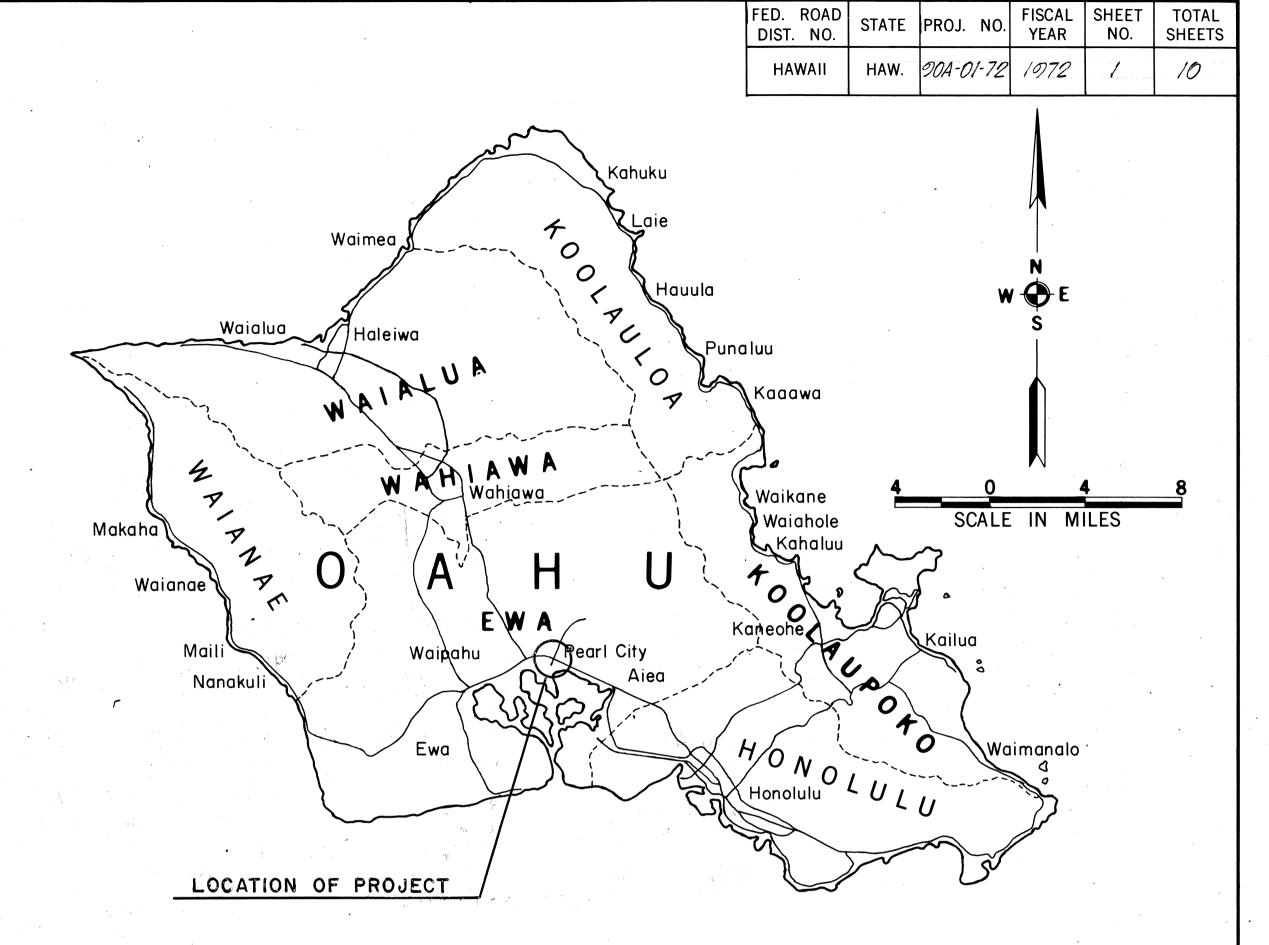

ALL CHANGES MADE DURING CONSTRUCTION HAVE BEEN INCORPORATED ON THESE PLANS IN RED EXCEPT CHANGES IN THE ORIGINAL THEORETICAL QUANTITIES FOR ACTUAL QUANTITIES, REFER TO PROJECT LEDGER AND/OR COMPUTATION BOOK.

R-T. Sandi 11-23-81 for RESIDENT ENGINEER DATE

DEPARTMENT OF TRANSPORTATION
STATE OF HAWAII

APPROVED:

Trunny Lee 10/25/72

FOR DIR. OF TRANSPORTATION DATE