



FED. ROAD DIST. NO.	STATE	PROJ. NO.	FISCAL YEAR	SHEET NO.	TOTAL SHEETS
HAWAII	HAW.	99C-01-99	2002	33	45

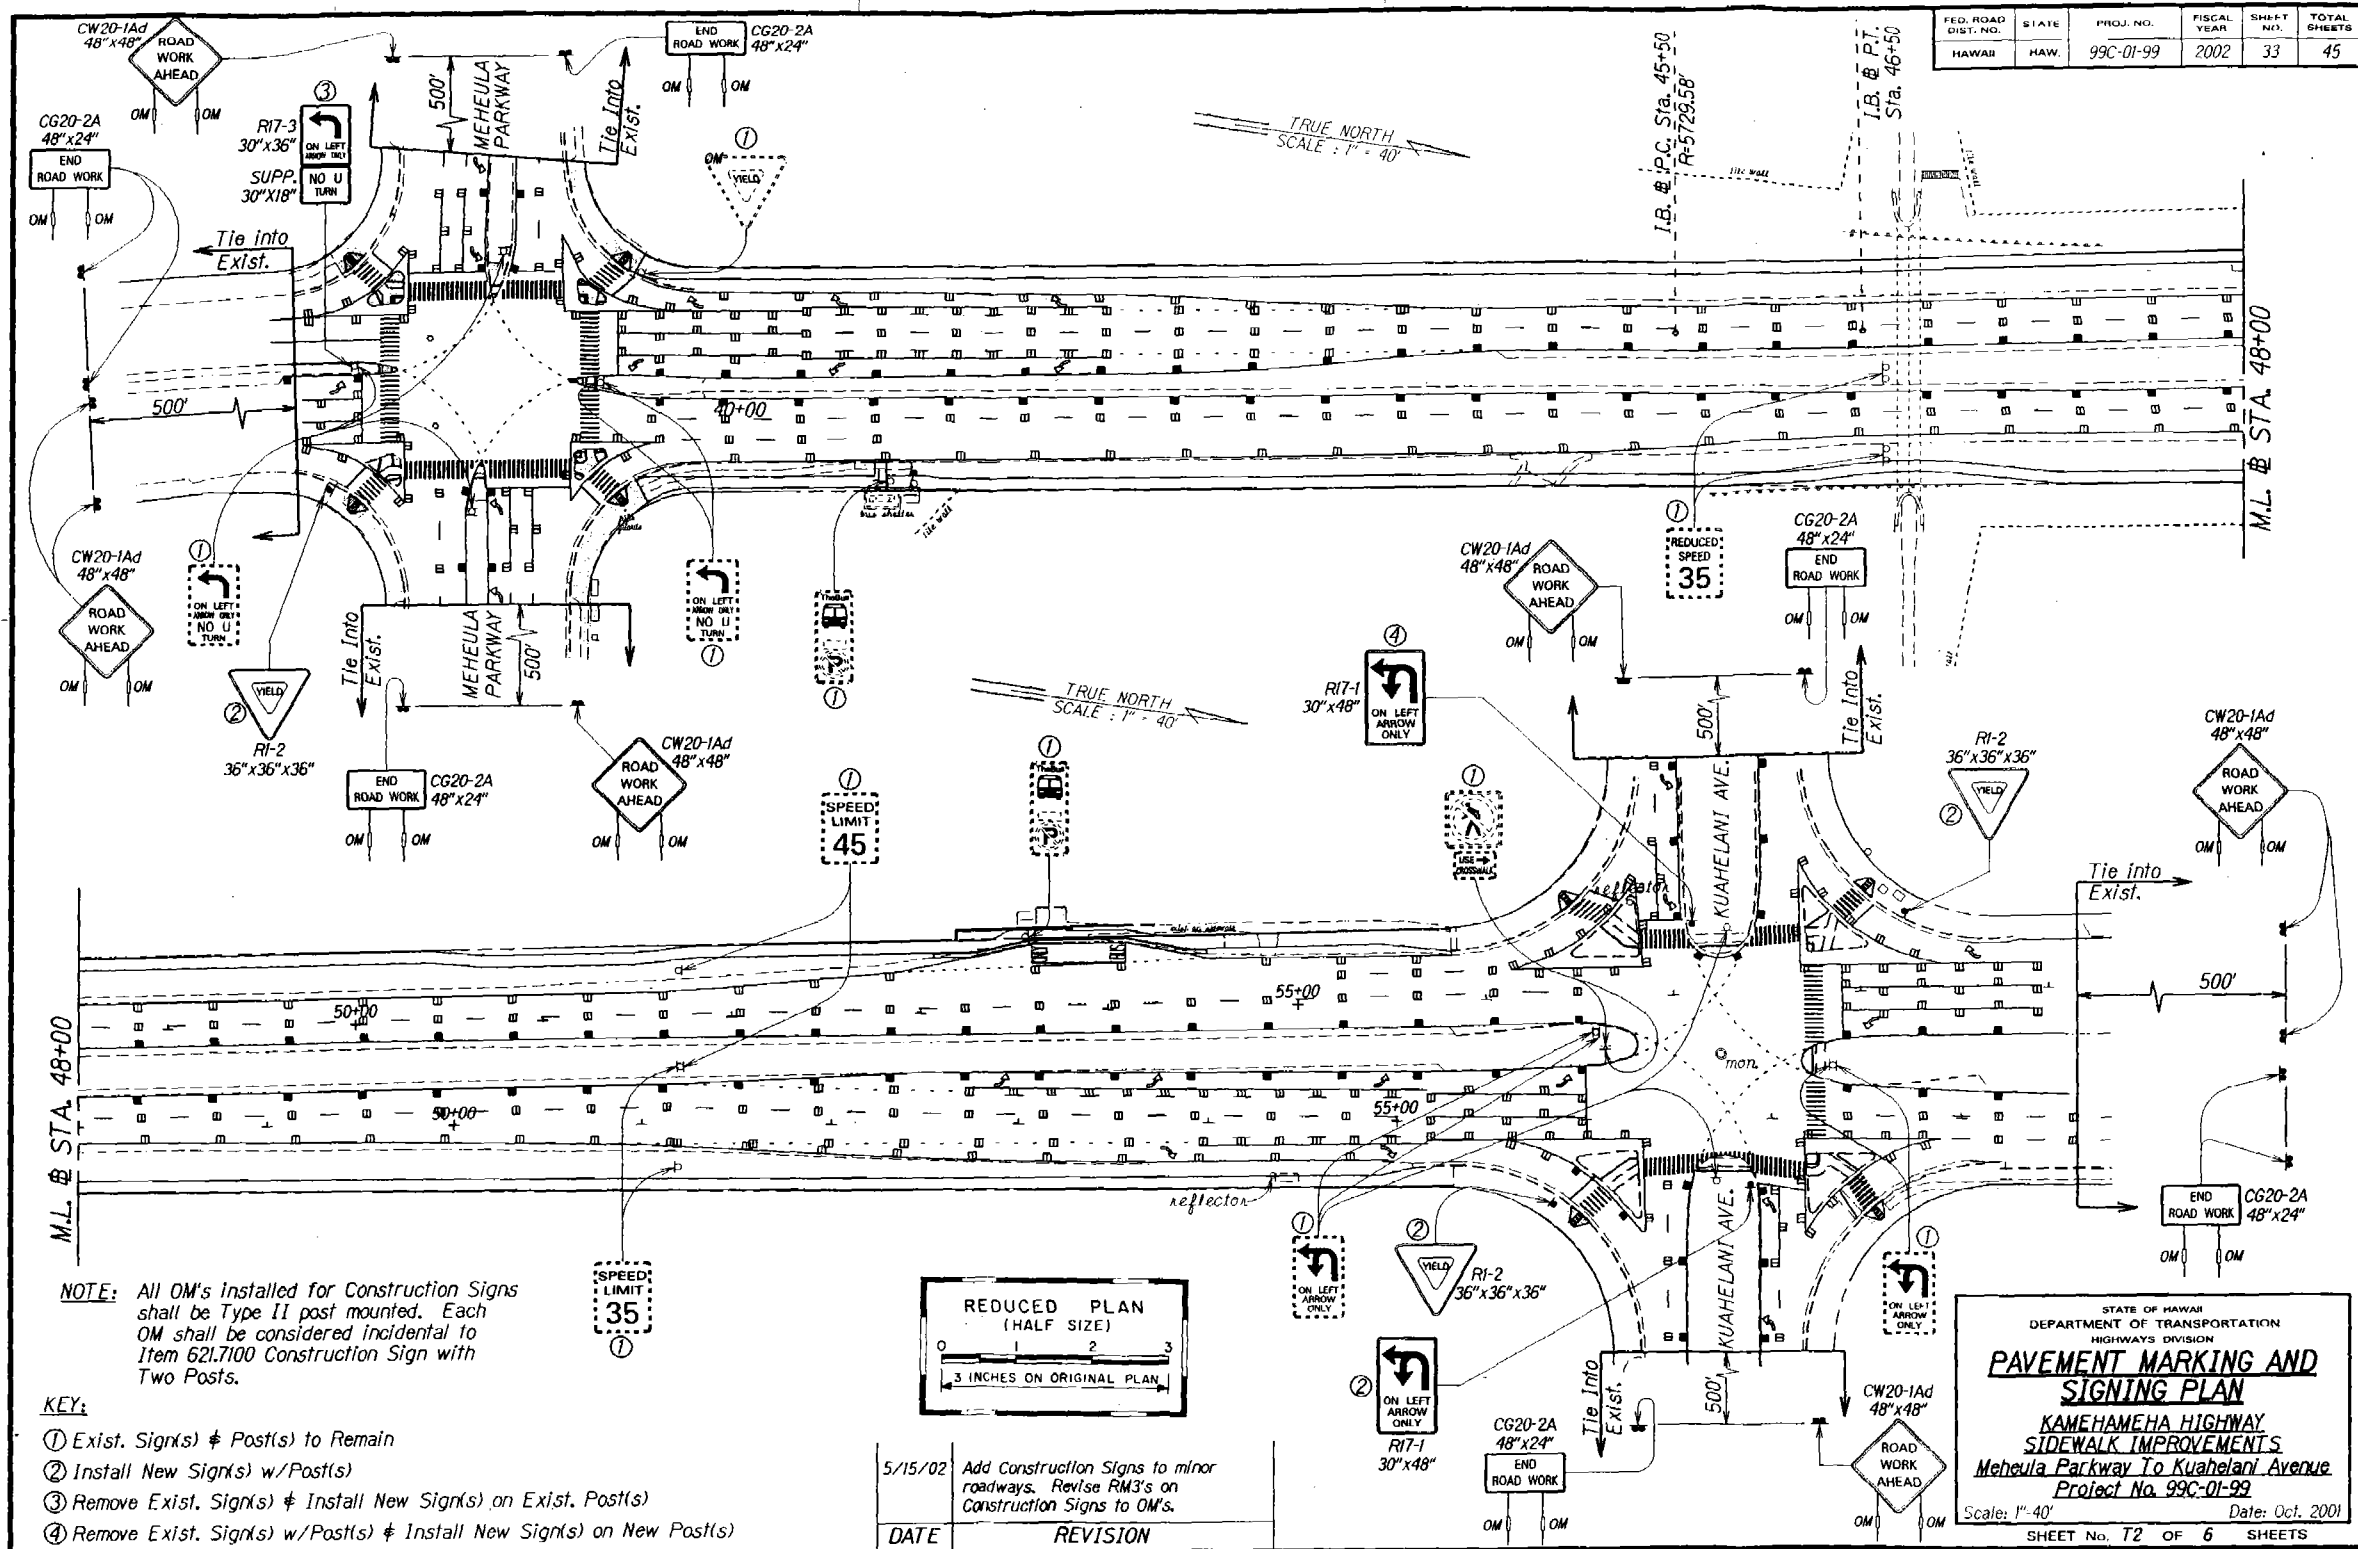

NOTE: All OM's installed for Construction Signs shall be Type II post mounted. Each OM shall be considered incidental to Item 621.7100 Construction Sign with Two Posts.

KEY:

- ① Exist. Sign(s) & Post(s) to Remain
- ② Install New Sign(s) w/Post(s)
- ③ Remove Exist. Sign(s) & Install New Sign(s) on Exist. Post(s)
- ④ Remove Exist. Sign(s) w/Post(s) & Install New Sign(s) on New Post(s)

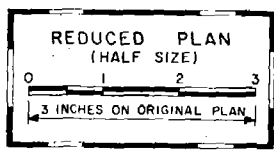

5/15/02	Add Construction Signs to minor roadways. Revise RM3's on Construction Signs to OM's.
DATE	REVISION

STATE OF HAWAII
DEPARTMENT OF TRANSPORTATION
HIGHWAYS DIVISION

PAVEMENT MARKING AND SIGNING PLAN

**KAMEHAMEHA HIGHWAY
SIDEWALK IMPROVEMENTS
Meheula Parkway To Kuahelani Avenue
Project No. 99C-01-99**

Scale: 1"=40' Date: Oct. 2001

SHEET No. T2 OF 6 SHEETS