




FED. ROAD DIST. NO.	STATE	PROJ. NO.	FISCAL YEAR	SHEET NO.	TOTAL SHEETS
HAWAII	HAW.	99C-01-99	2002	15	45

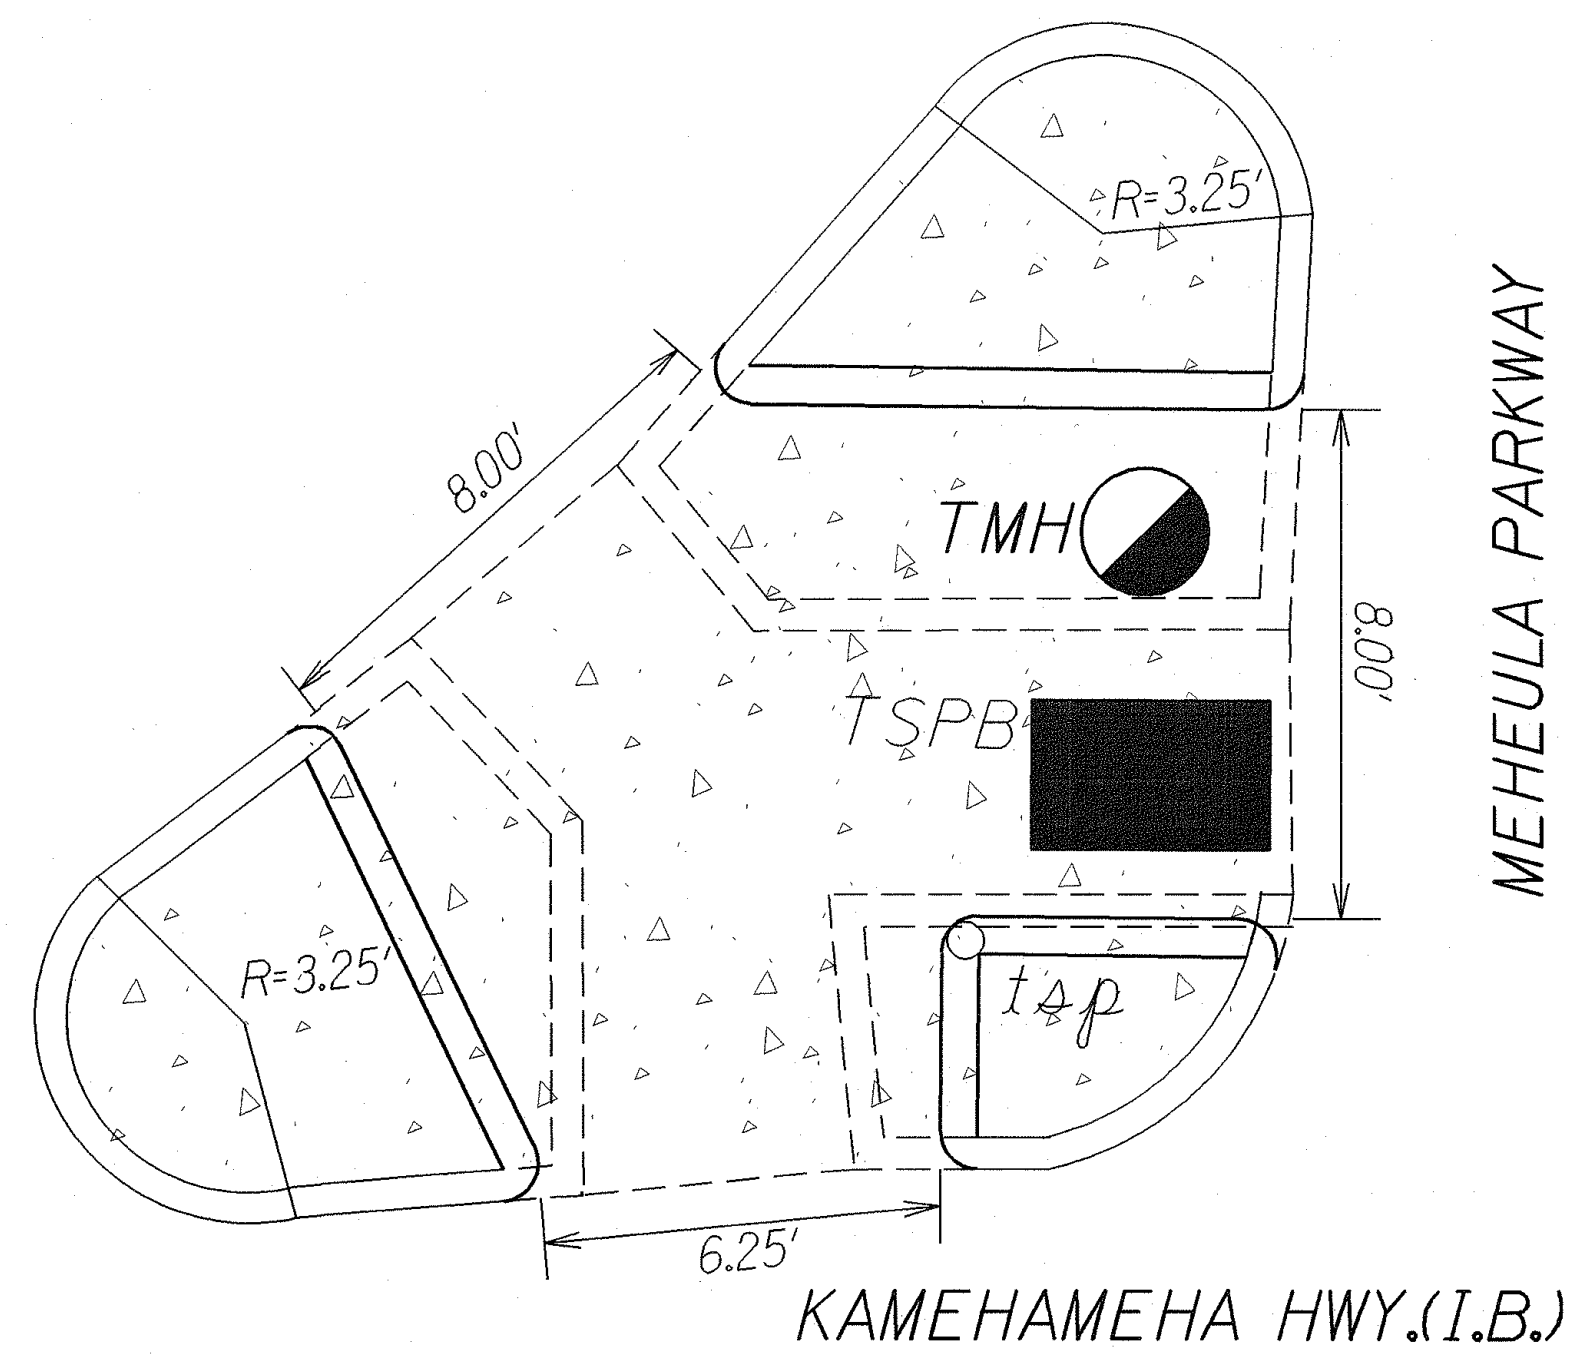


CURB RAMP - MODIFIED TYPE "C" *
Scale: 1"=3.0'

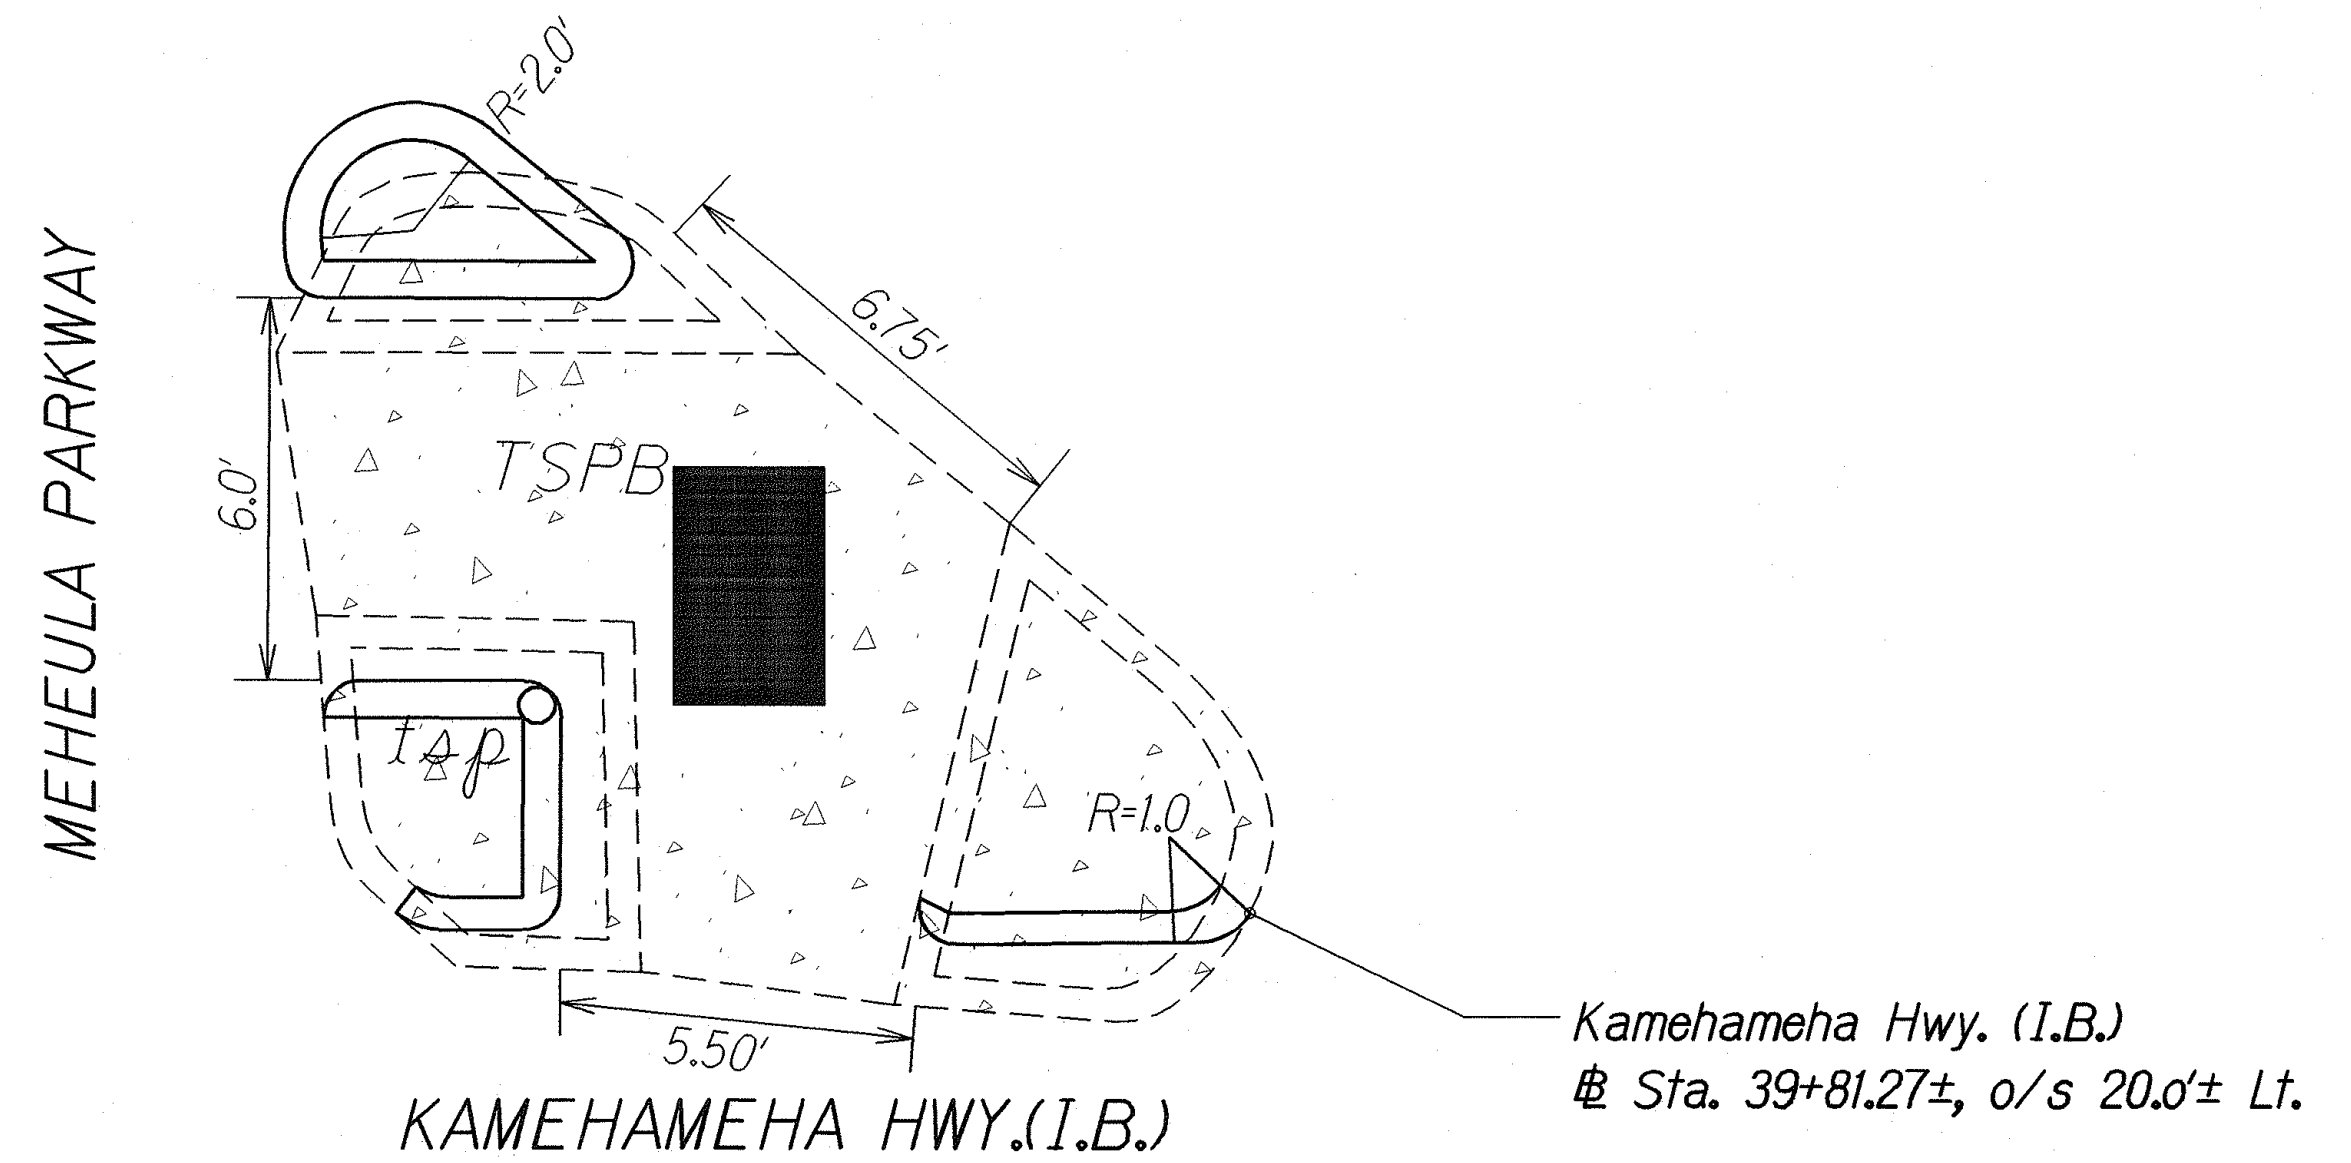

CURB RAMP - MODIFIED TYPE "C" *
Scale: 1"=3.0'

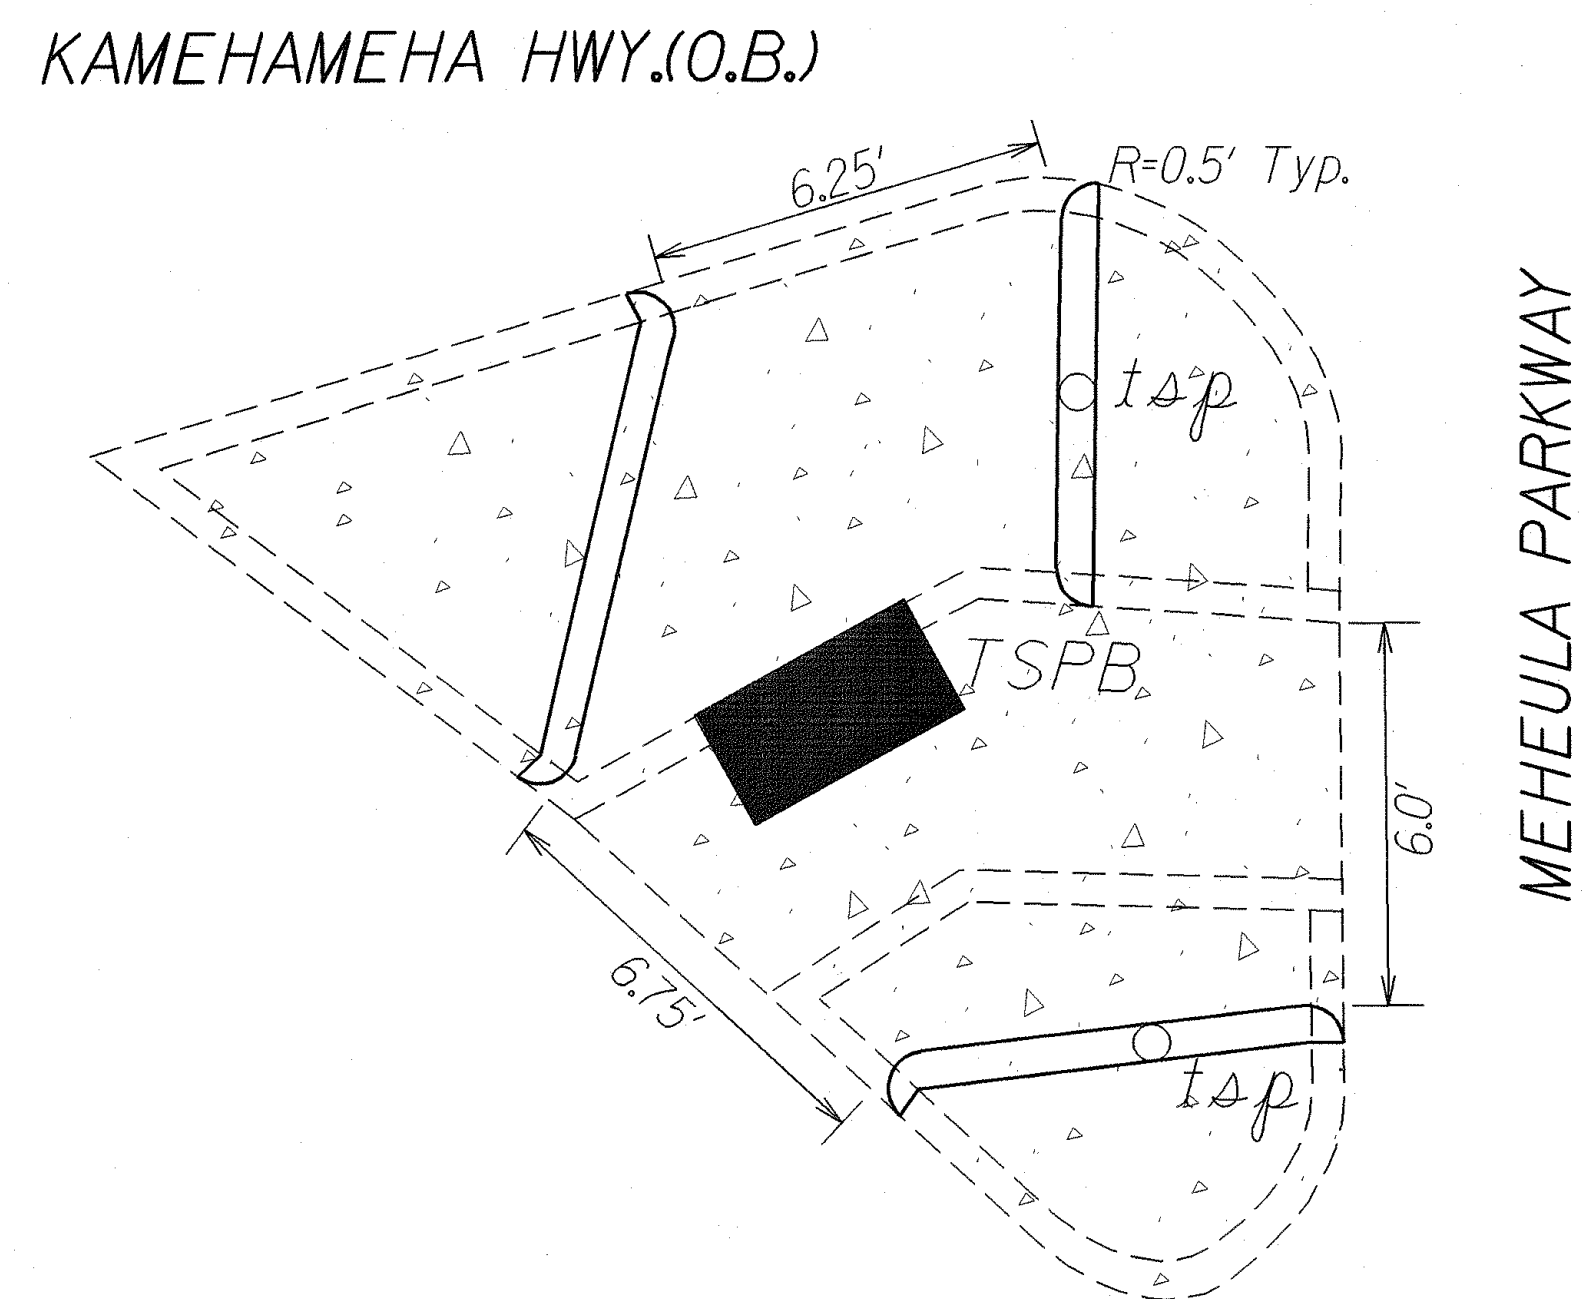

CURB RAMP - MODIFIED TYPE "C" *
Scale: 1"=3.0'

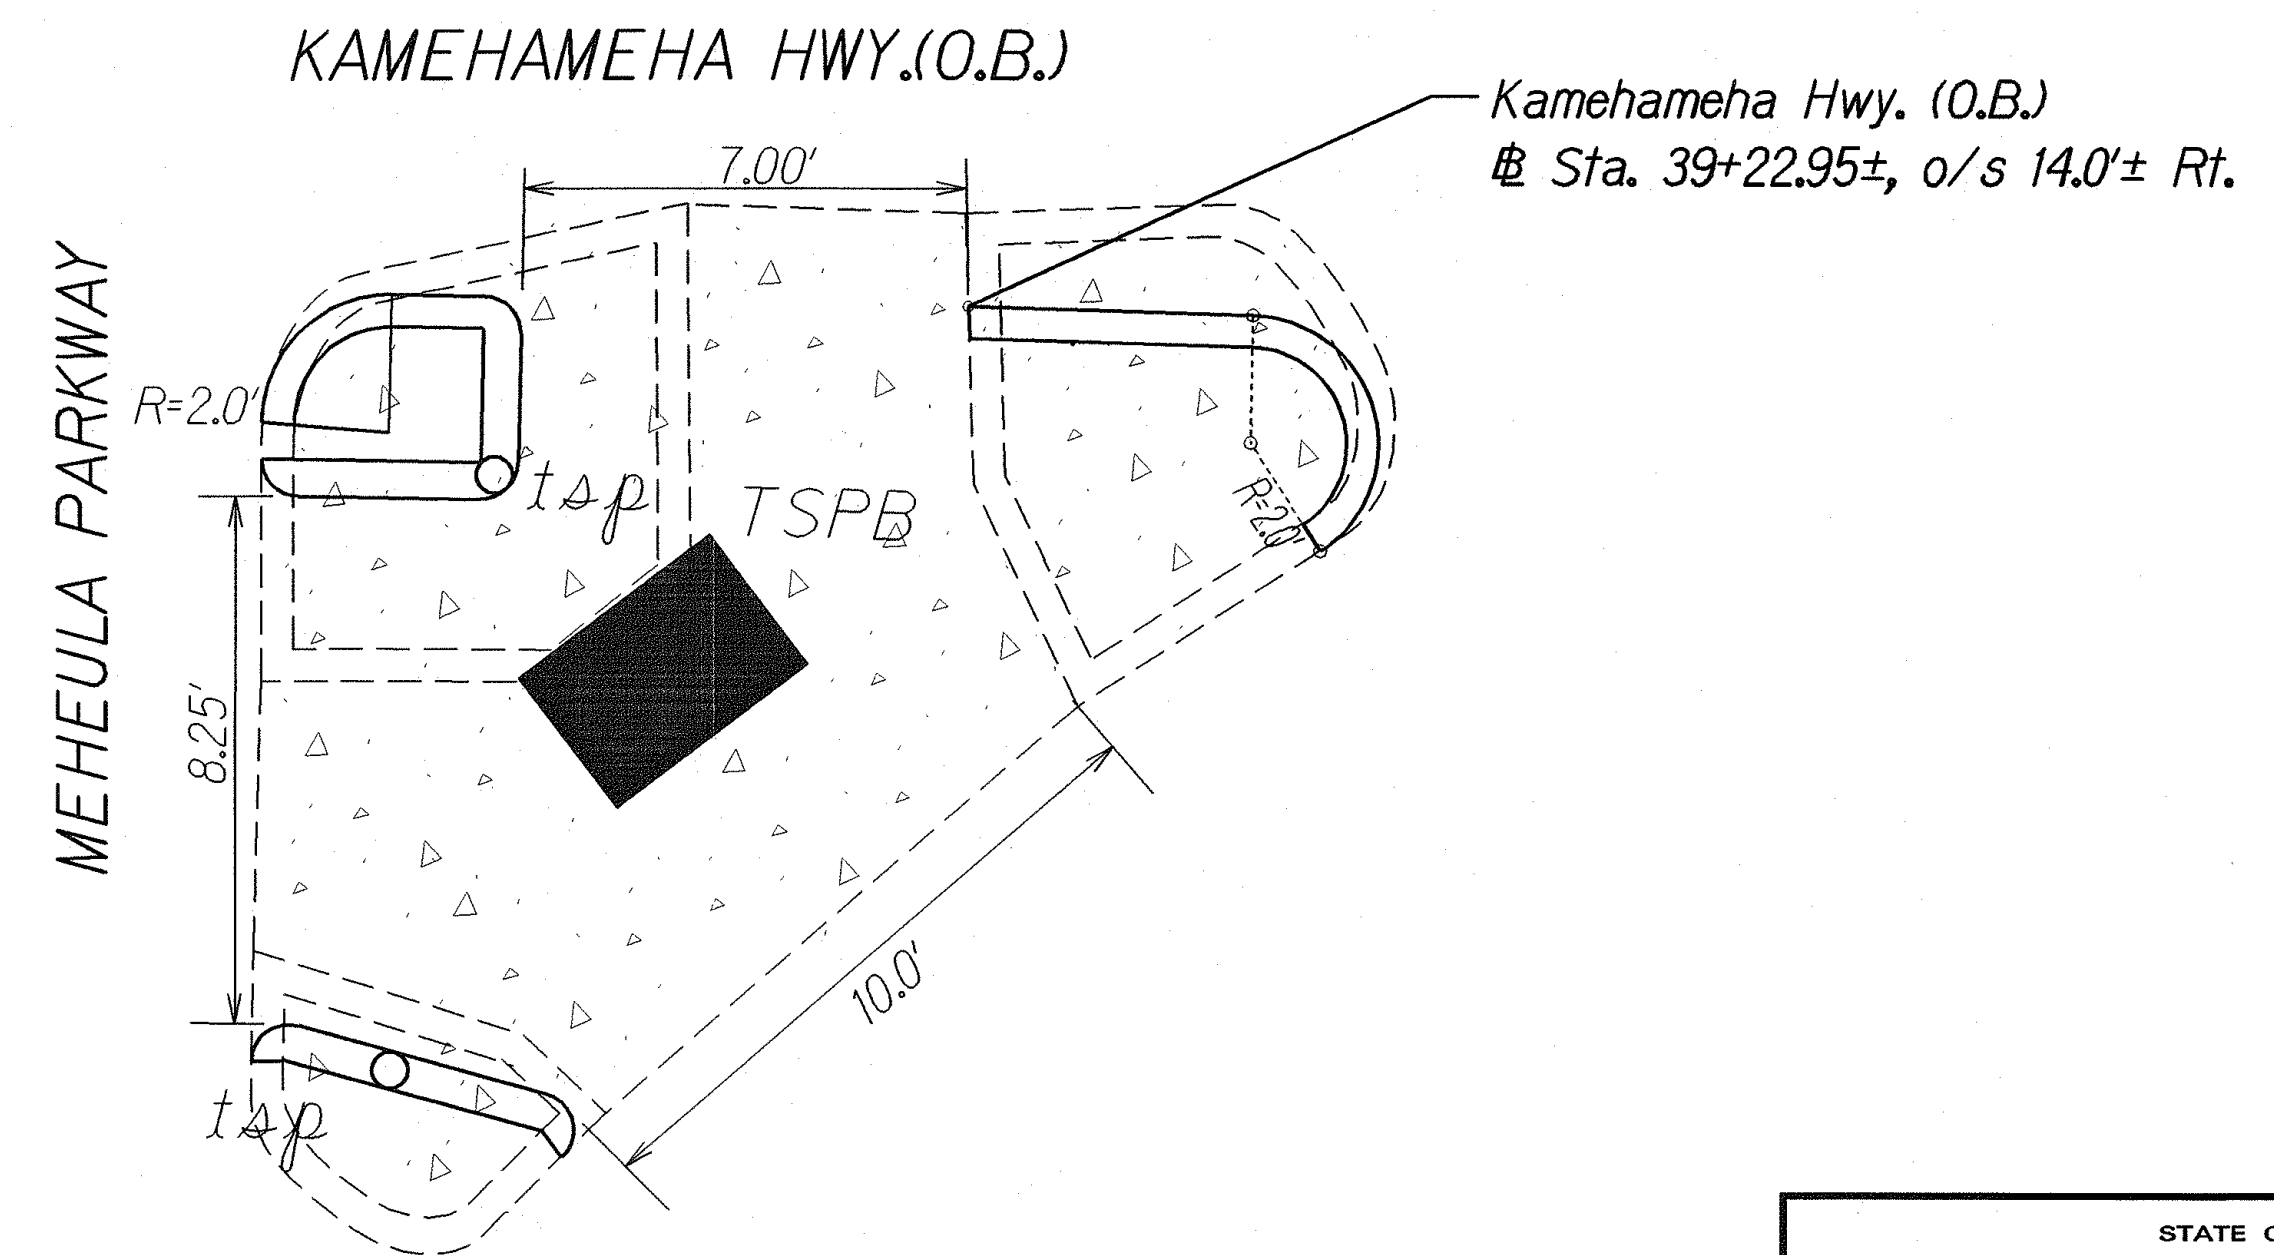

CURB RAMP - MODIFIED TYPE "C" *
Scale: 1"=3.0'





* Demolish and Reconstruct as necessary.

ORIGINAL PLAN	SURVEY PLOTTED BY	DATE
DESIGNED BY	DESIGNED BY	DESIGNED BY
NOTED BY	NOTED BY	NOTED BY
CHECKED BY	CHECKED BY	CHECKED BY
N.	N.	N.

STATE OF HAWAII
DEPARTMENT OF TRANSPORTATION
HIGHWAYS DIVISION
ISLAND DETAILS
KAMEHAMEHA HIGHWAY
SIDEWALK IMPROVEMENTS
Meheula Parkway to Kuahelani Avenue
Project No. 99C-01-99
Scale: 1" = 3.0'

Date: June, 2001
SHEET No. 1 OF 2 SHEETS

FED. ROAD DIST. NO.	STATE	PROJ. NO.	FISCAL YEAR	SHEET NO.	TOTAL SHEETS
HAWAII	HAW.	99C-01-99	2002	16	45

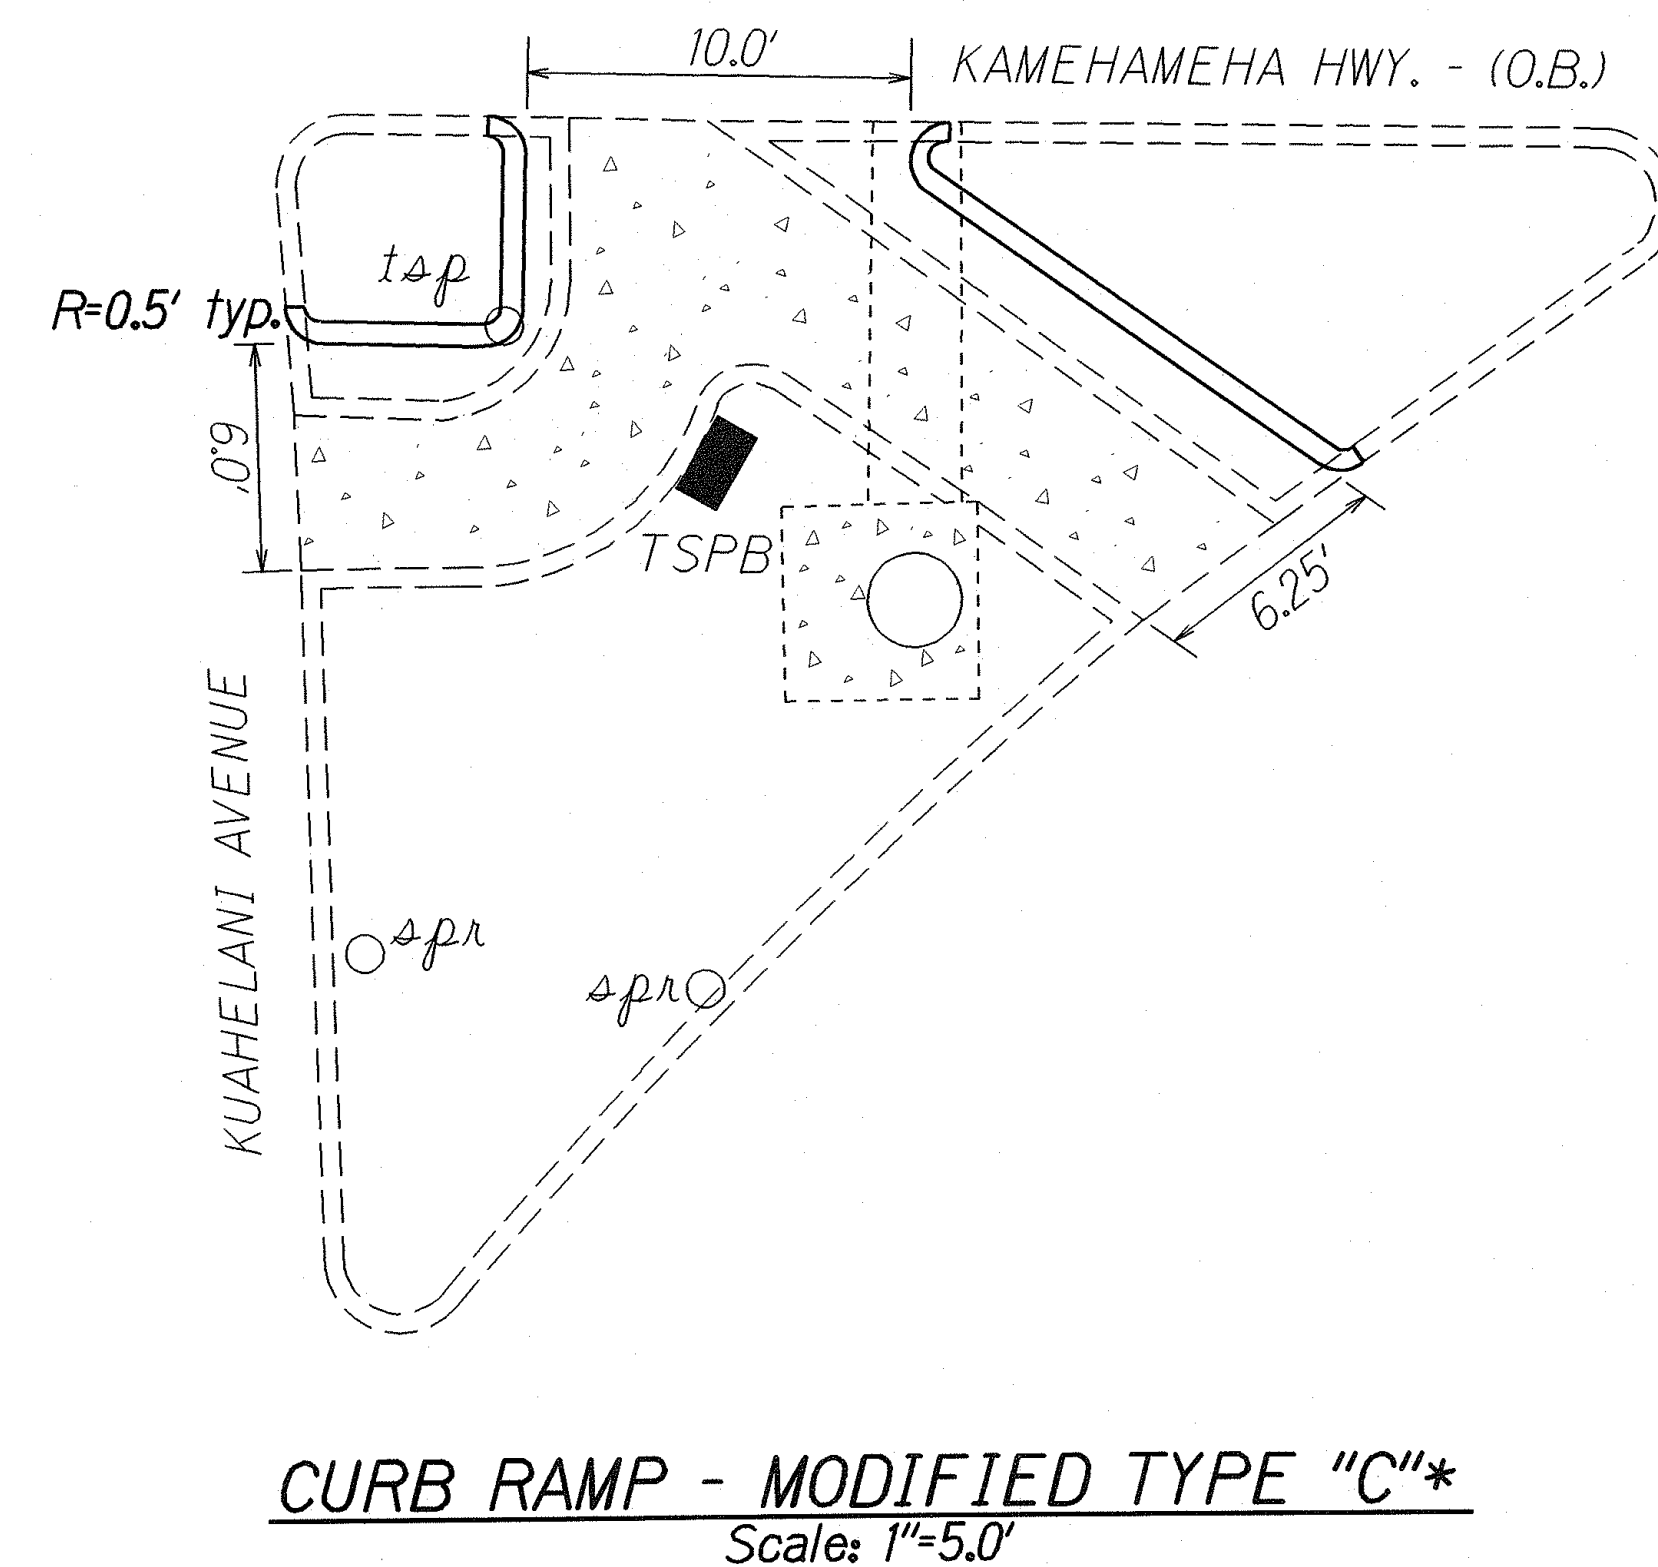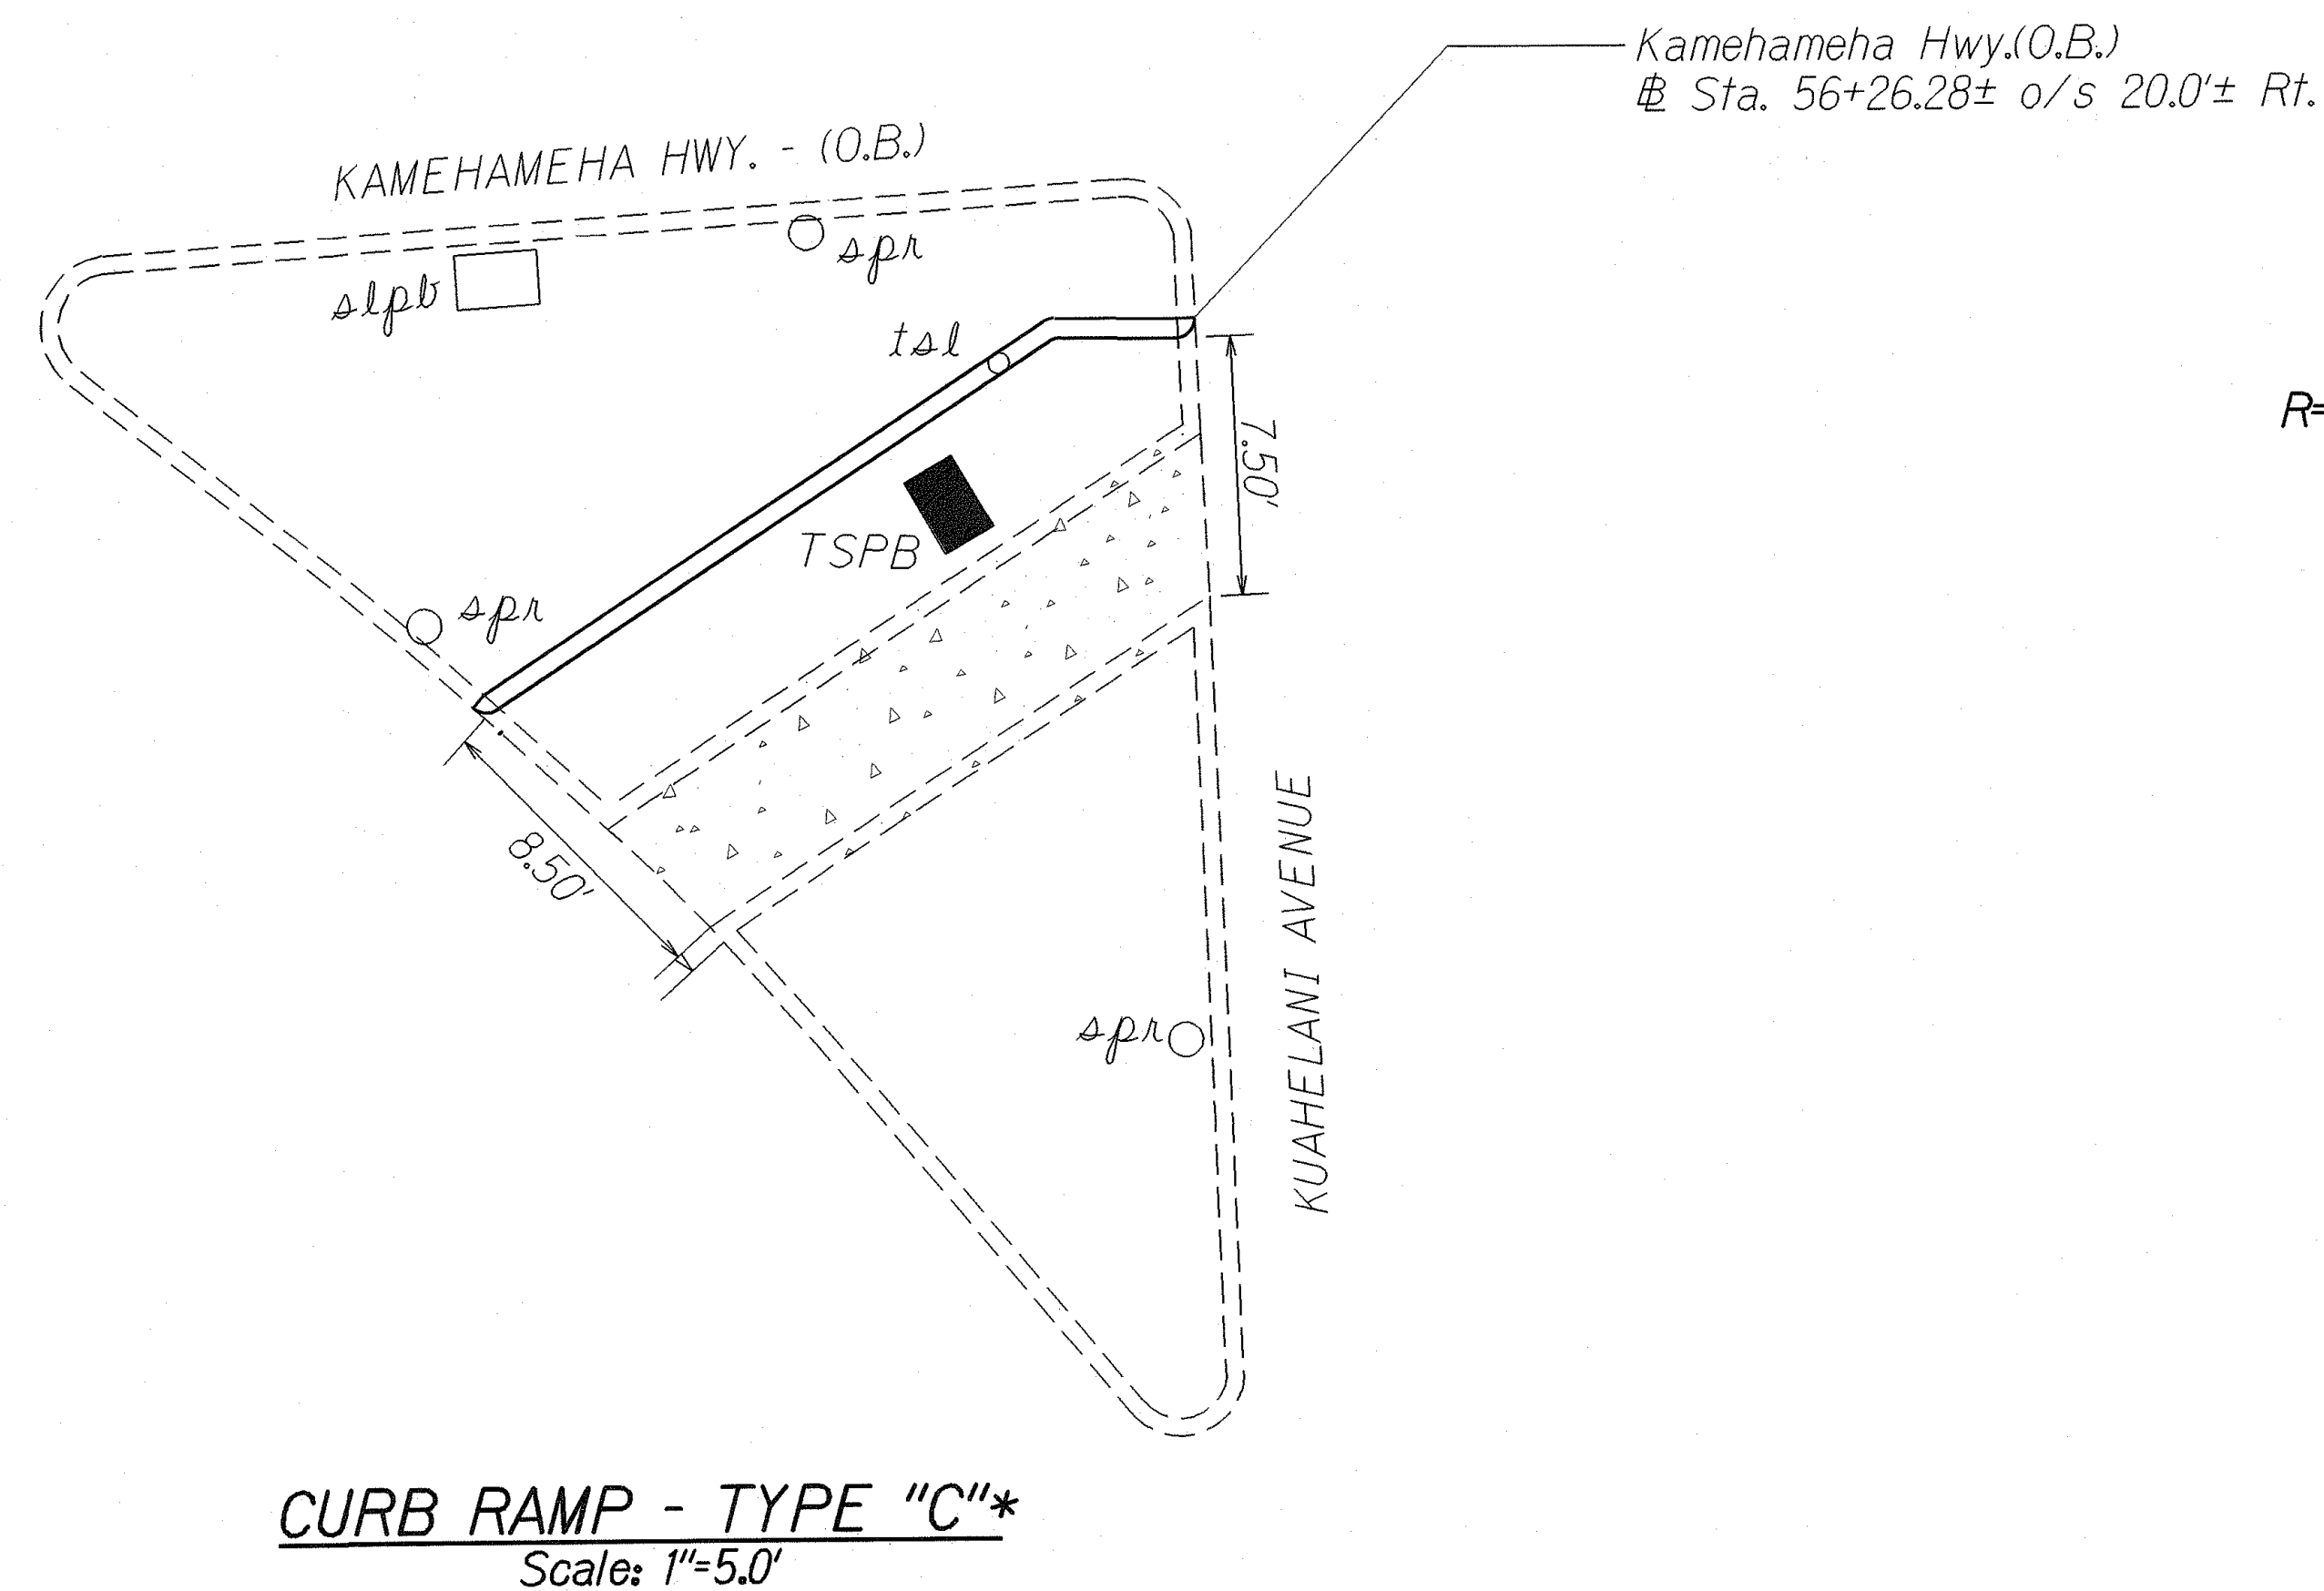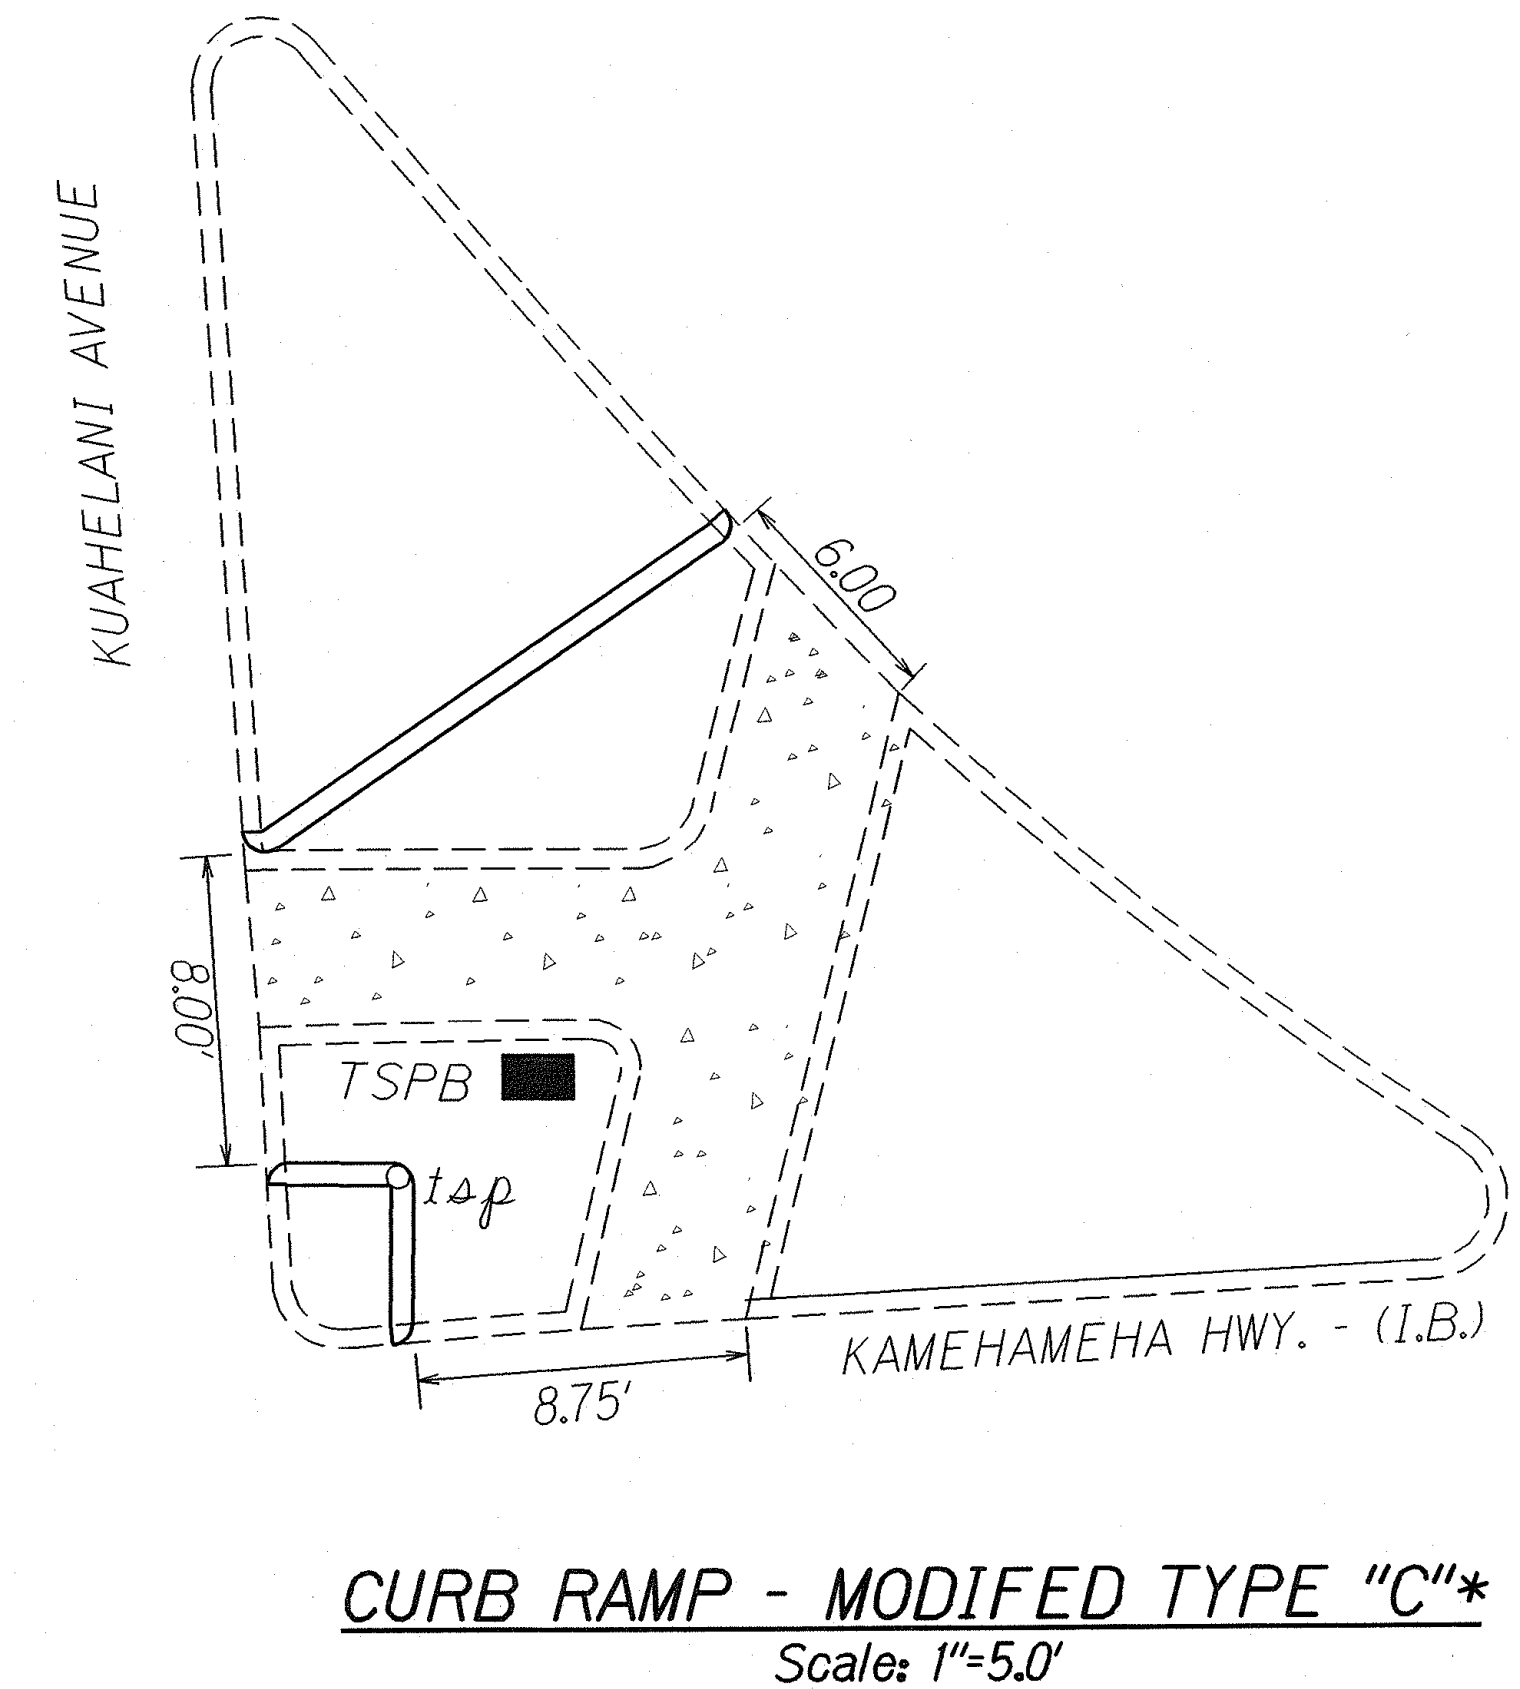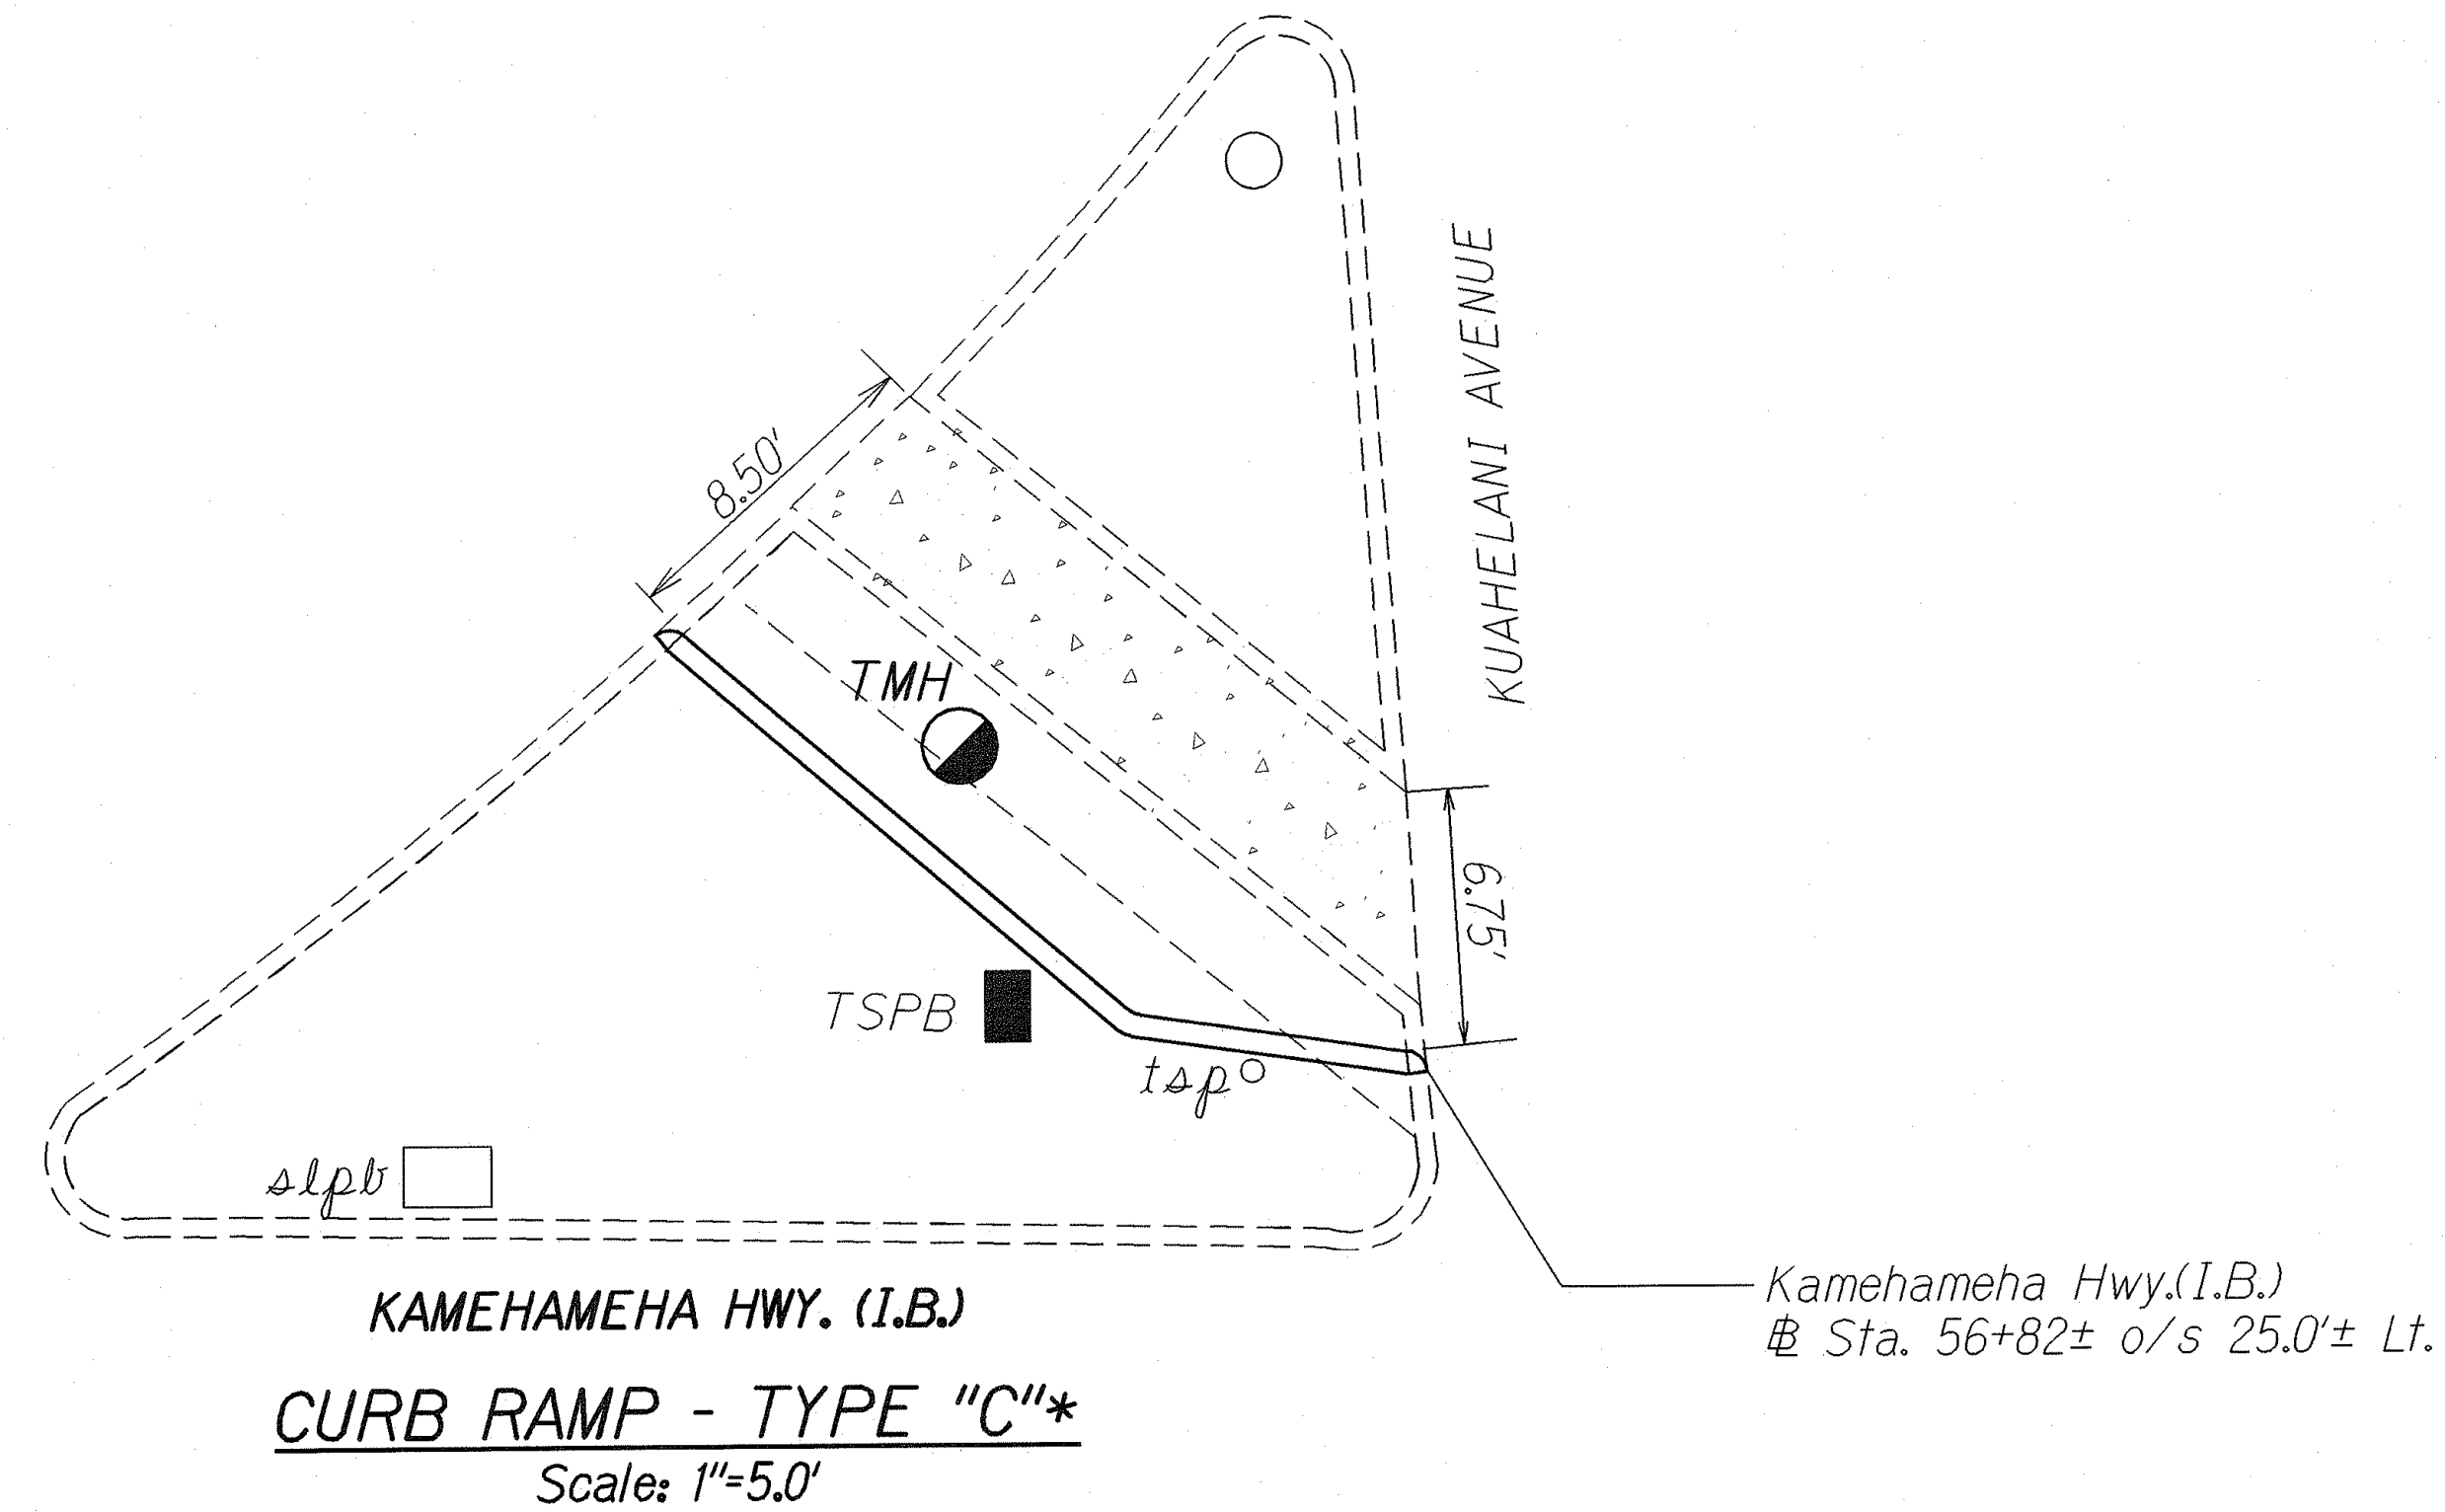

* Note: 1) All islands are landscaped.
Millilani Town Association will
adjust landscaping prior to NTP
2) Demolish and reconstruct
as necessary.

ORIGINAL PLAN	SURVEY PLOTTED BY	DATE
NOTE BOOK	DRAWN BY	
	TRACED BY	
	QUANTITIES BY	
	CHECKED BY	

STATE OF HAWAII
DEPARTMENT OF TRANSPORTATION
HIGHWAYS DIVISION

ISLAND DETAILS

KAMEHAMEHA HIGHWAY
SIDEWALK IMPROVEMENTS
Meheula Parkway to Kuahelani Avenue
Project No. 99C-01-99

Scale: 1"=5.0' Date: Aug., 2001

SHEET No. 2 OF 2 SHEETS