


FED. ROAD DIST. NO.	STATE	PROJ. NO.	FISCAL YEAR	SHEET NO.	TOTAL SHEETS
HAWAII	HAW.	99C-01-99	2002	33	45

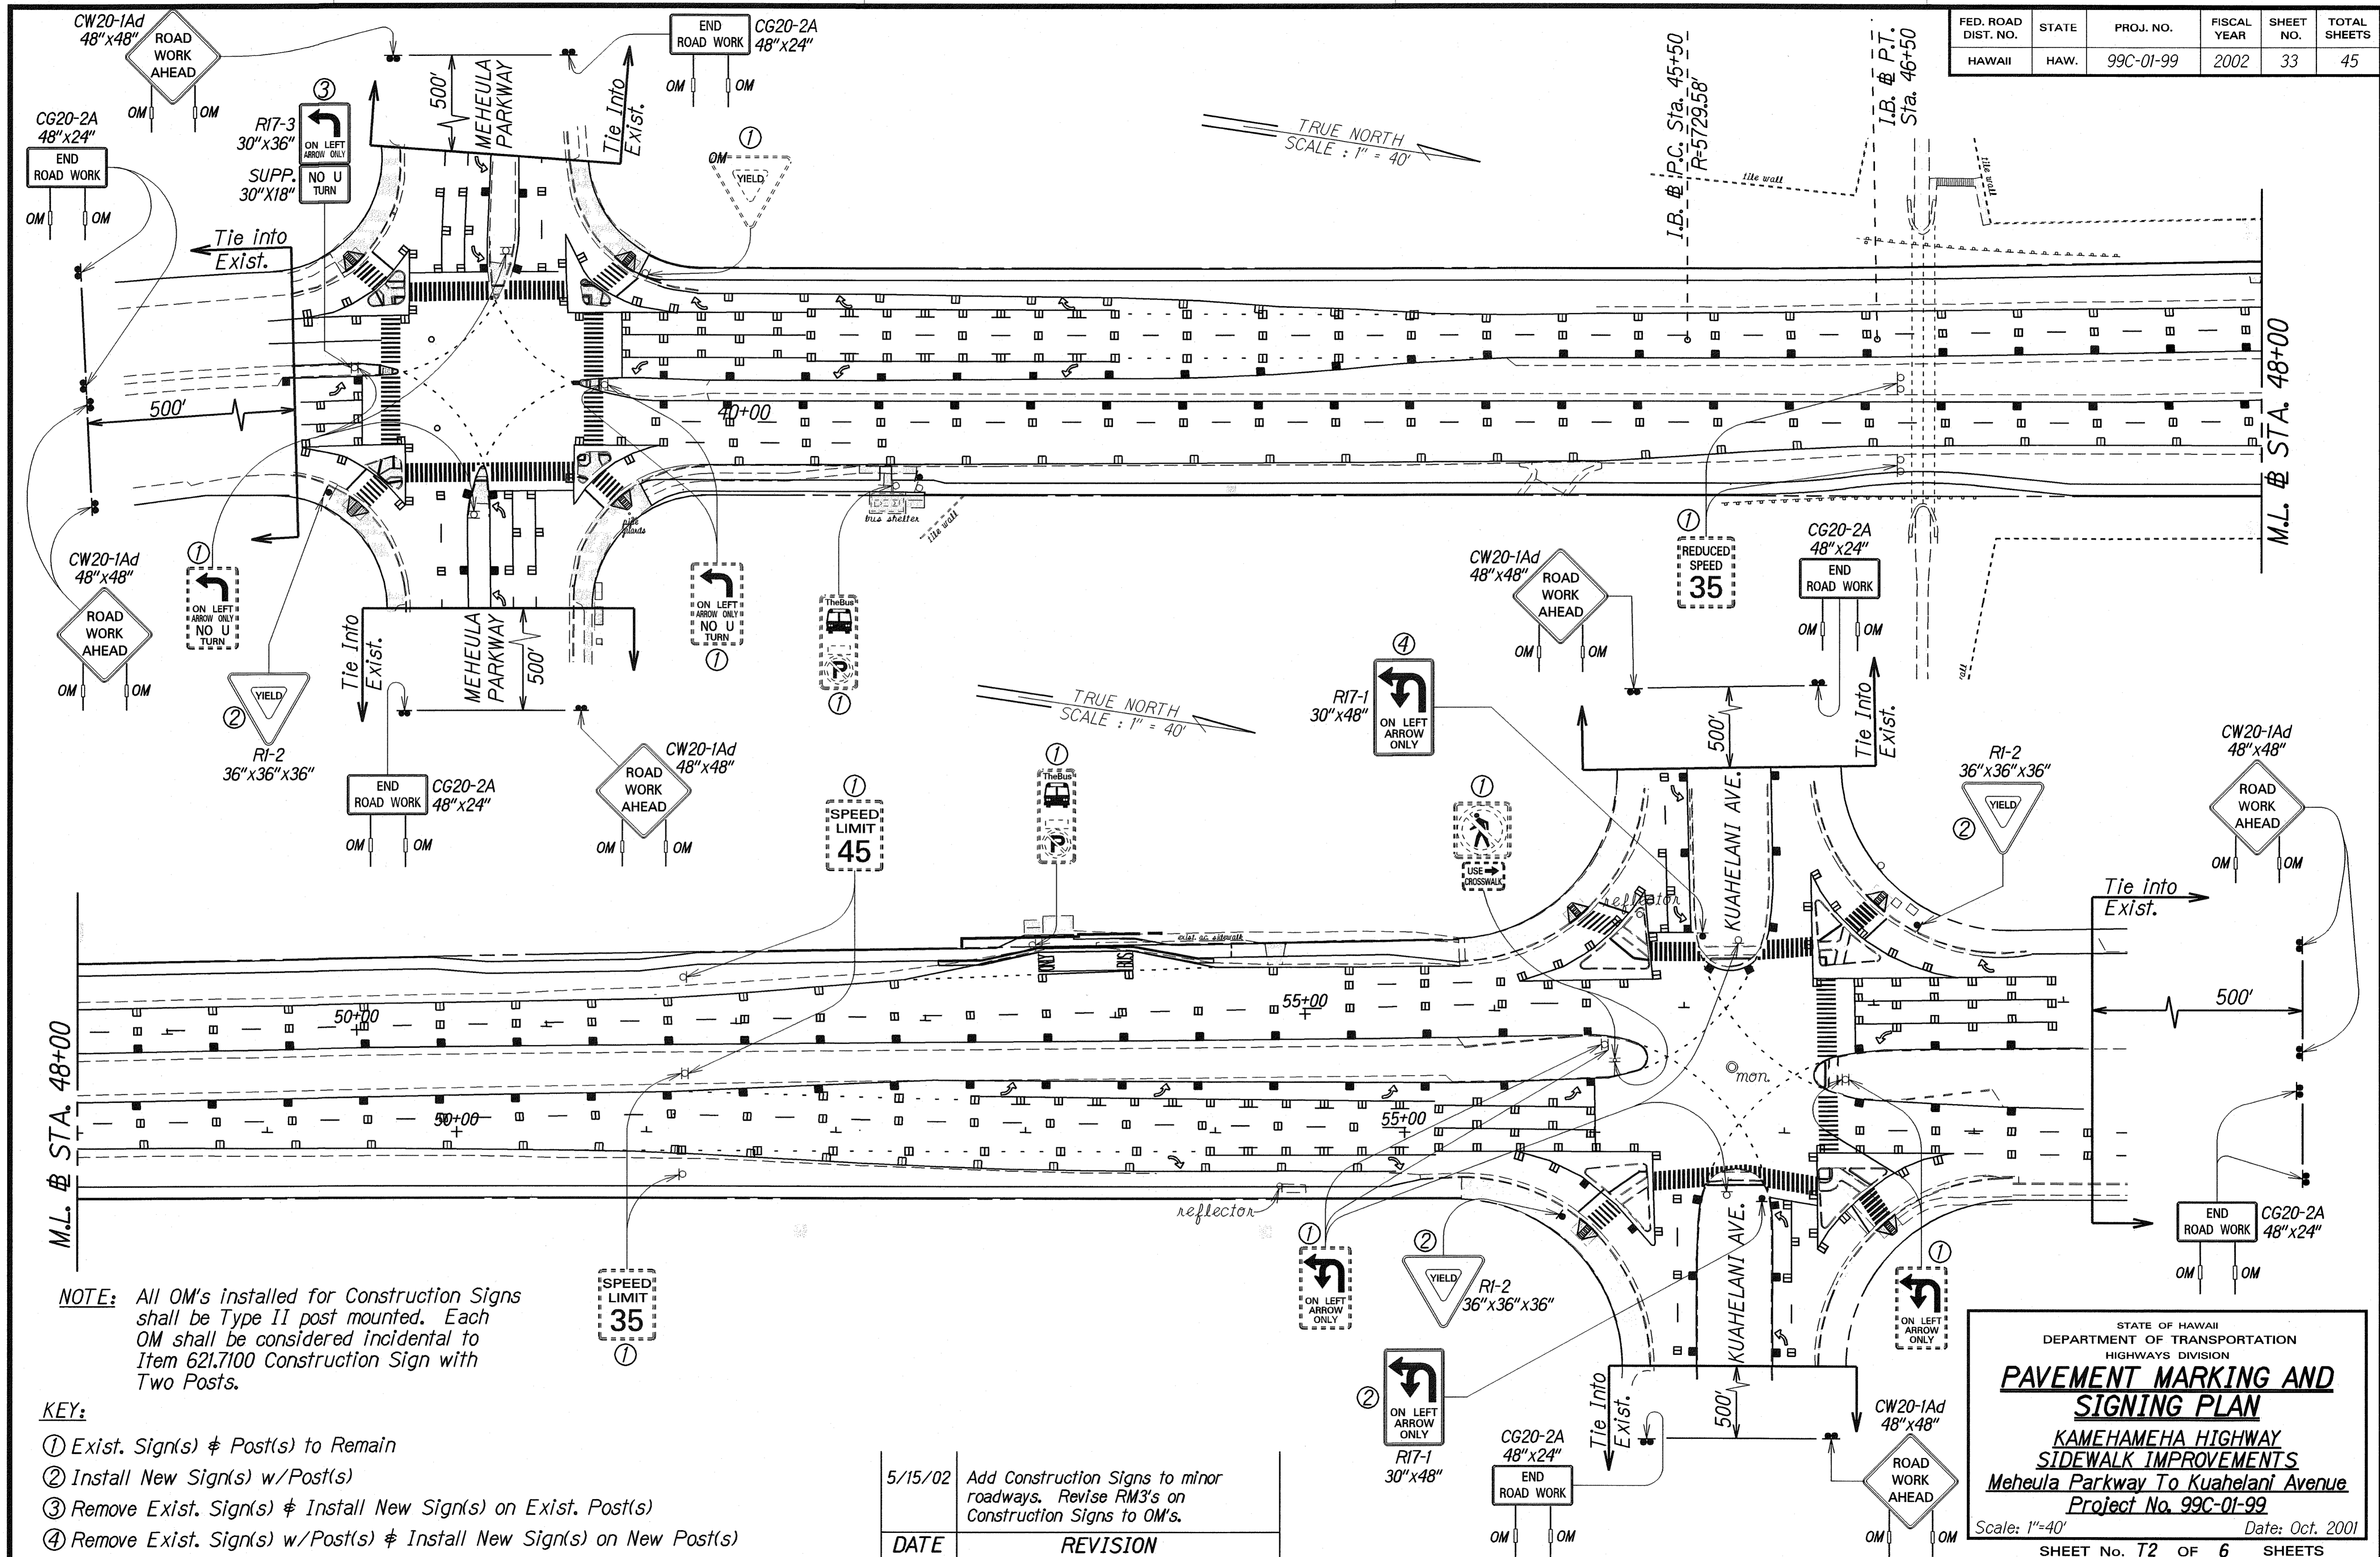

NOTE: All OM's installed for Construction Signs shall be Type II post mounted. Each OM shall be considered incidental to Item 621.7100 Construction Sign with Two Posts.

KEY:

- ① Exist. Sign(s) & Post(s) to Remain
- ② Install New Sign(s) w/Post(s)
- ③ Remove Exist. Sign(s) & Install New Sign(s) on Exist. Post(s)
- ④ Remove Exist. Sign(s) w/Post(s) & Install New Sign(s) on New Post(s)

DATE	REVISION
5/15/02	Add Construction Signs to minor roadways. Revise RM3's on Construction Signs to OM's.

SURVEY PLOTTED BY	DATE
DRAWN BY	
TRACED BY	
NOTE BOOK	
QUANTITIES BY	
CHECKED BY	

STATE OF HAWAII
DEPARTMENT OF TRANSPORTATION
HIGHWAYS DIVISION

**PAVEMENT MARKING AND
SIGNING PLAN**

**KAMEHAMEHA HIGHWAY
SIDEWALK IMPROVEMENTS
Meheula Parkway To Kuahelani Avenue
Project No. 99C-01-99**

Scale: 1"=40' Date: Oct. 2001

SHEET No. T2 OF 6 SHEETS