


INDEX TO DRAWINGS	
SHEET NO.	DESCRIPTION
1	TITLE SHEET
2	STANDARD PLANS SUMMARY
3	GENERAL NOTES AND LEGEND
4	UTILITY NOTES
5 - 6	WATER POLLUTION & CONTROL NOTES
7 - 8	TYPICAL SECTIONS
9 - 14	CURB RAMPS NOTES AND DETAILS
15 - 16	ISLAND DETAILS
17	BUS BAY DETAILS
18 - 21	ROADWAY PLANS
22	CONSTRUCTION PHASE PLAN
23 - 27	SIDEWALK GRADE CONTROL PLANS
28 - 31	DRAINAGE PLANS
32	PAVEMENT MARKING LEGEND, DETAILS, AND NOTES
33	PAVEMENT MARKING & SIGNING PLAN
34	TRAFFIC SIGNAL LEGEND AND NOTES
35 - 36	TRAFFIC SIGNAL PLAN
37	PULLBOX AND COVER DETAILS
38 - 45	CROSS SECTIONS




STATE OF HAWAII
DEPARTMENT OF TRANSPORTATION
HIGHWAYS DIVISION
HONOLULU, HAWAII
"AS-BUILT"
PLANS FOR
KAMEHAMEHA HIGHWAY SIDEWALK IMPROVEMENTS
MEHEULA PARKWAY TO KUAHELANI AVENUE
PROJECT NO. 99C-01-99

DISTRICT OF EWA
ISLAND OF OAHU

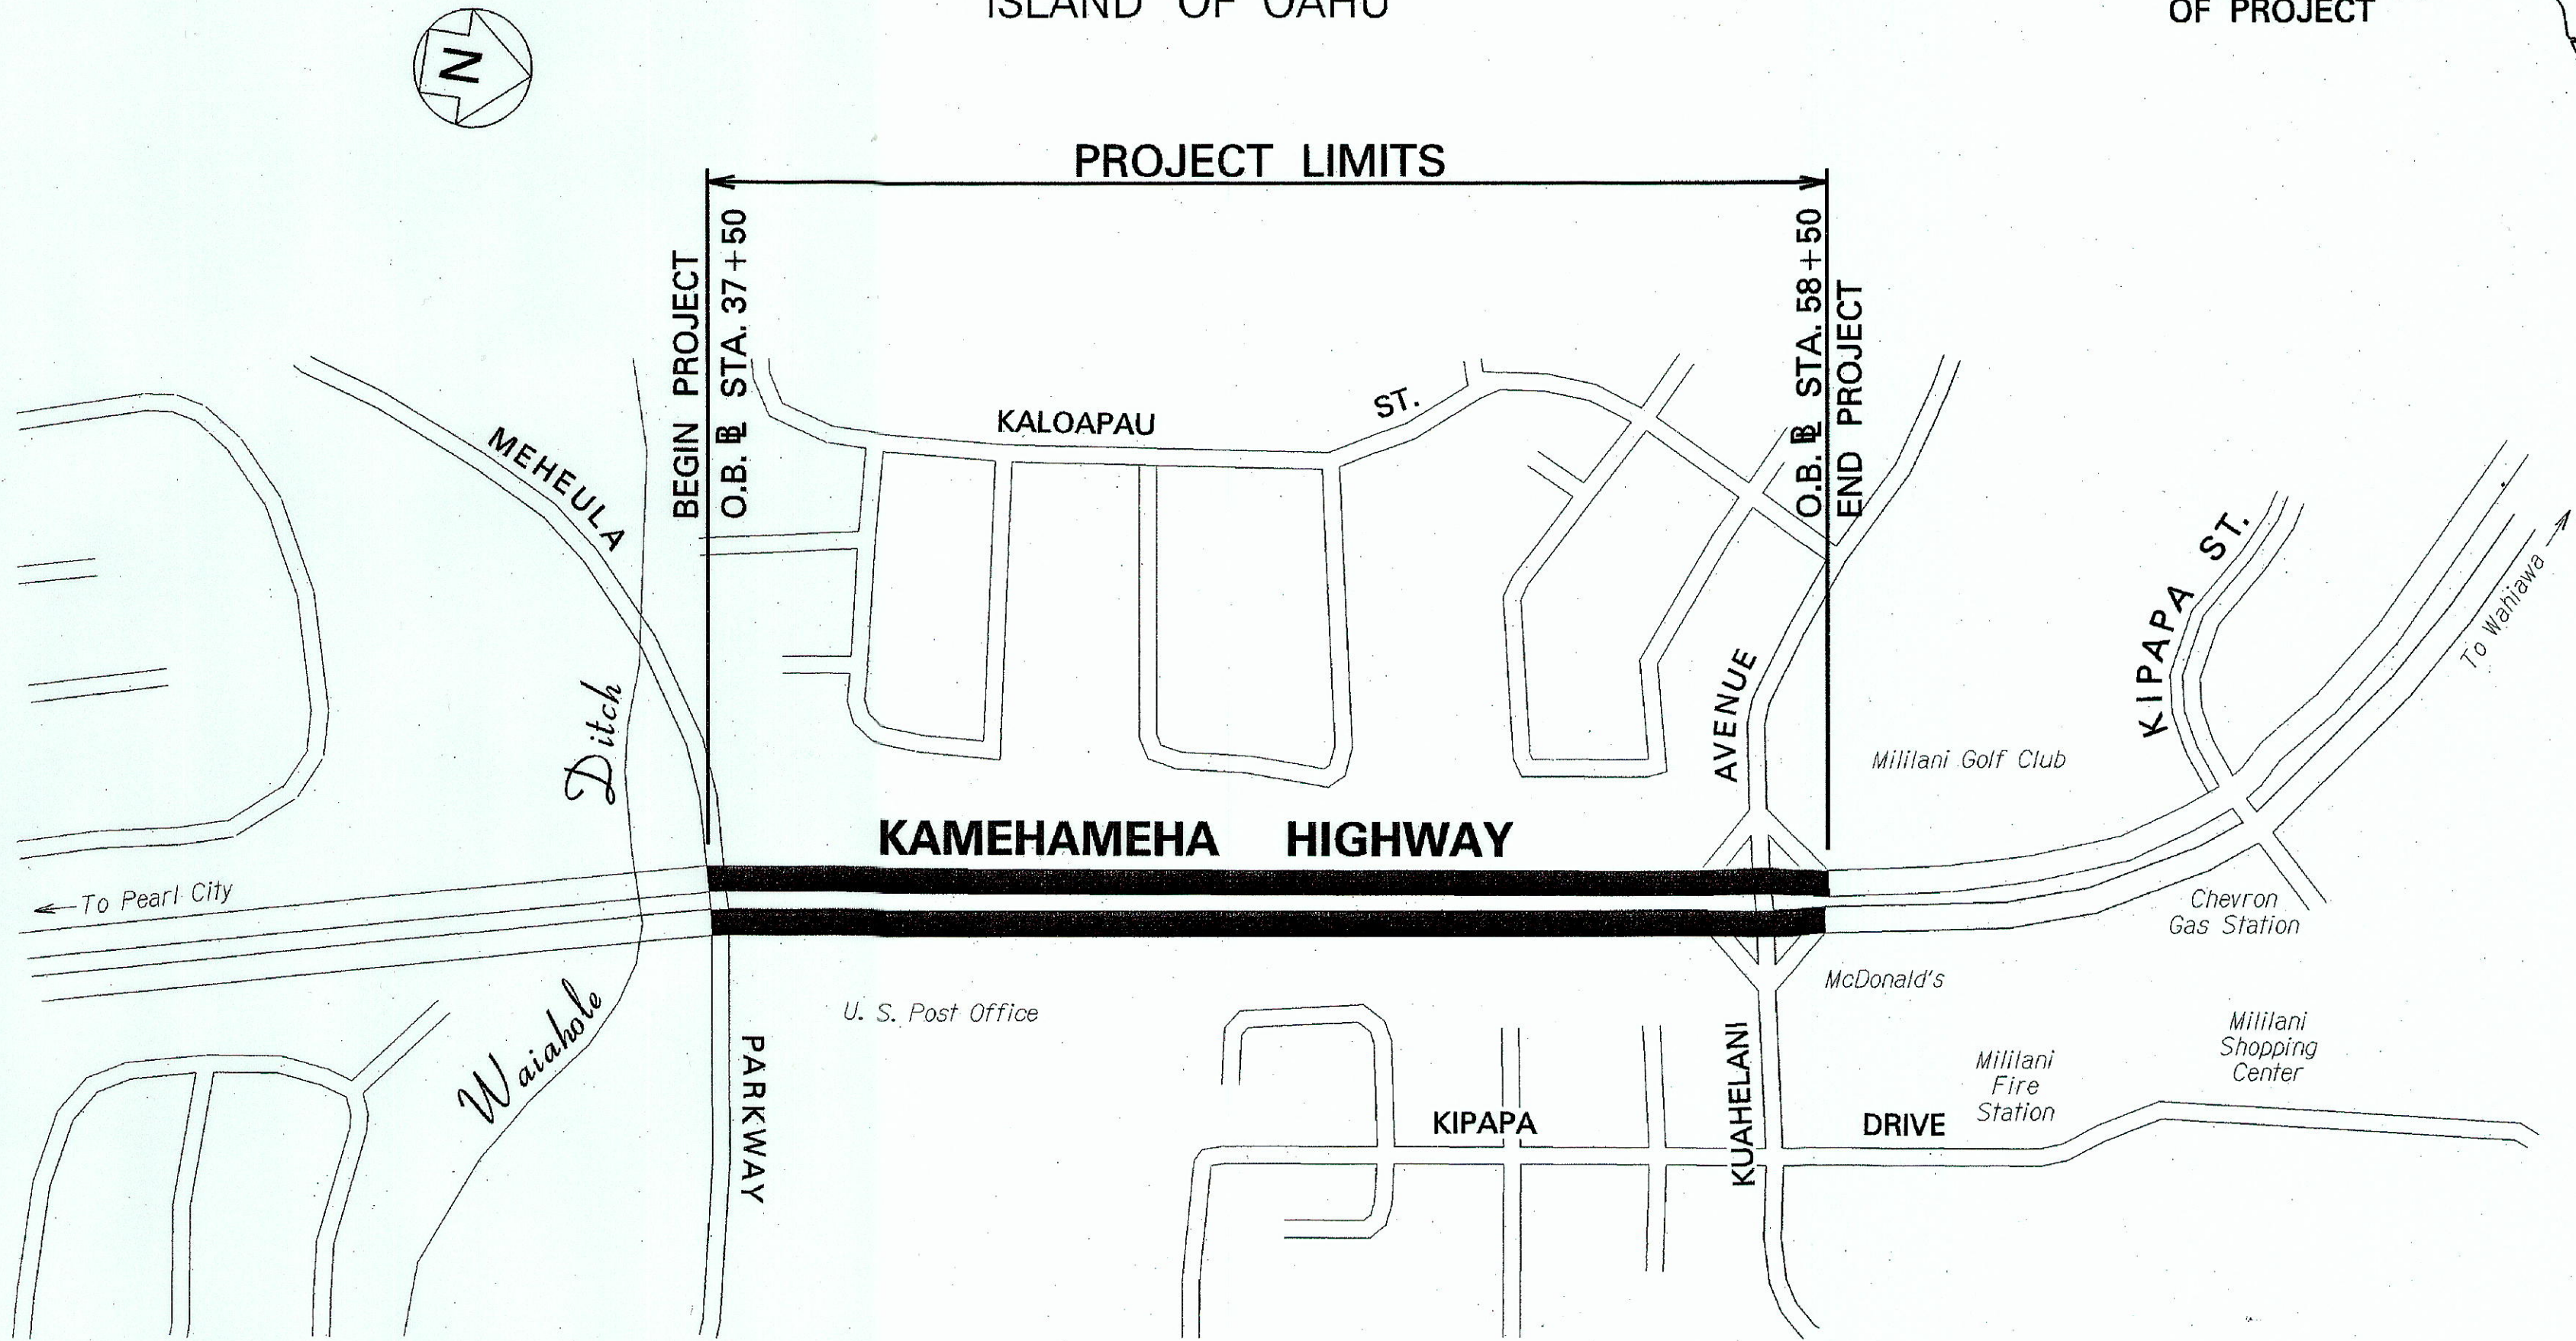

LAYOUT PLAN
LENGTH OF PROJECT.....0.36 MILE
SCALE IN HUNDRED FEET

FED. ROAD DIST. NO.	STATE	PROJ. NO.	FISCAL YEAR	SHEET NO.	TOTAL SHEETS
HAWAII	HAW.	99C-01-99	2002	1	45

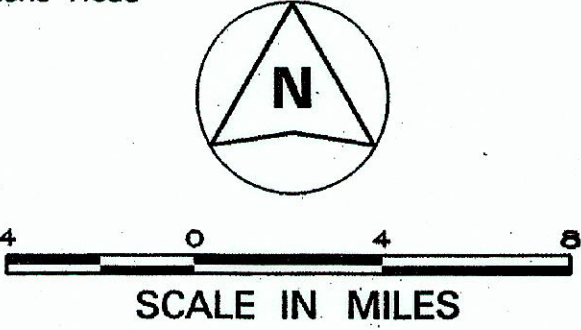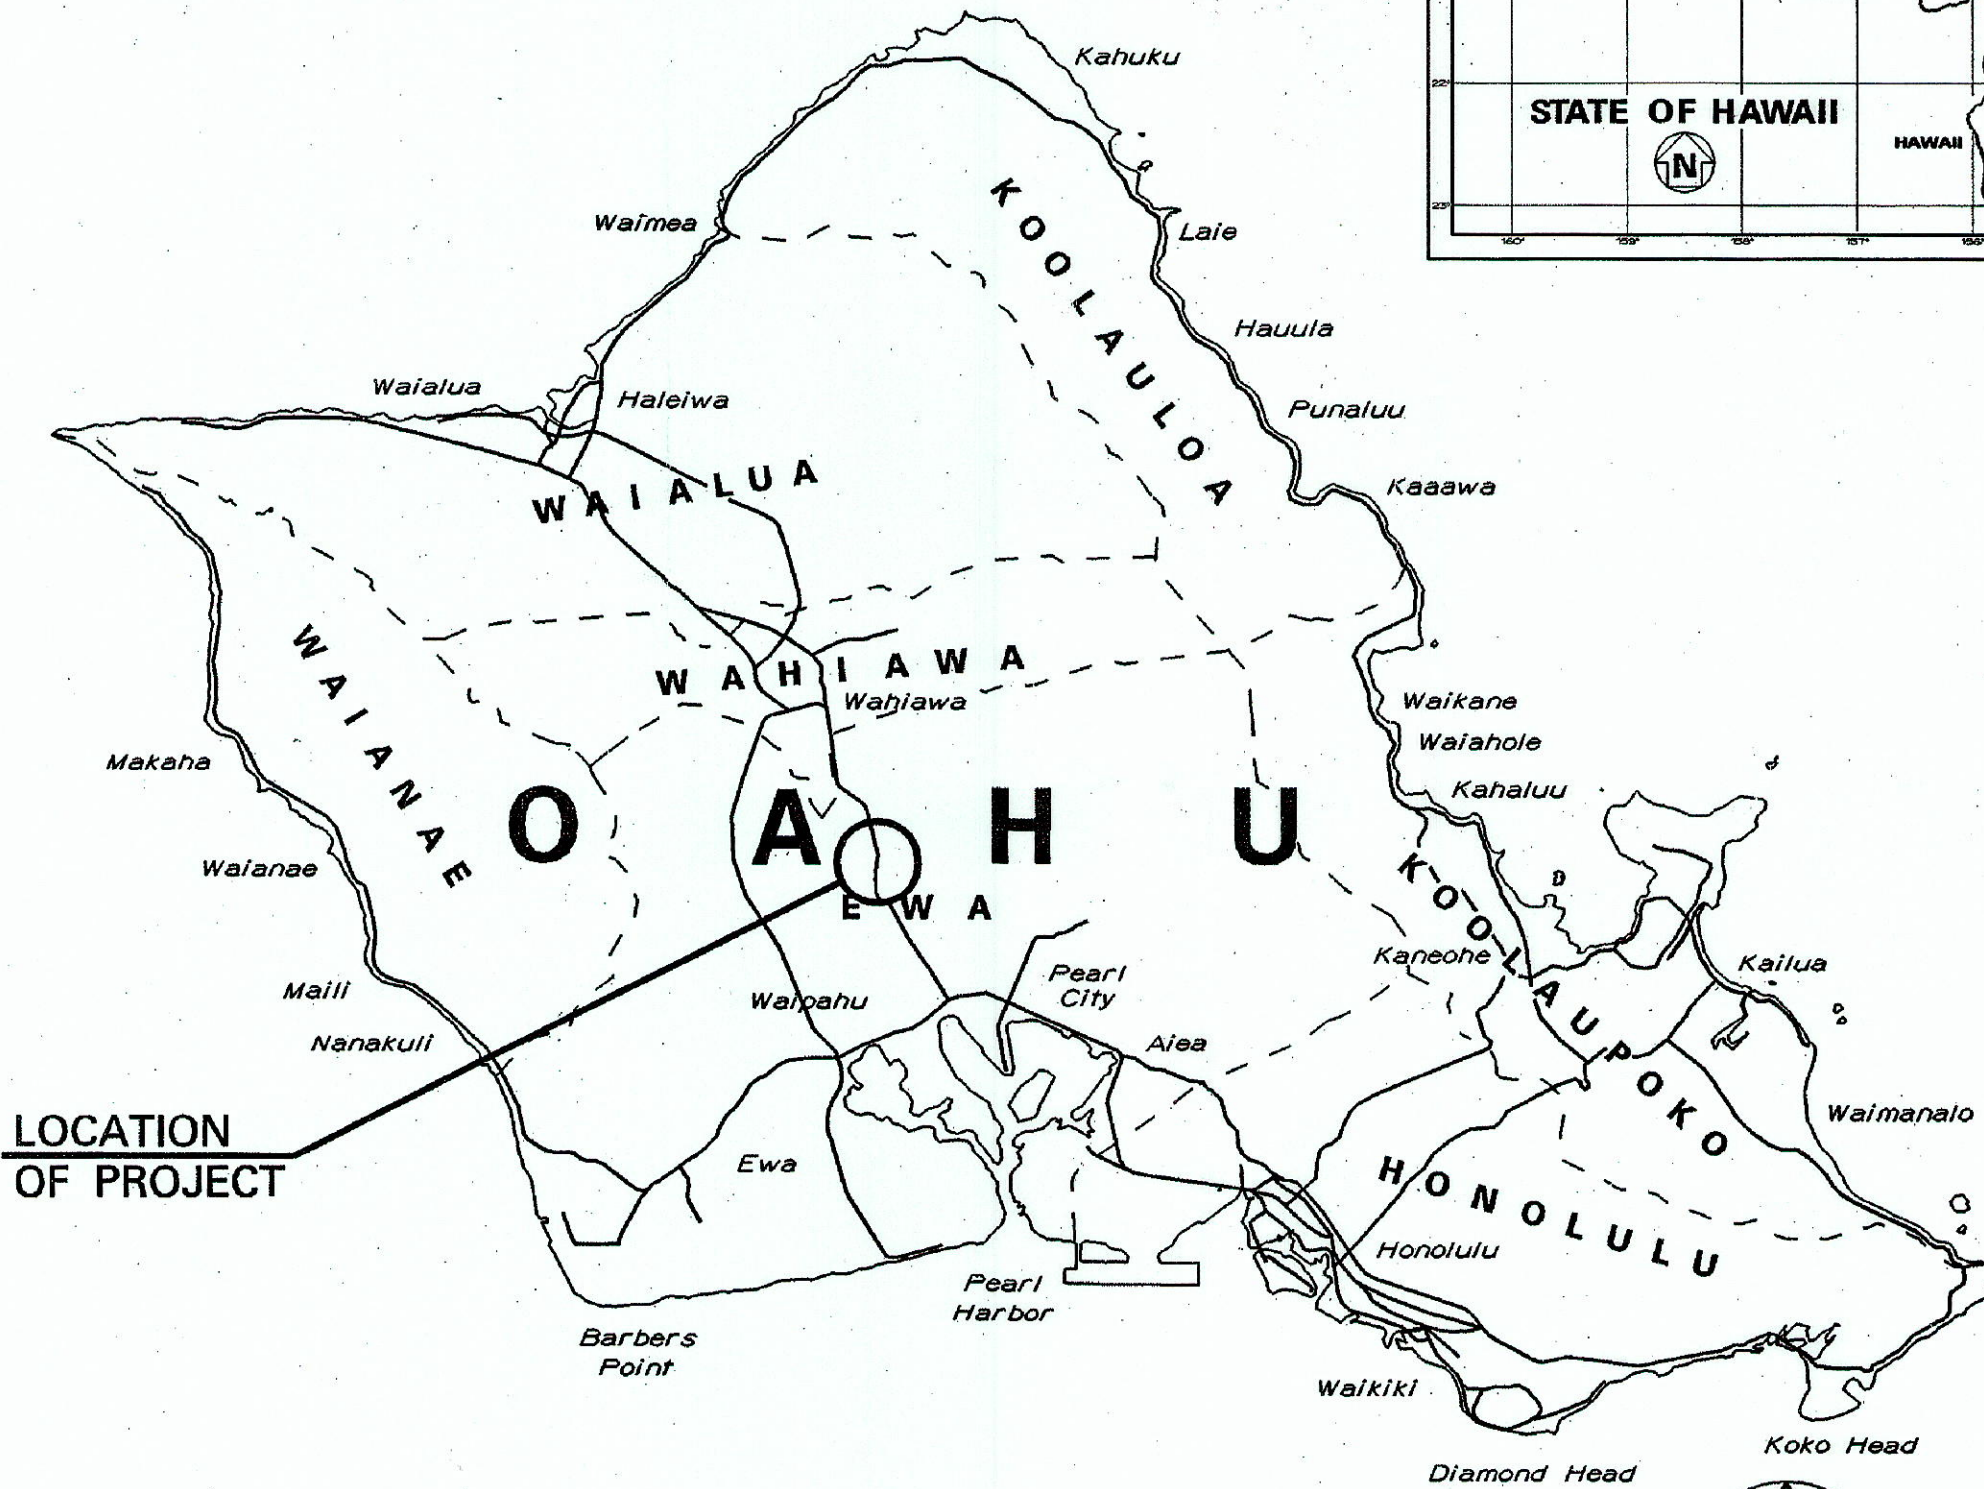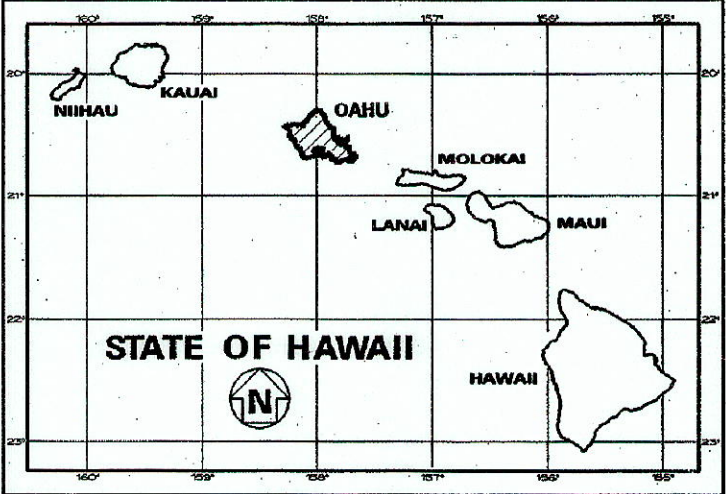

MILE POST 12.71 TO MILE POST 12.35

CHANGES MADE DURING CONSTRUCTION HAVE BEEN INCORPORATED ON THESE PLANS EXCEPT CHANGES IN THE ORIGINAL THEORETICAL QUANTITIES. FOR ACTUAL QUANTITIES, REFER TO PROJECT LEDGER AND/OR COMPUTATION BOOK.
RESIDENT ENGINEER
DATE

DEPARTMENT OF TRANSPORTATION STATE OF HAWAII	
APPROVED:	
for DIR. OF TRANSPORTATION	3.6.02 DATE

DESIGN UNIT "E"
DESIGNED BY
S. HIRAOKA
P. S. & E. BY
692-7581
PHONE
NOV., 2001
DATE