




FED. ROAD DIST. NO.	STATE	FED. AID PROJ. NO.	FISCAL YEAR	SHEET NO.	TOTAL SHEETS
HAWAII	HAW.	I-H-1(11)14	1974	101	234

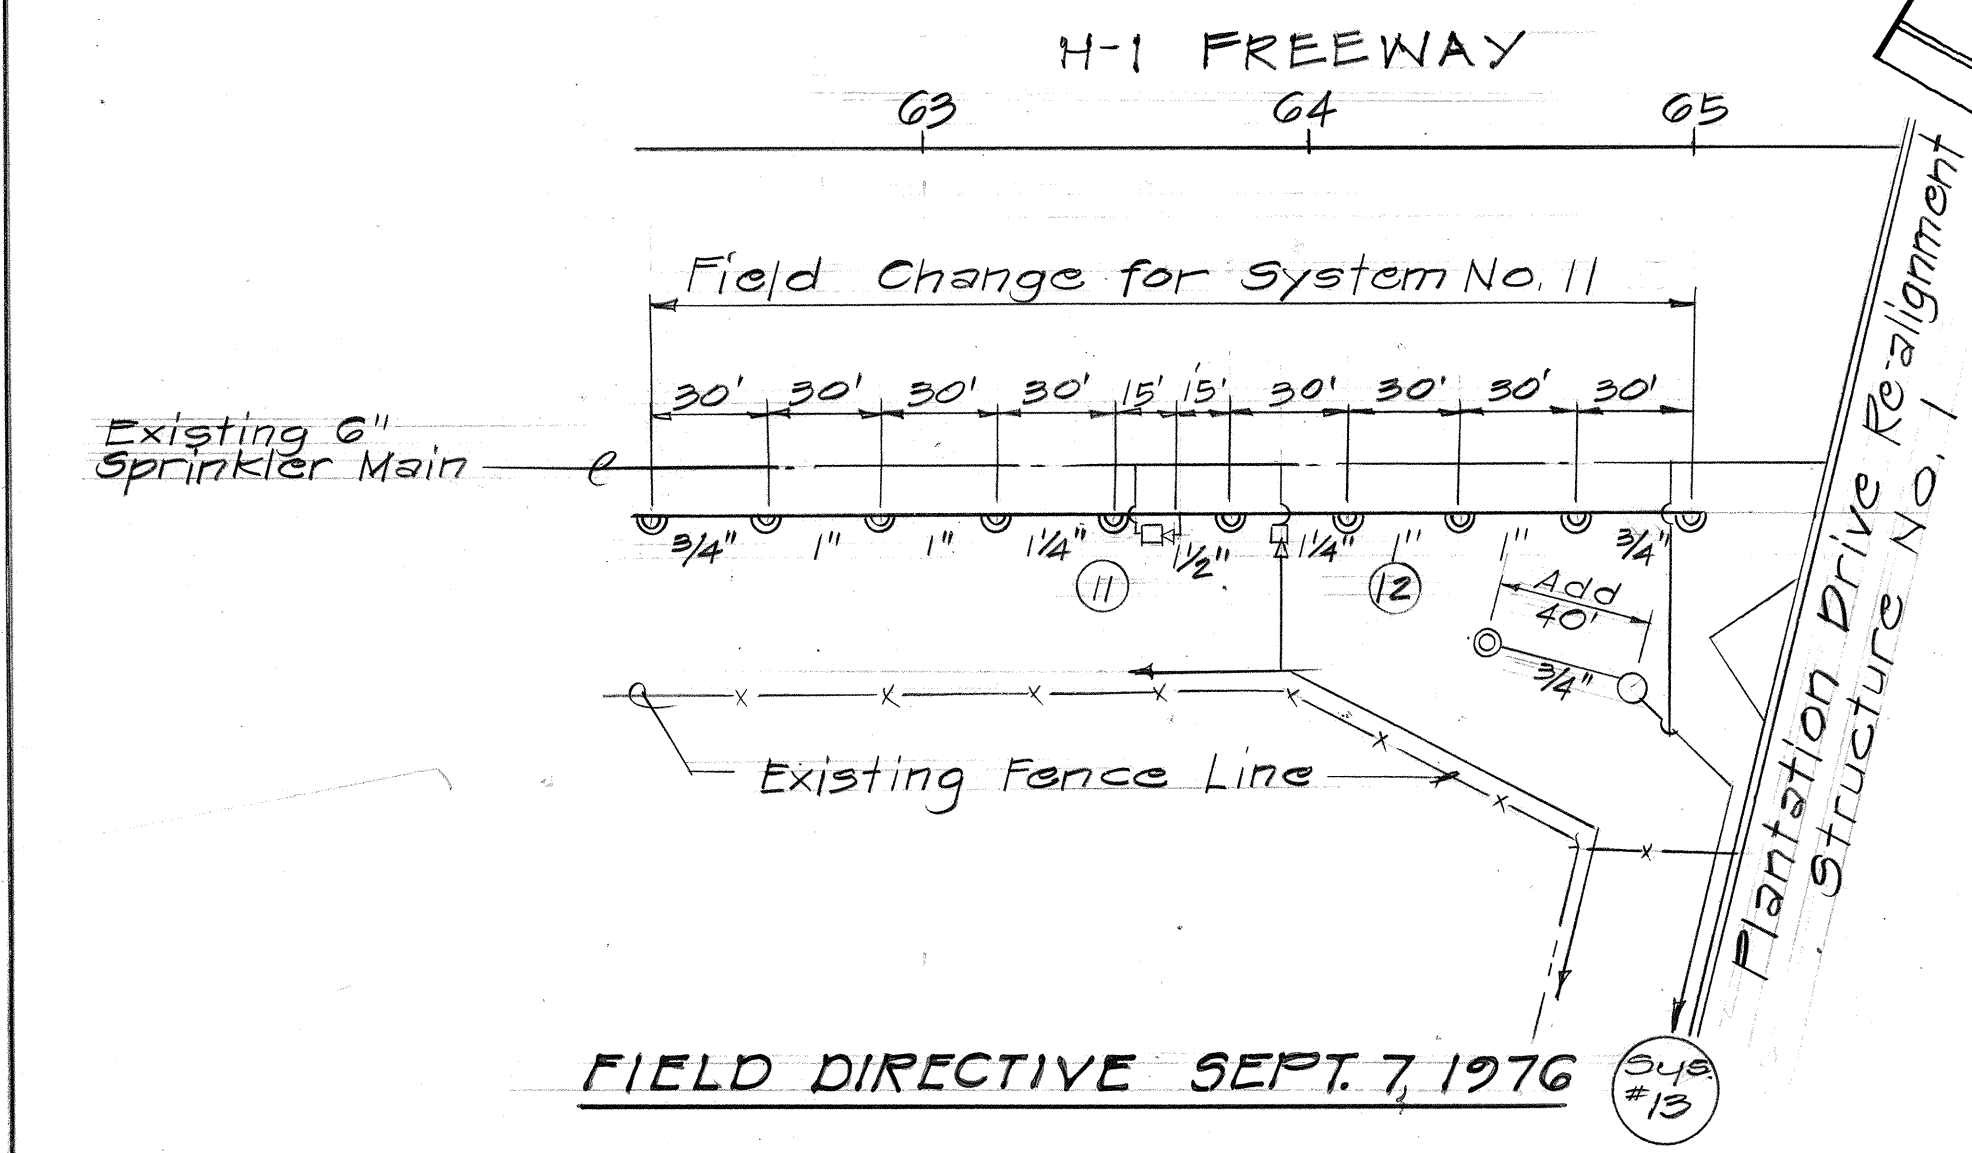

NOTE:
SEE SHT. L-6 FOR
DIMENSION BETWEEN HEADS.
SEE SHT III FOR SPRINKLER MAIN GENERAL PLAN.

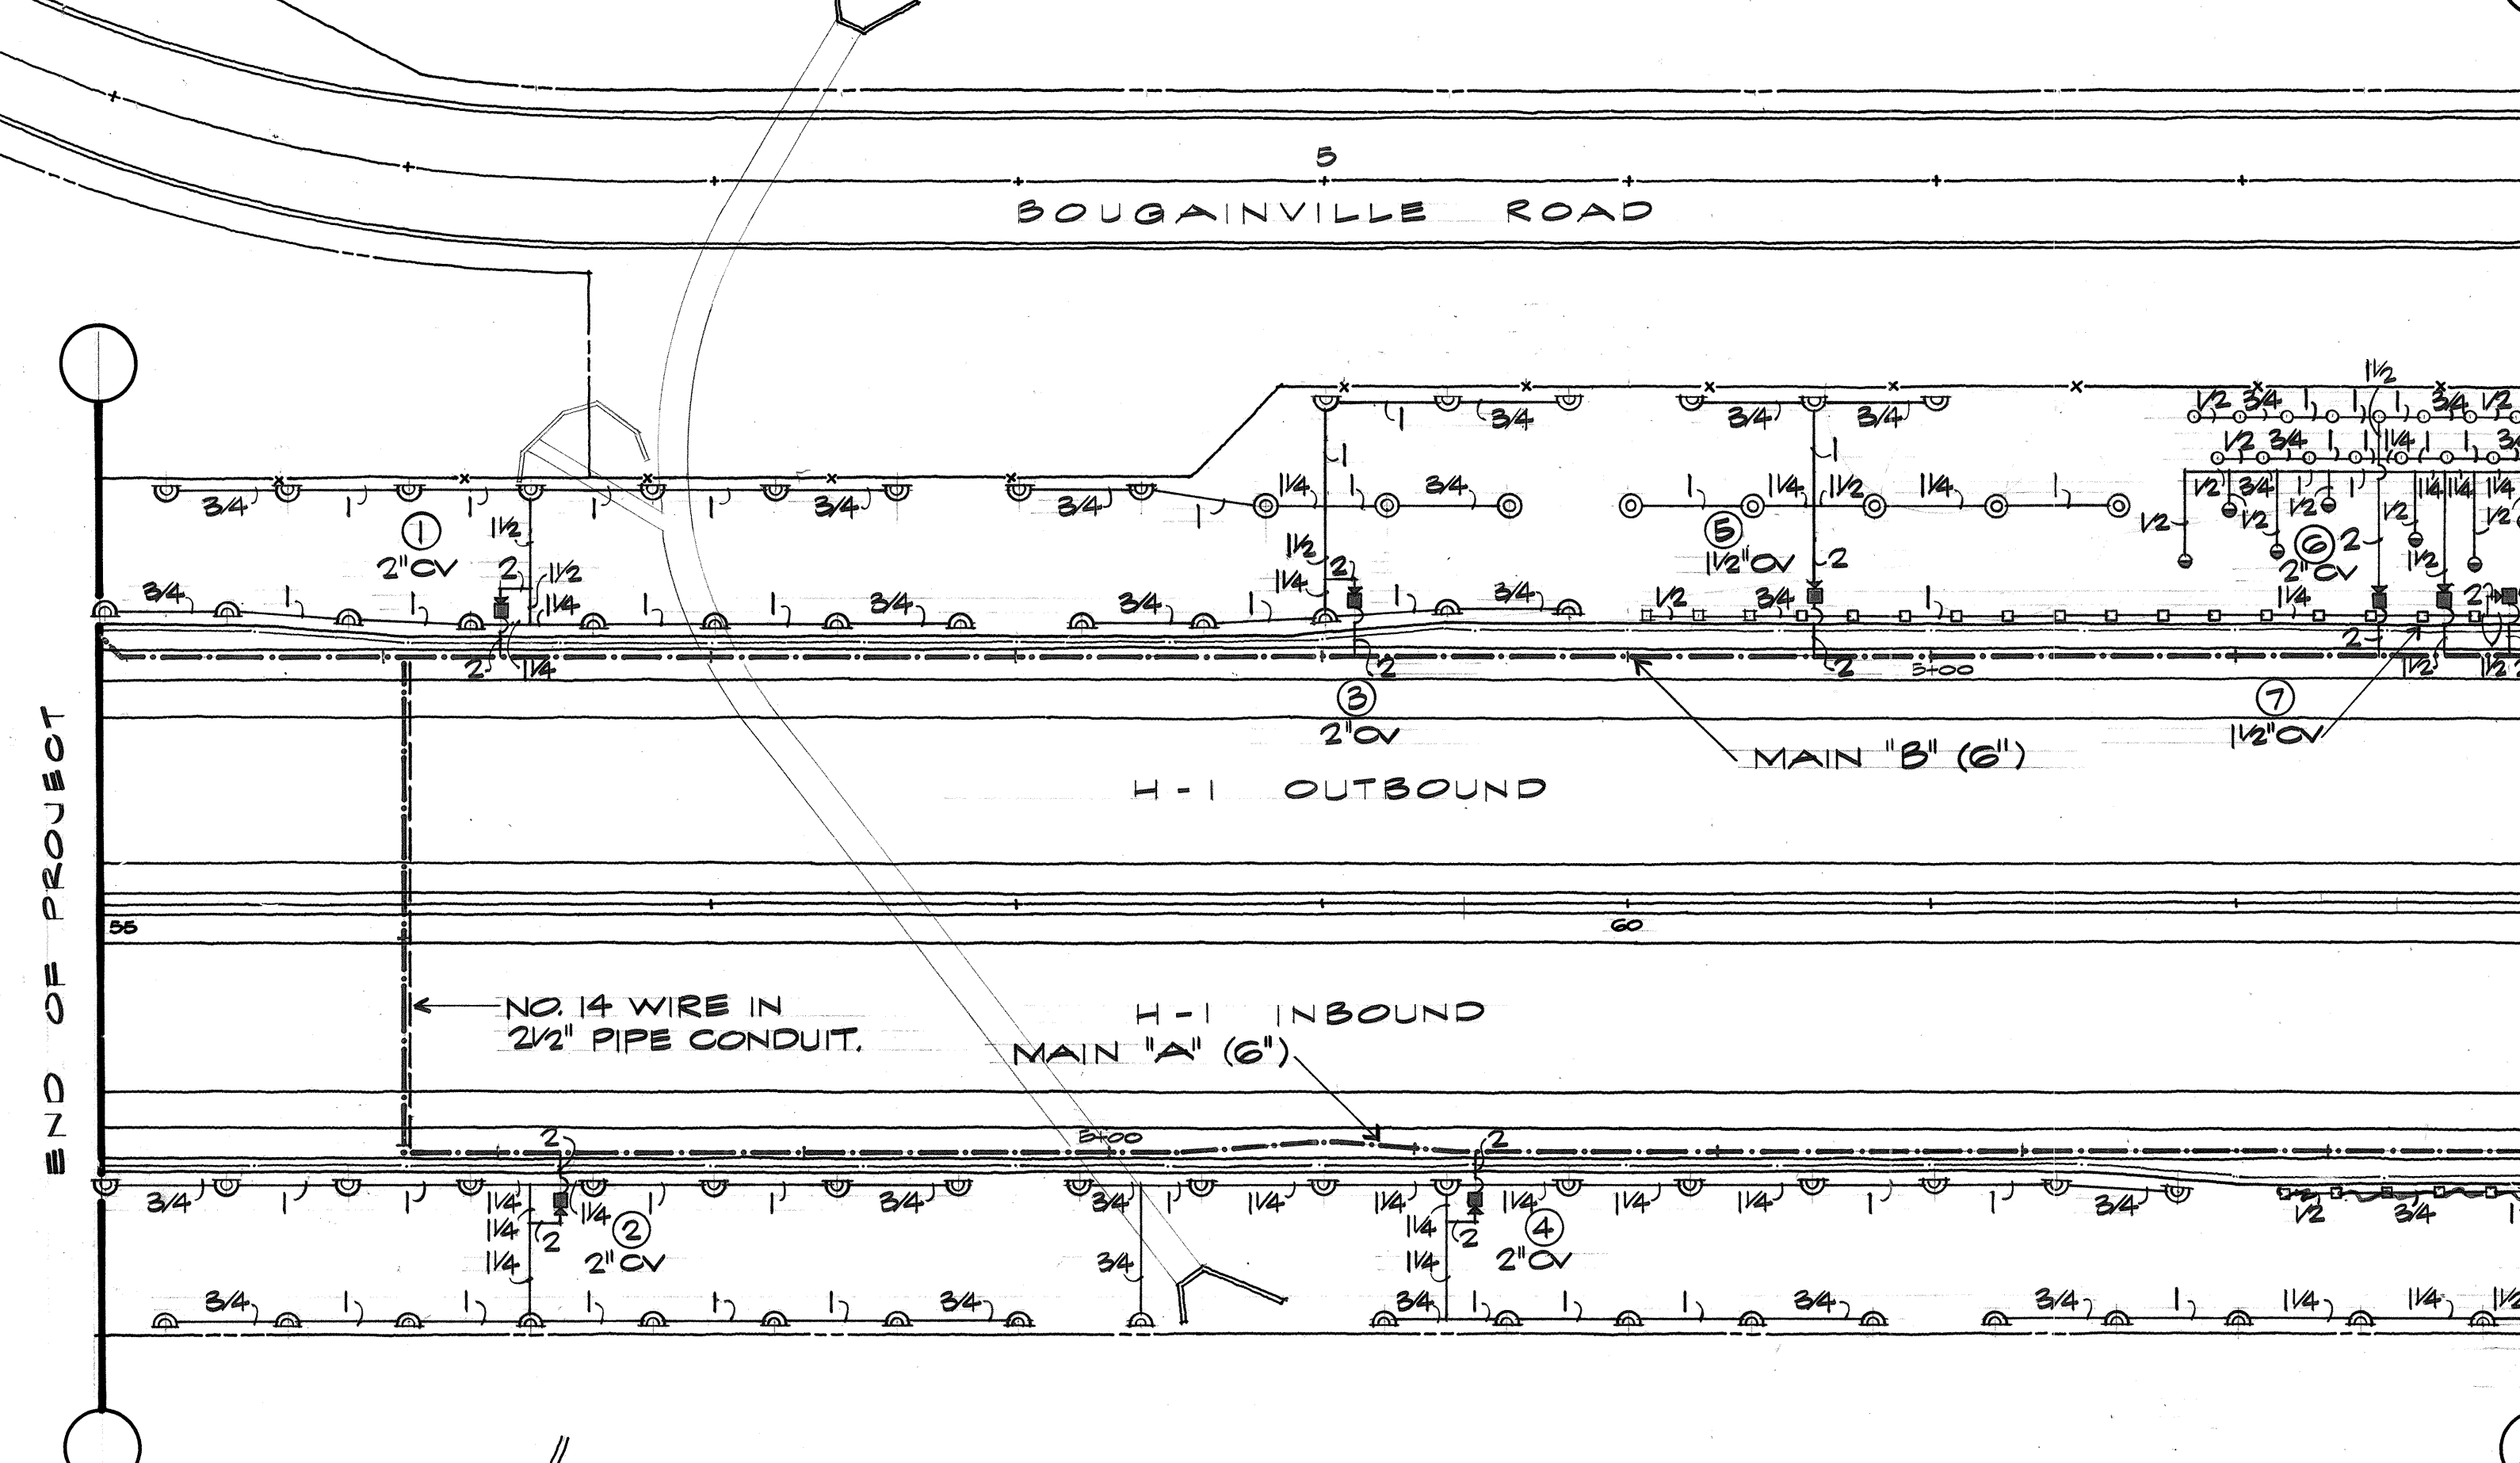


Field Directive
Sept. 7, 1976
Field change of
Sprinkler Systems
See this sheet

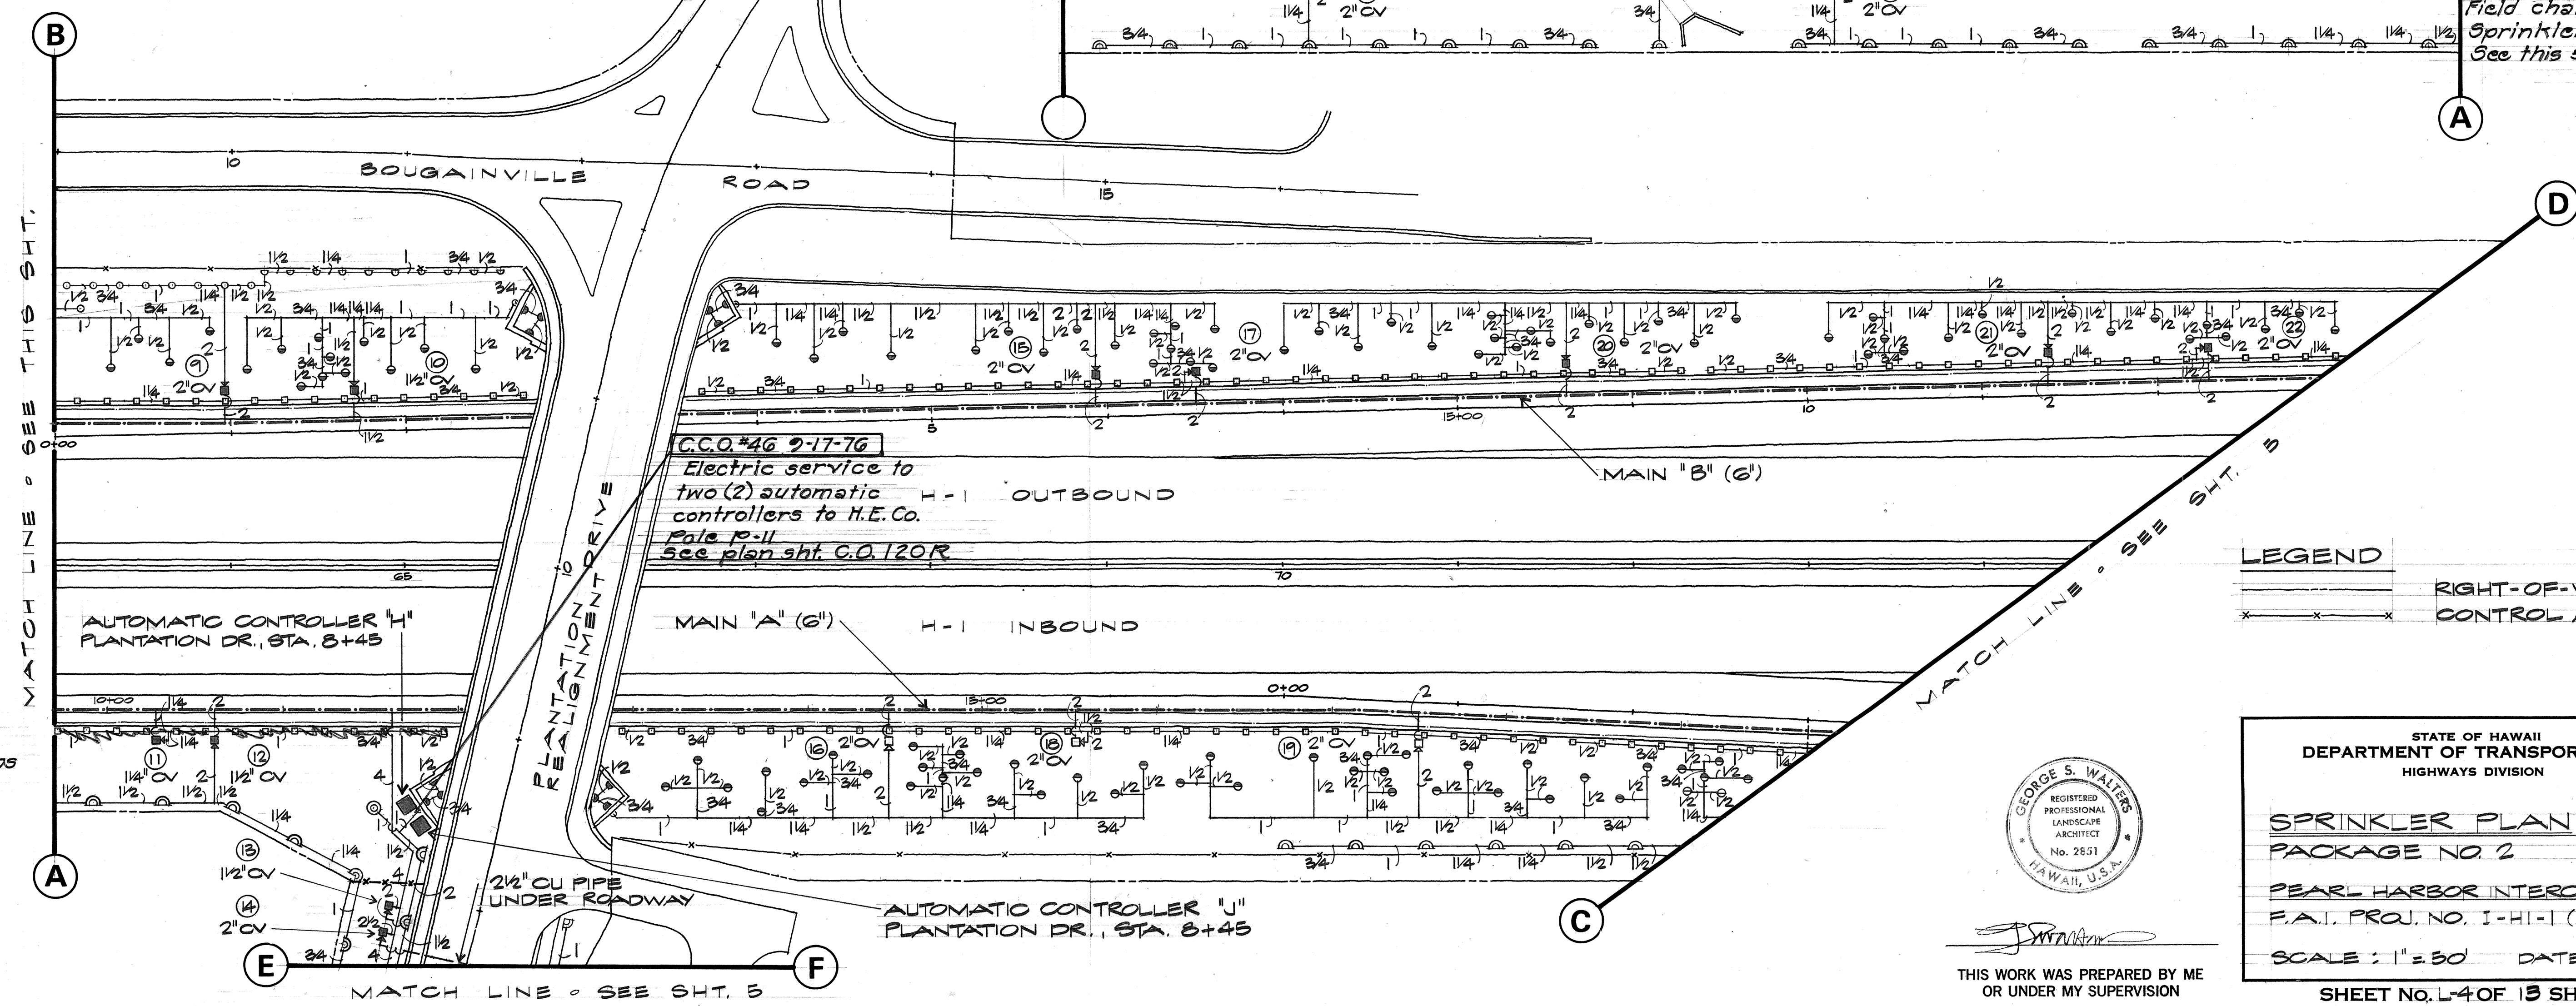

LEGEND
RIGHT-OF-WAY
CONTROL ACCESS

Field Directive
Sept. 7, 1976
Field change of
Sprinkler Systems
See this sheet

ORIGINAL PLAN	DATE
DESIGNED BY	
TRACED BY	
NOTED BY	
CHECKED BY	

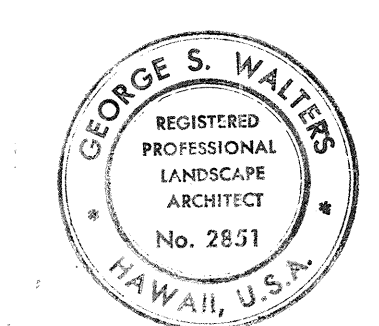

THIS WORK WAS PREPARED BY ME
OR UNDER MY SUPERVISION

STATE OF HAWAII
DEPARTMENT OF TRANSPORTATION
HIGHWAYS DIVISION

SPRINKLER PLAN
PACKAGE NO. 2


PEARL HARBOR INTERCHANGE
F.A.I. PROJ. NO. I-H-1(11)14

SCALE: 1" = 30' DATE: DEC. 14, 1973

SHEET NO. L4 OF 13 SHEETS

FED. ROAD DIST. NO.	STATE	FED. AID PROJ. NO.	FISCAL YEAR	SHEET NO.	TOTAL SHEETS
HAWAII	HAW.	I-H-1(111)14	1974	102	234

ORIGINAL PLAN	DATE
SURVEY PLOTTED BY	
DRAWN BY	
DESIGNED BY	
NOTED BY	
CHECKED BY	

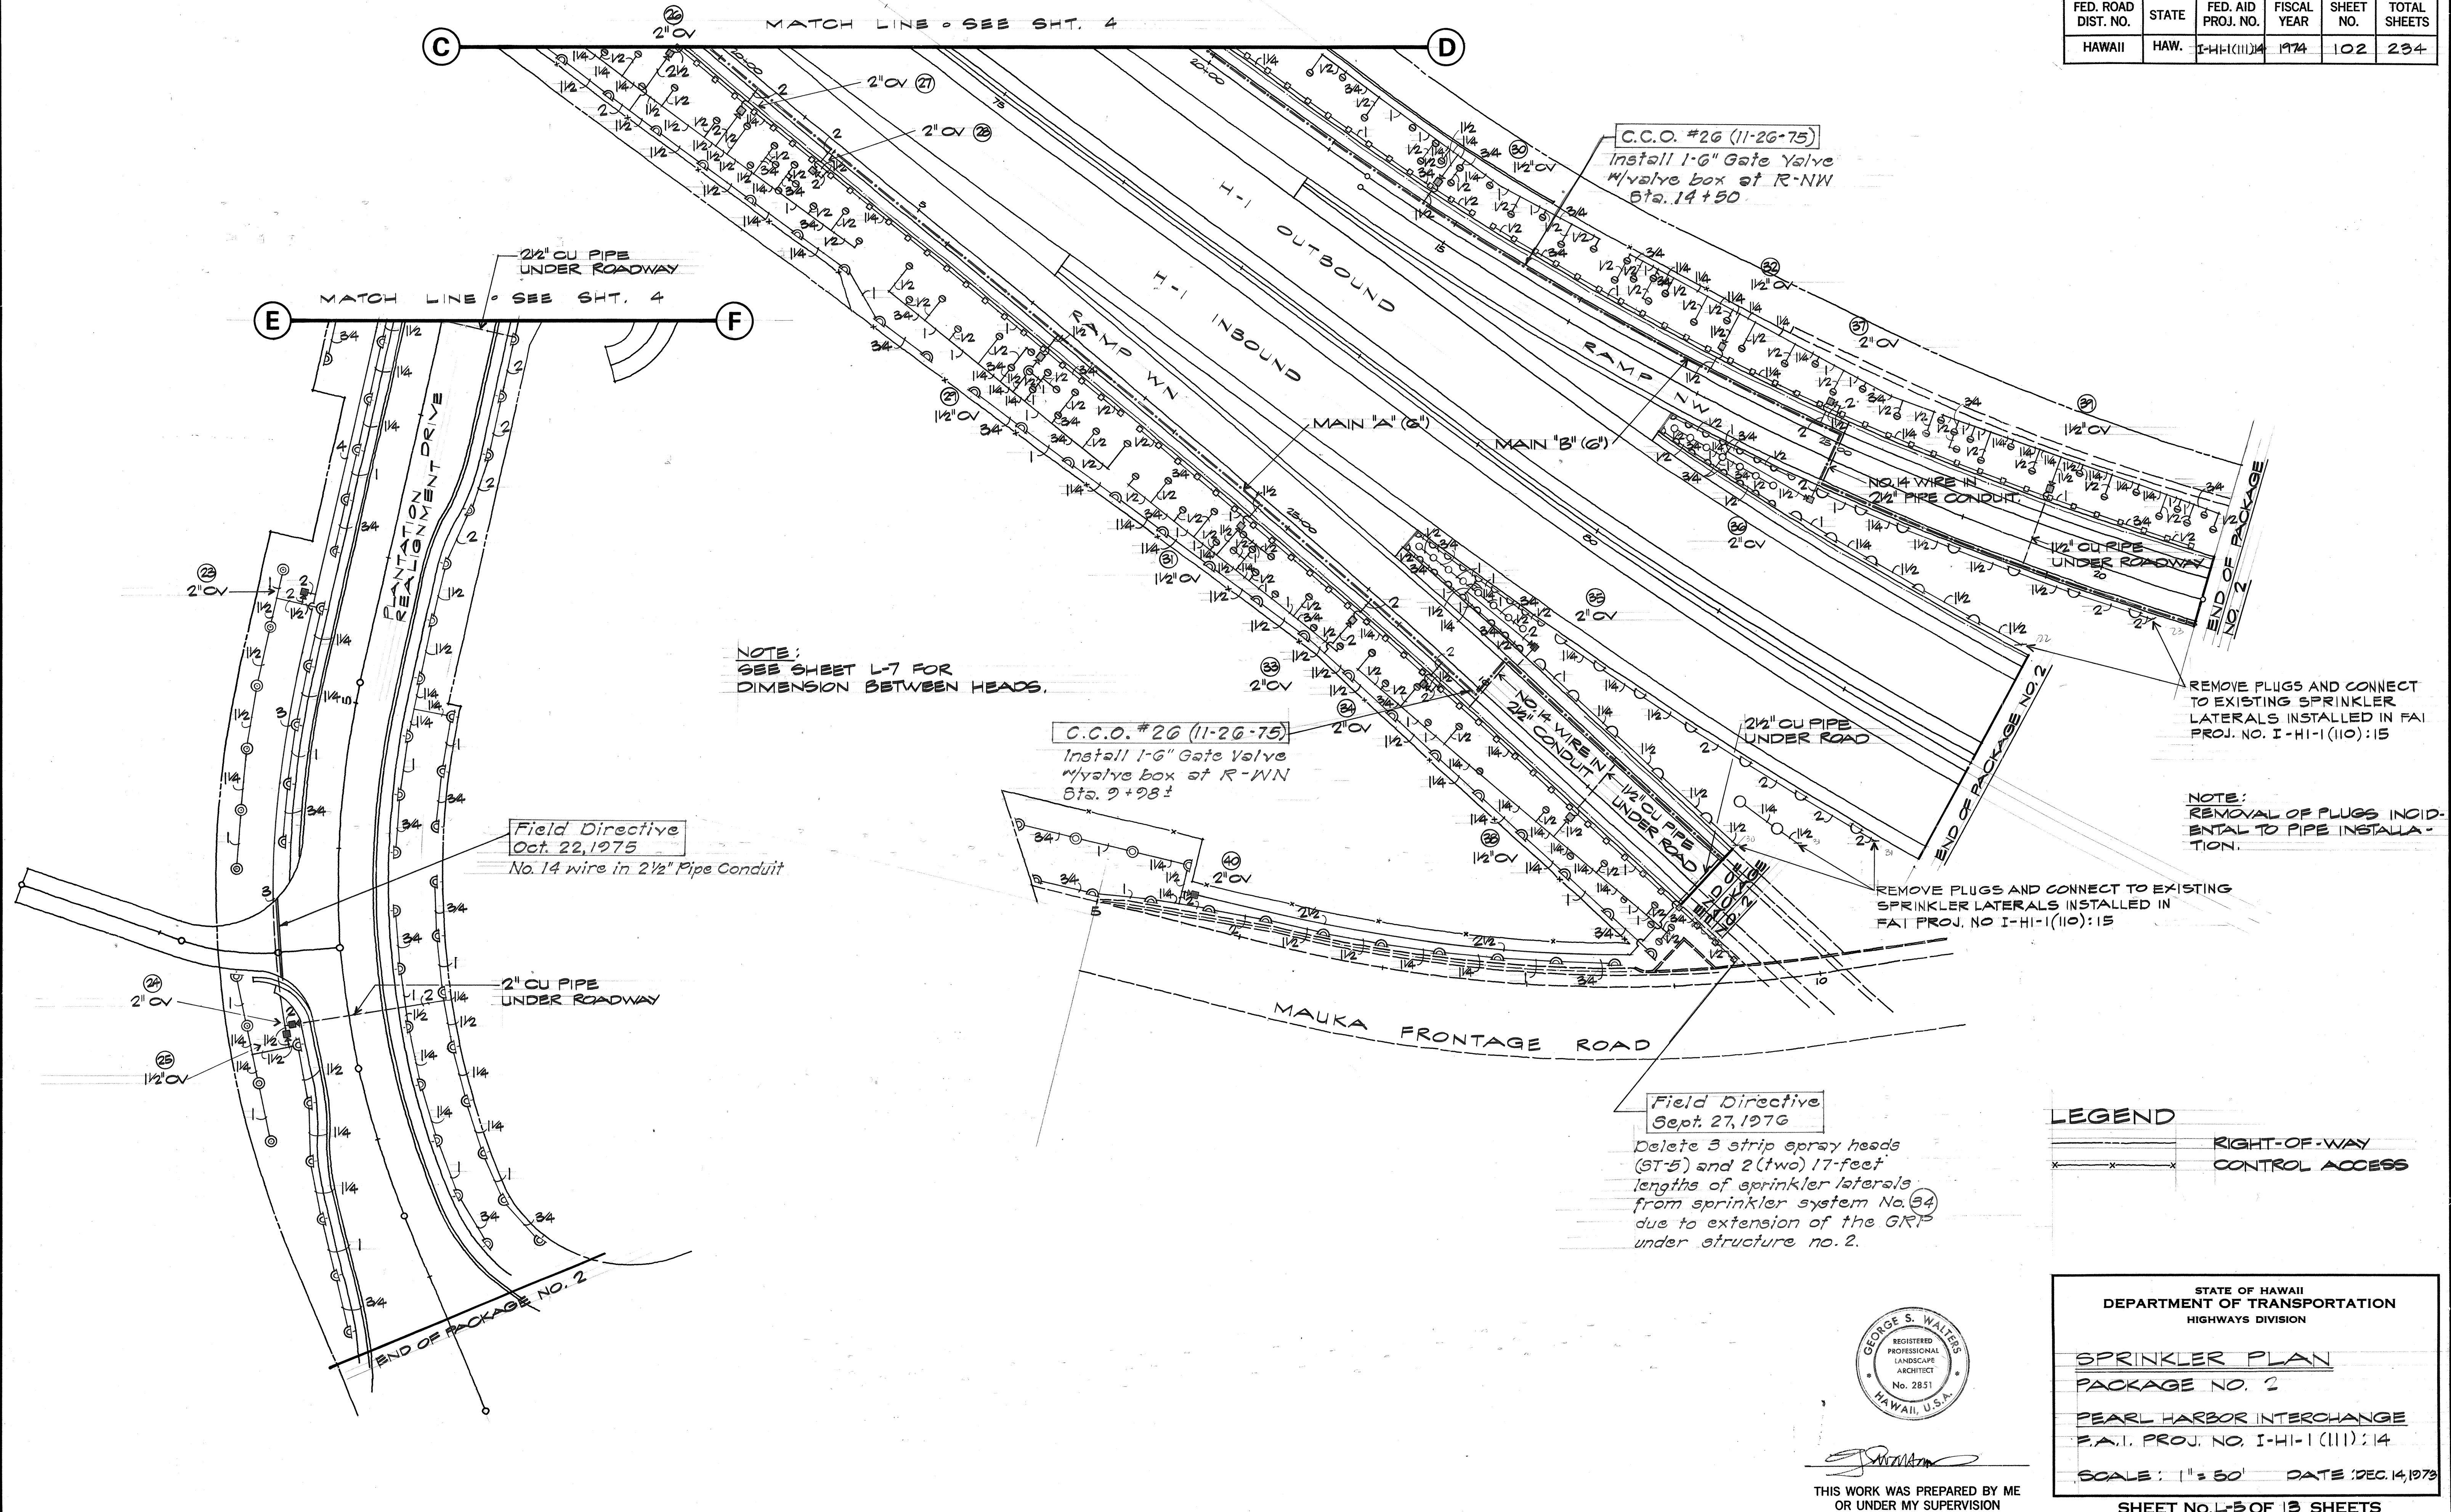

LEGEND	
—	RIGHT-OF-WAY
—	CONTROL ACCESS

STATE OF HAWAII
DEPARTMENT OF TRANSPORTATION
HIGHWAYS DIVISION

SPRINKLER PLAN
PACKAGE NO. 2
PEARL HARBOR INTERCHANGE
F.A.I. PROJ. NO. I-H-1 (111) 14
SCALE: 1" = 30' DATE: DEC. 14, 1973

SHEET NO. 15 OF 13 SHEETS

FED. ROAD DIST. NO.	STATE	FED. AID PROJ. NO.	FISCAL YEAR	SHEET NO.	TOTAL SHEETS
HAWAII	HAW.	I-HI-1(III)14	1974	103	234

VALVE NO.	LOCATION	VALVE NO.	LOCATION
① Φ OS = 97'	H-1 STA. 56+32	⑫ Φ OS = 100'	H-1 STA. 63+90
② Φ OS = 97'	H-1 STA. 56+51	⑬ Φ OS = 45'	PLANTATION DR STA. 7+91
③ Φ OS = 100'	H-1 STA. 59+11	⑭ Φ OS = 45'	PLANTATION DR STA. 7+75
④ Φ OS = 97'	H-1 STA. 59+50	⑮ Φ OS = 24'	RAMP NW STA. 5+94
⑤ Φ OS = 101'	H-1 STA. 60+61	⑯ Φ OS = 101'	H-1 STA. 67+76
⑥ Φ OS = 100'	H-1 STA. 62+47	⑰ Φ OS = 19'	RAMP NW STA. 6+51
⑦ Φ OS = 100'	H-1 STA. 62+69	⑱ Φ OS = 101'	H-1 STA. 68+83
⑧ Φ OS = 100'	H-1 STA. 62+90	⑲ Φ OS = 24'	RAMP WN STA. 00+76
⑨ Φ OS = 100'	H-1 STA. 63+97	⑳ Φ OS = 19'	RAMP NW STA. 8+63
⑩ Φ OS = 100'	H-1 STA. 64+71	㉑ Φ OS = 25'	RAMP NW STA. 8+38
⑪ Φ OS = 100'	H-1 STA. 63+57	㉒ Φ OS = 25'	RAMP NW STA. 12+30

NOTE:
DIMENSIONS ON THIS SHEET
INDICATE SPACING BETWEEN HEADS.

B

MATCH LINE - SEE THIS SHT.

A

E

F

MATCH LINE - SEE SHT. 5

Field Directive
Sept. 7, 1976
See Sht. #101

Automatic Controller "H"

Automatic Controller "J"

Plantation Drive

Bougainville Road

H-1 Outbound

H-1 Inbound

Main "A" (6")

Main "B" (6")

See Sht. #101 & C.O. 120 R

C.C.O. #46 (2-17-76)

END OF PROJECT

6" MAIN (BY OTHERS)

100'

2" CV

40'

20'

1 1/2" CV

17'

2" CV

40'

20'

1 1/2" CV

17'

2" CV

40'

20'

1 1/2" CV

FED. ROAD DIST. NO.	STATE	FED. AID PROJ. NO.	FISCAL YEAR	SHEET NO.	TOTAL SHEETS
HAWAII	HAW.	I-H-1(111)14	1974	104	234

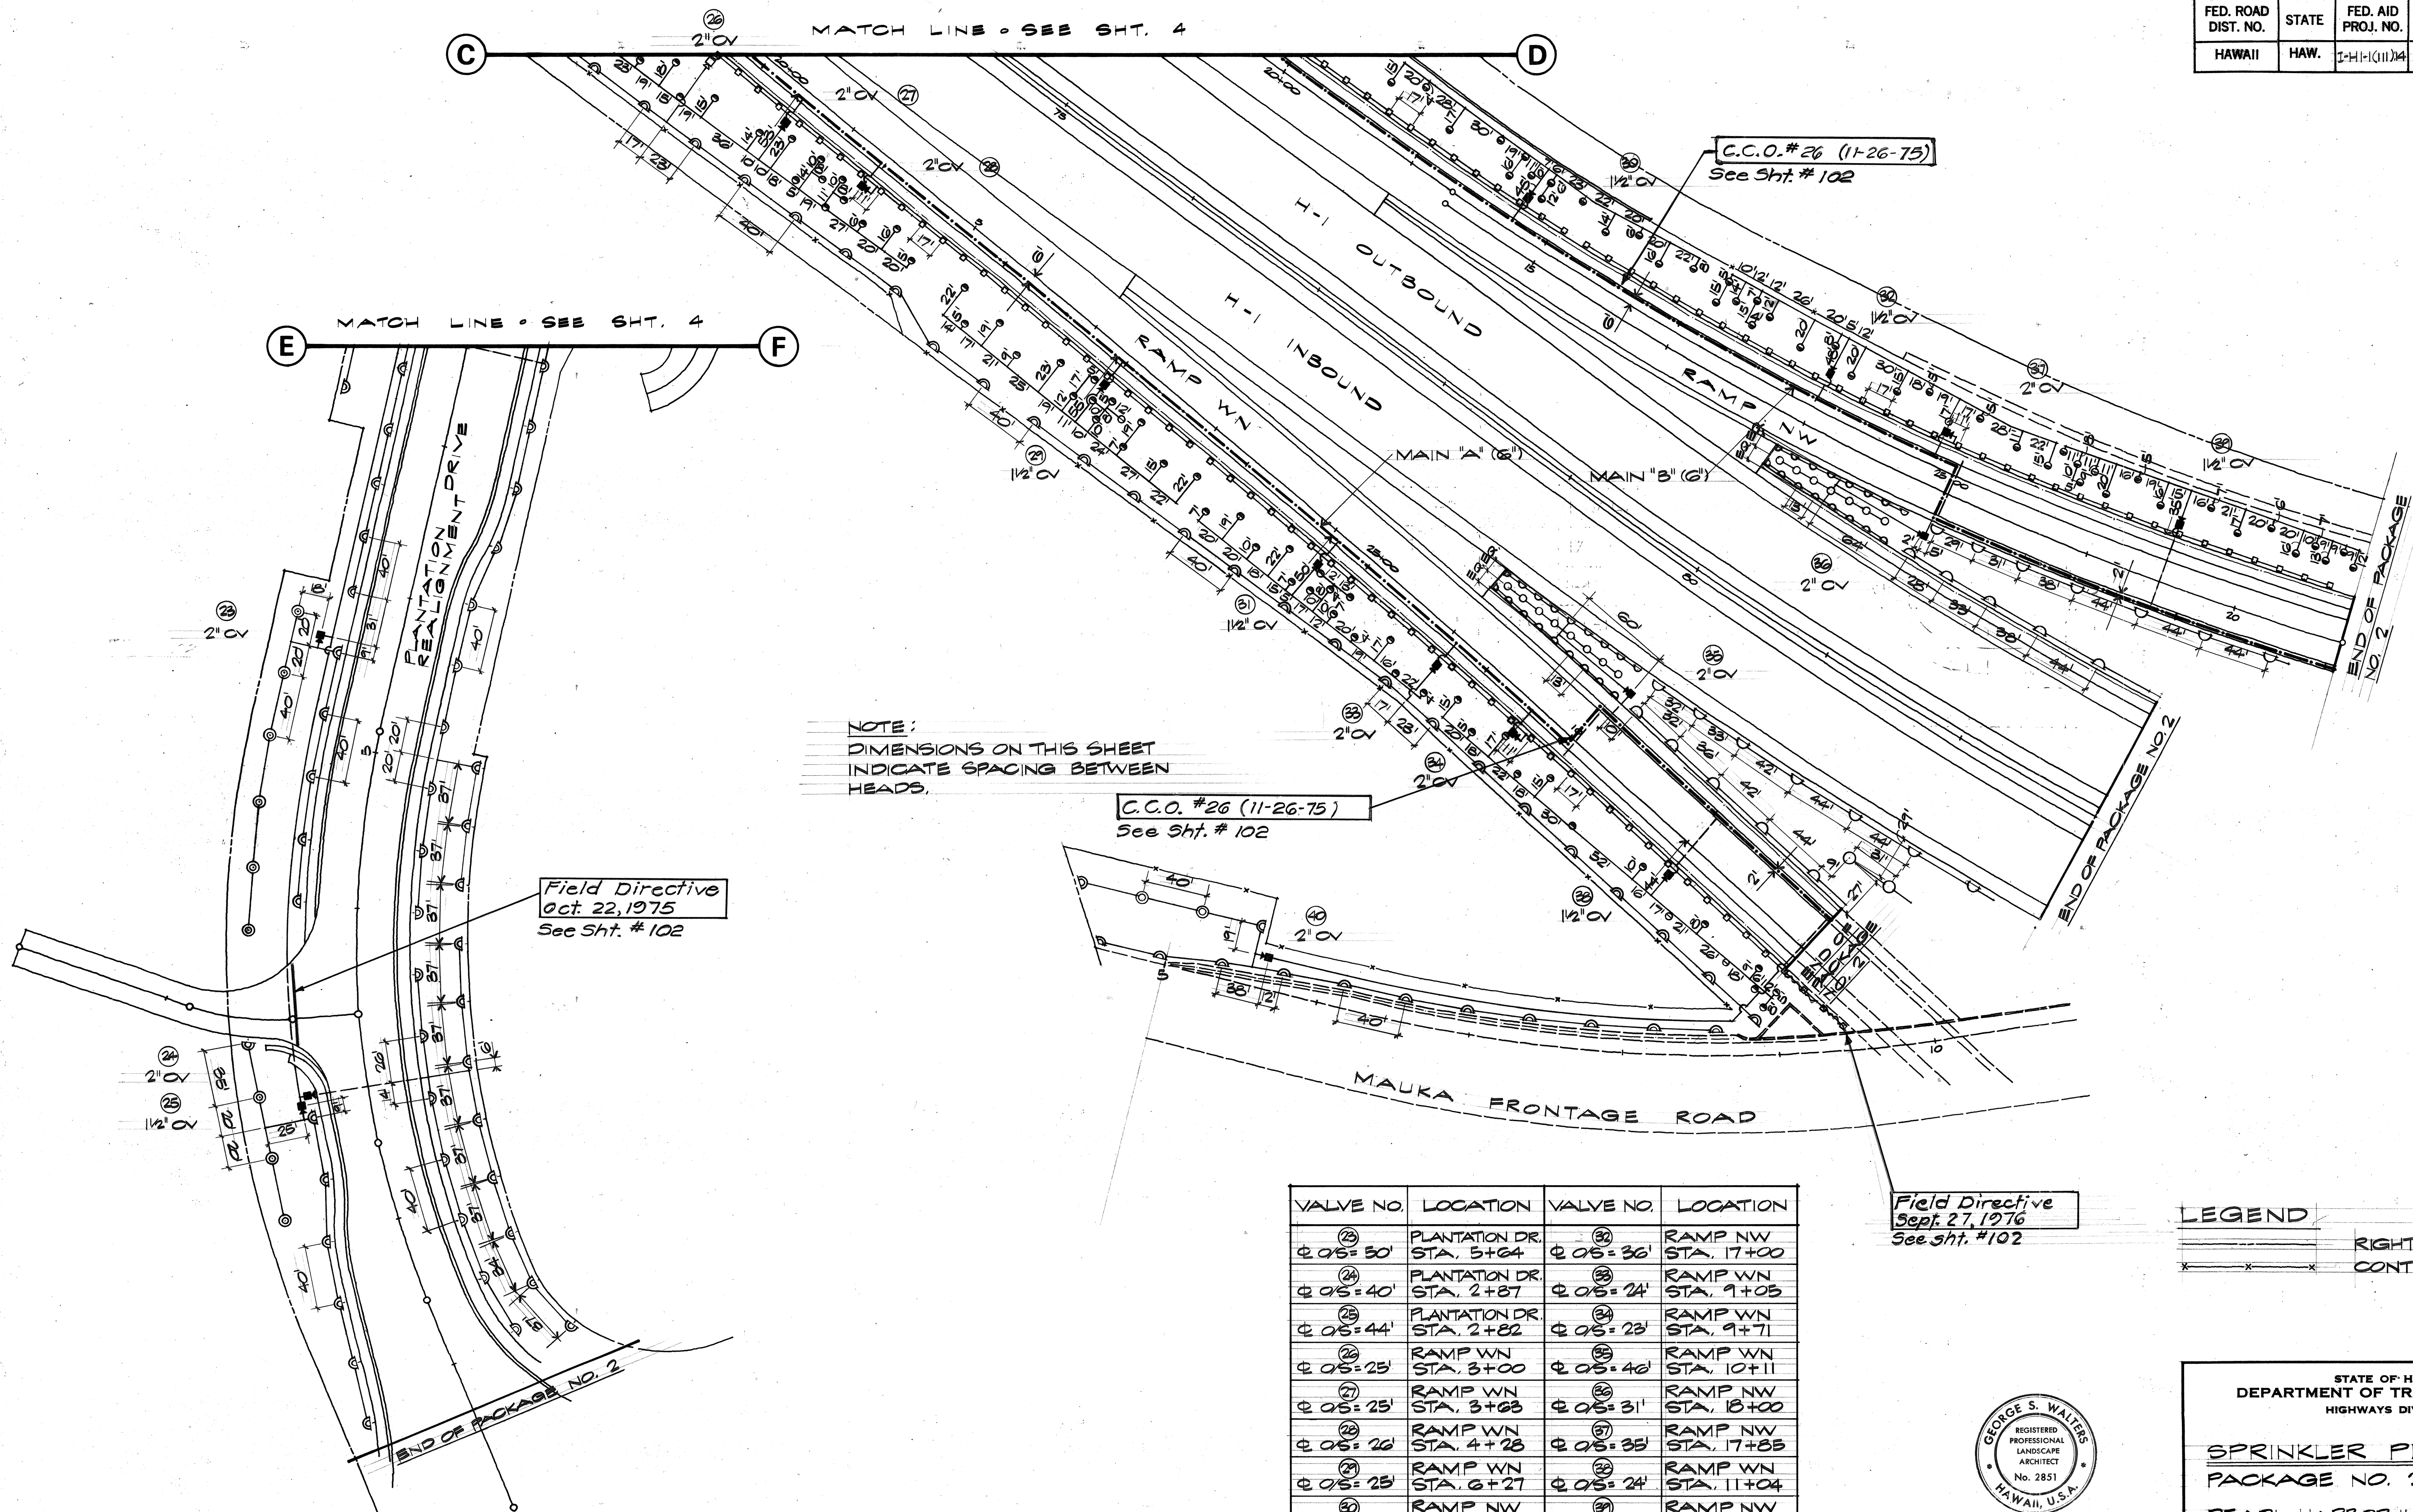

NOTE:
DIMENSIONS ON THIS SHEET
INDICATE SPACING BETWEEN
HEADS.

C.C.O. #26 (11-26-75)
See Sht. #102

Field Directive
Oct. 22, 1975
See Sht. #102

Field Directive
Sept. 27, 1976
See Sht. #102

VALVE NO.	LOCATION	VALVE NO.	LOCATION
26	PLANTATION DR. STA. 5+64	36	RAMP NW STA. 17+00
27	PLANTATION DR. STA. 2+87	37	RAMP WN STA. 9+03
28	PLANTATION DR. STA. 2+82	38	RAMP WN STA. 9+71
29	RAMP WN STA. 3+00	39	RAMP WN STA. 10+11
30	RAMP WN STA. 3+03	40	RAMP NW STA. 13+00
31	RAMP WN STA. 4+28	41	RAMP NW STA. 17+85
32	RAMP WN STA. 6+27	42	RAMP WN STA. 11+04
33	RAMP NW STA. 14+74	43	RAMP NW STA. 19+50
34	RAMP WN STA. 8+06	44	MAUKA FR. RD STA. 5+64

LEGEND
— RIGHT-OF-WAY
— CONTROL ACCESS




THIS WORK WAS PREPARED BY ME
OR UNDER MY SUPERVISION

STATE OF HAWAII
DEPARTMENT OF TRANSPORTATION
HIGHWAYS DIVISION

SPRINKLER PLAN
PACKAGE NO. 2
PEARL HARBOR INTERCHANGE
F.A.I. PROJ. NO. I-H-1 (111) 14
SCALE: 1" = 50' DATE: DEC. 14, 1978
SHEET NO. 1-7 OF 13 SHEETS

ORIGINAL PLAN	SURVEY PLOTTED BY	DATE
NOTE BOOK	DRAWN BY	
	DESIGNED BY	
	CHECKED BY	


FED. ROAD DIST. NO.	STATE	FED. AID PROJ. NO.	FISCAL YEAR	SHEET NO.	TOTAL SHEETS
HAWAII	HAW.	1-1-1-1111	1974	105	234

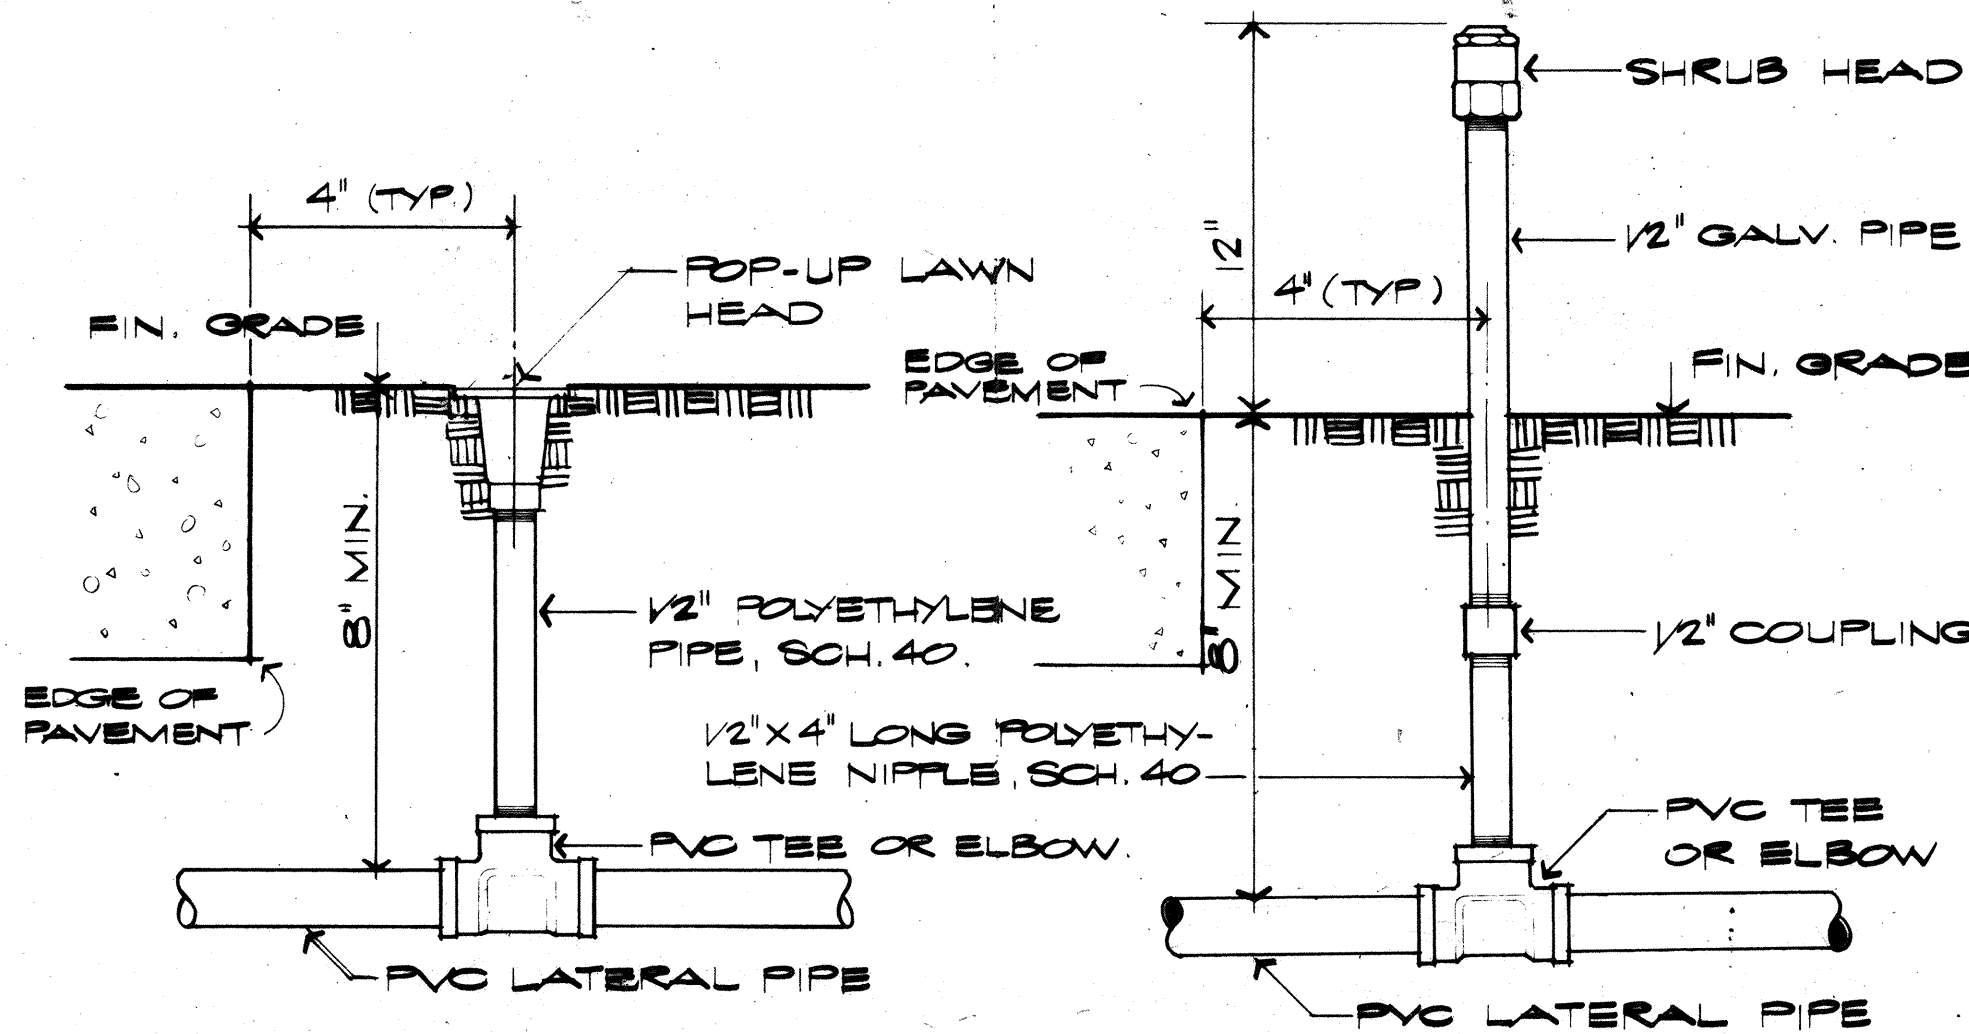

NOTE:
USE 1/2" POLYETHYLENE PIPE ON ALL POP-UP LAWN, STRIP-SPRAY, AND SHRUB HEADS DIRECTLY ADJACENT TO ROADWAY SHOULDERS. USE 1/2" GALV. STEEL PIPE RISER FOR REMAINING TYPES OF HEADS MENTIONED ABOVE.

TYPICAL POP-UP AND STRIP-SPRAY DETAIL
NO SCALE


TYPICAL SHRUB HEAD AND BUBBLER DETAIL
NO SCALE

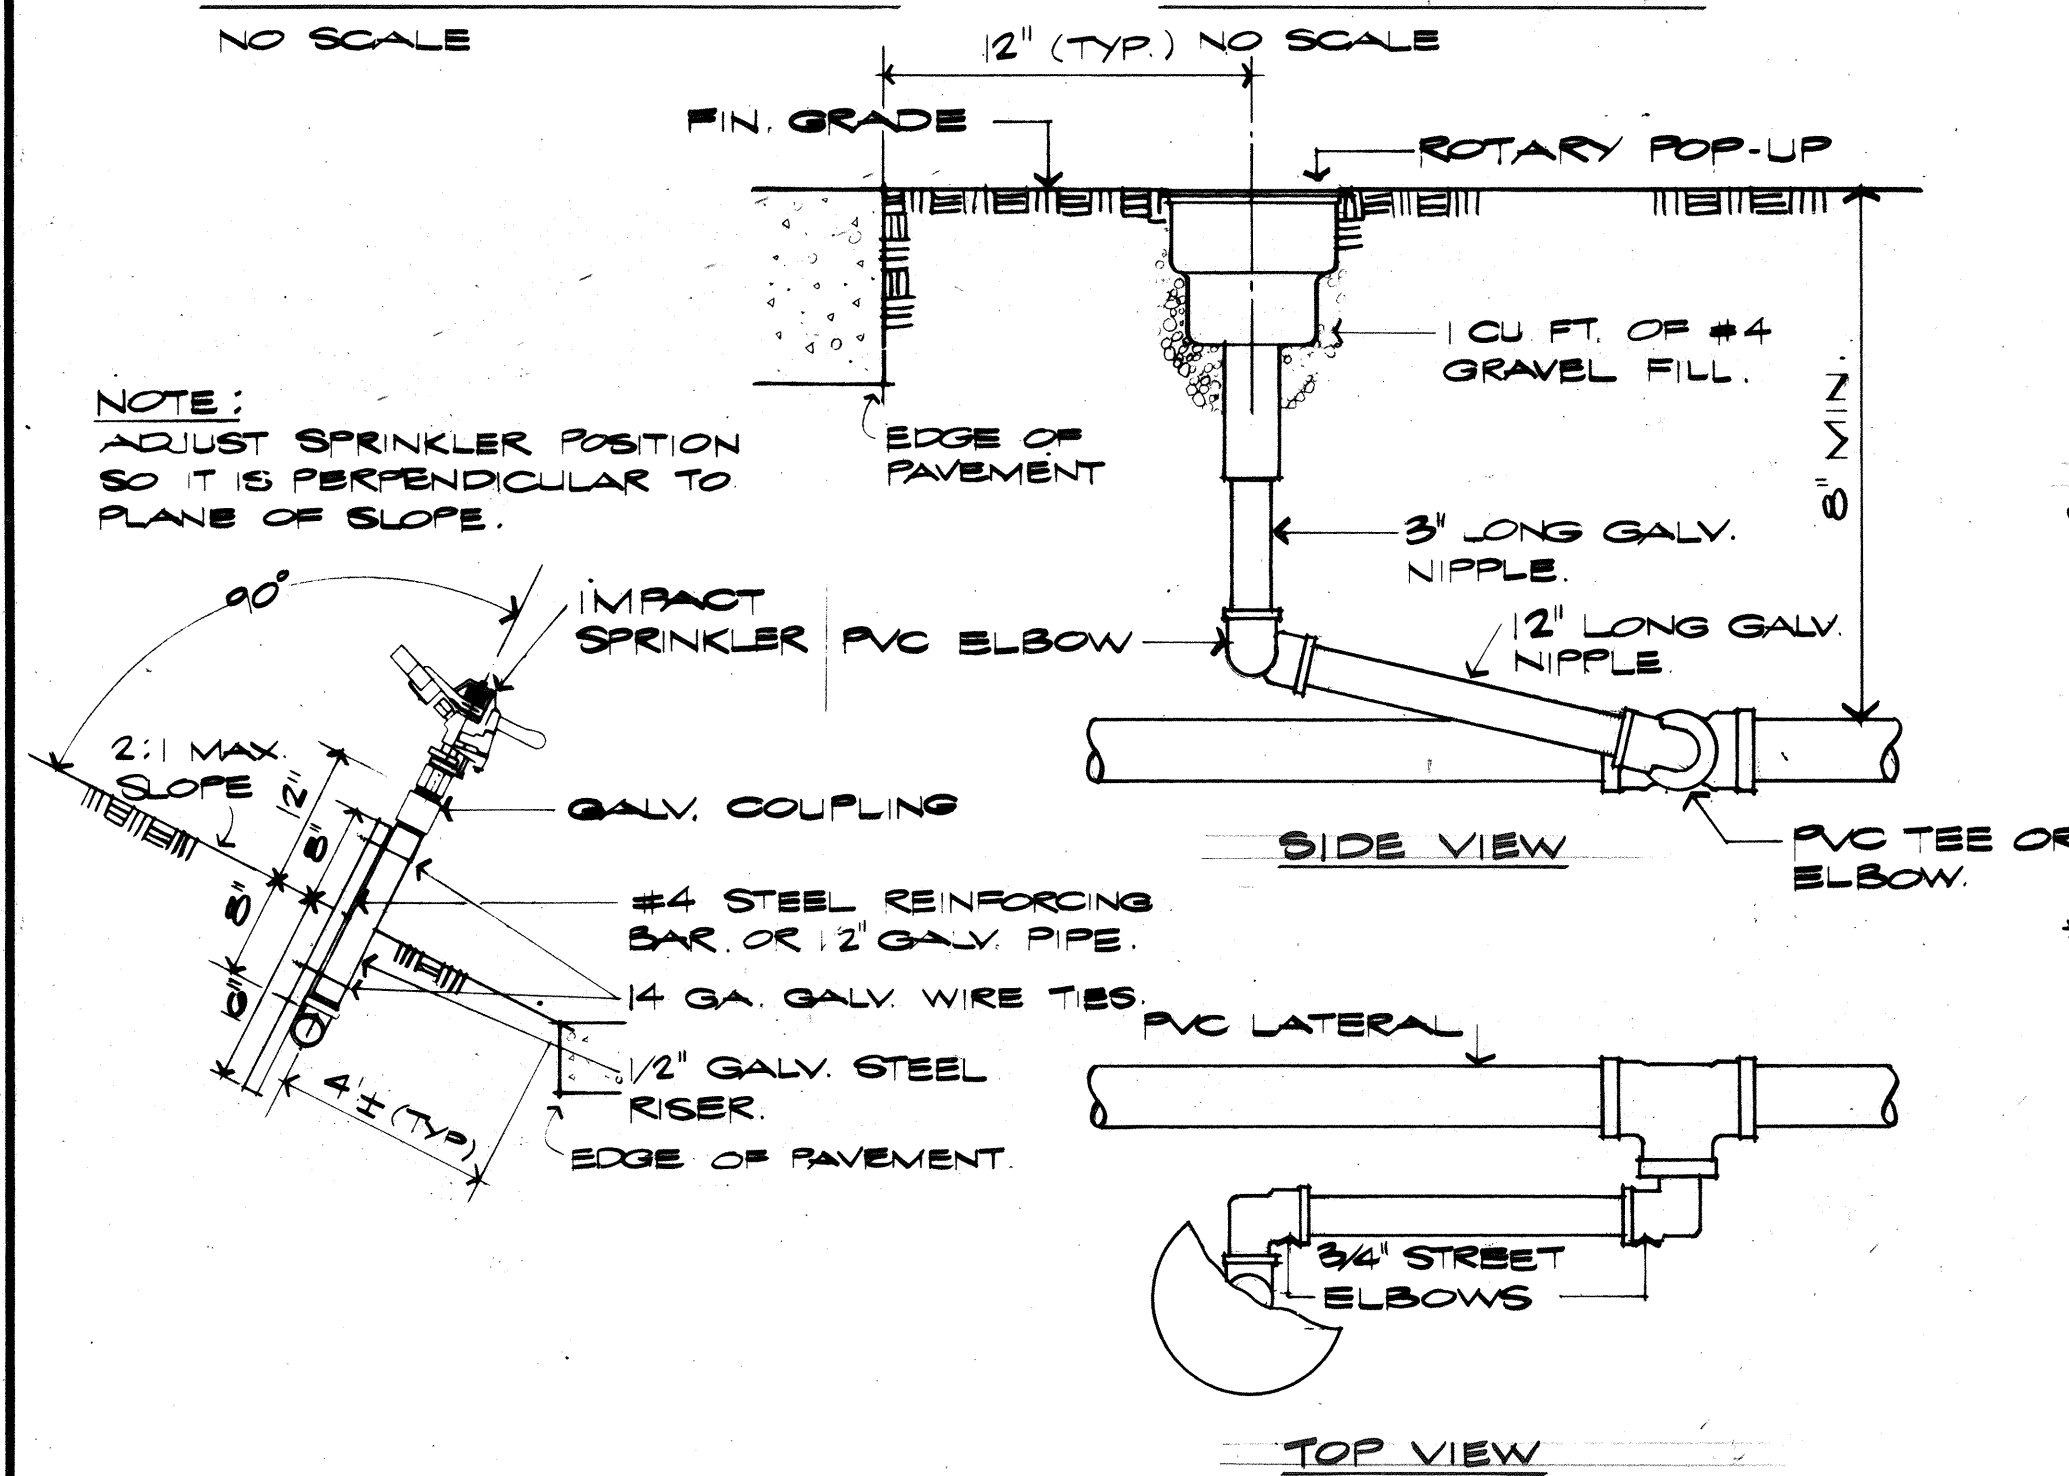

NOTE:
ADJUST SPRINKLER POSITION SO IT IS PERPENDICULAR TO PLANE OF SLOPE.


IMPACT HEAD DETAIL
NO SCALE

ROTARY POP-UP DETAIL
NO SCALE

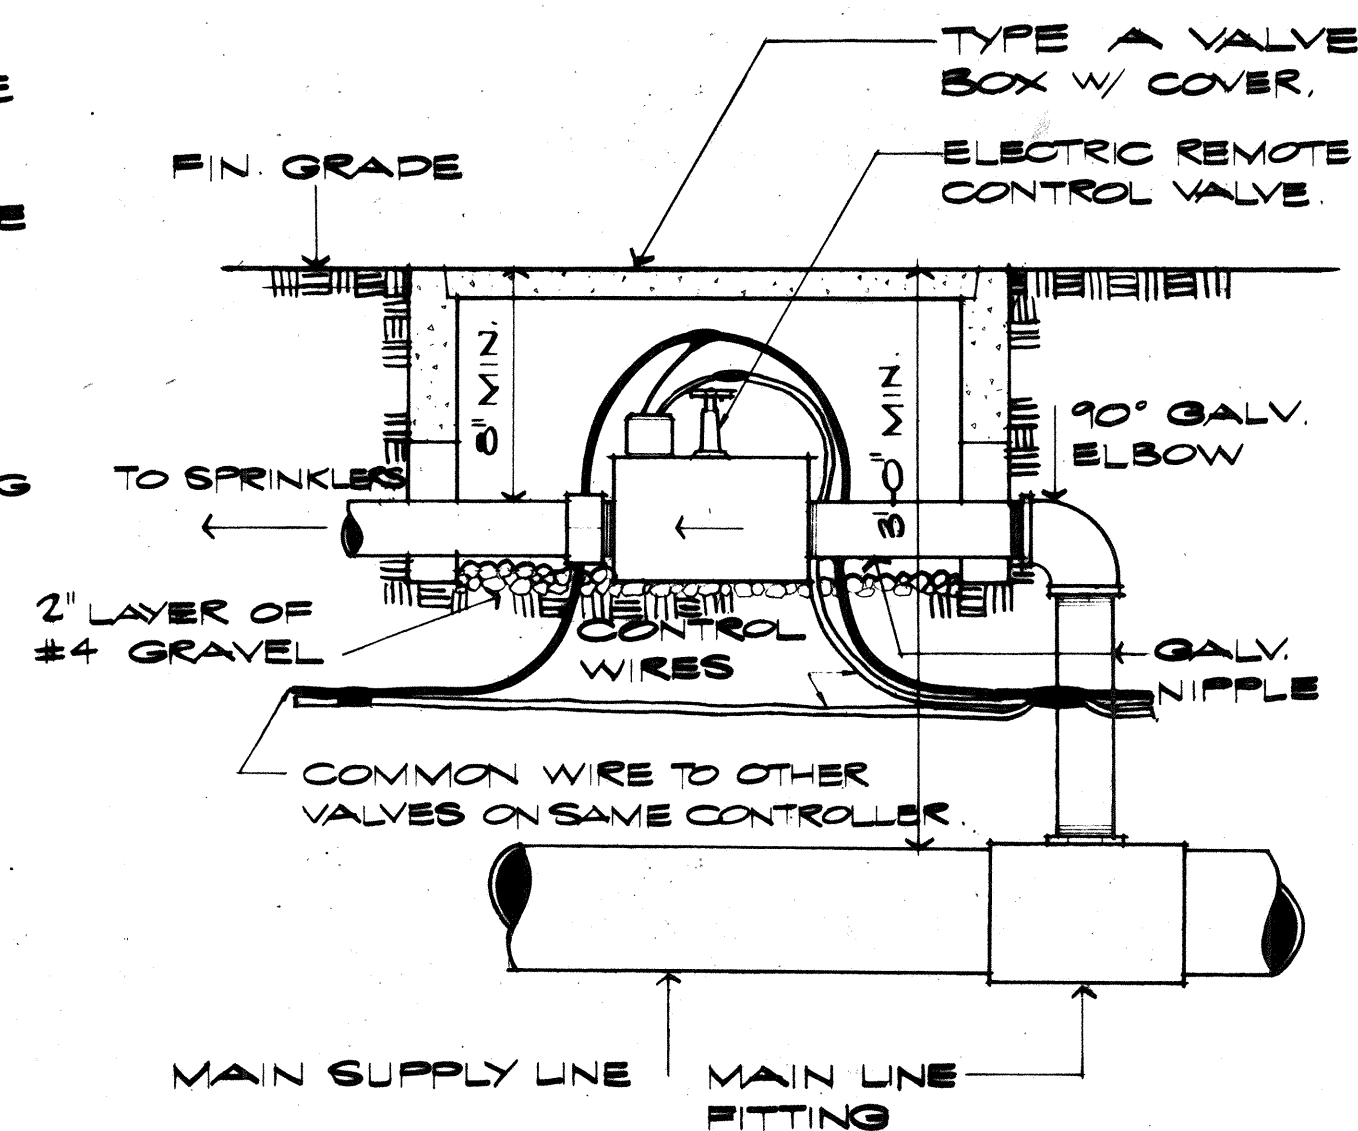

SOLENOID VALVE DETAIL
NO SCALE

NOTE:
SEE ELECTRICAL PLANS FOR ELECTRICAL TRANSFORMER DETAILS.
ADDITIONAL CONCRETE BASE REQUIRED FOR ELECTRICAL TRANSFORMER

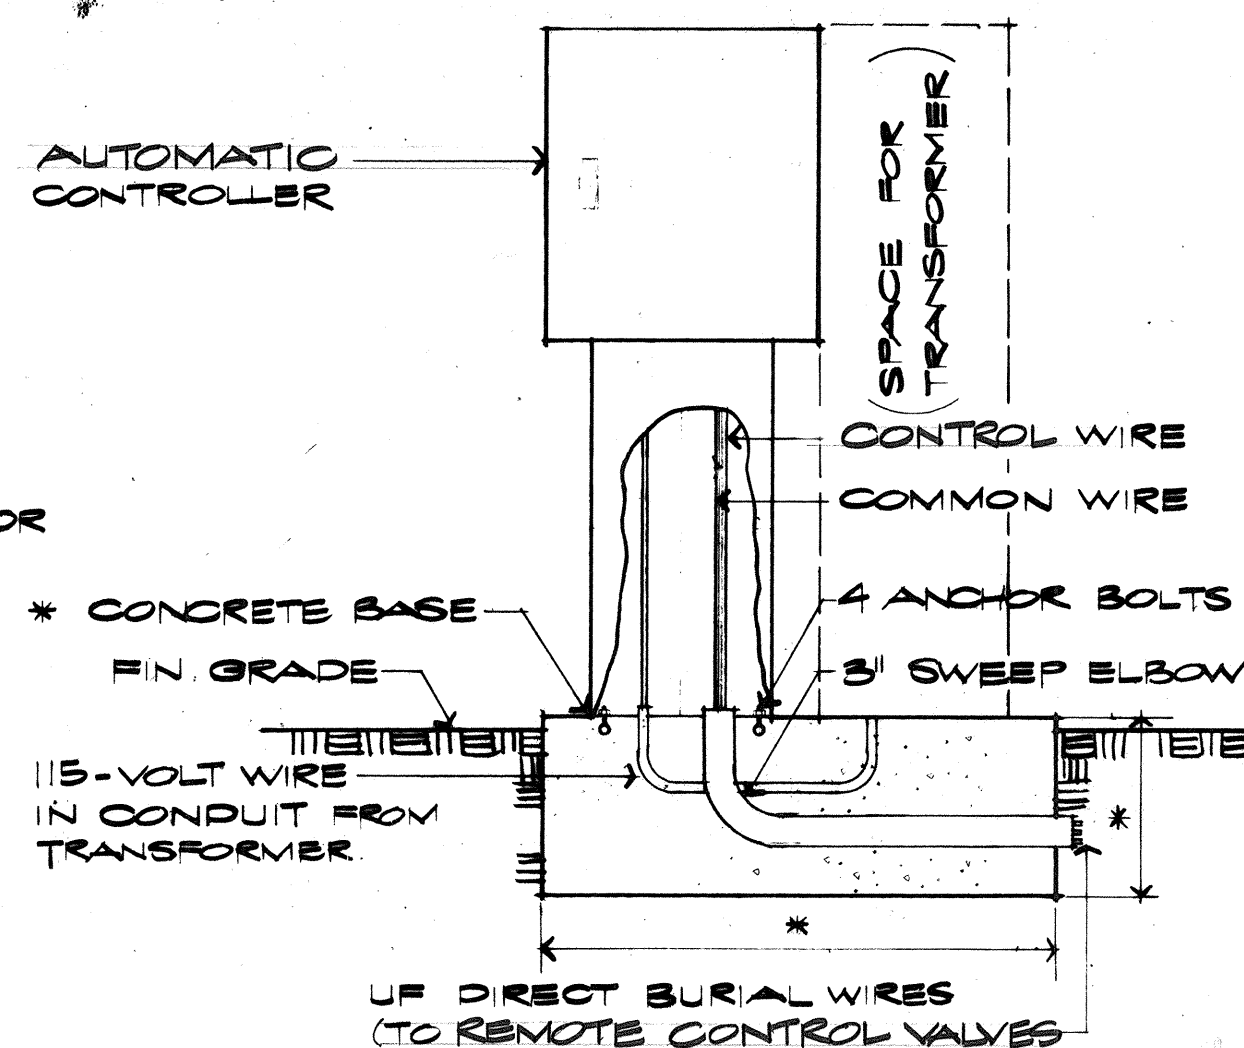

CONTROLLER DETAIL
NO SCALE

NOTE:
CONCRETE BASE TO BE SIZED ACCORDING TO MANUFACTURER'S RECOMMENDATIONS.

SPRINKLER LEGEND									
SPRINKLER	SYMBOL	DESCRIPTION	PRESSURE P.S.I.	COVERAGE FT.	FLOW GPM	NOZZLE INCHES	RISER INCHES	SPECIAL FEATURES	
P-12	○	POP-UP LAWN - FULL	20	12 RAD.	3.2		1/2	2" POP-UP	
P-12	△	POP-UP LAWN - HALF	20	12 RAD.	2.5		1/2		
P-12	◻	POP-UP LAWN - QUARTER	20	12 RAD.	1.2		1/2		
S-12	●	SHRUB SPRAY - FULL	20	10 RAD.	3.0		1/2		
S-12	▲	SHRUB SPRAY - HALF	20	10 RAD.	2.5		1/2		
S-12	◻	SHRUB SPRAY - QUARTER	20	10 RAD.	1.2		1/2		
B-10	⊙	BUBBLER HEAD	15	0	3.1		1/2		
ST-5	□	STRIP SPRAY	15	8X12	1.5		1/2		
I-35F	⊙	IMPACT - FULL	30	39 RAD.	5.5	3/16	3/4	BRASS/ BRONZE CONSTRUCTION W/ BRASS NOZZLE W/ BREAK-UP PIN.	
I-35P	⊙	IMPACT - PART	30	36 RAD.	3.1	9/64	1/2		
R-40F	⊙	ROTARY POP-UP - FULL	40	46 RAD.	9.3	7/32	1	BRASS/ BRONZE CONSTRUCTION W/ BRASS NOZZLE W/ BREAK-UP PIN.	
R-40P	⊙	ROTARY POP-UP - PART	40	40 RAD.	4.6	5/32	3/4		
	■	AUTOMATIC CONTROLLER - 10 STATION (MINIMUM)							PEDESTAL MOUNTED
	■	ELECTRIC REMOTE CONTROL VALVE							24V WATERPROOF SOLENOID INSTALL IN VALVE BOX W/ COVER

NOTES TO CONTRACTOR:

- 1- ALL WIRING UNDER ROADWAY TO BE INSTALLED IN 2 1/2" PIPE CONDUITS.
- 2- PVC PIPE AND FITTINGS SHALL BE INSTALLED IN STRICT ACCORDANCE WITH THE MANUFACTURER'S RECOMMENDATIONS.
- 3- NO ROCKS OR SHARP OBJECTS ONE INCH OR LARGER SHALL BE USED IN THE BACKFILLING OF TRENCHES EXCEPT IN TUFF-CUT SLOPES.
- 4- FINAL LOCATIONS OF CONTROL VALVES SHALL BE DETERMINED BY THE ENGINEER.
- 5- CONTRACTOR SHALL ADJUST ALL SPRINKLER HEADS FOR PROPER COVERAGE.
- 6- CONCRETE REACTION BLOCK SHALL BE CLASS B.
- 7- PROVIDE TWO 30" LONG HEAVY PLATED IRON KEY FOR CONTROL VALVE (INCIDENTAL TO VALVE COST).
- 8- UNLESS OTHERWISE NOTED ON DRAWINGS THE STANDARD TRIANGULAR SPACING BETWEEN VARIOUS TYPES OF SPRINKLER HEADS ARE AS FOLLOWS:
- 9- TRENCH WIDTHS SHALL NOT BE LESS THAN 12".
- 10- ALL SPRINKLER LATERALS UNDER THE ROADWAY SHALL BE AT A DEPTH OF 2'-0".
- 11- ALL SPRINKLER SUPPLY LINES SHALL BE AT A DEPTH OF 3'-0".

POP-UP LAWN - 15' PART FULL
SHRUB SPRAY - 15' - 40' 43'
ROTARY POP-UP - 44' 47'

THIS WORK WAS PREPARED BY ME OR UNDER MY SUPERVISION




STATE OF HAWAII
DEPARTMENT OF TRANSPORTATION
HIGHWAYS DIVISION

SPRINKLER DETAILS PACKAGE NO. 2

PEARL HARBOR INTERCHANGE
F.A.I. PROJ. NO. I-HI-1(111):14

SCALE: NONE DATE: DEC. 14, 1973

SHEET NO. 105 OF 13 SHEETS

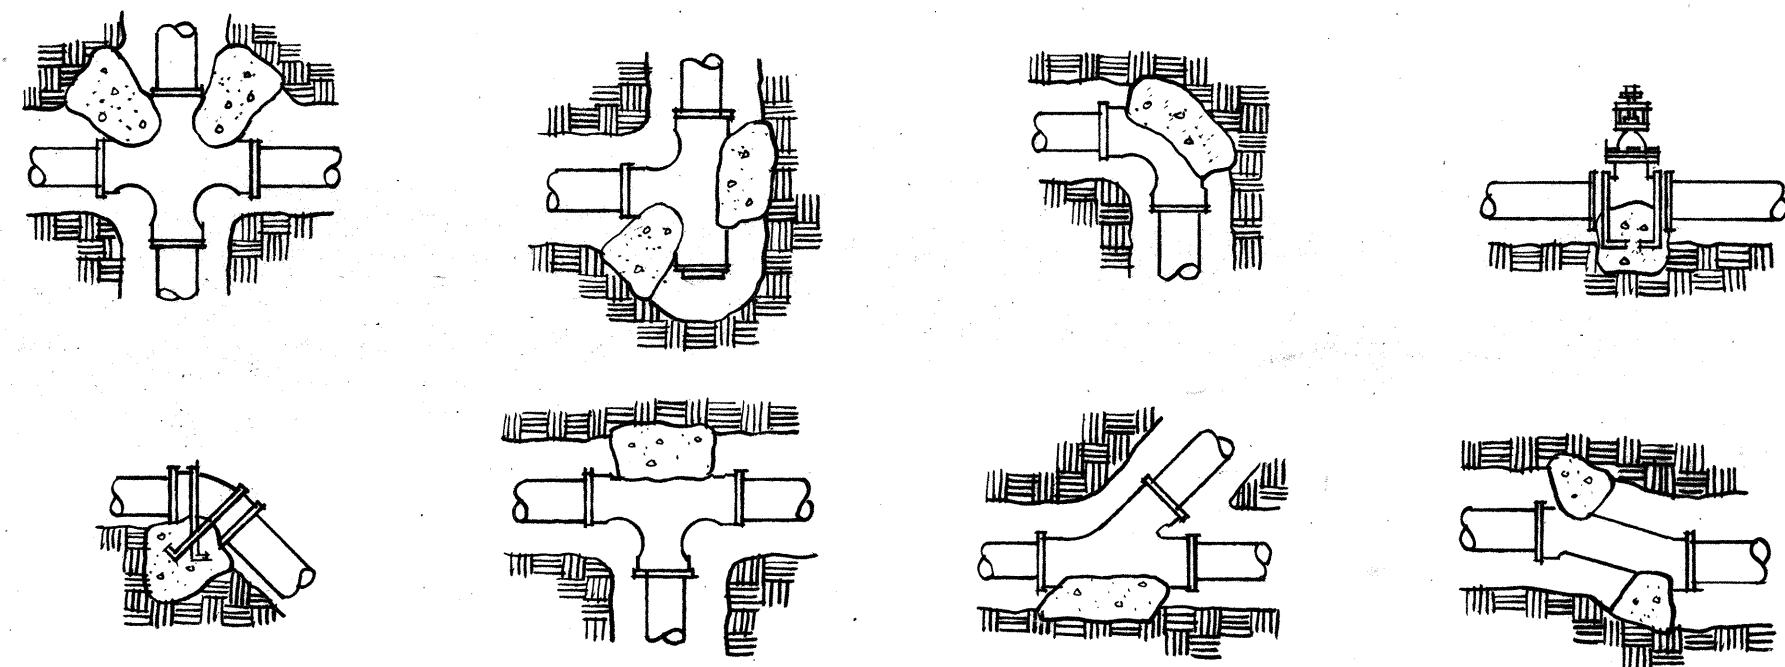



INSTALLATION NOTES

1. ALL MAIN LINE TO BE INSTALLED & TESTED ACCORDING TO MANUFACTURER'S INSTALLATION GUIDE. EACH SHALL BE A PART OF THE INSTALLATION SPECIFICATIONS.
2. ALL TRENCH DEPTH AND WIDTH SHALL BE AS SHOWN ON THE IRRIGATION PLANS.
3. THE CONTRACTOR SHALL ARRANGE FOR THE SERVICE OF THE MANUFACTURER'S QUALIFIED INSTRUCTOR.

TYPICAL THRUST BLOCK DETAILS FOR
TRANSITE OR PVC PIPE

NO SCALE

BEARING AREA REQUIRED FOR THRUST BLOCKS (SQ. FT.)						
PIPE SIZE	3"	2 1/2"	2"	1 1/2"	1 1/4"	4"
TEES & CROSSES	1.00	0.80	0.50	0.50	0.50	1.25
90° BEND	1.25	0.75	0.50	0.50	0.50	2.00
45° BEND	0.75	0.50	0.50	0.50	0.50	1.00

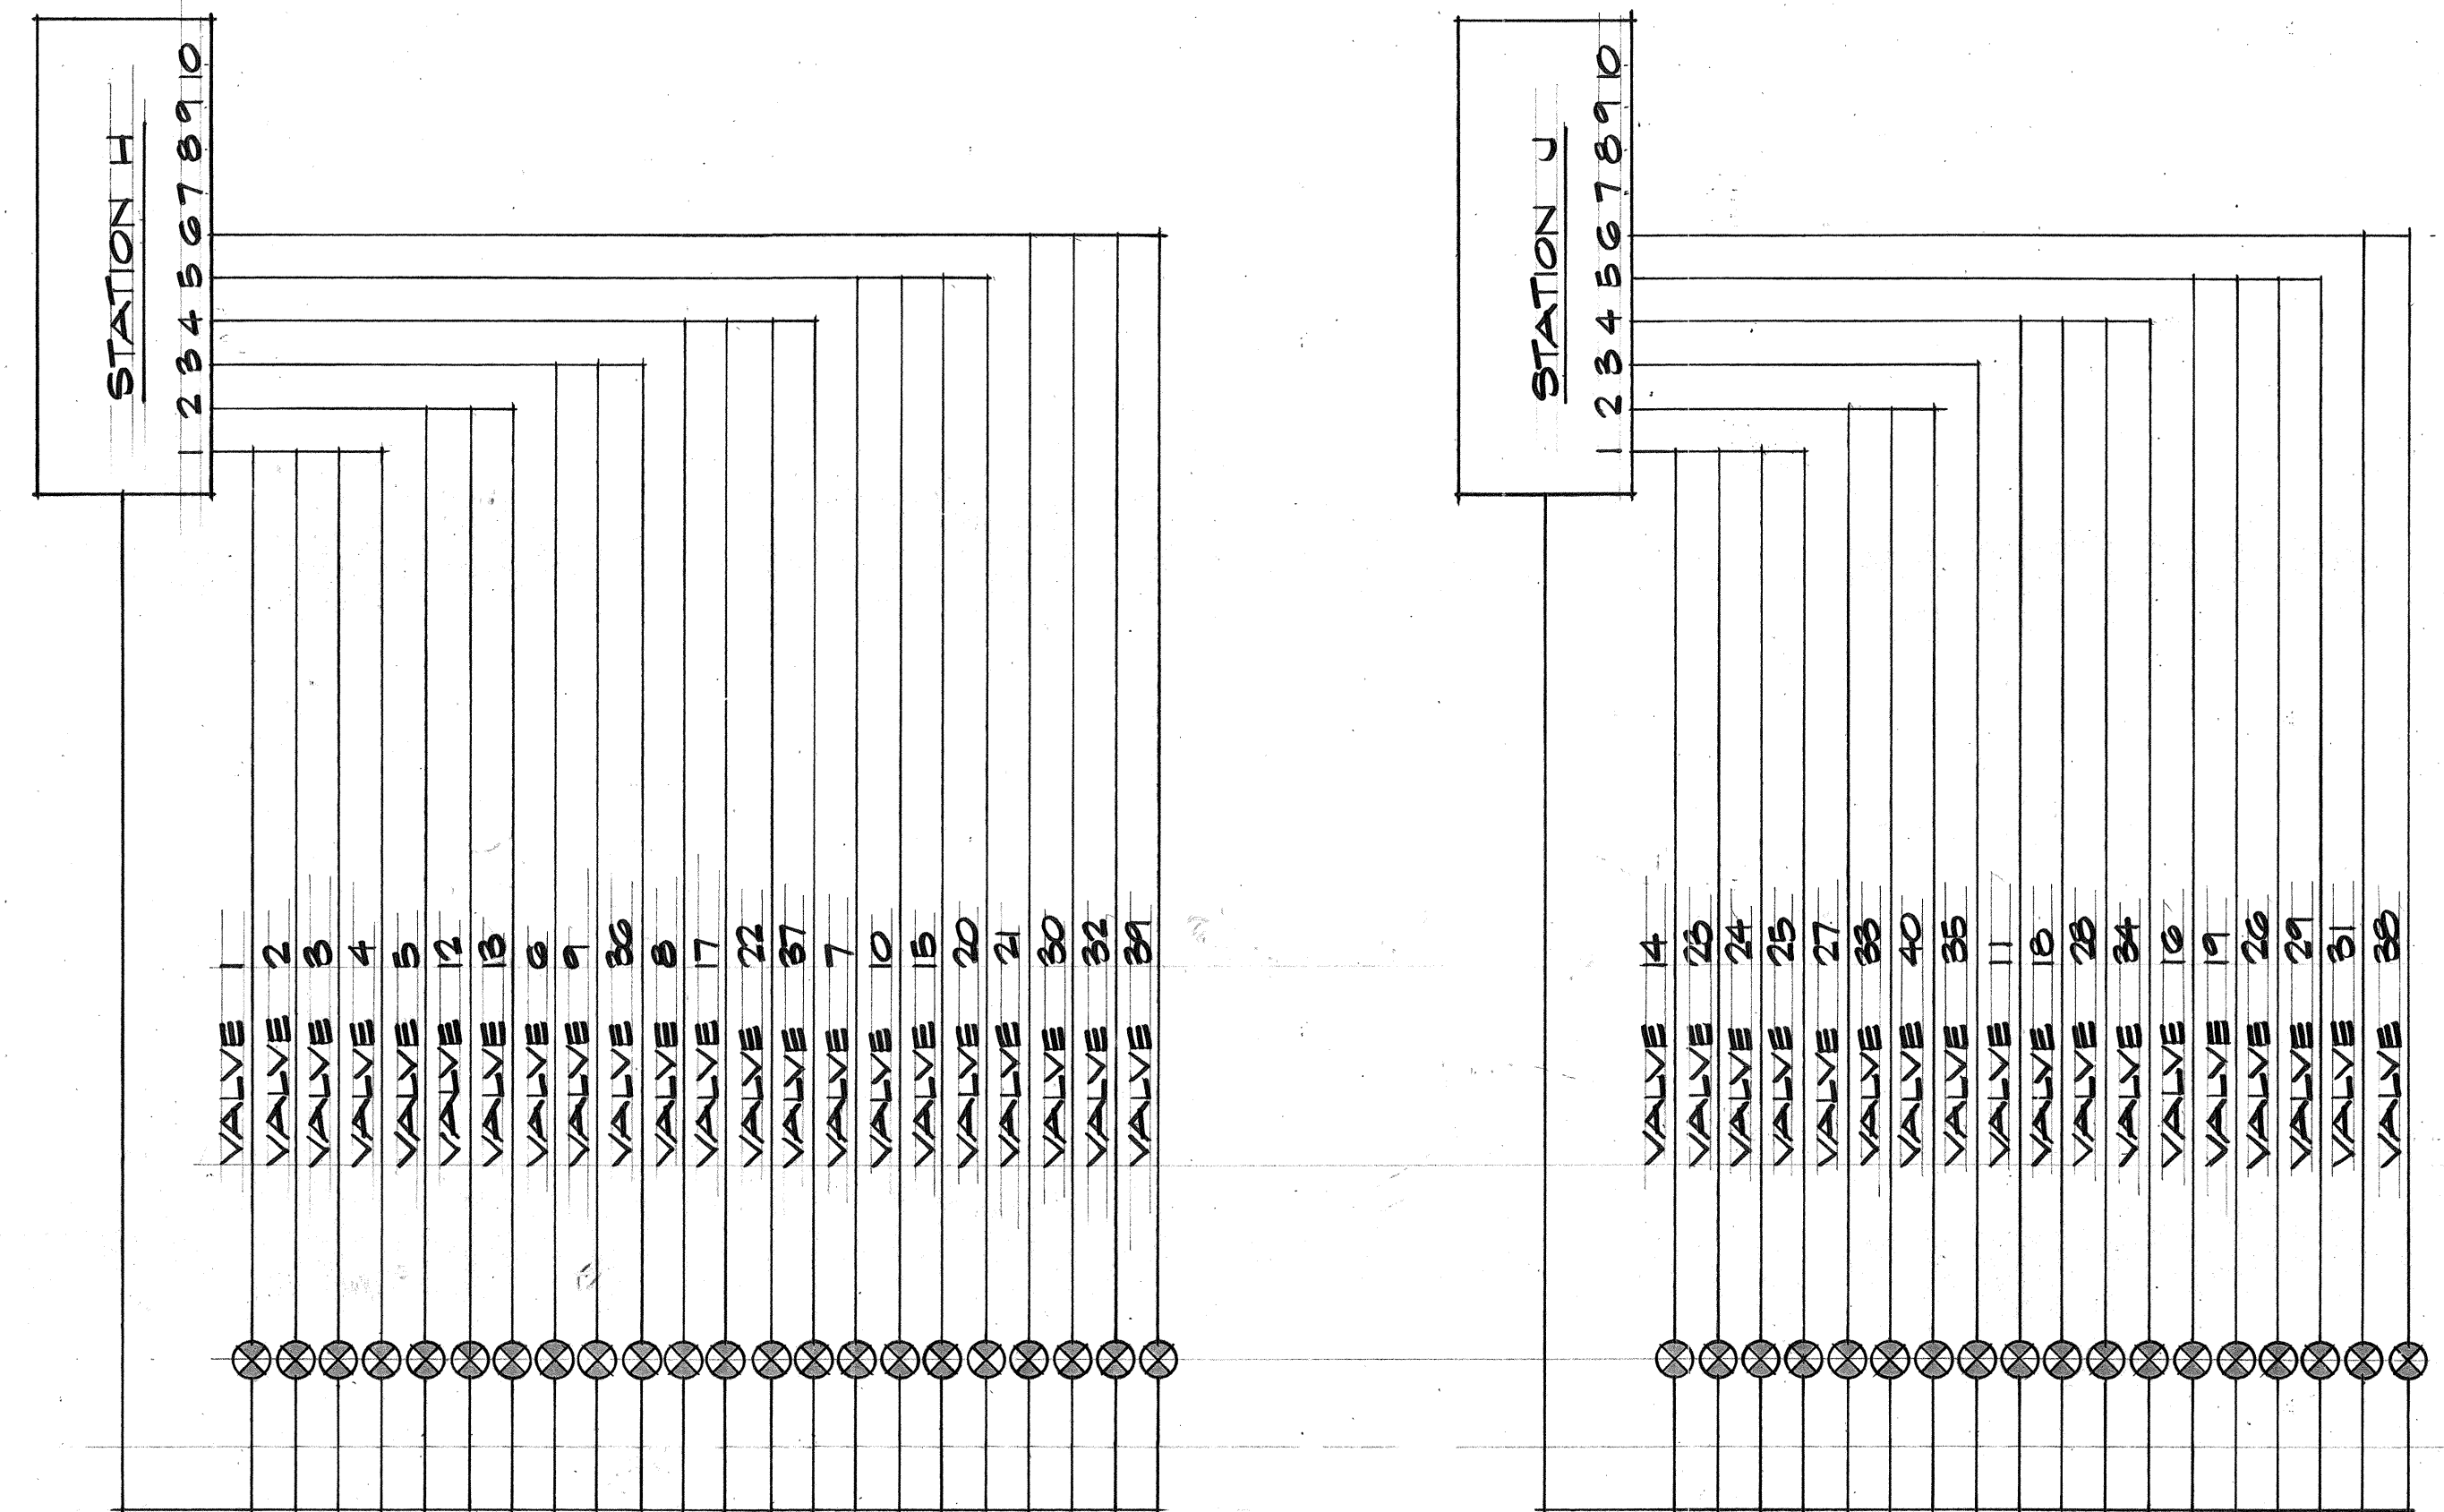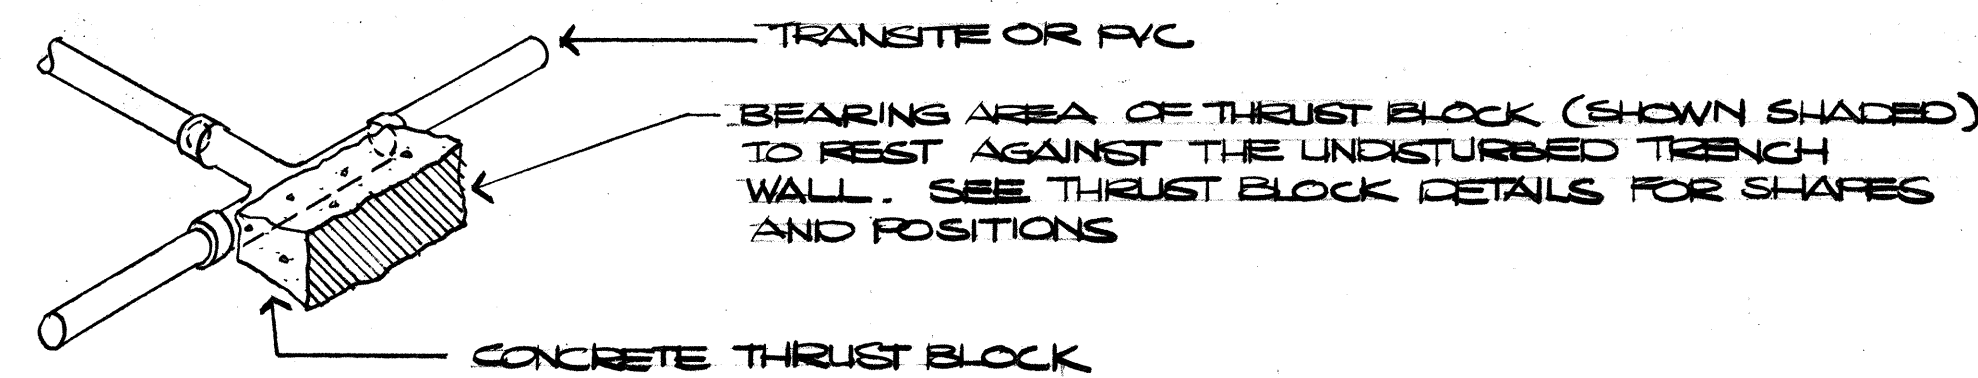

NOTE:
ALL WIRES ARE NO. 14 WIRE.

SCHEMATIC WIRING DIAGRAM

OPERATING SCHEDULE			
STATION NUMBER	STATION NO.	H	J
	DAY OF OPERATION	MTWThFS	MTWThFS
	STARTING TIME	8:00 A.M. 2:00 P.M.	8:30 P.M. 8:00 A.M.
1		42 MIN.	42 MIN.
2		42	42
3		7	7
4		4	4
5		2	2
6		2	2
7			
8			
9			
10			

Field Directive
Feb. 5, 1976

All automatic sprinkler
system controllers shall
be set to operate only
between 8:00 a.m. and 3:30 p.m.



THIS WORK WAS PREPARED BY ME
OR UNDER MY SUPERVISION

STATE OF HAWAII
DEPARTMENT OF TRANSPORTATION
HIGHWAYS DIVISION

SPRINKLER DETAILS
PACKAGE NO. 2

PEARL HARBOR INTERCHANGE
F.A.I. PROJ. NO. 1-HI-1(111):14

SCALE: NONE DATE: DEC. 14, 1973

SHEET NO. 19 OF 13 SHEETS

SPRINKLER

SUMMARY

FED. ROAD DIST. NO.	STATE	FED. AID PROJ. NO.	FISCAL YEAR	SHEET NO.	TOTAL SHEETS
HAWAII	HAW.	1-HI-1(111)4	1974	109	234

ESTIMATED QUANTITIES

SYSTEM NO.	ITEM NO.	003	008	009	010	1092	10
------------	----------	-----	-----	------	------	----

SUMMARY

FED. ROAD DIST. NO.	STATE	FED. AID PROJ. NO.	FISCAL YEAR	SHEET NO.	TOTAL SHEETS
HAWAII	HAW.	1-H-1(III)4	1974	110	234

ESTIMATED QUANTITIES

SYSTEM NO.	ITEM NO.	VALVE LOCATION																				REMARKS														
	CONCRETE FOR SPRINKLER SYSTEM	CONCRETE OTHER THAN SPRINKLER SYSTEM (COPES 5)	2 1/2-INCH RIGID STEEL PIPE, ACP OR PVC PIPE CONDUIT	12-INCH GALVANIZED STEEL PIPE OR POLYETHYLENE PIPE	12-INCH GALVANIZED STEEL PIPE	3/4-INCH GALVANIZED STEEL PIPE	1-INCH GALVANIZED STEEL PIPE	1 1/4-INCH COPPER PIPE	1 1/2-INCH COPPER PIPE	2-INCH COPPER PIPE	2 1/2-INCH COPPER PIPE	3-INCH COPPER PIPE	12-INCH GALVANIZED STEEL PIPE COPPER PIPE, OR PVC PIPE	3/4-INCH GALVANIZED STEEL PIPE COPPER PIPE, OR PVC PIPE	1-INCH GALVANIZED STEEL PIPE COPPER PIPE, OR PVC PIPE	1 1/4-INCH GALVANIZED STEEL PIPE COPPER PIPE, OR PVC PIPE	1 1/2-INCH GALVANIZED STEEL PIPE COPPER PIPE, OR PVC PIPE	2-INCH GALVANIZED STEEL PIPE COPPER PIPE, OR PVC PIPE	2 1/2-INCH GALVANIZED STEEL PIPE COPPER PIPE, OR PVC PIPE	3-INCH GALVANIZED STEEL PIPE COPPER PIPE, OR PVC PIPE	P-1/2 SPRINKLER HEAD	S-1/2 SPRINKLER HEAD	R(40) SPRINKLER HEAD	T(85) SPRINKLER HEAD	B-10 SPRINKLER HEAD	S-5 SPRINKLER HEAD	AUTOMATIC CONTROLLER 10-STATION MINIMUM	CENTRAL AUTOMATIC CONTROLLER 8-STATION MINIMUM	1 1/4-INCH ELECTRIC CONTROL VALVE W/ TYPE A VALVE BOX	1 1/2-INCH ELECTRIC CONTROL VALVE W/ TYPE A VALVE BOX	2-INCH ELECTRIC CONTROL VALVE W/ TYPE A VALVE BOX	DIRECT BURIAL CABLES	STRUCTURE EXCAVATION FOR SPRINKLER LATERALS	FURNISHING AND INSTALLING OF SPRINKLER GLASS		
	UNIT USED	CUYD.	CUYD.	LN. FT.	LN. FT.	LN. FT.	LN. FT.	LN. FT.	LN. FT.	LN. FT.	LN. FT.	LN. FT.	LN. FT.	LN. FT.	LN. FT.	LN. FT.	LN. FT.	LN. FT.	LN. FT.	LN. FT.	EACH	EACH	EACH	EACH	EACH	EACH	EACH	EACH	EACH	EACH	LN. FT.	CUYD.	LN. FT.			
25 Φ 0.6=44'	PLANTATION DR STA. 2+02		.07			11	5										40	115	120	87					10						610	14				
26 Φ 0.6=25'	RAMP WN STA. 3+00		.06			23											80	80	160	223	17	71			15						1300	24				
27 Φ 0.6=25'	RAMP WN STA. 3+03		.06			21											225	50	35	91	98	53				21					1200	21				
28 Φ 0.6=22'	RAMP WN STA. 4+28		.06		16												34	68	102	238	85	26					32				1330	21				
29 Φ 0.6=25'	RAMP WN STA. 6+21		.06			15											219	63	68	40	55					15					1130	17				
30 Φ 0.6=33'	RAMP NW STA. 14+74		.06			14											160	54	91	46	45					14					4340	15				
31 Φ 0.6=25'	RAMP WN STA. 8+06		.06			14											170	36	84	27	67					14					1030	14				
32 Φ 0.6=36'	RAMP NW STA. 17+00		.06			15											198	50	48	125	48					15					4510	18				
33 Φ 0.6=24'	RAMP WN STA. 9+05		.06			24												80	80	240	200	55			16						1030	24				
34 Φ 0.6=23'	RAMP WN STA. 9+71		.06		17												34	68	102	238	102	25					33					2060	21			
35 Φ 0.6=46'	RAMP WN STA. 10+11		.06		13												78	78	130	26	4	80			26							2170	15			
36 Φ 0.6=31'	RAMP NW STA. 16+00		.06		12												130	104	39	5	65	13			23							4370	13			
37 Φ 0.6=35'	RAMP NW STA. 17+05		.06		16												34	68	102	238	85	22					32					4520	21			
38 Φ 0.6=24'	RAMP WN STA. 11+04		.06			14				40							112	30	64	163	28						14					2400	15			
39 Φ 0.6=40'	RAMP NW STA. 19+50		.06			15				48							163	26	41	111	51						15					4940	15			
40 Φ 0.6=20'	MAUKA PK. RD STA. 5+64		.07			18	3				40						120	120	140	100	80	337					15					3330	34			
22	VALVE FROM F.A.I. PROJ. NO. I-III(112)15						8											28	33	117					3											
23	VALVE FROM F.A.I. PROJ. NO. I-III(110)15						11											29	31	126	57				7											
30	VALVE FROM F.A.I. PROJ. NO. I-III(110)15						8											32	36	114					3											
31	VALVE FROM F.A.I. PROJ. NO. I-III(112)15						11	3										96	59	147					9											
CONTROLLER "H"		1.8		225																										1						
CONTROLLER "J"		1.8		55																										1						
TOTALS		3.6	2.5	280	162	462	70	3		88	67	120	64		3687	3043	4394	4976	3221	1644	452	235	343		83	12	26	184	215	250	2		13	26	26740	771

ORIGINAL PLAN	SURVEY PLOTTED BY _____	DATE _____
	DRAWN BY _____	" _____
	TRACED BY _____	" _____
NOTE BOOK	DESIGNED BY _____	" _____
	QUANTITIES BY _____	" _____
No. _____	CHECKED BY _____	" _____

C.C.O. #22 (10-6-75)	
DATE	REVISION
9/18/75	CHANGE IN DIRECT BURIAL CABLE BURIAL FOOTAGE



THIS WORK WAS PREPARED BY ME
OR UNDER MY SUPERVISION

STATE OF HAWAII
DEPARTMENT OF TRANSPORTATION
HIGHWAYS DIVISION

SPRINKLER SUMMARY

PACKAGE NO. 2


PEARL HARBOR INTERCHANGE
F.A.I. PROJ. NO. I-HI-1(111):14

SCALE: NONE DATE: DEC. 14, 1973

SHEET No. L-13 OF 13 SHEETS

UOR


FED. ROAD DIST. NO.	STATE	FED. AID PROJ. NO.	FISCAL YEAR	SHEET NO.	TOTAL SHEETS
HAWAII	HAW.	I-H-1(11):14	1974	III	234

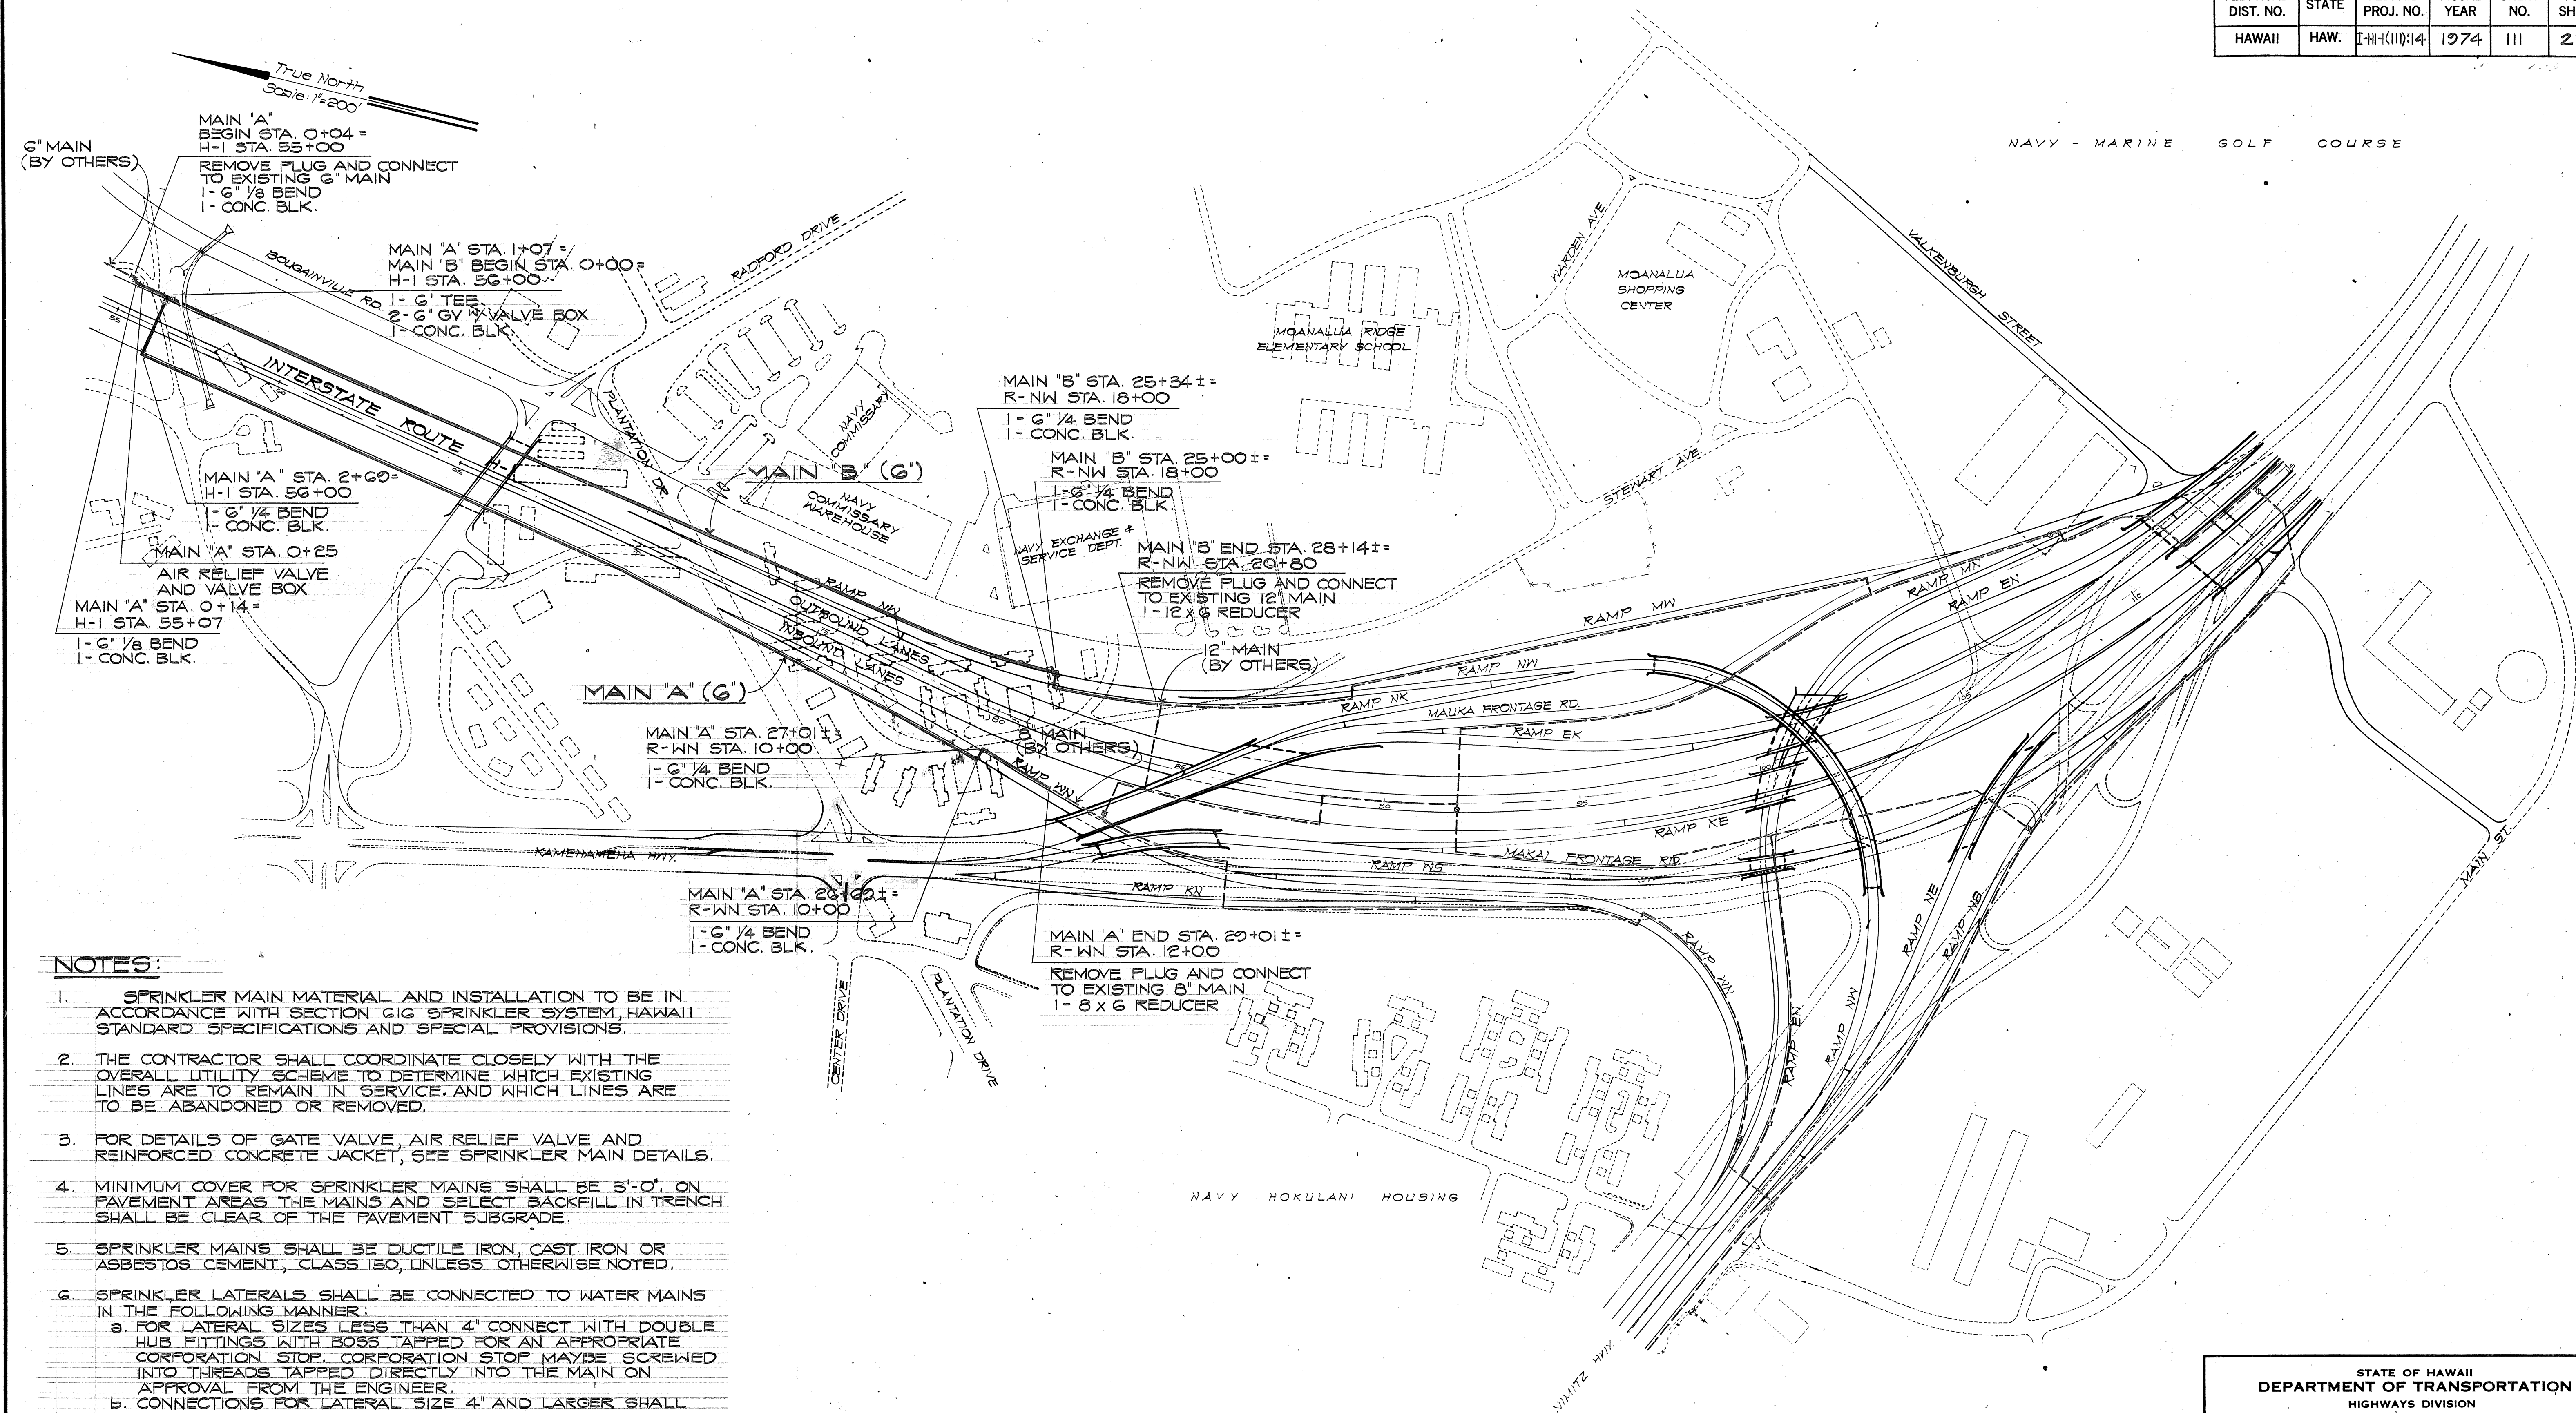

NOTES:

- SPRINKLER MAIN MATERIAL AND INSTALLATION TO BE IN ACCORDANCE WITH SECTION GIG SPRINKLER SYSTEM, HAWAII STANDARD SPECIFICATIONS AND SPECIAL PROVISIONS.
- THE CONTRACTOR SHALL COORDINATE CLOSELY WITH THE OVERALL UTILITY SCHEME TO DETERMINE WHICH EXISTING LINES ARE TO REMAIN IN SERVICE, AND WHICH LINES ARE TO BE ABANDONED OR REMOVED.
- FOR DETAILS OF GATE VALVE, AIR RELIEF VALVE AND REINFORCED CONCRETE JACKET, SEE SPRINKLER MAIN DETAILS.
- MINIMUM COVER FOR SPRINKLER MAINS SHALL BE 3'-0". ON PAVEMENT AREAS THE MAINS AND SELECT BACKFILL IN TRENCH SHALL BE CLEAR OF THE PAVEMENT SUBGRADE.
- SPRINKLER MAINS SHALL BE DUCTILE IRON, CAST IRON OR ASBESTOS CEMENT, CLASS 150, UNLESS OTHERWISE NOTED.
- SPRINKLER LATERALS SHALL BE CONNECTED TO WATER MAINS IN THE FOLLOWING MANNER:
 - FOR LATERAL SIZES LESS THAN 4" CONNECT WITH DOUBLE HUB FITTINGS WITH BOSS TAPPED FOR AN APPROPRIATE CORPORATION STOP. CORPORATION STOP MAY BE SCREWED INTO THREADS TAPPED DIRECTLY INTO THE MAIN ON APPROVAL FROM THE ENGINEER.
 - CONNECTIONS FOR LATERAL SIZE 4" AND LARGER SHALL BE TEE CONNECTIONS WITH REDUCERS.

PLAN
SCALE: 1" = 200'

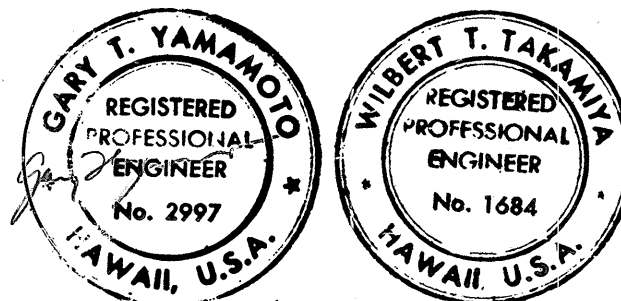

THIS WORK WAS PREPARED BY ME
OR UNDER MY SUPERVISION


STATE OF HAWAII
DEPARTMENT OF TRANSPORTATION
HIGHWAYS DIVISION

SPRINKLER MAIN
GENERAL PLAN

PEARL HARBOR INTERCHANGE
F.A.I. PROJ. NO. I-H-1(11):14


SCALE: AS SHOWN DATE: DEC. 14, 1973
SHEET NO. III OF 4 SHEETS

FED. ROAD DIST. NO.	STATE	FED. AID PROJ. NO.	FISCAL YEAR	SHEET NO.	TOTAL SHEETS
HAWAII	HAW.	I-H-I(III):14	1974	112	234

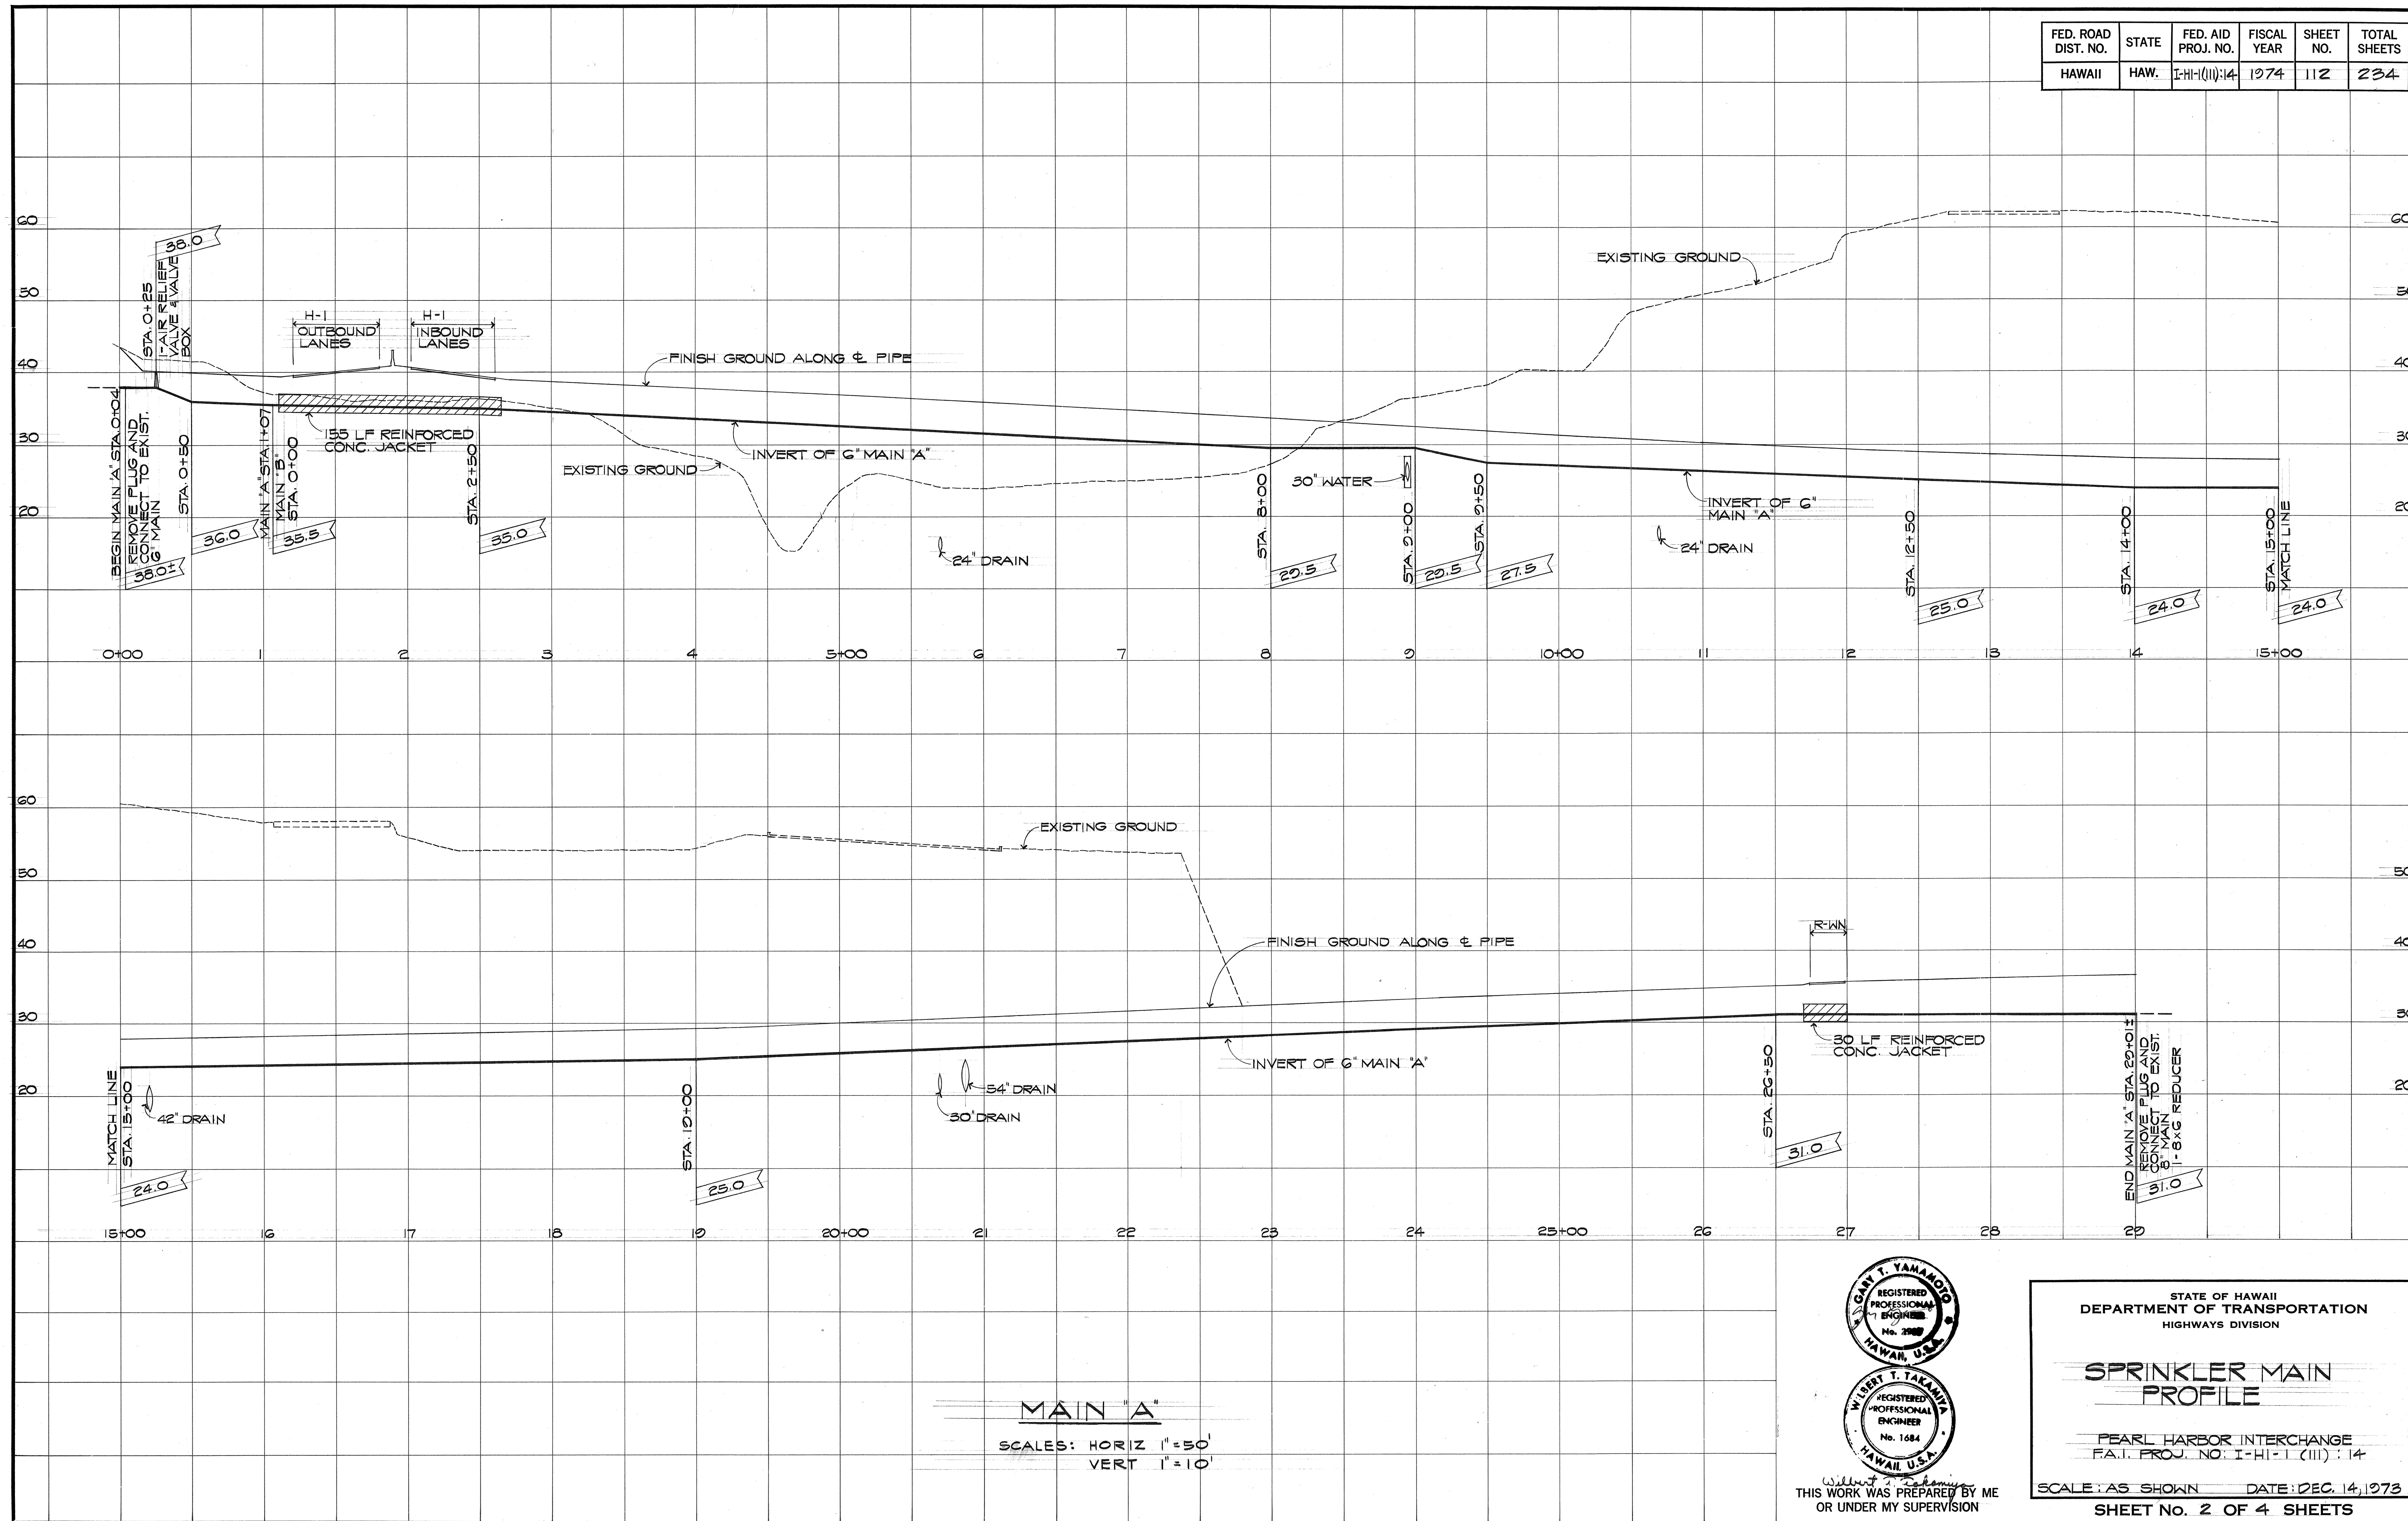

ORIGINAL	DATE
PLAN	
DESIGNED BY	
NOTED BY	
CHECKED BY	

MAIN "A"
 SCALES: HORIZ 1"=50'
 VERT 1"=10'

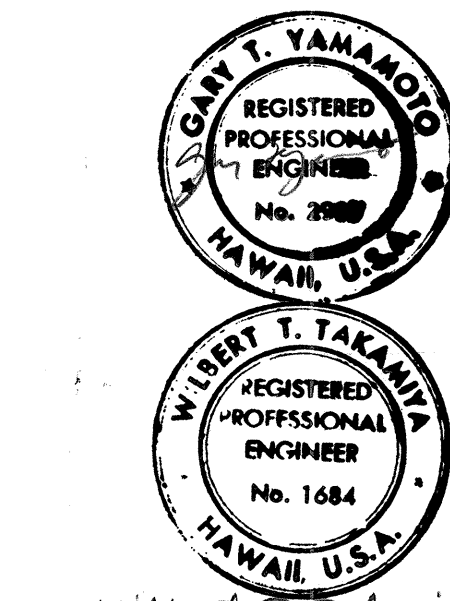

THIS WORK WAS PREPARED BY ME
 OR UNDER MY SUPERVISION

STATE OF HAWAII
 DEPARTMENT OF TRANSPORTATION
 HIGHWAYS DIVISION


**SPRINKLER MAIN
PROFILE**

PEARL HARBOR INTERCHANGE
 F.A.I. PROJ. NO. I-H-I (III): 14

SCALE: AS SHOWN DATE: DEC. 14, 1973
 SHEET NO. 2 OF 4 SHEETS


SCALES: HORIZ 1"=50'
 VERT 1"=10'

FED. ROAD DIST. NO.	STATE	FED. AID PROJ. NO.	FISCAL YEAR	SHEET NO.	TOTAL SHEETS
HAWAII	HAW.	I-HI-10114	1974	113	234

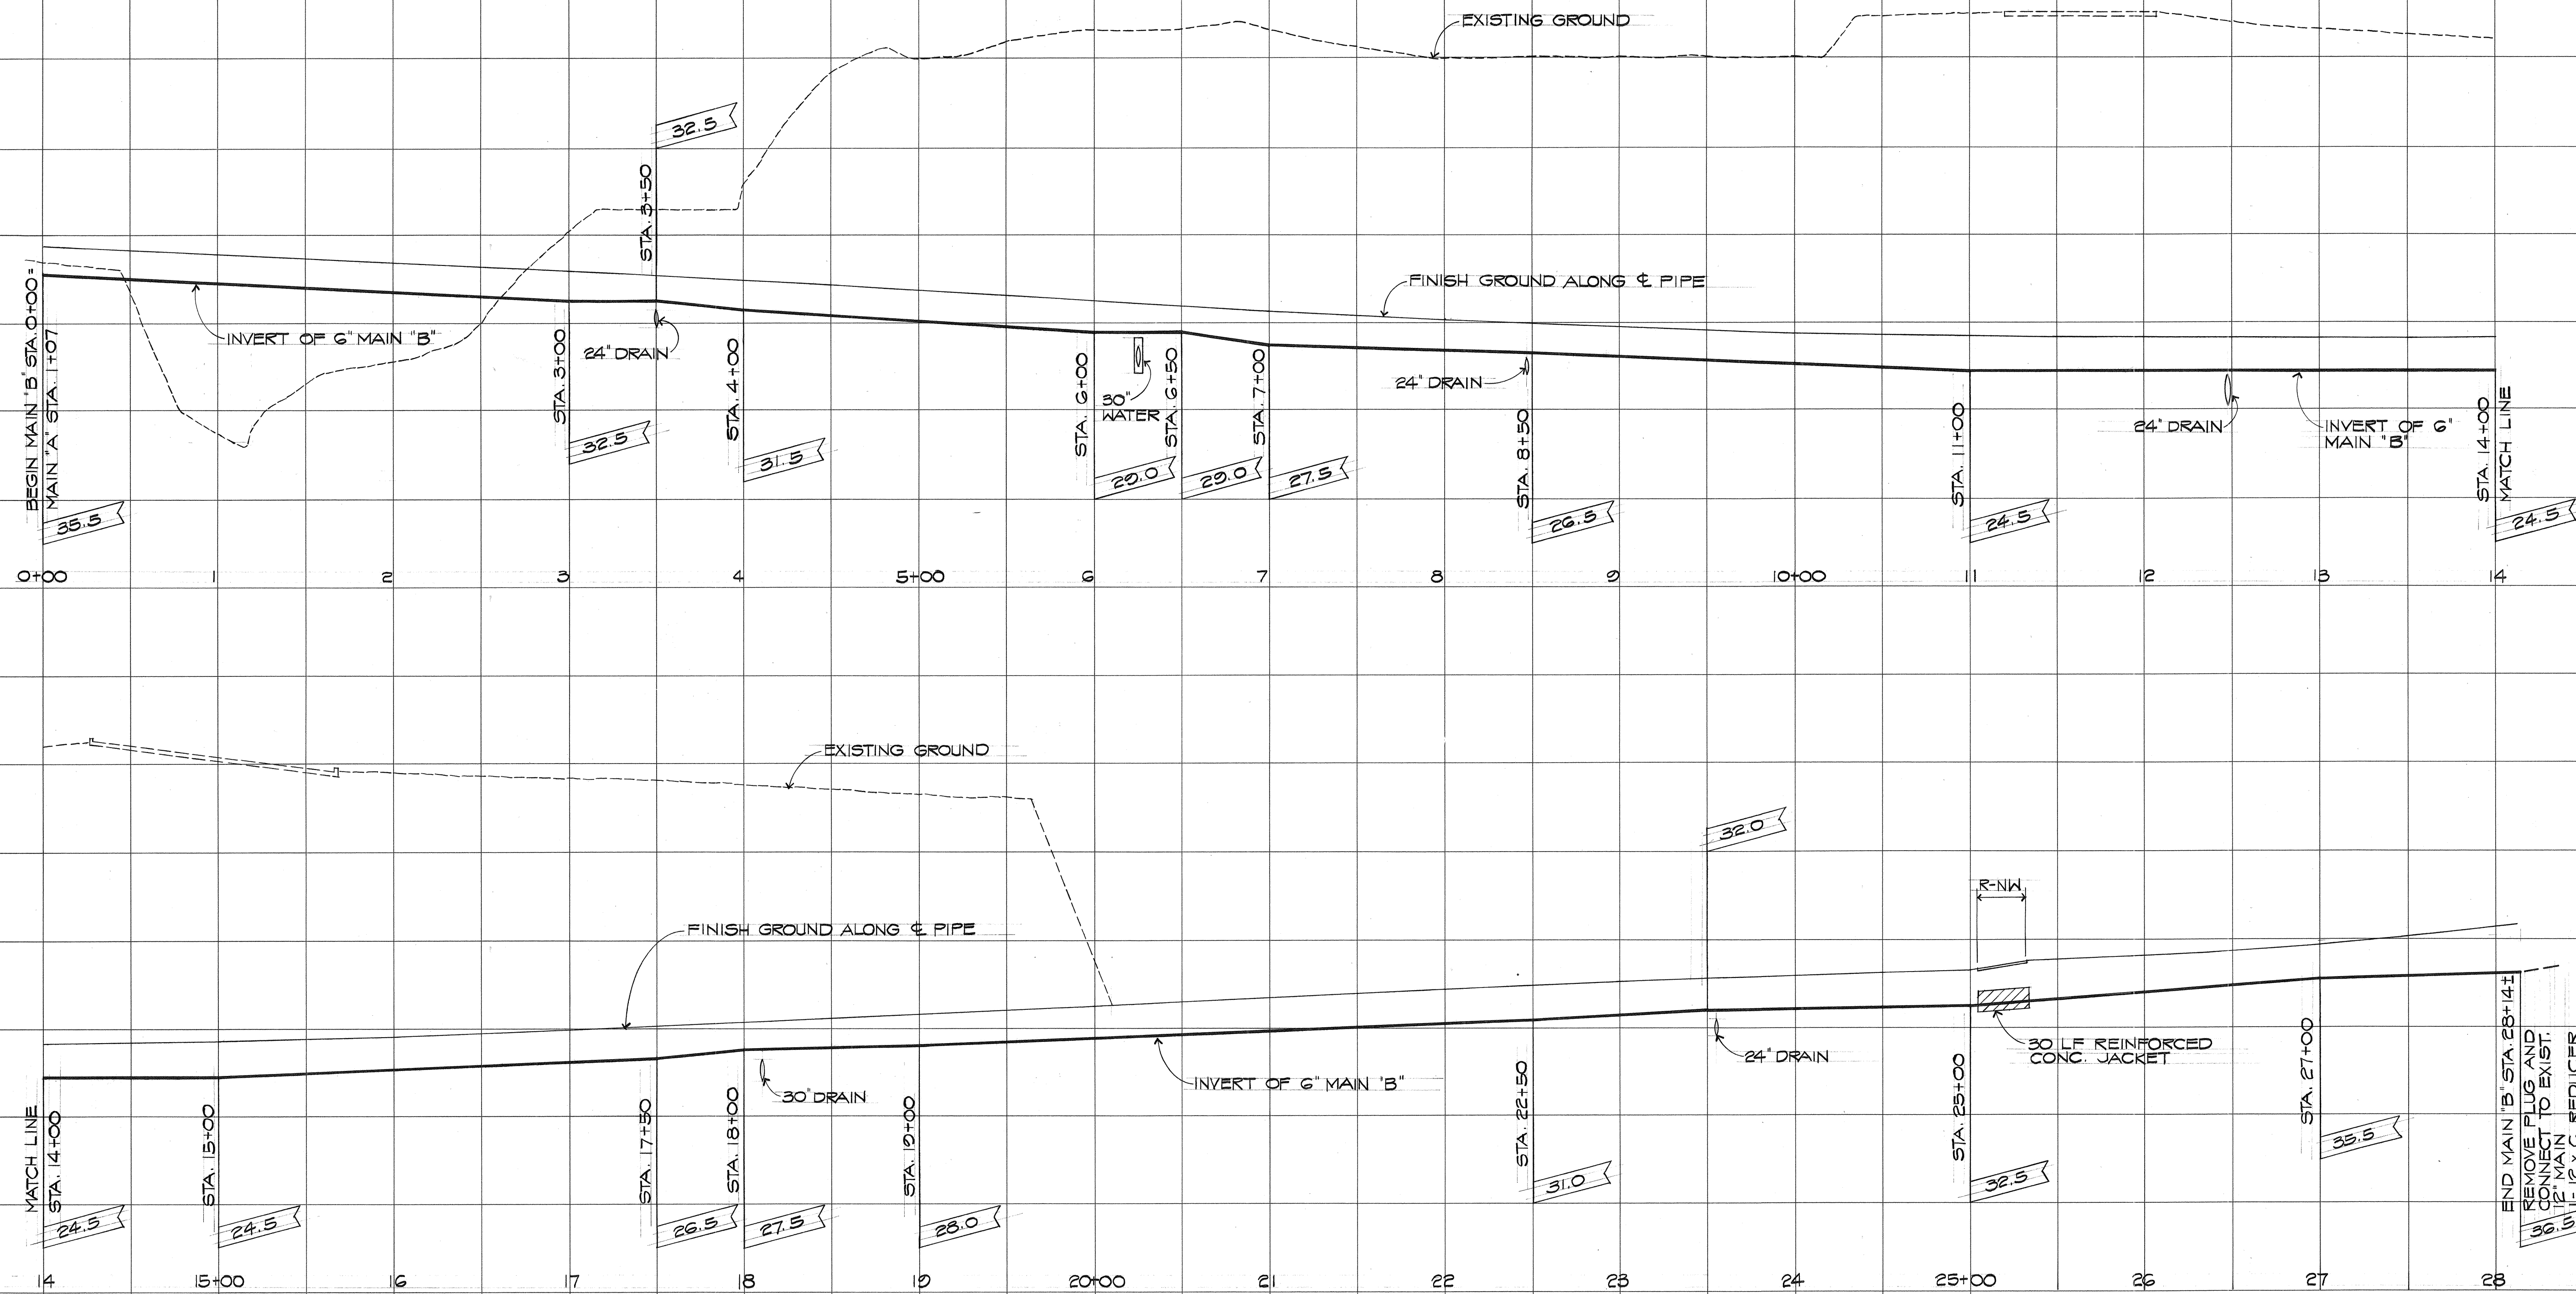

ORIGINAL PLAN	SURVEY PLOTTED BY	DATE
DESIGNED BY	DRAWN BY	
CHECKED BY	TRACED BY	
	DESIGNED BY	
	CHECKED BY	

MAIN "B"
 SCALES: HORIZ. 1" = 50'
 VERT. 1" = 10'

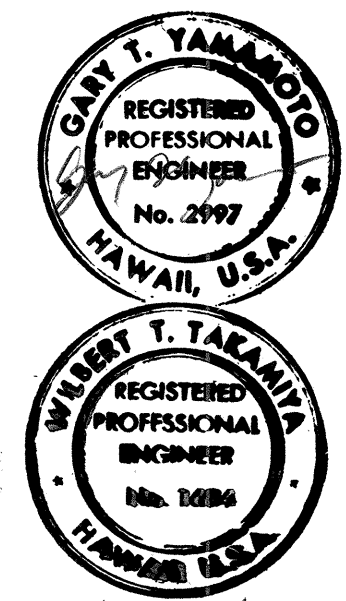

THIS WORK WAS PREPARED BY ME
 OR UNDER MY SUPERVISION


STATE OF HAWAII
 DEPARTMENT OF TRANSPORTATION
 HIGHWAYS DIVISION

**SPRINKLER MAIN
 PROFILE**

PEARL HARBOR INTERCHANGE
 F.A.I. PROJ. NO. I-HI-1 (111) : 14


SCALE: AS SHOWN DATE: DEC. 14, 1973
 SHEET NO. 3 OF 4 SHEETS

FED. ROAD DIST. NO.	STATE	FED. AID PROJ. NO.	FISCAL YEAR	SHEET NO.	TOTAL SHEETS
HAWAII	HAW.	I-HI-(III):14	1974	114	234

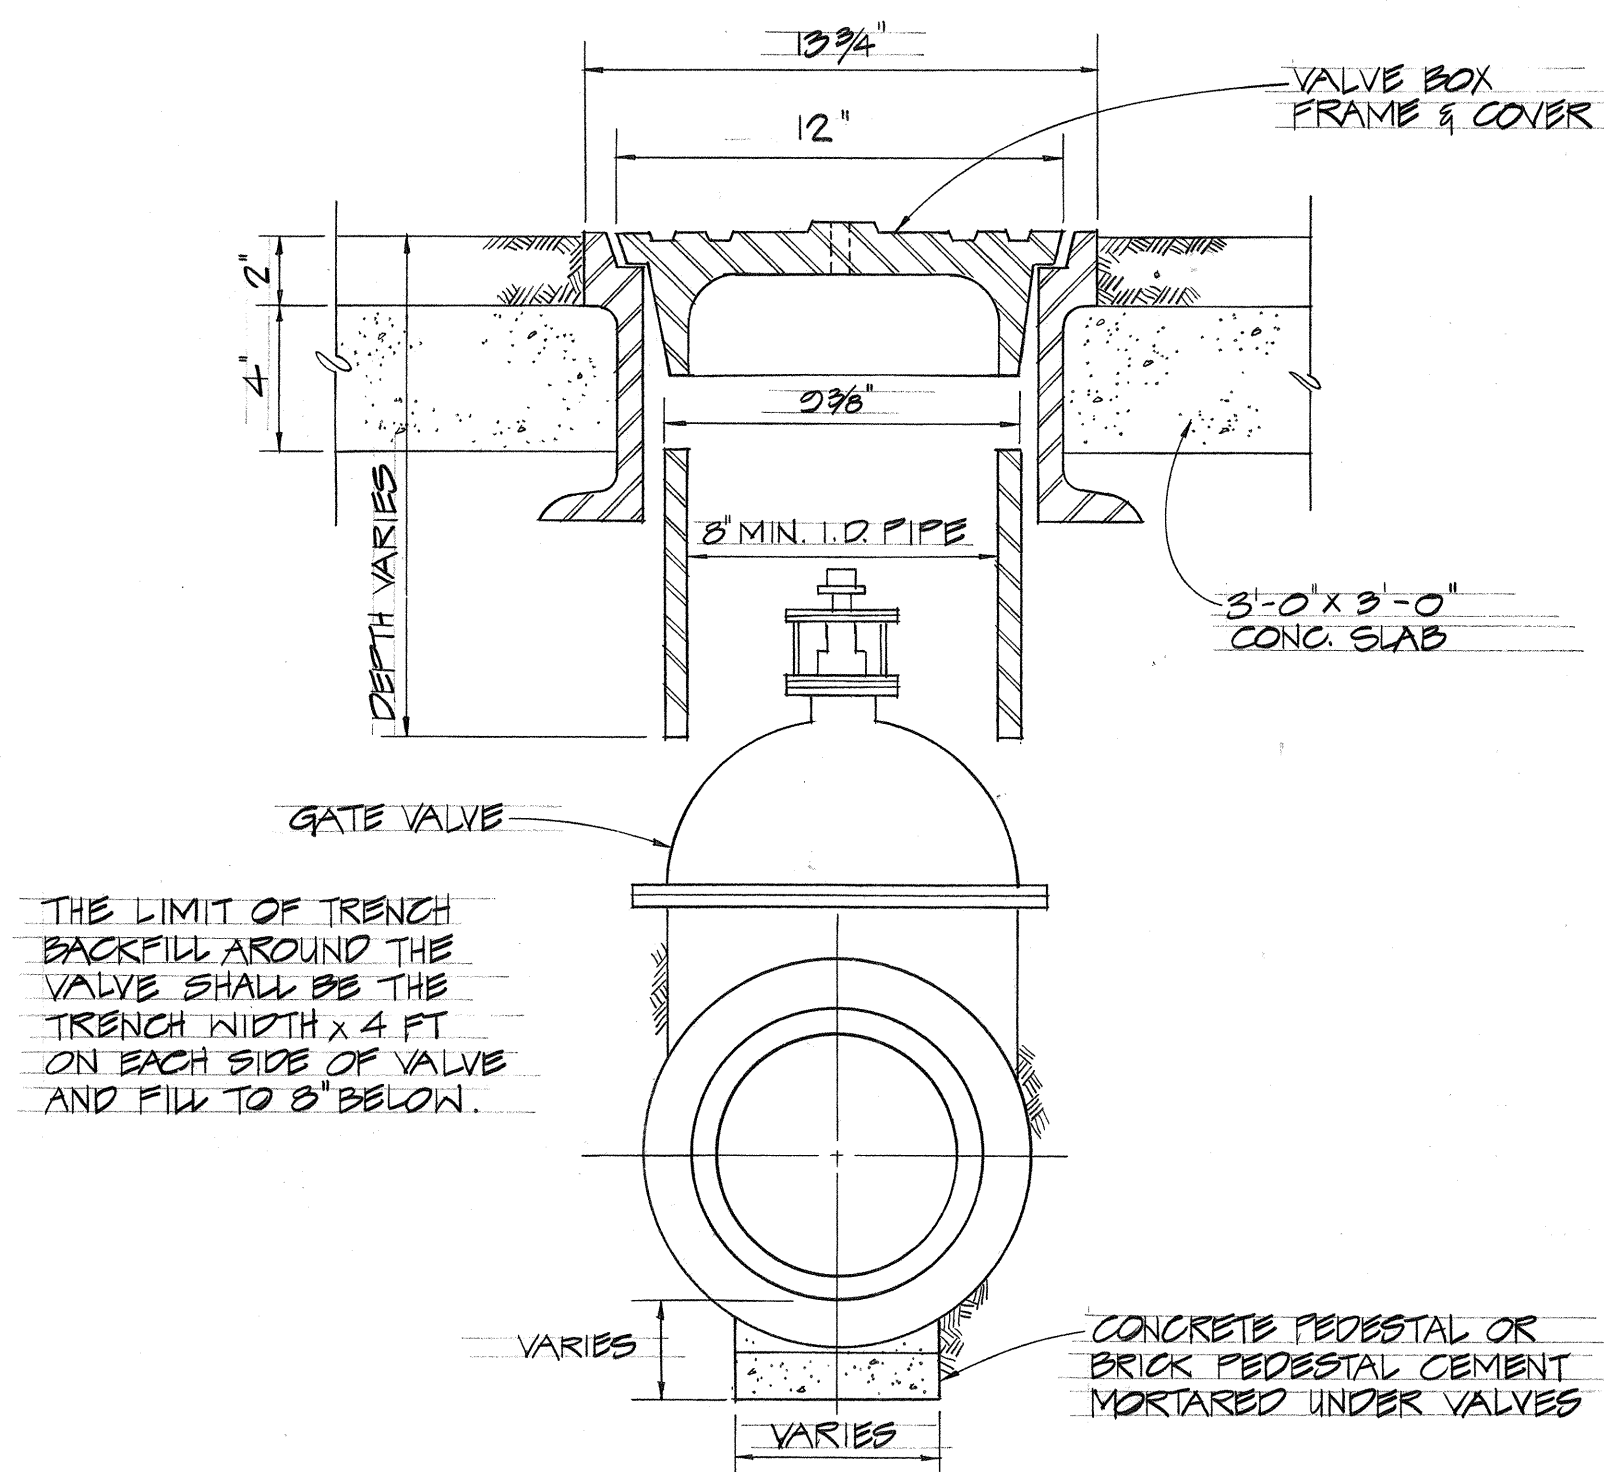



GATE VALVE AND VALVE BOX
NOT TO SCALE

NOTE:
ALL CASTINGS SHALL BE MADE ACCURATELY TO THE DIMENSIONS SHOWN. SEAT AND COVER SHALL BE MACHINED NOT GROUND TO SECURE FLAT AND TRUE SURFACES. THE COVER SHALL NOT RATTLE IN ANY POSITION.

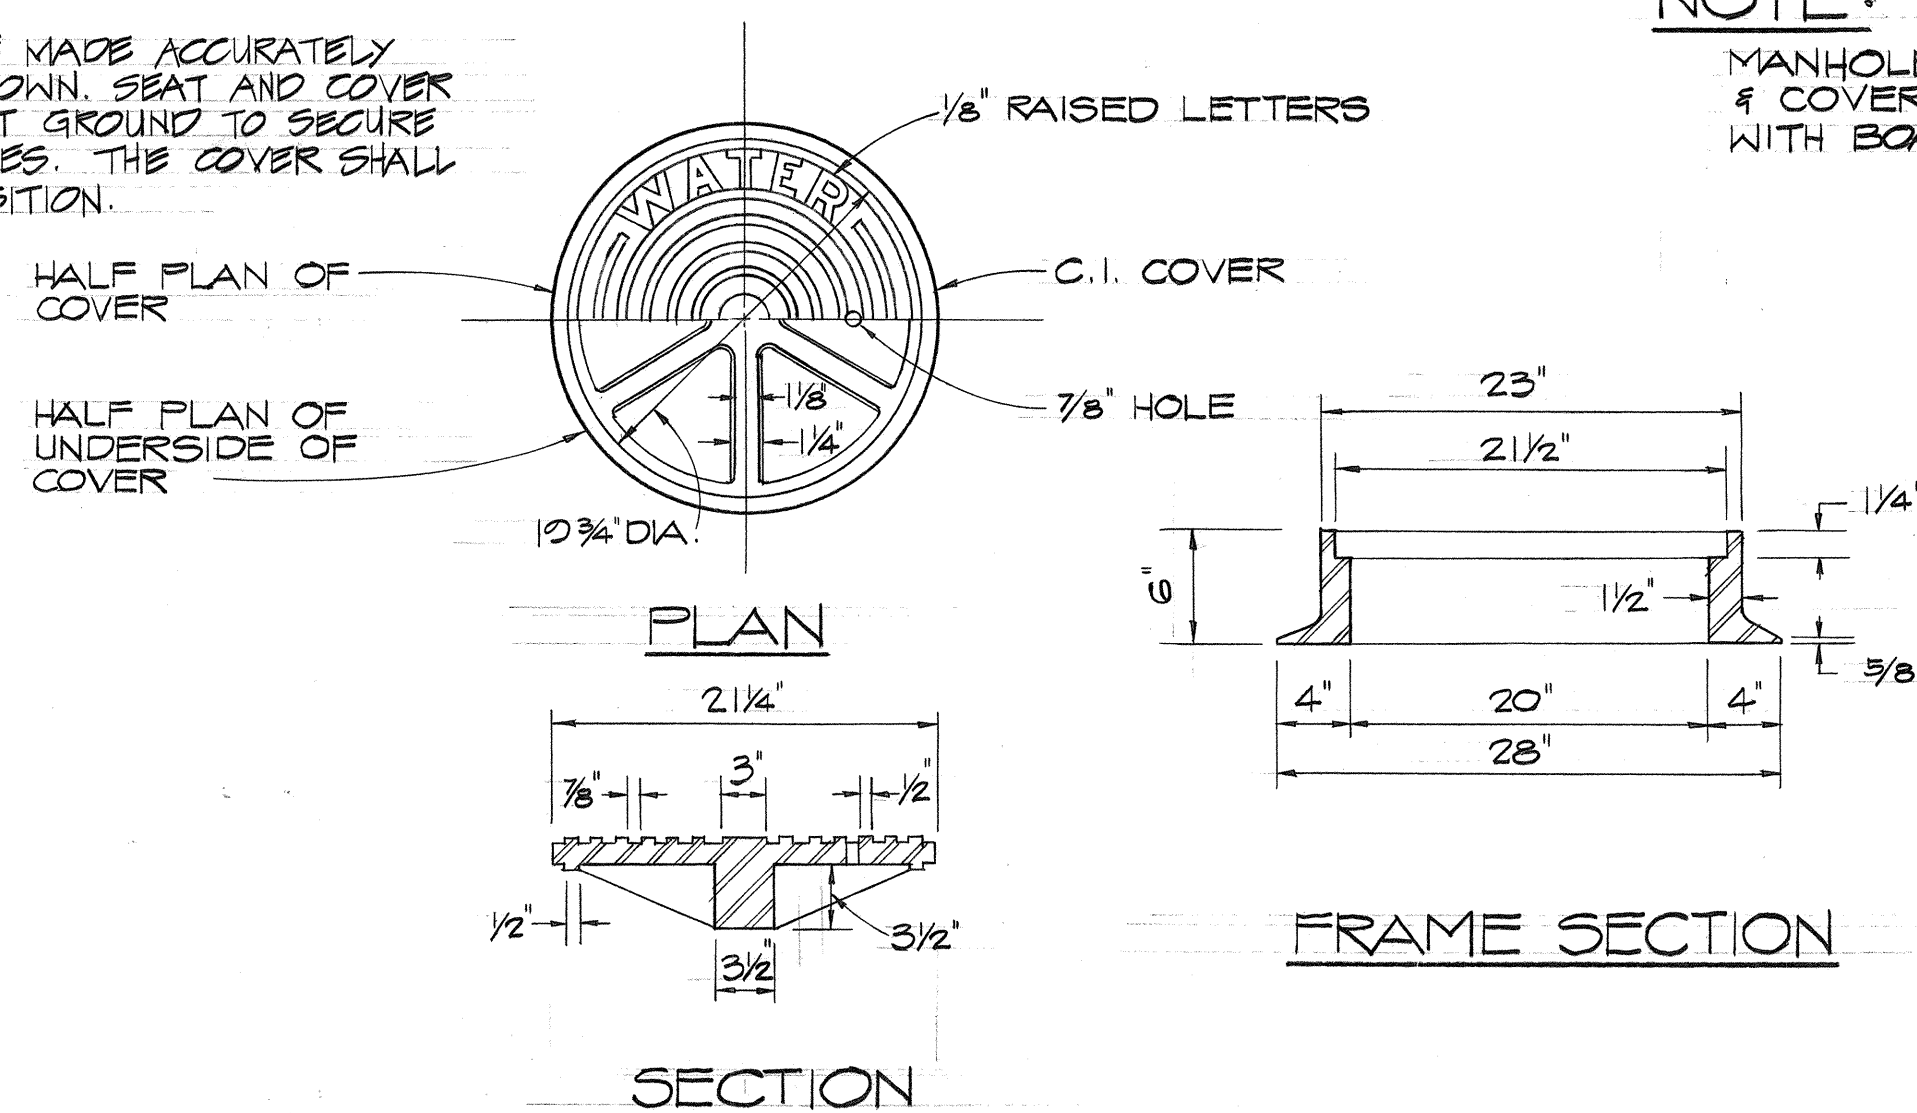


TYPICAL MANHOLE FRAME & COVER
NOT TO SCALE


NOTE:
BEARING AREA
4 SQ. FT. MINIMUM

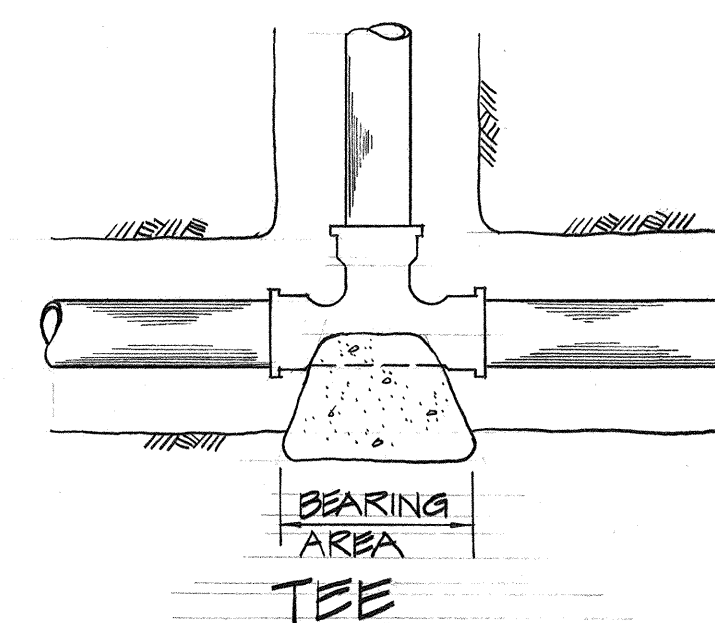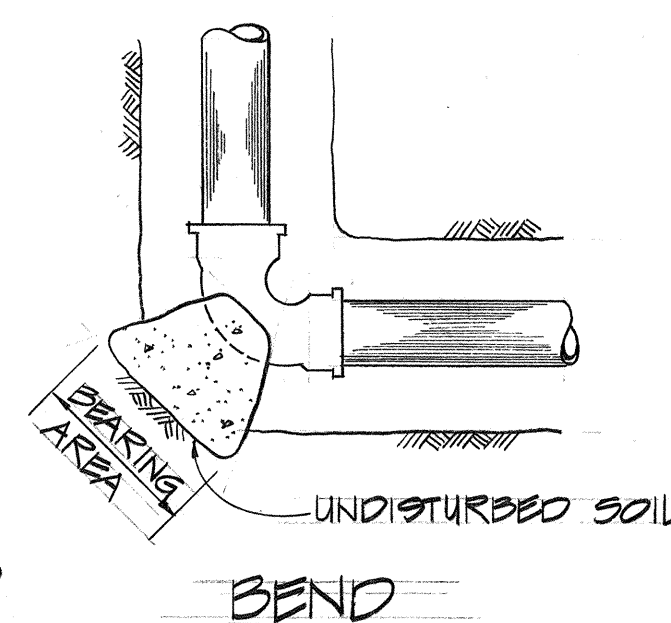

CONCRETE BLOCK DETAILS
(FOR HORIZONTAL BENDS)
NOT TO SCALE

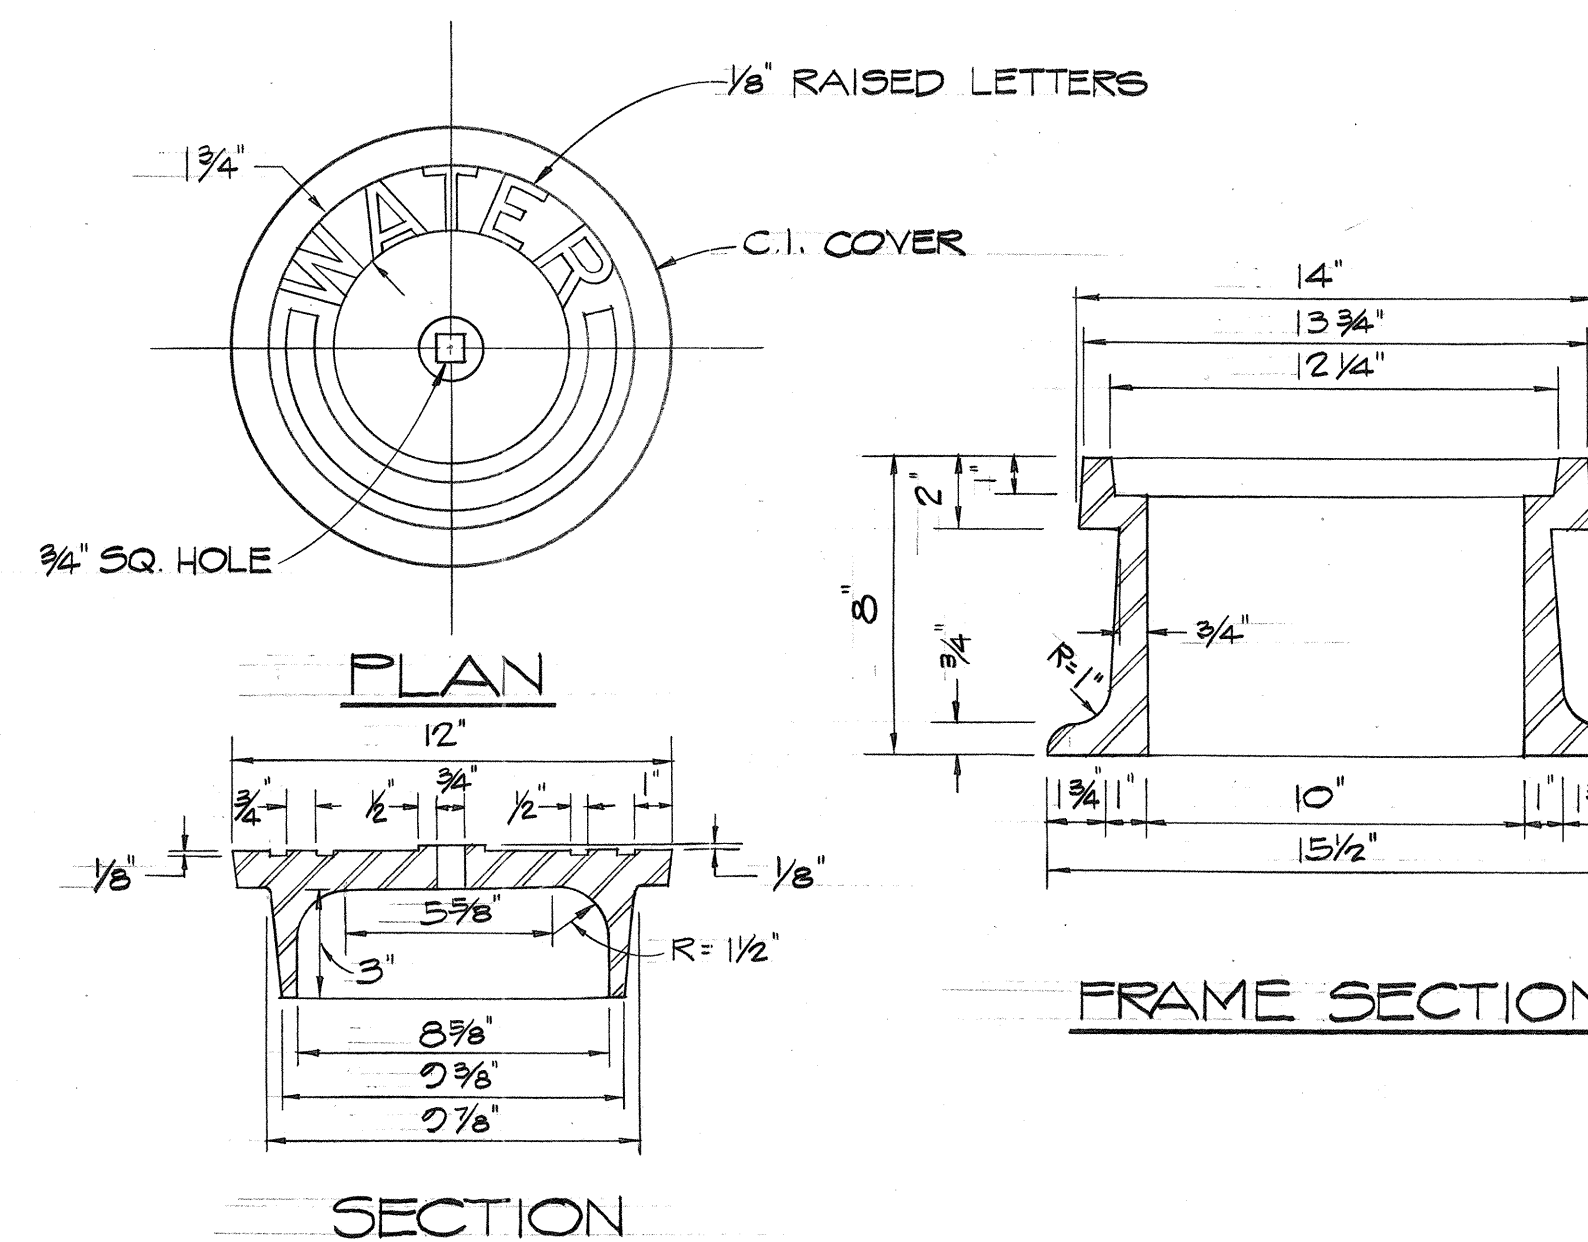


TYPICAL VALVE BOX FRAME & COVER
NOT TO SCALE

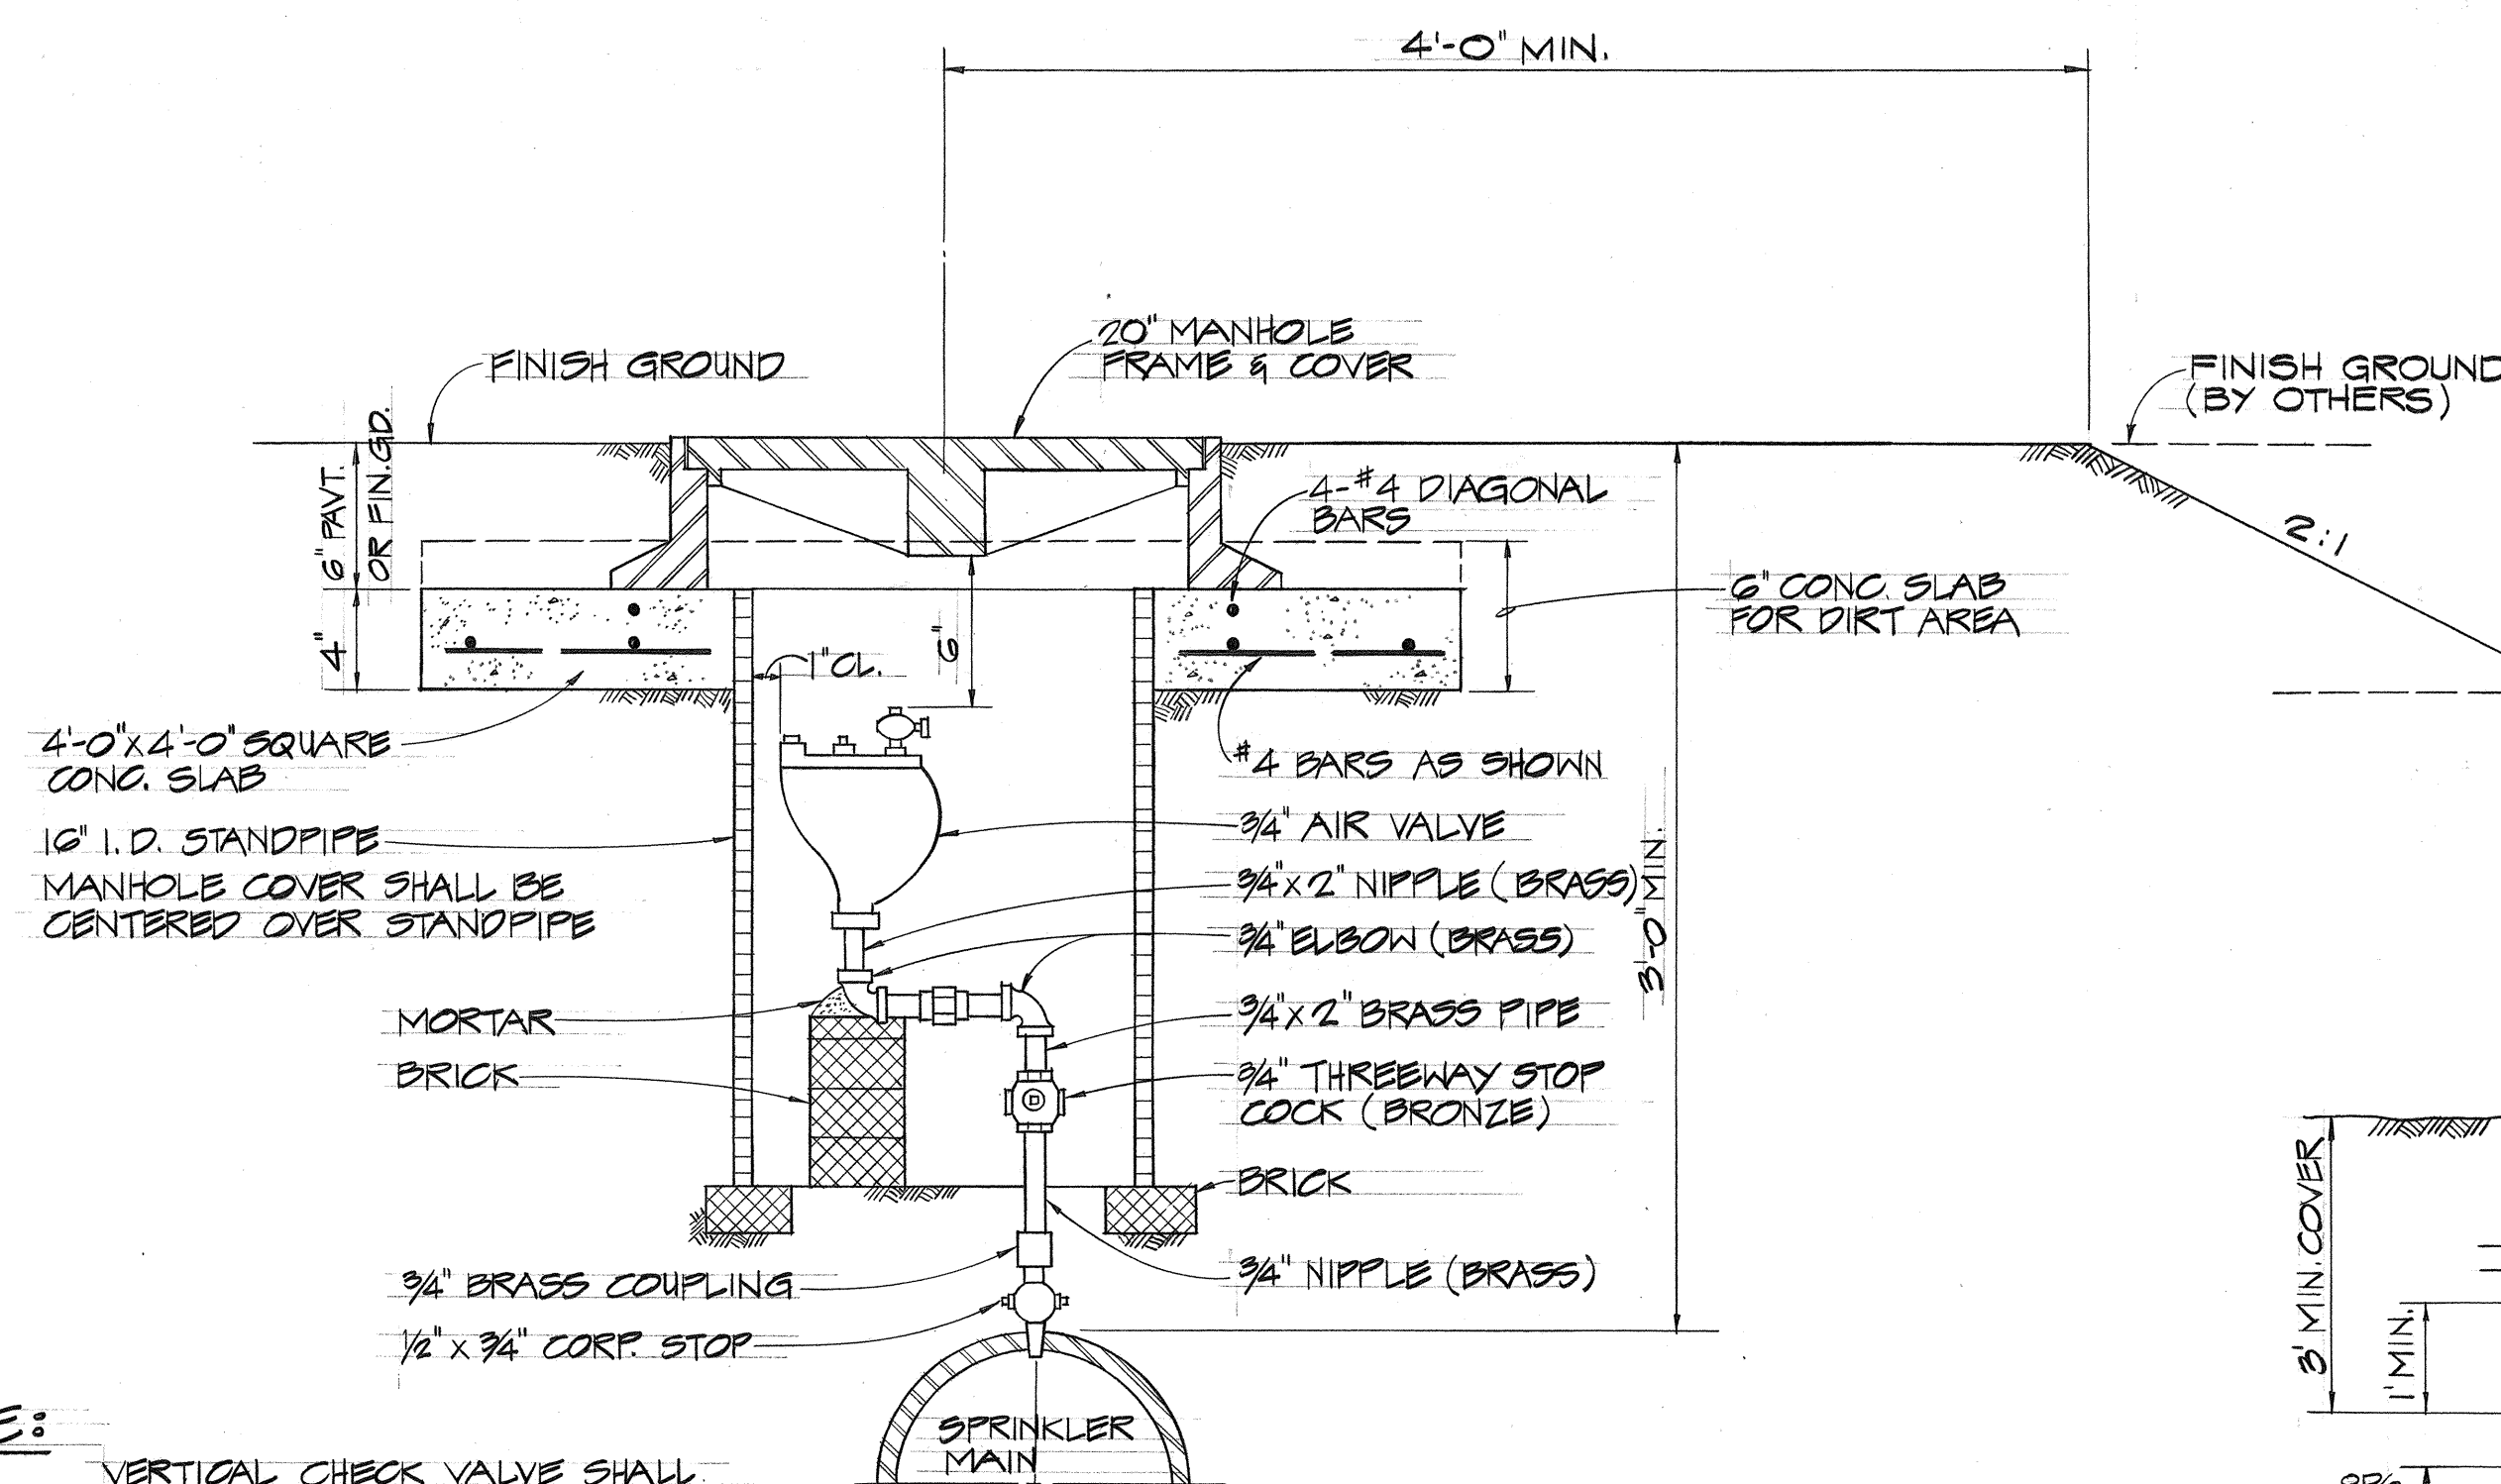


AIR RELIEF VALVE AND VALVE BOX
NOT TO SCALE



NOTE:
VERTICAL CHECK VALVE SHALL BE USED IN LIEU OF COUPLING WHEN THREWAY STOP COCK IS IMMERSED IN WATER.

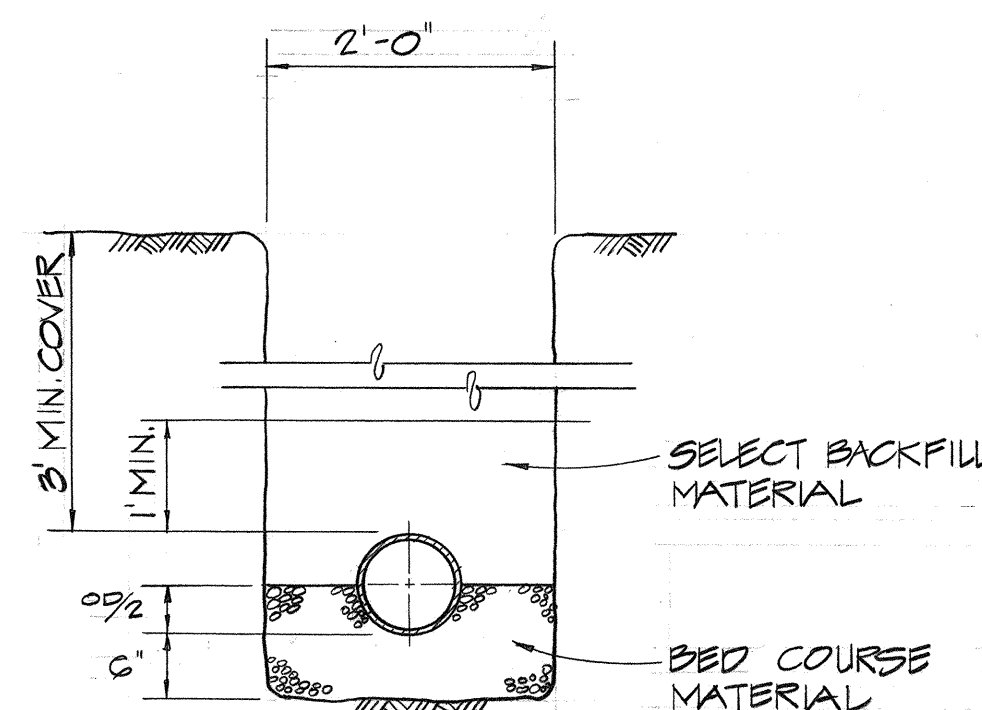

TRENCH DETAIL
NOT TO SCALE

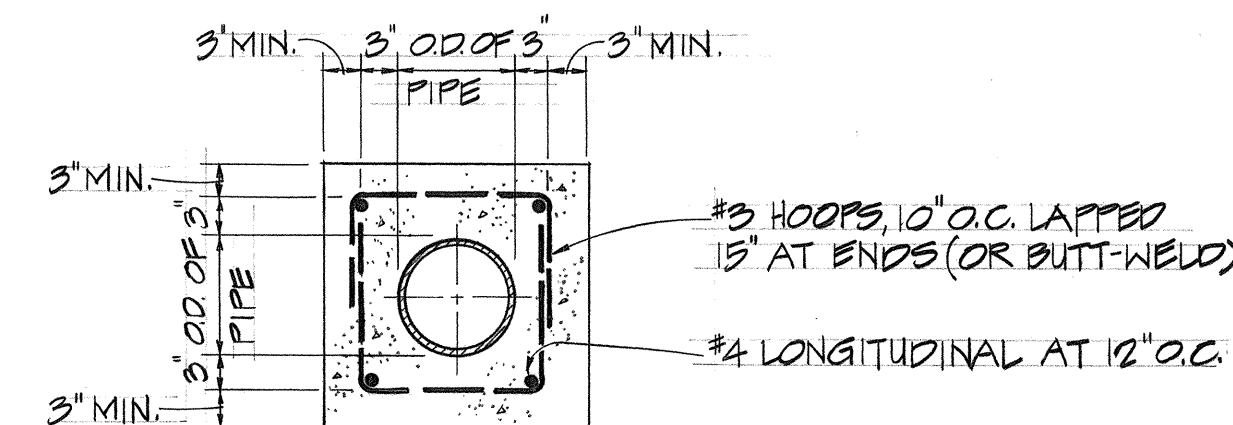

REINFORCED CONCRETE JACKET
NOT TO SCALE

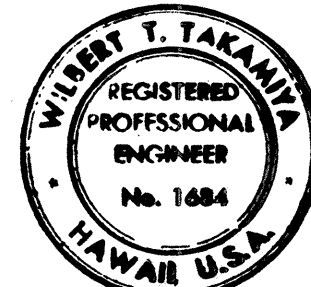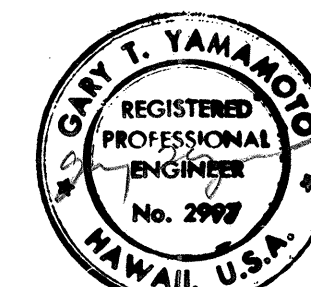

Willbert T. Takahira
THIS WORK WAS PREPARED BY ME
OR UNDER MY SUPERVISION

STATE OF HAWAII
DEPARTMENT OF TRANSPORTATION
HIGHWAYS DIVISION

SPRINKLER MAIN DETAILS

PEARL HARBOR INTERCHANGE
F.A.I. Proj. No. I-HI-I(III):14

Scale: As Shown Date: DEC. 14, 1973
SHEET NO. 4 OF 4 SHEETS

ORIGINAL PLAN	DATE
DRAWN BY	DESIGNED BY
NOTE BOOK	QUANTITIES BY
NO.	CHECKED BY