




FED. ROAD DIST. NO.	STATE	PROJECT NO.	FISCAL YEAR	SHEET NO.	TOTAL SHEETS
HAWAII	HAW.	99D/G-02-08	2008	86	89

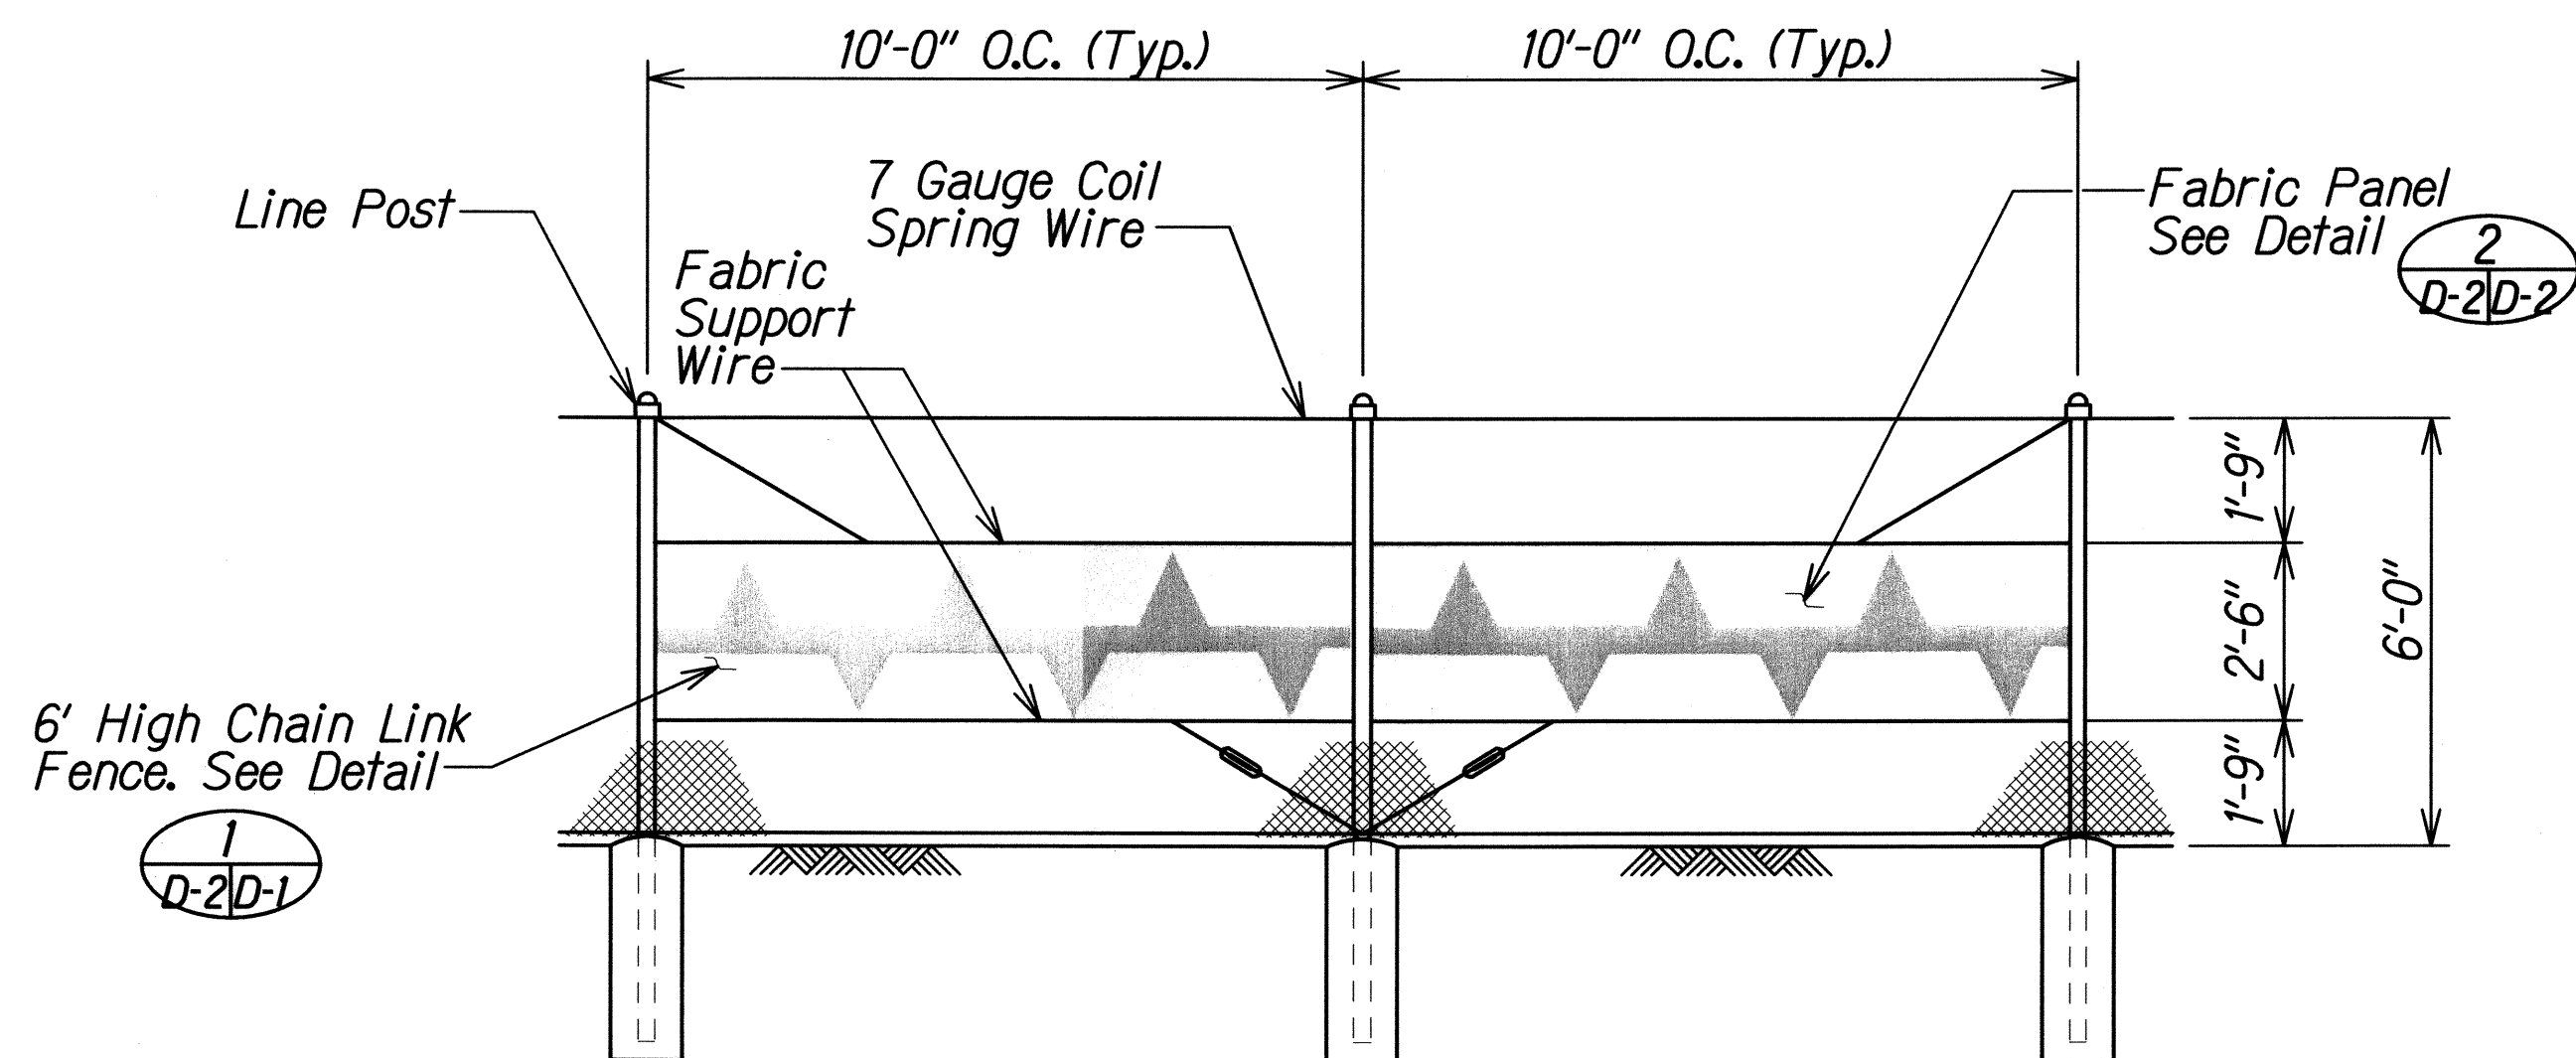


FABRIC PANEL DETAILS (1 D-2D-2)
Scale: $\frac{3}{8}"=1'-0"$

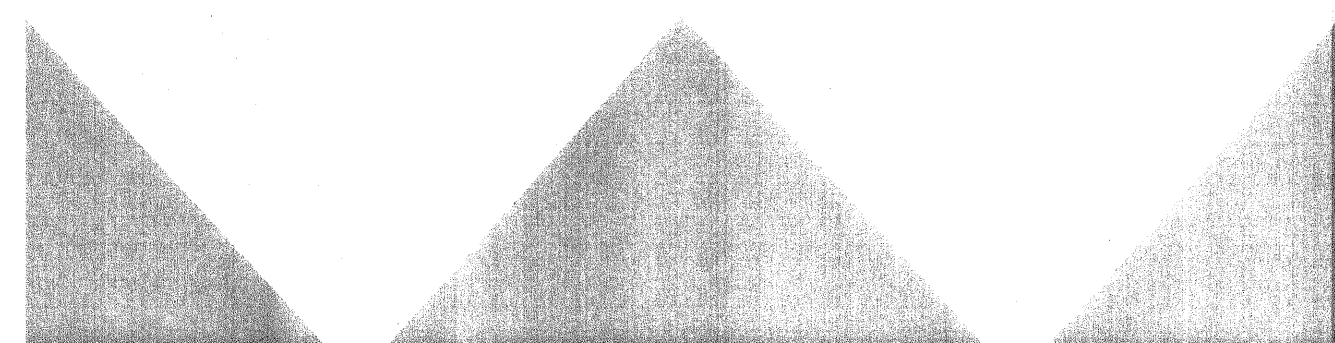


Single Mountain Design : from Sam's Club to H-1 Overpass

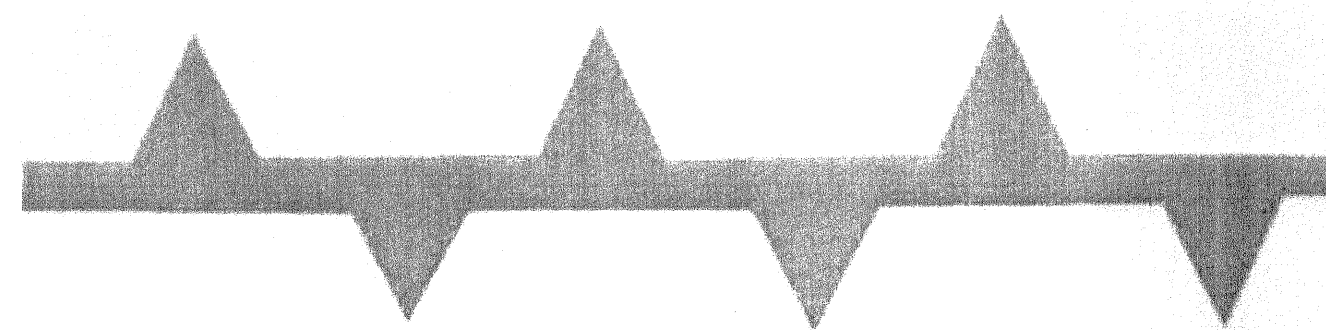

Niho Mano Design : H-1 Overpass to Hekaha Street

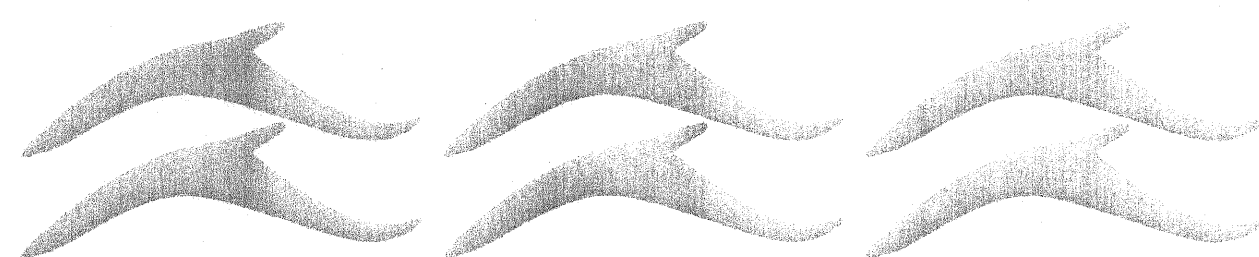

Nai'a Design : from Hekaha Street to Honomanu Street

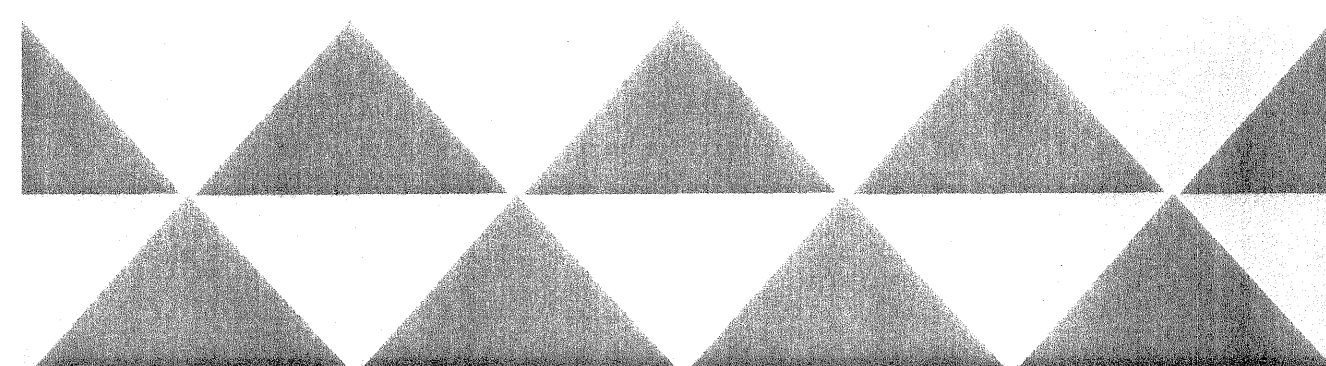

Double Mountain Design : from Honomanu Street to Salt Lake Boulevard

FABRIC PANELS (2 D-2D-2)
Not to Scale

Part 1: General

1.1 System Description

- A. Provide all labor, materials, appliances, tools, equipment, facilities, transportation, and services necessary for an incidental to performing all operations in connection with furnishing, delivery, and installation of the Work of this Section, complete, as specified herein. The Work includes, but is not limited to, the following:

1. Install, complete in place, privacy fence fabric.

1.2 Submittals

- A. Submit fence fabric samples for color selection, patterns, and weave density.

Part 2: Productions

2.1 Materials

- A. Fabric: 2'-6" x 9'-8" panel

- Material: Shall be UV resistant woven vinyl mesh with heat welded edges.
- Grommets: Shall be zinc coated spaced 12" on center.
- Weight: 10 o.z. per square yard.
- Printable on both sides with UV-stabilized ink.

- B. Fasteners: All fasteners shall be UV-stabilized zip ties.

- C. Printed pattern: Shall be mirrored on both sides.

Part 3: Execution

- 3.1 Privacy fence fabric shall be installed taut to prevent sagging along the entire panel. Install one panel 1'-9" from top edge of chainlink fence and install mirror imaged panel on the opposite side of the chainlink fence.

- 3.2 Center panels between line posts at 10' on centers. Fasten with UV-stabilized zip ties. See Drawings.



THIS WORK WAS PREPARED BY ME OR UNDER MY SUPERVISION. Signature: [Signature] 4/30/2010 EXPIRATION DATE OF THE LICENSE	STATE OF HAWAII DEPARTMENT OF TRANSPORTATION HIGHWAYS DIVISION
	FENCE DETAILS - 2 KAMEHAMEHA HIGHWAY MEDIAN FENCING IMPROVEMENTS VICINITY OF ACACIA ROAD TO SALT LAKE BOULEVARD PROJECT NO. 99D/G-02-08 Scale: None Date: April 2008

SHEET No. D-2 OF 2 SHEETS



SURVEY PLOTTED BY	DATE
DRAWN BY	
TRACED BY	
QUANTITIES BY	
CHECKED BY	
ORIGINAL PLAN	
NOTE BOOK	
No.	

J:\Kam Hwy Sams Club\Microstation\Plans\Detail.dgn



FED. ROAD DIST. NO.	STATE	PROJECT NO.	FISCAL YEAR	SHEET NO.	TOTAL SHEETS
HAWAII	HAW.	99D/G-02-08	2008	86 S-1	89

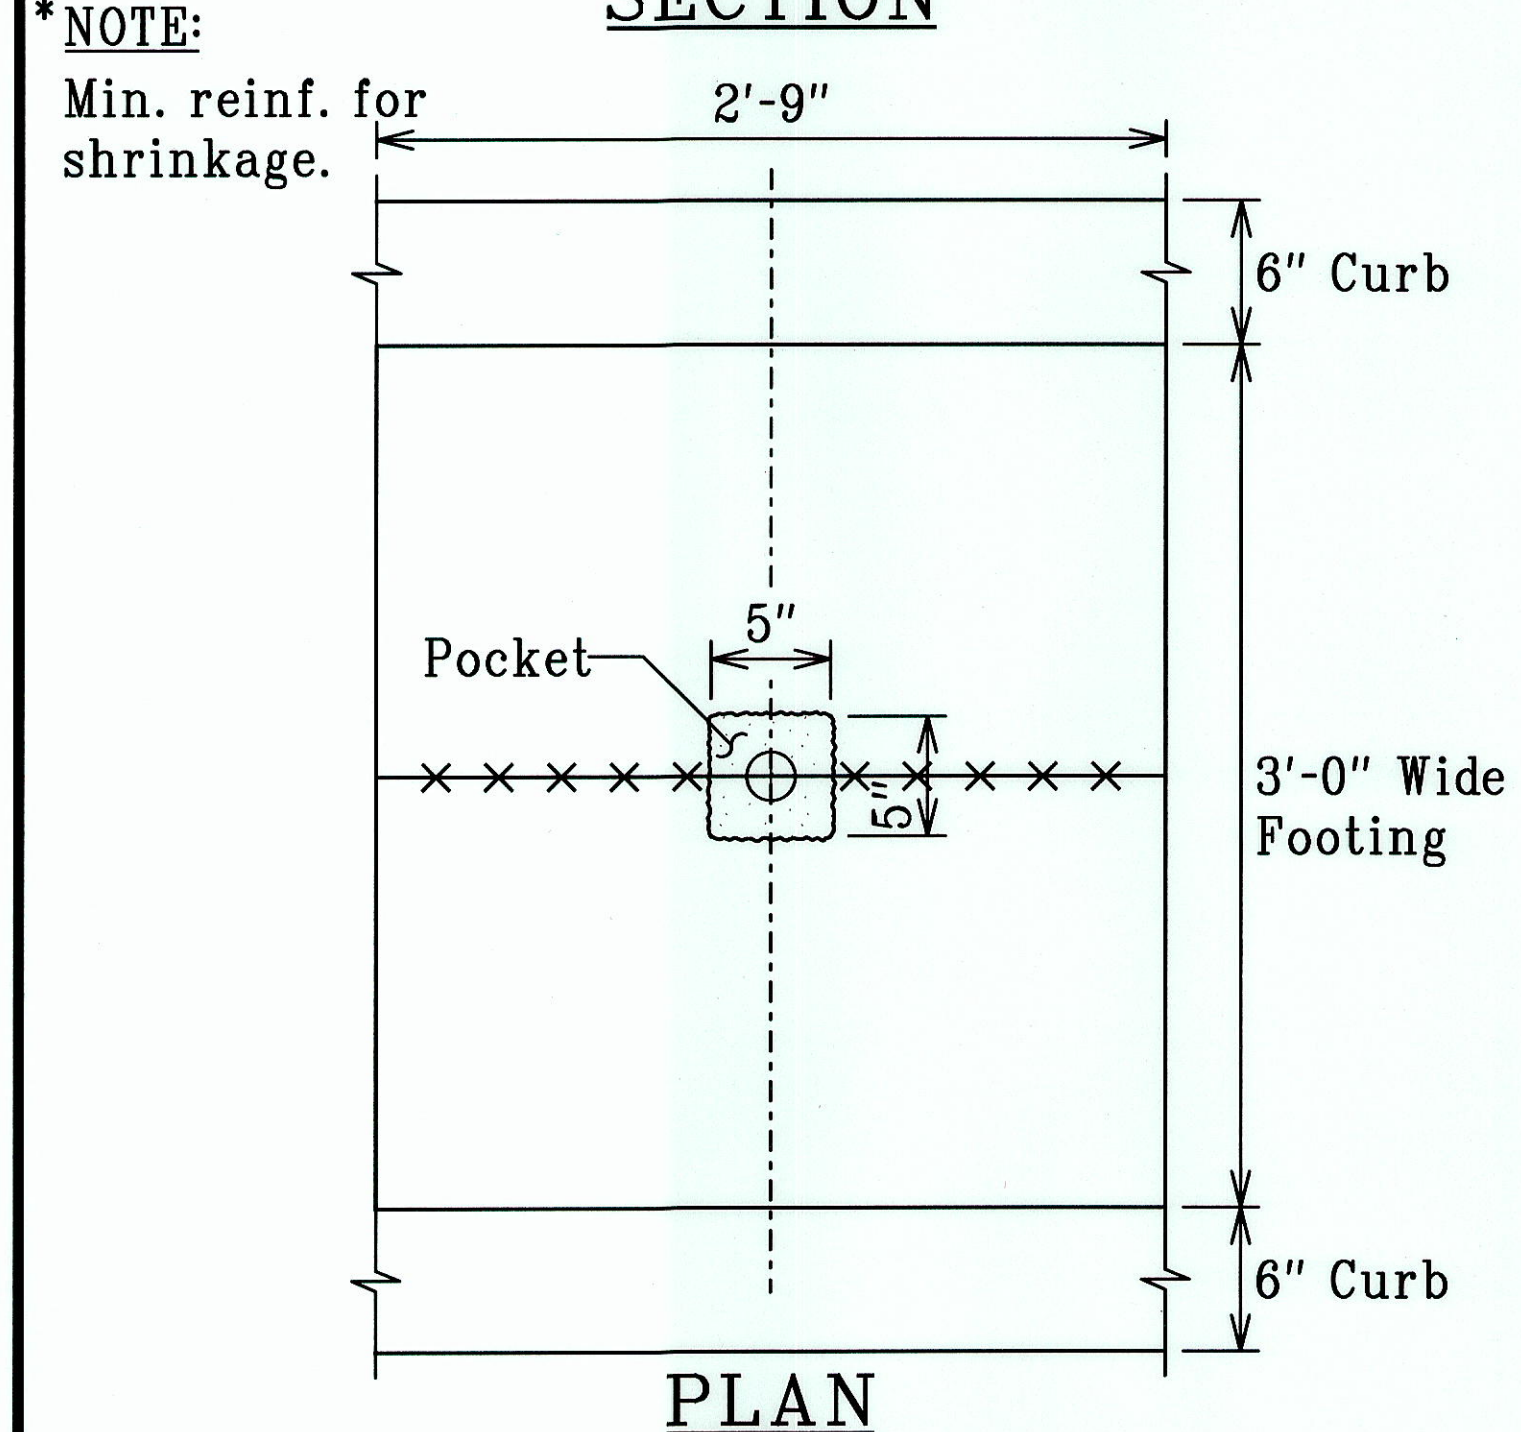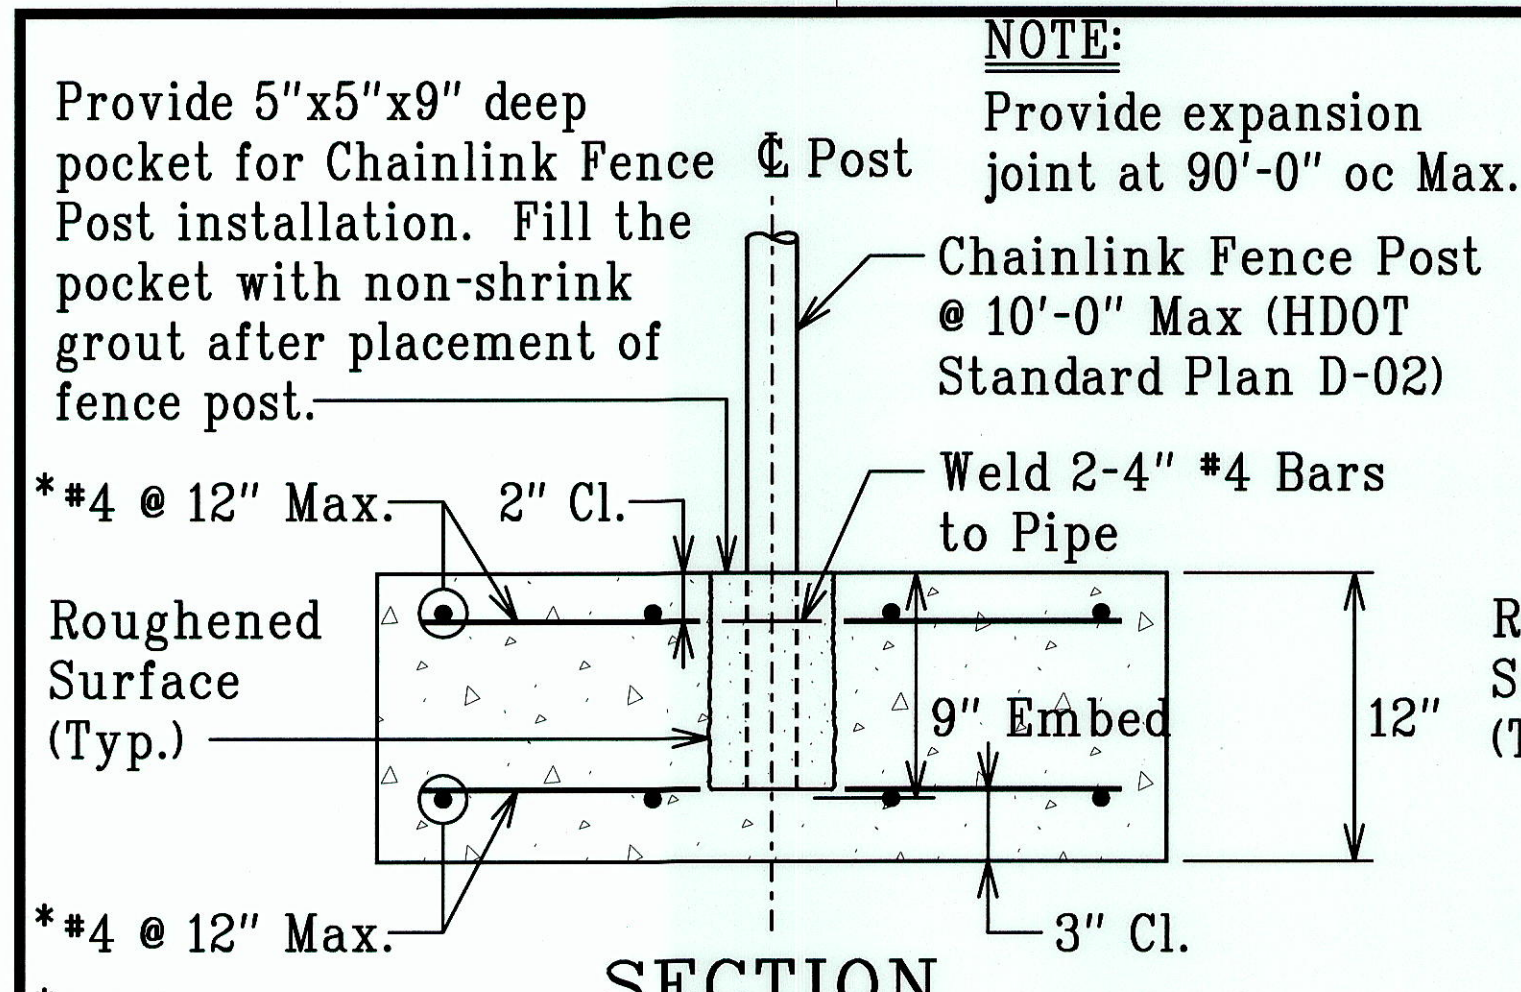



3'x2'-9"x12"D CHAINLINK FENCE POST FOOTING DETAIL
Scale: 1"=1'-0"

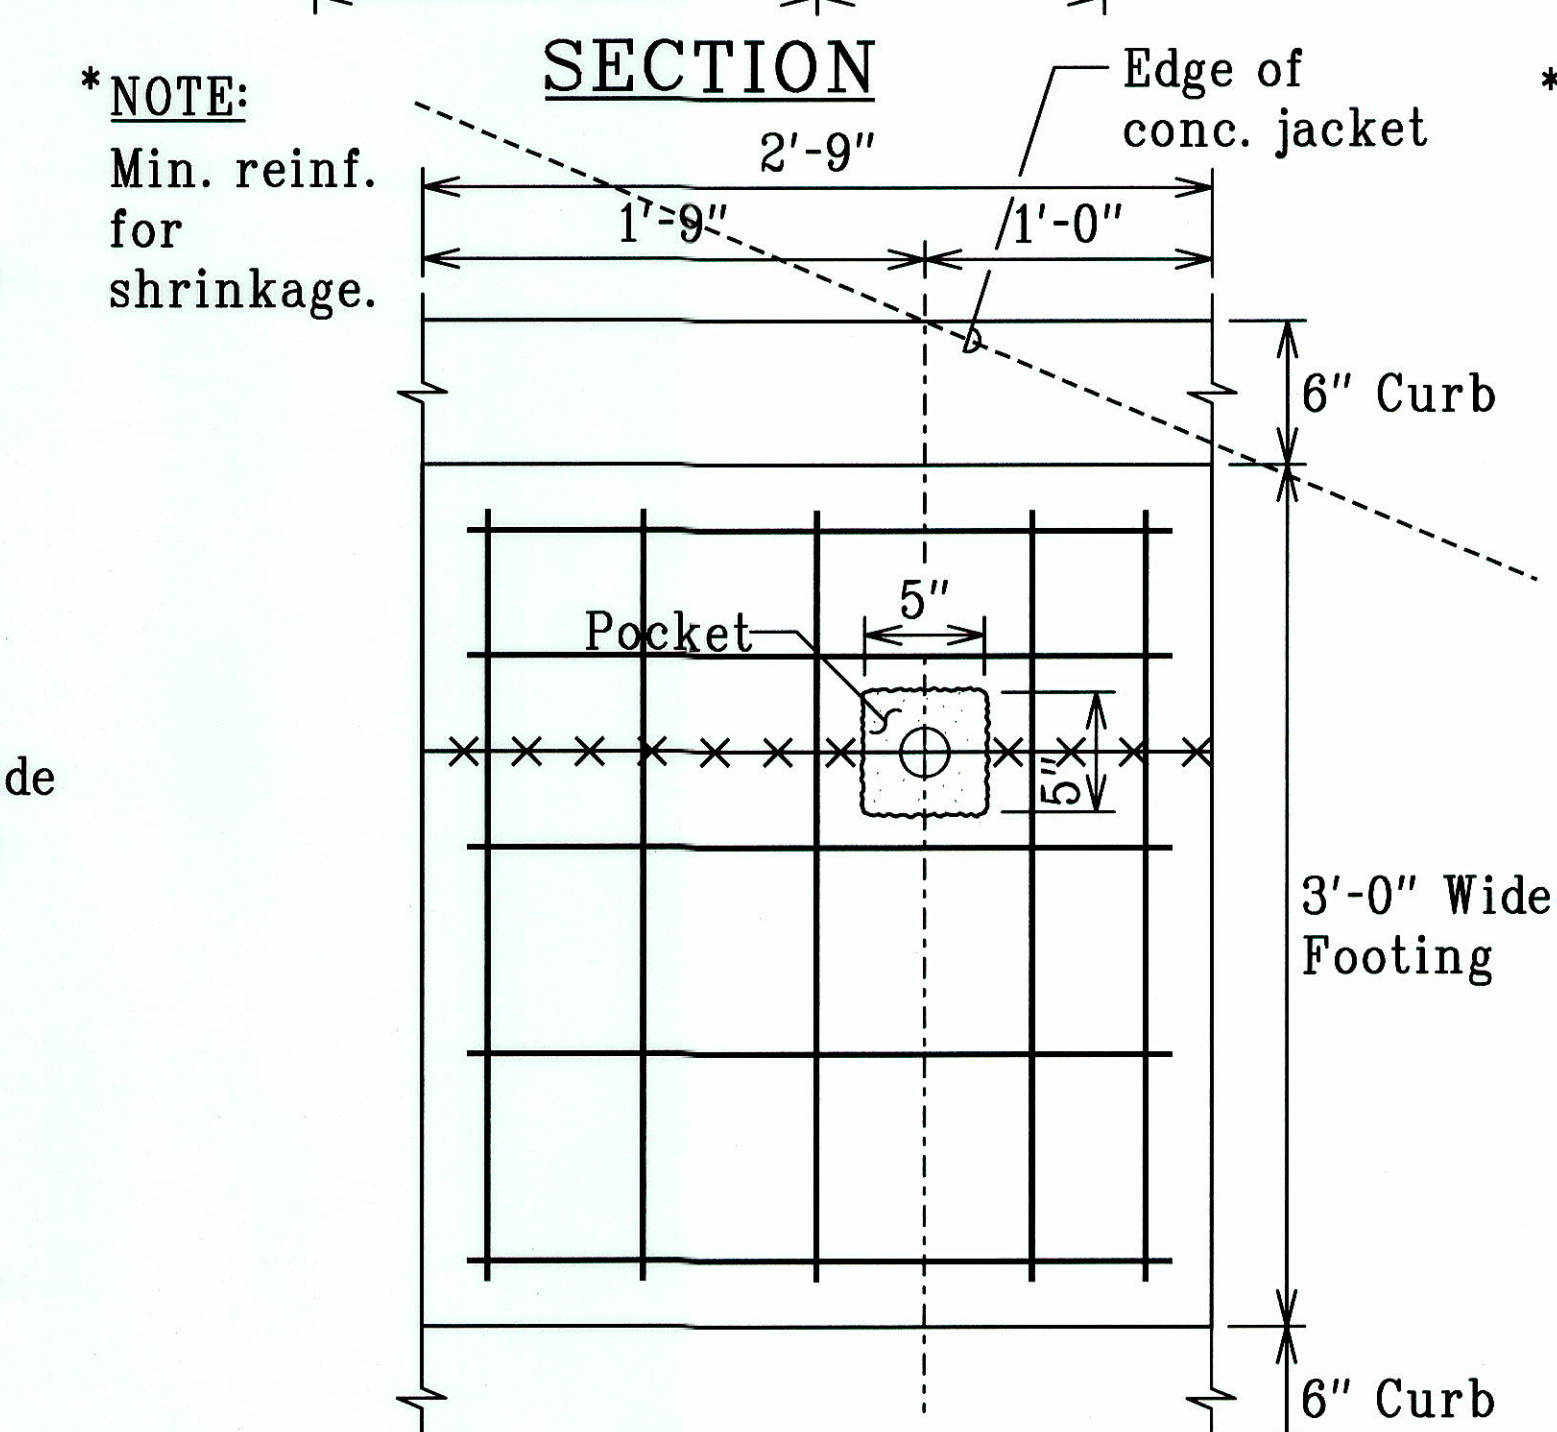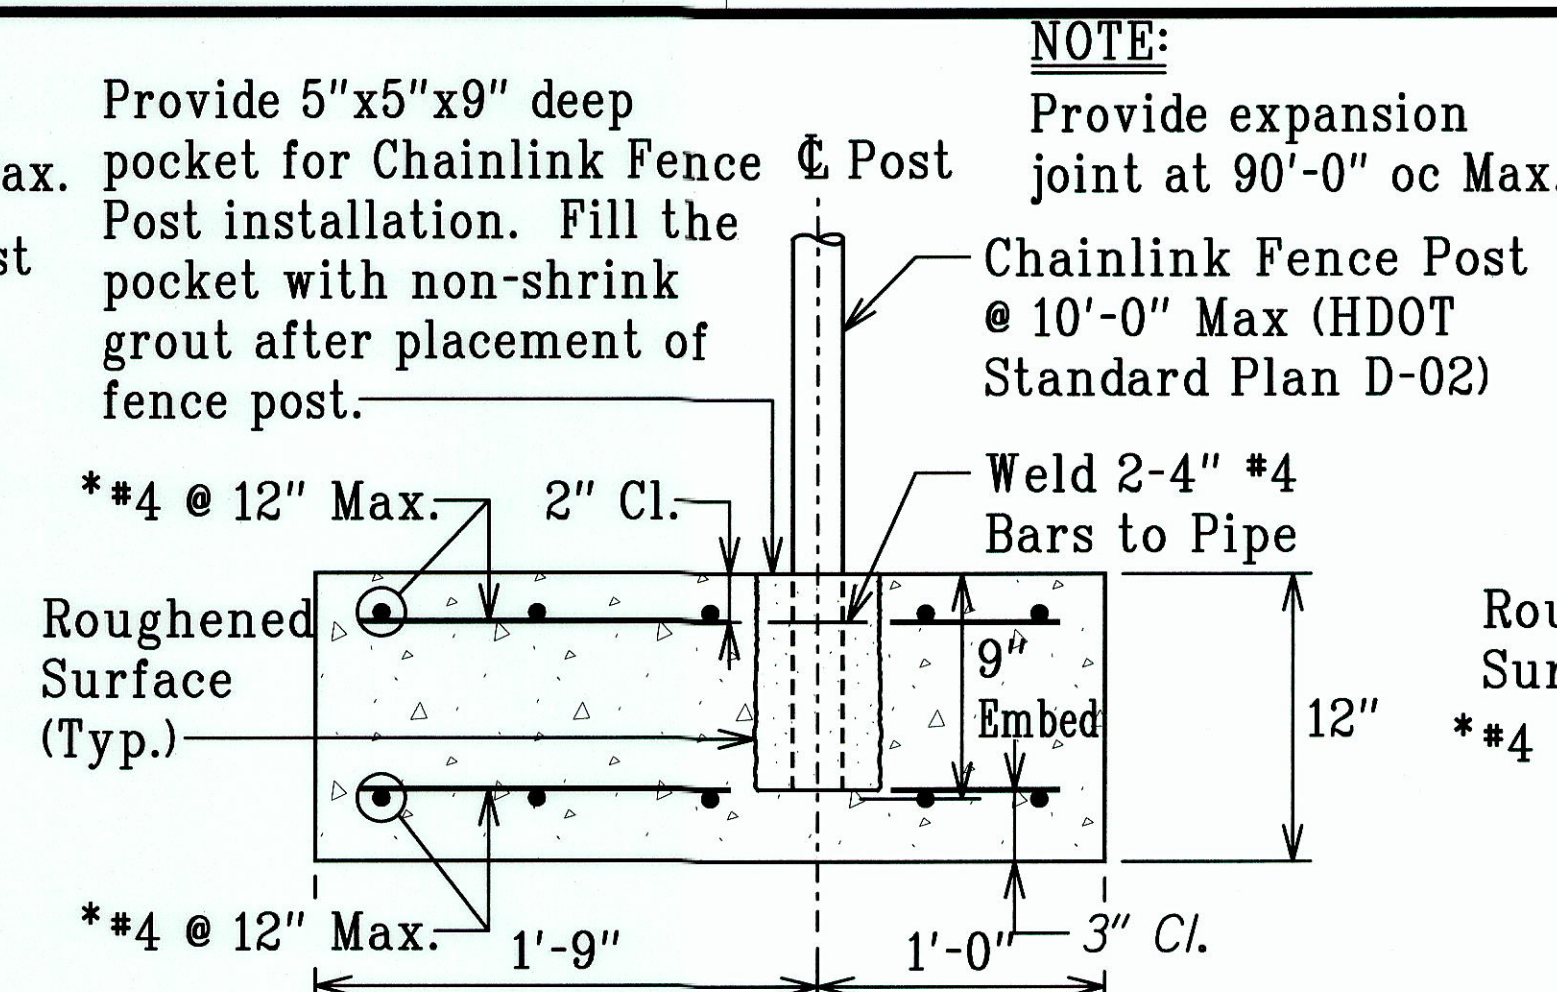


3'x2'-9"x12"D ECCENTRIC CHAINLINK FENCE POST FOOTING DETAIL
Scale: 1"=1'-0"

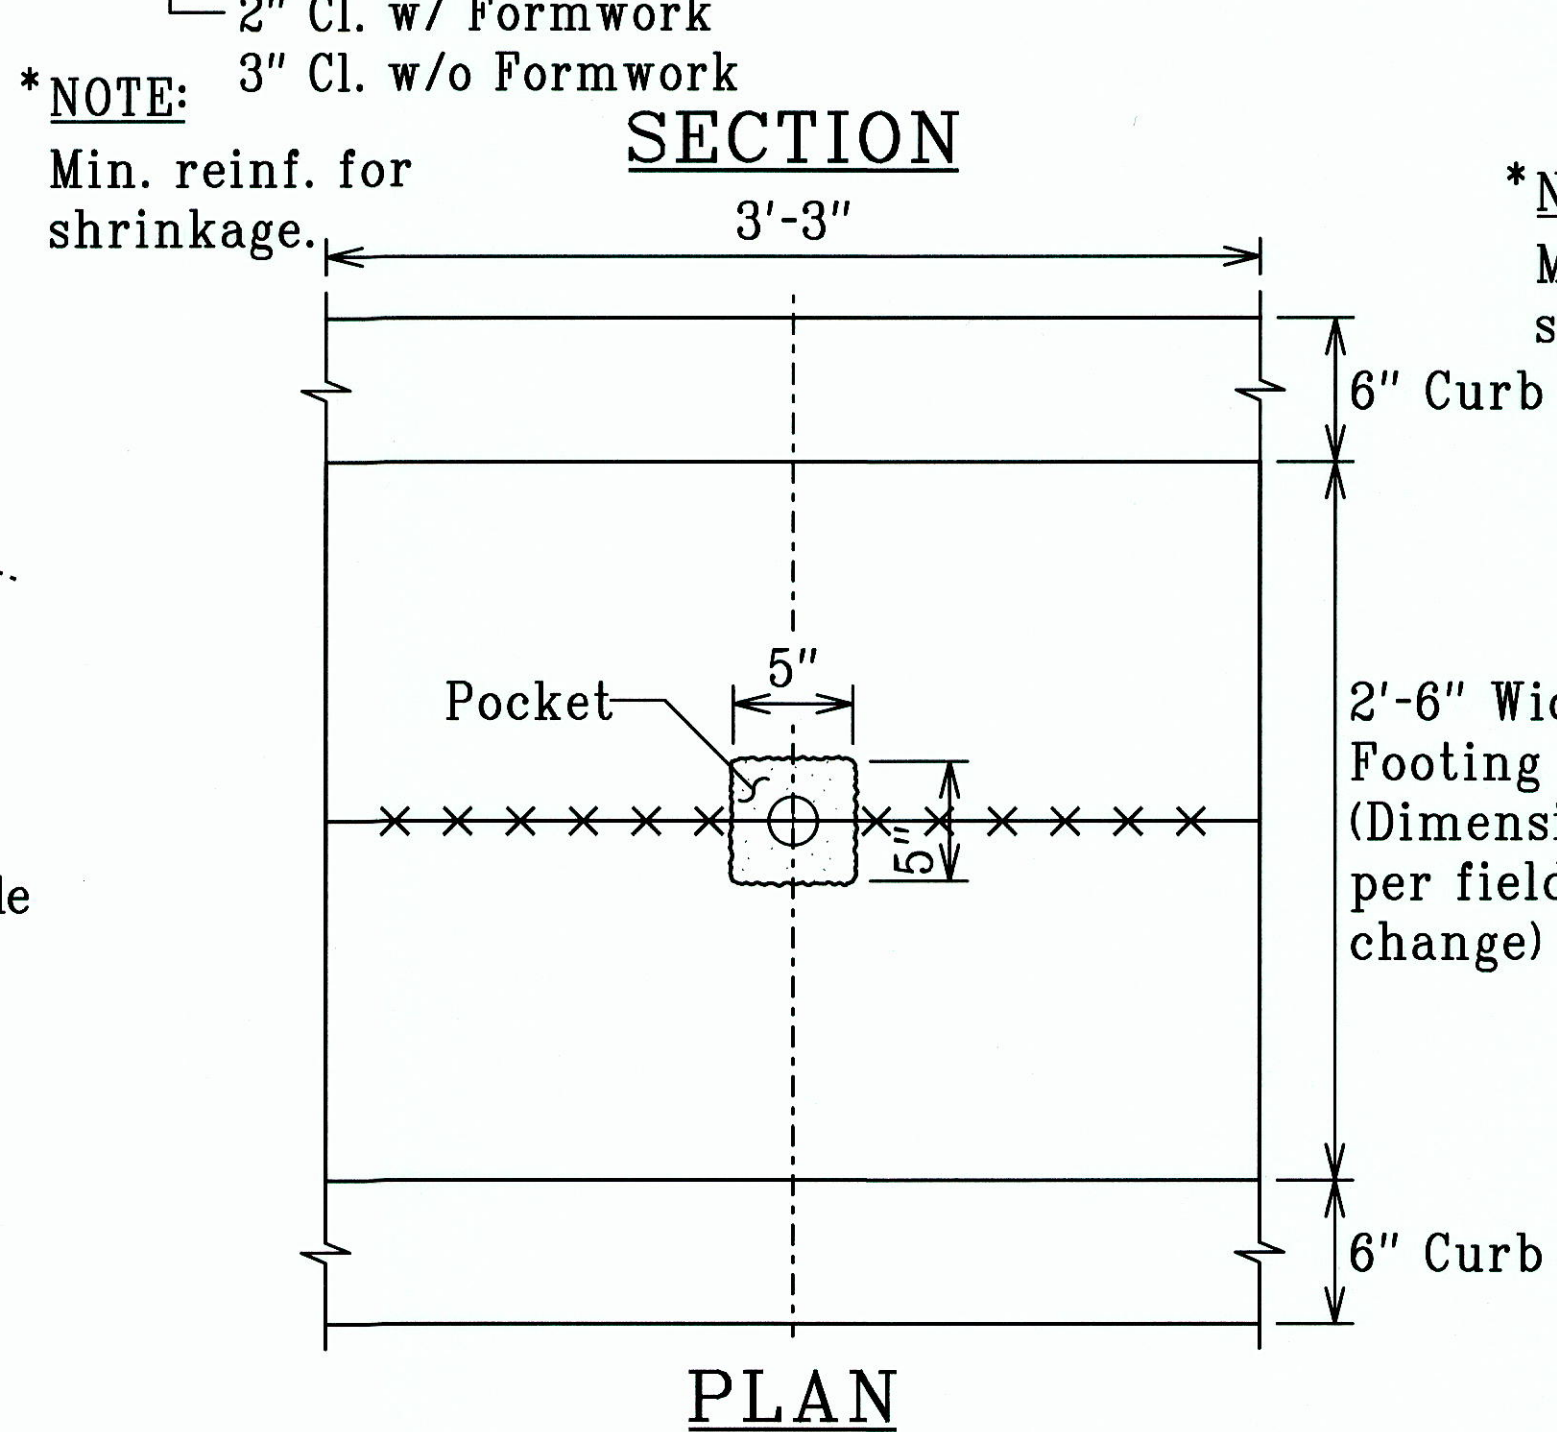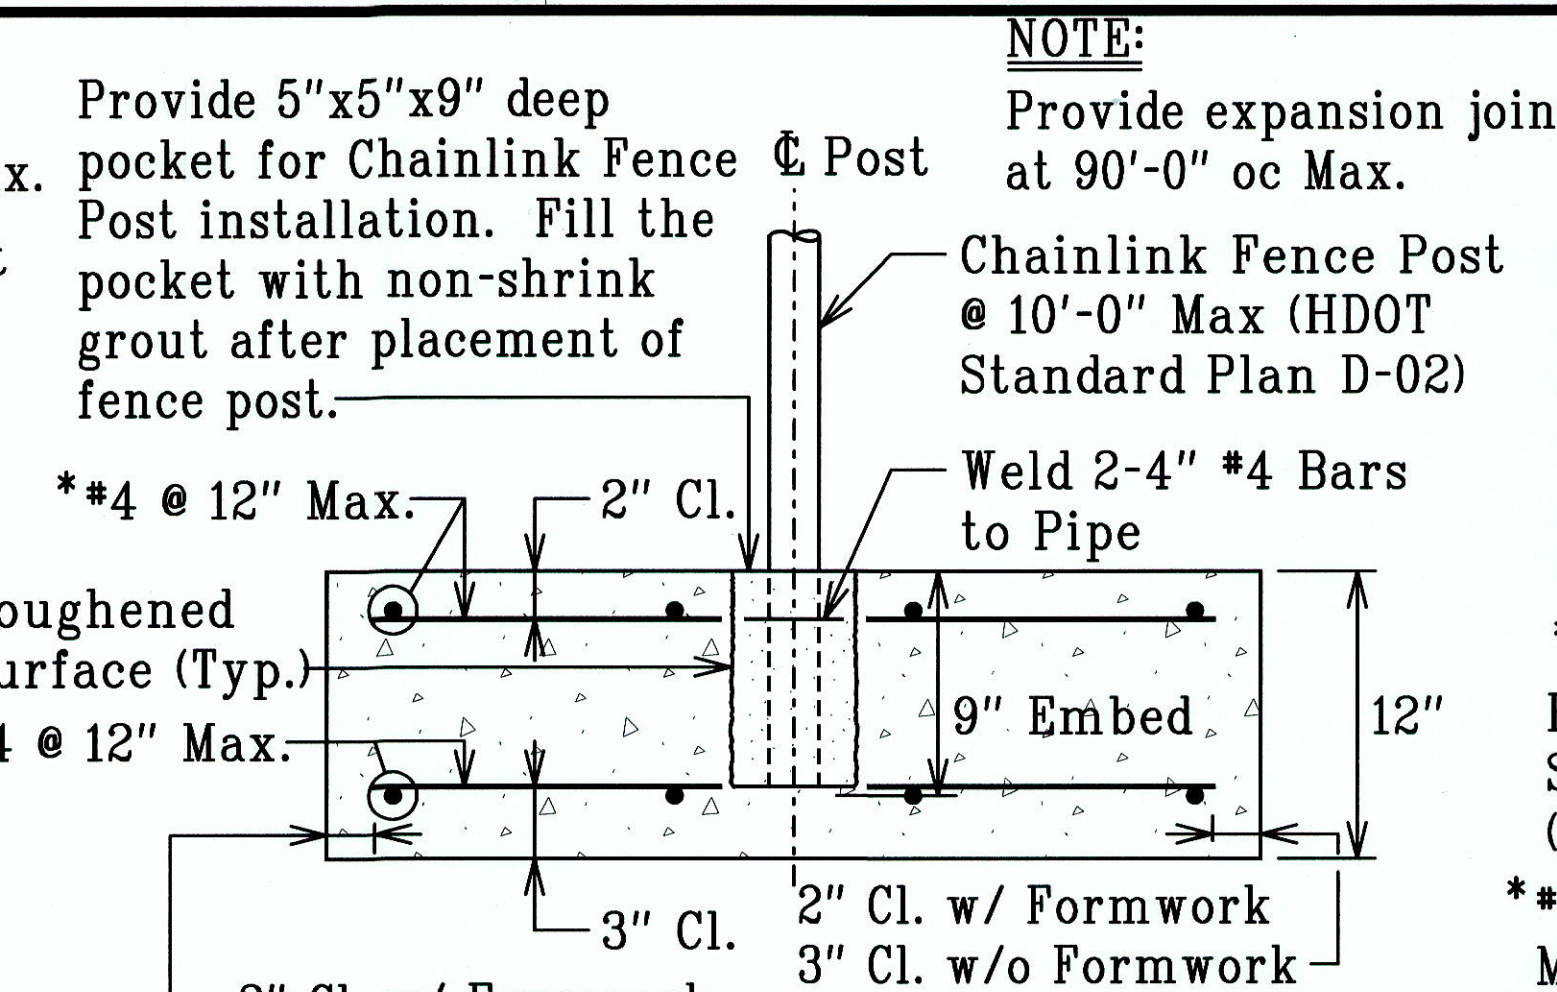


2'-6"x3'-3"x12"D CHAINLINK FENCE POST FOOTING DETAIL
Scale: 1"=1'-0"

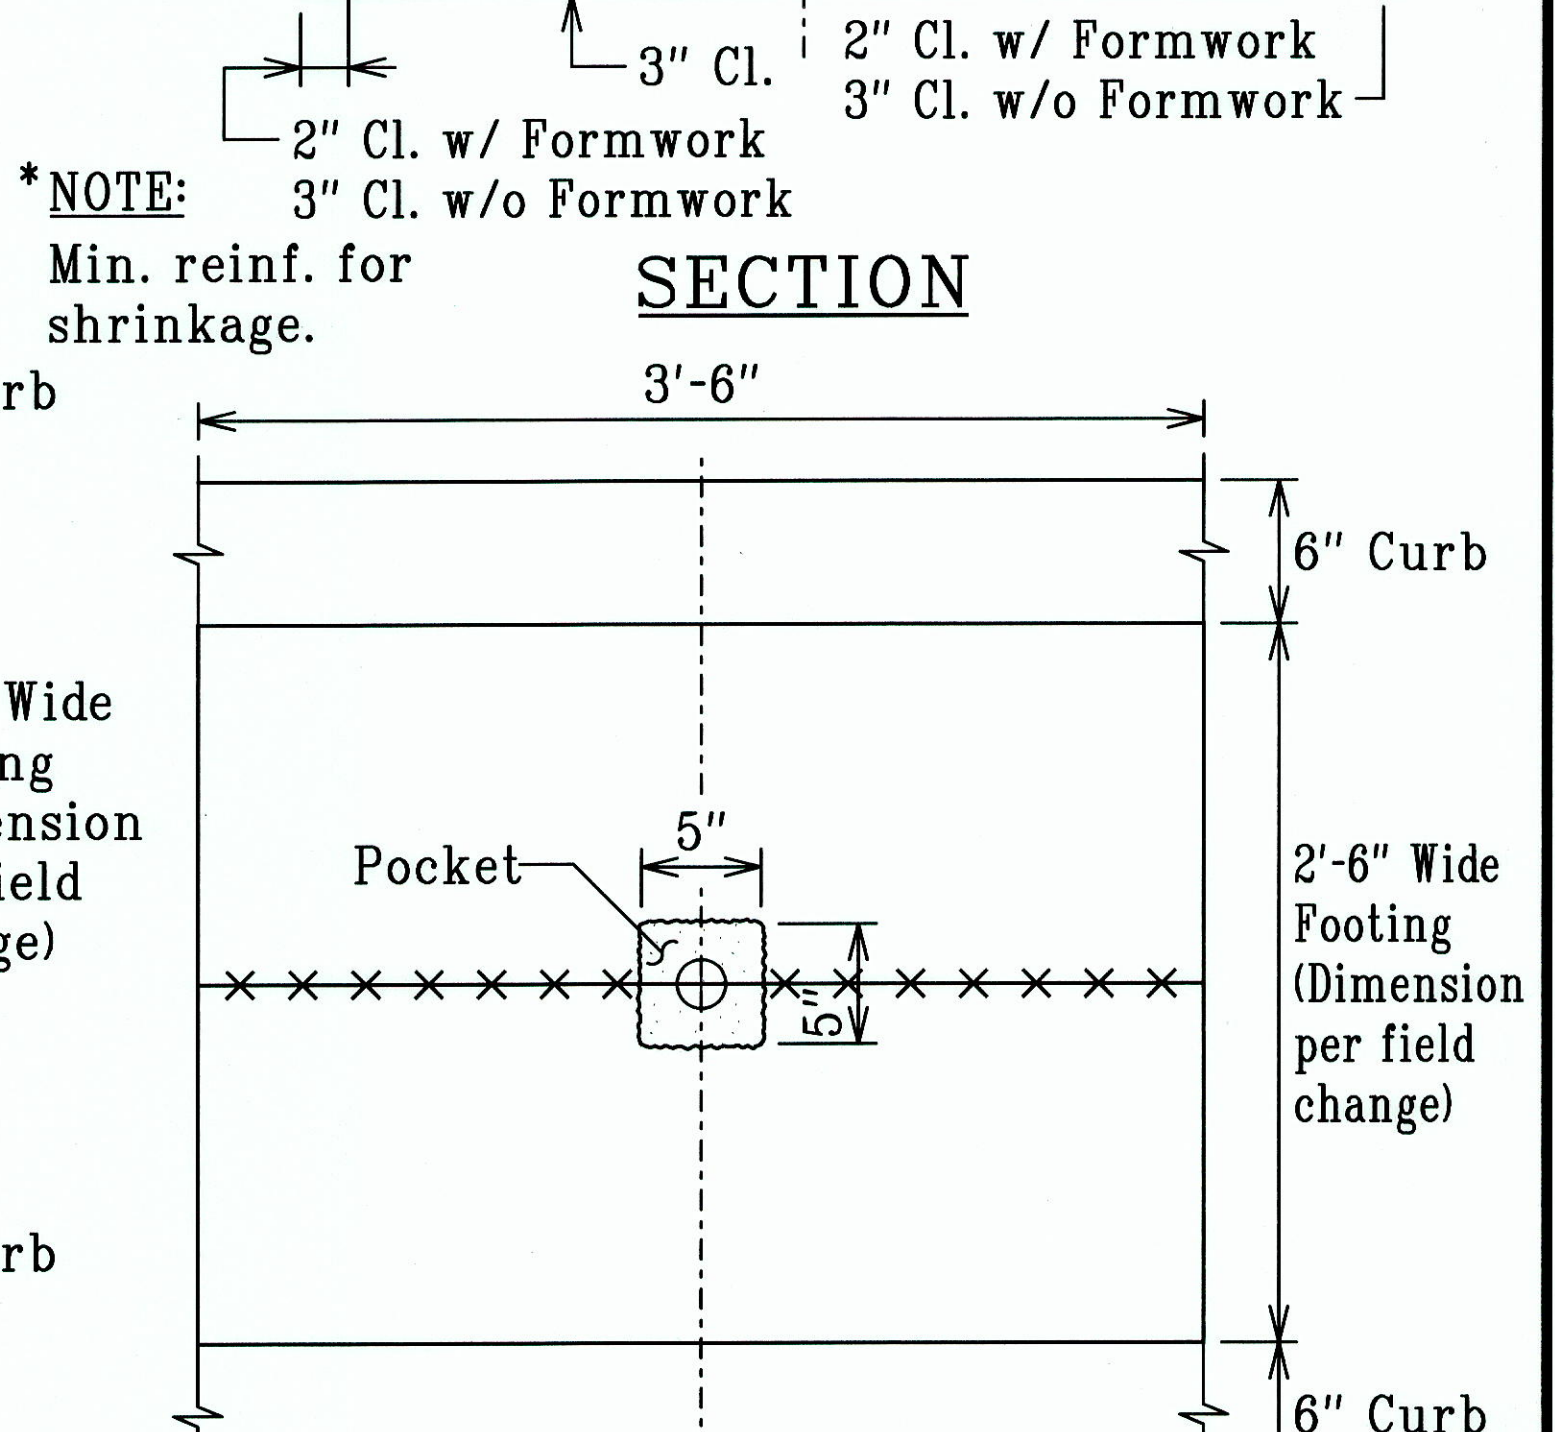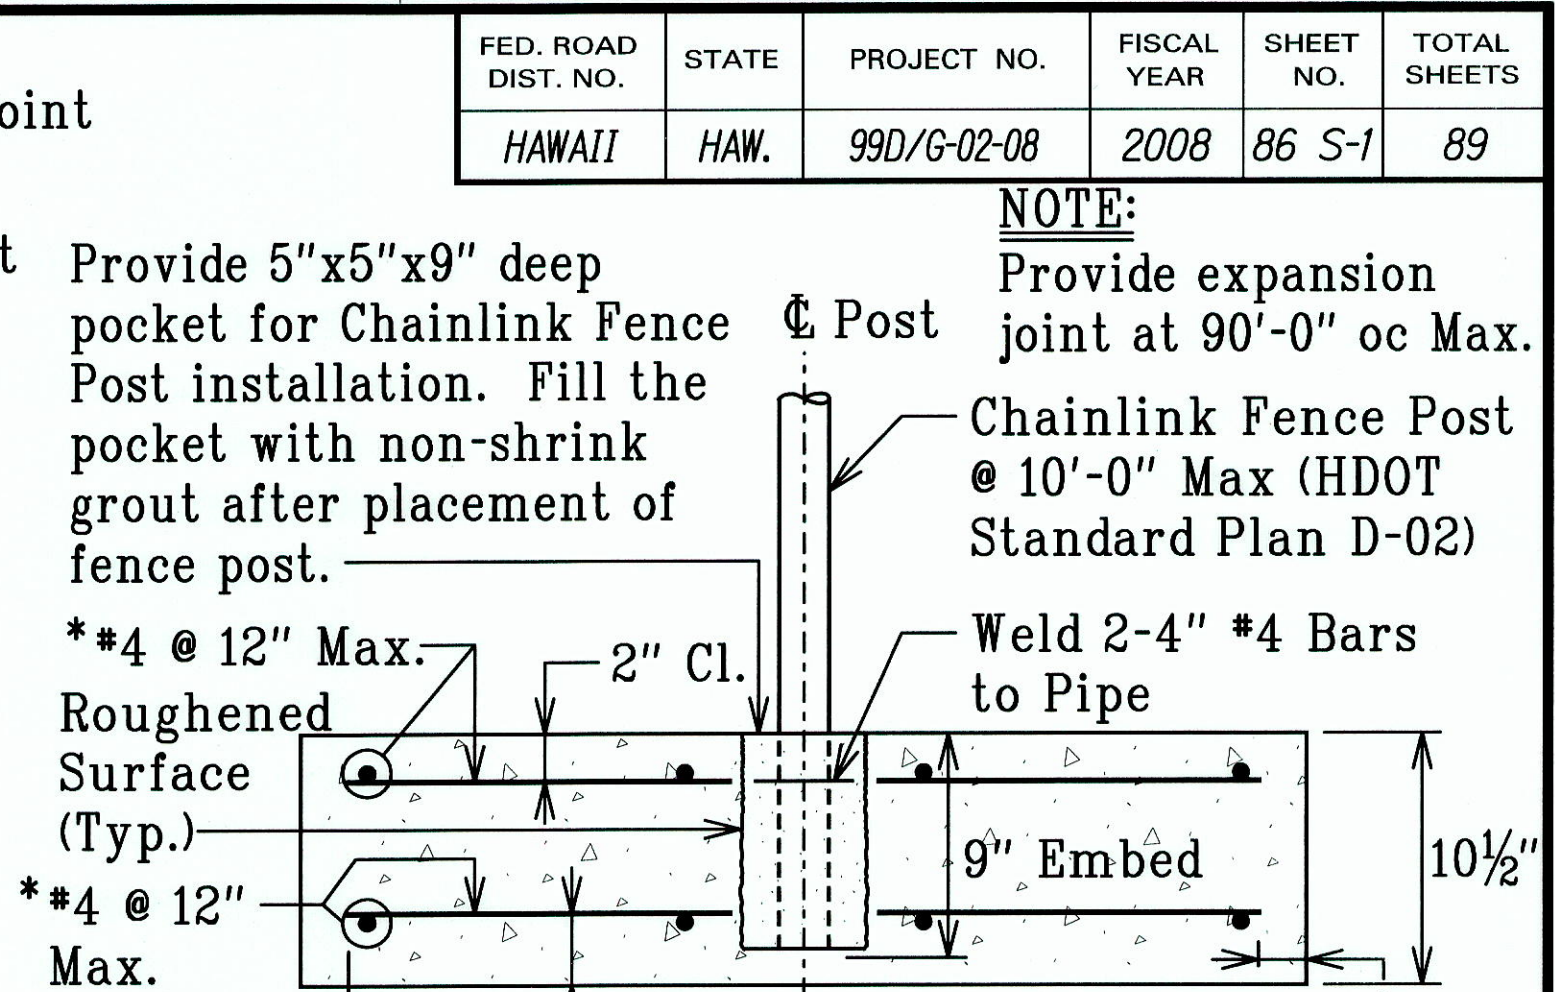

2'-6"x3'-6"x10-1/2"D CHAINLINK FENCE POST FOOTING DETAIL
Scale: 1"=1'-0"

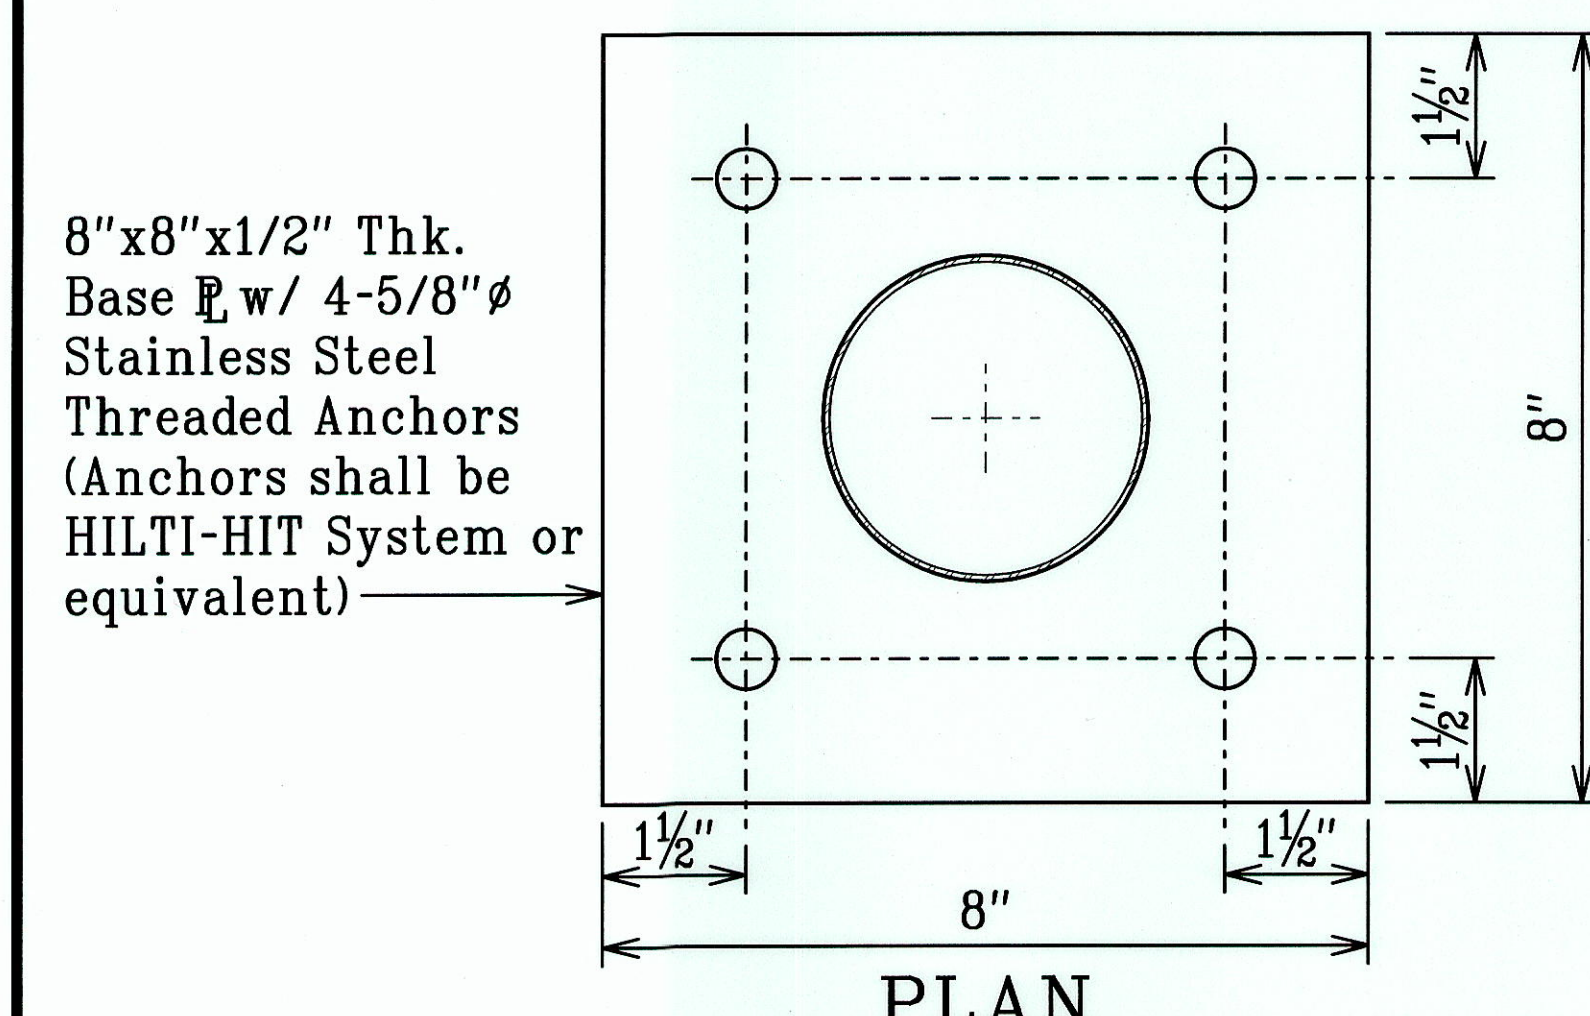

FENCE POST BASE PLATE DETAIL
Not to Scale

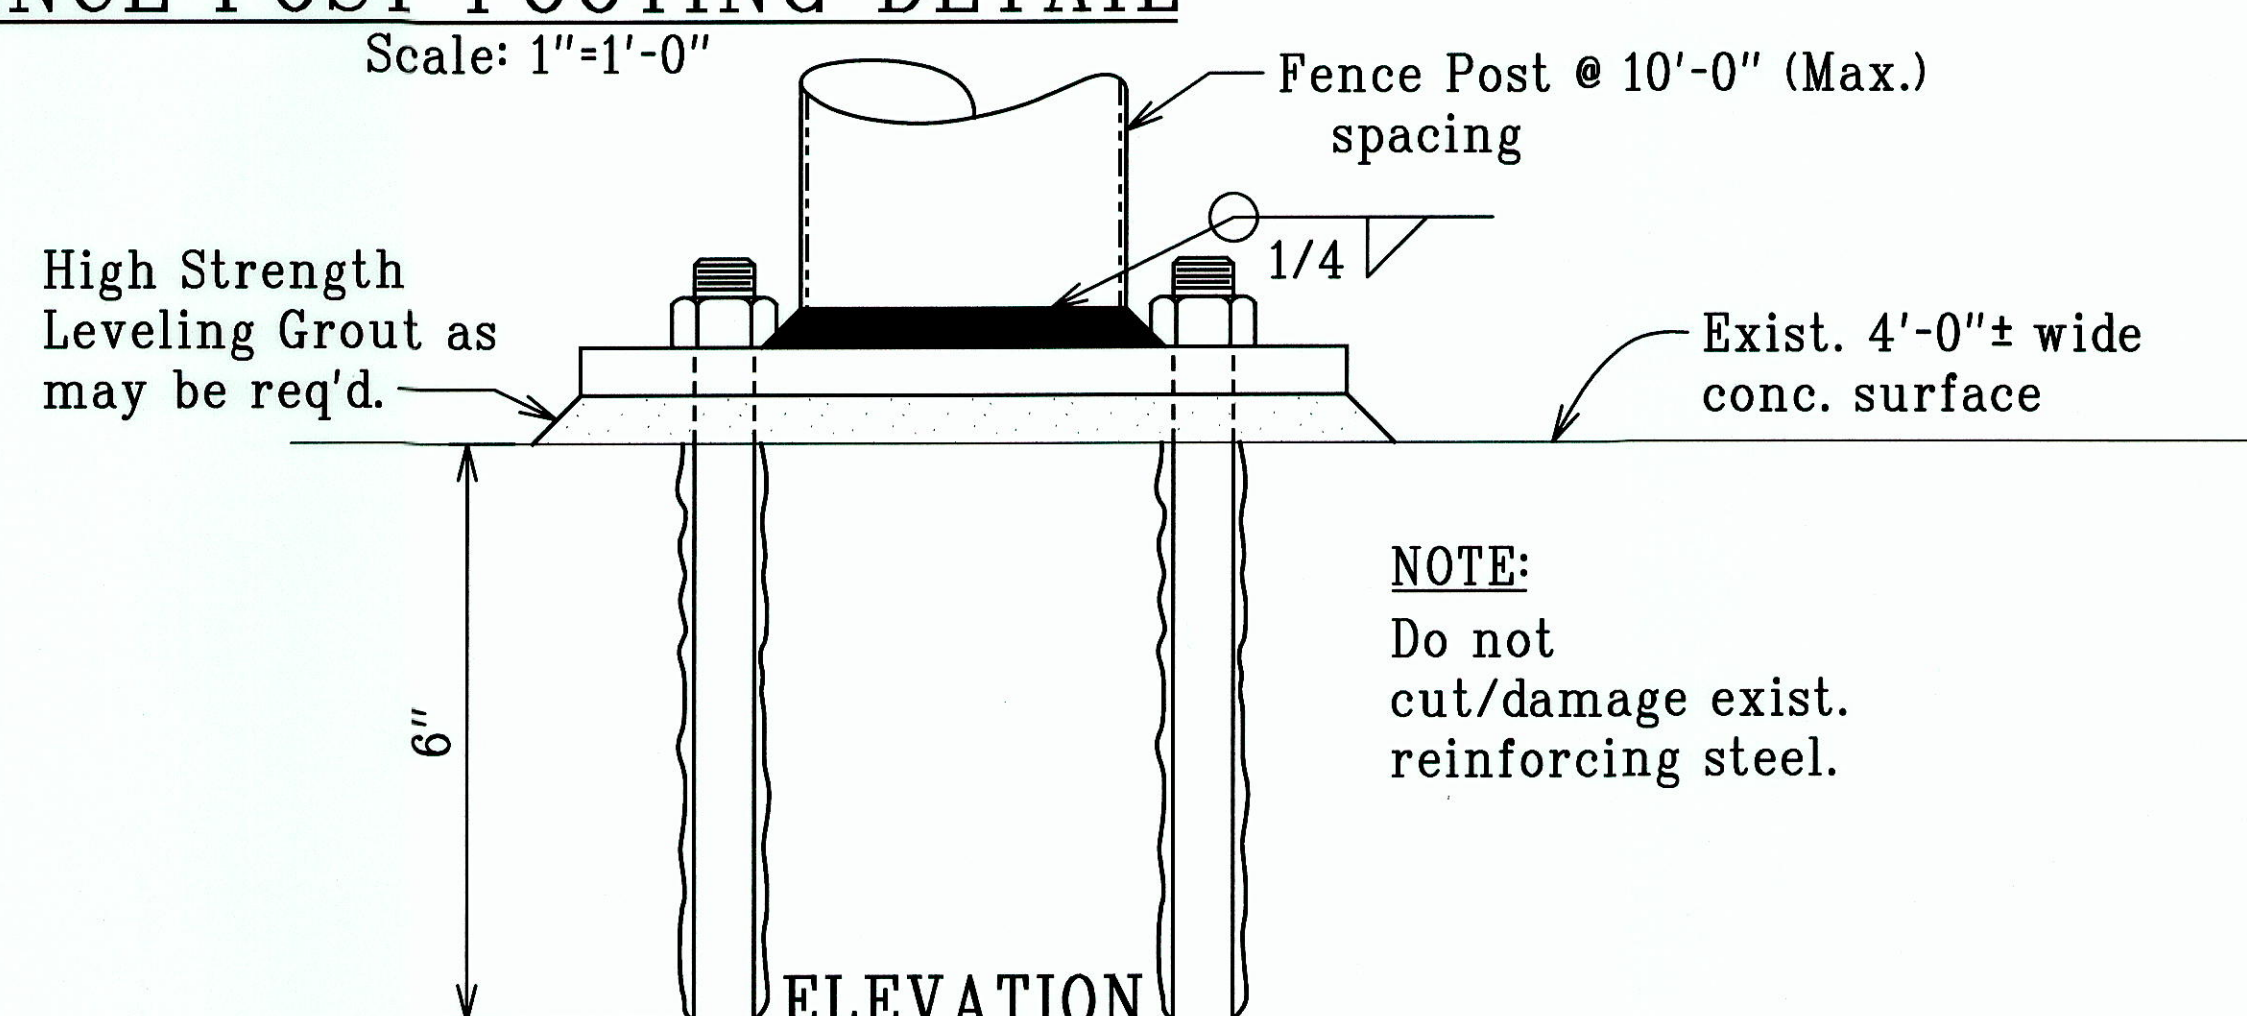

FENCE POST BASE PLATE DETAIL
Not to Scale

NOTE: Do not cut/damage exist. reinforcing steel.

LEGEND FOR AS-BUILT POSTINGS

	Squiggly line for as-built deletion
	Double line for as-built deletion
Roadway	Text for as-built posting

SURVEY PLOTTED BY	DATE
DRAWN BY	
TRACED BY	
QUANTITIES BY	
CHECKED BY	
ORIGINAL PLAN	
NOTE BOOK	
N.	

STATE OF HAWAII
DEPARTMENT OF TRANSPORTATION
HIGHWAYS DIVISION

FENCE DETAILS - 3

KAMEHAMEHA HIGHWAY MEDIAN FENCING IMPROVEMENTS
VICINITY OF ACACIA ROAD TO SALT LAKE BOULEVARD
PROJECT NO. 99D/G-02-08
Scale: As Noted Date: April 2008
SHEET No. D-2A OF 2 SHEETS