
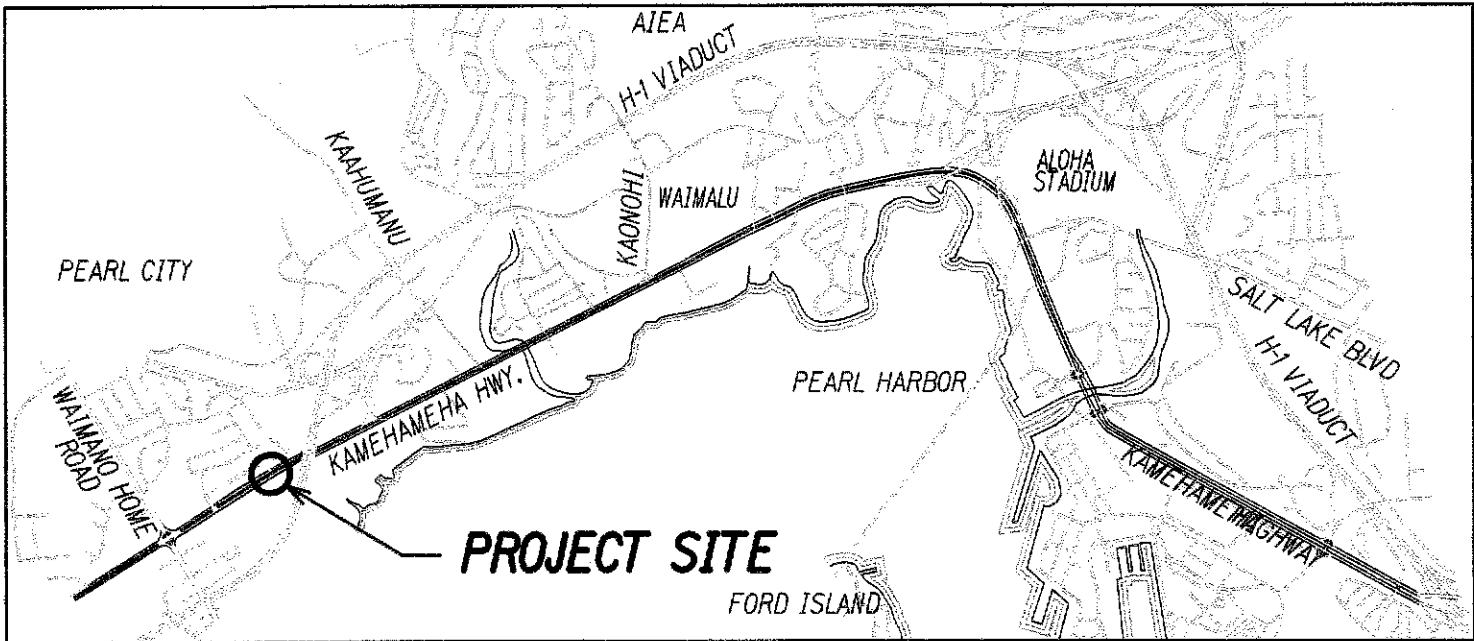


FED. ROAD DIST. NO.	STATE	PROJECT NO.	FISCAL YEAR	SHEET NO.	TOTAL SHEETS
HAWAII	HAW.	99D/G-01-08	2008	13	89

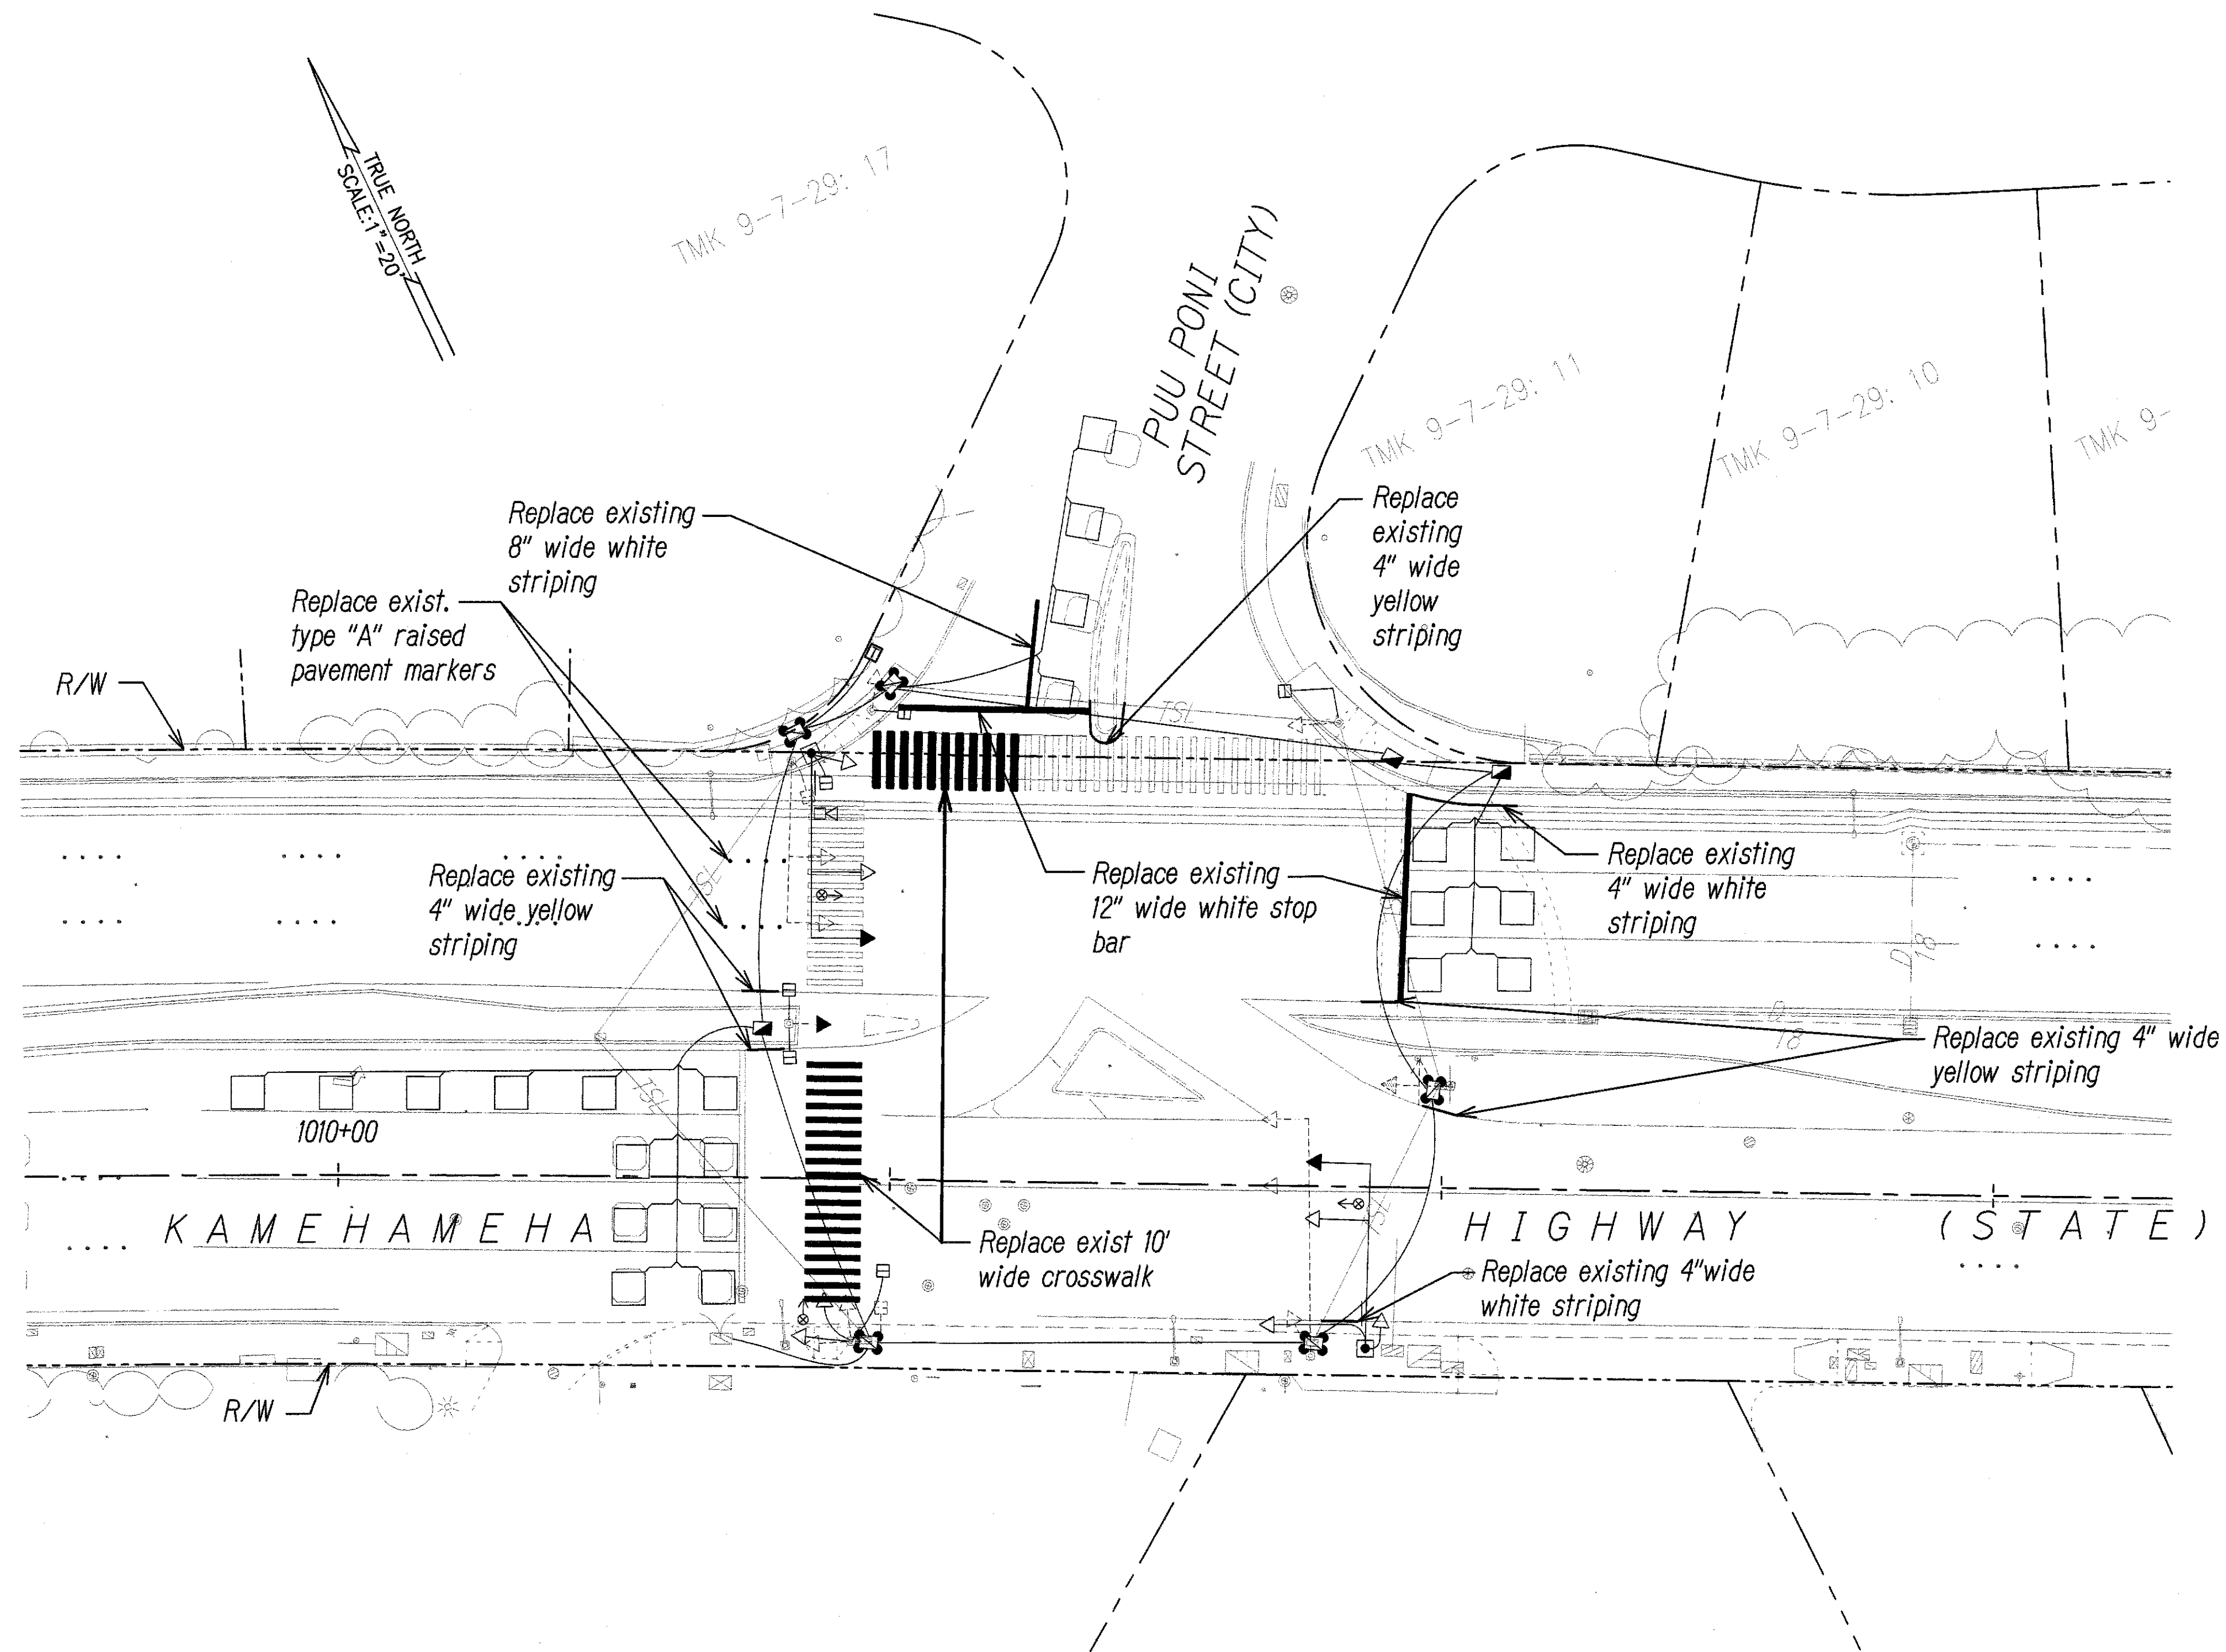

KEY MAP
Not to Scale

PAVEMENT MARKING PLAN
KAMEHAMEHA HIGHWAY AND PUU PONI STREET
SCALE: 1"=20'

LEGEND FOR AS-BUILT POSTINGS	
	Squiggly line for as-built deletion
	Double line for as-built deletion
Roadway	Text for as-built posting

THIS WORK WAS PREPARED BY ME OR UNDER MY SUPERVISION

Signature: *Keith K. Niya* 4/30/10

EXPIRATION DATE OF THE LICENSE

STATE OF HAWAII
DEPARTMENT OF TRANSPORTATION
HIGHWAYS DIVISION

PAVEMENT MARKING PLAN

KAMEHAMEHA HIGHWAY
TRAFFIC OPERATIONAL IMPROVEMENTS
VICINITY OF ACACIA ROAD TO CENTER DRIVE
PROJECT NO. 99D/G-01-08



Scale: 1"=20'

Date: April 2008

SHEET No. C-03 OF 9 SHEETS

SURVEY PLOTTED BY	DATE
DRAWN BY	
DESIGNED BY	
QUANTITIES BY	
CHECKED BY	
ORIGINAL PLAN	
NOTE BOOK	
No.	

FED. ROAD DIST. NO.	STATE	PROJECT NO.	FISCAL YEAR	SHEET NO.	TOTAL SHEETS
HAWAII	HAW.	99D/G-01-08	2008	14	89

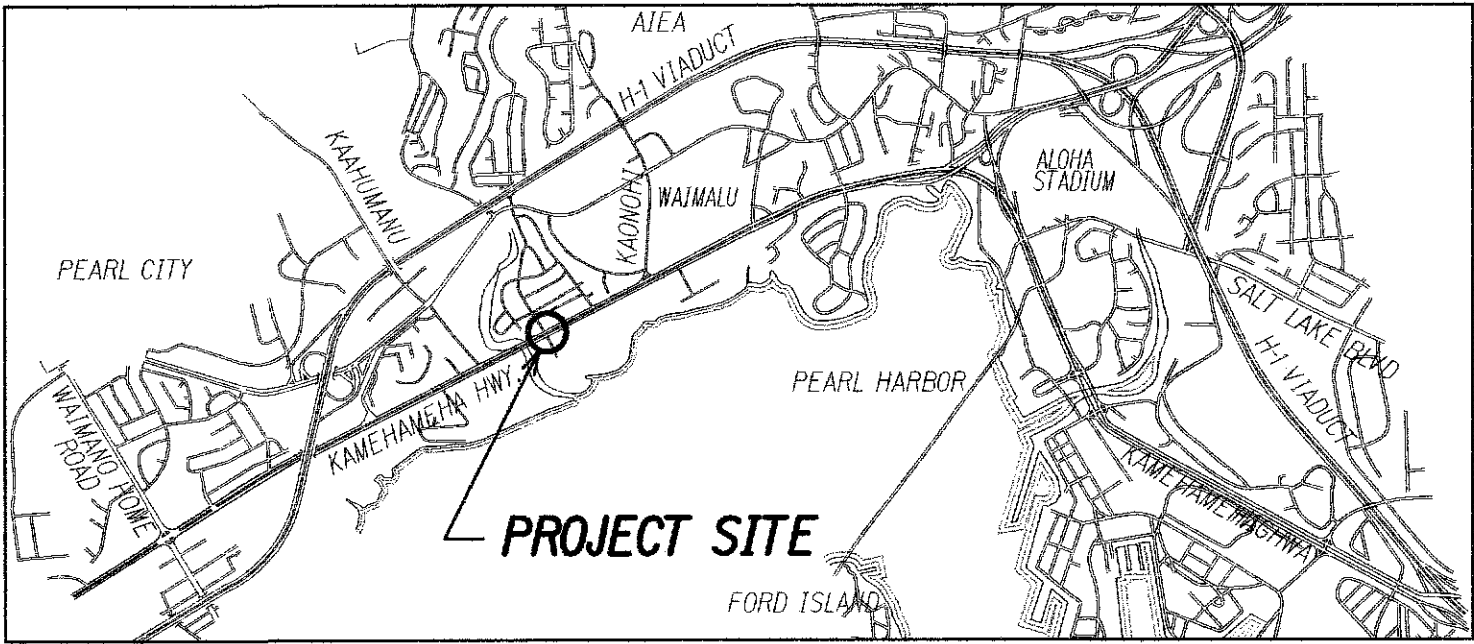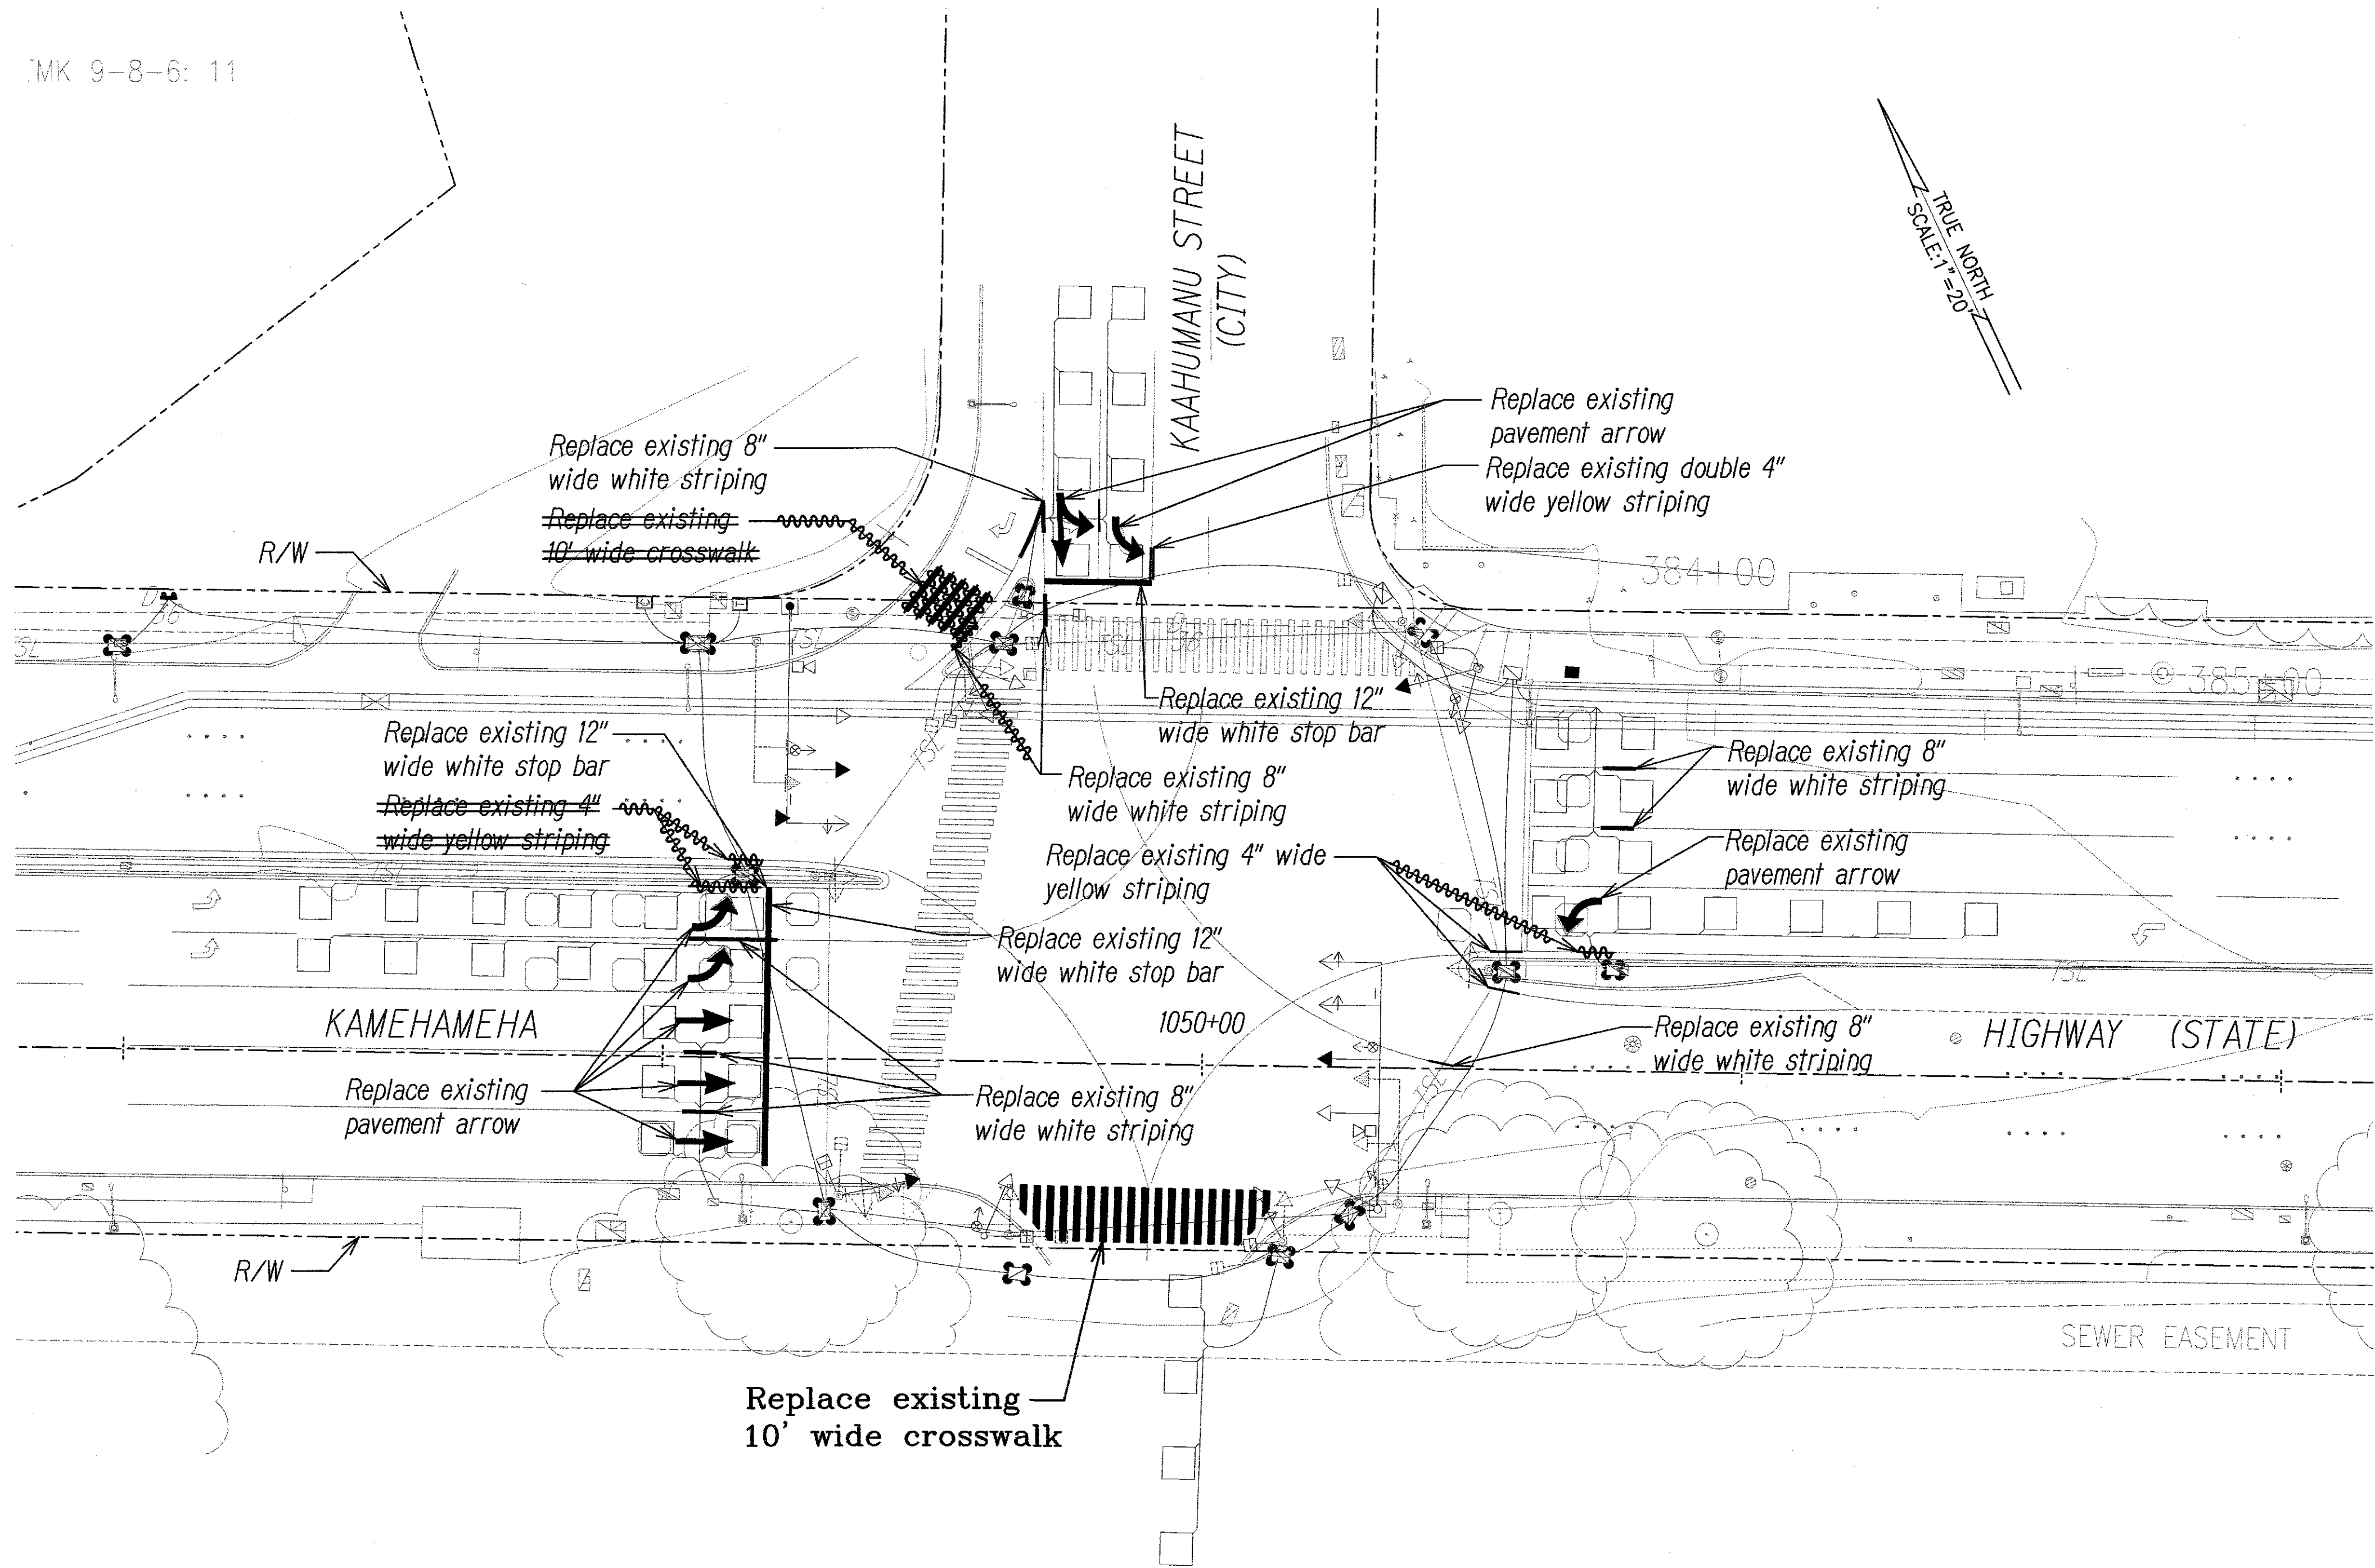

KEY MAP
Not to Scale

PAVEMENT MARKING PLAN
KAMEHAMEHA HIGHWAY AND KAAHUMANU STREET
SCALE: 1"=20'

LEGEND FOR AS-BUILT POSTINGS	
	Squiggly line for as-built deletion
	Double line for as-built deletion
Roadway	Text for as-built posting

THIS WORK WAS PREPARED BY ME OR UNDER MY SUPERVISION

Keith K. Niya 4/30/14

SIGNATURE EXPIRATION DATE OF THE LICENSE

STATE OF HAWAII
DEPARTMENT OF TRANSPORTATION
HIGHWAYS DIVISION

PAVEMENT MARKING PLAN



KAMEHAMEHA HIGHWAY
TRAFFIC OPERATIONAL IMPROVEMENTS
VICINITY OF ACACIA ROAD TO CENTER DRIVE
PROJECT NO. 99D/G-01-08

Scale: 1"=20' Date: April 2008

SHEET No. C-04 OF 9 SHEETS

DATE	
SURVEY PLOTTED BY	
DRAWN BY	
DESIGNED BY	
QUANTITIES BY	
CHECKED BY	
ORIGINAL PLAN	
NOTE BOOK	
No.	

FED. ROAD DIST. NO.	STATE	PROJECT NO.	FISCAL YEAR	SHEET NO.	TOTAL SHEETS
HAWAII	HAW.	99D/G-01-08	2008	16	89

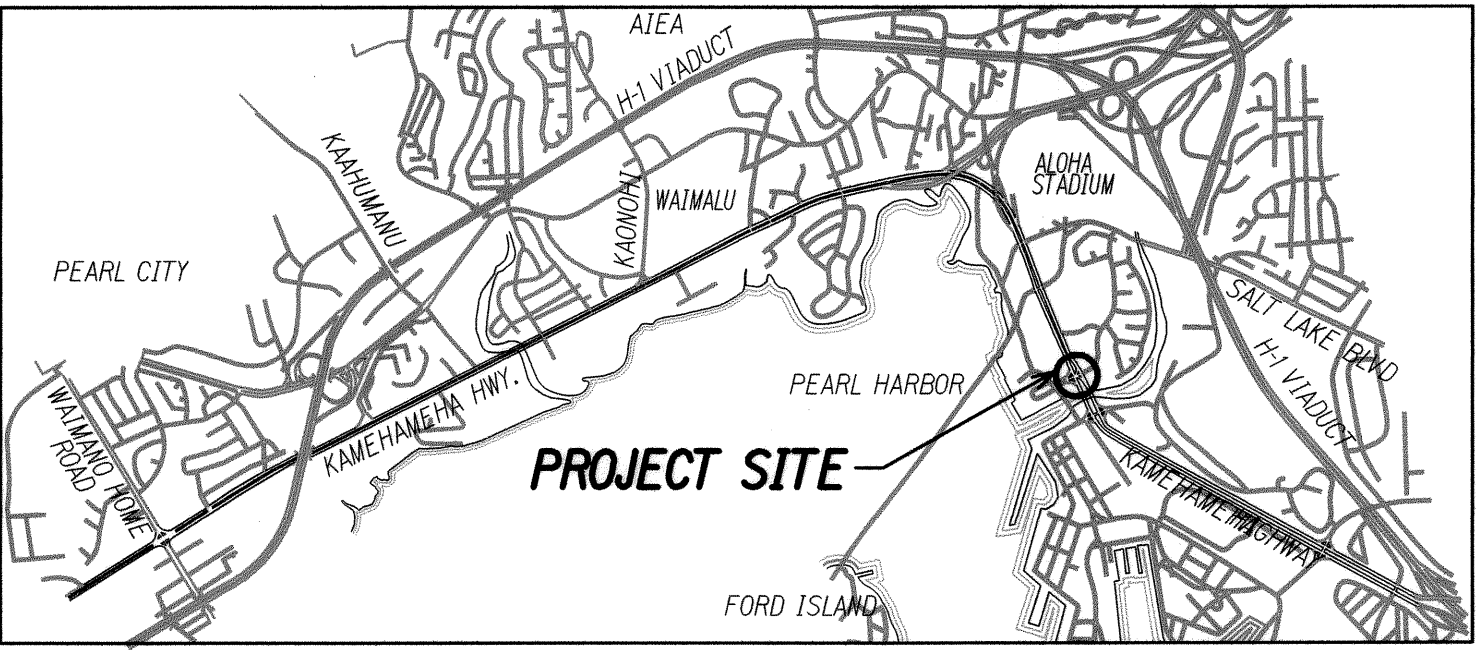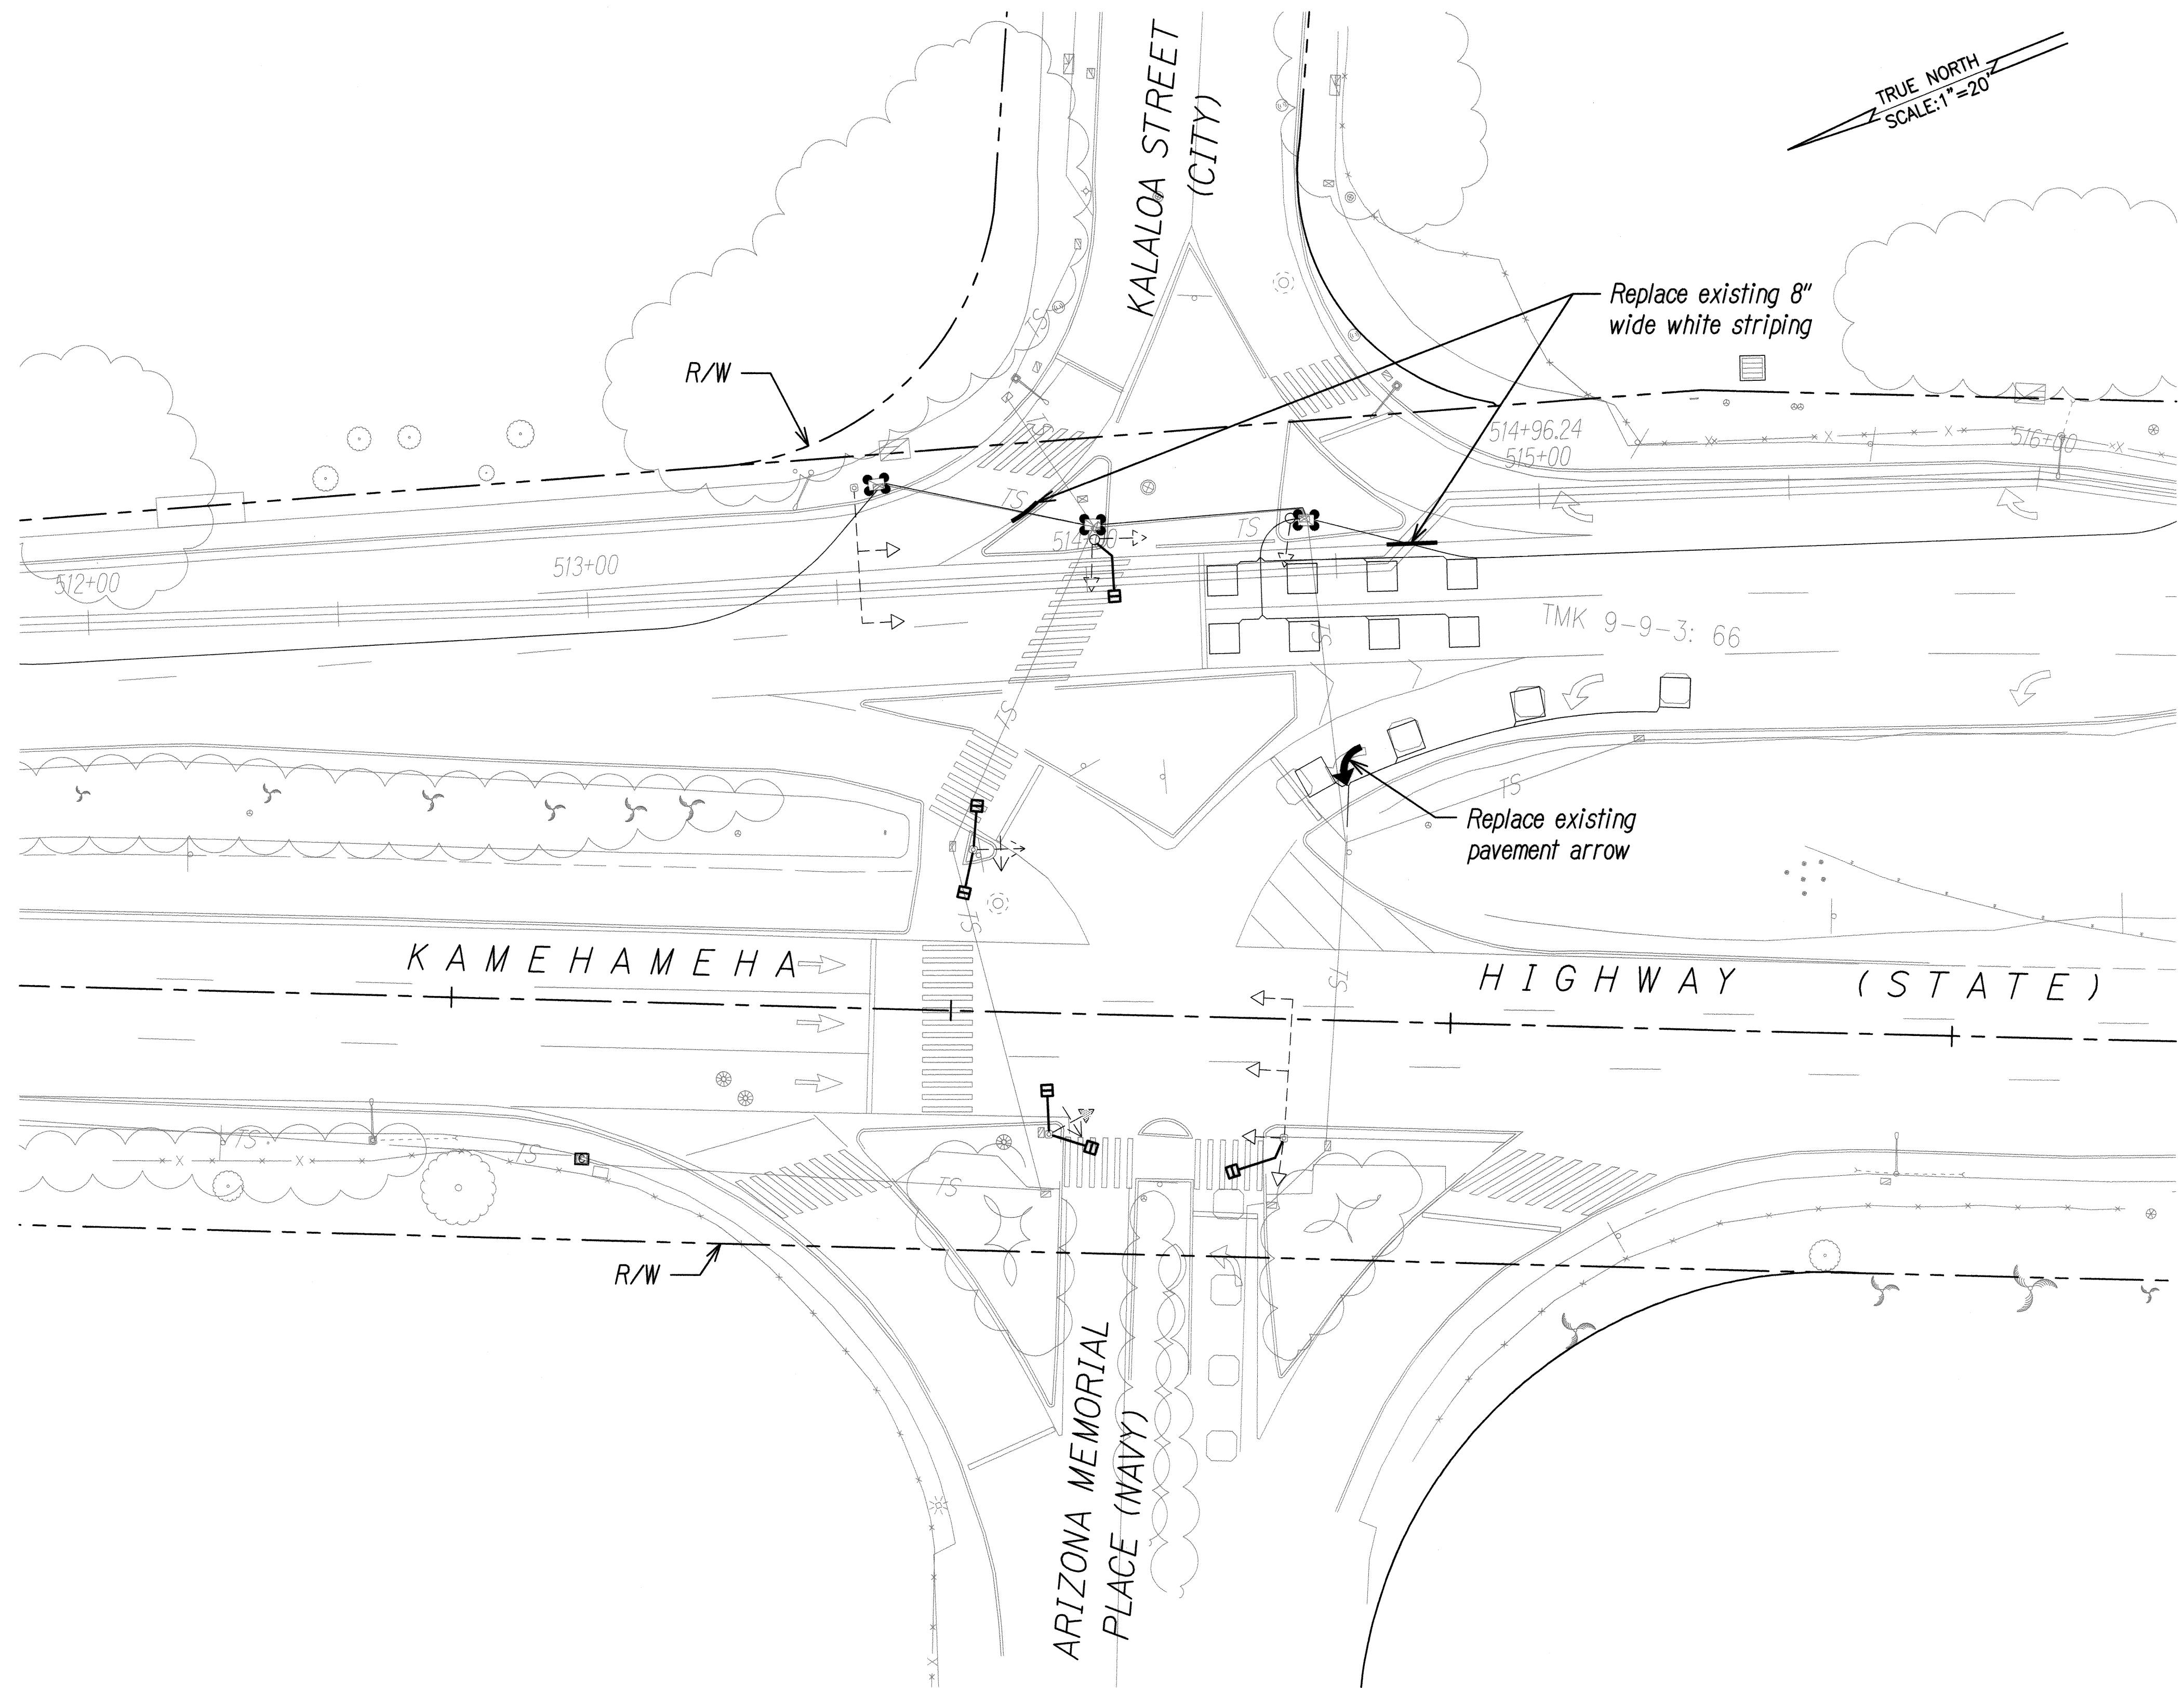

KEY MAP
Not to Scale

DESIGNED BY	DATE
TRACED BY	
DESIGNED BY	
QUANTITIES BY	
CHECKED BY	

PAVEMENT MARKING PLAN
KAMEHAMEHA HIGHWAY AND KALALOA STREET/ARIZONA MEMORIAL PLACE
SCALE: 1"=20'

KEITH K. NIYA
LICENSED PROFESSIONAL ENGINEER
No. 8226-C
HAWAII, U.S.A.

THIS WORK WAS PREPARED BY ME
OR UNDER MY SUPERVISION

SIGNATURE


STATE OF HAWAII
DEPARTMENT OF TRANSPORTATION
HIGHWAYS DIVISION

PAVEMENT MARKING PLAN

KAMEHAMEHA HIGHWAY
TRAFFIC OPERATIONAL IMPROVEMENTS
VICINITY OF ACACIA ROAD TO CENTER DRIVE
PROJECT NO. 99D/G-01-08

Scale: 1"=20' Date: April 2008

FED. ROAD DIST. NO.	STATE	PROJECT NO.	FISCAL YEAR	SHEET NO.	TOTAL SHEETS
HAWAII	HAW.	99D/G-01-08	2008	17	89

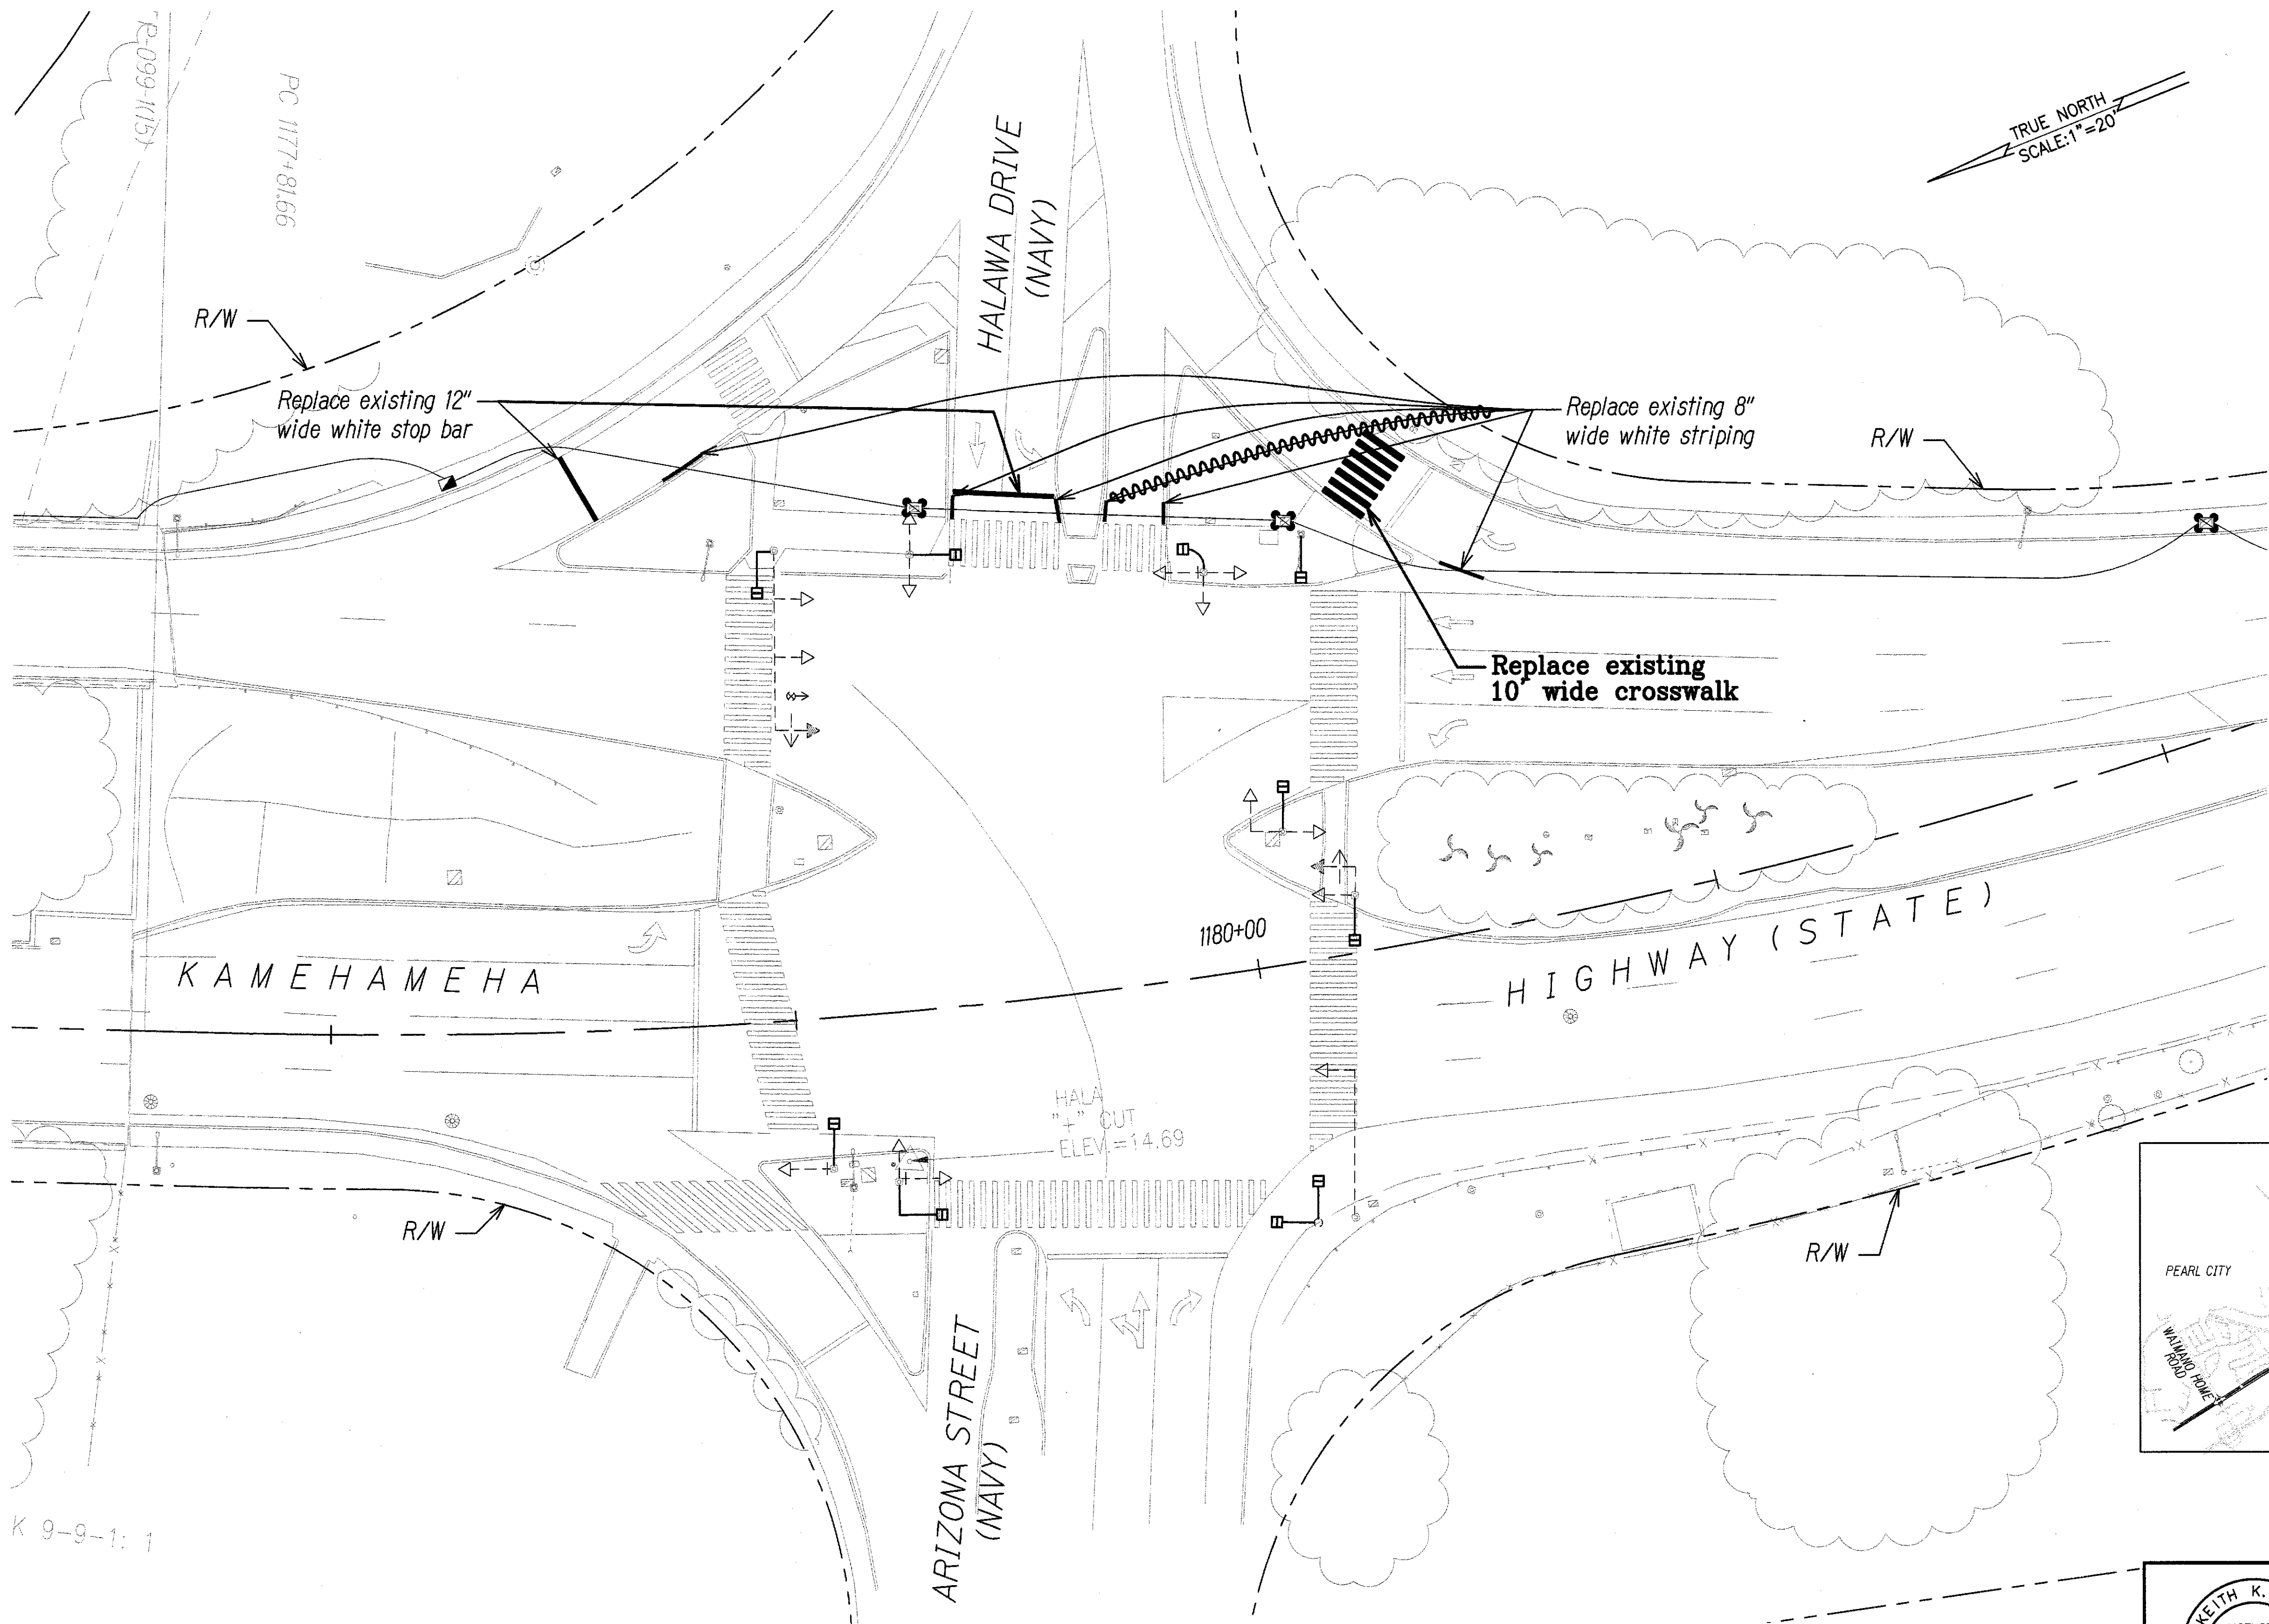


LEGEND FOR AS-BUILT POSTINGS

Squiggly line for as-built deletion

Double line for as-built deletion

Roadway Text for as-built posting

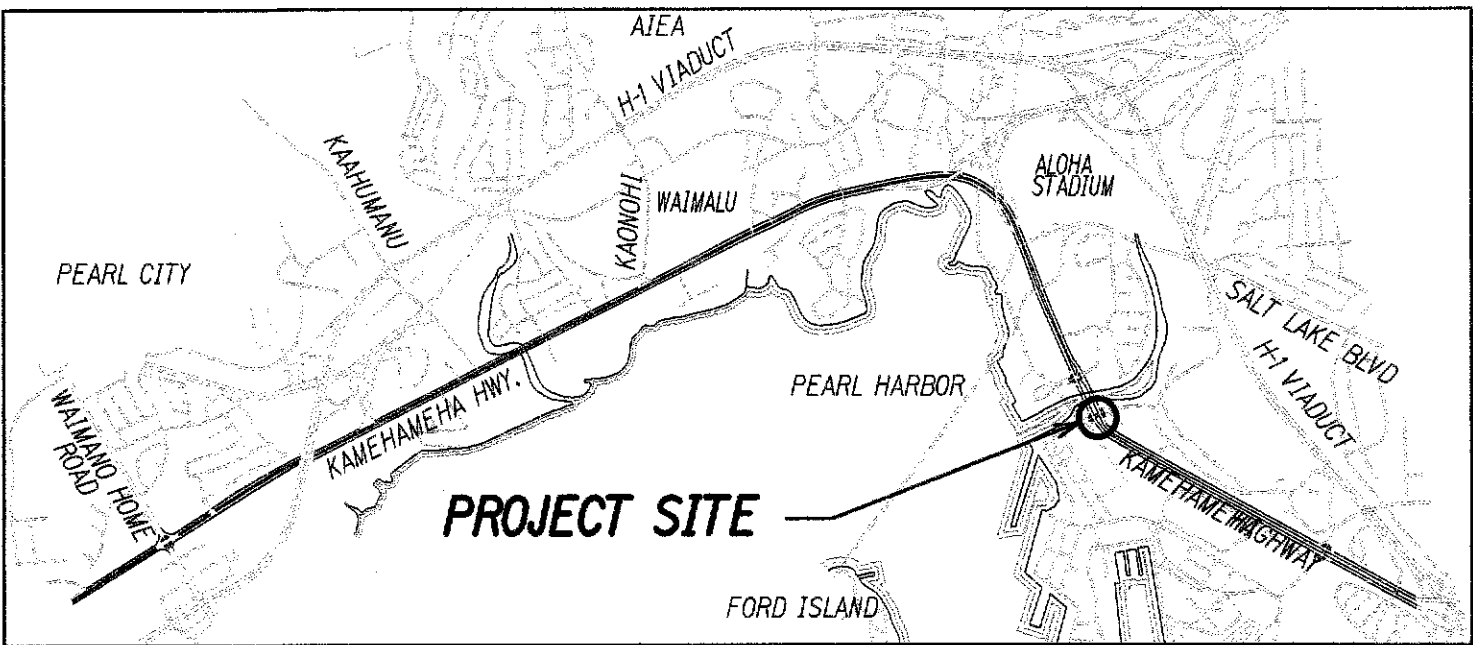

KEY MAP
Not to Scale

DATE	
SURVEY PLOTTED BY	
DRAWN BY	
DESIGNED BY	
QUANTITIES BY	
CHECKED BY	
ORIGINAL PLAN	
NOTE BOOK	
No.	

PAVEMENT MARKING PLAN
KAMEHAMEHA HIGHWAY AND HALAWA DRIVE/ARIZONA STREET
SCALE: 1"=20'

KEITH K. NIHA
LICENSED PROFESSIONAL ENGINEER
No. 8226-C
HAWAII, U.S.A.

THIS WORK WAS PREPARED BY ME OR UNDER MY SUPERVISION

4/30/10

SIGNATURE EXPIRATION DATE OF THE LICENSE

STATE OF HAWAII
DEPARTMENT OF TRANSPORTATION
HIGHWAYS DIVISION



PAVEMENT MARKING PLAN

KAMEHAMEHA HIGHWAY
TRAFFIC OPERATIONAL IMPROVEMENTS
VICINITY OF ACACIA ROAD TO CENTER DRIVE
PROJECT NO. 99D/G-01-08

Scale: 1"=20' Date: April 2008

SHEET No. C-07 OF 9 SHEETS

FED. ROAD DIST. NO.	STATE	PROJECT NO.	FISCAL YEAR	SHEET NO.	TOTAL SHEETS
HAWAII	HAW.	99D/G-01-08	2008	18	89

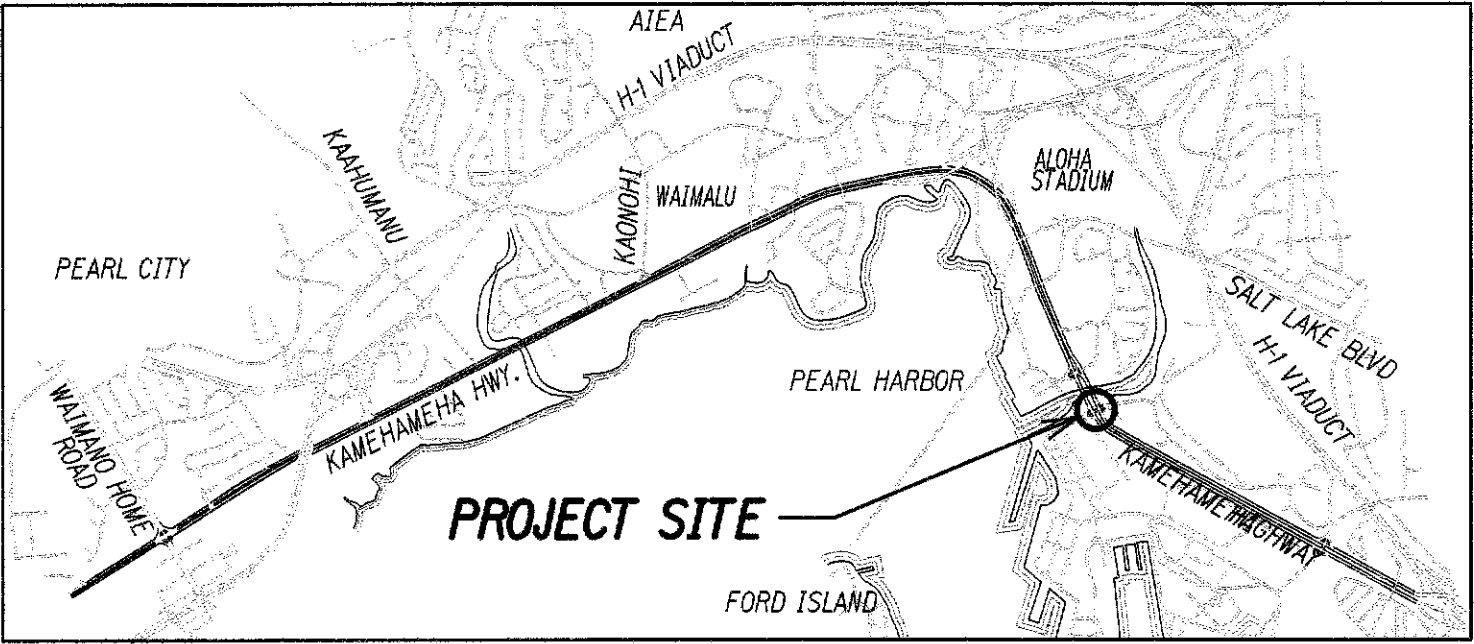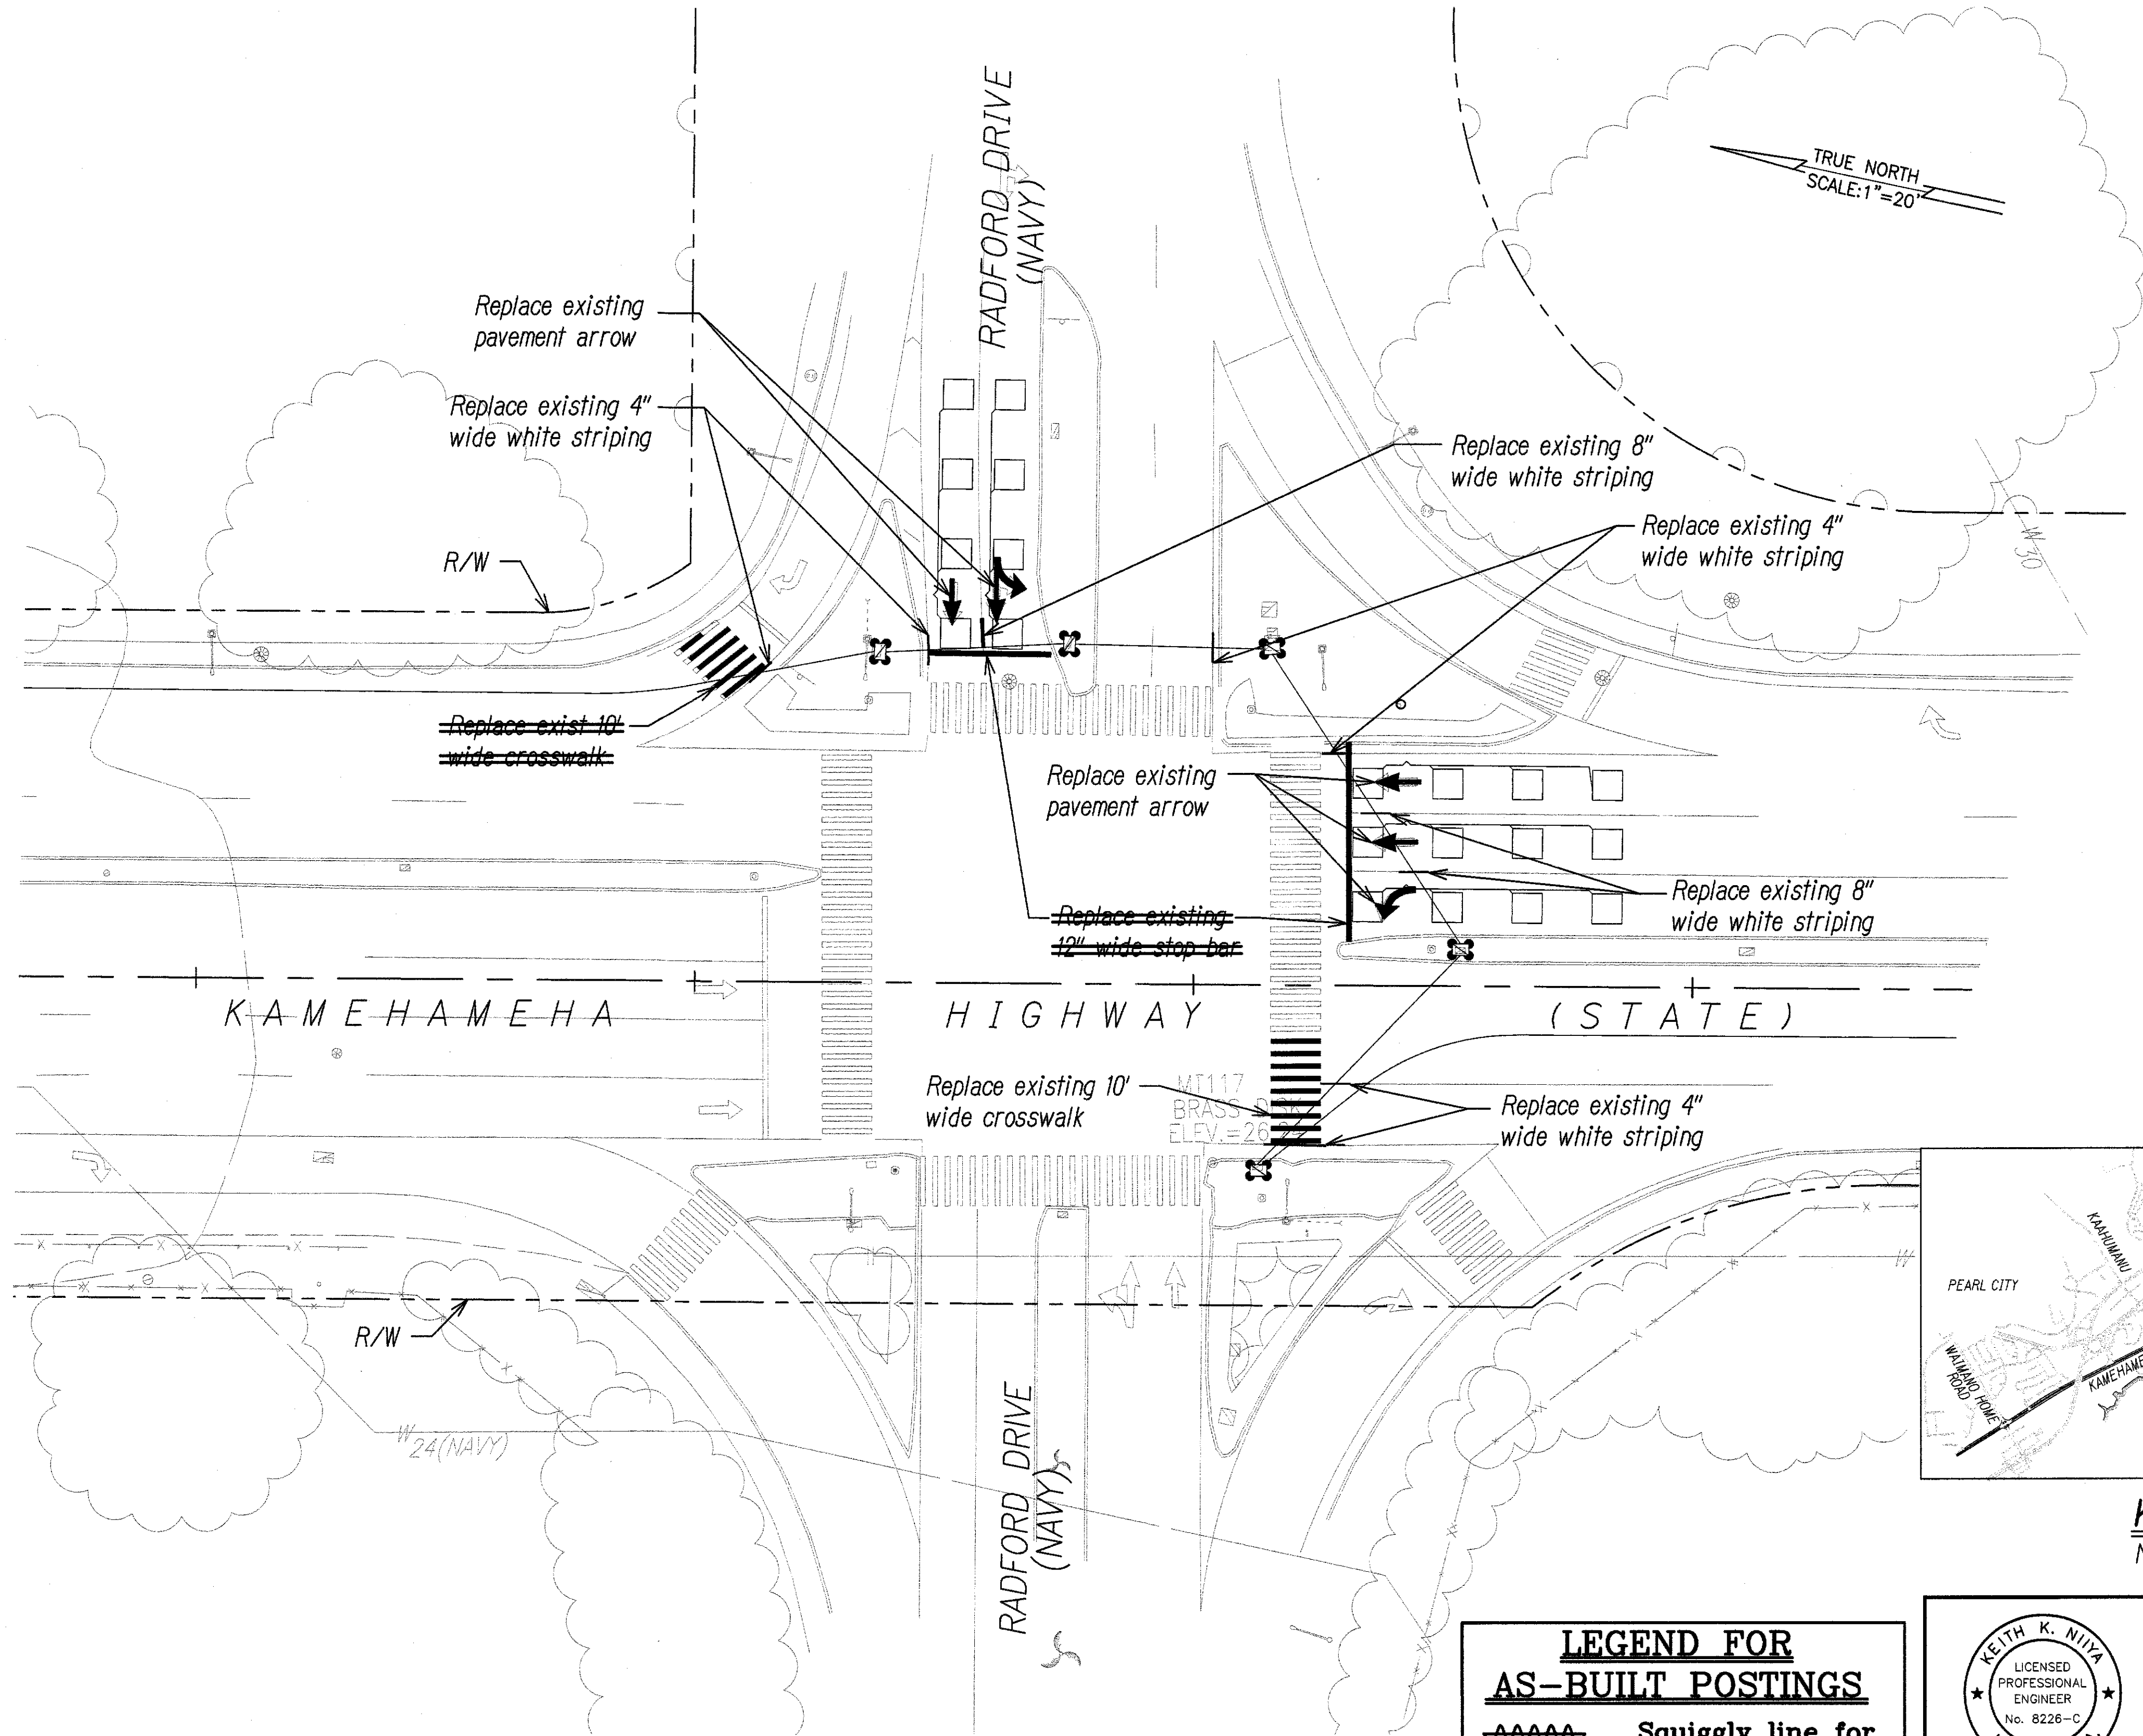

KEY MAP
Not to Scale

DATE	
DESIGNED BY	
NOTED BY	
CHECKED BY	
APPROVED BY	
DATE	

09/18/08 CUB SS RADFORD DRIVING

PAVEMENT MARKING PLAN
KAMEHAMEHA HIGHWAY AND RADFORD DRIVE
SCALE: 1"=20'

LEGEND FOR AS-BUILT POSTINGS

~~~~~ Squiggly line for as-built deletion

== Double line for as-built deletion

Roadway Text for as-built posting

**KEITH K. NIYA**  
LICENSED PROFESSIONAL ENGINEER  
No. 8226-C  
HAWAII, U.S.A.

THIS WORK WAS PREPARED BY ME OR UNDER MY SUPERVISION

Signature: [Signature] Date: 4/30/10

EXPIRATION DATE OF THE LICENSE

STATE OF HAWAII  
DEPARTMENT OF TRANSPORTATION  
HIGHWAYS DIVISION

**PAVEMENT MARKING PLAN**



KAMEHAMEHA HIGHWAY  
TRAFFIC OPERATIONAL IMPROVEMENTS  
VICINITY OF ACACIA ROAD TO CENTER DRIVE  
PROJECT NO. 99D/G-01-08

Scale: 1"=20' Date: April 2008

SHEET No. C-08 OF 9 SHEETS



| FED. ROAD DIST. NO. | STATE | PROJECT NO. | FISCAL YEAR | SHEET NO. | TOTAL SHEETS |
|---------------------|-------|-------------|-------------|-----------|--------------|
| HAWAII              | HAW.  | 99D/G-01-08 | 2008        | 19        | 89           |

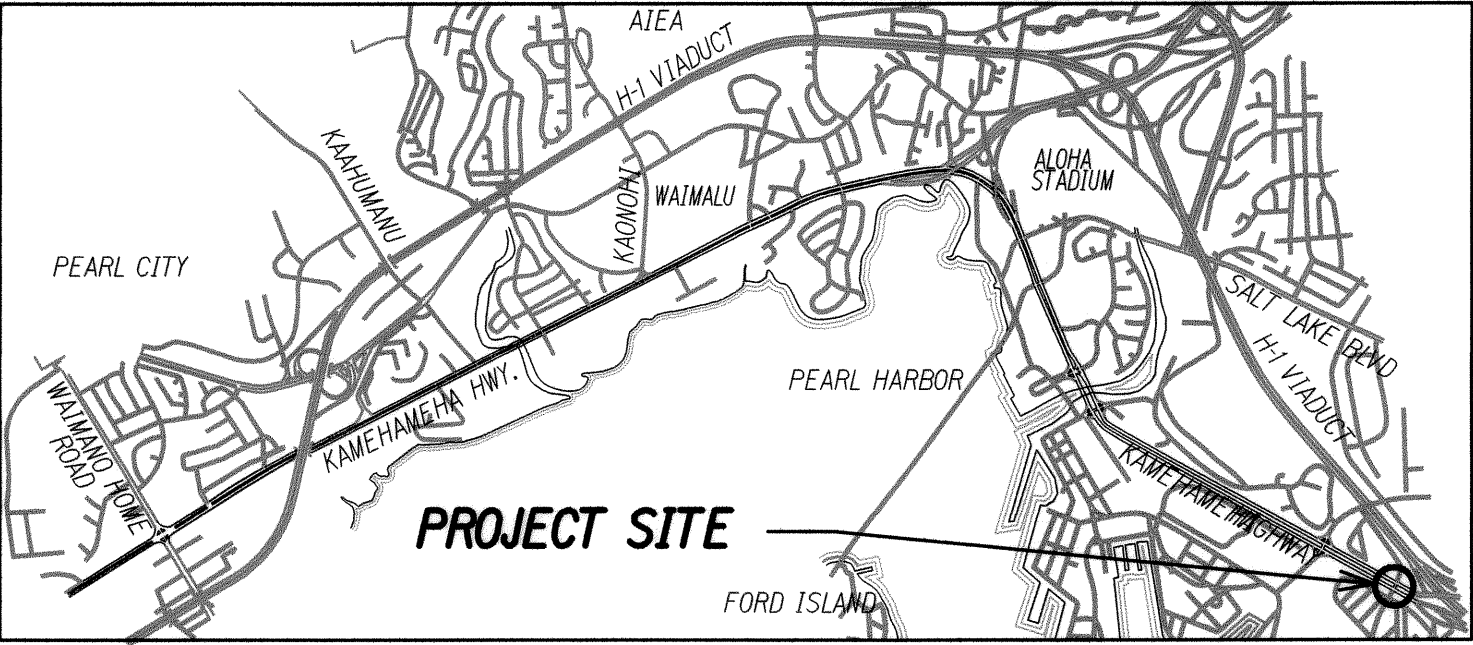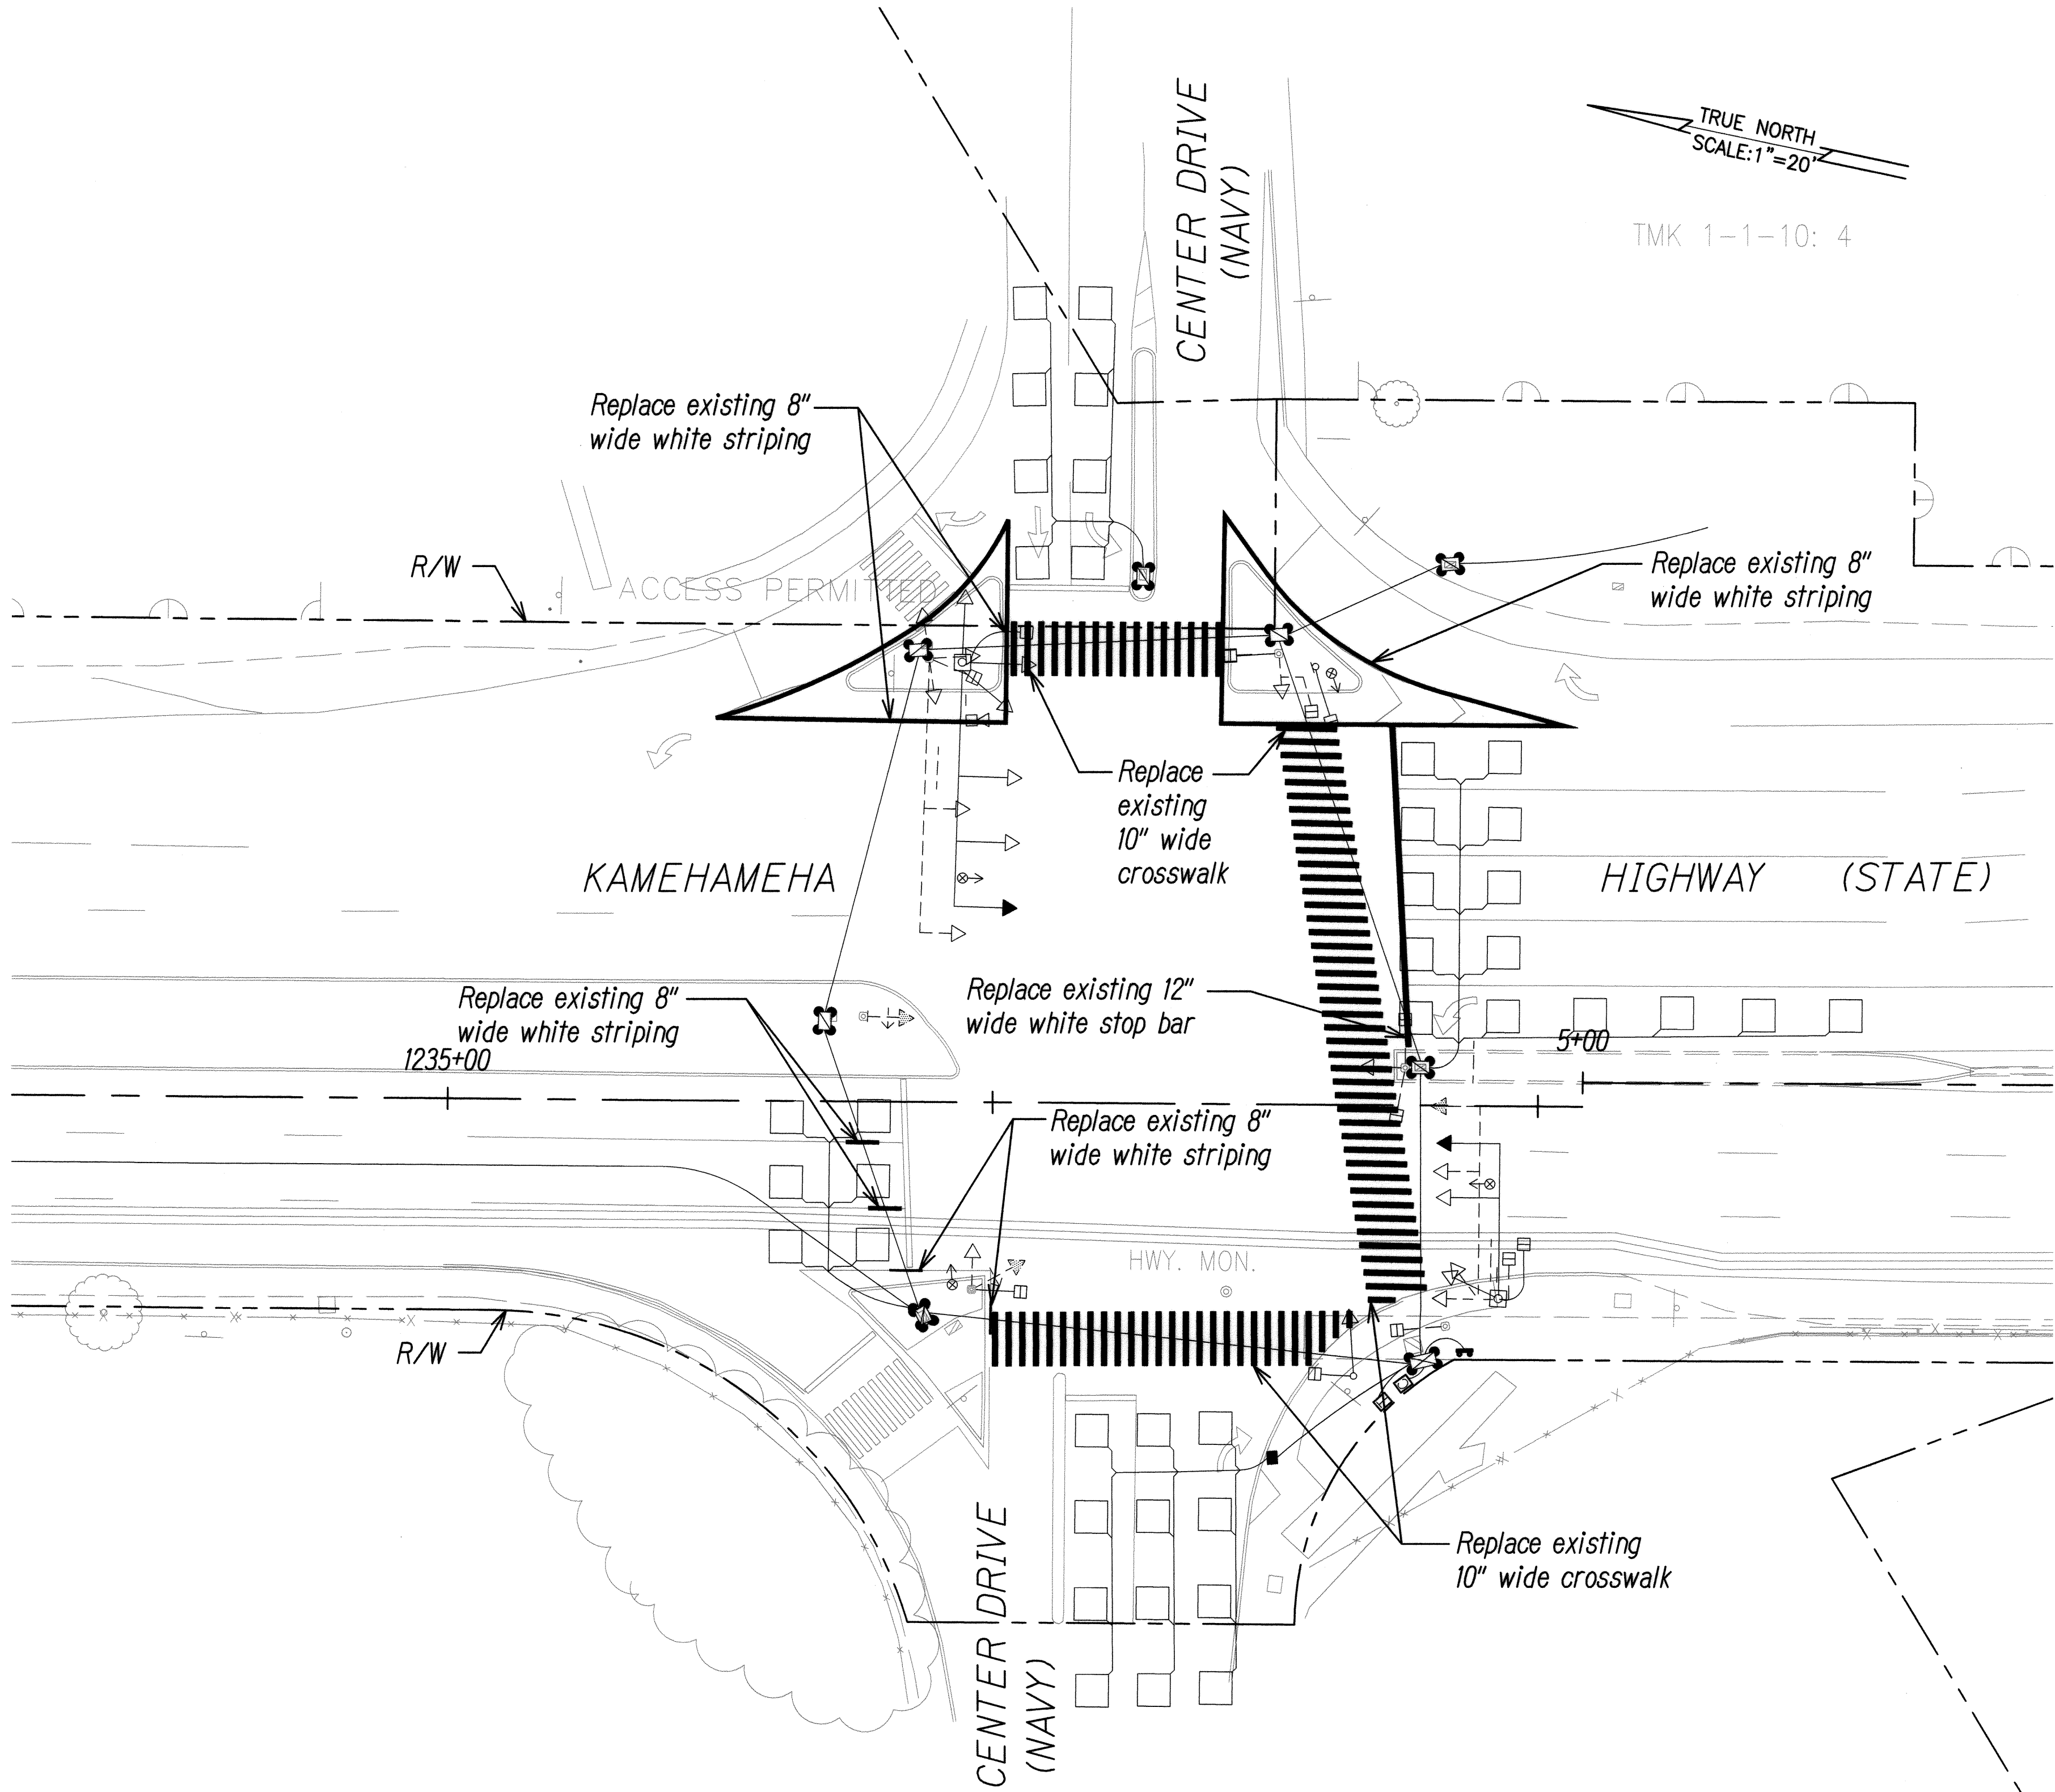

**KEY MAP**  
Not to Scale

KEITH K. NIYA  
LICENSED PROFESSIONAL ENGINEER  
No. 8226-C  
HAWAII, U.S.A.

THIS WORK WAS PREPARED BY ME OR UNDER MY SUPERVISION

SIGNATURE: *[Signature]* EXPIRATION DATE OF THE LICENSE: 4/30/10

STATE OF HAWAII  
DEPARTMENT OF TRANSPORTATION  
HIGHWAYS DIVISION

**PAVEMENT MARKING PLAN**

**KAMEHAMEHA HIGHWAY  
TRAFFIC OPERATIONAL IMPROVEMENTS  
VICINITY OF ACACIA ROAD TO CENTER DRIVE  
PROJECT NO. 99D/G-01-08**

Scale: 1"=20' Date: April 2008

|               |      |
|---------------|------|
| DESIGNED BY   | DATE |
| DRAWN BY      |      |
| CHECKED BY    |      |
| NOTED BY      |      |
| QUANTITIES BY |      |
| ORIGINAL PLAN |      |
| No.           |      |

**PAVEMENT MARKING PLAN**  
**KAMEHAMEHA HIGHWAY AND CENTER DRIVE**  
SCALE: 1"=20'