


FED. ROAD DIST. NO.	STATE	PROJECT NO.	FISCAL YEAR	SHEET NO.	TOTAL SHEETS
HAWAII	HAW.	99D/G-01-08	2008	2	89

SHEET NO.	INDEX TO DRAWINGS
DESCRIPTION	
2	TITLE SHEET
3	STANDARD PLAN SUMMARY
4-9	CONSTRUCTION NOTES
10	GENERAL PLAN
11	TEMPORARY WATER POLLUTION, DUST, DUST, EROSION CONTROL
12	PAVEMENT MARKING NOTES
13-19	PAVEMENT MARKING PLAN
20	TRAFFIC SIGNAL NOTES AND LEGEND
21-37	TRAFFIC SIGNAL PLAN
38-48	INTERCONNECT PLAN
49-50	TRAFFIC SIGNAL MISCELLANEOUS DETAILS 1 AND 2
51	TYPE II FOUNDATION DETAILS
52-53	TRENCH DETAILS
54	TRAFFIC SIGNAL PULLBOX DETAILS
55	STREET NAME SIGN DETAILS
56	TRAFFIC CONTROL NOTES
57-62	TRAFFIC CONTROL PLAN 1 - 5
63	DETOUR PLANS

SUPPLEMENTARY SHEETS TO THIS PROJECT ARE SHEET NOS:
63S-1 through 63S-5


STATE OF HAWAII
DEPARTMENT OF TRANSPORTATION
HIGHWAYS DIVISION
HONOLULU, HAWAII
"AS-BUILT"
PLANS FOR
KAMEHAMEHA HIGHWAY
TRAFFIC OPERATIONAL IMPROVEMENTS
VICINITY OF ACACIA ROAD TO CENTER DRIVE
PROJECT NO. 99D/G-01-08

DISTRICT OF EWA
ISLAND OF OAHU

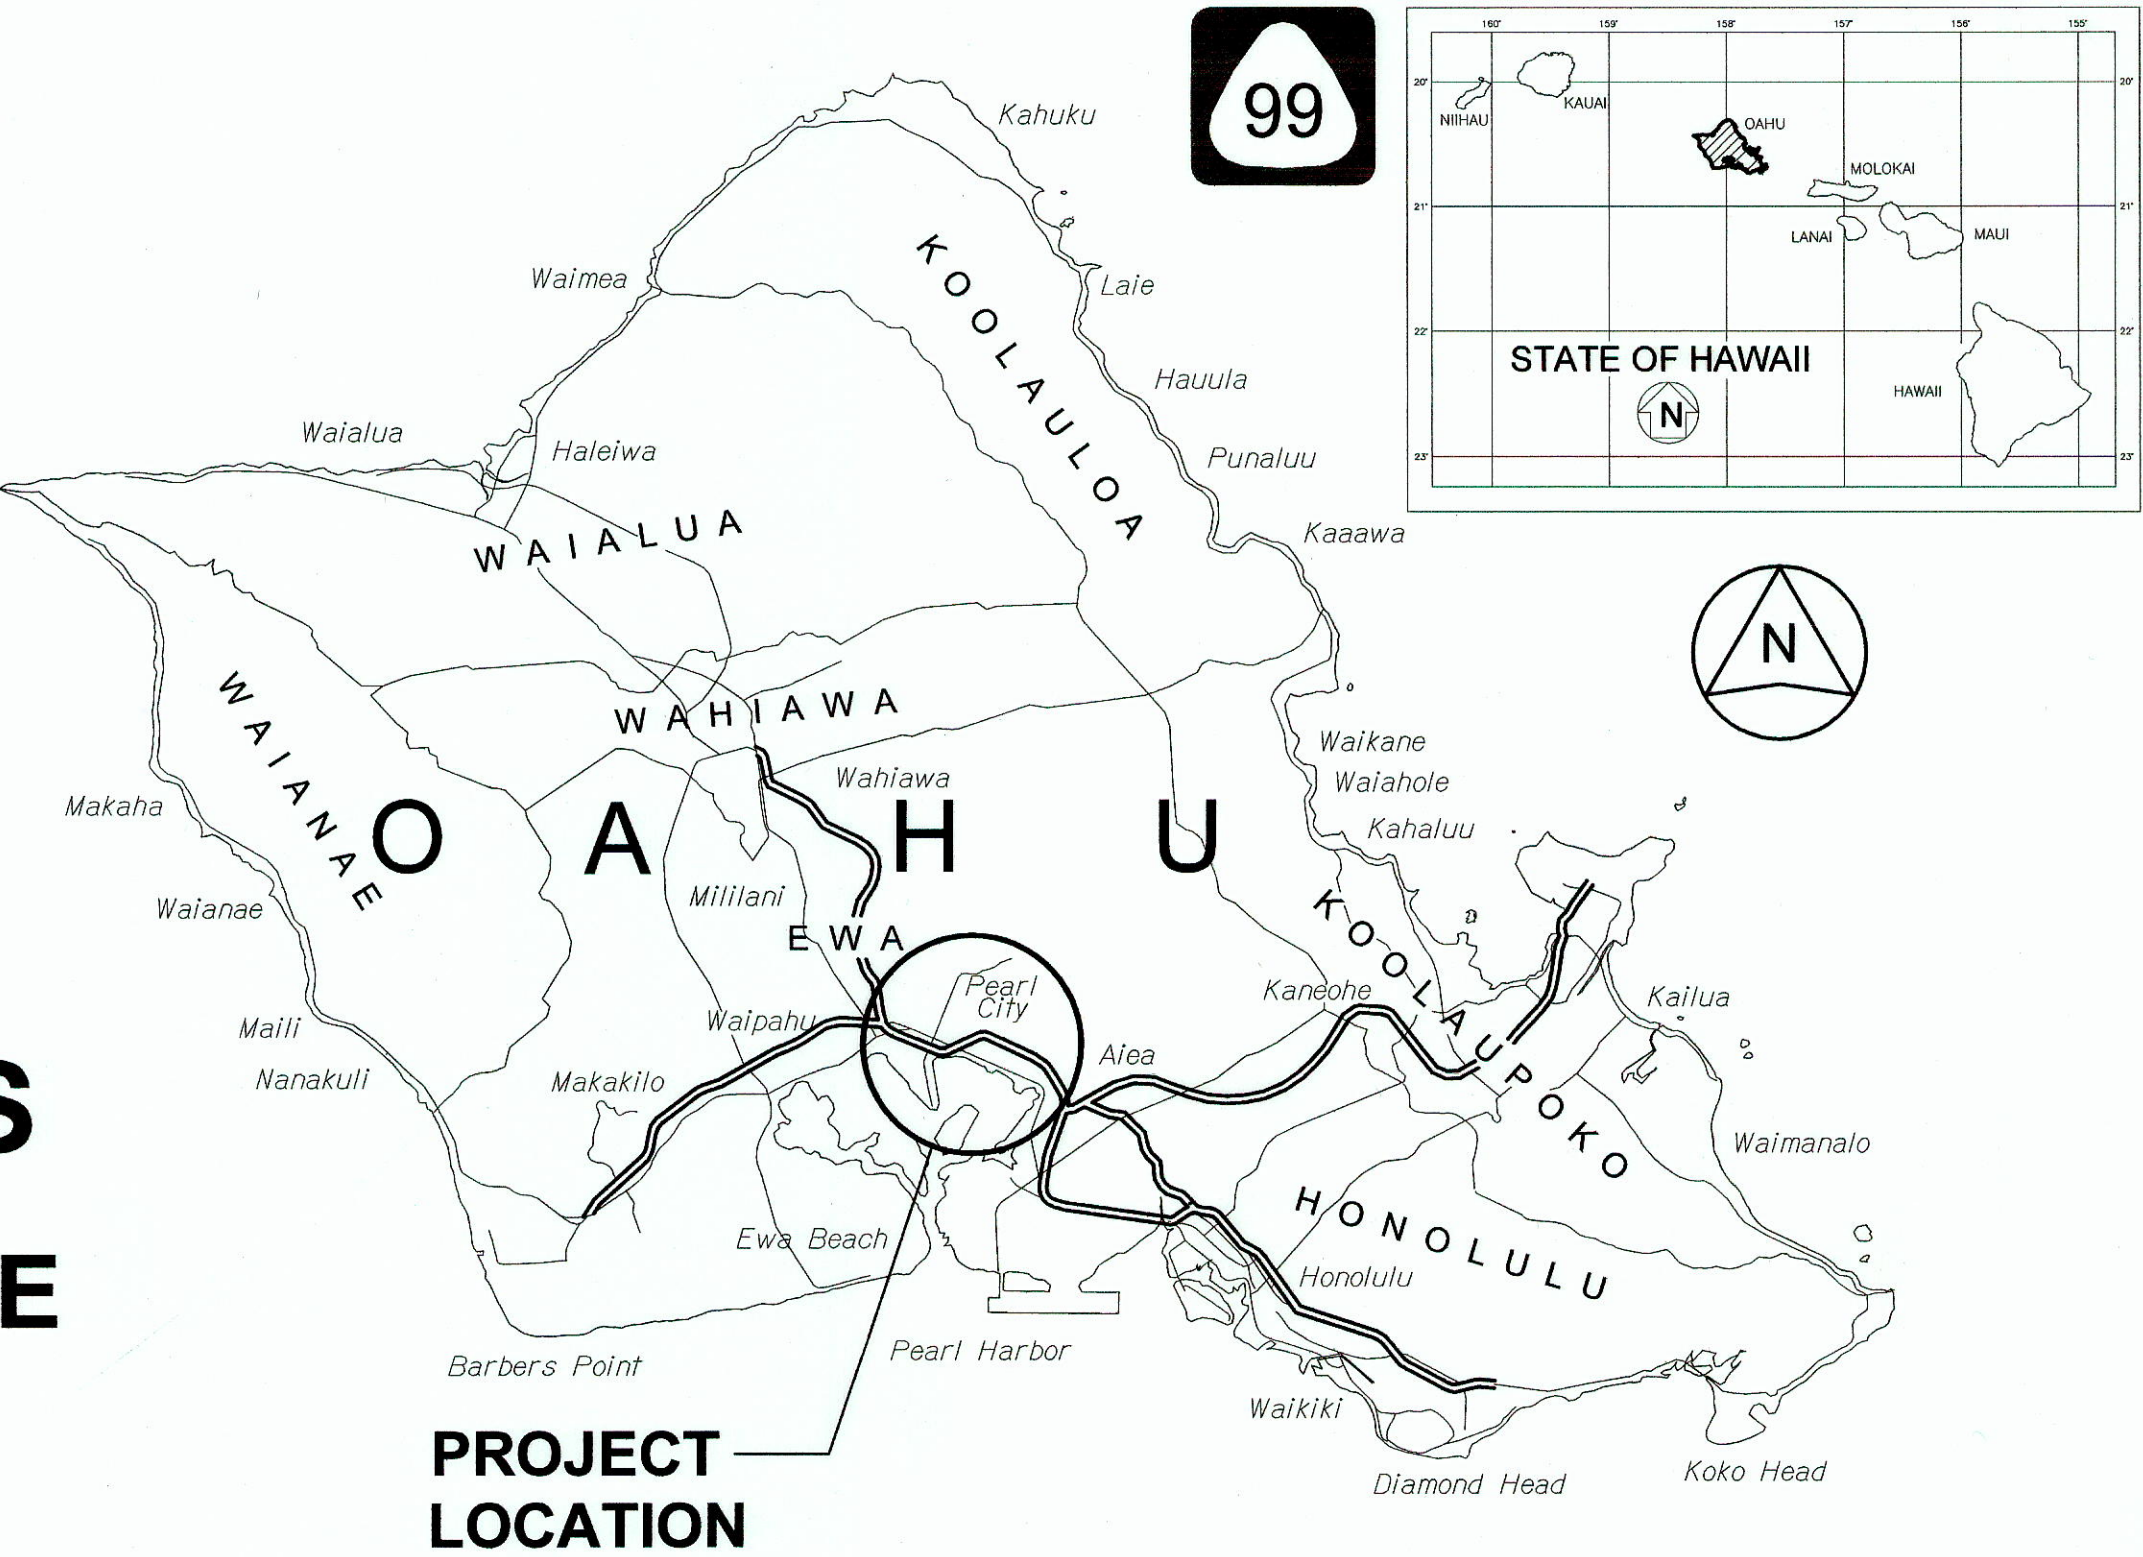

4 0 4 8
SCALE IN MILES

MILE POST 18.3 TO MILE POST 23.2

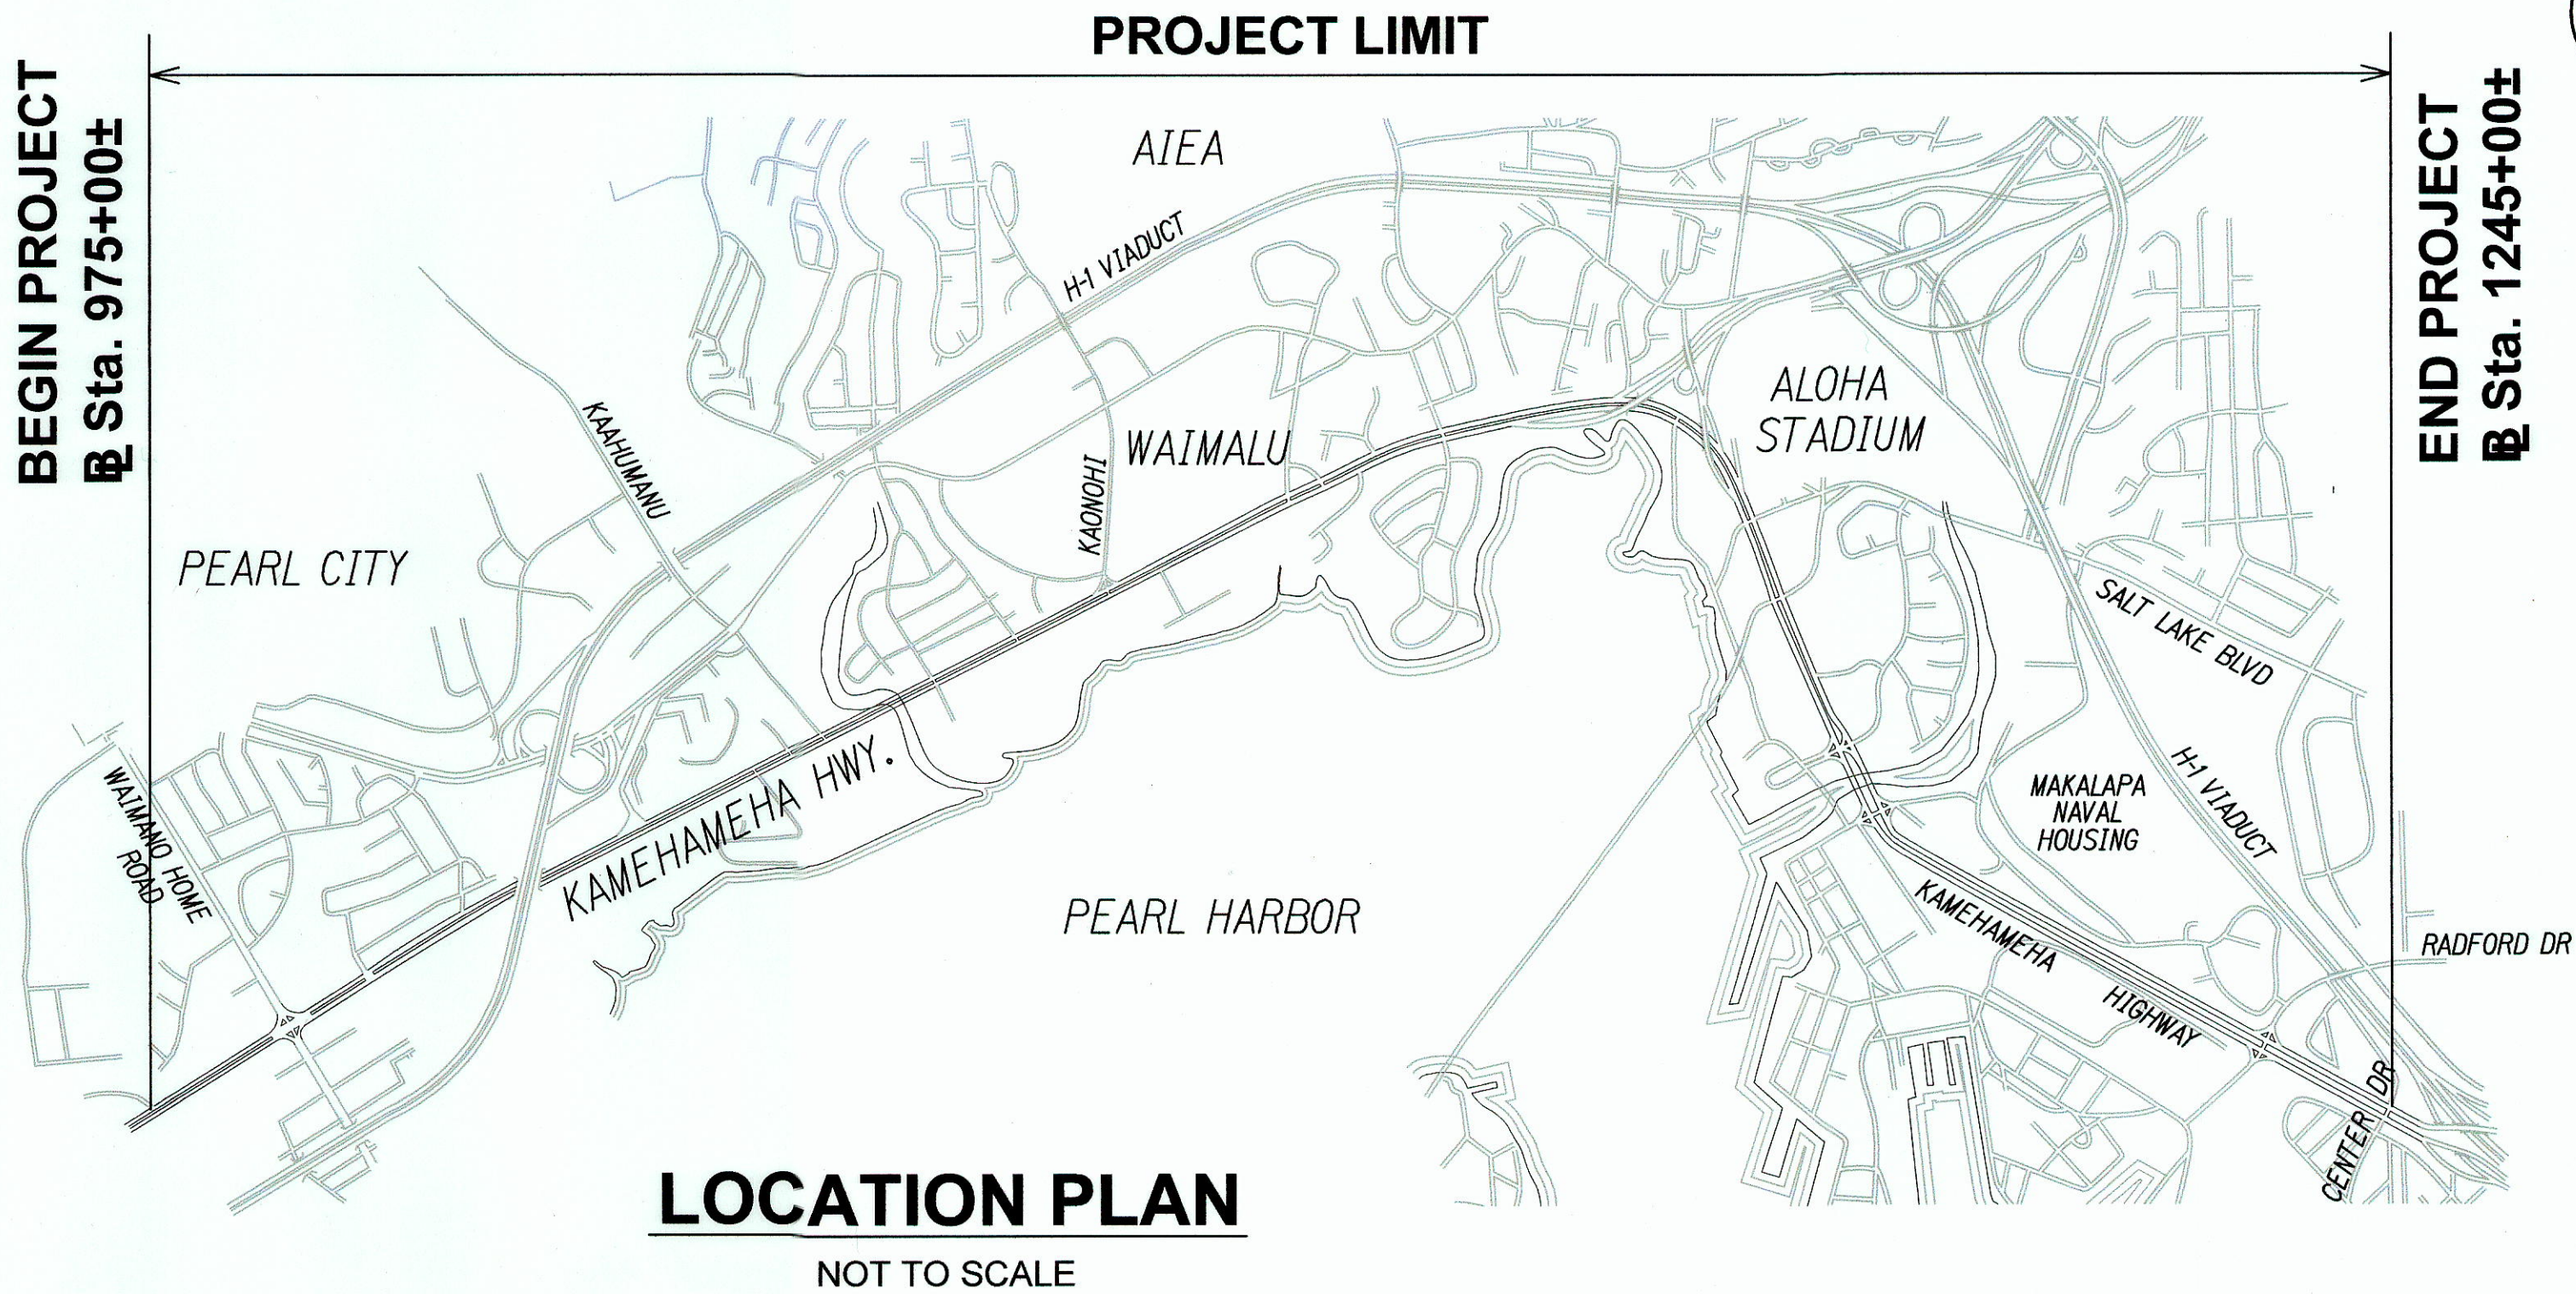

CHANGES MADE DURING CONSTRUCTION HAVE BEEN INCORPORATED ON THESE PLANS EXCEPT CHANGES IN THE ORIGINAL THEORETICAL QUANTITIES. FOR ACTUAL QUANTITIES, REFER TO PROJECT LEDGER AND/OR COMPUTATION BOOK.

Mark C. H. J. 2-12-2015
RESIDENT ENGINEER DATE

DEPARTMENT OF TRANSPORTATION
STATE OF HAWAII
APPROVED: [Signature] 5/13/08
DIR. OF TRANSPORTATION DATE