


INDEX TO DRAWINGS	
SHEET NO.	DESCRIPTION
64	TITLE SHEET
65	STANDARD PLANS SUMMARY
66 - 68	GENERAL NOTES
69 - 71	UTILITY NOTES
72	LEGEND AND ABBREVIATIONS
73 - 84	FENCING PLAN
85 - 86	FENCE DETAILS
87	TRAFFIC CONTROL NOTES AND LEGEND
88 - 89	TRAFFIC CONTROL


FED. ROAD DIST. NO.	STATE	PROJECT NO.	FISCAL YEAR	SHEET NO.	TOTAL SHEETS
HAWAII	HAW.	99D/G-02-08	2008	64	89

STATE OF HAWAII
DEPARTMENT OF TRANSPORTATION
HIGHWAYS DIVISION
HONOLULU, HAWAII
"AS-BUILT"
PLANS FOR
**KAMEHAMEHA HIGHWAY
MEDIAN FENCING IMPROVEMENTS
VICINITY OF ACACIA ROAD TO SALT LAKE BOULEVARD
PROJECT NO. 99D/G-02-08**

DISTRICT OF EWA
ISLAND OF OAHU

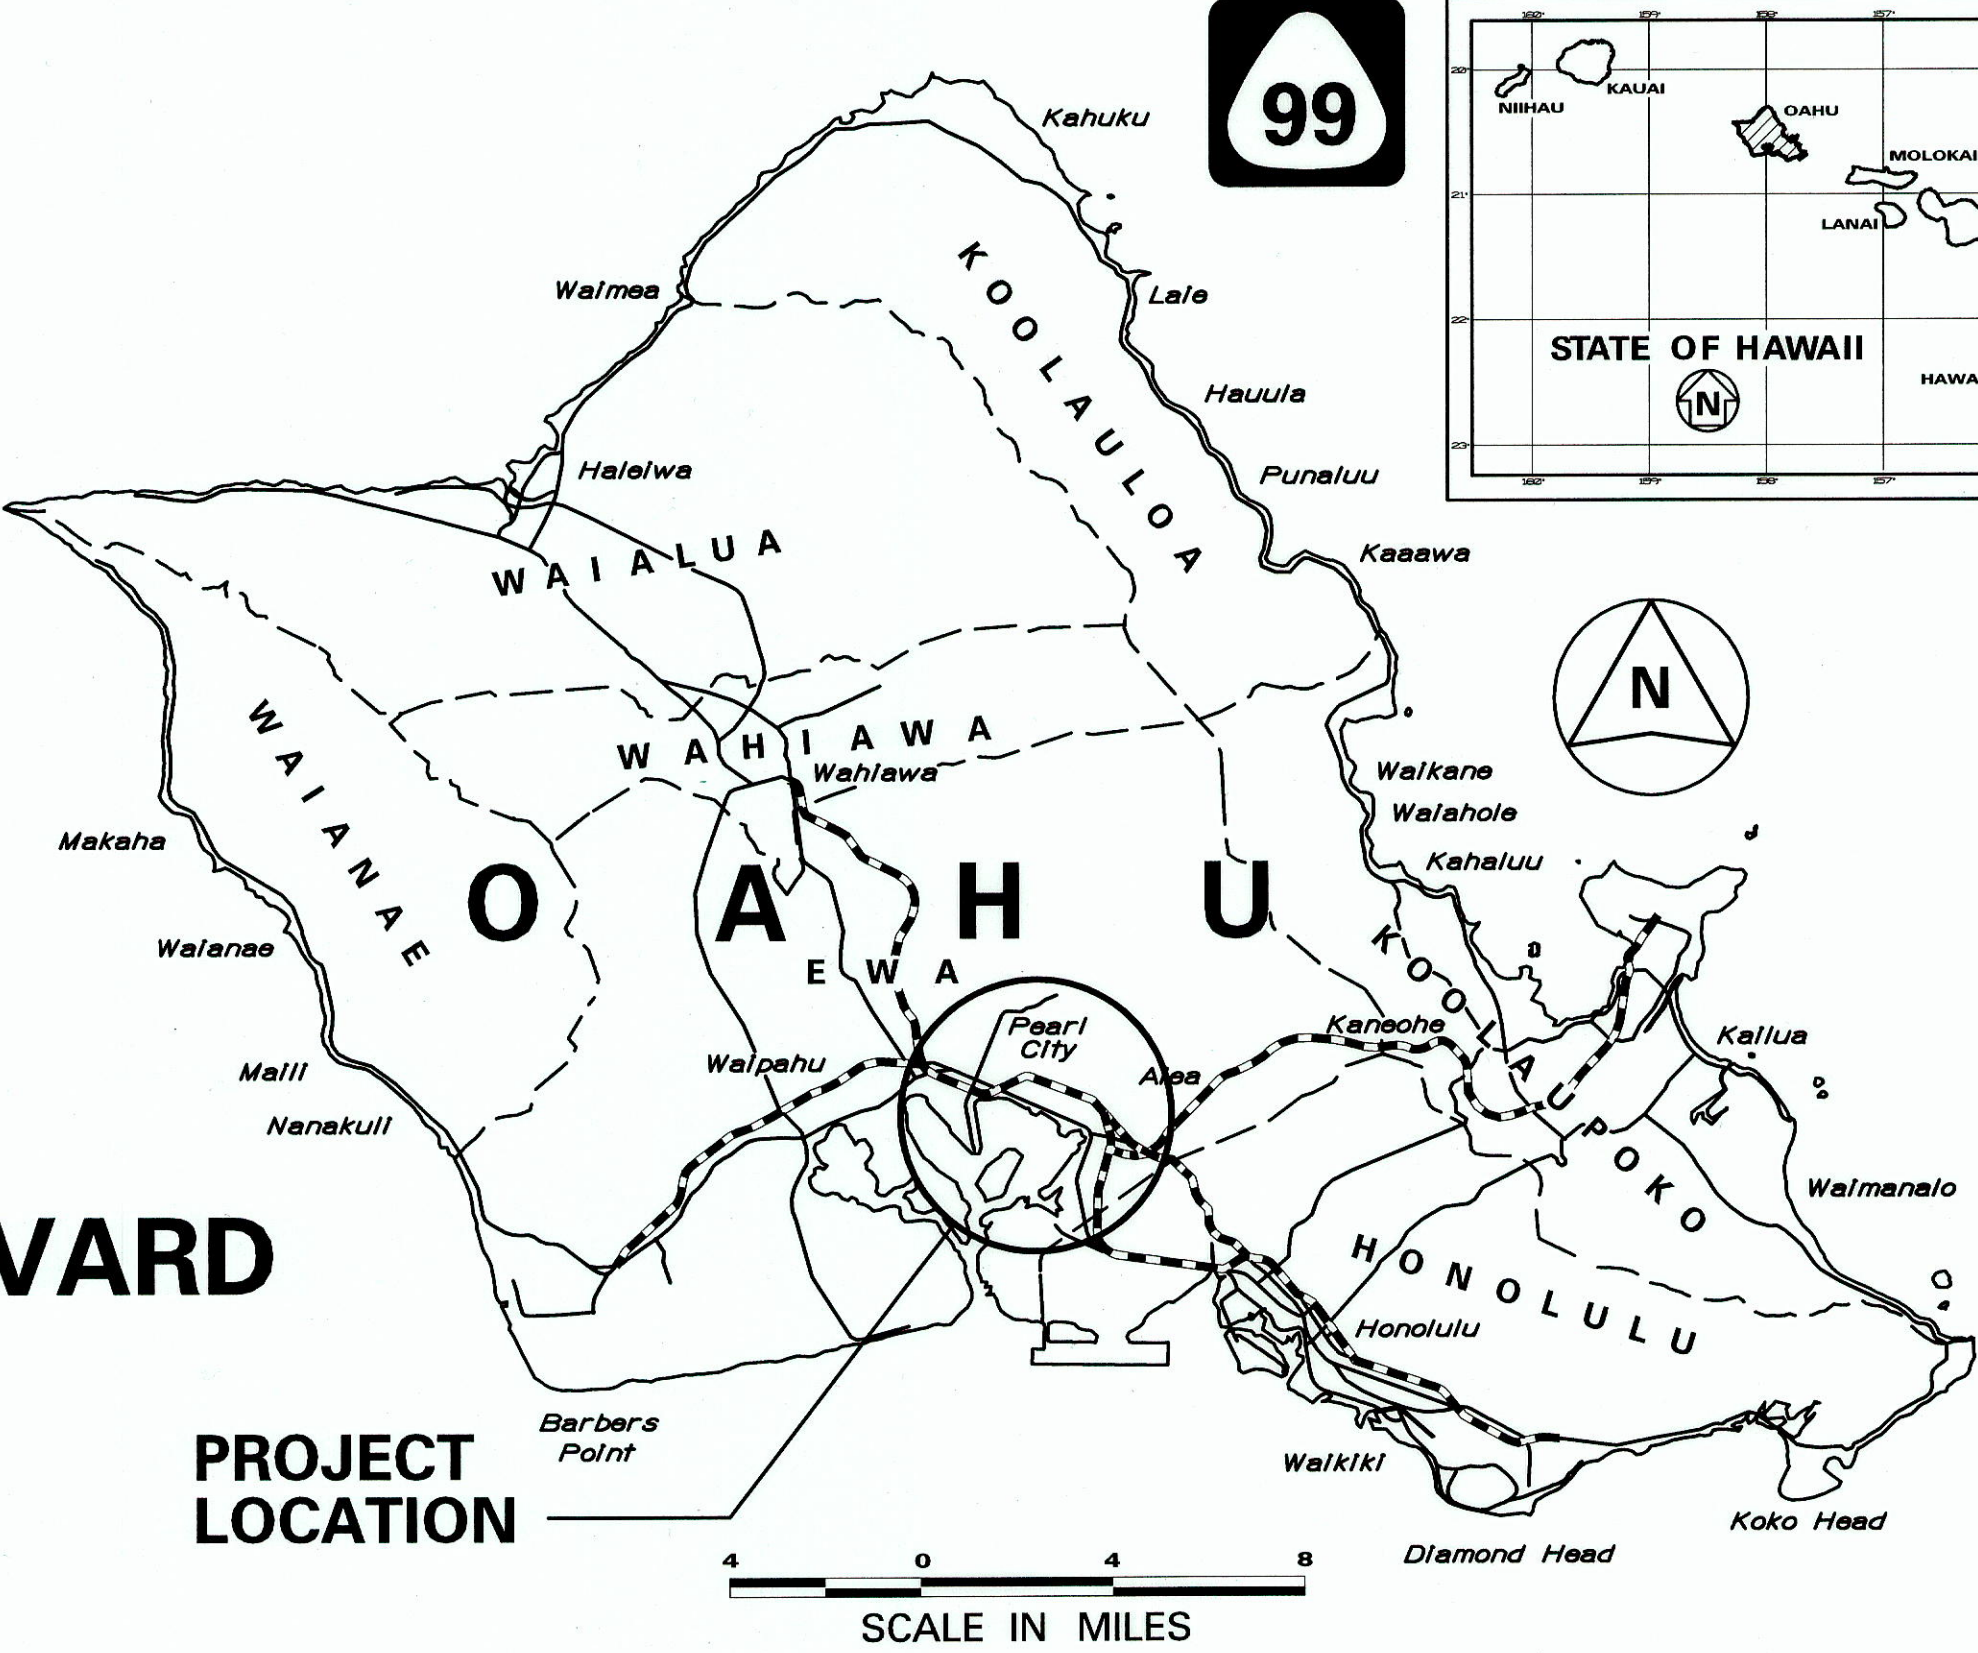

MILE POST 18.3 TO MILE POST 21.6

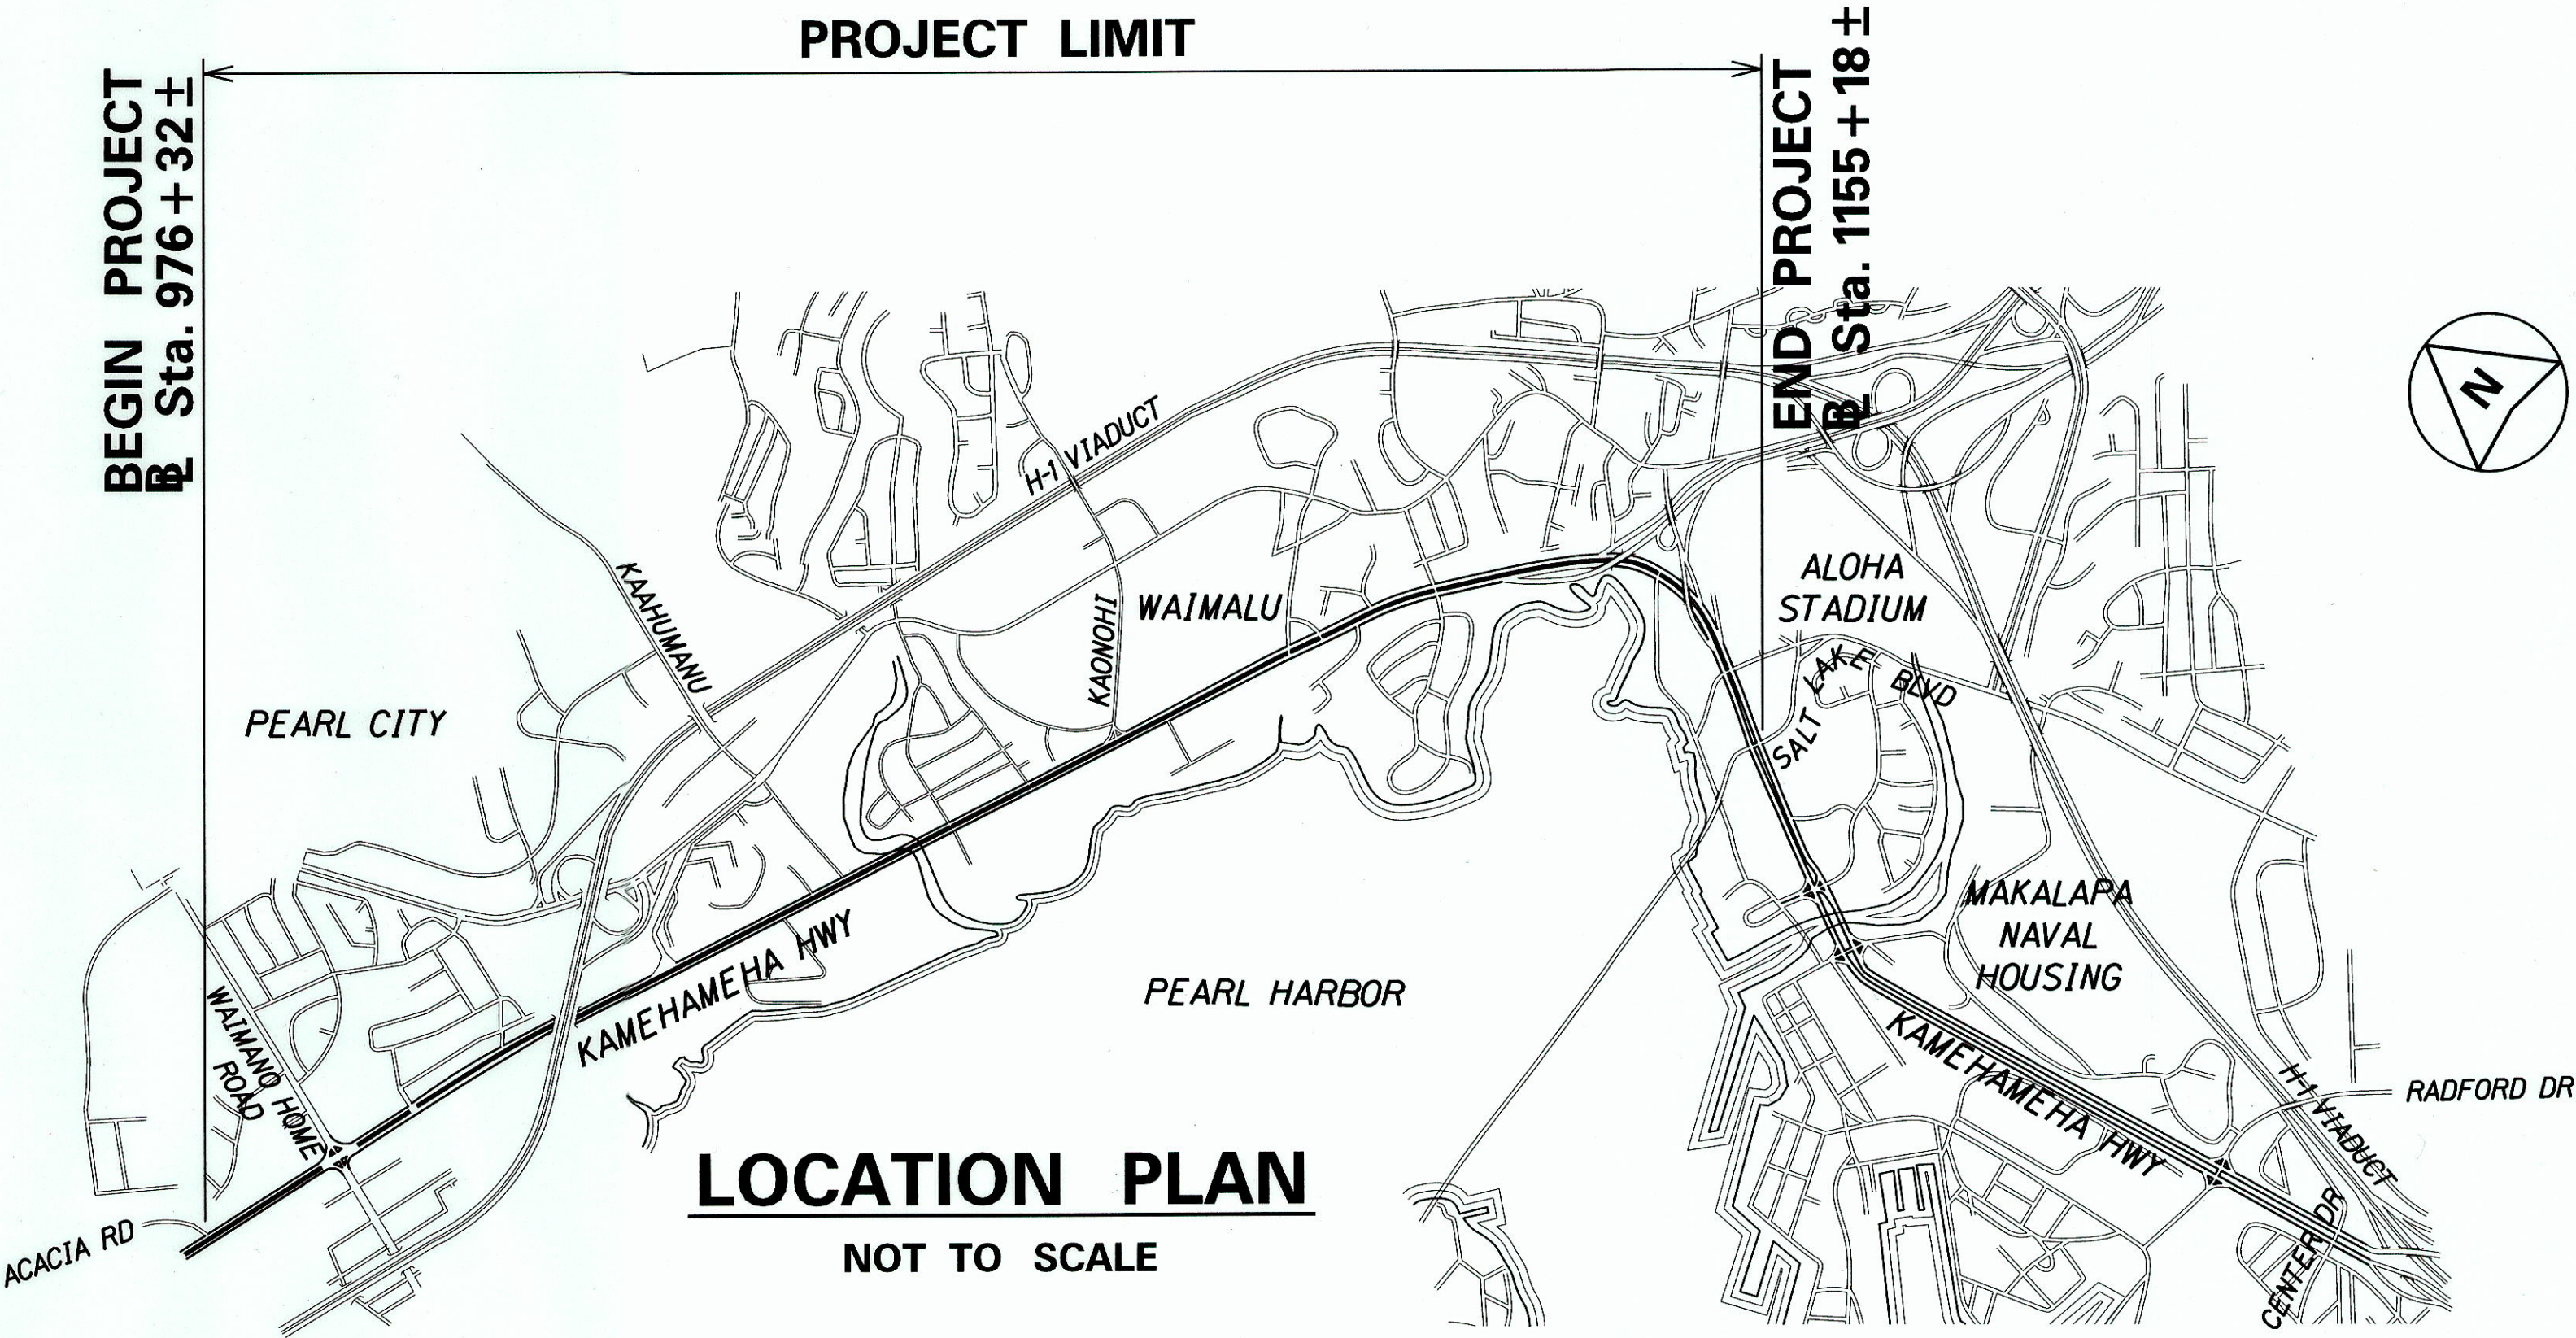

CHANGES MADE DURING CONSTRUCTION HAVE BEEN INCORPORATED ON THESE PLANS EXCEPT CHANGES IN THE ORIGINAL THEORETICAL QUANTITIES. FOR ACTUAL QUANTITIES, REFER TO PROJECT LEDGER AND/OR COMPUTATION BOOK.

Morrin C. A. Juehfeld
RESIDENT ENGINEER
2-12-2015
DATE

DEPARTMENT OF TRANSPORTATION STATE OF HAWAII	
APPROVED:	
<i>Scott J. M.</i>	5/13/08
DIR. OF TRANSPORTATION	DATE

ORIGINAL PLAN	SURVEY PLOTTED BY	DATE
PLAN	DRAWN BY	
NOTE BOOK	TRACED BY	
	QUANTITIES BY	
	CHECKED BY	

PB DESIGNED BY _____ HWY-DS _____ APRIL 2008 _____ DATE
MANAGED BY: _____ PHONE _____