



INDEX TO DRAWINGS	
SHEET NO.	DESCRIPTION
1 TO 63	FEDERAL-AID PROJECT NO. 99D/G-01-08
64 TO 89	FEDERAL-AID PROJECT NO. 99D/G-02-08

FED. ROAD DIST. NO.	STATE	PROJECT NO.	FISCAL YEAR	SHEET NO.	TOTAL SHEETS
HAWAII	HAW.	99D/G-02-08	2008	1	89

STATE OF HAWAII
DEPARTMENT OF TRANSPORTATION
HIGHWAYS DIVISION
HONOLULU, HAWAII
"AS-BUILT"
PLANS FOR
**KAMEHAMEHA HIGHWAY
TRAFFIC OPERATIONAL IMPROVEMENTS
VICINITY OF ACACIA ROAD TO CENTER DRIVE
PROJECT NO. 99D/G-01-08**
AND
**KAMEHAMEHA HIGHWAY
MEDIAN FENCING IMPROVEMENTS
VICINITY OF ACACIA ROAD TO SALT LAKE BOULEVARD
PROJECT NO. 99D/G-02-08**
DISTRICT OF EWA
ISLAND OF OAHU

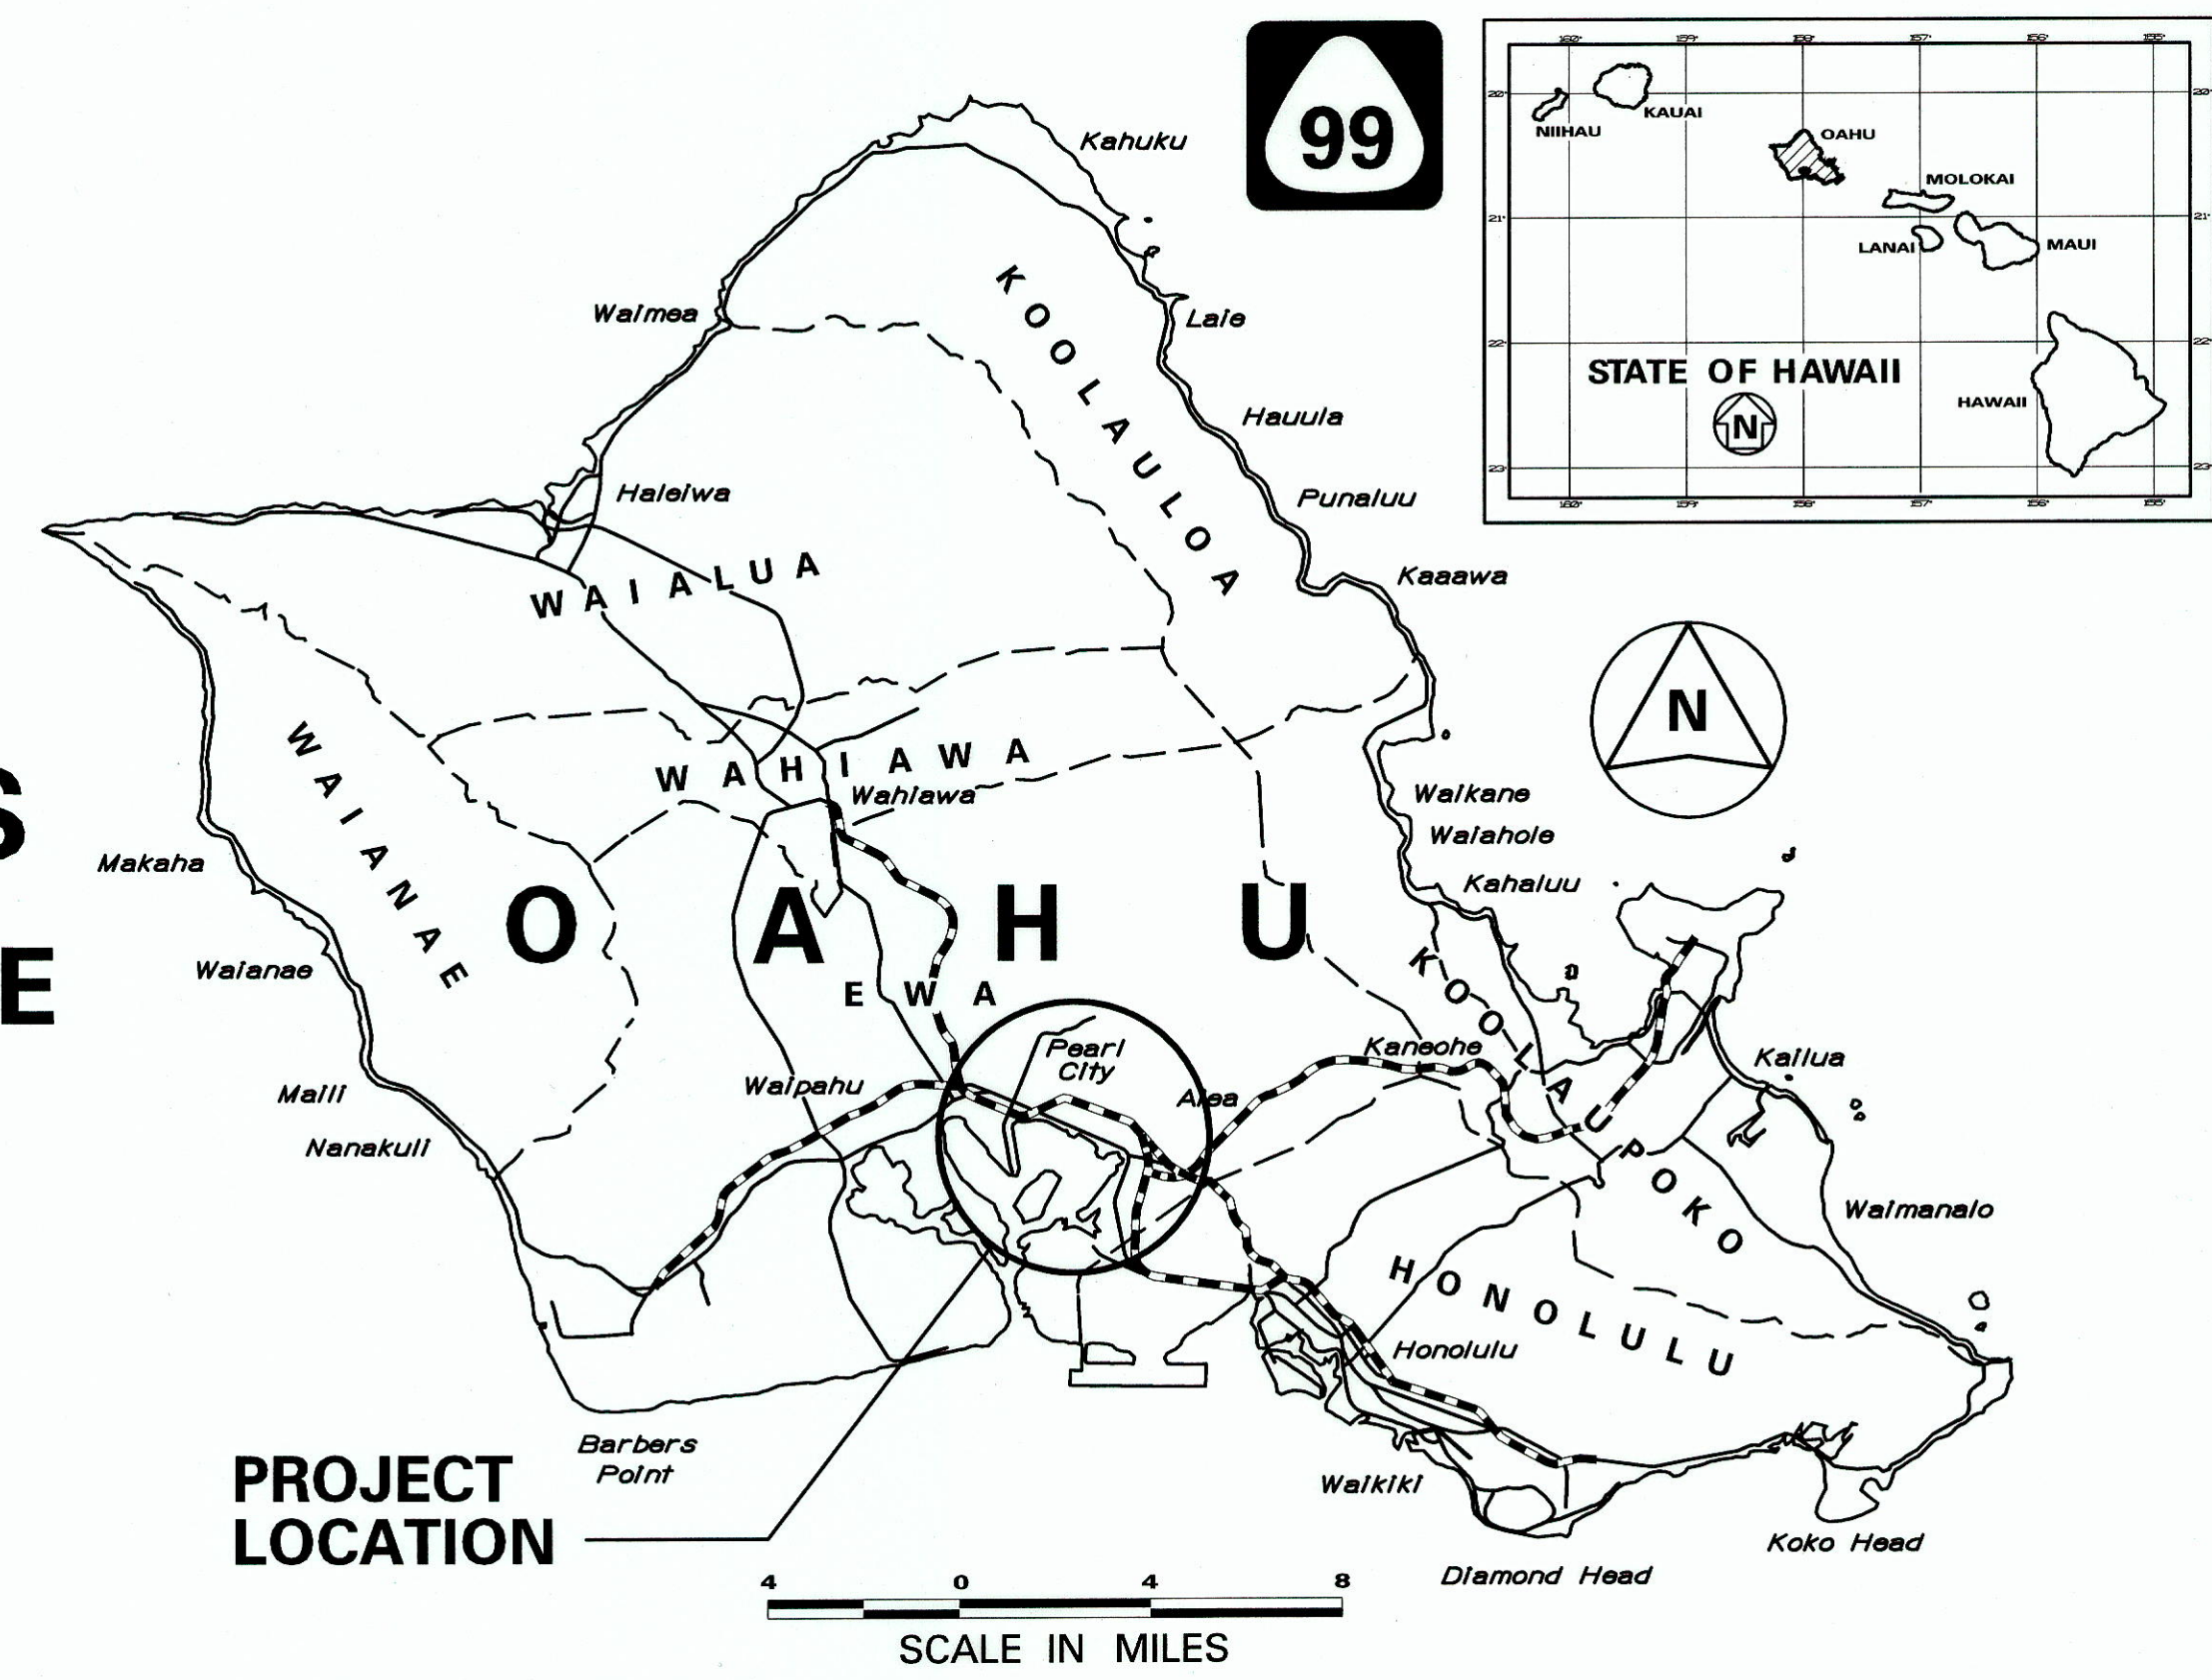

MILE POST 18.3 TO MILE POST 23.32

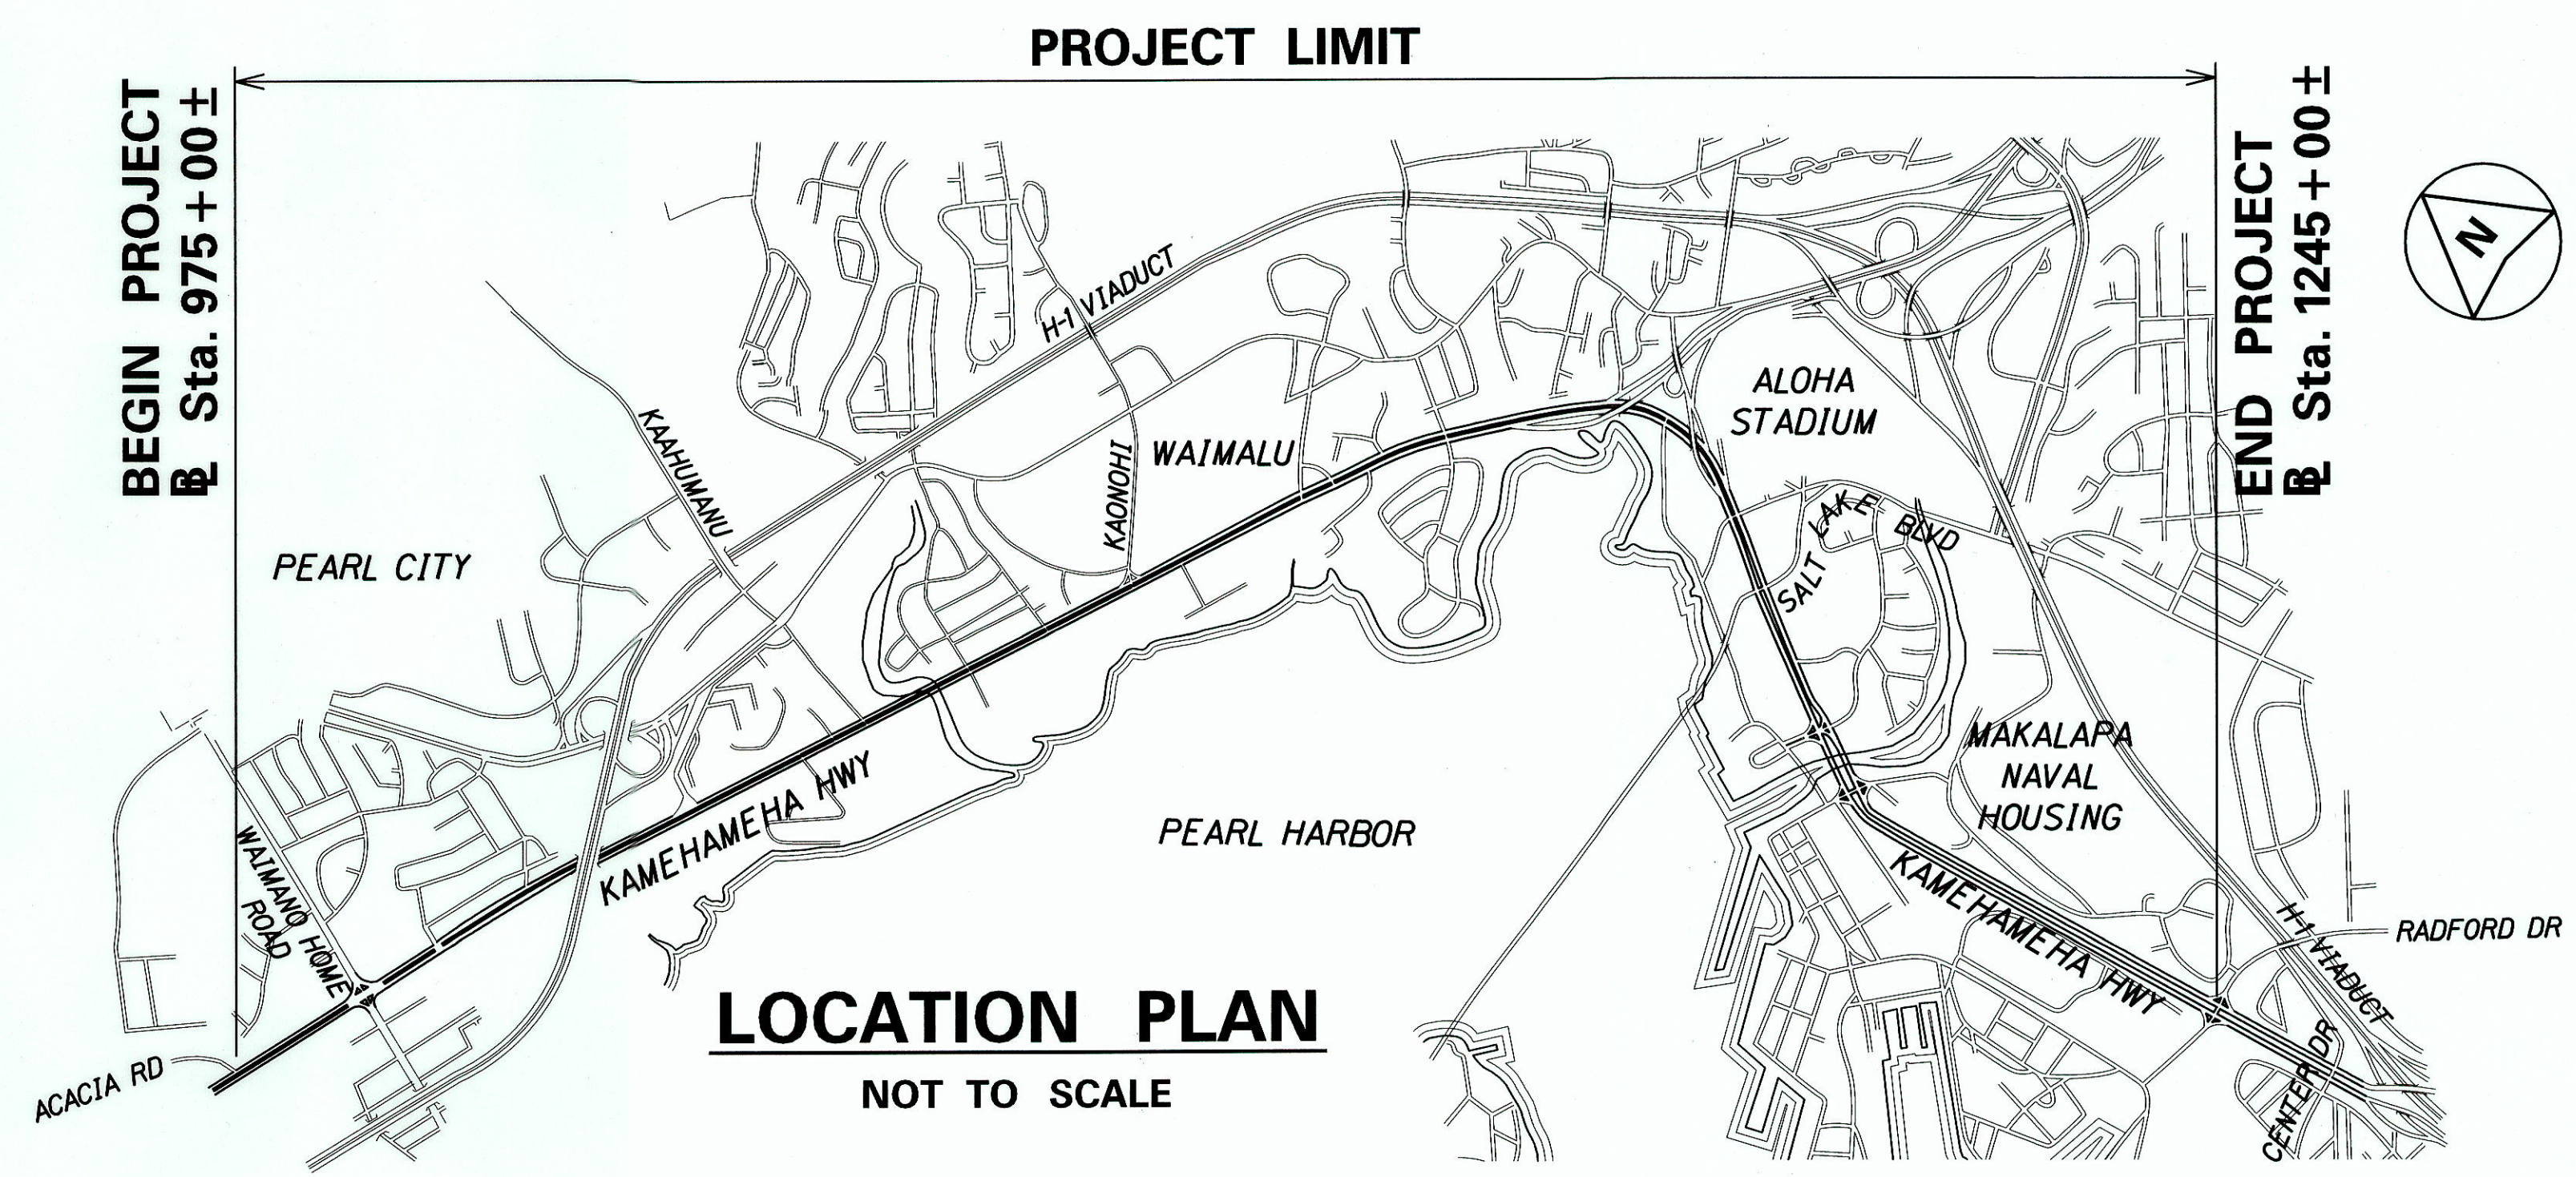

ORIGINAL PLAN	DATE
NOTED BY	
DESIGNED BY	
CHECKED BY	

ATA/PB DESIGNED BY
HWY-DS
692-7544
APRIL 2008
PHONE
DATE