
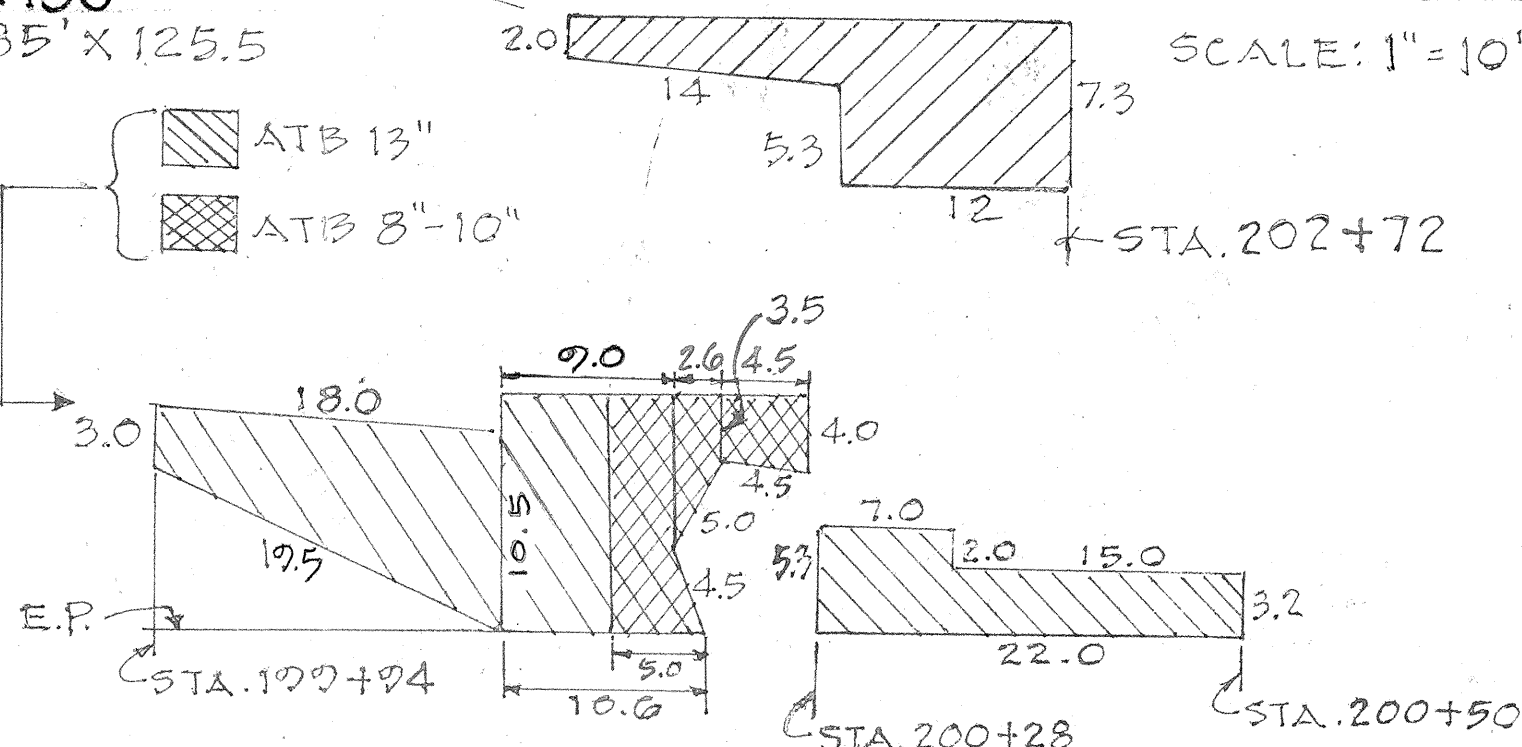
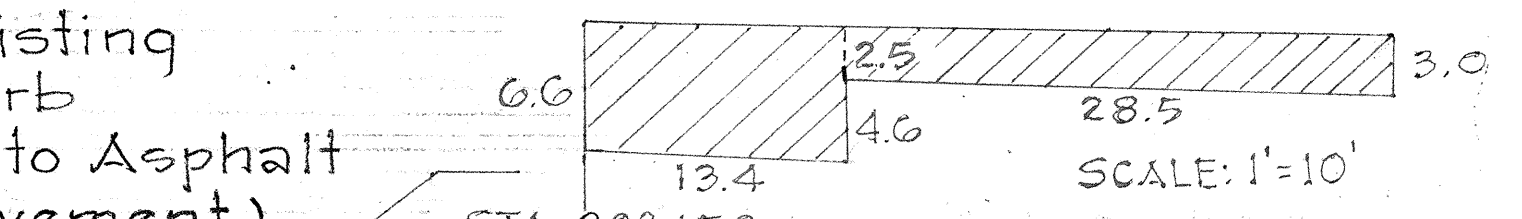


FED. ROAD DIST. NO.	STATE	PROJ. NO.	FISCAL YEAR	SHEET NO.	TOTAL SHEETS
HAWAII	HAW.	90CD-01-74	1974	3	7

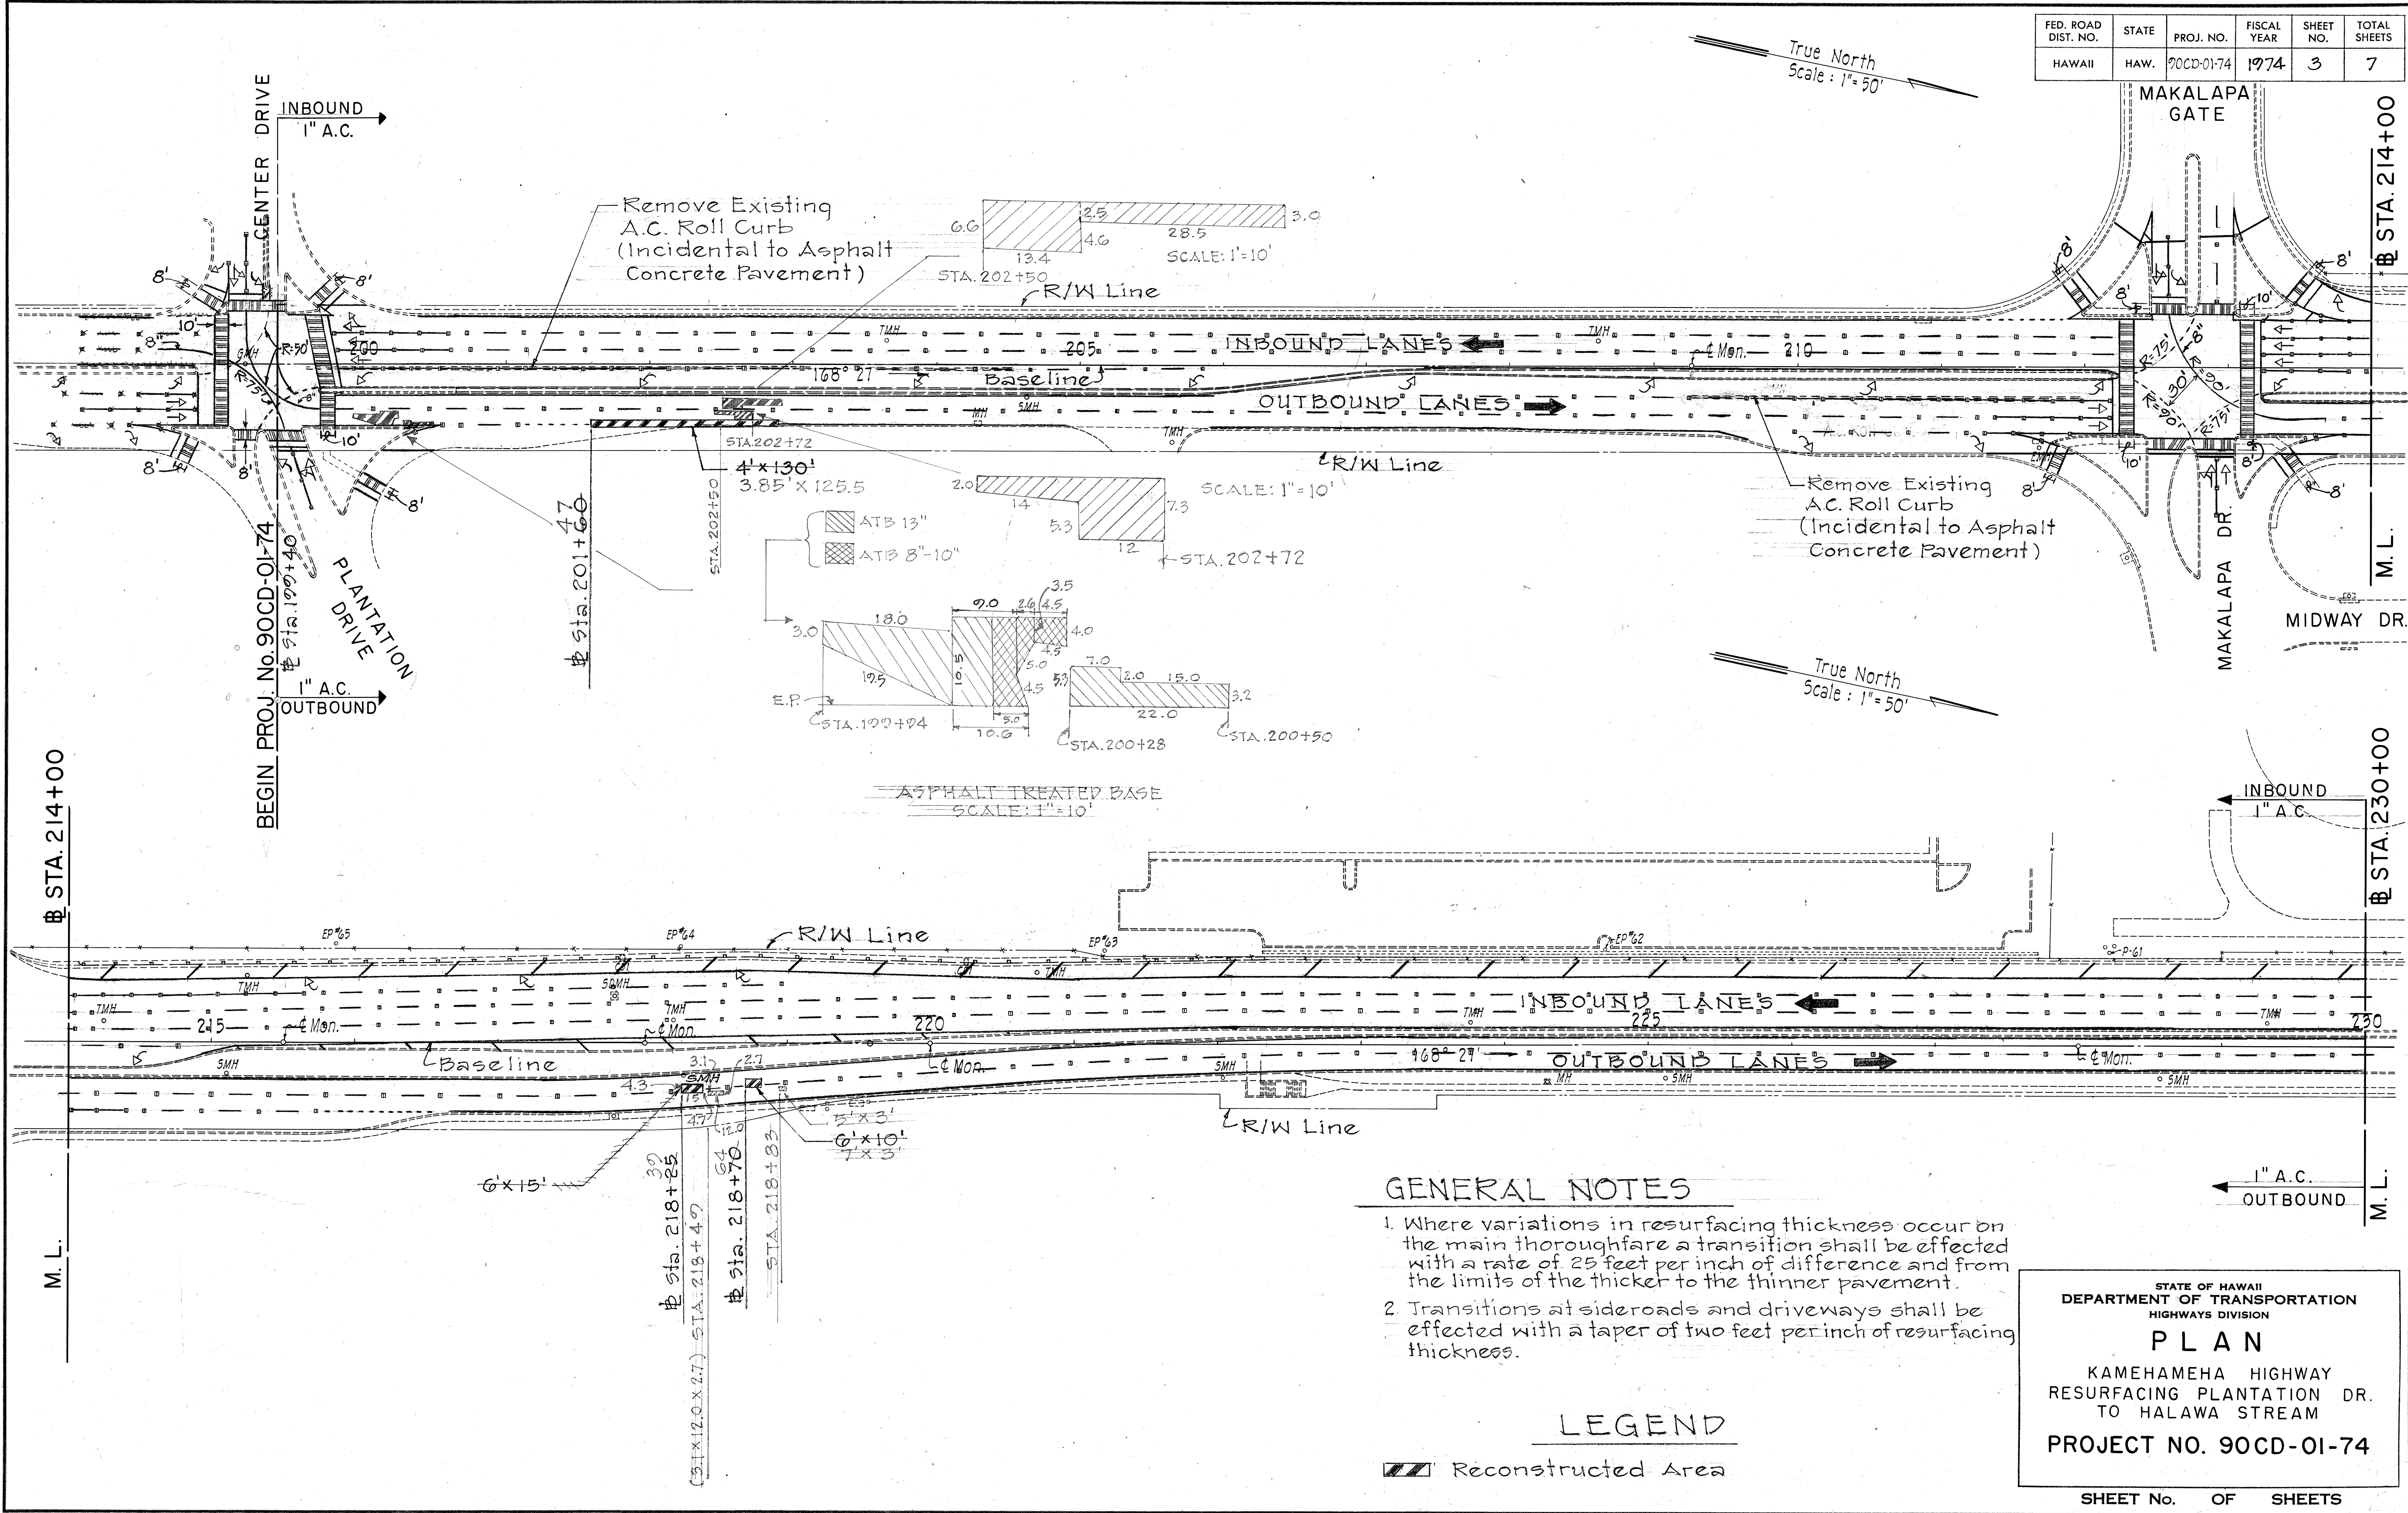

ASPHALT TREATED BASE
SCALE: 1" = 10'

GENERAL NOTES

- Where variations in resurfacing thickness occur on the main thoroughfare a transition shall be effected with a rate of 25 feet per inch of difference and from the limits of the thicker to the thinner pavement.
- Transitions at sideroads and driveways shall be effected with a taper of two feet per inch of resurfacing thickness.

LEGEND

Reconstructed Area

STATE OF HAWAII
DEPARTMENT OF TRANSPORTATION
HIGHWAYS DIVISION


PLAN
KAMEHAMEHA HIGHWAY
RESURFACING PLANTATION DR.
TO HALAWA STREAM

PROJECT NO. 90CD-01-74

SHEET No. OF SHEETS

DATE	
SURVEY PLOTTED BY	
DRAWN BY	
NOTED BY	
CHECKED BY	
ORIGINAL PLAN	
NOTE BOOK	
No.	

FED. ROAD DIST. NO.	STATE	PROJ. NO.	FISCAL YEAR	SHEET NO.	TOTAL SHEETS
HAWAII	HAW.	90CD-01-74	1974	4	7

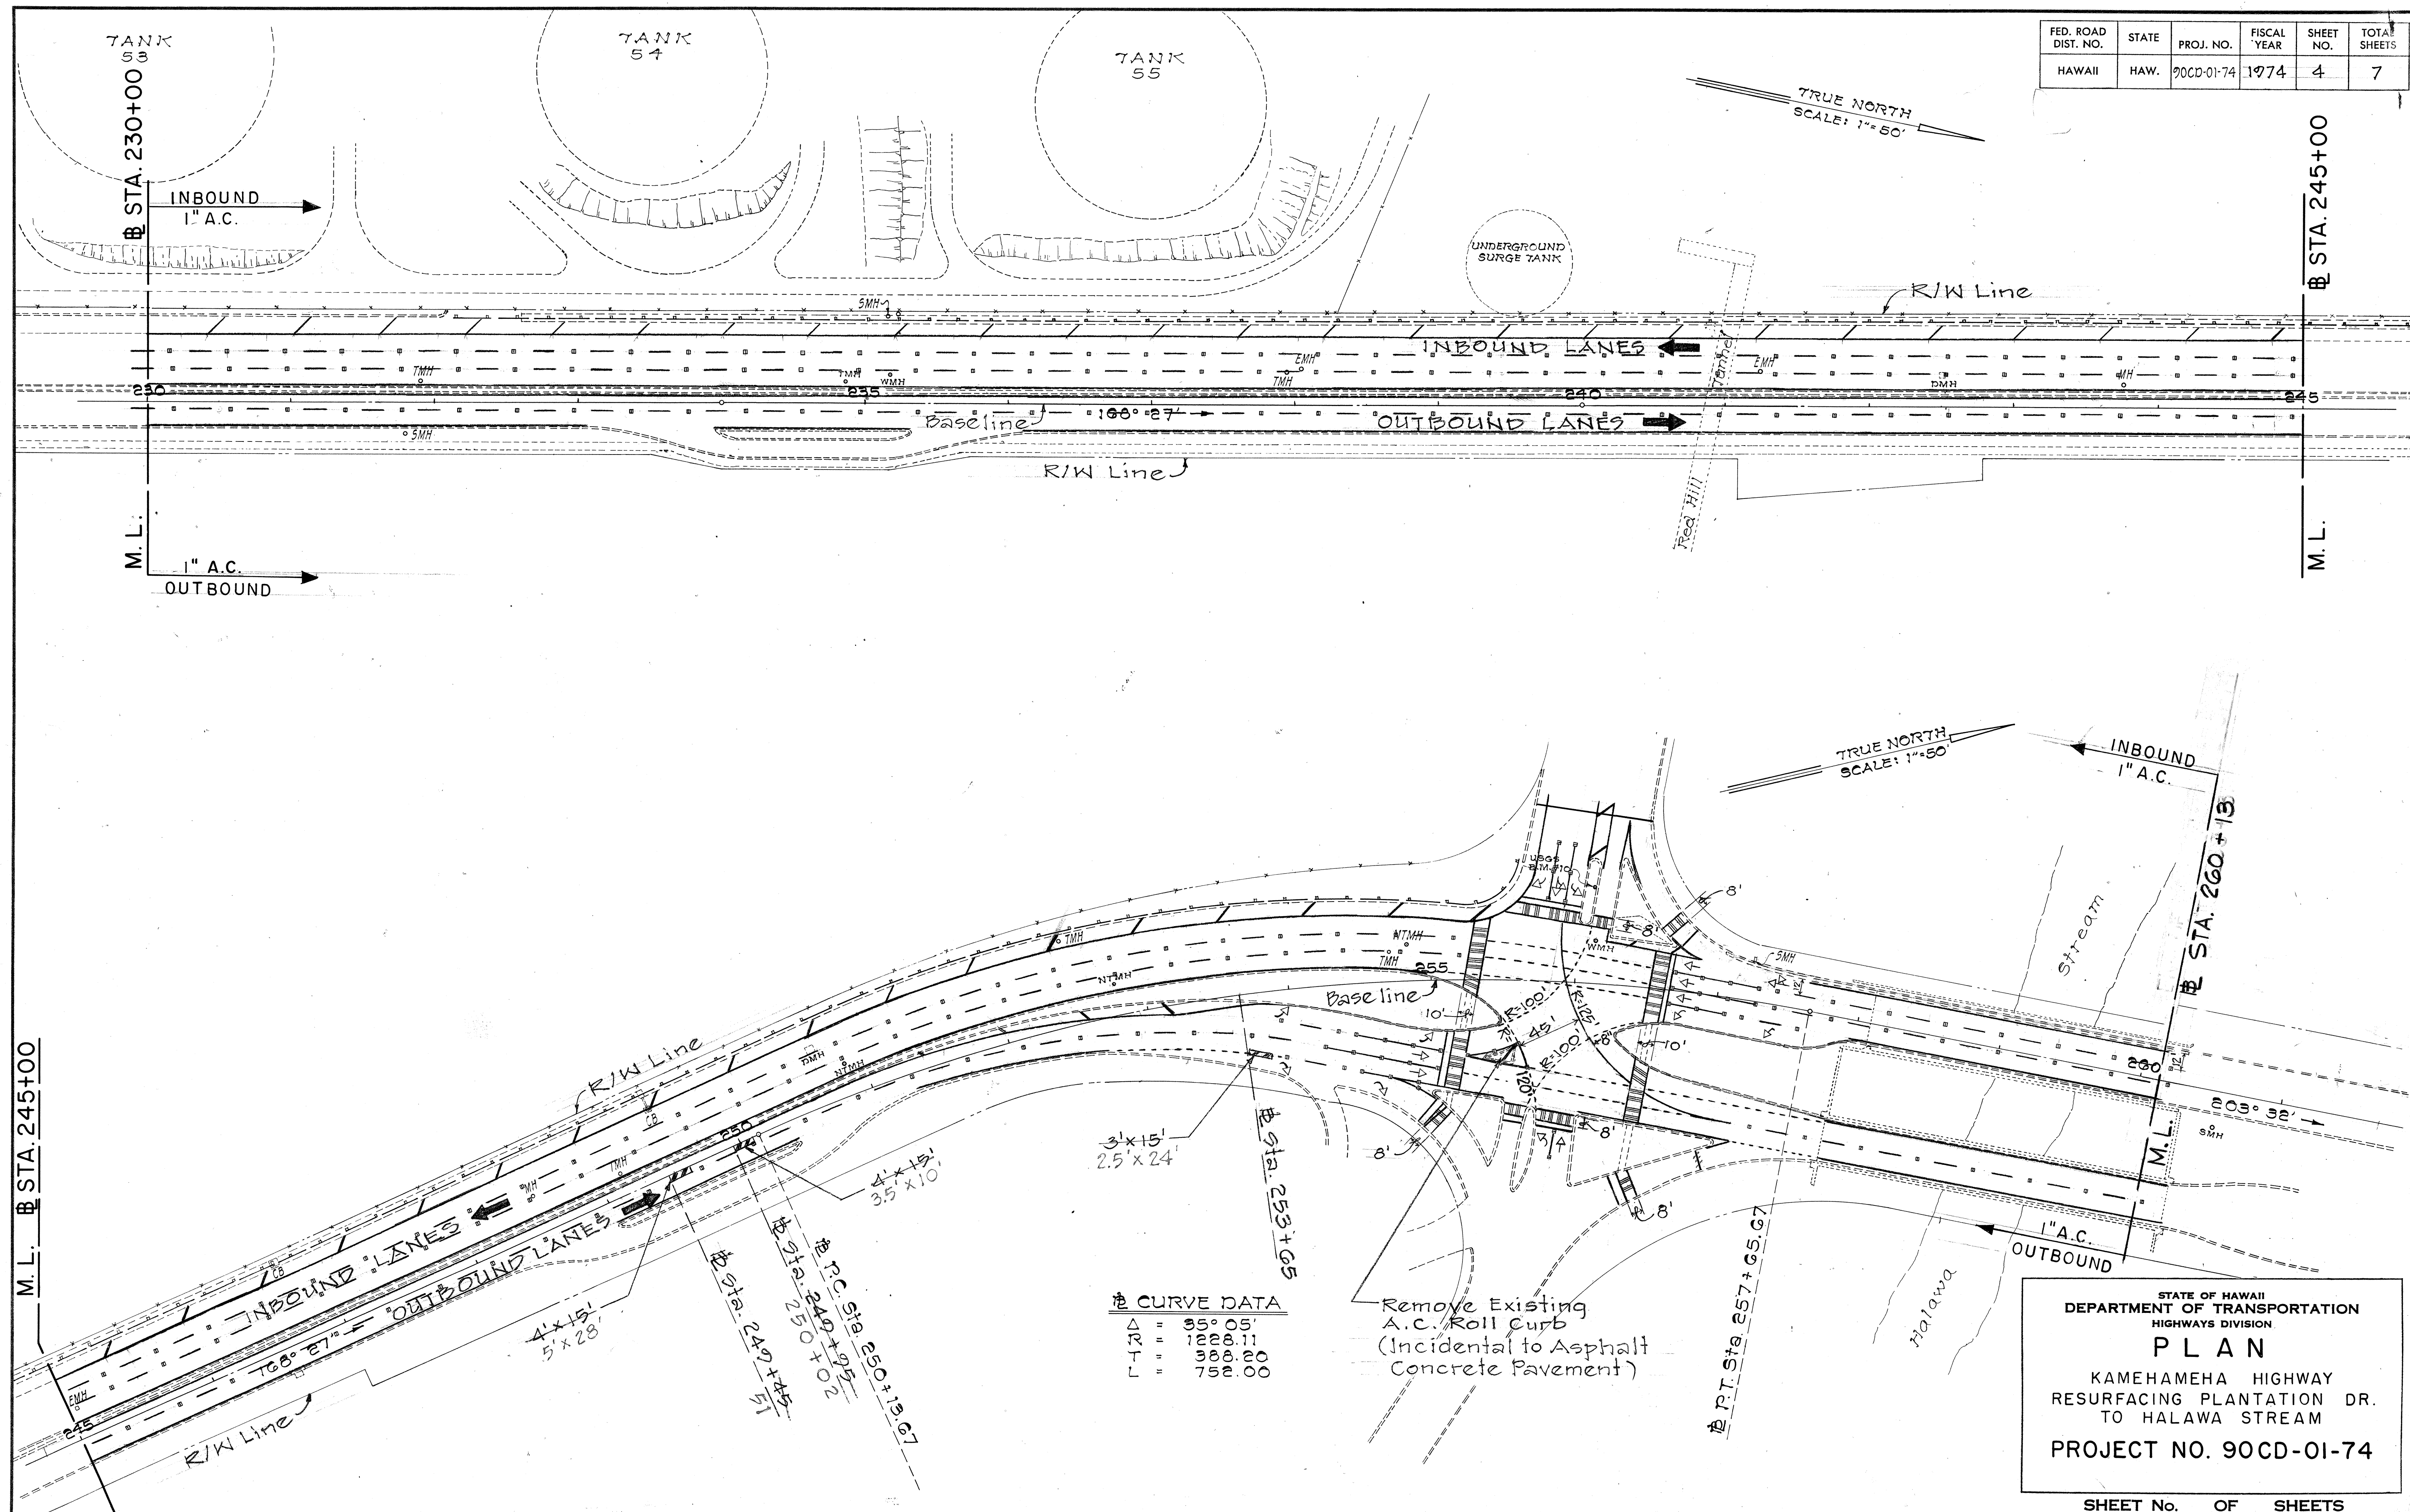

STATE OF HAWAII
DEPARTMENT OF TRANSPORTATION
HIGHWAYS DIVISION
PLAN
KAMEHAMEHA HIGHWAY
RESURFACING PLANTATION DR.
TO HALAWA STREAM
PROJECT NO. 90CD-01-74

SHEET No. OF SHEETS

