INDEX TO DRAWINGS	
SHEET NO.	DESCRIPTION
**************************************	TITLE SHEET
2	TYPICAL SECTION
3 5	PLAN
<u>6</u>	PAVEMENT MARKING DETAIL
 7	TYPICAL DETAILS
*	
÷	
ł	
	•
,	
**************************************	,
	on the
	·



STATE OF HAWAII

DEPARTMENT OF TRANSPORTATION HIGHWAYS DIVISION

HONOLULU, HAWAII


"AS BUILT"


PLANS FOR

RESURFACING PLANTATION DRIVE TO HALAWA STREAM
PROJECT NO. 90CD-01-74

DISTRICT OF EWA

1"= 1000

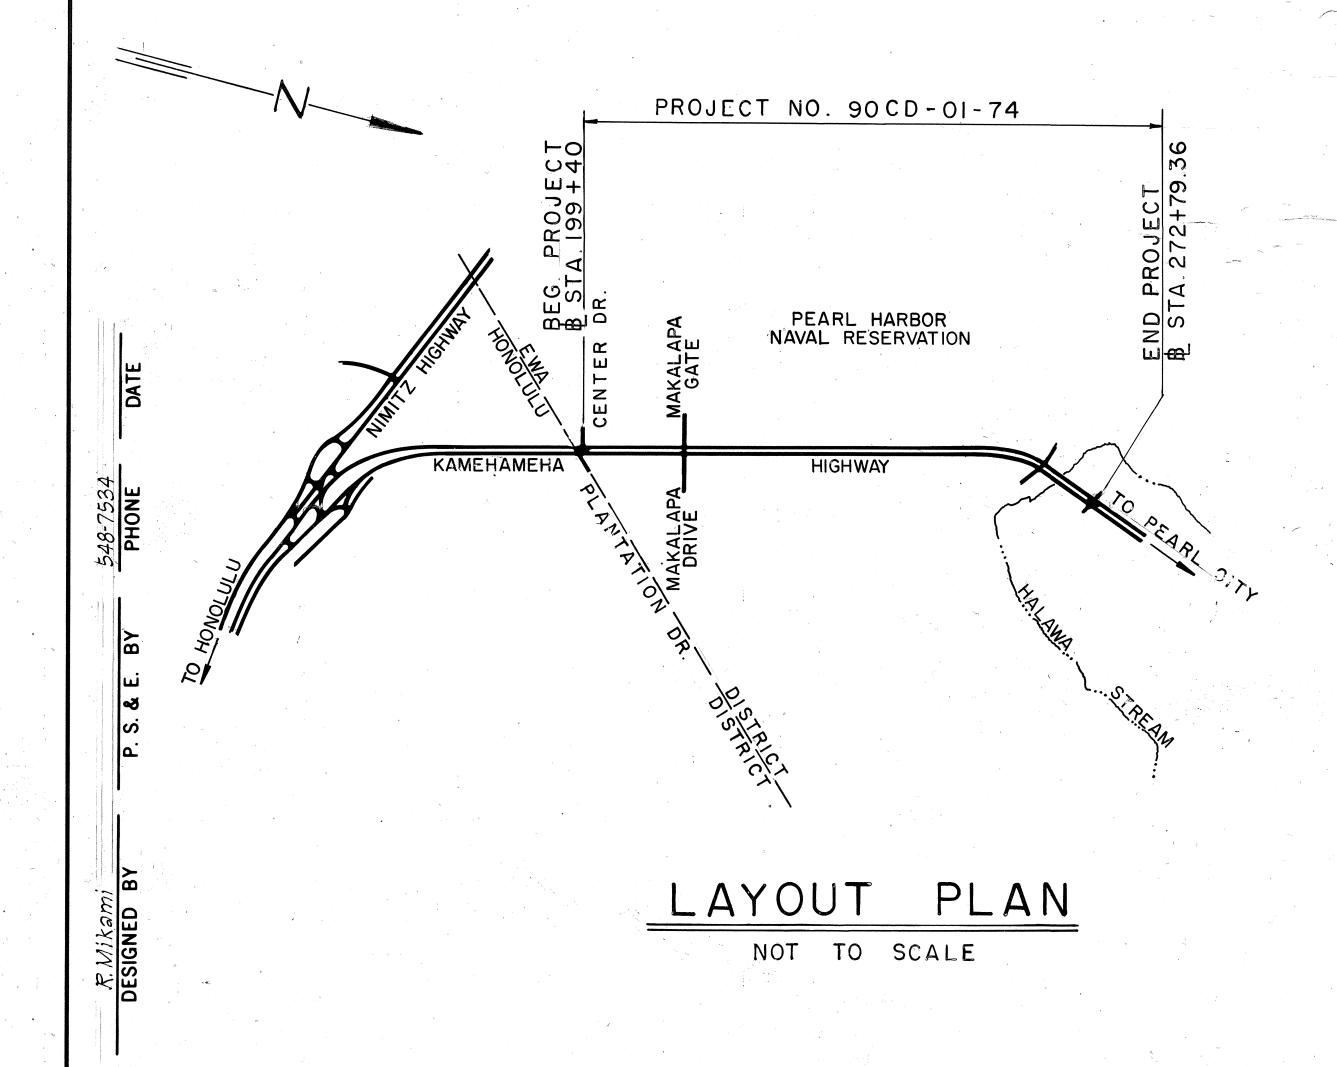

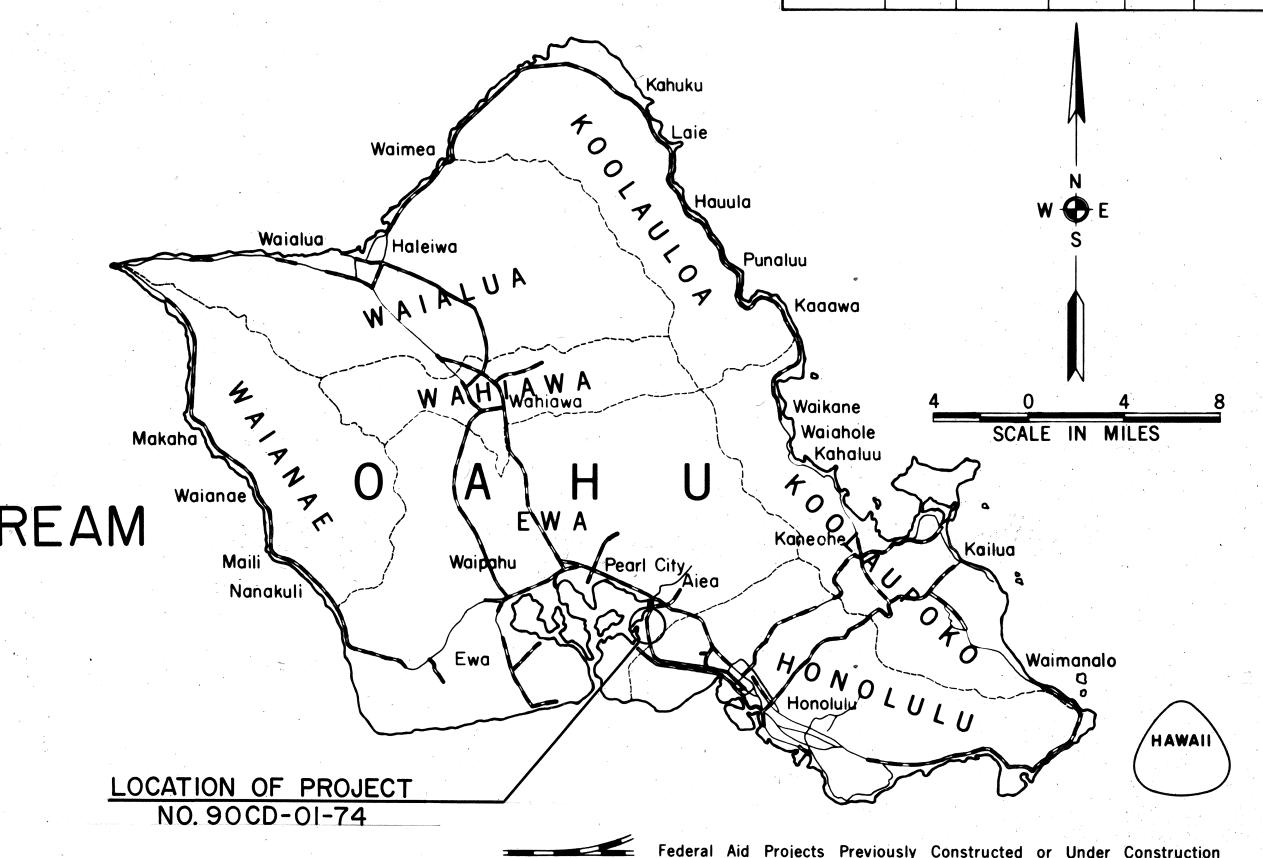

NOTE:

ALL CHANGES MADE DURING CONSTRUCTION HAVE
BEEN INCORPORATED ON THESE PLANS EXCEPT
CHANGES IN THE ORIGINAL THEORETICAL QUANTITIES.

PROJECT ENGINEER

April 25, 1975 DATE

DEPARTMENT OF TRANSPORTATION
STATE OF HAWAII
APPROVED:

munn

DIR. OF TRANSPORTATION

N DATE