




FED. ROAD DIST. NO.	STATE	PROJ. NO.	FISCAL YEAR	SHEET NO.	TOTAL SHEETS
HAWAII	HAW.	90CD-01-74	1974	2	7

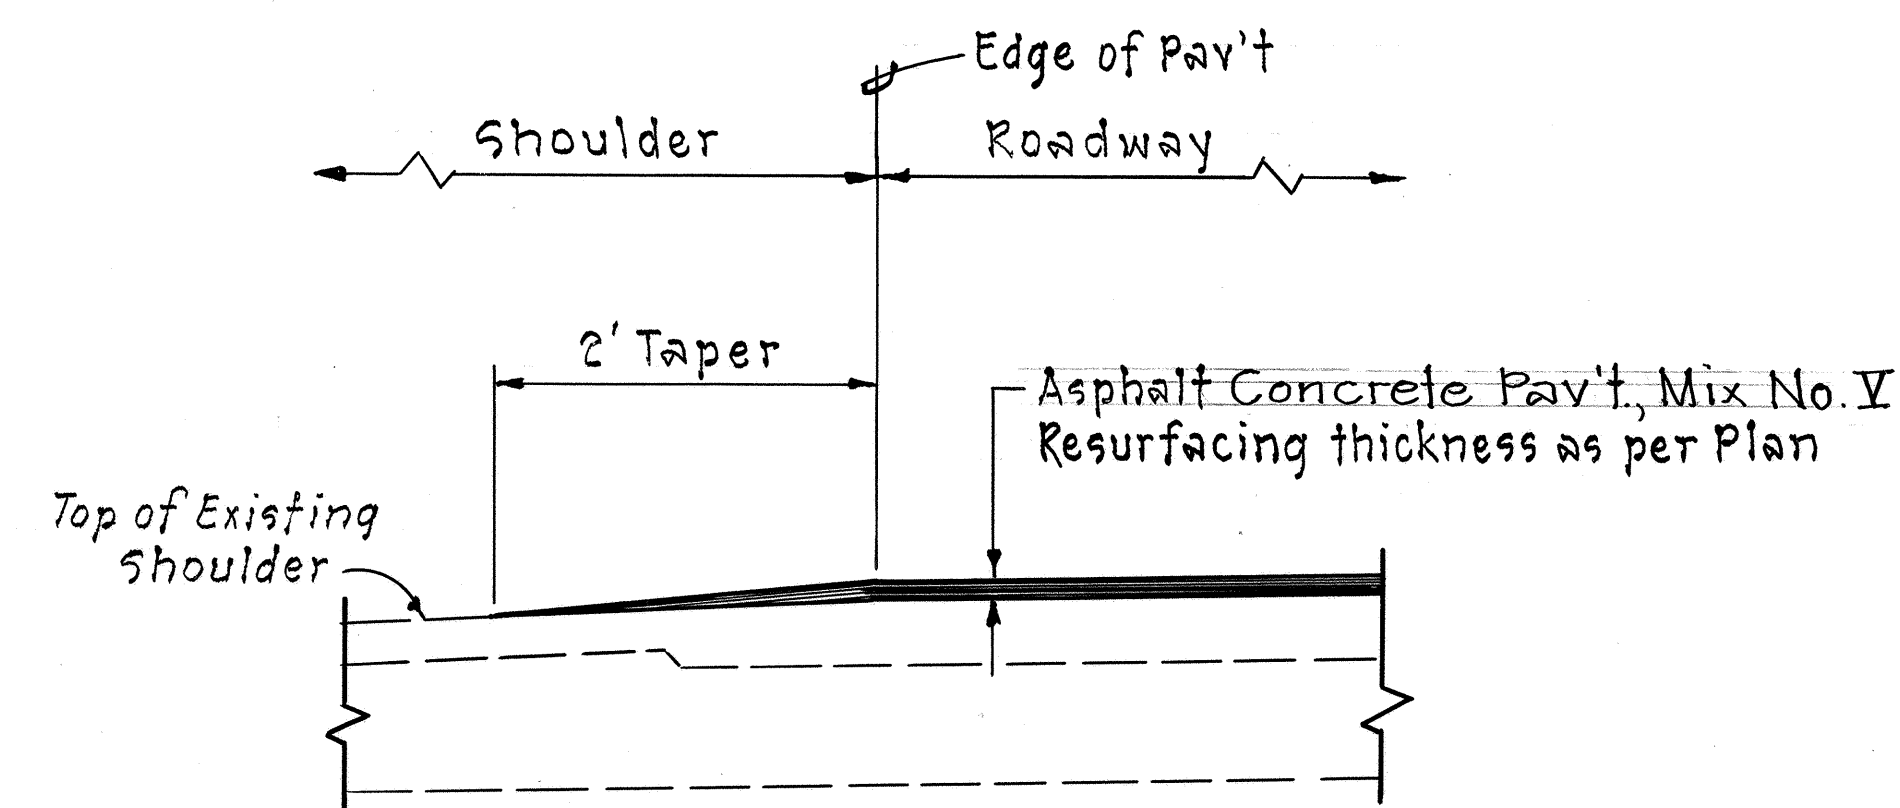


**SHOULDER SECTION**

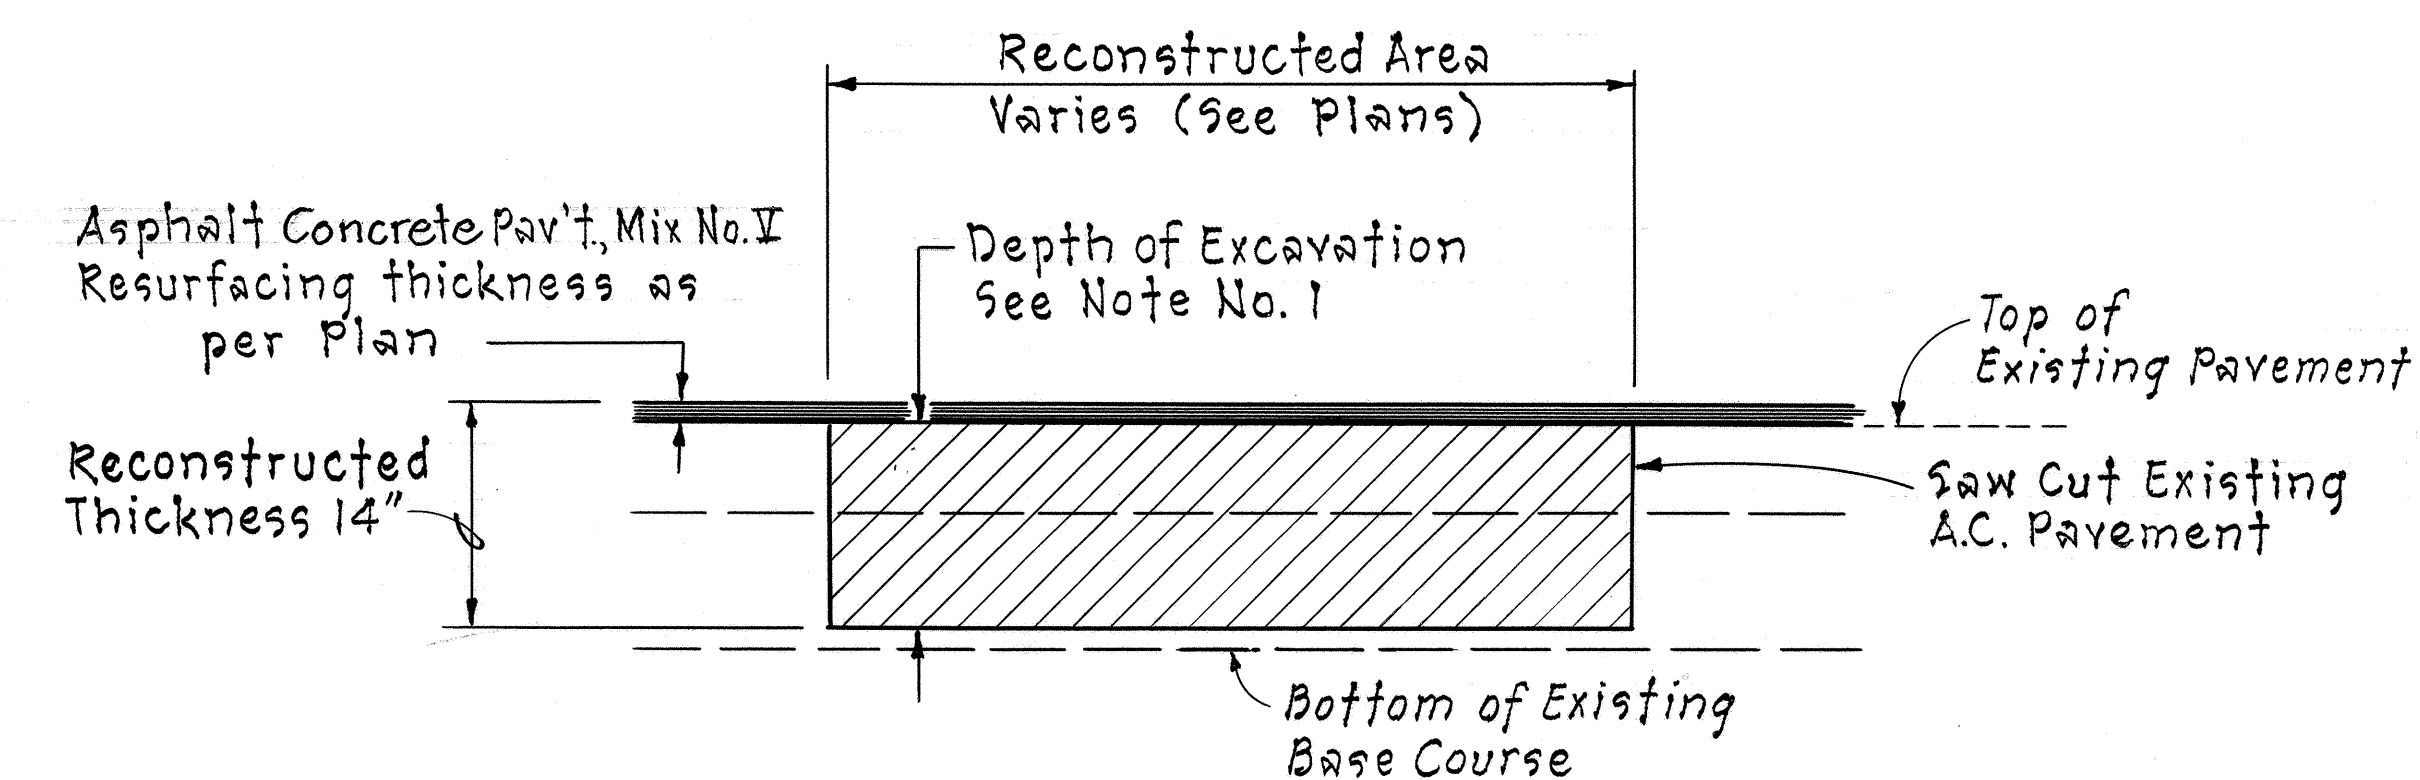


**RECONSTRUCTED PAVEMENT DETAIL**

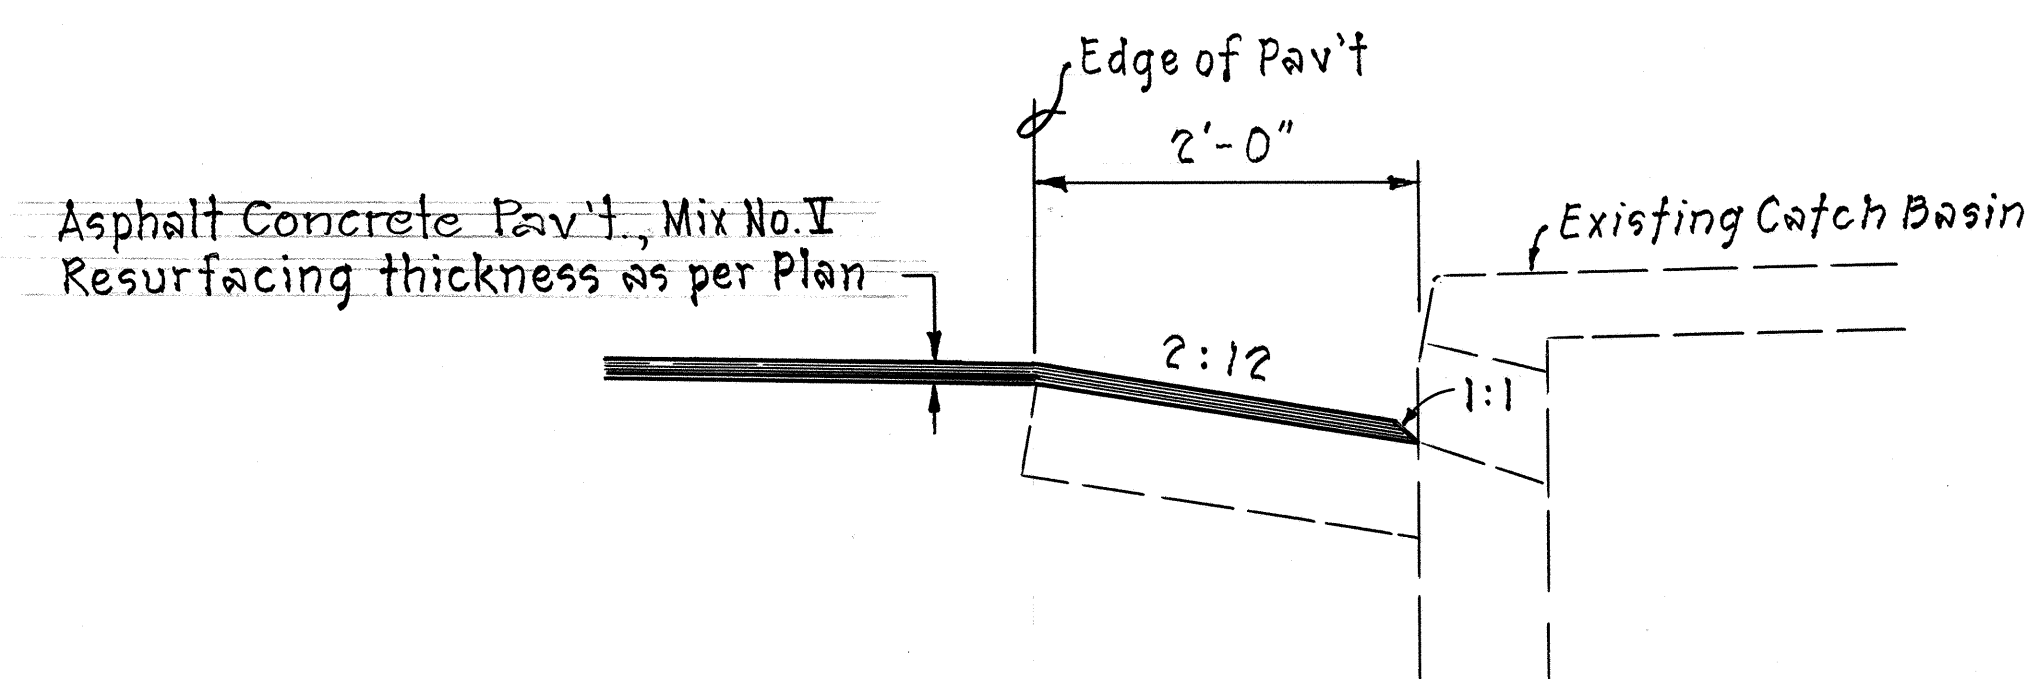

**CATCH BASIN SECTION**

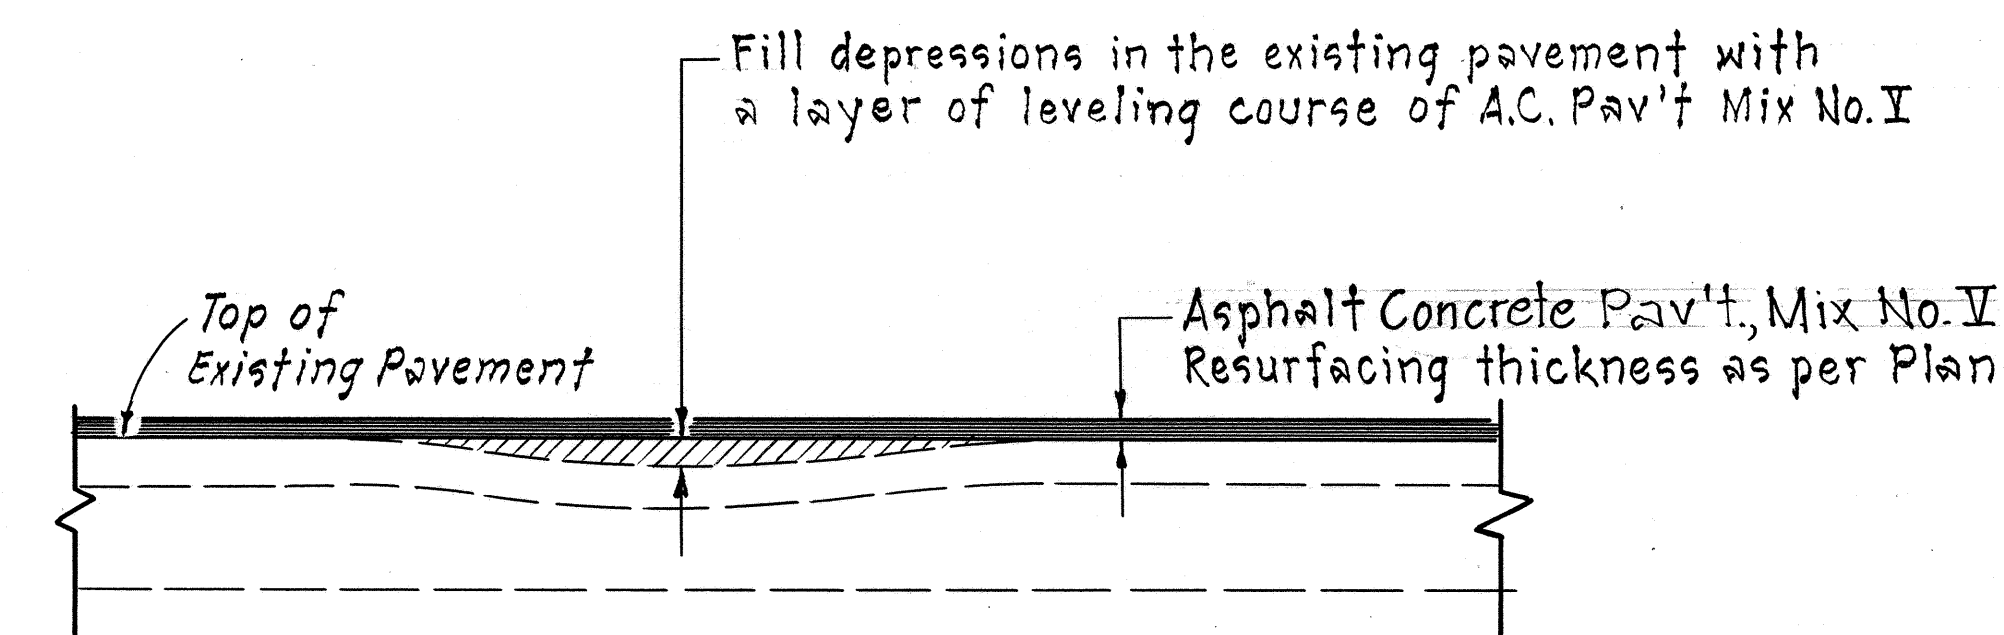

**LEVELING COURSE DETAIL**

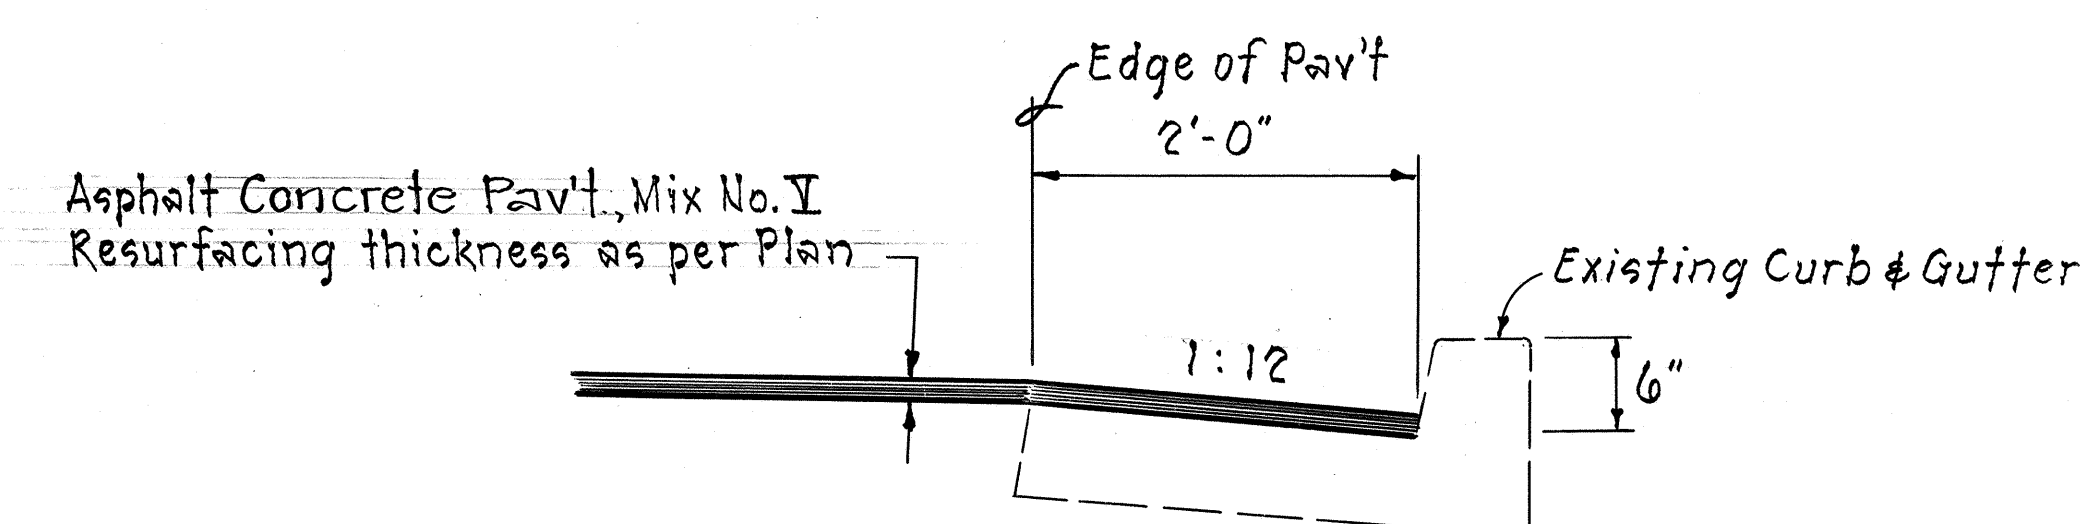

**CURB AND GUTTER SECTION**

**NOTES:**

1. The depth of excavation for reconstruction shall be the reconstructed thickness minus the resurfacing thickness as designated on plans. The excavated areas shall be reconstructed with Plant Mix Asphalt Treated Base Course prior to resurfacing.

STATE OF HAWAII  
DEPARTMENT OF TRANSPORTATION  
HIGHWAYS DIVISION  
**TYPICAL SECTION**  
KAMEHAMEHA HIGHWAY  
RESURFACING PLANTATION DR.  
TO HALAWA STREAM  
**PROJECT NO. 90CD-01-74**  
Not To Scale  
SHEET No. OF SHEETS