


FED. ROAD DIST. NO.	STATE	FED. AID PROJ. NO.	FISCAL YEAR	SHEET NO.	TOTAL SHEETS
HAWAII	HAW.	NH-099-1(24)	2007	44	74

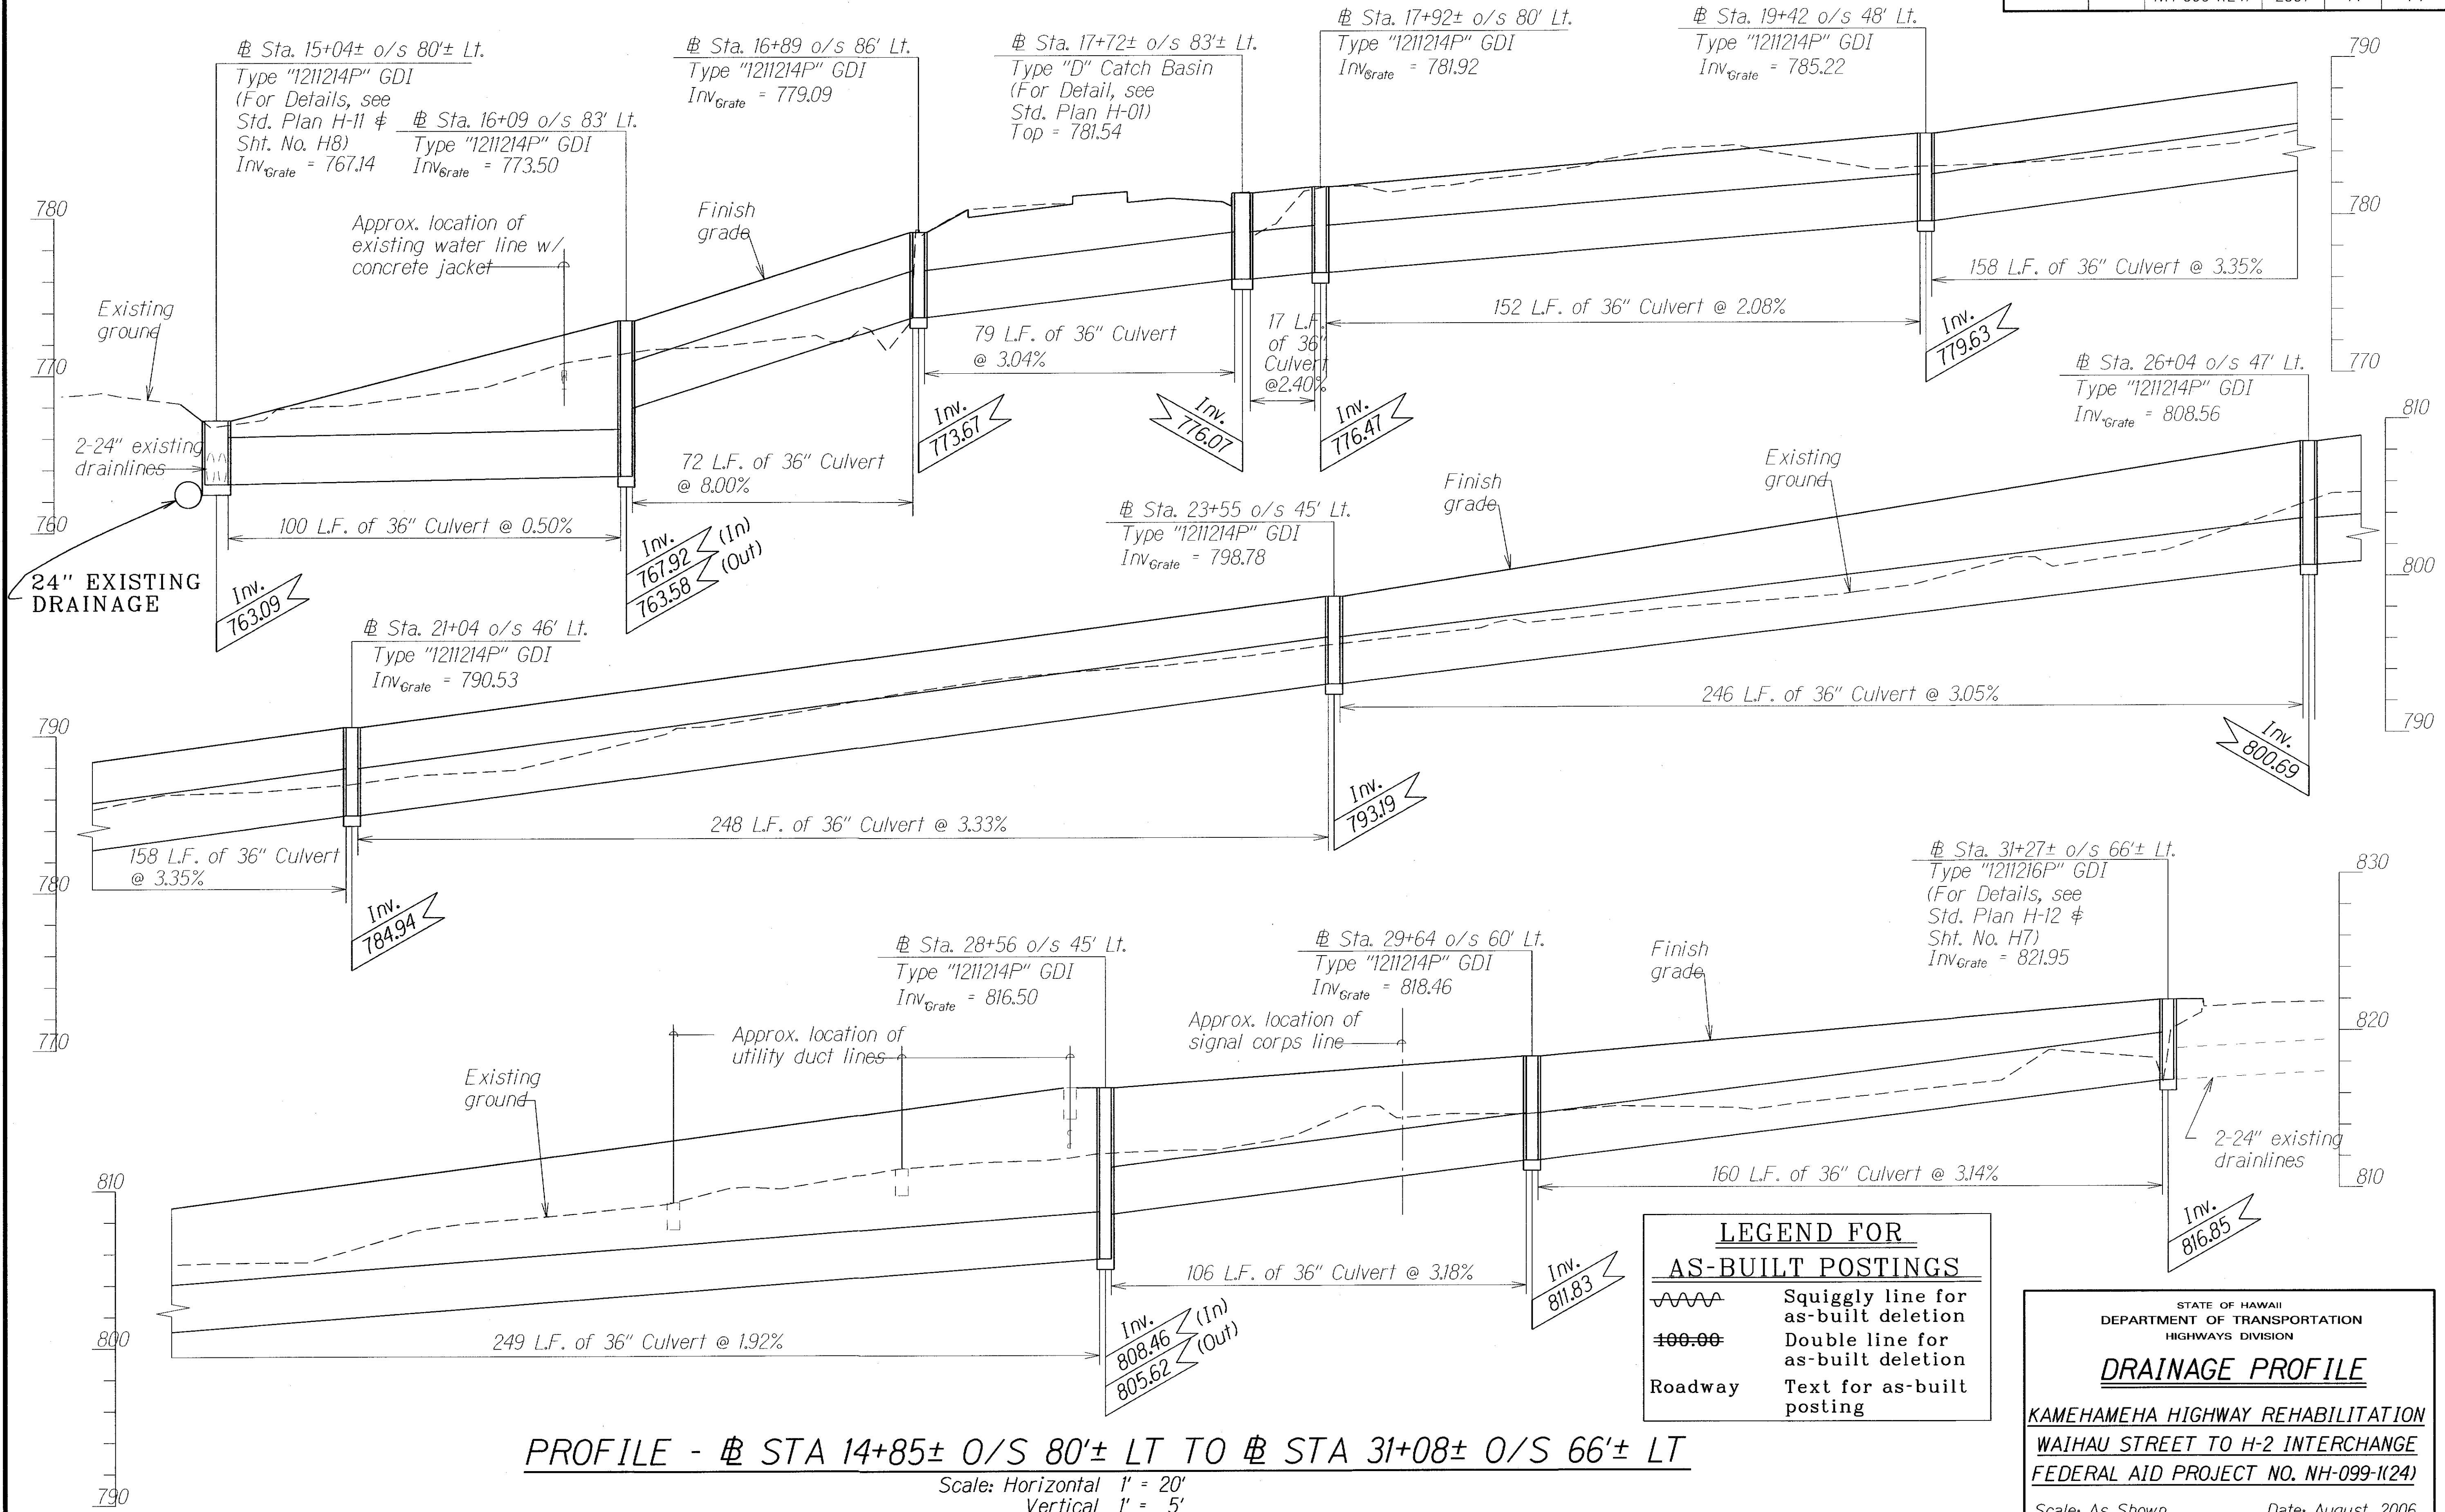

PROFILE - # STA 14+85± 0/S 80'± LT TO # STA 31+08± 0/S 66'± LT

Scale: Horizontal 1" = 20'
Vertical 1" = 5'

LEGEND FOR AS-BUILT POSTINGS

Squiggly line for as-built deletion

Double line for as-built deletion

Roadway Text for as-built posting

STATE OF HAWAII
DEPARTMENT OF TRANSPORTATION
HIGHWAYS DIVISION

DRAINAGE PROFILE

KAMEHAMEHA HIGHWAY REHABILITATION
WAIHAU STREET TO H-2 INTERCHANGE
FEDERAL AID PROJECT NO. NH-099-1(24)

Scale: As Shown Date: August, 2006

SHEET No. H6 OF 13 SHEETS

SURVEY PLOTTED BY	DATE
DRAWN BY	
DESIGNED BY	
CHECKED BY	
ORIGINAL PLAN	
NOTE BOOK	
DESIGNED BY	
CHECKED BY	

"AS-BUILT"