


FED. ROAD DIST. NO.	STATE	FED. AID PROJ. NO.	FISCAL YEAR	SHEET NO.	TOTAL SHEETS
HAWAII	HAW.	NH-099-1(24)	2007	70	74

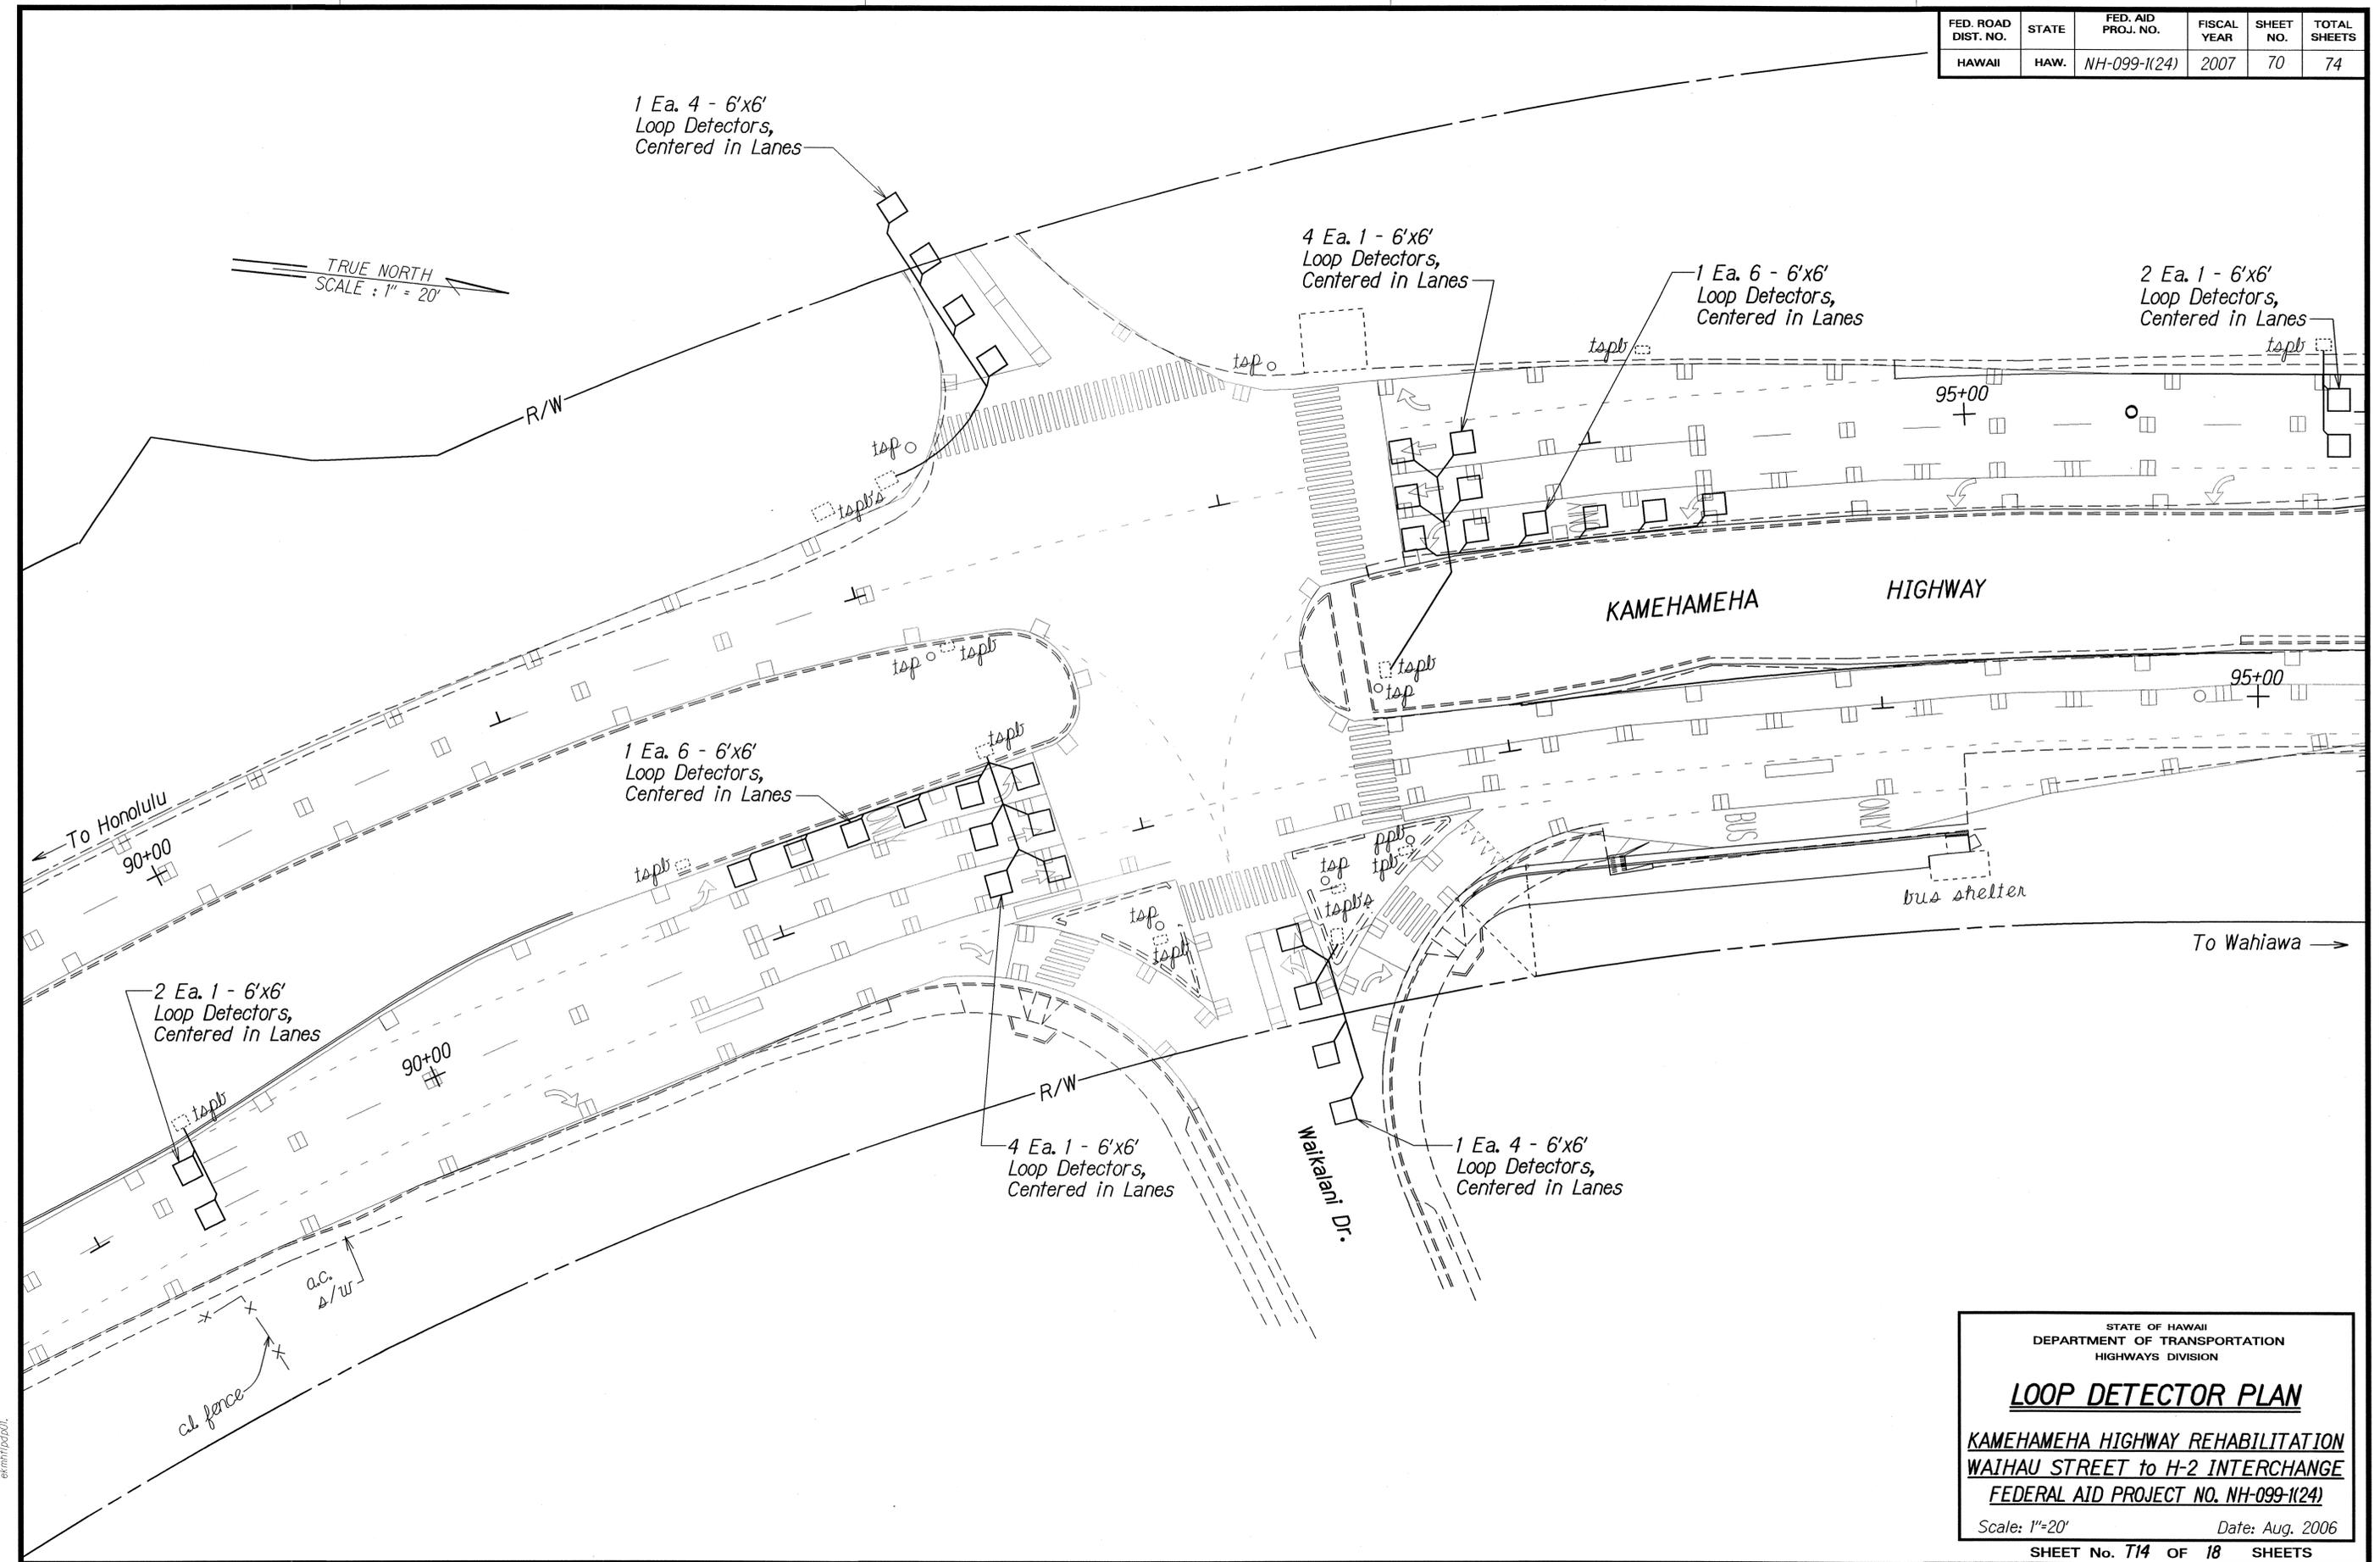

SURVEY PLOTTED BY: DATE: 8/17/06
 DRAWN BY: J.L.
 TRACED BY: P.C.
 DESIGNED BY: P.C.
 QUANTITIES BY: J.L.
 CHECKED BY: J.L.
 ORIGINAL PLAN: _____
 NOTE BOOK: _____
 No. of Lanes: _____
 8/17/06

STATE OF HAWAII
 DEPARTMENT OF TRANSPORTATION
 HIGHWAYS DIVISION

LOOP DETECTOR PLAN


KAMEHAMEHA HIGHWAY REHABILITATION
WAIHAU STREET to H-2 INTERCHANGE
FEDERAL AID PROJECT NO. NH-099-1(24)

Scale: 1"=20' Date: Aug. 2006

SHEET No. T14 OF 18 SHEETS

FED. ROAD DIST. NO.	STATE	FED. AID PROJ. NO.	FISCAL YEAR	SHEET NO.	TOTAL SHEETS
HAWAII	HAW.	NH-099-1(24)	2007	71	74

TRUE NORTH
SCALE: 1" = 20'

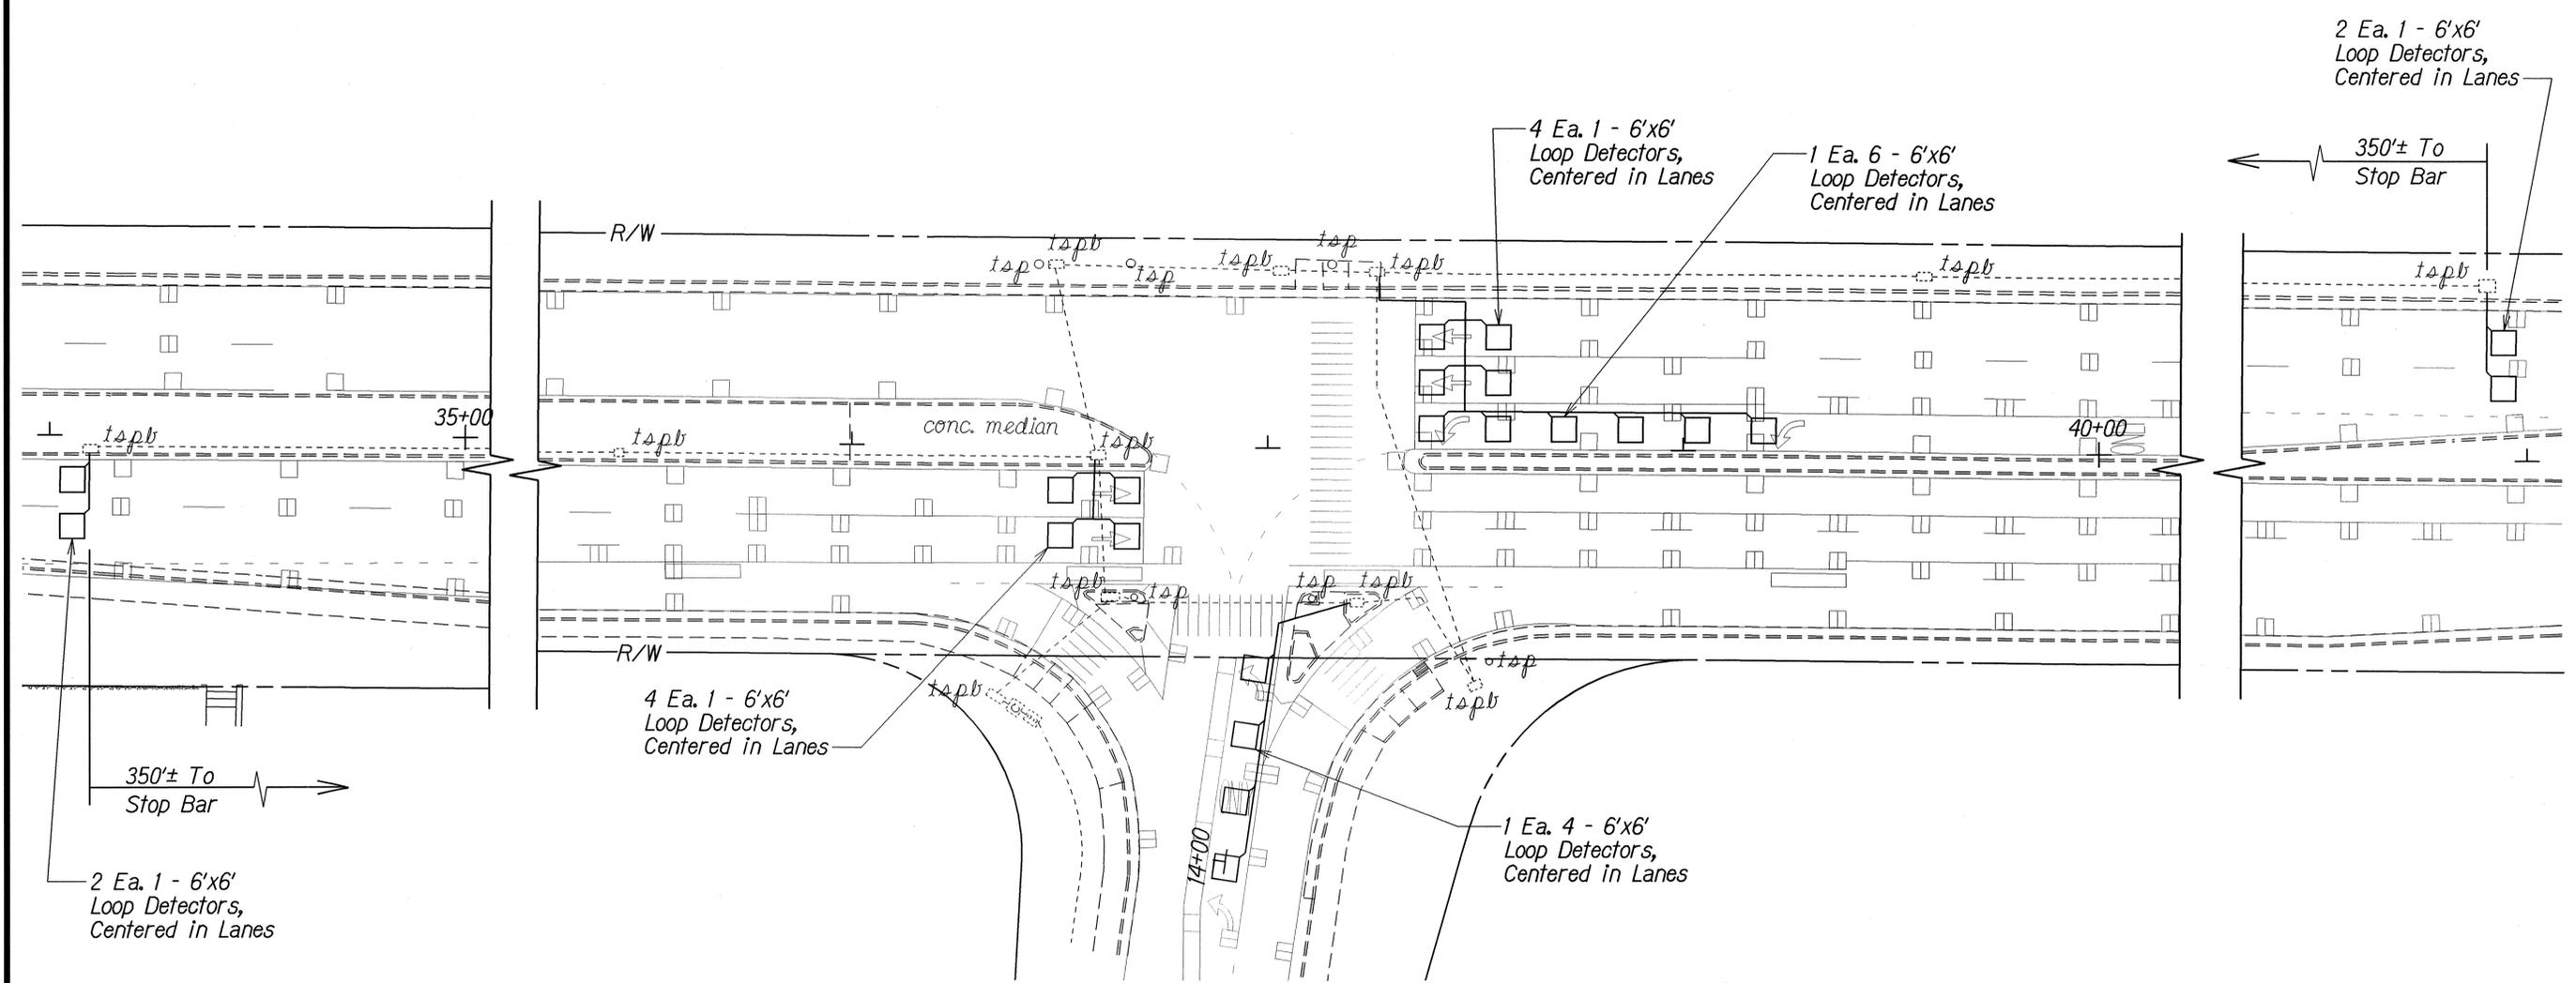

DATE: 8/2/06
 SURVEY PLOTTED BY: L.H.
 DRAWN BY: L.H.
 TRACED BY: P.C.
 DESIGNED BY: L.H.
 QUANTITIES BY: L.H.
 CHECKED BY: L.H.
 ORIGINAL PLAN: []
 NOTE BOOK: []
 N. 141/1000
 8/2/06

STATE OF HAWAII
 DEPARTMENT OF TRANSPORTATION
 HIGHWAYS DIVISION


LOOP DETECTOR PLAN

**KAMEHAMEHA HIGHWAY REHABILITATION
 WAIHAU STREET to H-2 INTERCHANGE
 FEDERAL AID PROJECT NO. NH-099-1(24)**

Scale: 1"=20' Date: Aug. 2006

SHEET No. 71 OF 18 SHEETS

FED. ROAD DIST. NO.	STATE	FED. AID PROJ. NO.	FISCAL YEAR	SHEET NO.	TOTAL SHEETS
HAWAII	HAW.	NH-099-1(24)	2007	72	74

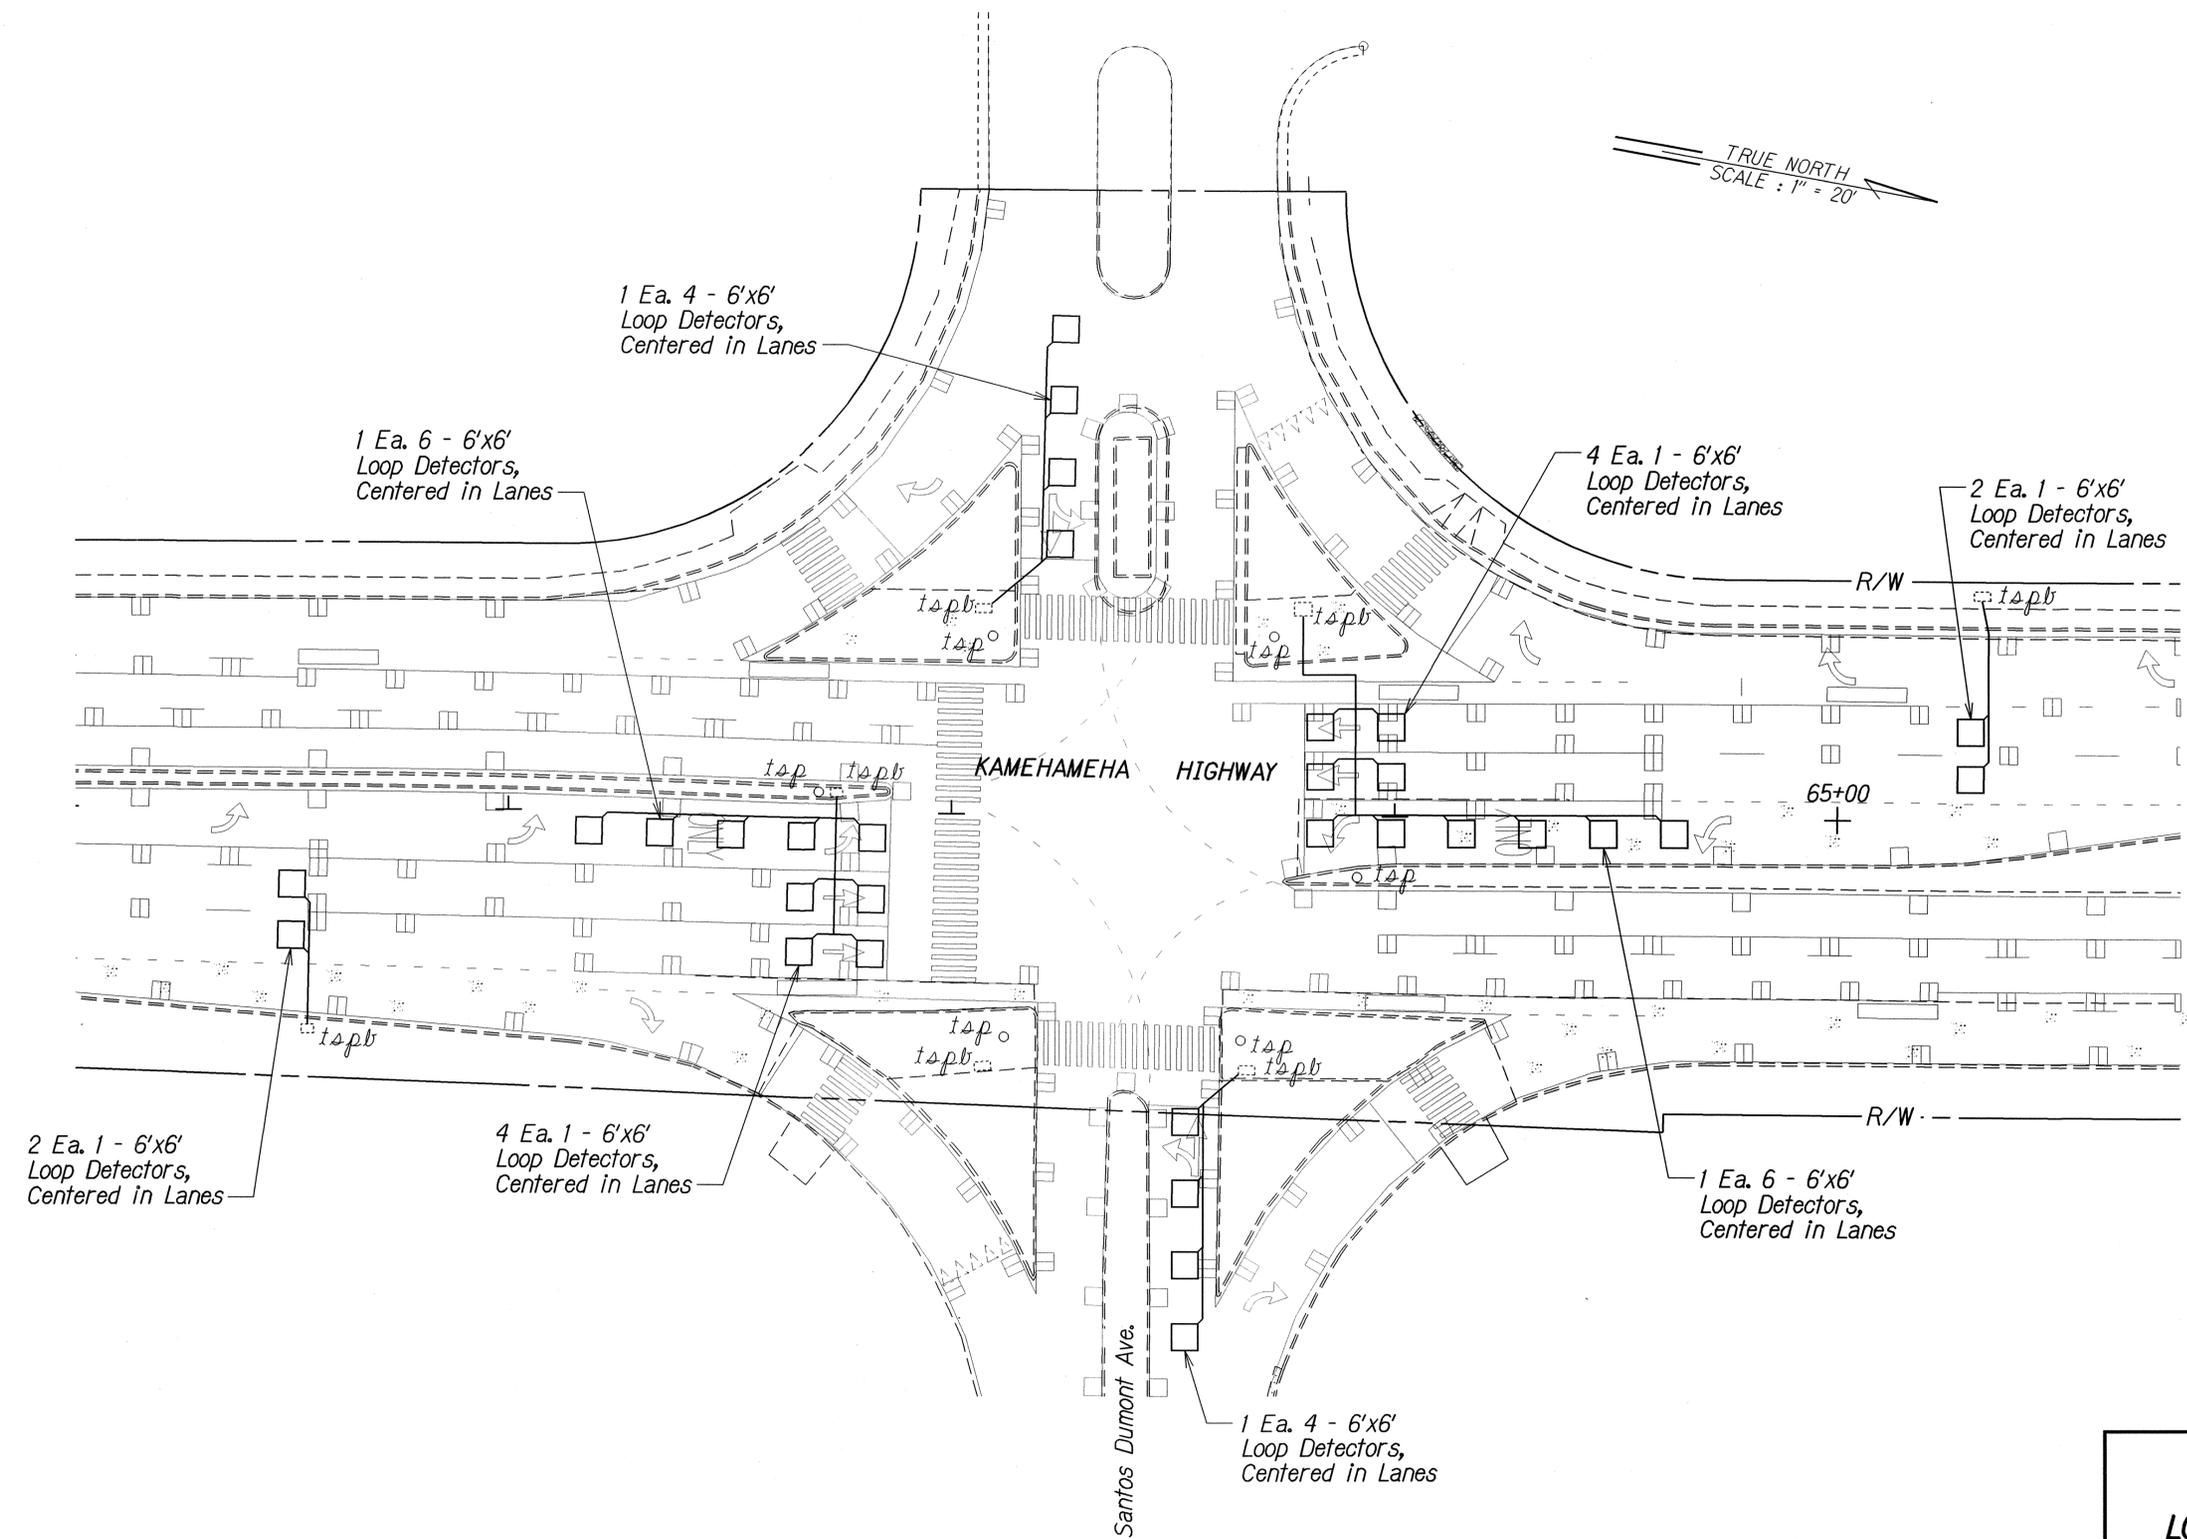

SURVEY PLOTTED BY: DATE: 8/1/06
 DRAWN BY: J.C.
 TRACED BY: P.C.
 DESIGNED BY: P.C.
 QUANTITIES BY: P.C.
 CHECKED BY: P.C.
 ORIGINAL PLAN: _____
 NOTE BOOK: _____
 No. Ed./Issue: _____
 ekm/10/06/03

STATE OF HAWAII
 DEPARTMENT OF TRANSPORTATION
 HIGHWAYS DIVISION


LOOP DETECTOR PLAN

KAMEHAMEHA HIGHWAY REHABILITATION
WAIHAU STREET to H-2 INTERCHANGE
FEDERAL AID PROJECT NO. NH-099-1(24)

Scale: 1"=20' Date: Aug. 2006

SHEET No. 72 OF 18 SHEETS

FED. ROAD DIST. NO.	STATE	FED. AID PROJ. NO.	FISCAL YEAR	SHEET NO.	TOTAL SHEETS
HAWAII	HAW.	NH-099-1(24)	2007	73	74

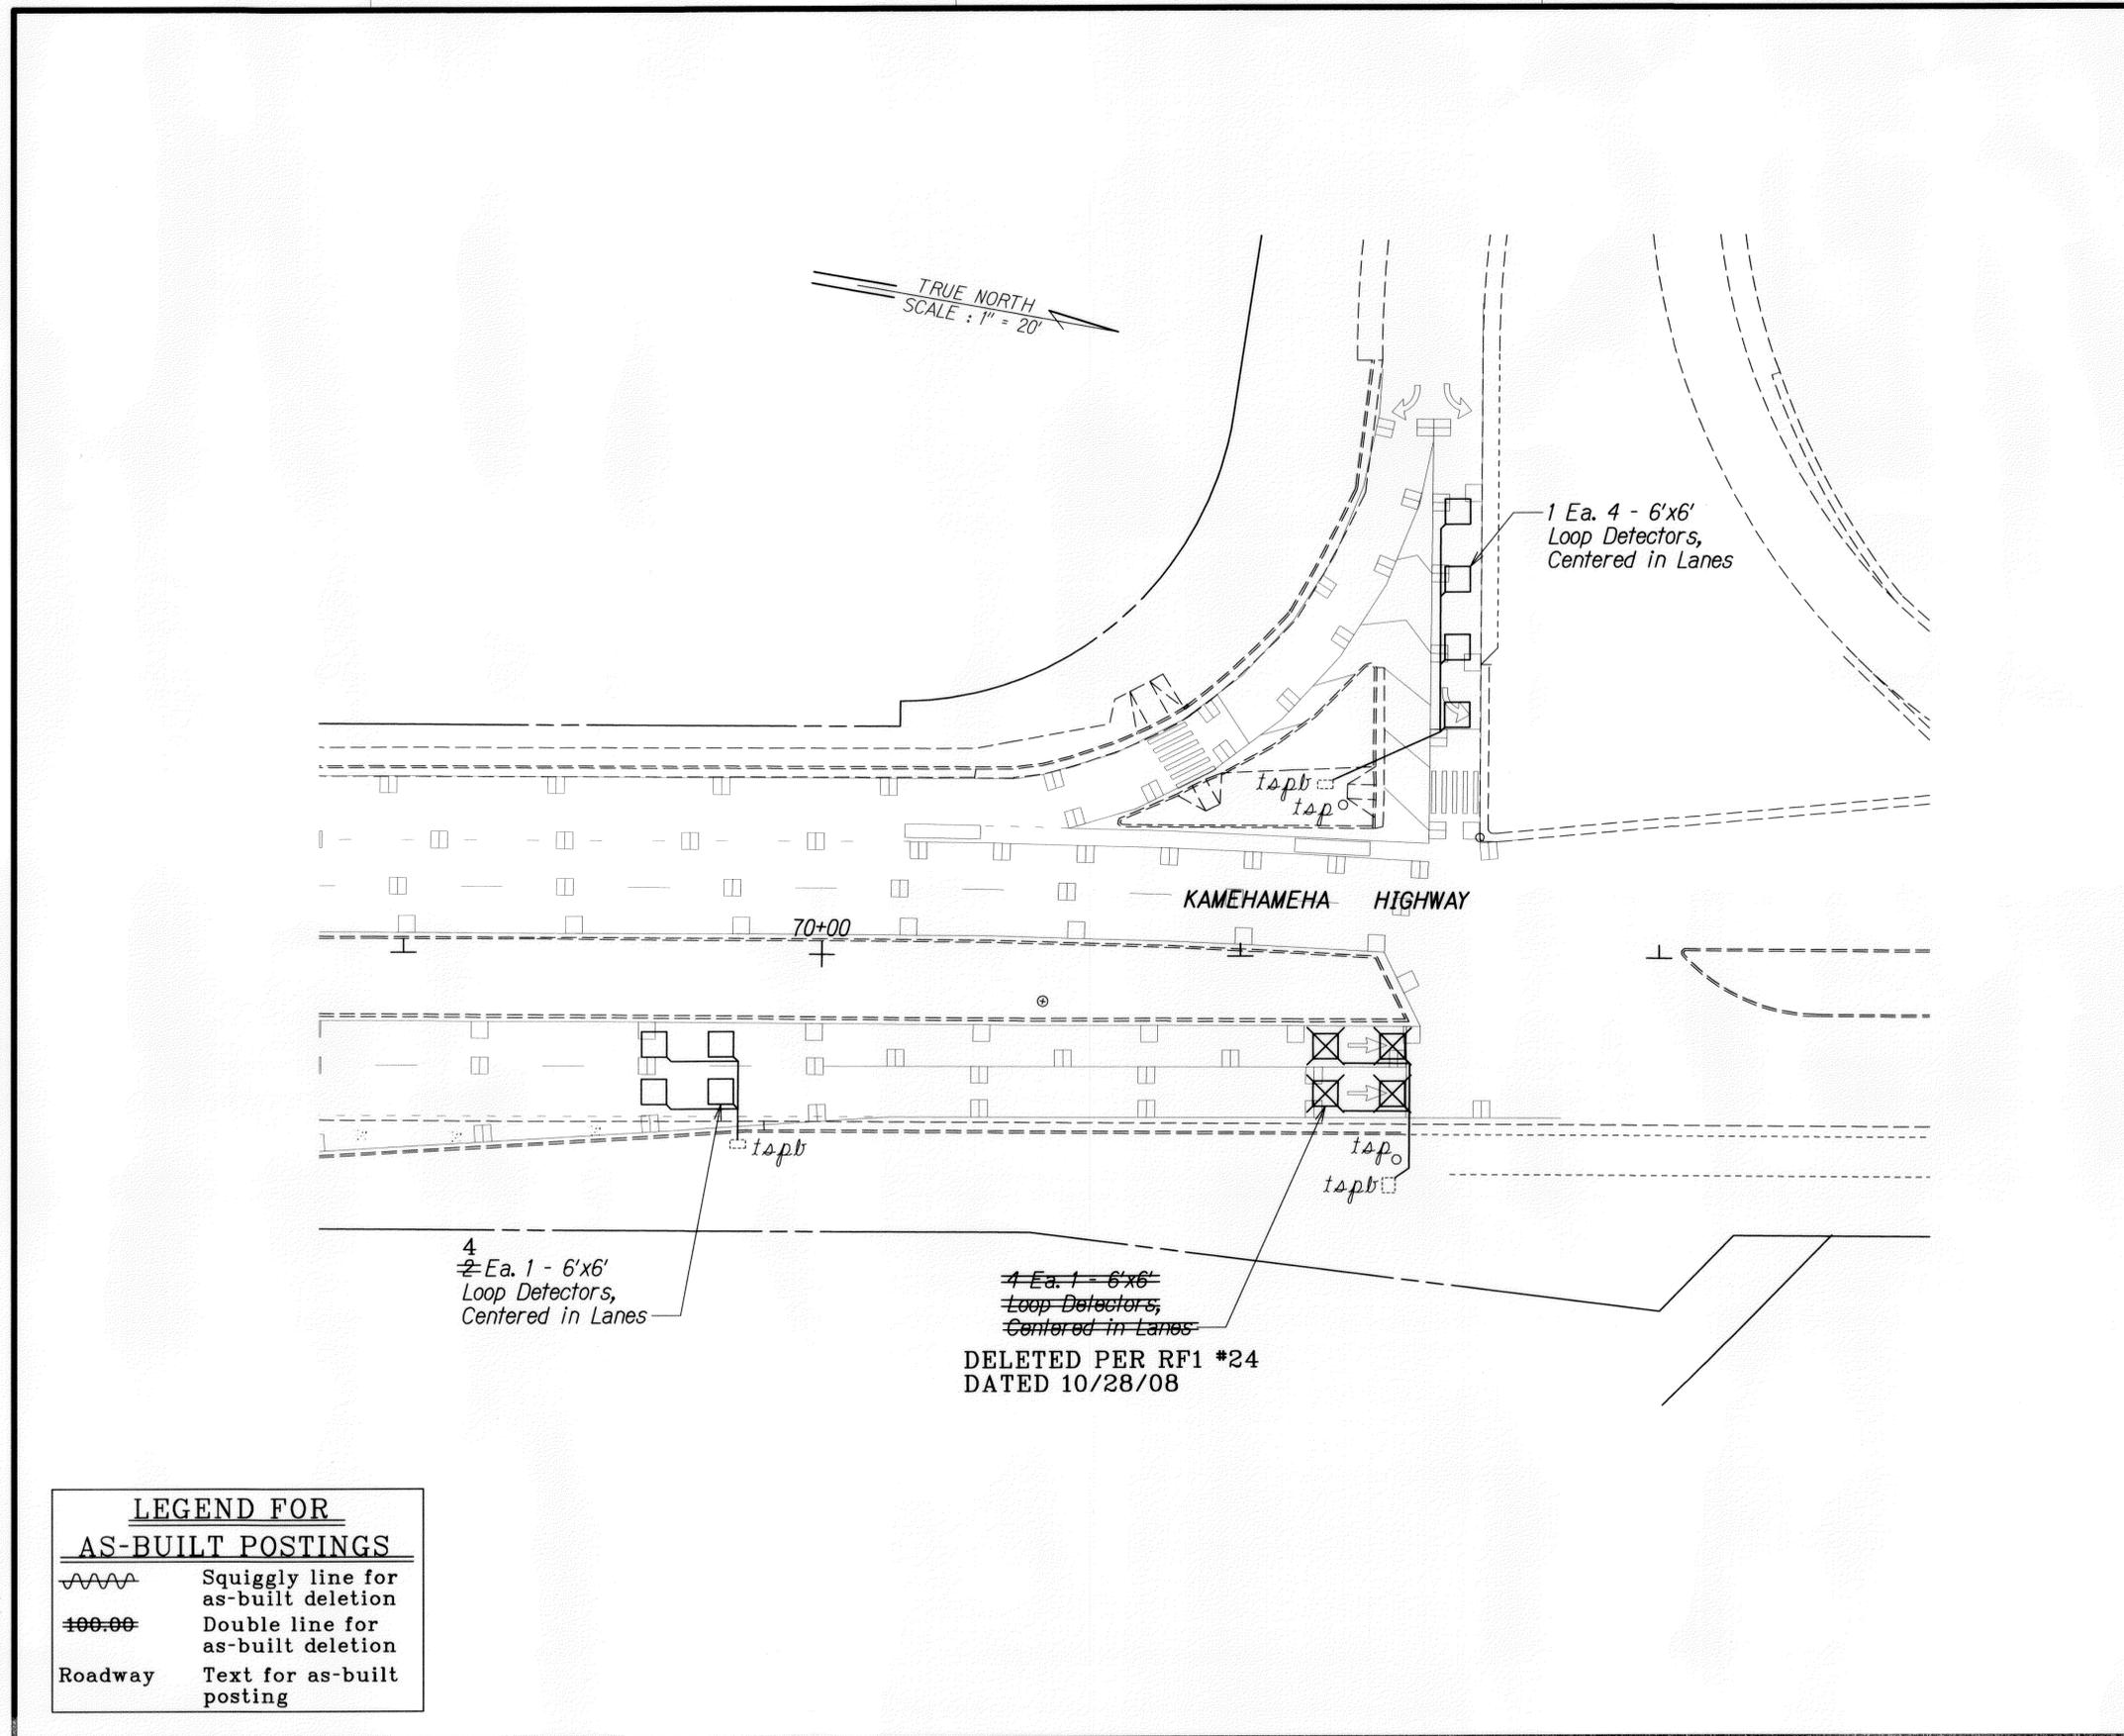

TRUE NORTH
SCALE : 1" = 20'

1 Ea. 4 - 6'x6'
Loop Detectors,
Centered in Lanes

KAMEHAMEHA HIGHWAY

70+00

4
~~2~~ Ea. 1 - 6'x6'
Loop Detectors,
Centered in Lanes

~~4~~ Ea. 1 - 6'x6'
~~Loop Detectors,~~
~~Centered in Lanes~~
DELETED PER RF1 #24
DATED 10/28/08

LEGEND FOR AS-BUILT POSTINGS	
	Squiggly line for as-built deletion
	Double line for as-built deletion
Roadway	Text for as-built posting

STATE OF HAWAII
DEPARTMENT OF TRANSPORTATION
HIGHWAYS DIVISION

LOOP DETECTOR PLAN

KAMEHAMEHA HIGHWAY REHABILITATION
WAIHAU STREET to H-2 INTERCHANGE
FEDERAL AID PROJECT NO. NH-099-1(24)

Scale: 1"=20' Date: Aug. 2006

SHEET No. 73 OF 18 SHEETS

SURVEY PLOTTED BY	DATE
DRAWN BY	
DESIGNED BY	
CHECKED BY	
ORIGINAL PLAN	
NOTE BOOK	
No. 101000	

"AS-BUILT"