


FED. ROAD DIST. NO.	STATE	FED. AID PROJ. NO.	FISCAL YEAR	SHEET NO.	TOTAL SHEETS
HAWAII	HAW.	NH-099-1(24)	2007	ADD.61	74

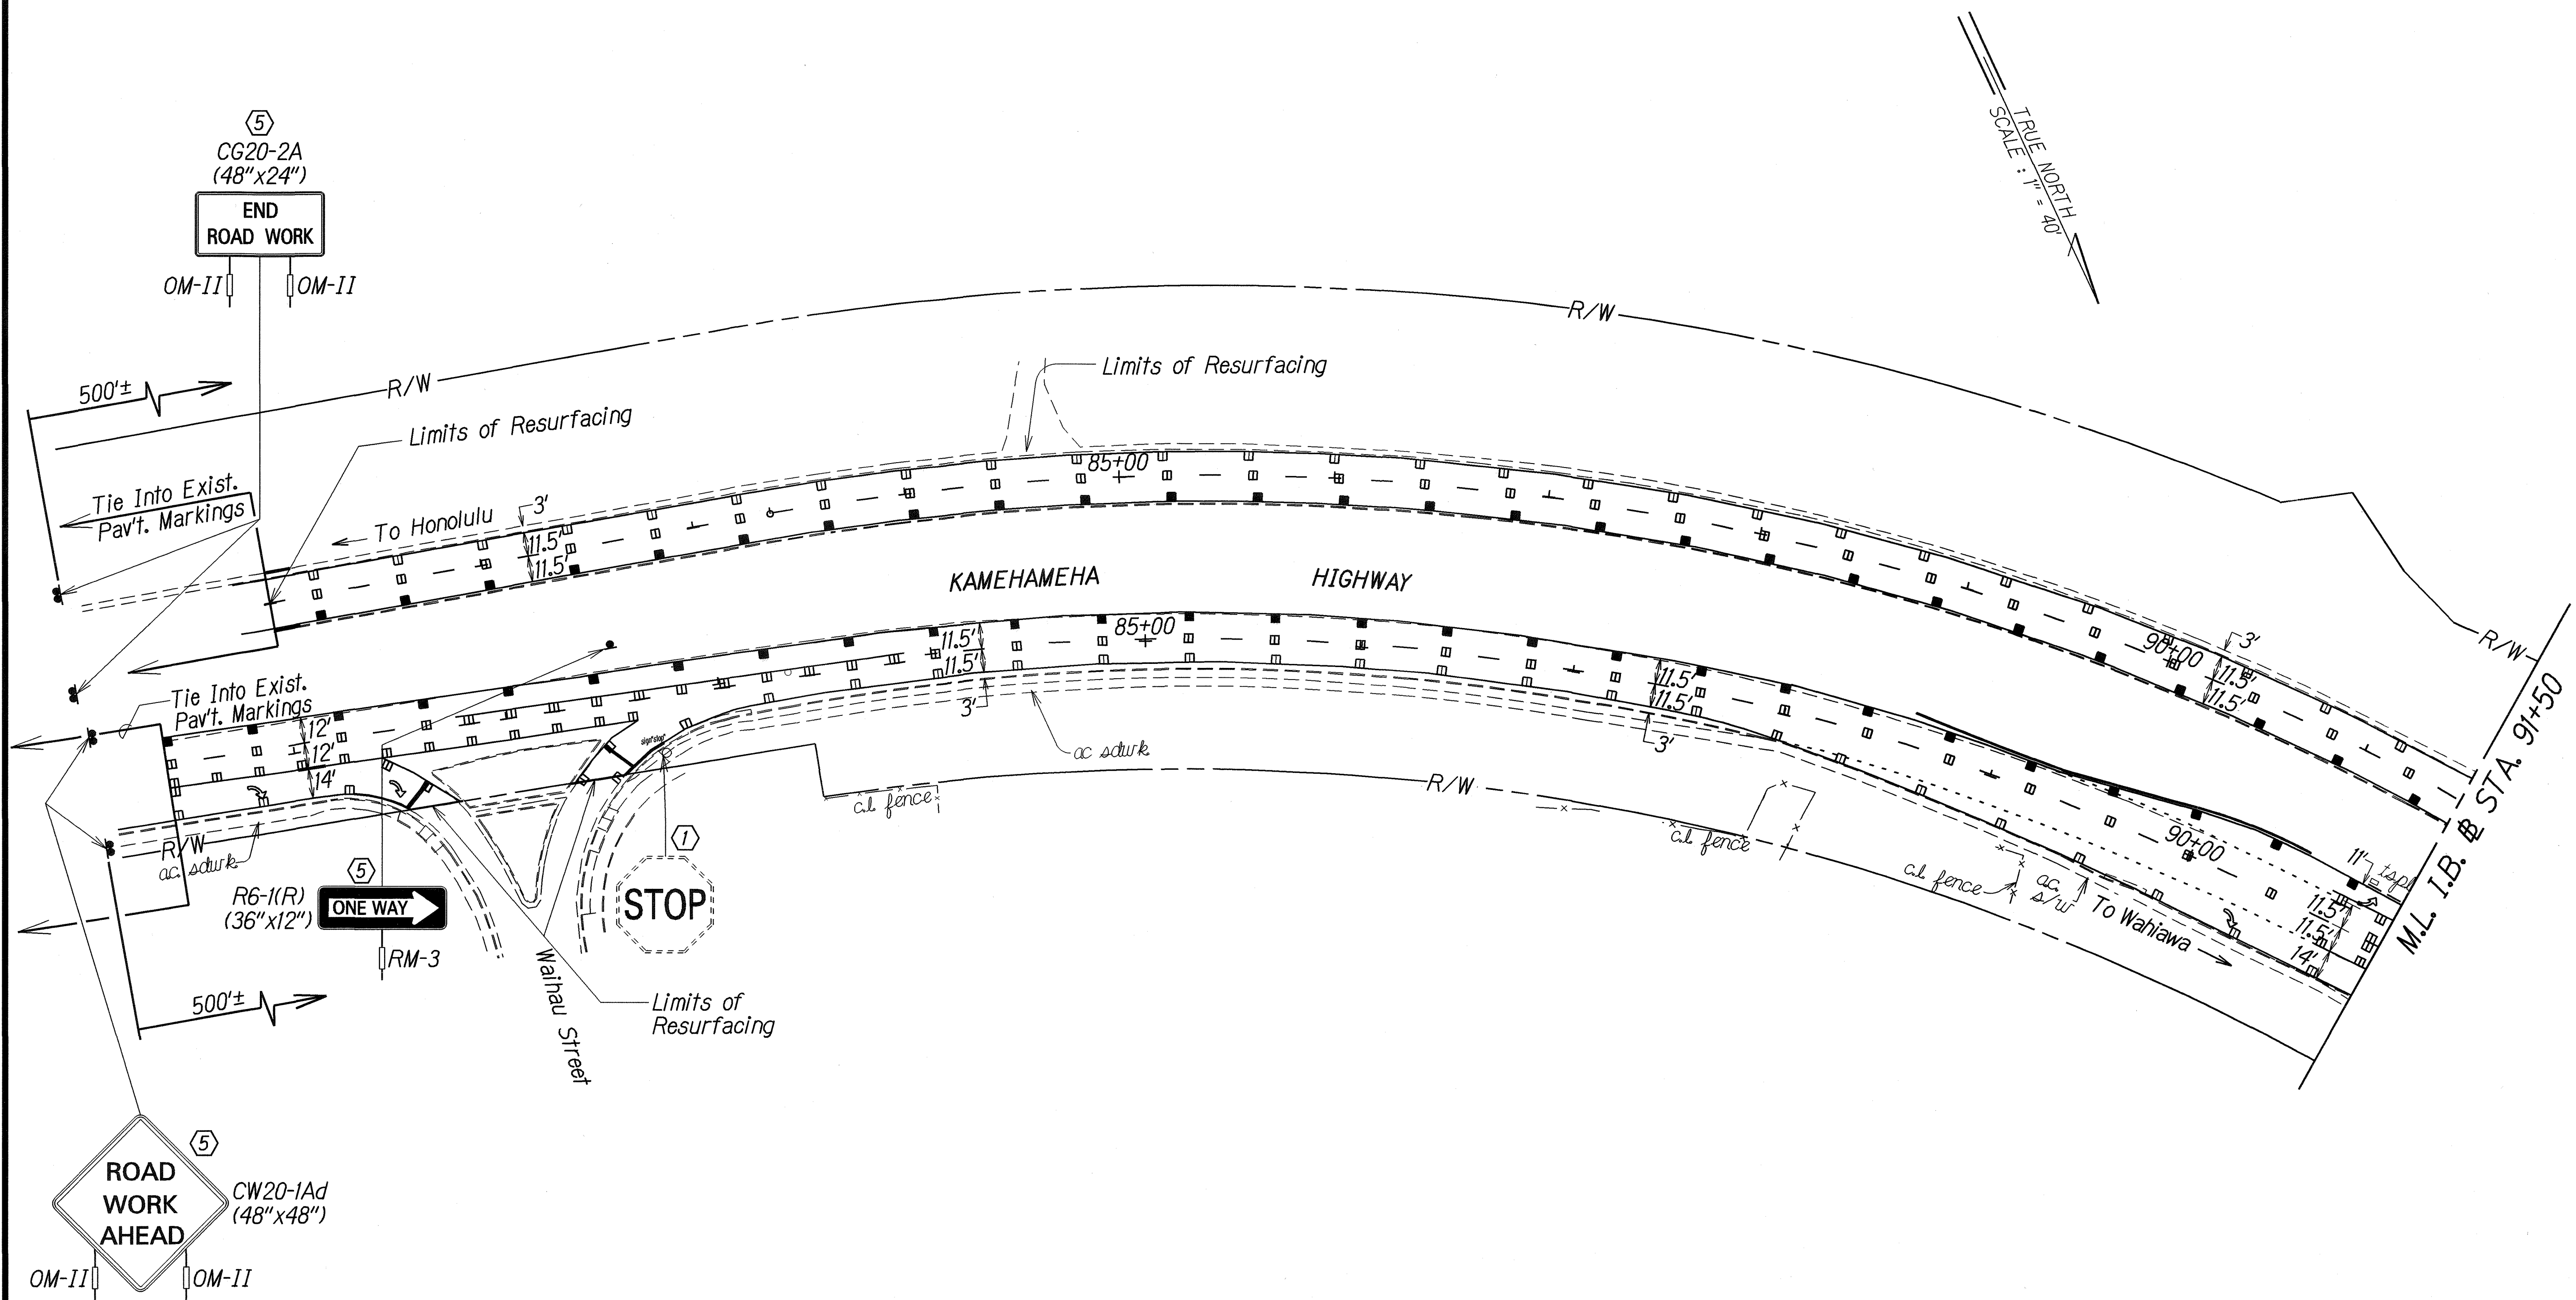

SURVEY PLOTTED BY	DATE
DESIGNED BY	6/16/06
TRACED BY	
NOTED BY	
QUANTITIES BY	
CHECKED BY	
ORIGINAL PLAN	
DATE	
BY	
REVISION	
DATE	
BY	

LEGEND
 Bike Lane Marking

- KEY:**
- ① Exist. Sign(s) & Post(s) to Remain
 - ② Remove Exist. Sign(s) w/Post(s)
 - ③ Remove Exist. Sign(s) w/Post(s) & Install New Sign(s) w/Post(s)
 - ④ Remove Exist. Sign(s) and Reinstall on New Post(s)
 - ⑤ Install New Sign(s) w/Post(s)


2/8/07	Revised striping.
DATE	REVISION

STATE OF HAWAII
DEPARTMENT OF TRANSPORTATION
HIGHWAYS DIVISION

PAVEMENT MARKING & STRIPING PLAN
KAMEHAMEHA HIGHWAY REHABILITATION
WAIHAU STREET to H-2 INTERCHANGE
FEDERAL AID PROJECT NO. NH-099-1(24)
Scale: 1"=40' Date: June 2006

SHEET No. 75 OF 18 SHEETS

FED. ROAD DIST. NO.	STATE	FED. AID PROJ. NO.	FISCAL YEAR	SHEET NO.	TOTAL SHEETS
HAWAII	HAW.	NH-099-1(24)	2007	ADD.62	74

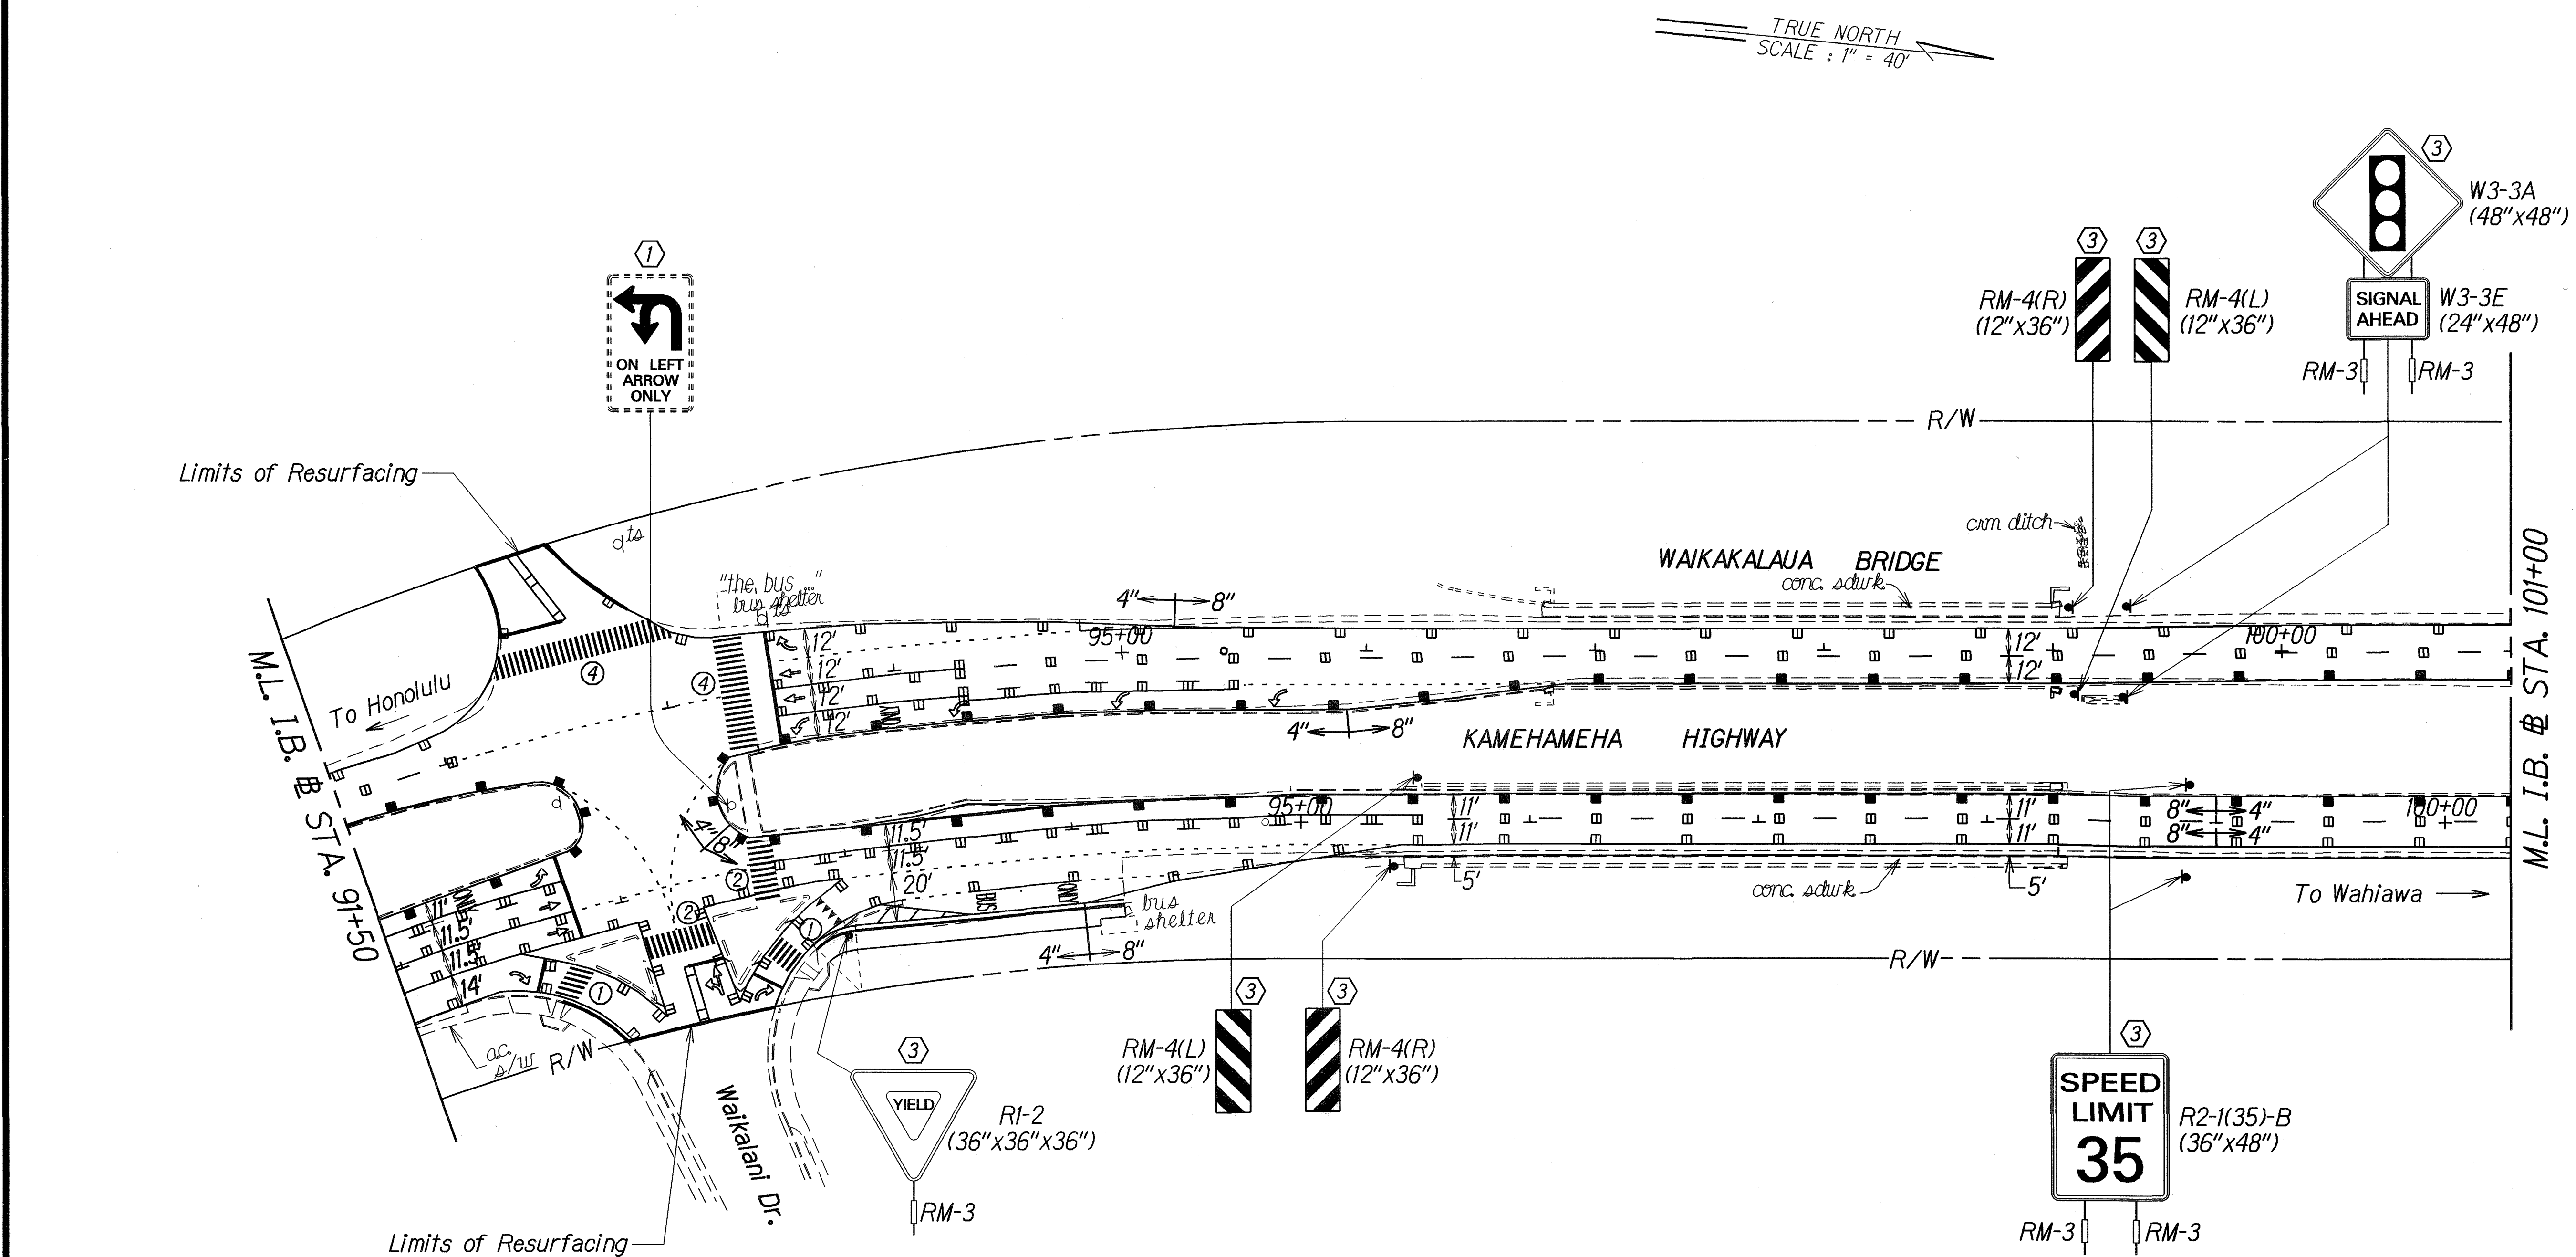

SURVEY PLOTTED BY	DATE
DESIGNED BY	8/16/06
NOTED BY	
CHECKED BY	

LEGEND
 Bike Lane Marking

- KEY:**
- ① Exist. Sign(s) & Post(s) to Remain
 - ② Remove Exist. Sign(s) w/Post(s)
 - ③ Remove Exist. Sign(s) w/Post(s) & Install New Sign(s) w/Post(s)
 - ④ Remove Exist. Sign(s) and Reinstall on New Post(s)
 - ⑤ Install New Sign(s) w/Post(s)



2/8/07	Revised striping & roadway signs.
DATE	REVISION

STATE OF HAWAII
DEPARTMENT OF TRANSPORTATION
HIGHWAYS DIVISION

PAVEMENT MARKING & STRIPING PLAN
KAMEHAMEHA HIGHWAY REHABILITATION
WAIHAU STREET to H-2 INTERCHANGE
FEDERAL AID PROJECT NO. NH-099-1(24)
Scale: 1"=40' Date: June 2006

SHEET No. T6 OF 18 SHEETS

FED. ROAD DIST. NO.	STATE	FED. AID PROJECT NO.	FISCAL YEAR	SHEET NO.	TOTAL SHEETS
HAWAII	HAW.	NH-099-1(24)	2007	ADD.63	74

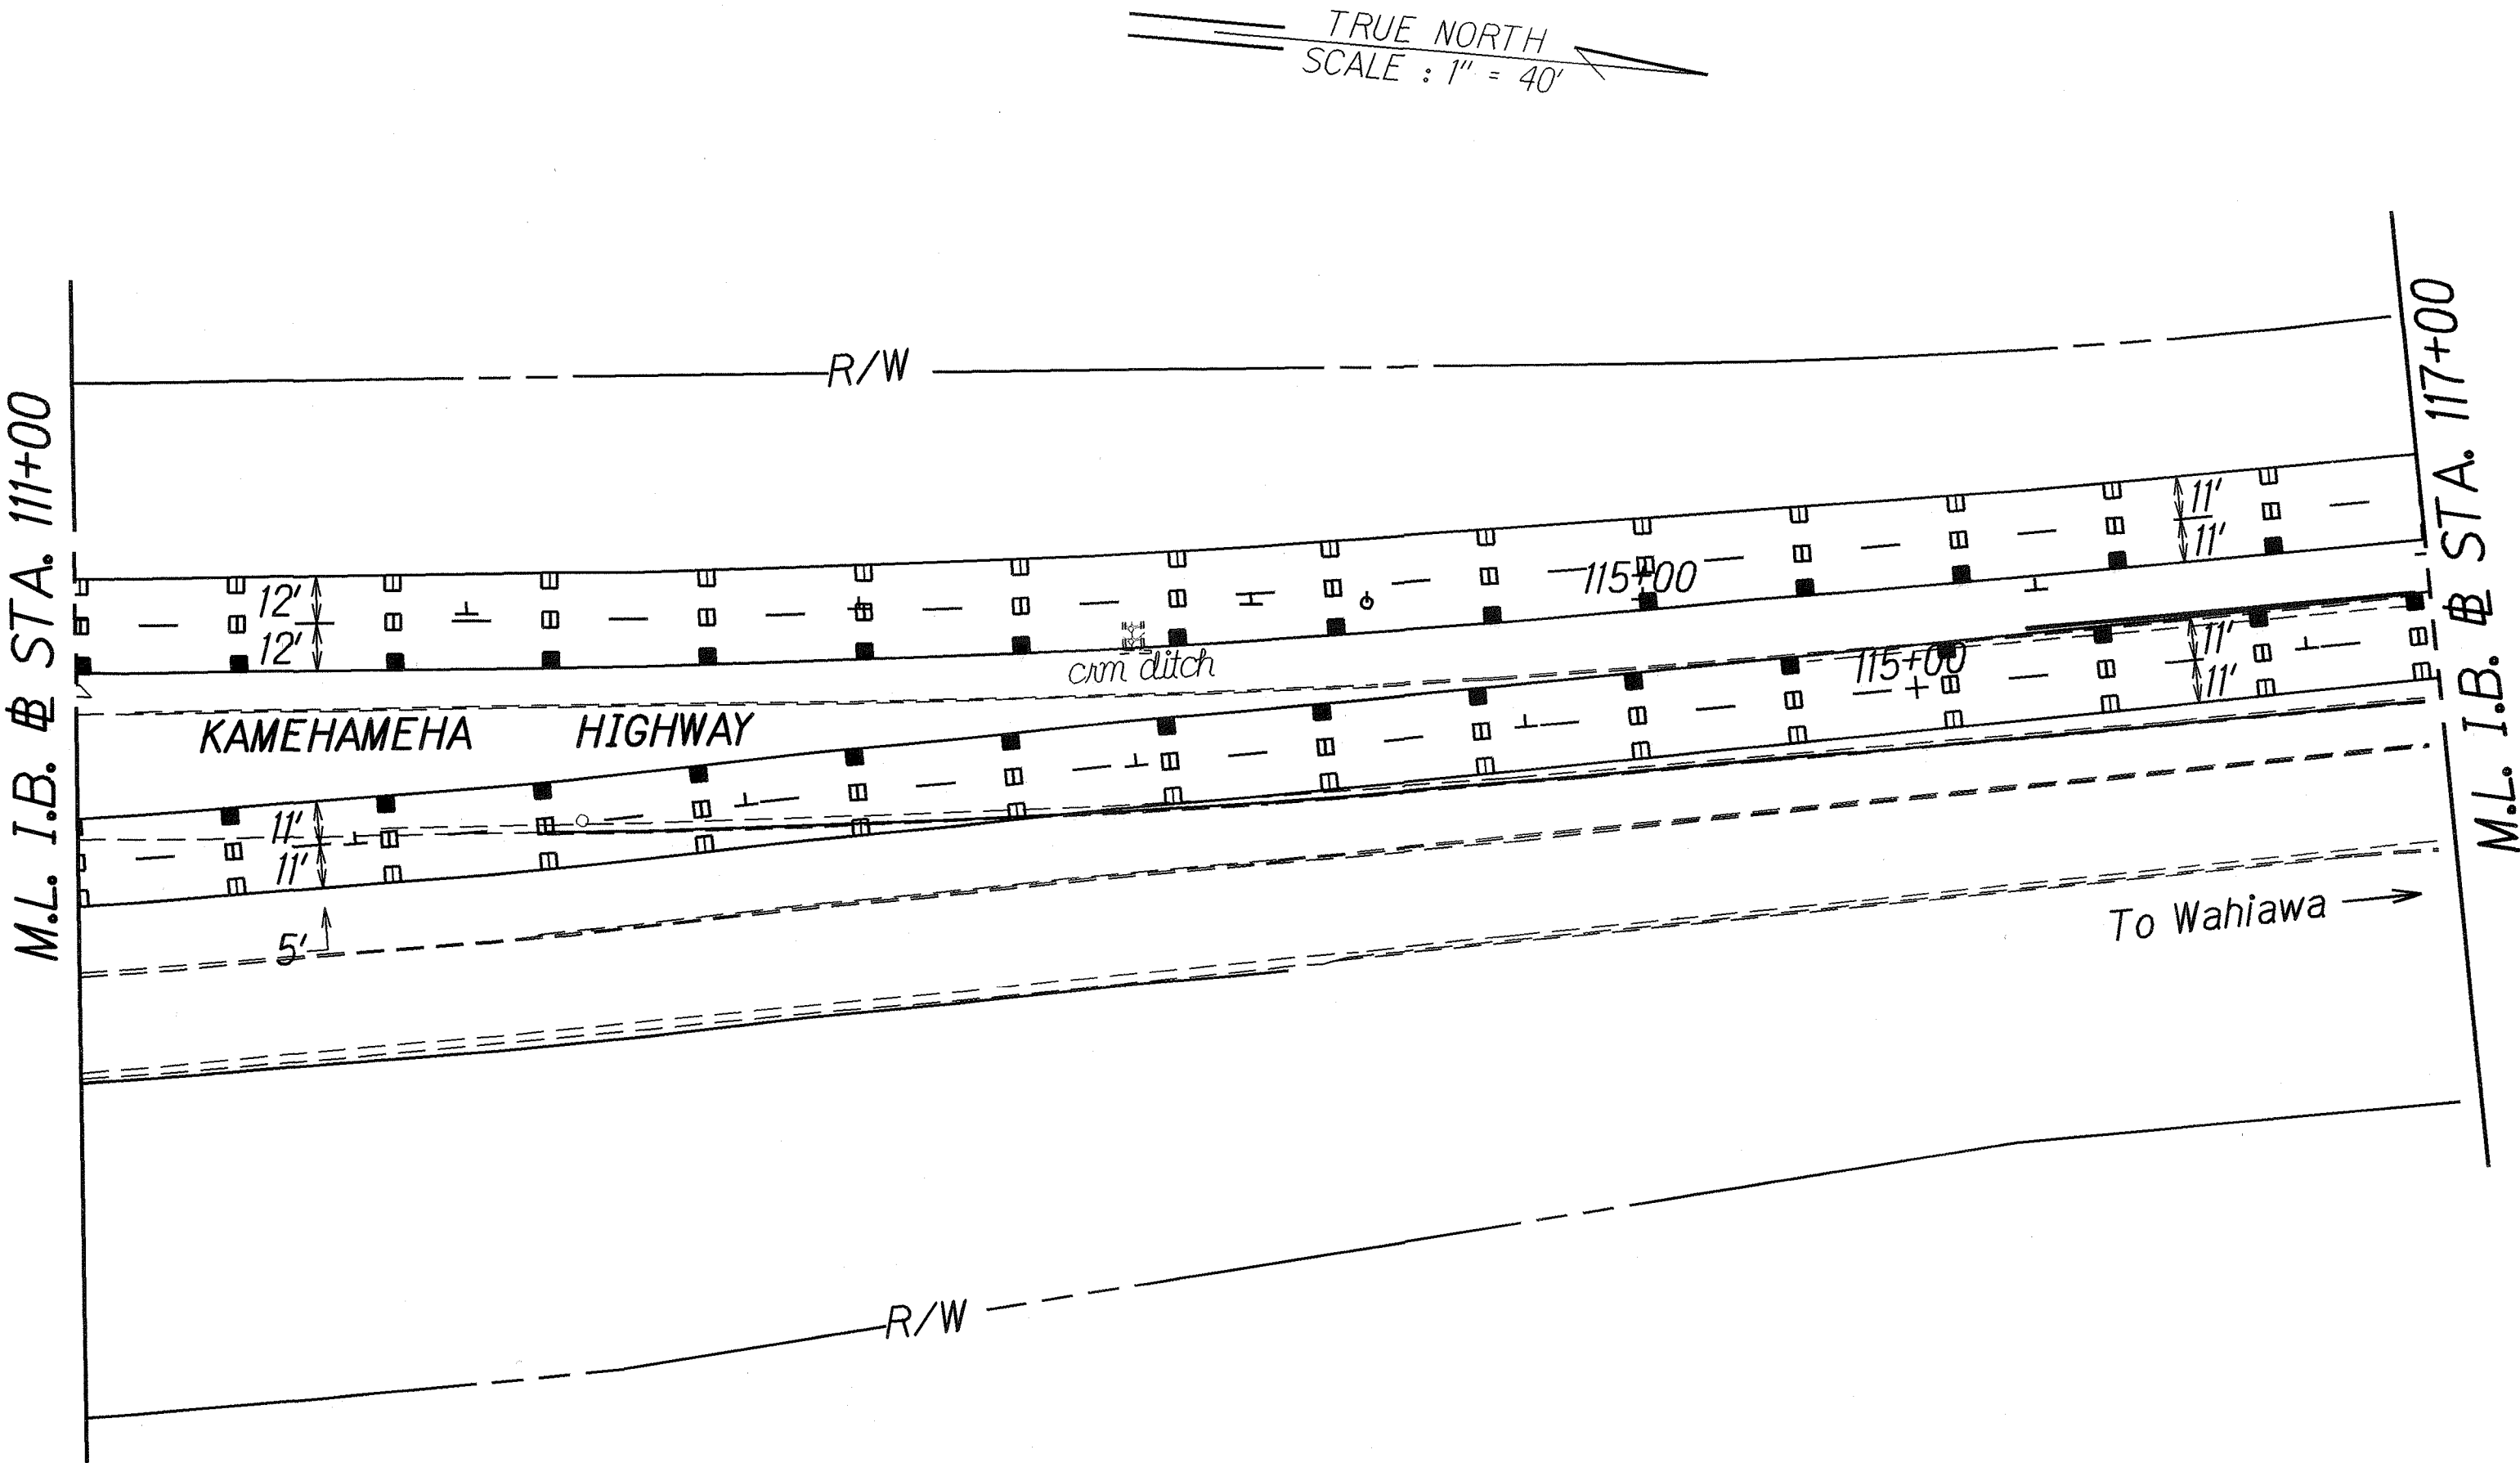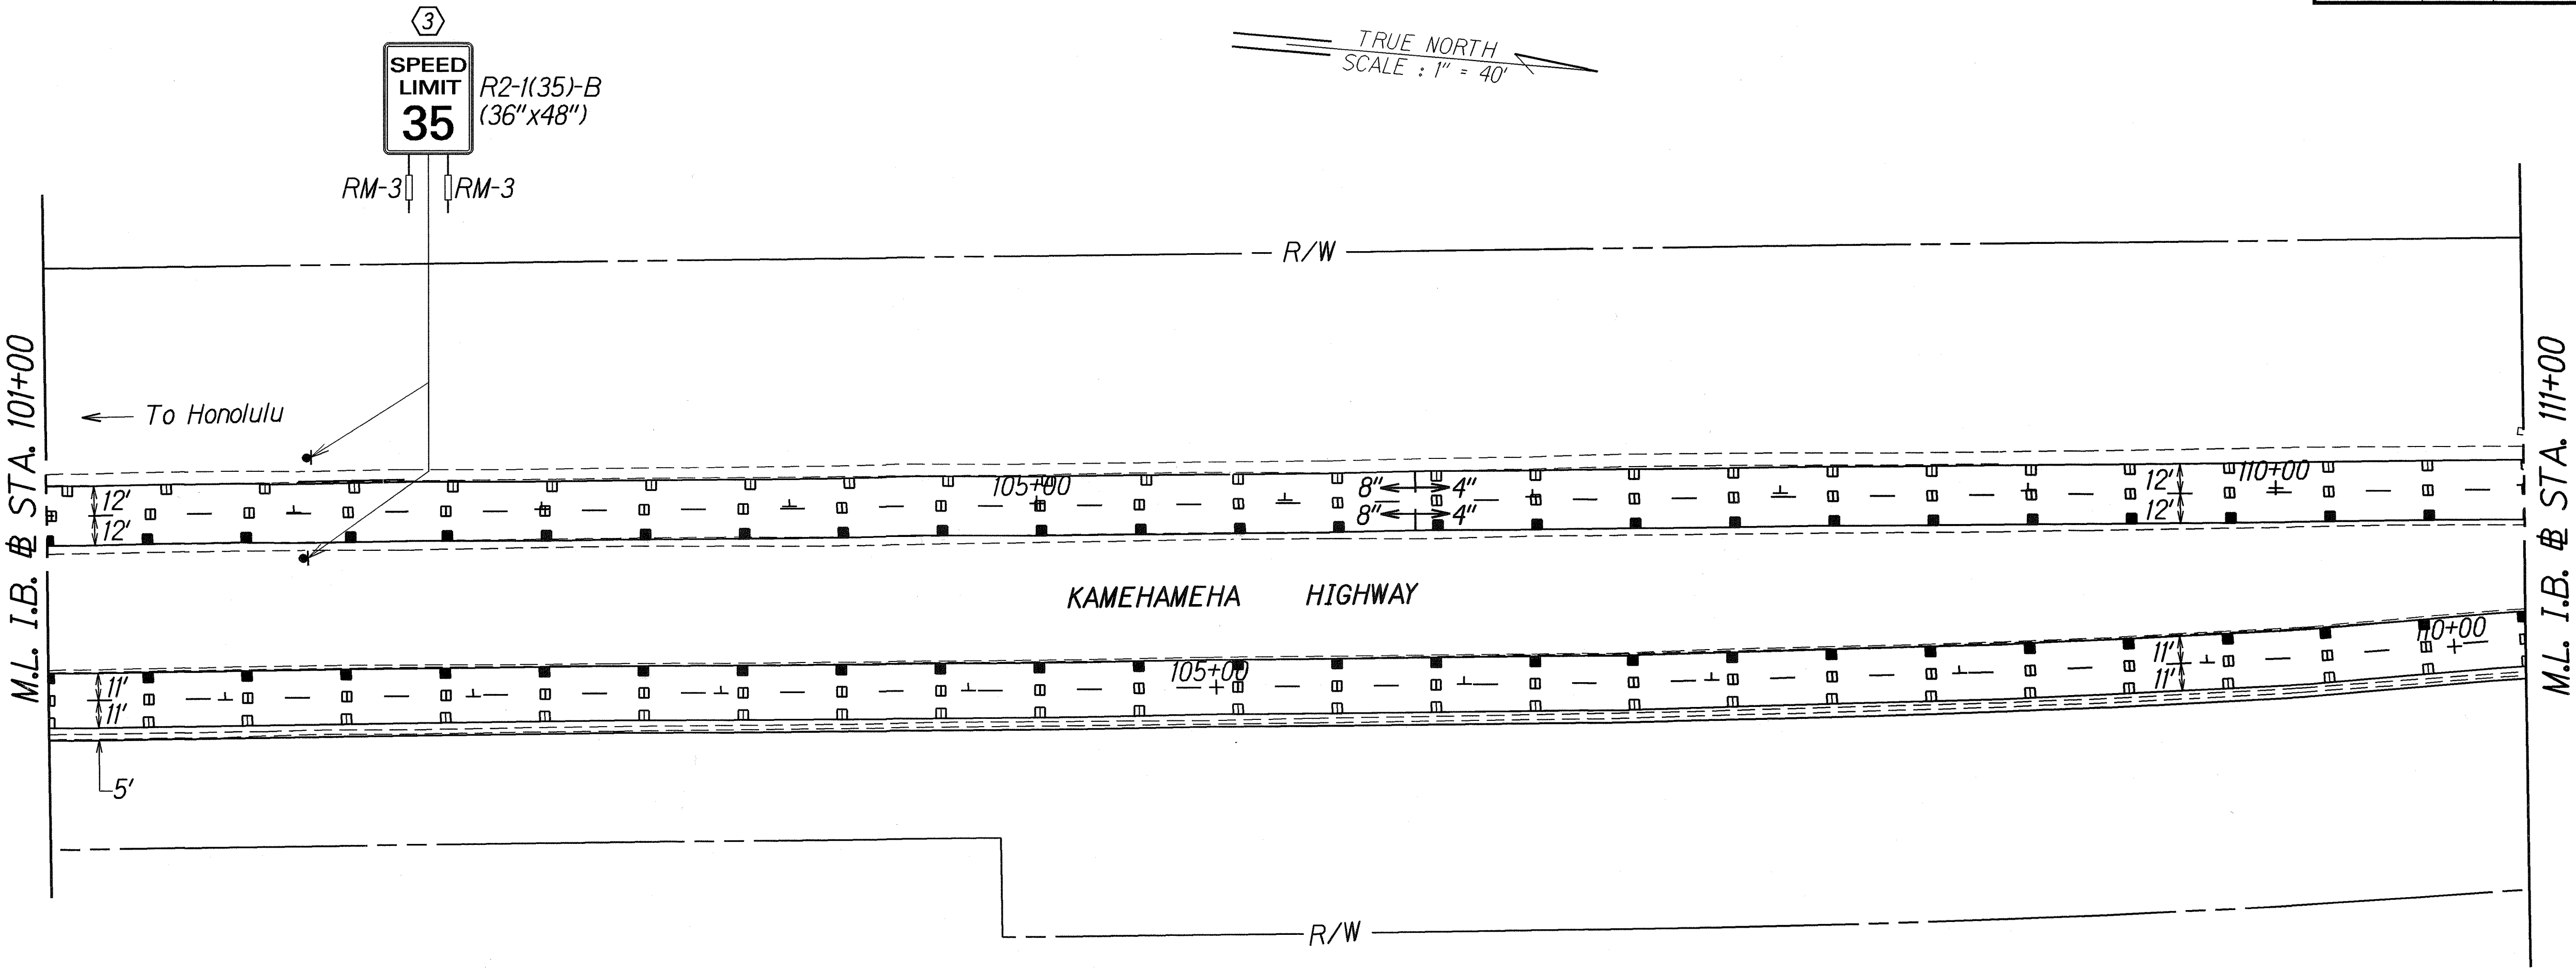

- KEY:**
- ① Exist. Sign(s) & Post(s) to Remain
 - ② Remove Exist. Sign(s) w/Post(s)
 - ③ Remove Exist. Sign(s) w/Post(s) & Install New Sign(s) w/Post(s)
 - ④ Remove Exist. Sign(s) and Reinstall on New Post(s)
 - ⑤ Install New Sign(s) w/Post(s)

ORIGINAL PLAN	SURVEY PLOTTED BY	DATE
NOTE BOOK	DRAWN BY	5/16/06
DESIGNED BY	CHECKED BY	
CHECKED BY		



2/8/07	Removed roadway signs.
DATE	REVISION

STATE OF HAWAII
DEPARTMENT OF TRANSPORTATION
HIGHWAYS DIVISION


PAVEMENT MARKING & STRIPING PLAN
KAMEHAMEHA HIGHWAY REHABILITATION
WAIHAU STREET to H-2 INTERCHANGE
FEDERAL AID PROJECT NO. NH-099-1(24)
Scale: 1"=40' Date: June 2006

SHEET No. 77 OF 18 SHEETS

FED. ROAD DIST. NO.	STATE	FED. AID PROJ. NO.	FISCAL YEAR	SHEET NO.	TOTAL SHEETS
HAWAII	HAW.	NH-099-1(24)	2007	ADD.64	74

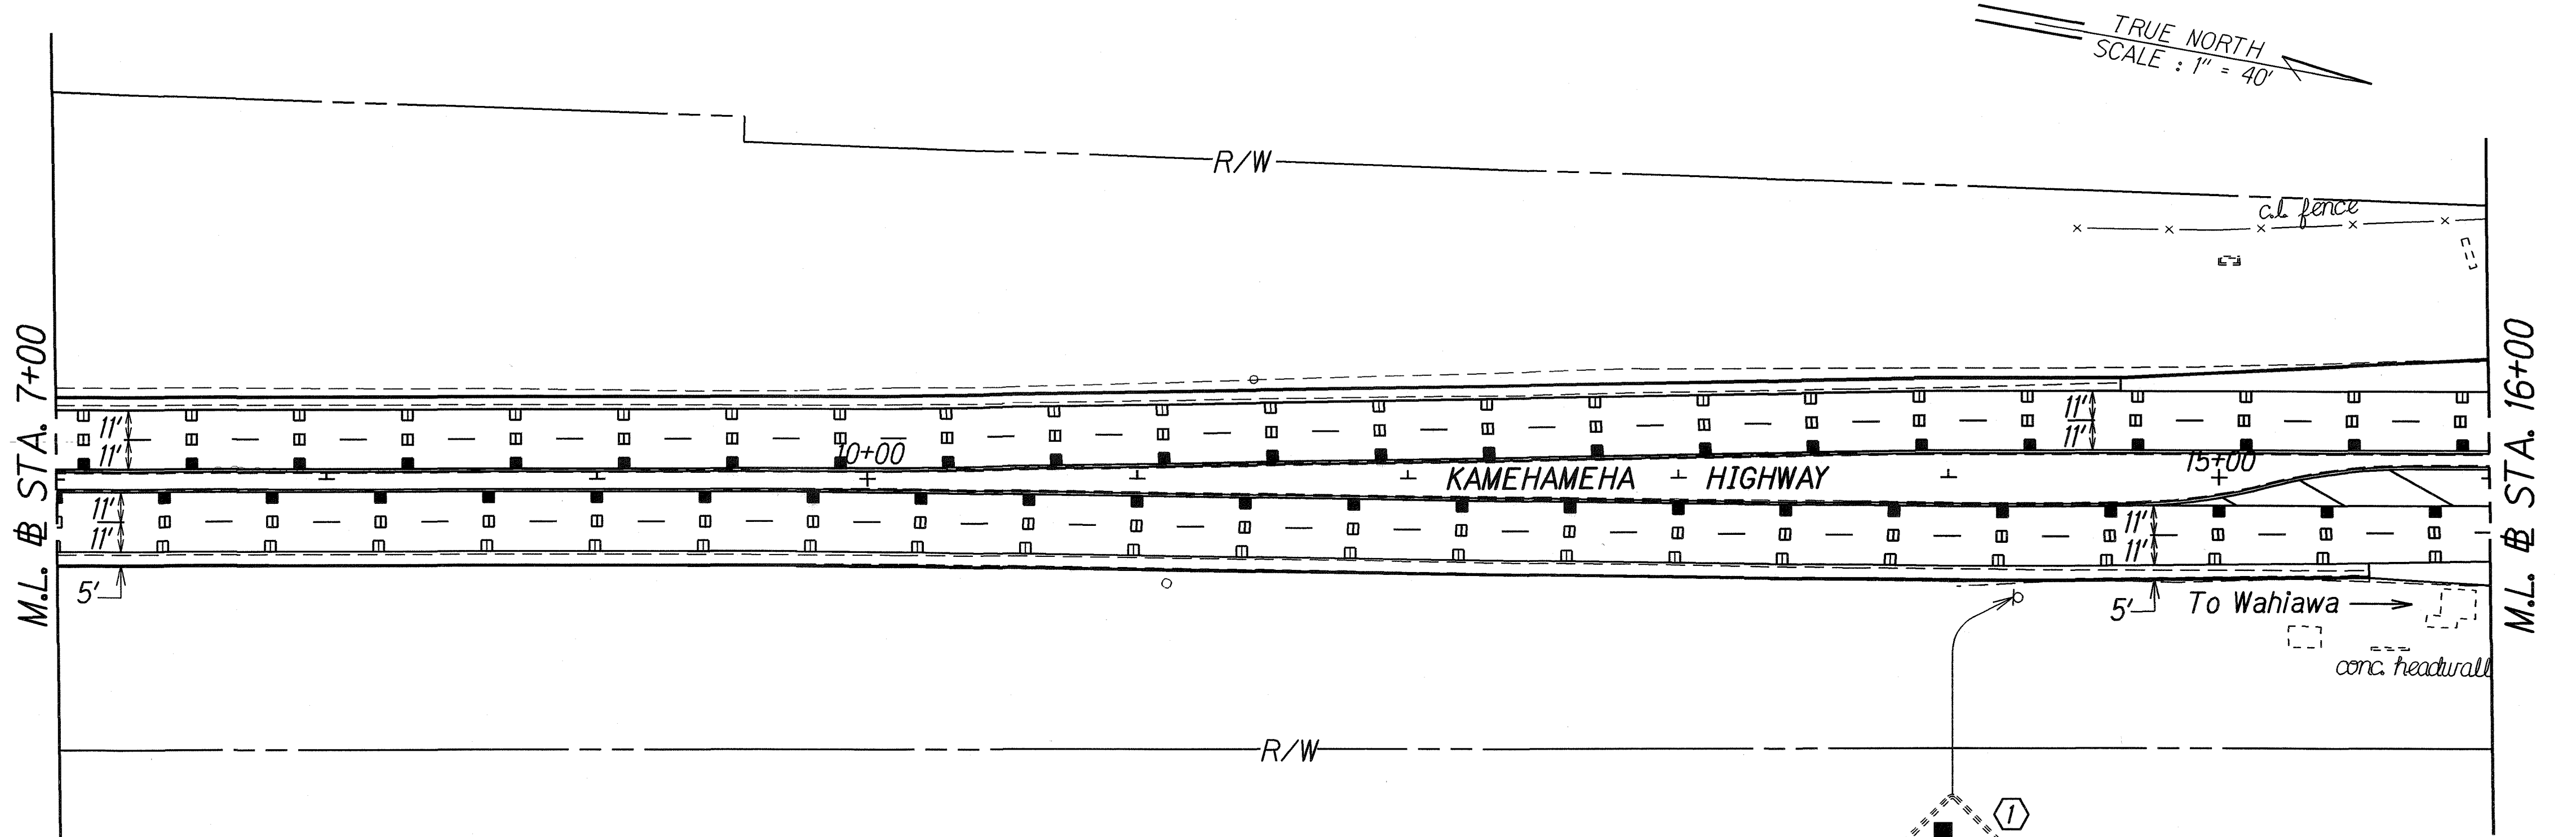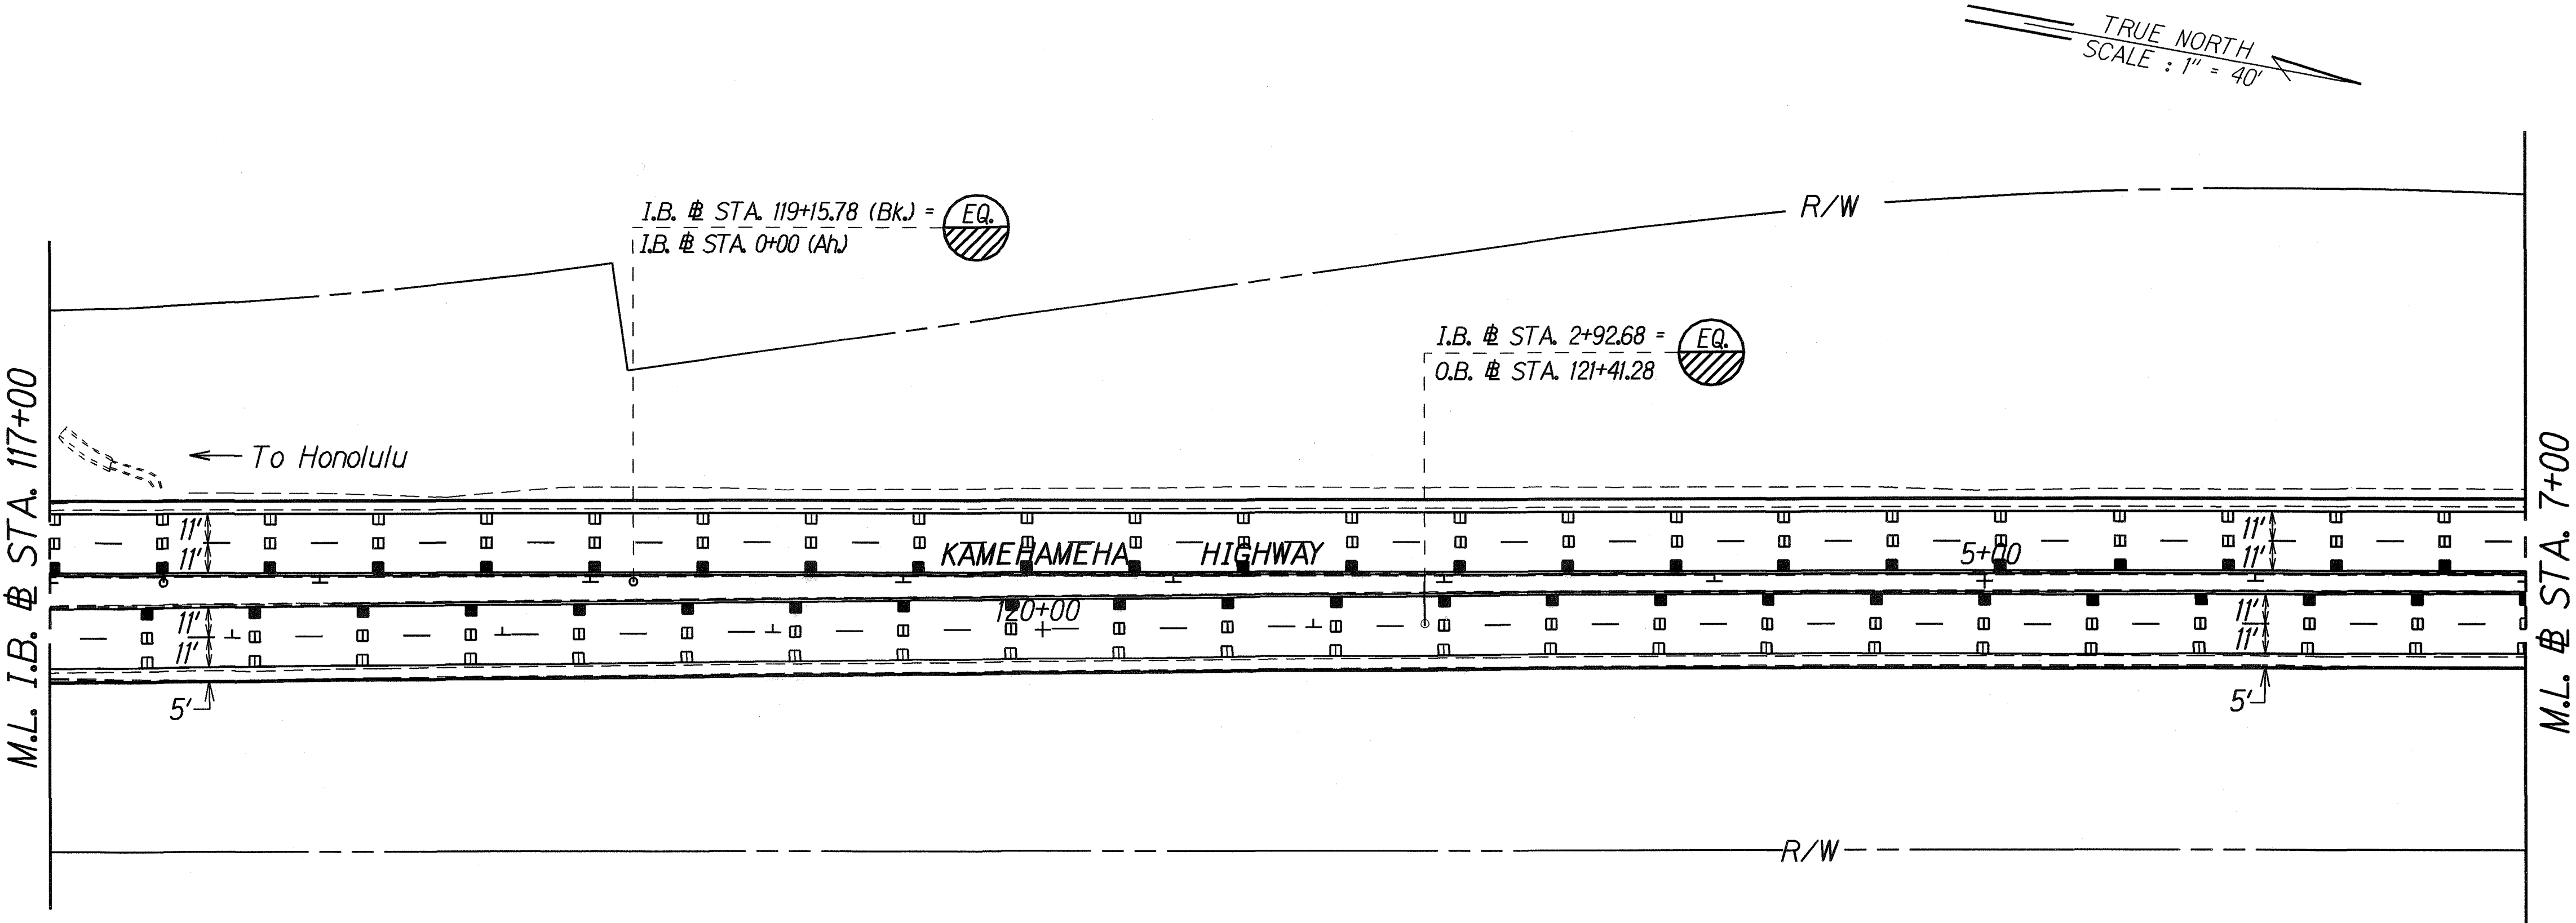

- KEY:**
- ① Exist. Sign(s) & Post(s) to Remain
 - ② Remove Exist. Sign(s) w/Post(s)
 - ③ Remove Exist. Sign(s) w/Post(s) & Install New Sign(s) w/Post(s)
 - ④ Remove Exist. Sign(s) and Reinstall on New Post(s)
 - ⑤ Install New Sign(s) w/Post(s)

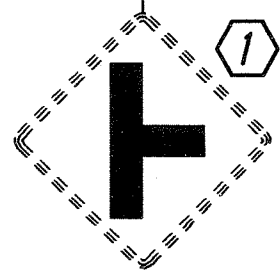


2/8/07	Added Equation Station labels.
DATE	REVISION

STATE OF HAWAII
DEPARTMENT OF TRANSPORTATION
HIGHWAYS DIVISION

PAVEMENT MARKING & STRIPING PLAN
KAMEHAMEHA HIGHWAY REHABILITATION
WAIHAU STREET to H-2 INTERCHANGE
FEDERAL AID PROJECT NO. NH-099-1(24)
Scale: 1"=40' Date: June 2006

SHEET No. 78 OF 18 SHEETS

FED. ROAD DIST. NO.	STATE	FED. AID PROJ. NO.	FISCAL YEAR	SHEET NO.	TOTAL SHEETS
HAWAII	HAW.	NH-099-1(24)	2007	ADD.65	74

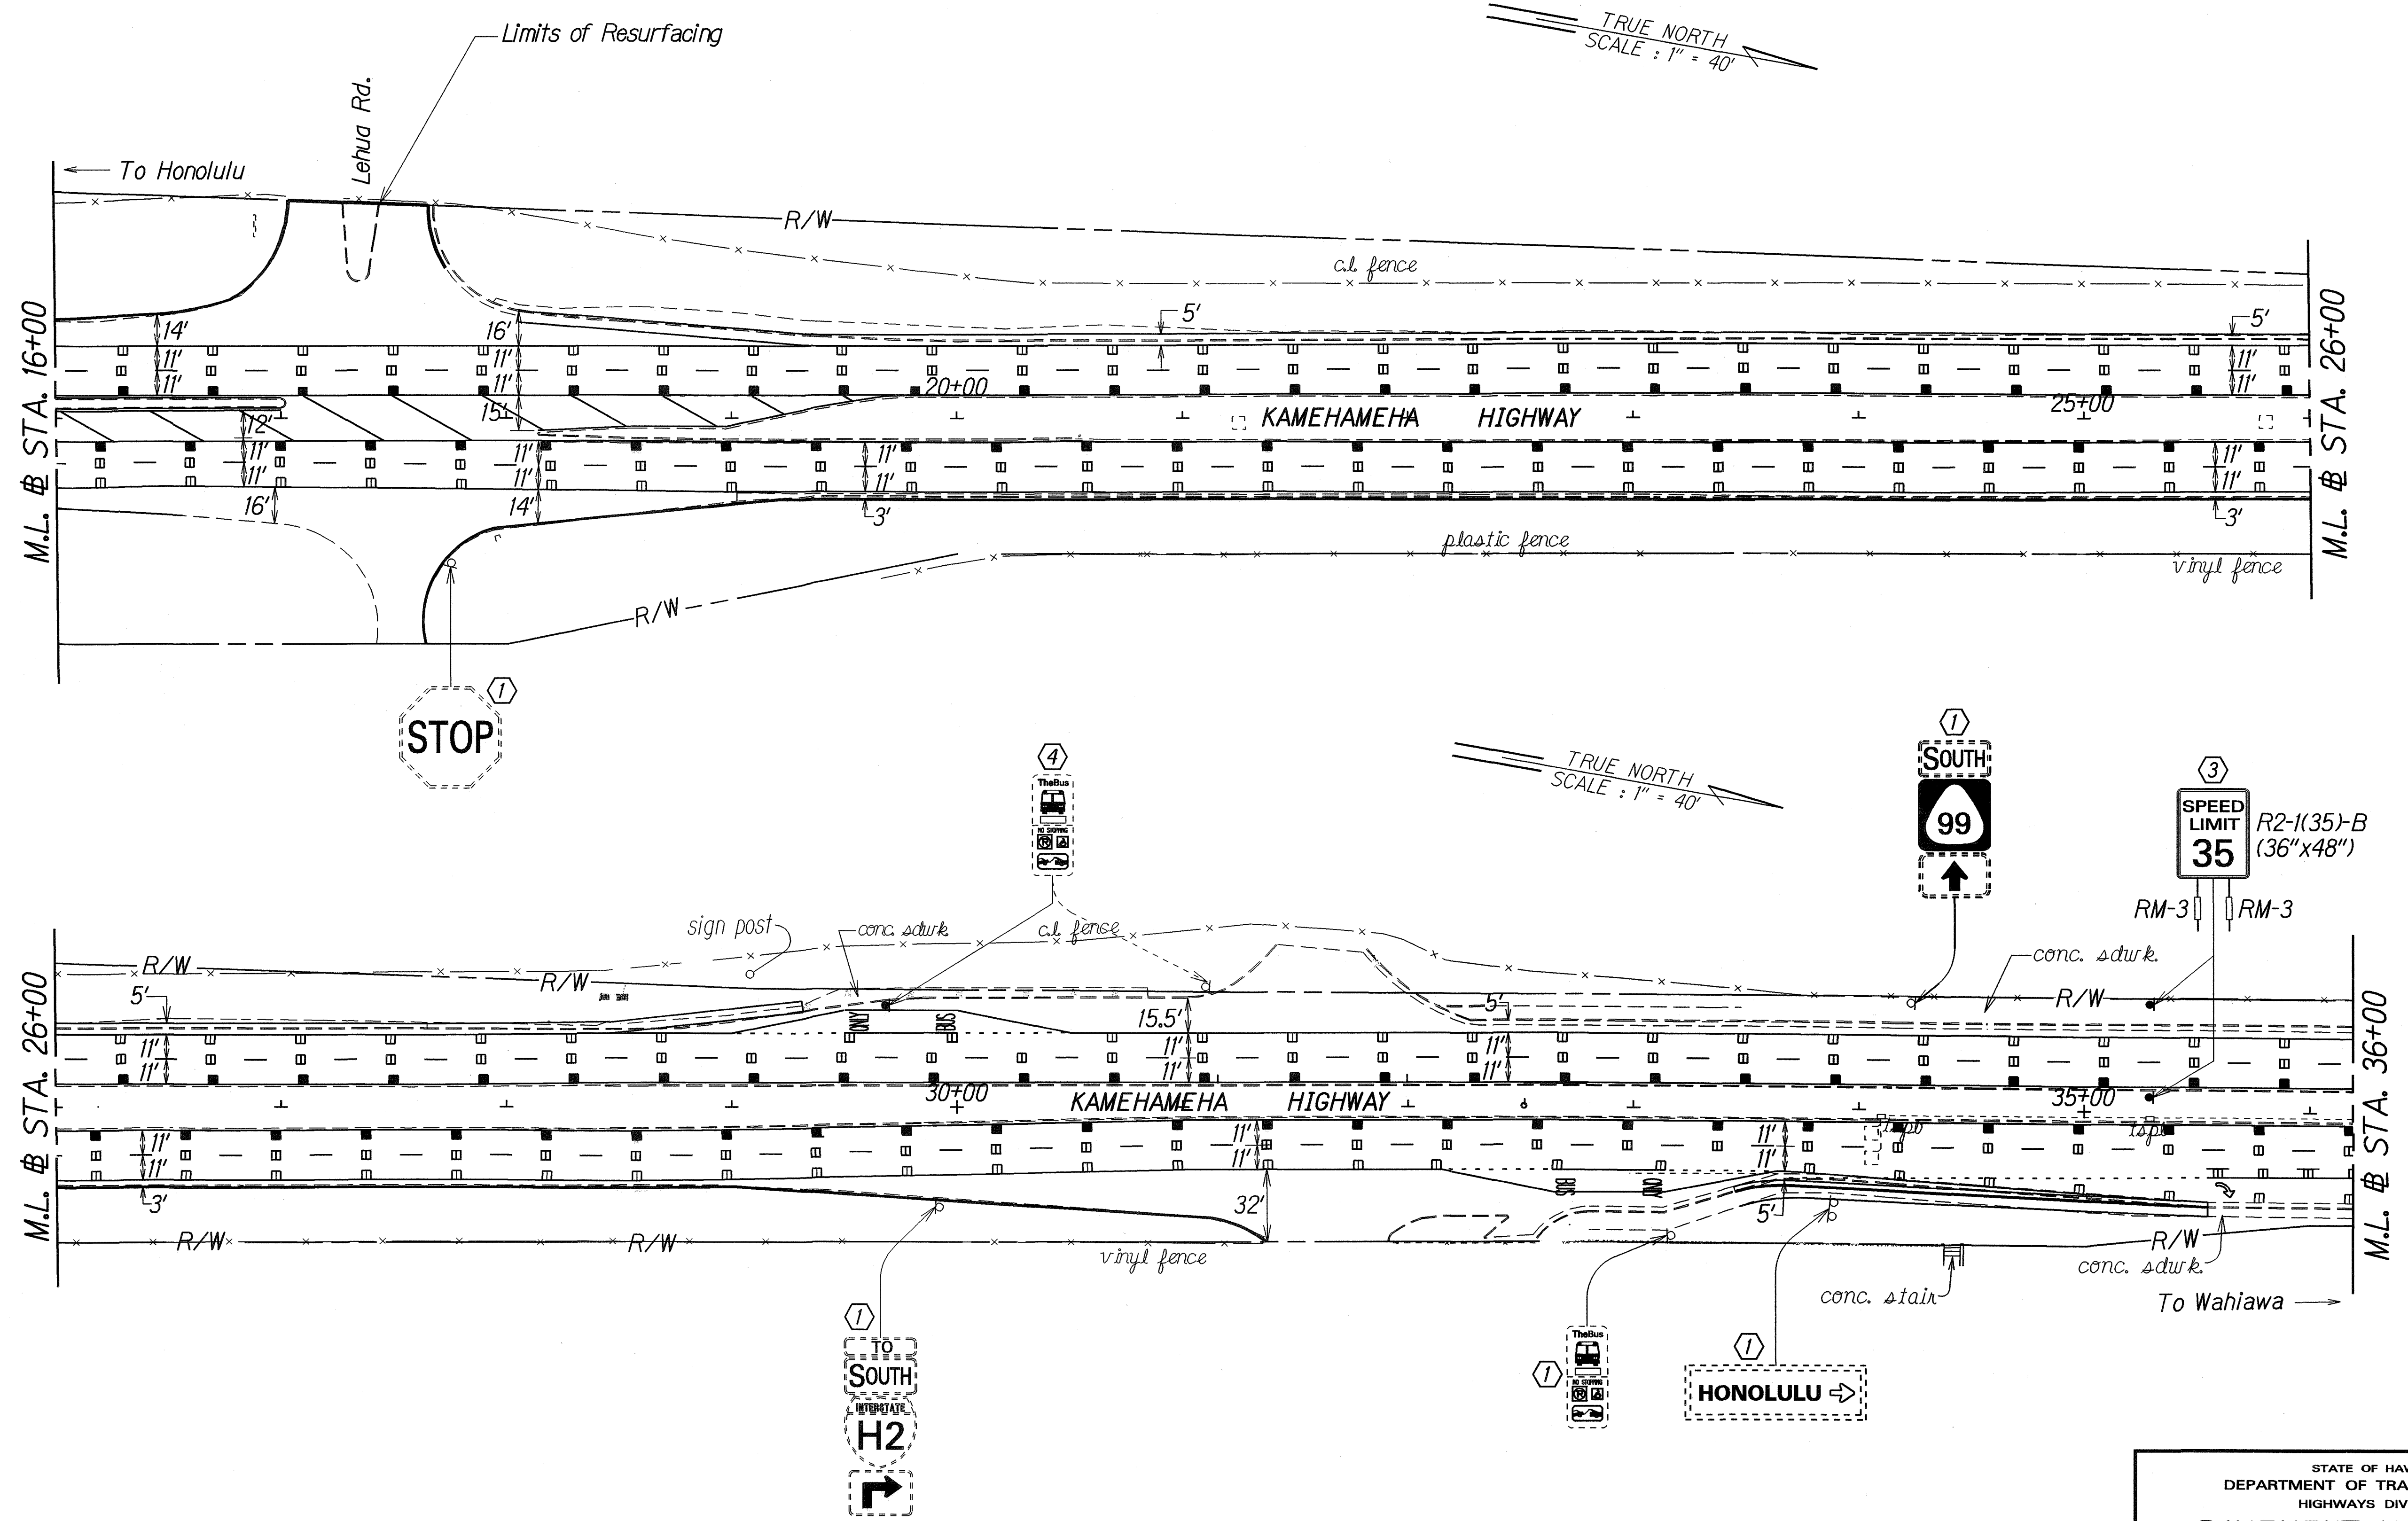

- KEY:**
- ① Exist. Sign(s) & Post(s) to Remain
 - ② Remove Exist. Sign(s) w/Post(s)
 - ③ Remove Exist. Sign(s) w/Post(s) & Install New Sign(s) w/Post(s)
 - ④ Remove Exist. Sign(s) and Reinstall on New Post(s)
 - ⑤ Install New Sign(s) w/Post(s)

ORIGINAL	DESIGNED BY	DATE
PLAN	TRACED BY	7/16/06
NOTE BOOK	DESIGNED BY	
QUANTITIES BY		
CHECKED BY		

2/8/07	Revised striping & roadway signs.
DATE	REVISION

STATE OF HAWAII
DEPARTMENT OF TRANSPORTATION
HIGHWAYS DIVISION


PAVEMENT MARKING & STRIPING PLAN

KAMEHAMEHA HIGHWAY REHABILITATION
WAIHAU STREET to H-2 INTERCHANGE
FEDERAL AID PROJECT NO. NH-099-1(24)

Scale: 1"=40' Date: June 2006

SHEET No. T9 OF 18 SHEETS

FED. ROAD DIST. NO.	STATE	FED. AID PROJ. NO.	FISCAL YEAR	SHEET NO.	TOTAL SHEETS
HAWAII	HAW.	NH-099-1(24)	2007	ADD.66	74

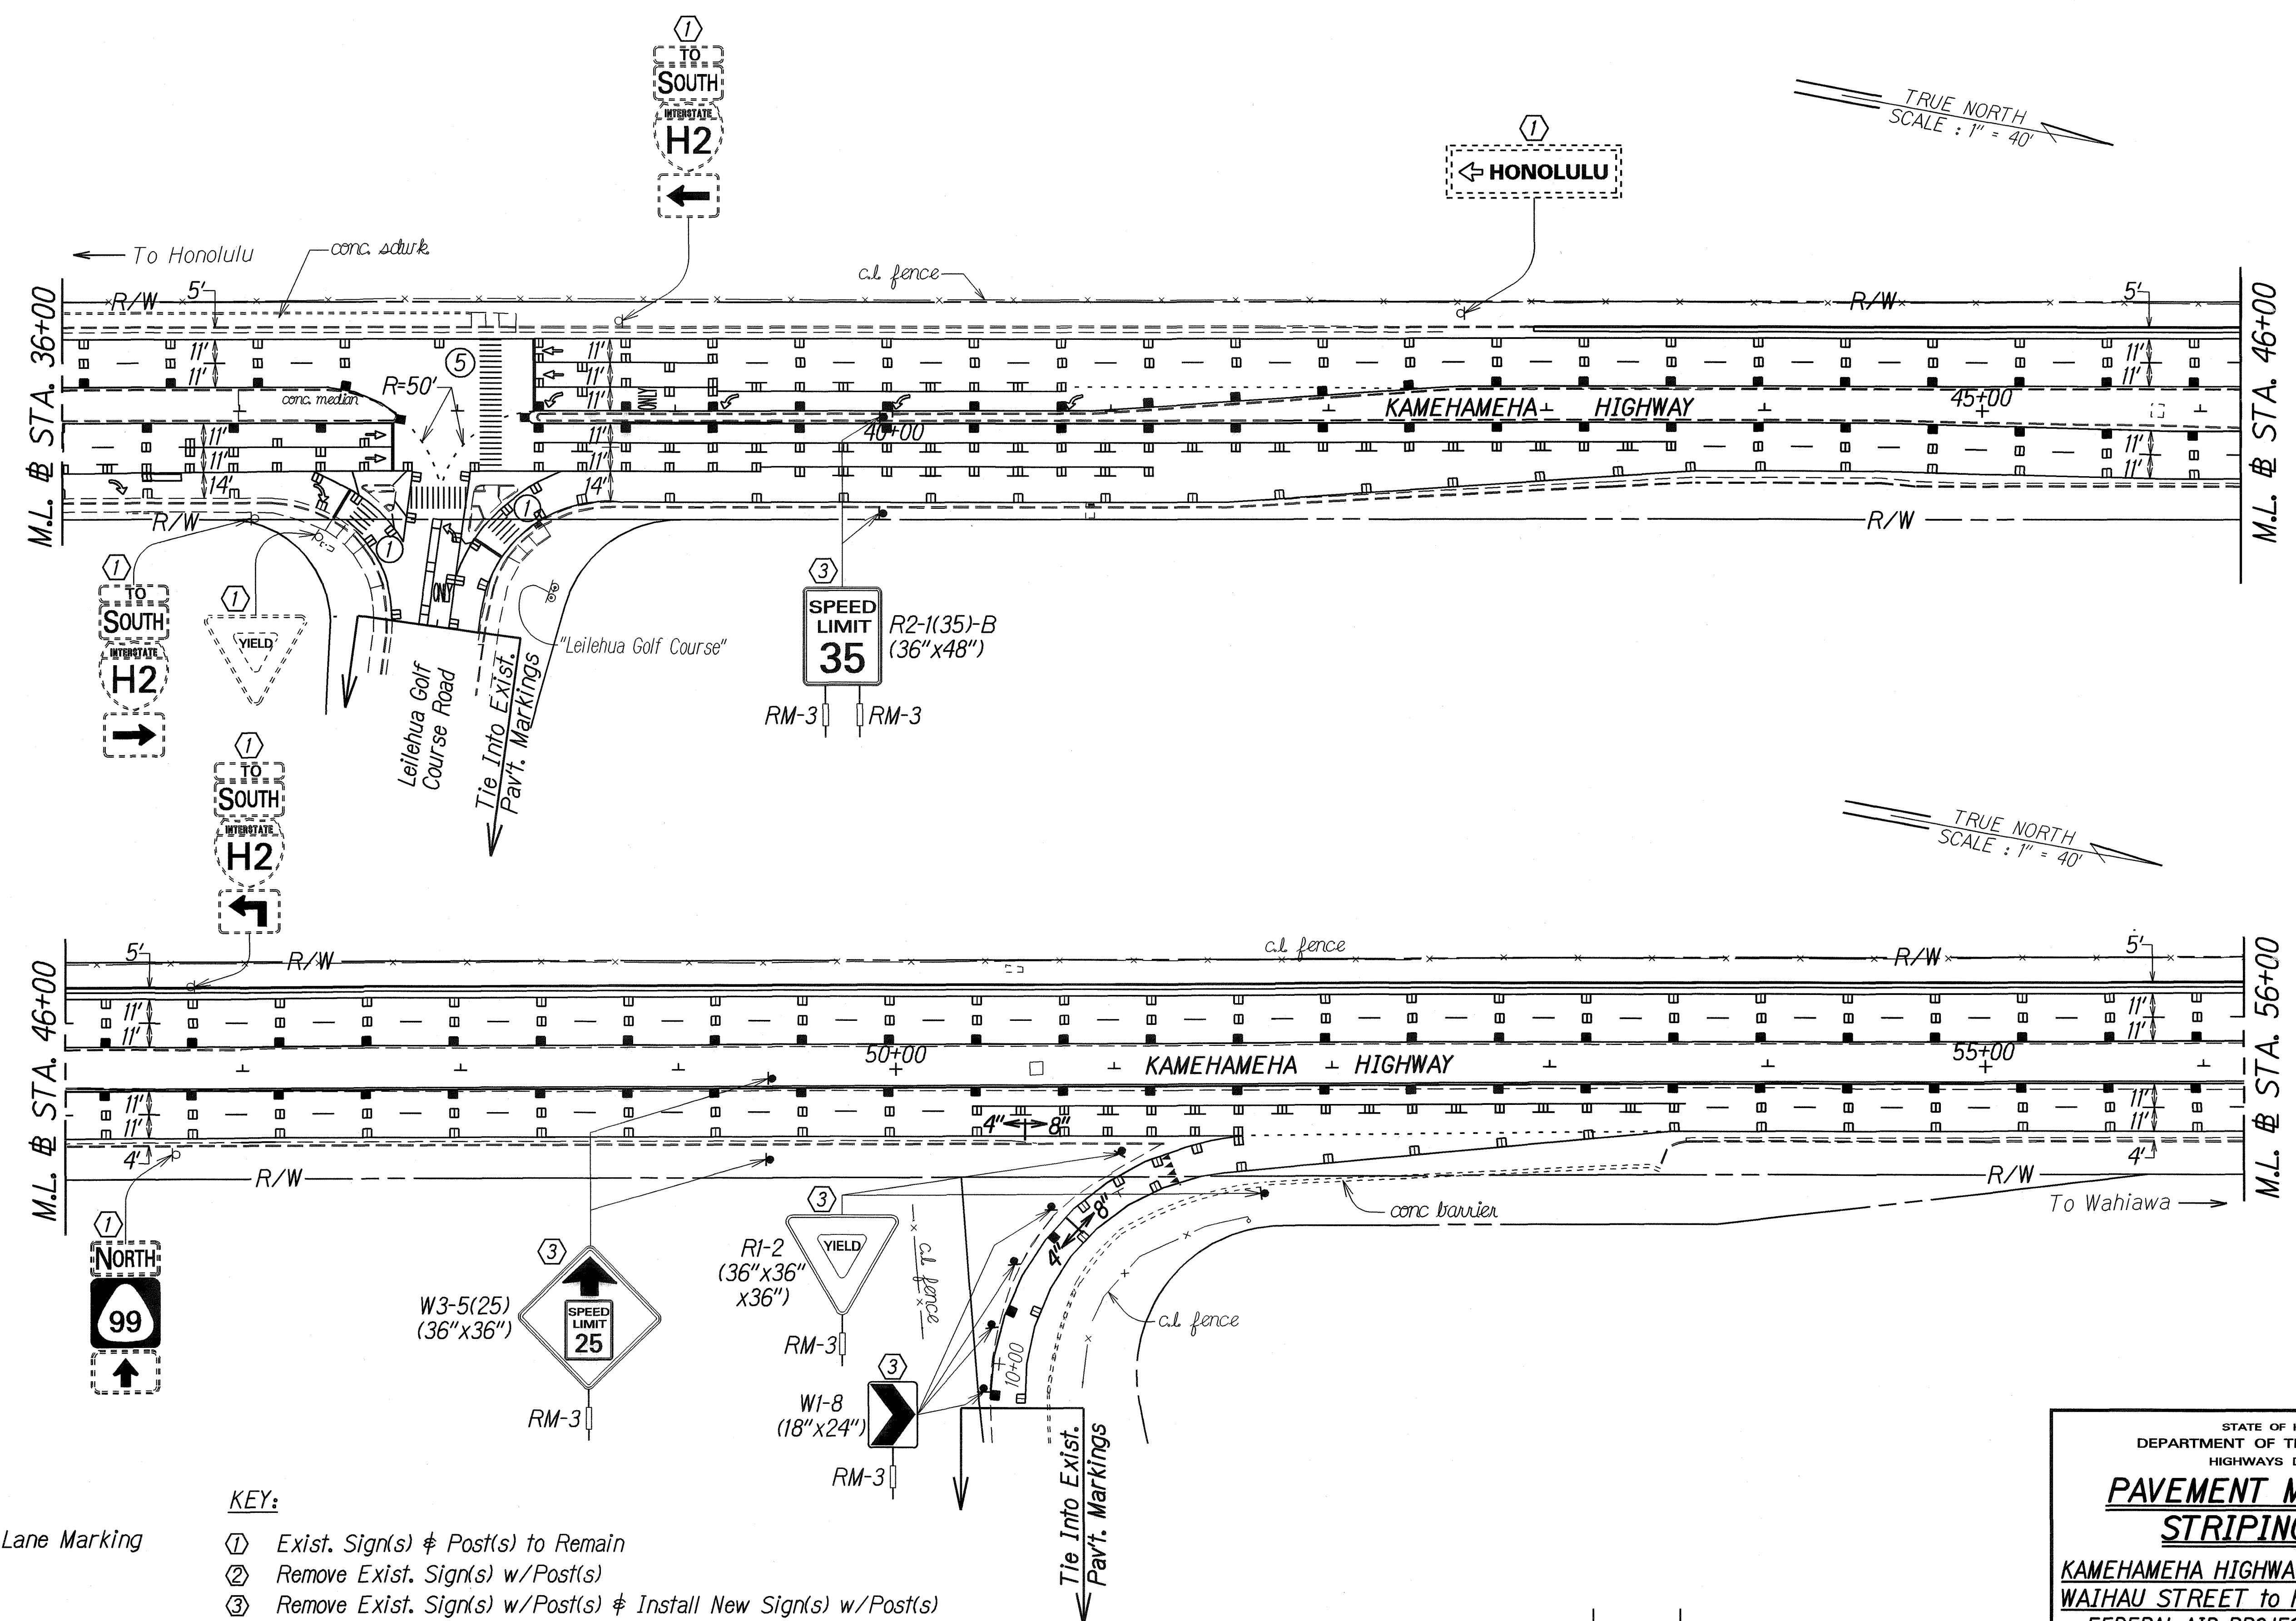

LEGEND

— Bike Lane Marking

- KEY:**
- ① Exist. Sign(s) & Post(s) to Remain
 - ② Remove Exist. Sign(s) w/Post(s)
 - ③ Remove Exist. Sign(s) w/Post(s) & Install New Sign(s) w/Post(s)
 - ④ Remove Exist. Sign(s) and Reinstall on New Post(s)
 - ⑤ Install New Sign(s) w/Post(s)

ORIGINAL PLAN	DATE
DESIGNED BY	6/16/06
NOTED BY	
CHECKED BY	
DATE	


2/8/07	Revised striping & roadway signs.
DATE	REVISION

STATE OF HAWAII
DEPARTMENT OF TRANSPORTATION
HIGHWAYS DIVISION

PAVEMENT MARKING & STRIPING PLAN
KAMEHAMEHA HIGHWAY REHABILITATION
WAIHAU STREET to H-2 INTERCHANGE
FEDERAL AID PROJECT NO. NH-099-1(24)
Scale: 1"=40' Date: June 2006

SHEET No. 110 OF 18 SHEETS
ADD. 66

FED. ROAD DIST. NO.	STATE	FED. AID PROJ. NO.	FISCAL YEAR	SHEET NO.	TOTAL SHEETS
HAWAII	HAW.	NH-099-1(24)	2007	ADD.67	74

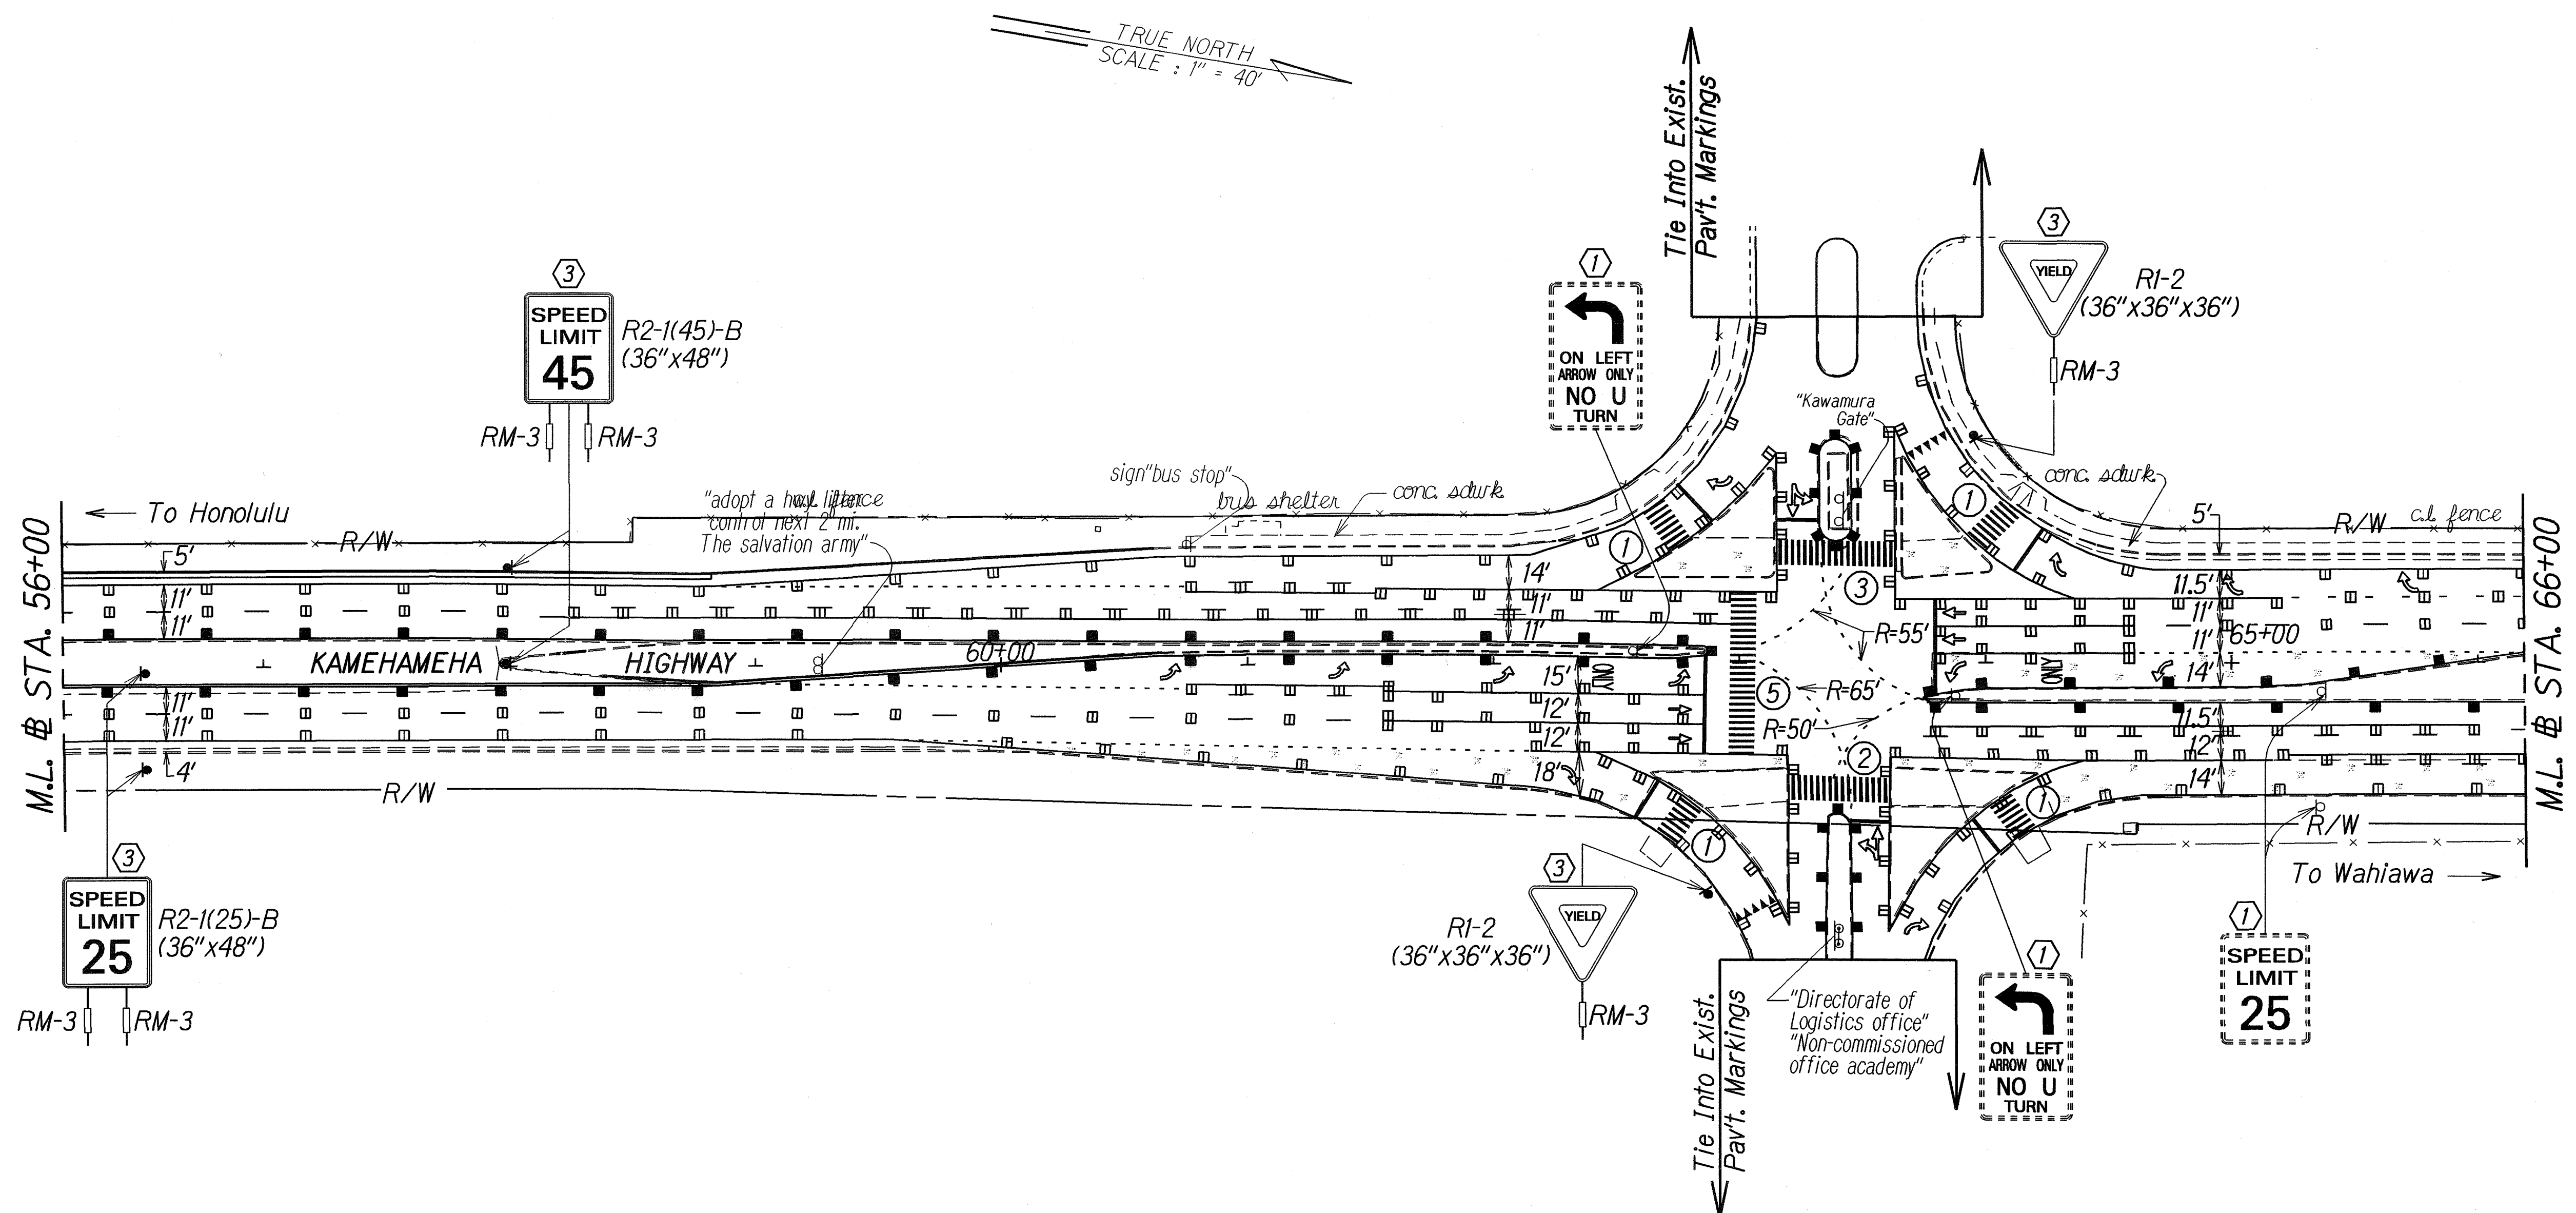

LEGEND

— Bike Lane Marking

KEY:

- ① Exist. Sign(s) & Post(s) to Remain
- ② Remove Exist. Sign(s) w/Post(s)
- ③ Remove Exist. Sign(s) w/Post(s) & Install New Sign(s) w/Post(s)
- ④ Remove Exist. Sign(s) and Reinstall on New Post(s)
- ⑤ Install New Sign(s) w/Post(s)

ORIGINAL PLAN	DATE
NOTED BY	6/16/06
DESIGNED BY	
QUANTITIES BY	
CHECKED BY	
IN CHARGE	
DATE	

2/8/07	Revised striping.
DATE	REVISION

STATE OF HAWAII
DEPARTMENT OF TRANSPORTATION
HIGHWAYS DIVISION

PAVEMENT MARKING & STRIPING PLAN
KAMEHAMEHA HIGHWAY REHABILITATION
WAIHAU STREET to H-2 INTERCHANGE
FEDERAL AID PROJECT NO. NH-099-1(24)
Scale: 1"=40' Date: June 2006

SHEET No. 711 OF 18 SHEETS


FED. ROAD DIST. NO.	STATE	FED. AID PROJ. NO.	FISCAL YEAR	SHEET NO.	TOTAL SHEETS
HAWAII	HAW.	NH-099-1(24)	2007	ADD.68	74

LEGEND

▬ Bike Lane Marking

KEY:

- ① Exist. Sign(s) & Post(s) to Remain
- ② Remove Exist. Sign(s) w/Post(s)
- ③ Remove Exist. Sign(s) w/Post(s) & Install New Sign(s) w/Post(s)
- ④ Remove Exist. Sign(s) and Reinstall on New Post(s)
- ⑤ Install New Sign(s) w/Post(s)

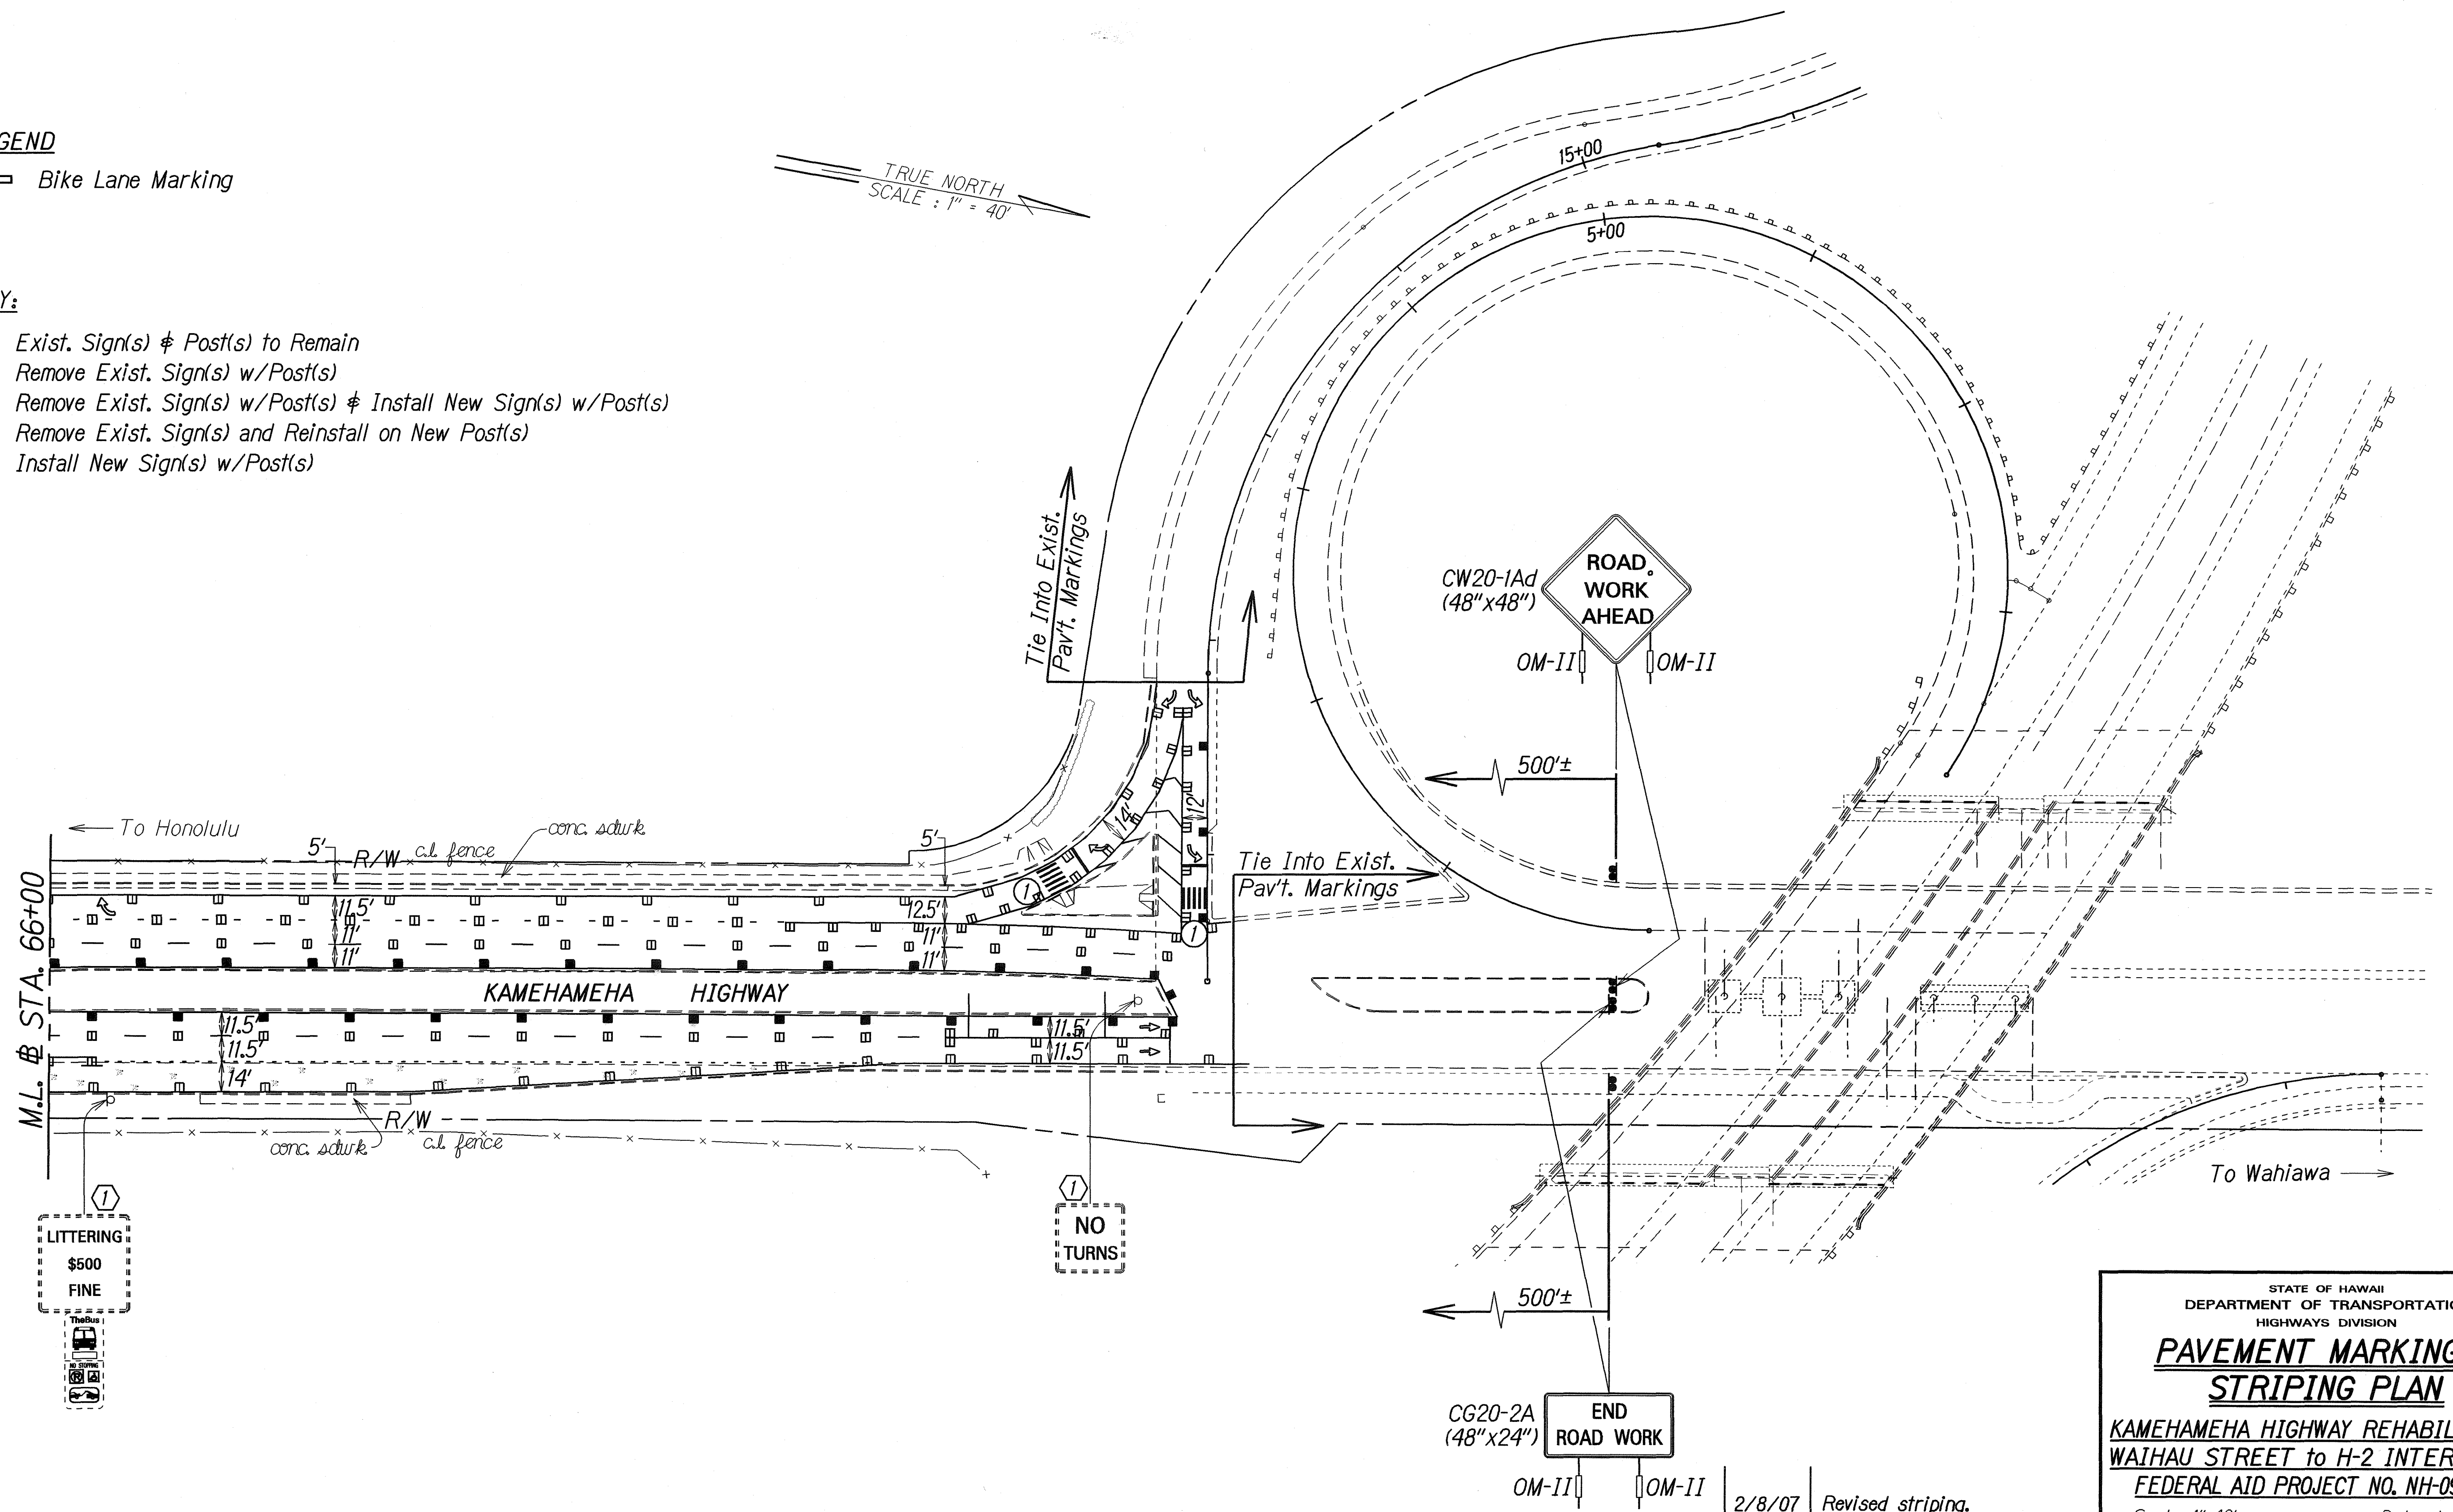

ORIGINAL PLAN	DATE 6/16/06
NOTES BOOK	DESIGNED BY E.C.
QUANTITIES BY	CHECKED BY
DATE	DATE

STATE OF HAWAII
DEPARTMENT OF TRANSPORTATION
HIGHWAYS DIVISION

PAVEMENT MARKING & STRIPING PLAN
KAMEHAMEHA HIGHWAY REHABILITATION
WAIHAU STREET to H-2 INTERCHANGE
FEDERAL AID PROJECT NO. NH-099-1(24)
Scale: 1"=40' Date: June 2006

2/8/07	Revised striping.
DATE	REVISION