
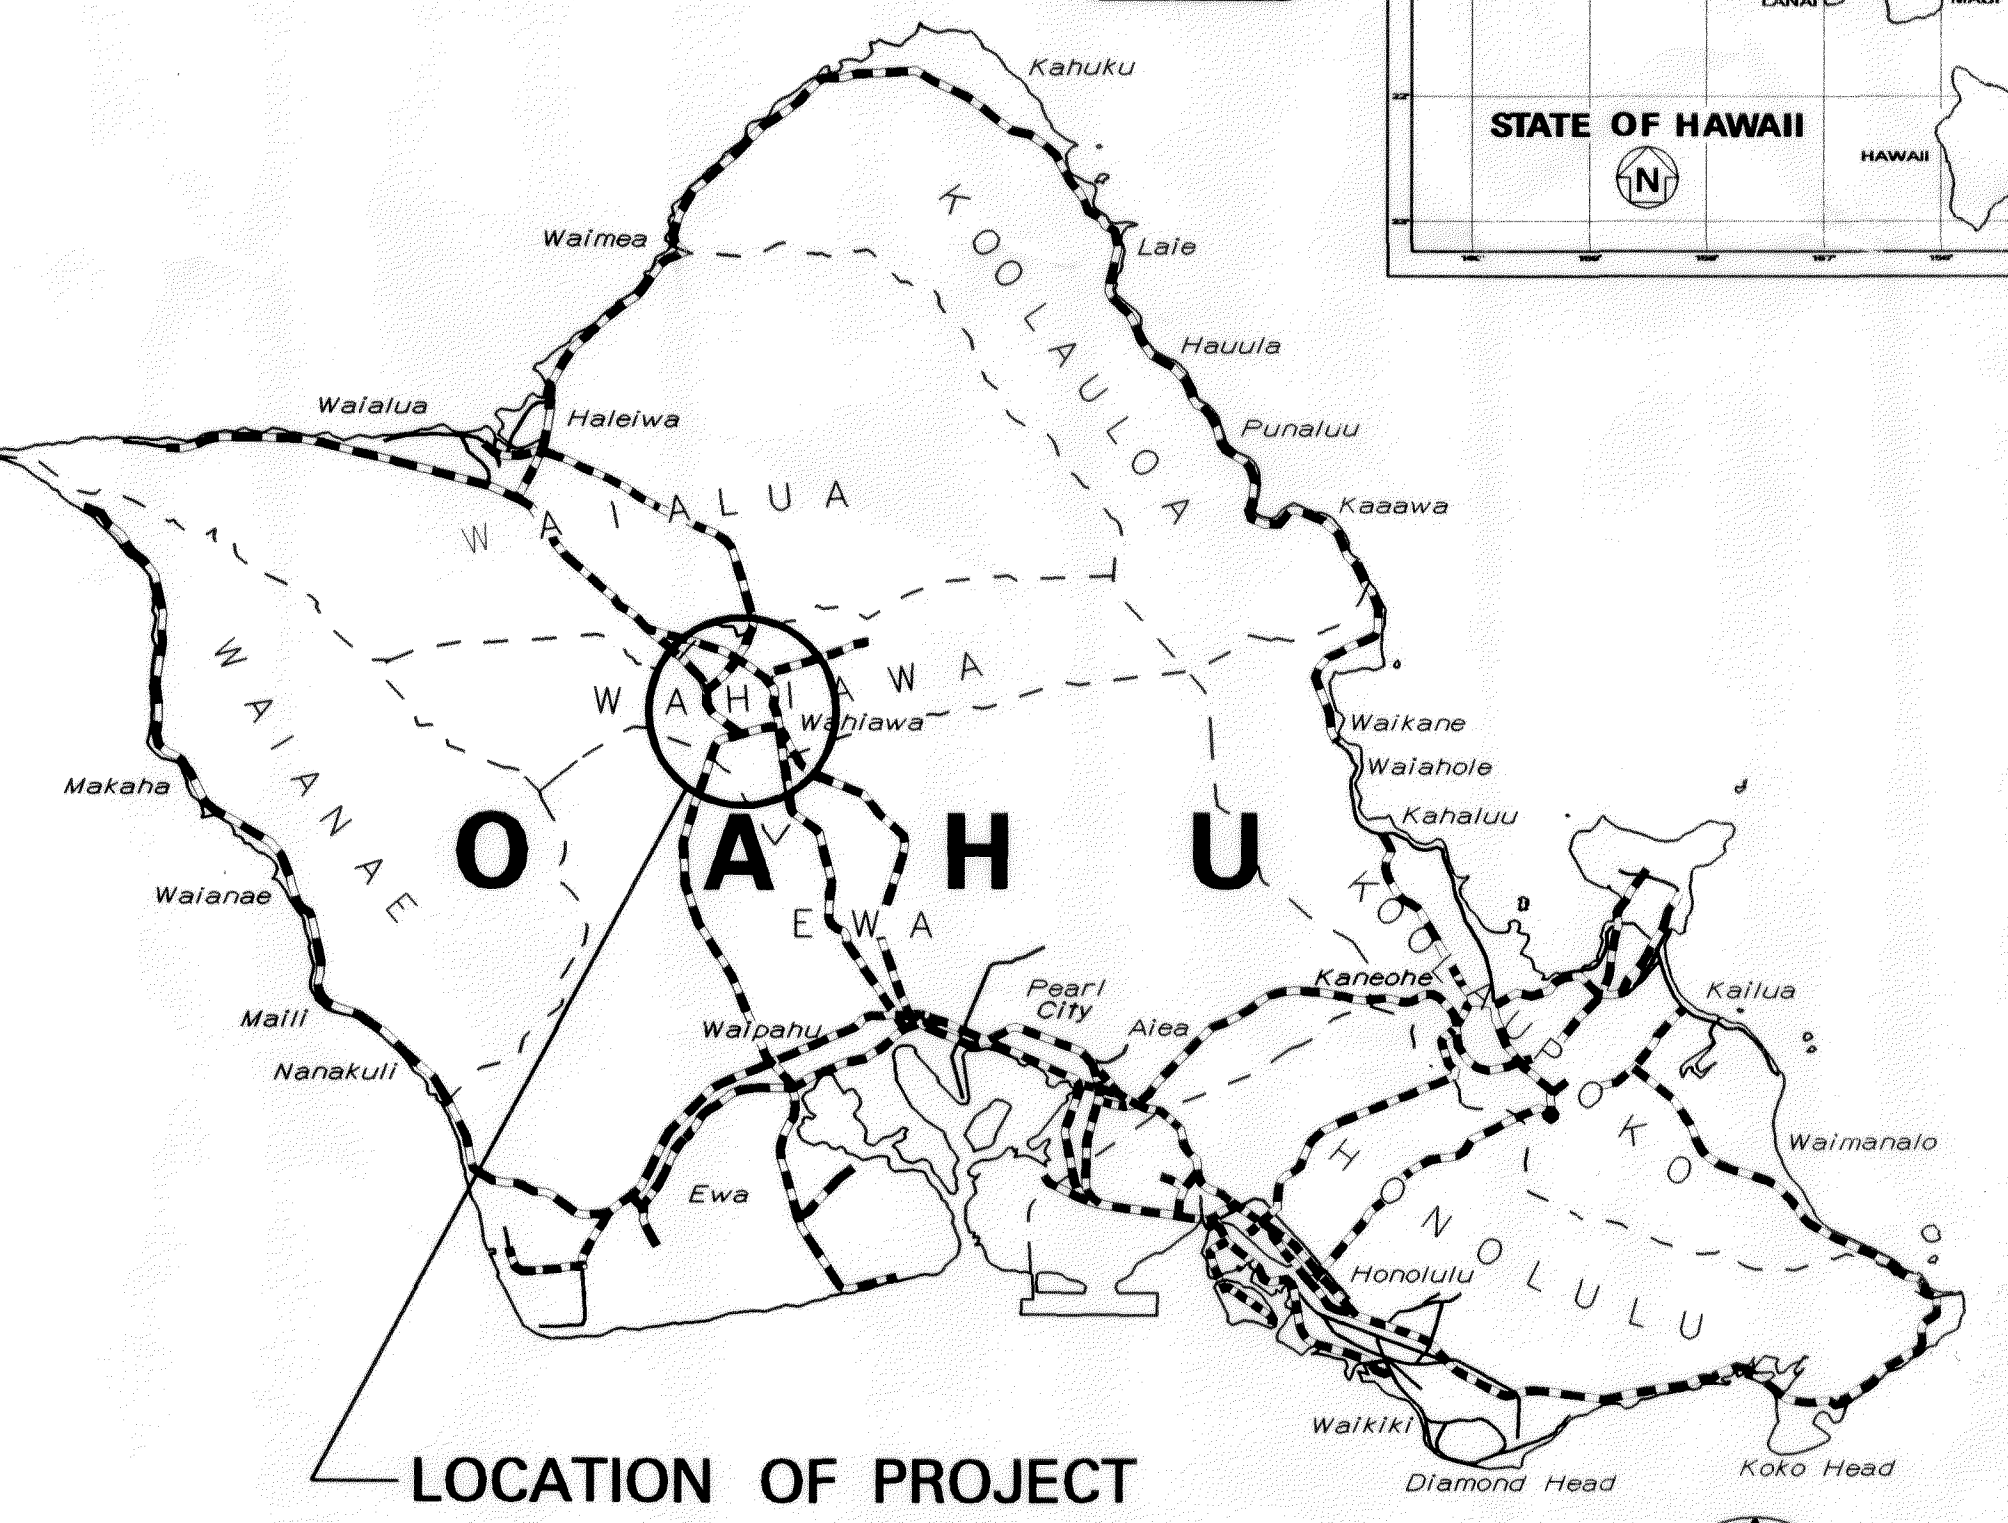
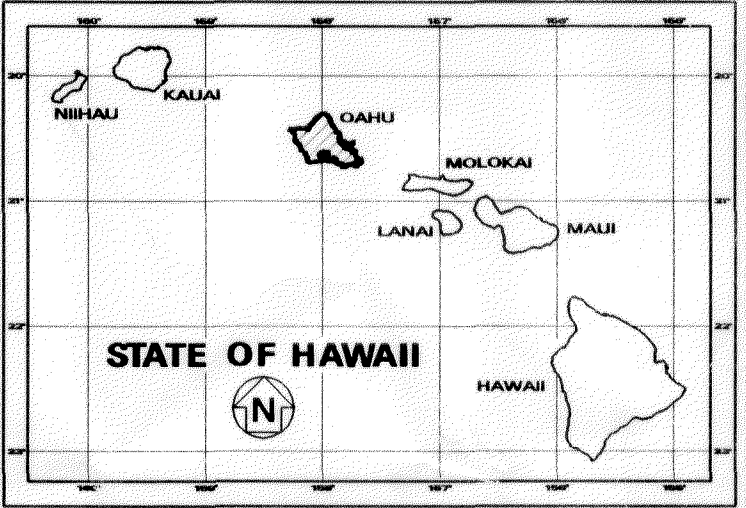


INDEX TO DRAWINGS	
SHEET NO.	DESCRIPTION
1	TITLE SHEET
2	STANDARD PLANS SUMMARY
3-4	GENERAL NOTES & LEGEND
5-6	WATER POLLUTION AND EROSION CONTROL NOTES
7-9	UTILITY NOTES
10-16	TYPICAL SECTIONS
17	CONCRETE SIDEWALK DETAILS
18	MANHOLE DETAILS
19-26	ROADWAY PLANS
27	PAVEMENT GRADE PLAN
28-38	GUARDRAIL DETAILS
39-43	DRAINAGE PLAN
44	DRAINAGE PROFILE
45-51	DRAINAGE DETAILS
52-56	STRUCTURAL PLANS
57-58	PAVEMENT MARKING LEGEND, DETAILS AND NOTES
59-60	WORK ZONE SIGNING PLAN, NOTES & DETAILS
61-68	PAVEMENT MARKING & STRIPING PLAN
69	TRAFFIC SIGNAL, LEGEND & NOTES
70-73	LOOP DETECTOR PLAN
74	LOOP DETECTOR DETAILS


STATE OF HAWAII
DEPARTMENT OF TRANSPORTATION
HIGHWAYS DIVISION
HONOLULU, HAWAII
"AS-BUILT"
PLANS FOR
KAMEHAMEHA HIGHWAY REHABILITATION
WAIHAU STREET TO H-2 INTERCHANGE
FEDERAL AID PROJECT NO. NH-099-1(24)

DISTRICT OF WAHIAWA
ISLAND OF OAHU

FED. ROAD DIST. NO.	STATE	FED. AID PROJ. NO.	FISCAL YEAR	SHEET NO.	TOTAL SHEETS
HAWAII	HAW.	NH-099-1(24)	2007	ADD.1	74

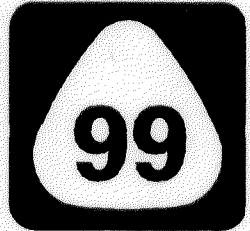


LOCATION OF PROJECT

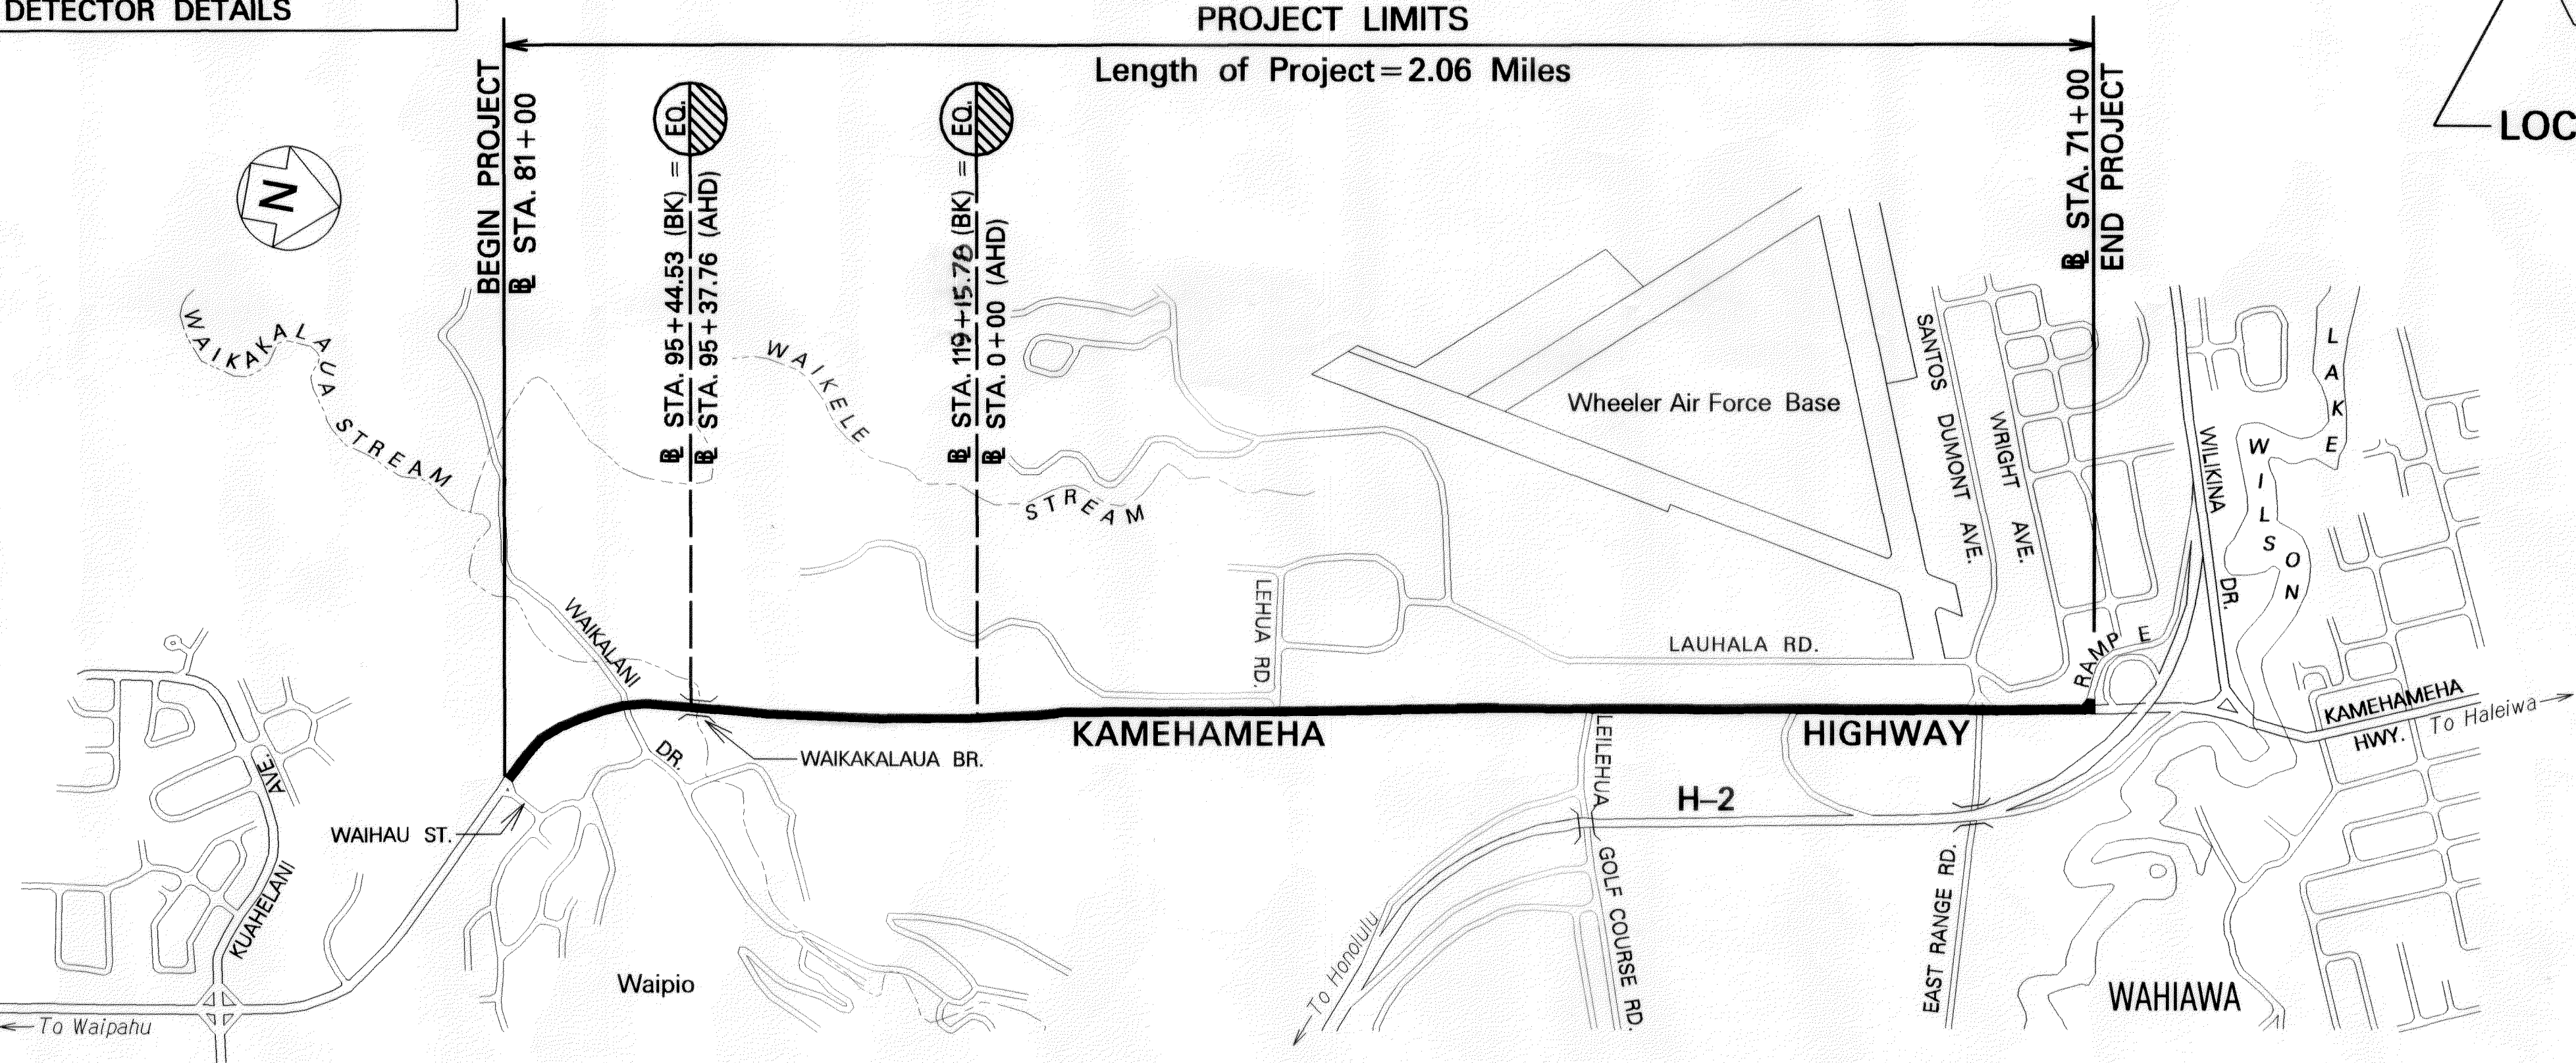

PROJECT LIMITS
Length of Project=2.06 Miles

LAYOUT PLAN

GROSS LENGTH OF PROJECT..... 2.06 MILES
NET LENGTH OF PROJECT..... 2.06 MILES

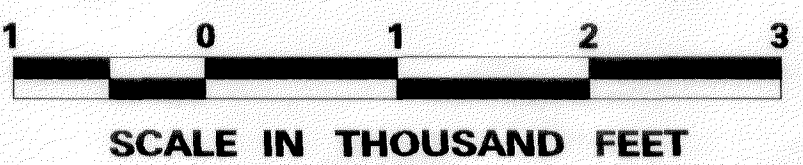

FEDERAL AID PROJECTS PREVIOUSLY CONSTRUCTED OR UNDER CONSTRUCTION

MILE POST 11.91 TO MILE POST 9.85

DESIGN DESIGNATION

ADT (2003)	22,500
ADT (2024)	25,800
DHV	2,100
D	45/35
T	3.5%
V	35/45/55 M.P.H.

CHANGES MADE DURING CONSTRUCTION HAVE BEEN INCORPORATED ON THESE PLANS EXCEPT CHANGES IN THE ORIGINAL THEORETICAL QUANTITIES. FOR ACTUAL QUANTITIES, REFER TO PROJECT LEDGER AND/OR COMPUTATION BOOK.

RESIDENT ENGINEER DATE

DEPARTMENT OF TRANSPORTATION
STATE OF HAWAII
APPROVED:
DIR. OF TRANSPORTATION DATE

1/27/07	Revised Equation Station.
DATE	REVISION

DESIGN UNIT "E"
DESIGNED BY
HWY-DD
MANAGED BY
692-7581
PHONE
6/30/05
DATE