



FED. ROAD DIST. NO.	STATE	FED. AID PROJ. NO.	FISCAL YEAR	SHEET NO.	TOTAL SHEETS
HAWAII	HAW.	NH-099-1(029)	2014	ADD.37	84

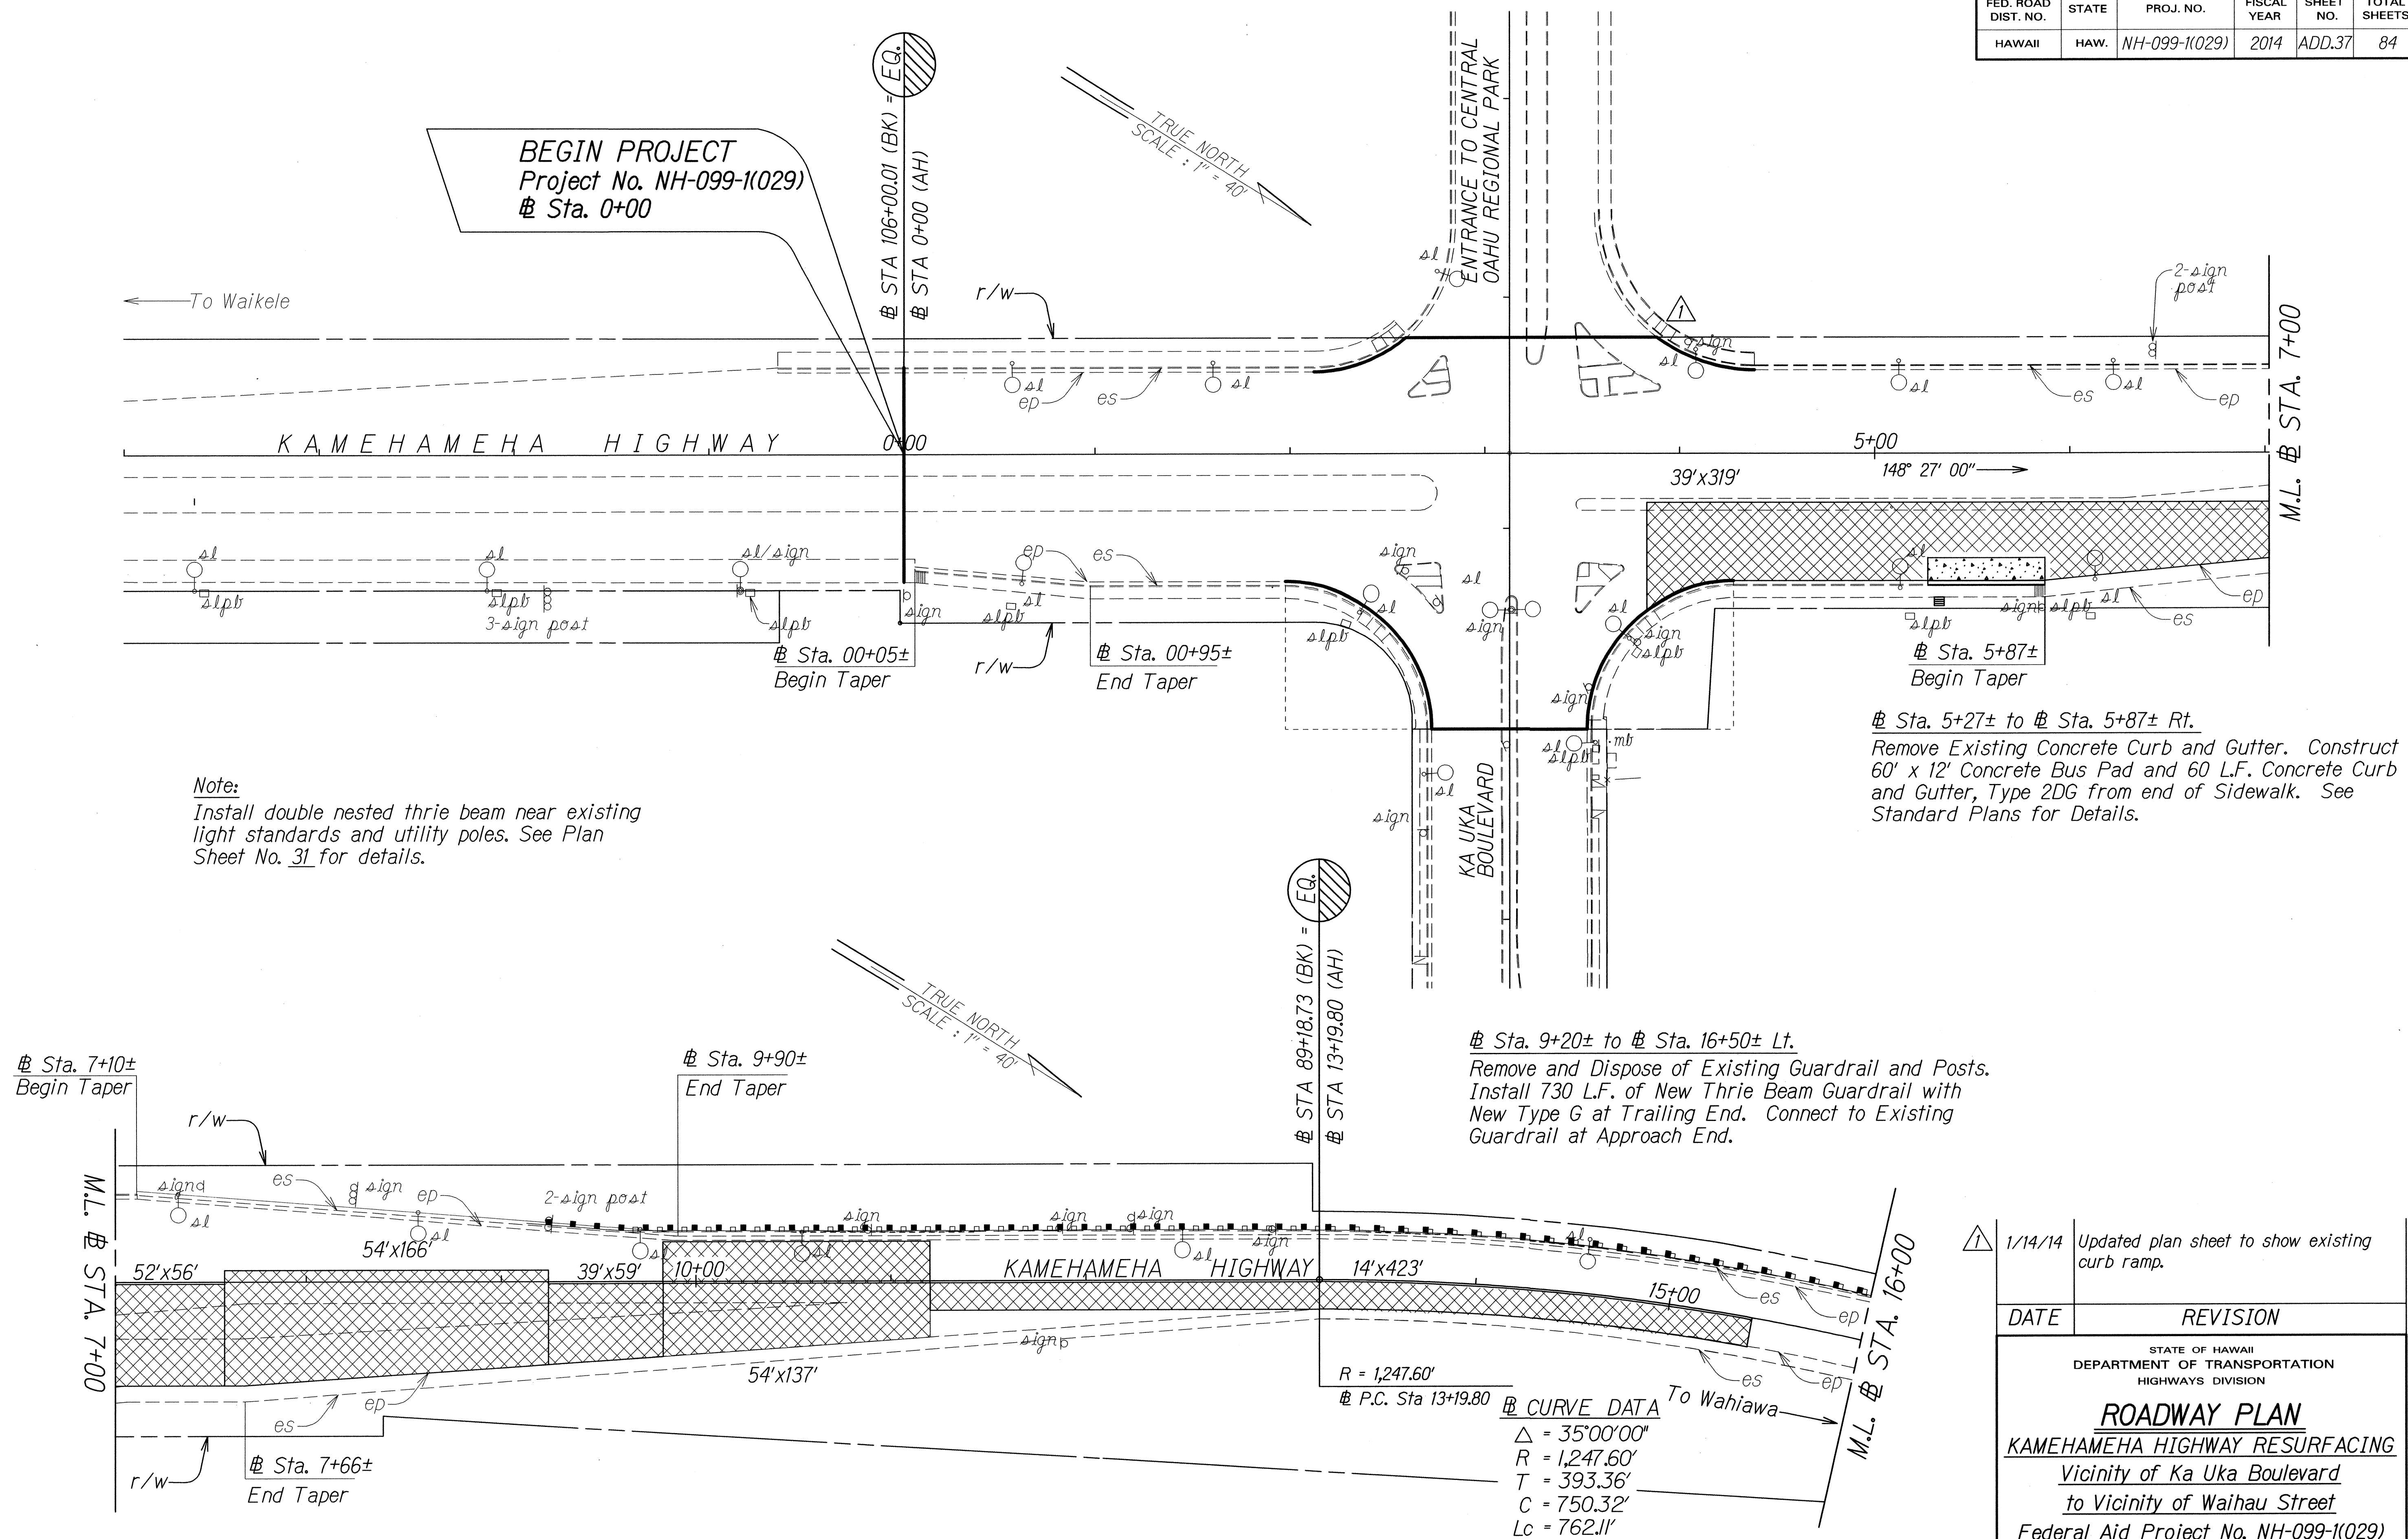

ORIGINAL PLAN	SURVEY PLOTTED BY _____	DATE _____
NOTE BOOK	DRAWN BY <i>X</i>	• <i>X</i>
<i>dd3.mile</i>	TRACED BY _____	•
<i>Wkmindgn</i>	DESIGNED BY <i>X</i>	•
NAME _____	QUANTITIES BY _____	•
	CHECKED BY _____	•

	1/14/14 Updated plan sheet to show existing curb ramp.	
	<table border="1"> <tr> <th>DATE</th> <th>REVISION</th> </tr> </table>	DATE
DATE	REVISION	
STATE OF HAWAII DEPARTMENT OF TRANSPORTATION HIGHWAYS DIVISION <u>ROADWAY PLAN</u> <u>KAMEHAMEHA HIGHWAY RESURFACING</u> <u>Vicinity of Ka Uka Boulevard</u> <u>to Vicinity of Waihau Street</u> <u>Federal Aid Project No. NH-099-1(029)</u> Scale: 1" = 40' Date: Sept., 2013		
SHEET No. 1 OF 10 SHEETS		

FED. ROAD DIST. NO.	STATE	FED. AID PROJ. NO.	FISCAL YEAR	SHEET NO.	TOTAL SHEETS
HAWAII	HAW.	NH-099-1(029)	2014	ADD.38	84

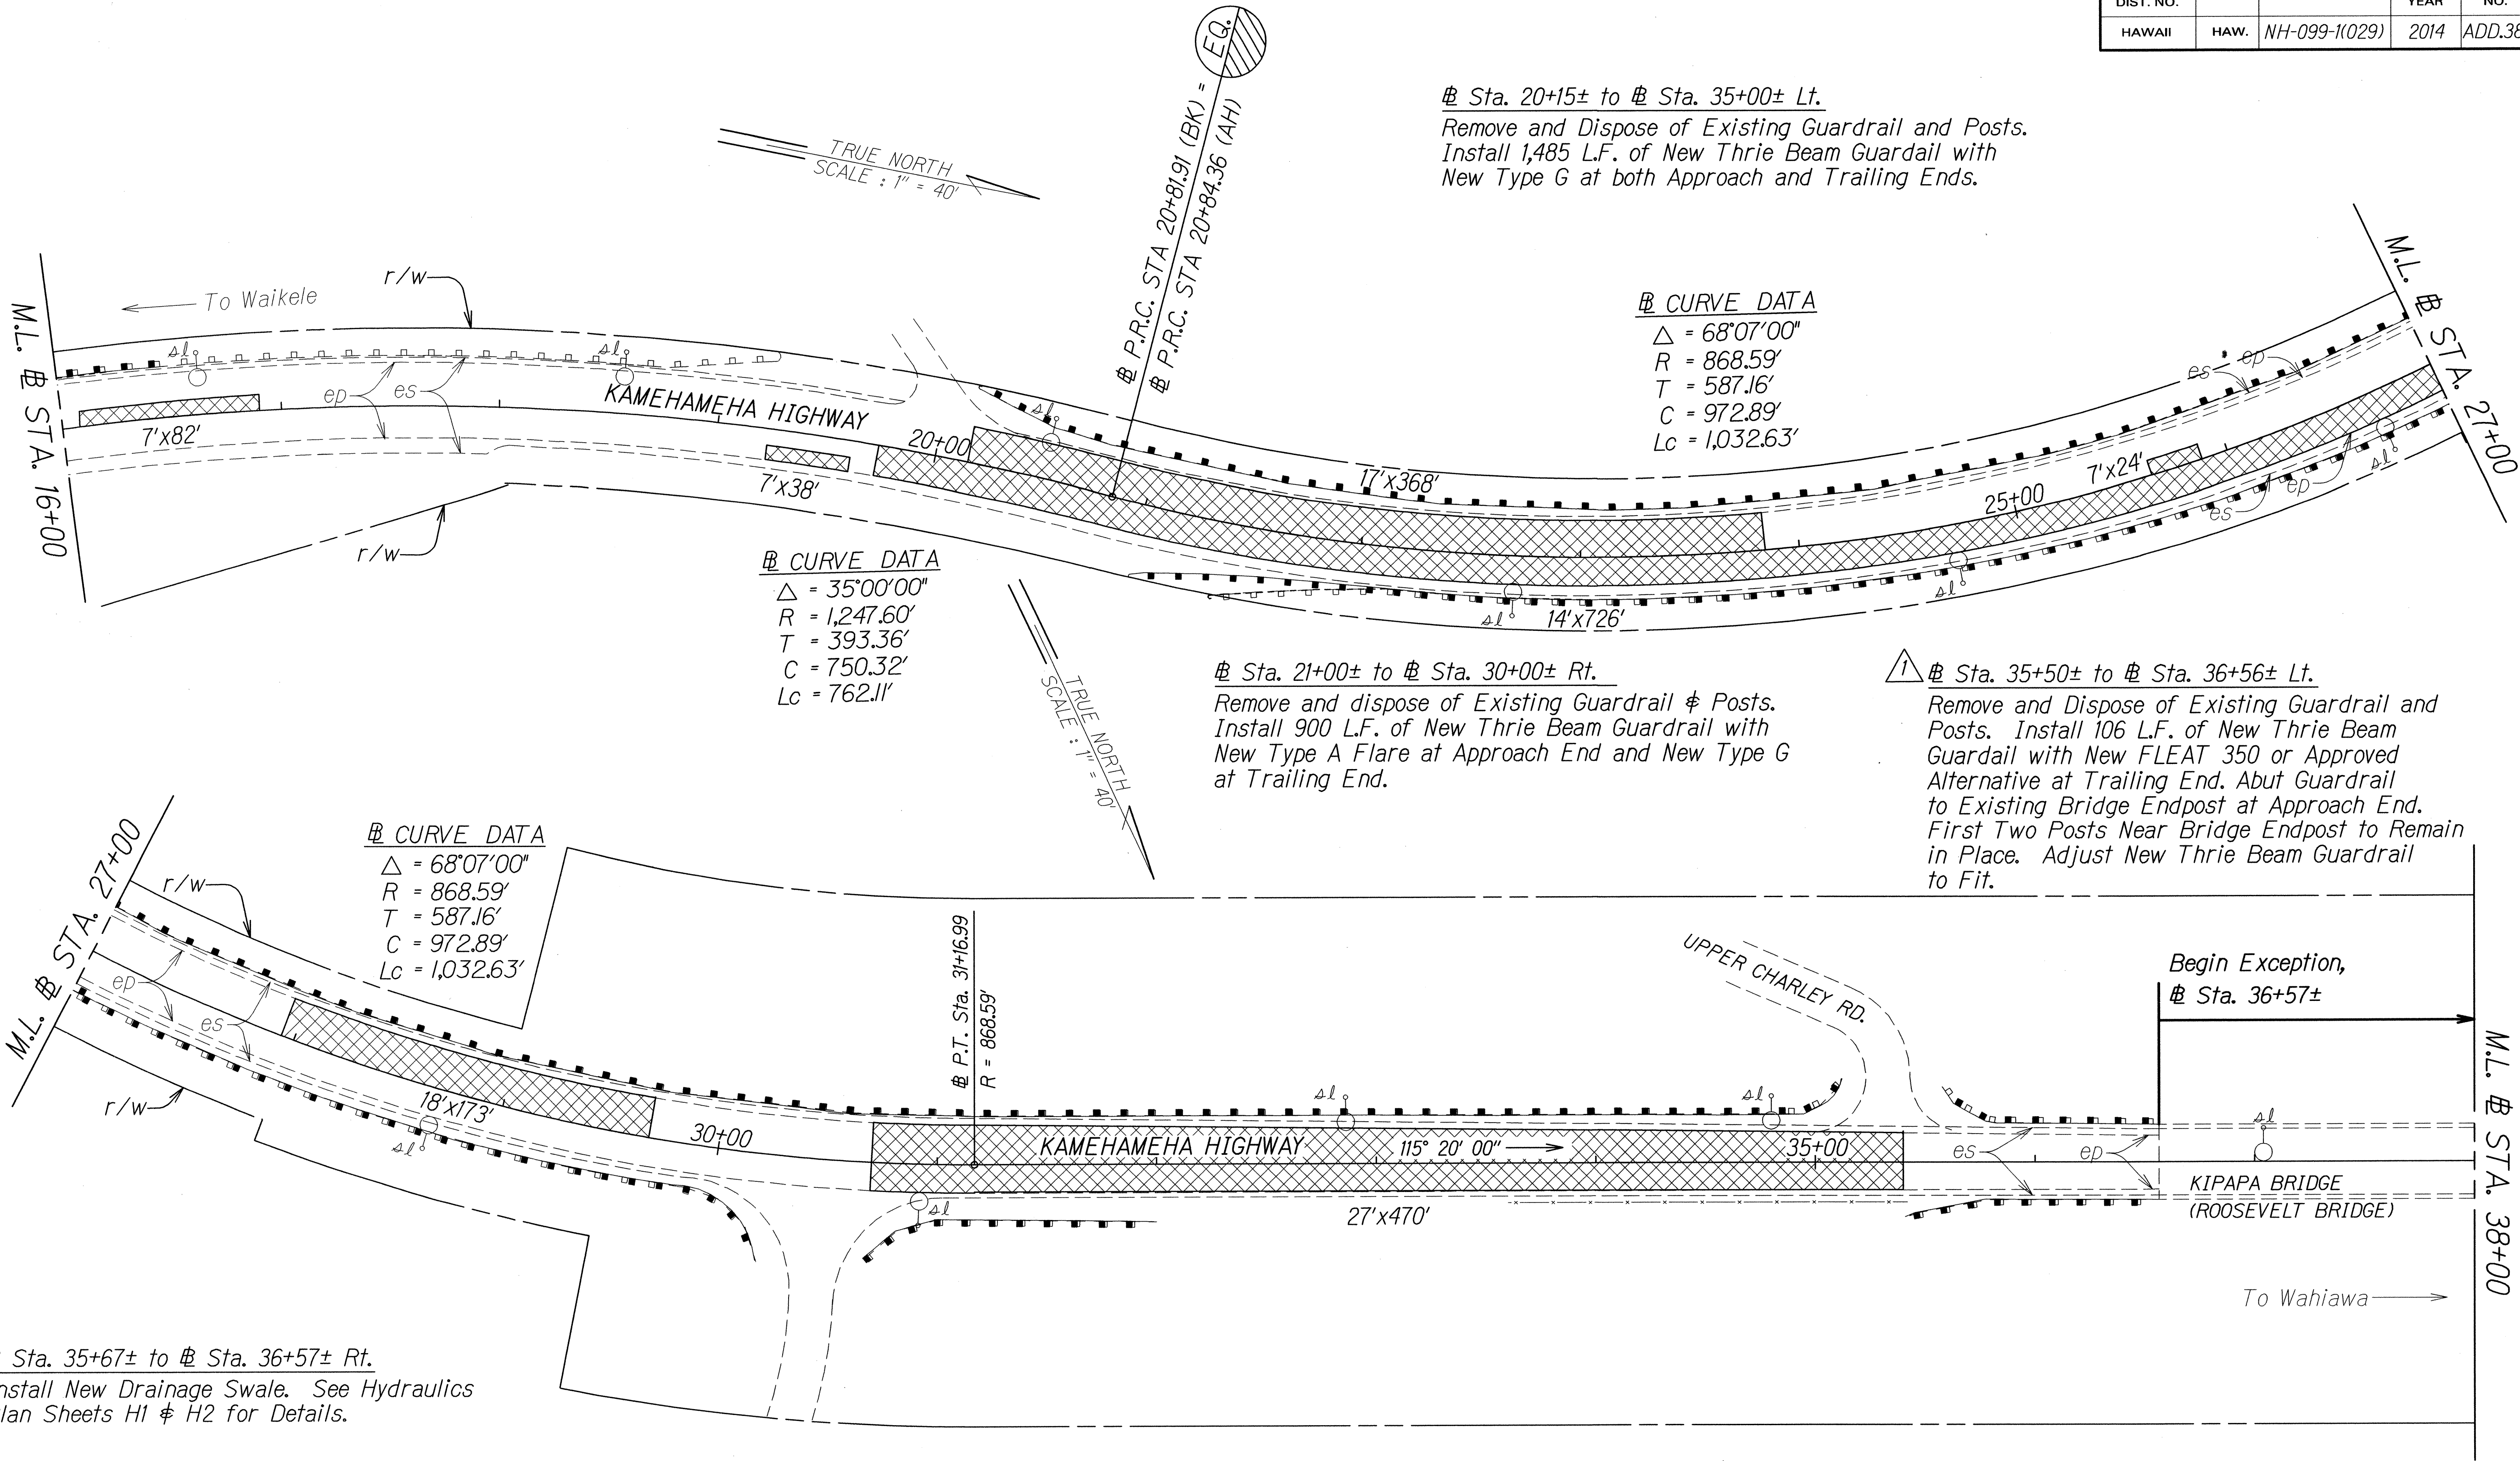

ORIGINAL PLAN	SURVEY PLOTTED BY	DATE
NOTE BOOK	DRAWN BY	
DESIGNED BY		
QUANTITIES BY		
CHECKED BY		

Note:
Install double nested thrie beam near existing light standards and utility poles. See Plan Sheet No. 31 for details.

1/16/14 Corrected Note.

DATE

REVISION

STATE OF HAWAII
DEPARTMENT OF TRANSPORTATION
HIGHWAYS DIVISION

ROADWAY PLAN
KAMEHAMEHA HIGHWAY RESURFACING
Vicinity of Ka Uka Boulevard
to Vicinity of Waihau Street
Federal Aid Project No. NH-099-1(029)
Scale: 1" = 40' Date: Sept., 2013


SHEET No. 2 OF 10 SHEETS

ADD. 38

FED. ROAD DIST. NO.	STATE	FED. AID PROJ. NO.	FISCAL YEAR	SHEET NO.	TOTAL SHEETS
HAWAII	HAW.	NH-099-1(029)	2014	40	84


Sta. 70+20± to Sta. 77+75± Lt.
Extend Paved Shoulder to 3 Ft. Width.

Sta. 69+75± to Sta. 78+06± Lt.
Remove and Dispose of Existing Guardrail and Posts.
Install 831 L.F. of New W-Beam Guardrail with New Type A Flare at both Approach and Trailing Ends.
Use 8 Ft. Posts.

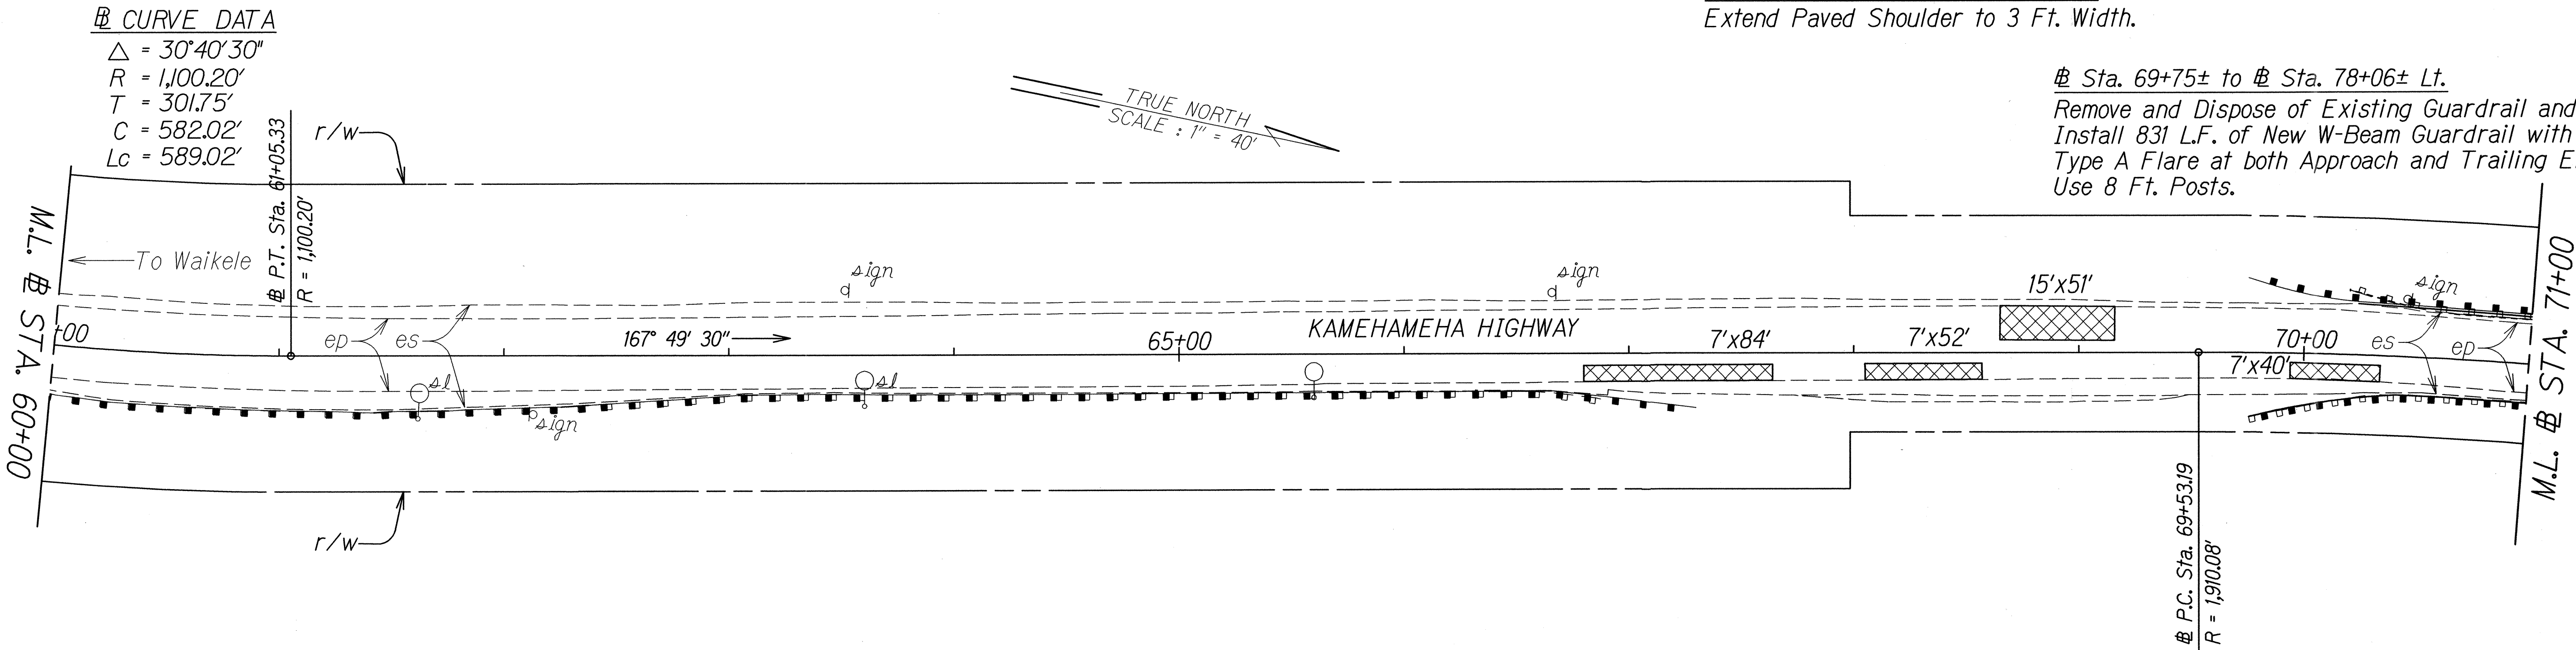

Note:
Install double nested thrie beam near existing light standards and utility poles. See Plan Sheet No. 31 for details.

Sta. 79+60± to Sta. 86+00± Lt.
Remove and Dispose of Existing Guardrail and Posts.
Install 640 L.F. of New W-Beam Guardrail with New Type A Flare at both Approach and Trailing Ends

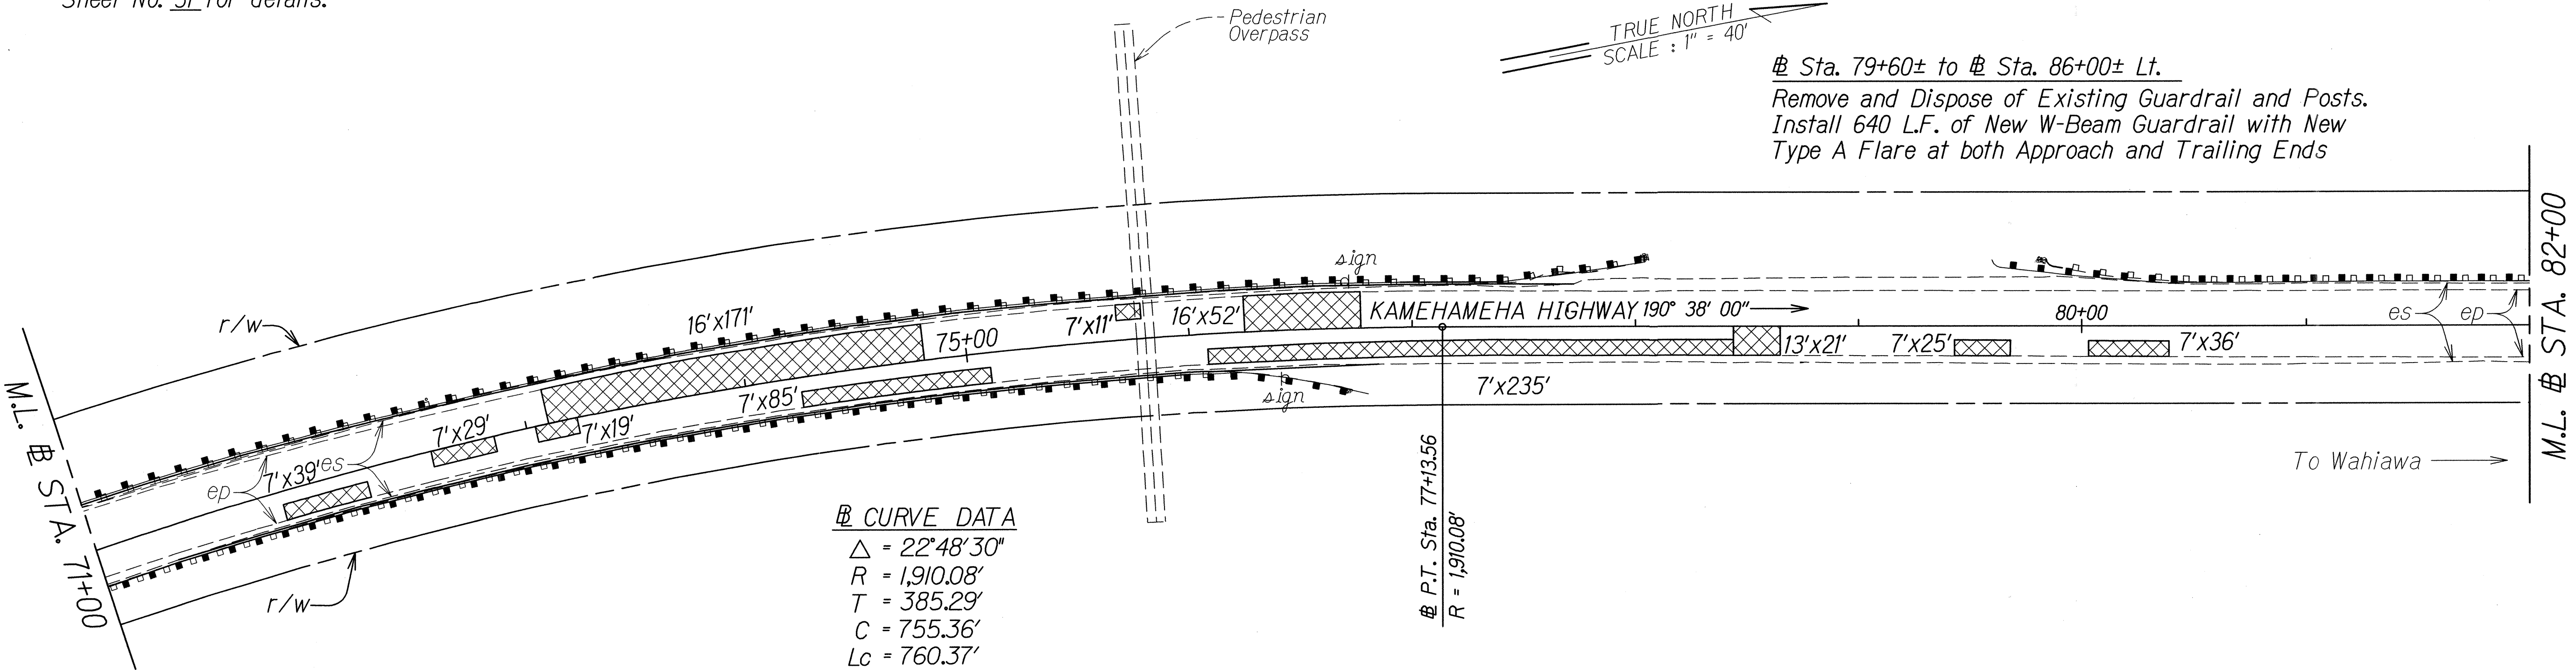

Sta. 69+80± to Sta. 76+80± Rt.
Remove and Dispose of Existing Guardrail and Posts.
Install 700 L.F. of New W-Beam Guardrail with New Type A Flare at both Approach and Trailing Ends.

Sta. 71+30± to Sta. 76+85± Rt.
Extend Paved Shoulder to 3 Ft. Width.


STATE OF HAWAII
DEPARTMENT OF TRANSPORTATION
HIGHWAYS DIVISION

ROADWAY PLAN
KAMEHAMEHA HIGHWAY RESURFACING
Vicinity of Ka Uka Boulevard
to Vicinity of Waihau Street
Federal Aid Project No. NH-099-1(029)
Scale: 1" = 40'
Date: Sept., 2013


SHEET No. 4 OF 10 SHEETS

ORIGINAL PLAN	DATE
NOTE BOOK	
DESIGNED BY	
QUANTITIES BY	
CHECKED BY	
dd3mike	
N. W. W. W. W.	

FED. ROAD DIST. NO.	STATE	FED. AID PROJ. NO.	FISCAL YEAR	SHEET NO.	TOTAL SHEETS
HAWAII	HAW.	NH-099-1(029)	2014	42	84

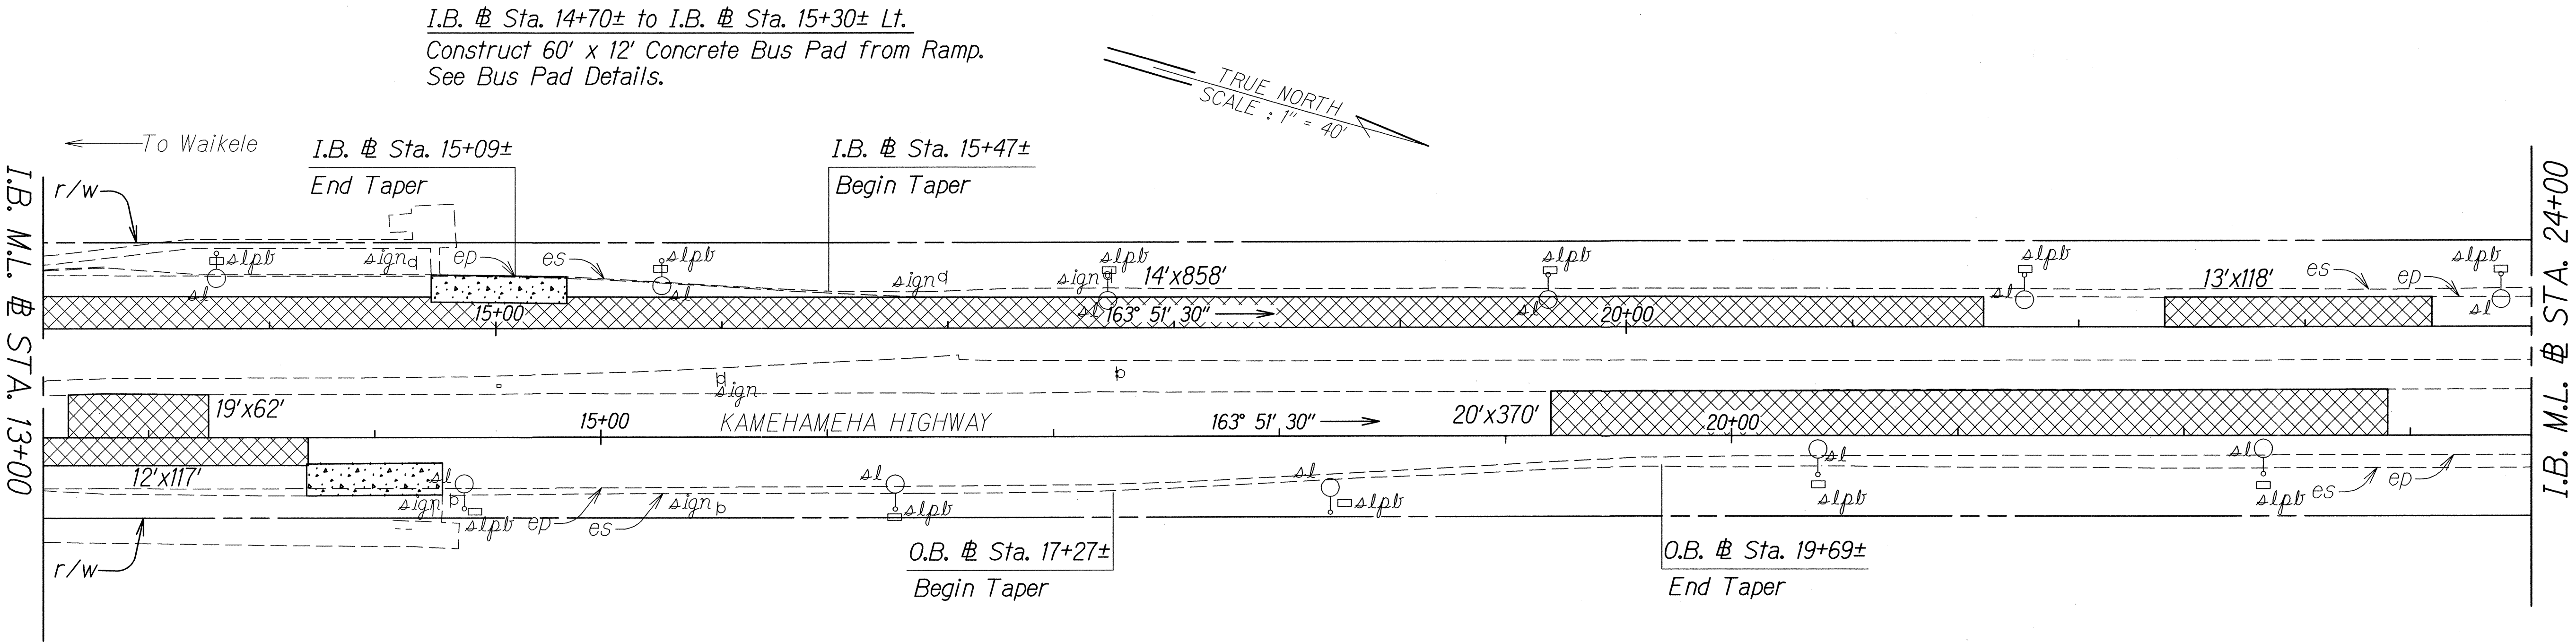

O.B. Sta. 13+70± to O.B. Sta. 14+30± Rt.
Construct 60' x 12' Concrete Bus Pad and 60 L.F.
Concrete Shoulder from Ramp. See Bus Pad Details.

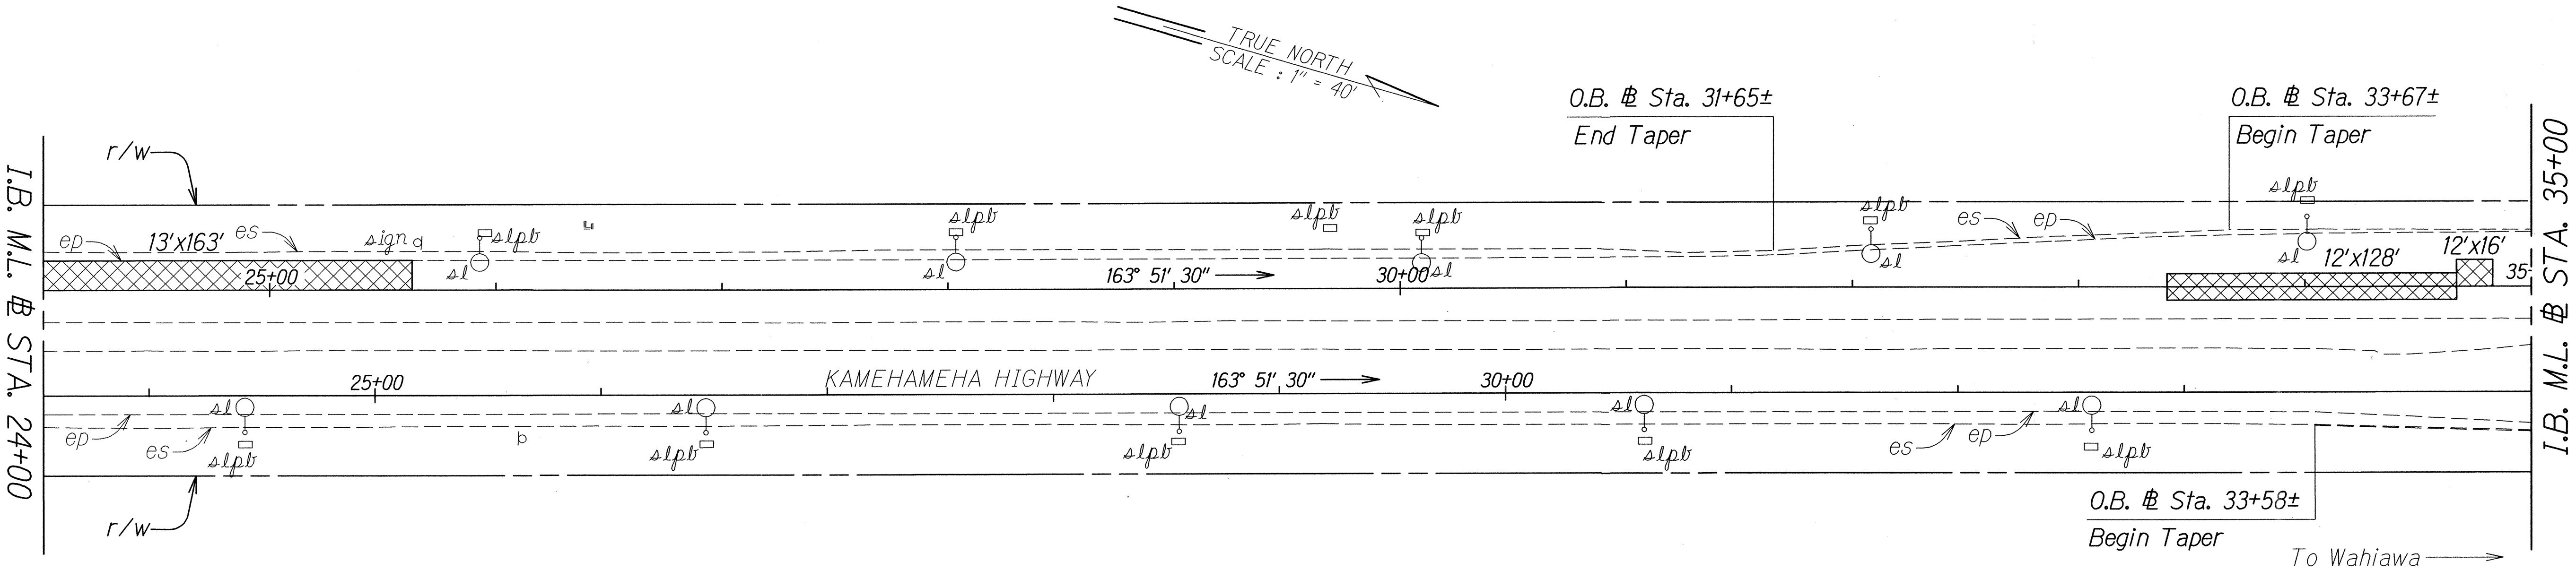

ORIGINAL PLAN	DATE
NOTED BY	
DESIGNED BY	
QUANTITIES BY	
CHECKED BY	

STATE OF HAWAII
DEPARTMENT OF TRANSPORTATION
HIGHWAYS DIVISION

ROADWAY PLAN

KAMEHAMEHA HIGHWAY RESURFACING

Vicinity of Ka Uka Boulevard


to Vicinity of Waihau Street

Federal Aid Project No. NH-099-1(029)

Scale: 1" = 40' Date: Sept., 2013

SHEET No. 6 OF 10 SHEETS

FED. ROAD DIST. NO.	STATE	FED. AID PROJ. NO.	FISCAL YEAR	SHEET NO.	TOTAL SHEETS
HAWAII	HAW.	NH-099-1(029)	2014	44	84

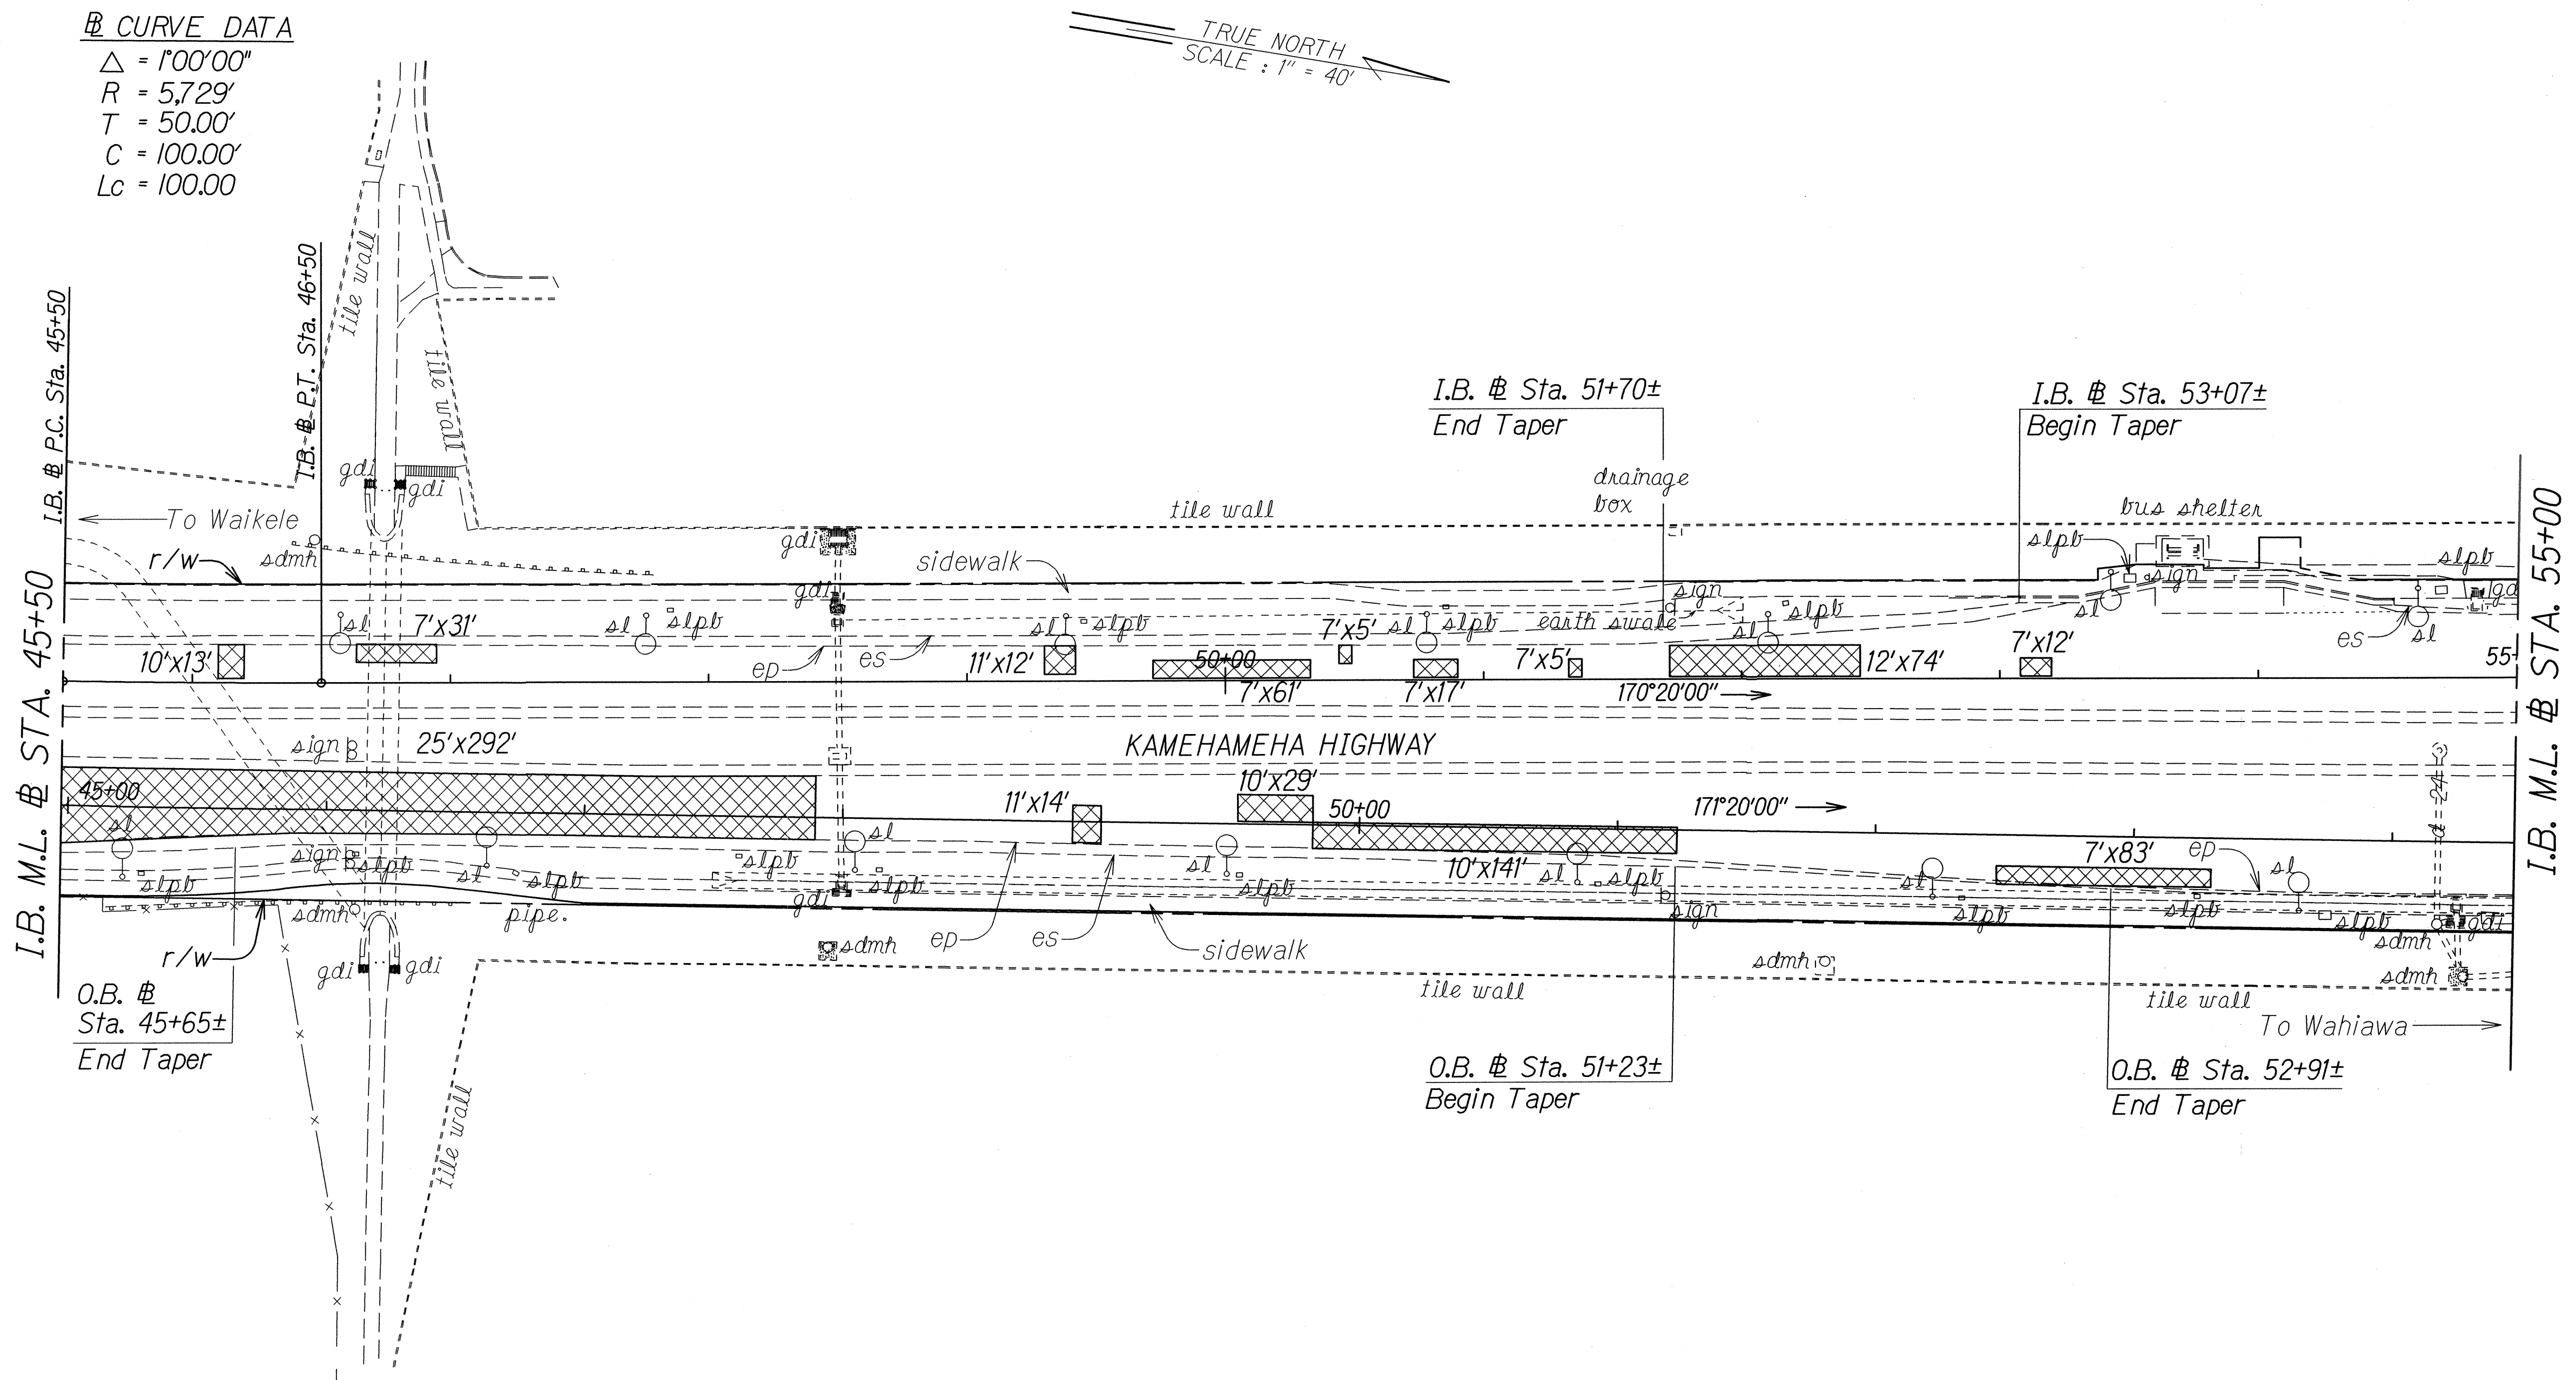

ORIGINAL PLAN	SURVEY PLOTTED BY	DATE
NOTE BOOK	DRAWN BY	
003.mke	DESIGNED BY	
N.williams	QUANTITIES BY	
	CHECKED BY	

STATE OF HAWAII
DEPARTMENT OF TRANSPORTATION
HIGHWAYS DIVISION

ROADWAY PLAN

KAMEHAMEHA HIGHWAY RESURFACING

Vicinity of Ka Uka Boulevard

to Vicinity of Waihau Street


Federal Aid Project No. NH-099-1(029)

Scale: 1" = 40' Date: Sept., 2013

SHEET No. 8 OF 10 SHEETS

FED. ROAD DIST. NO.	STATE	FED. AID PROJ. NO.	FISCAL YEAR	SHEET NO.	TOTAL SHEETS
HAWAII	HAW.	NH-099-1(029)	2014	45	84

I.B. @ Sta. 63+30± to I.B. @ Sta. 65+24± Lt.
 Remove Existing Concrete Bus Pullout and Construct
 New Concrete Bus Pullout. See Bus Pad Details.

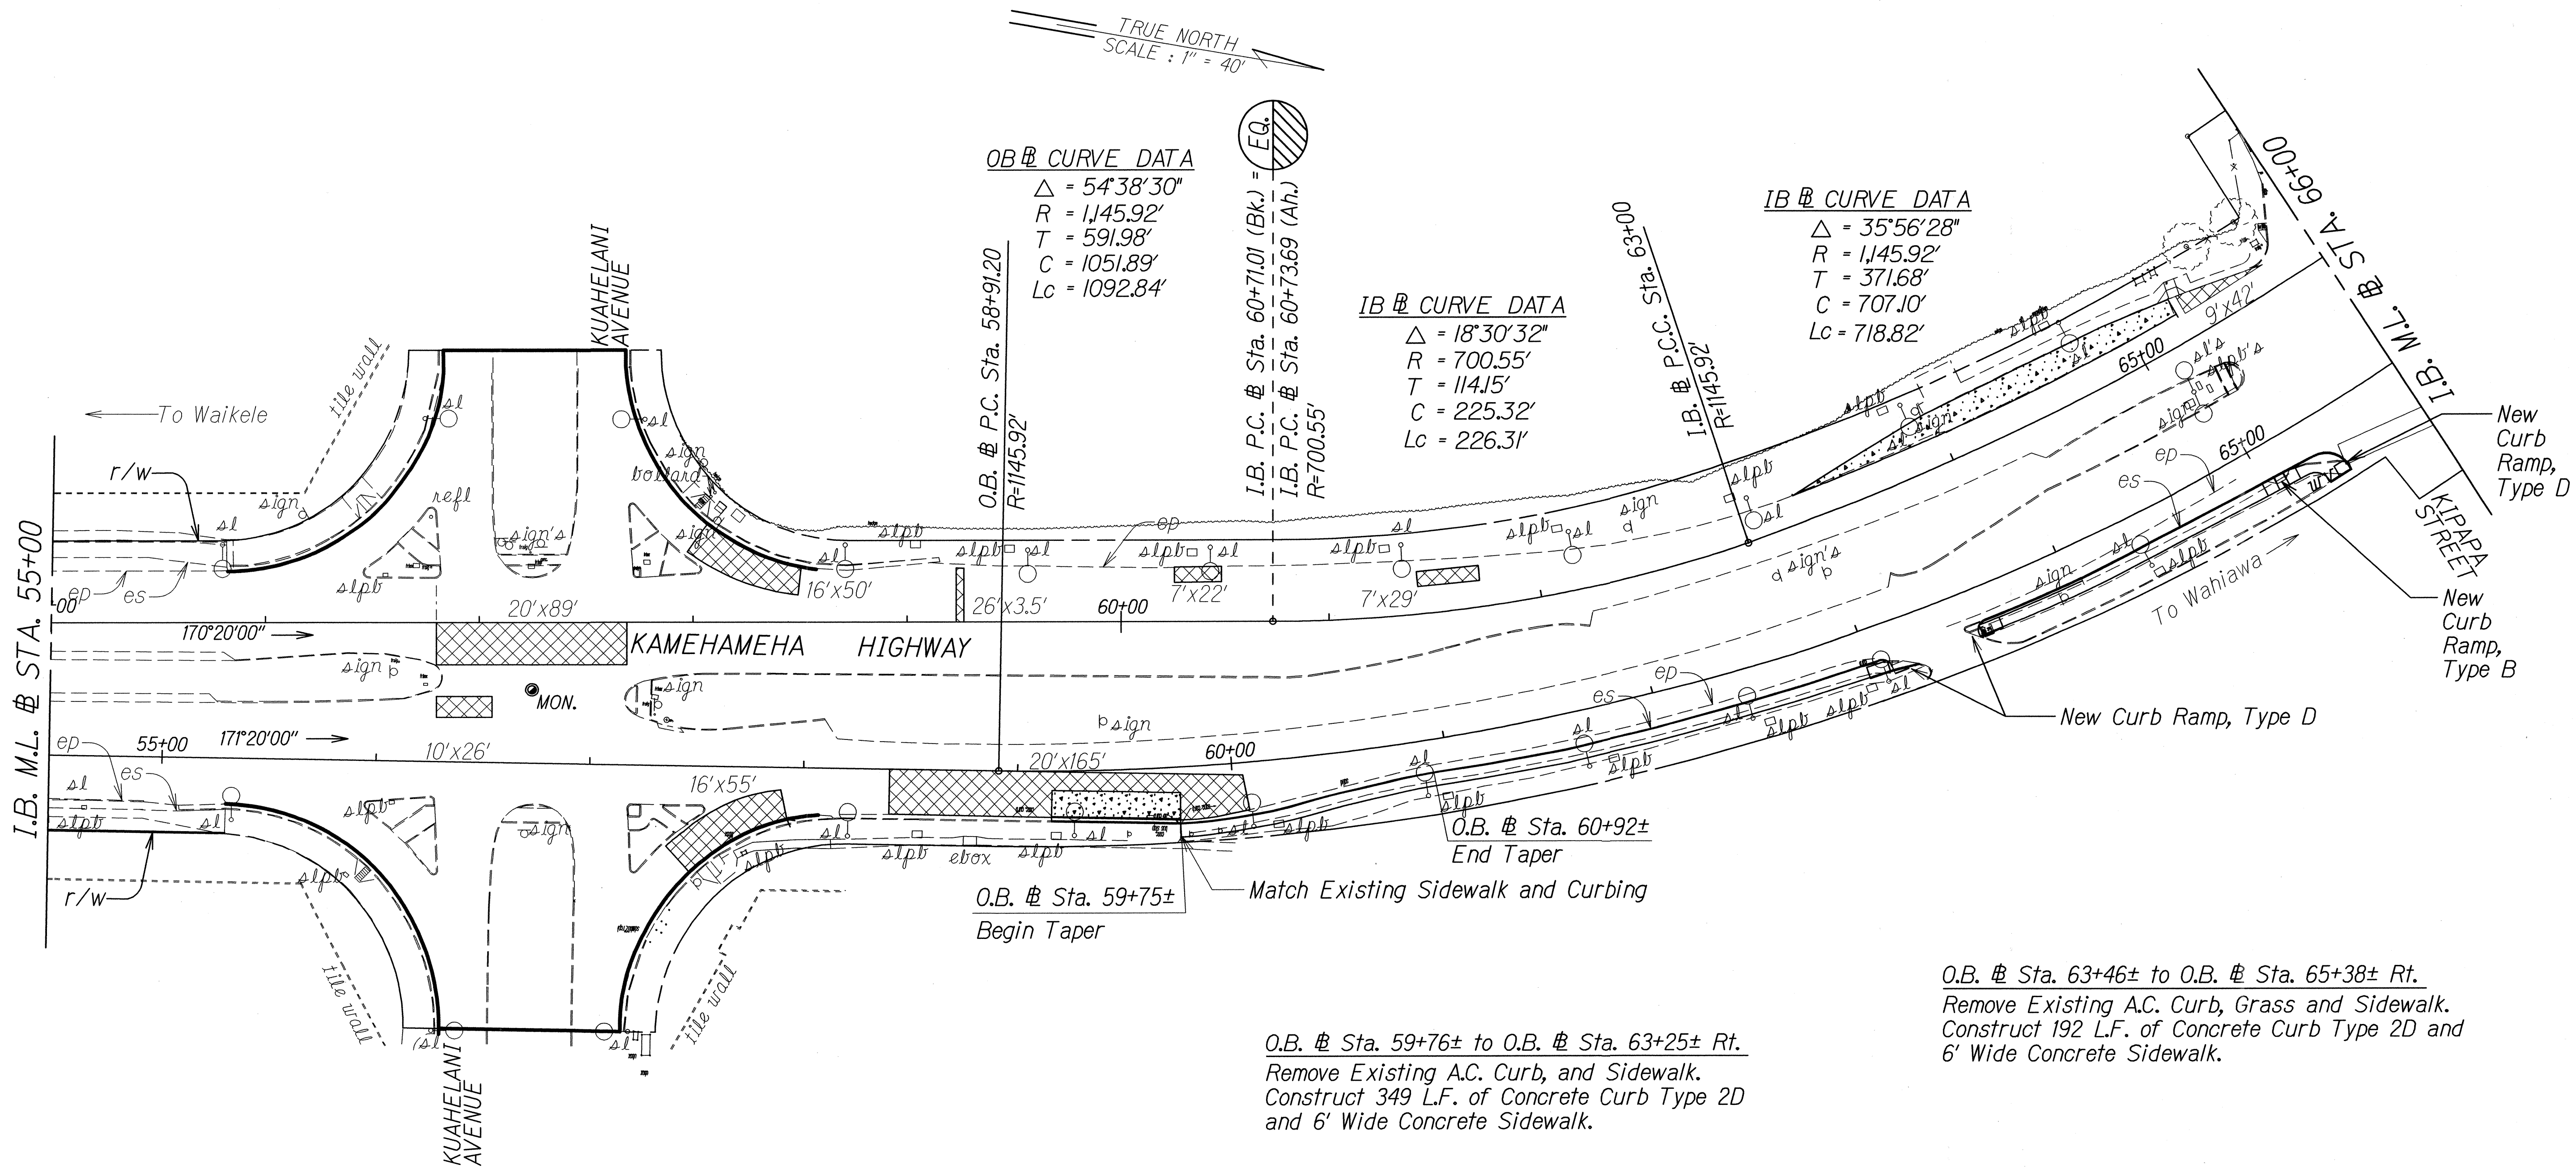

ORIGINAL PLAN	DATE
DESIGNED BY	
NOTED BY	
QUANTITIES BY	
CHECKED BY	


Note: See Plan Sheet Nos. 19 & 20
 for Curb Ramp Details.

STATE OF HAWAII
 DEPARTMENT OF TRANSPORTATION
 HIGHWAYS DIVISION

ROADWAY PLAN
 KAMEHAMEHA HIGHWAY RESURFACING
 Vicinity of Ka Uka Boulevard
 to Vicinity of Waihiwa Street
 Federal Aid Project No. NH-099-1(029)
 Scale: 1" = 40' Date: Sept., 2013

SHEET No. 9 OF 10 SHEETS

FED. ROAD DIST. NO.	STATE	FED. AID PROJ. NO.	FISCAL YEAR	SHEET NO.	TOTAL SHEETS
HAWAII	HAW.	NH-099-1(029)	2014	46	84

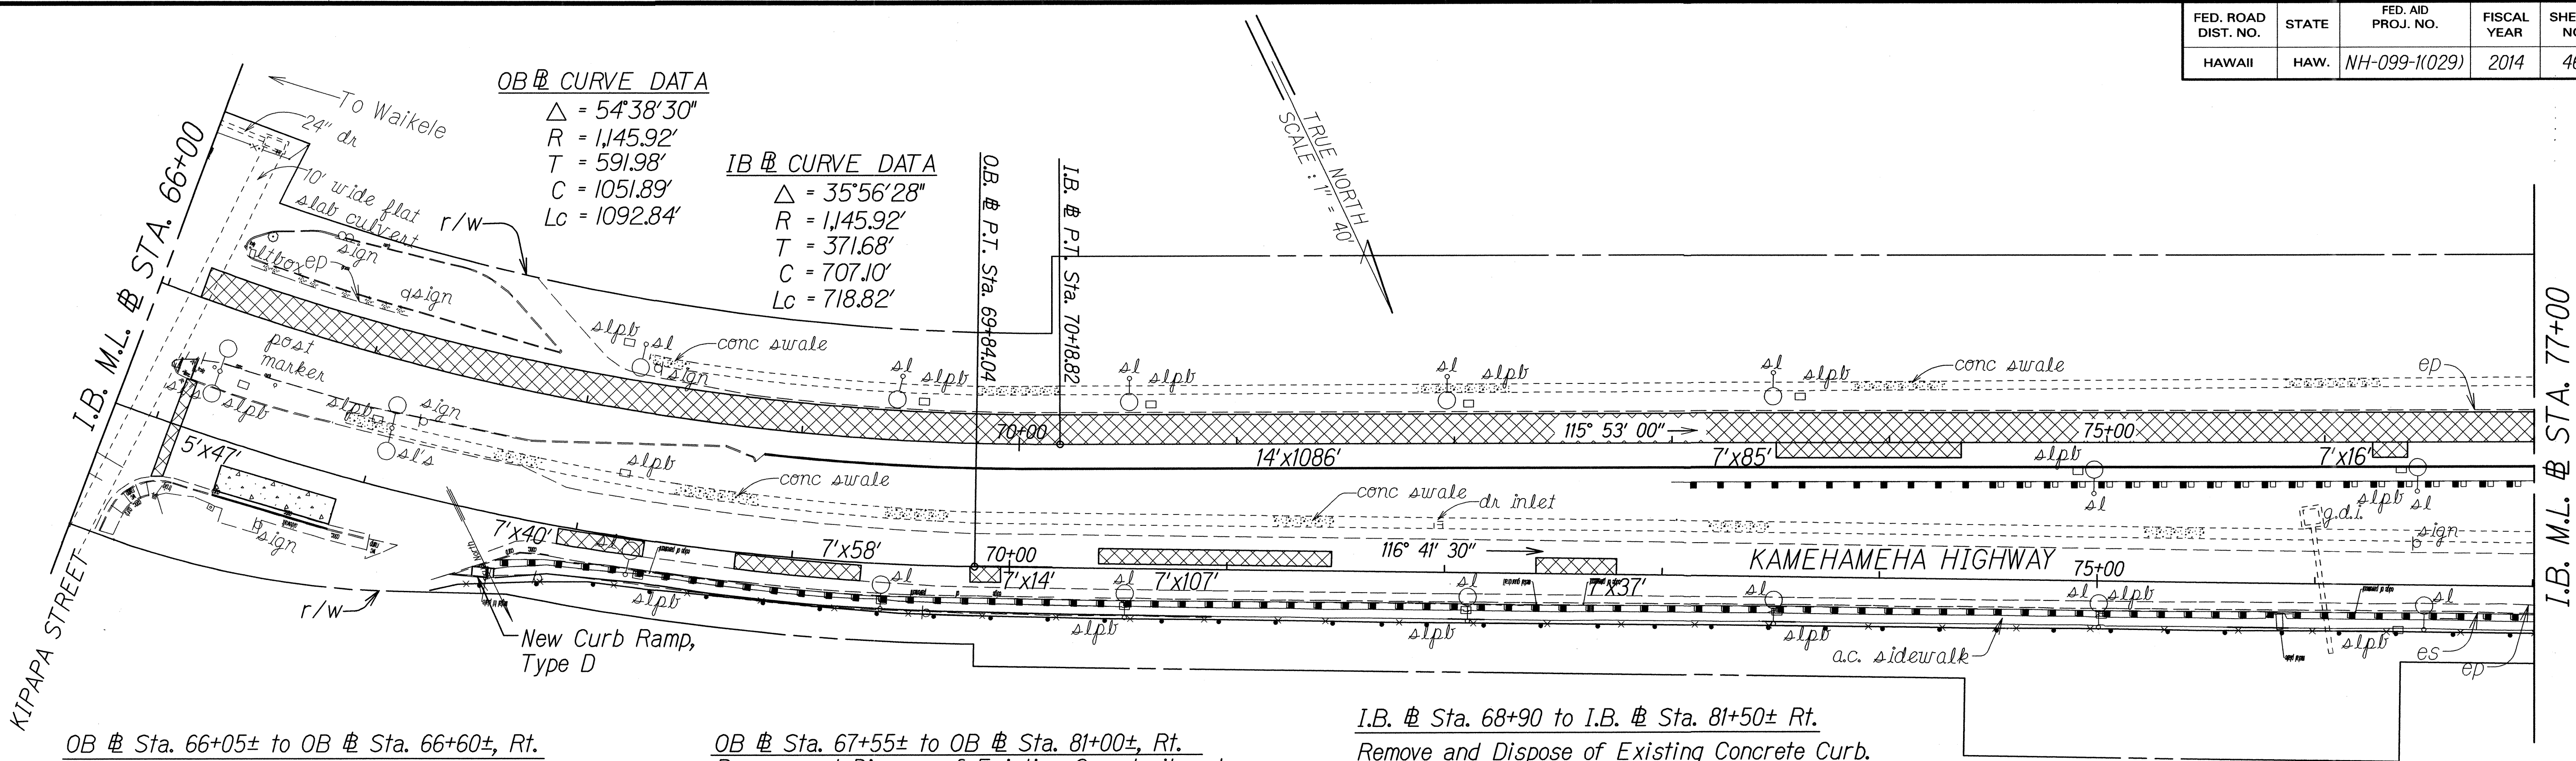

OB @ Sta. 66+05± to OB @ Sta. 66+60±, Rt.
Remove Existing Concrete Curb and Gutter. Construct 55' x 12' Concrete Bus Pad and 55 L.F. Concrete Curb and Gutter, Type 2DG from End of Bus Shelter. See Standard Plans for Details.


OB @ Sta. 67+55± to OB @ Sta. 81+00±, Rt.
Remove and Dispose of Existing Guardrail and Posts. Install 1345 L.F. of New W-Beam Guardrail with New Type G at both Approach and Trailing Ends. Remove Existing A.C. Sidewalk. Construct 1345 L.F. of 4' Wide A.C. Sidewalk. Match Existing Curb Ramp at Waihau Street. Remove and Dispose of Existing Chain Link Fence and Concrete Footings. Install 1345 L.F. of 6' High New Chain Link Fence on Concrete Footings.

I.B. @ Sta. 68+90 to I.B. @ Sta. 81+50± Rt.
Remove and Dispose of Existing Concrete Curb. Install 1300 L.F. of New Concrete Curb, Type 2D. Match Existing Curb at both ends. See Typical Sections for Details.

O.B. @ Sta. 75+80± Rt.
Remove and Dispose of 10 L.F. of Existing Chain Link Fence and Concrete Footings.

I.B. @ Sta. 73+00 to I.B. @ Sta. 81+50± Rt.
Remove and Dispose of Existing Guardrail and Posts. Install 850 L.F. of New Thrie Beam Guardrail with New Type G at Trailing End. Remove Transition Section plus 12'-6\"/>

Note: See Plan Sheet No. 21 for Curb Ramp Details.

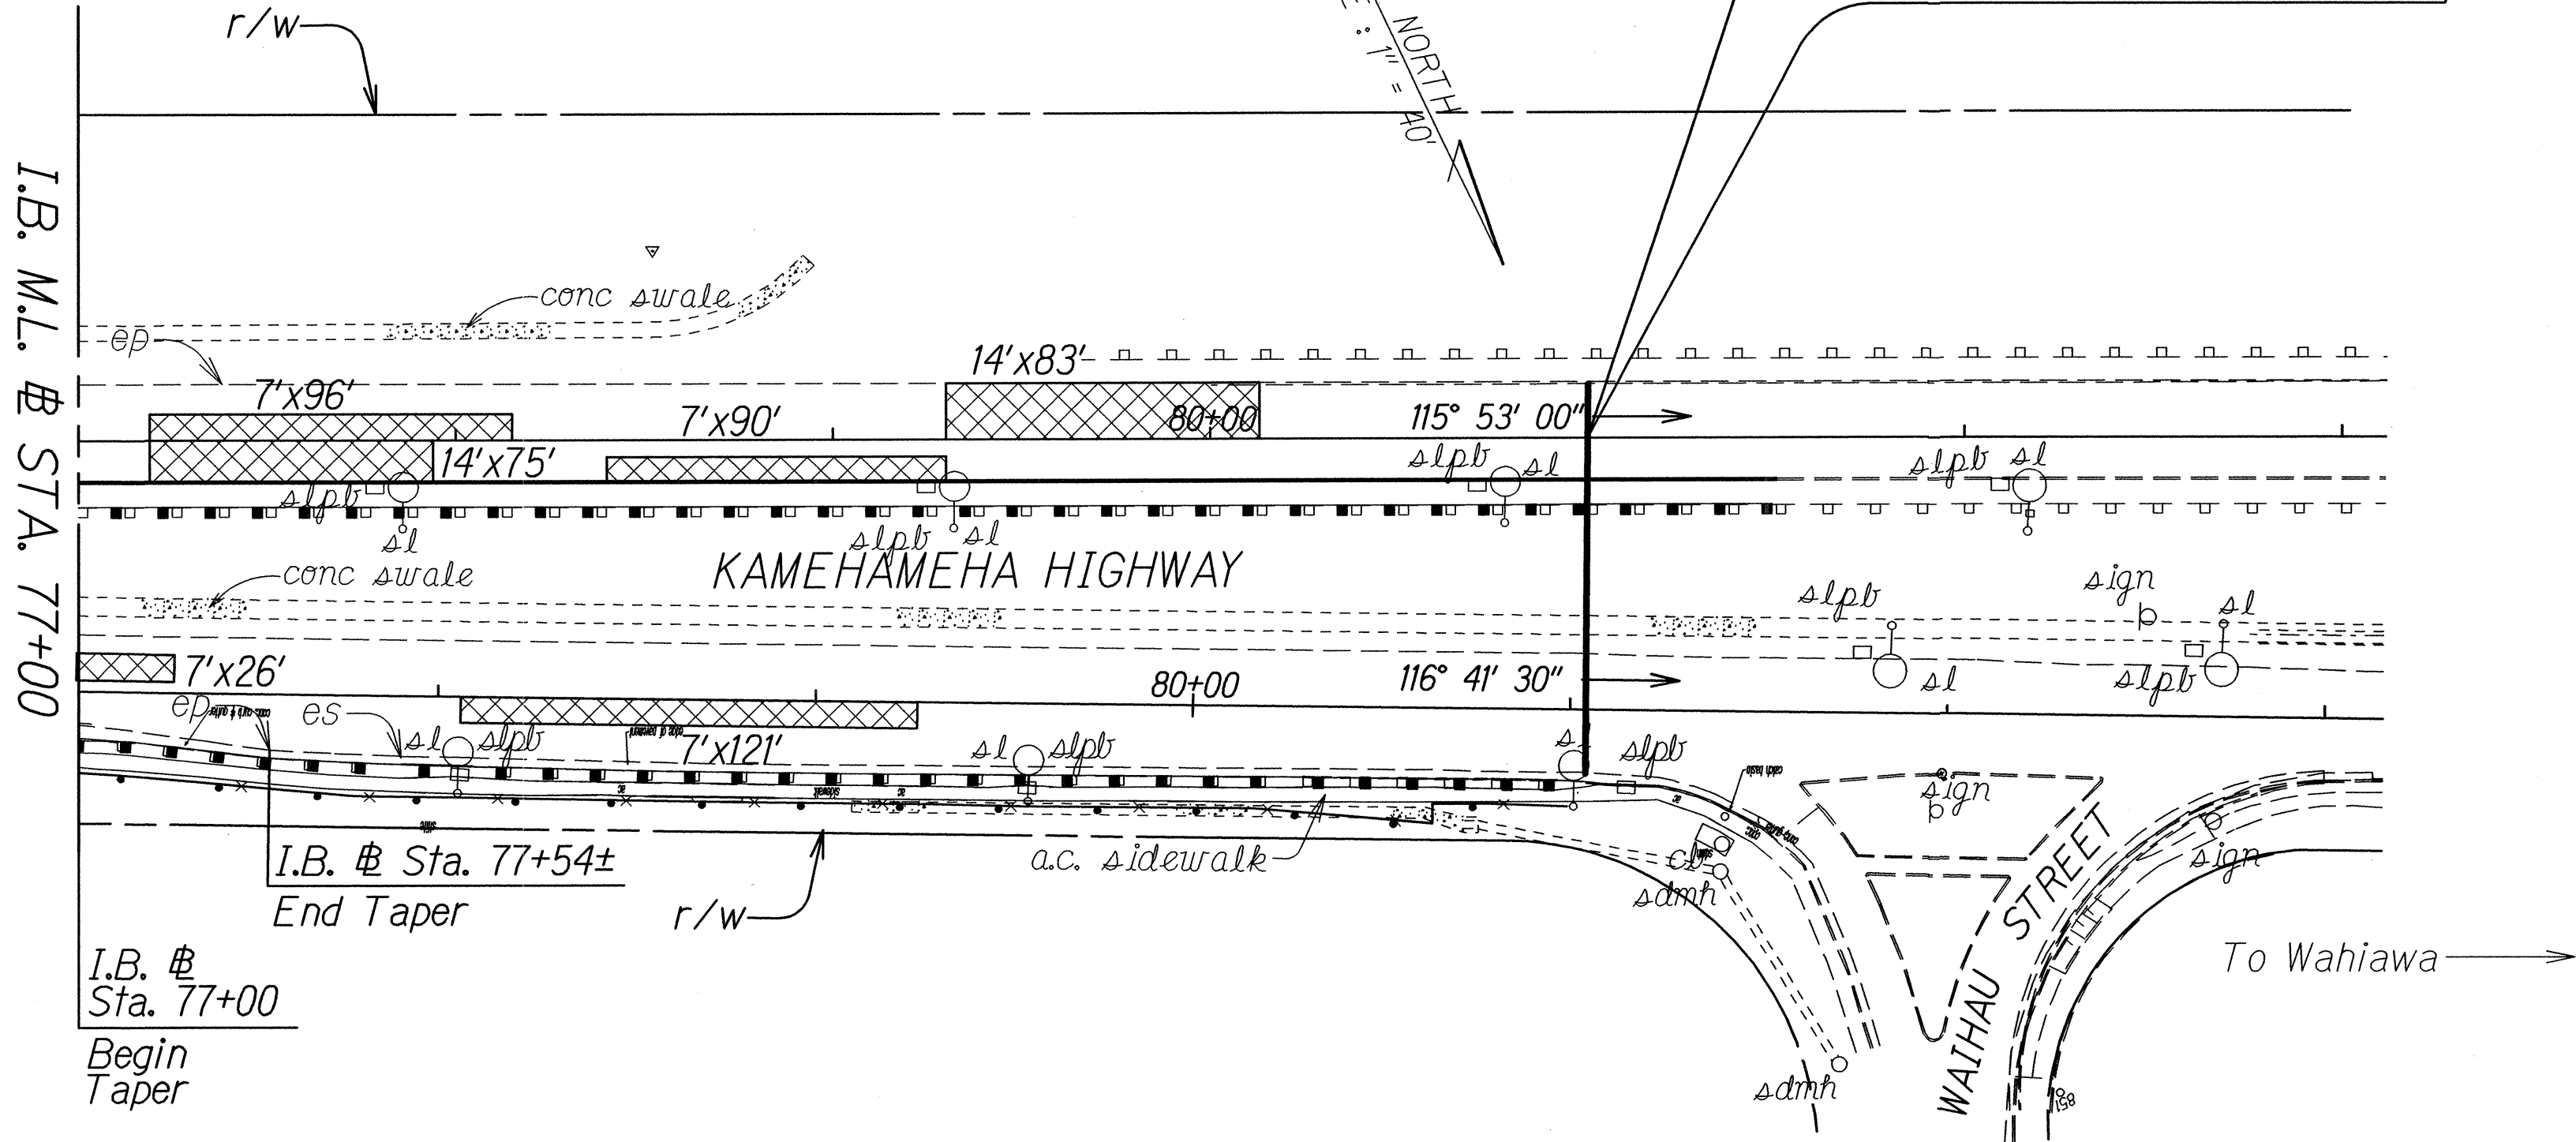

STATE OF HAWAII
DEPARTMENT OF TRANSPORTATION
HIGHWAYS DIVISION

ROADWAY PLAN

KAMEHAMEHA HIGHWAY RESURFACING

Vicinity of Ka Uka Boulevard
to Vicinity of Waihau Street

Federal Aid Project No. NH-099-1(029)

Scale: 1" = 40' Date: Sept., 2013

SHEET No. 10 OF 10 SHEETS

ORIGINAL PLAN	SURVEY PLOTTED BY	DATE
NOTE BOOK	DRAWN BY	
dd3holy	DESIGNED BY	
mmadillon	QUANTITIES BY	
	CHECKED BY	