



FED. ROAD DIST. NO.	STATE	PROJ. NO.	FISCAL YEAR	SHEET NO.	TOTAL SHEETS
OAHU	HAW.	99C-01-13	2014	ADD41	41


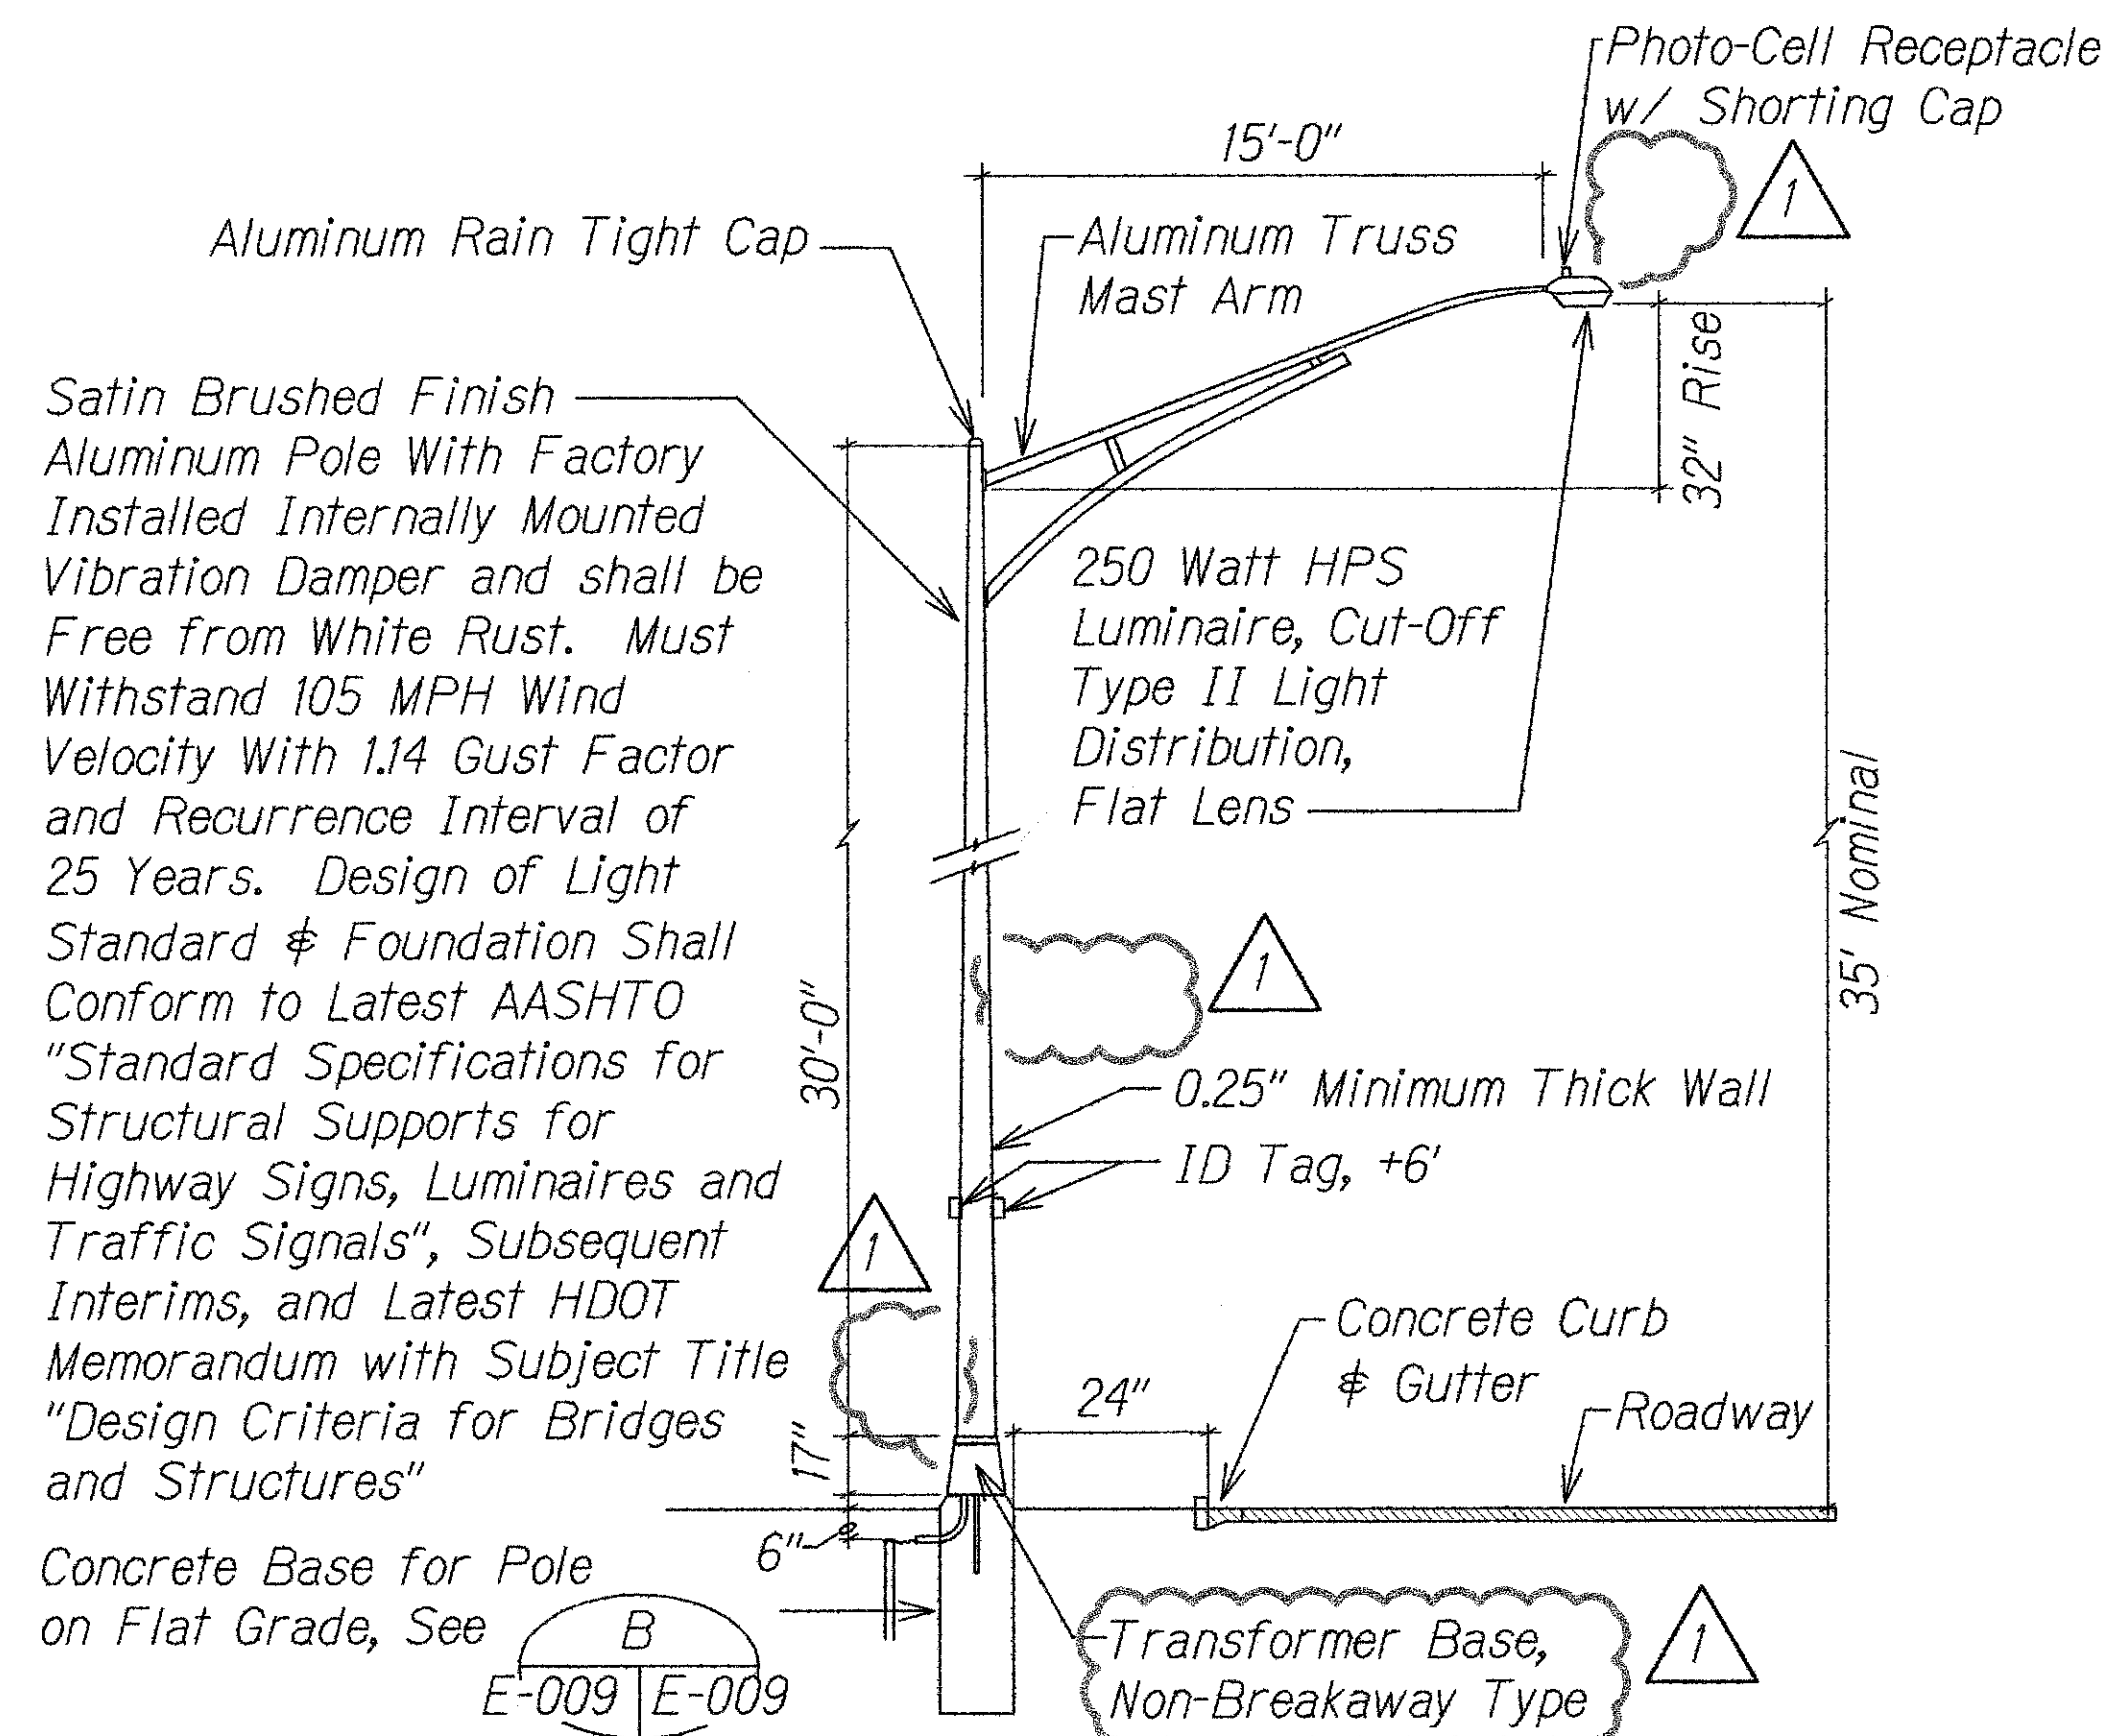


STREET LIGHT STANDARD DETAIL
E-004 E-009 NTS

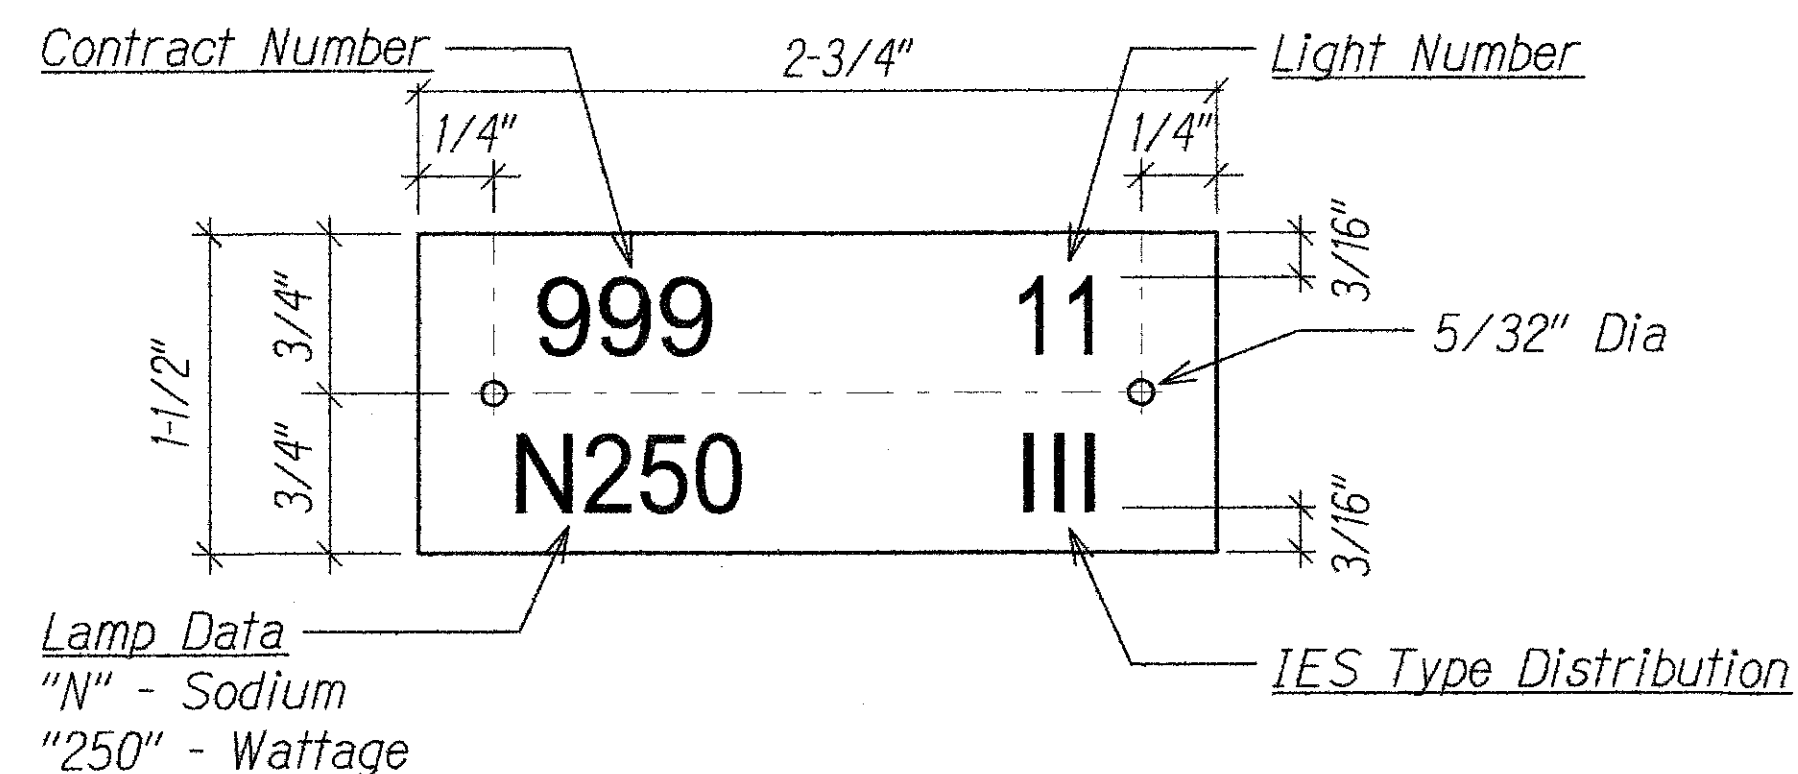


STATE - STREET LIGHT I.D. TAG DETAIL
E-004 E-009 NTS

- NOTES:**
1. Use 3-Ply Laminated Flexible Plastic, Black-white-black Thickness: Black Cap & Sheet - 0.010", White Middle Sheet - 0.052".
 2. Letters and Numbers Shall be Enlarged 1/4" High, 1/16" Stroke, White in Color.
 3. Attach to Steel Pole with No. 8 Stainless Steel. 1/2" Long Drive Screws in 1/8" Drill Hole.
 4. Letters and numbers Shall be Enlarged Through "Black Cap Sheet" to Expose "White" Letters.

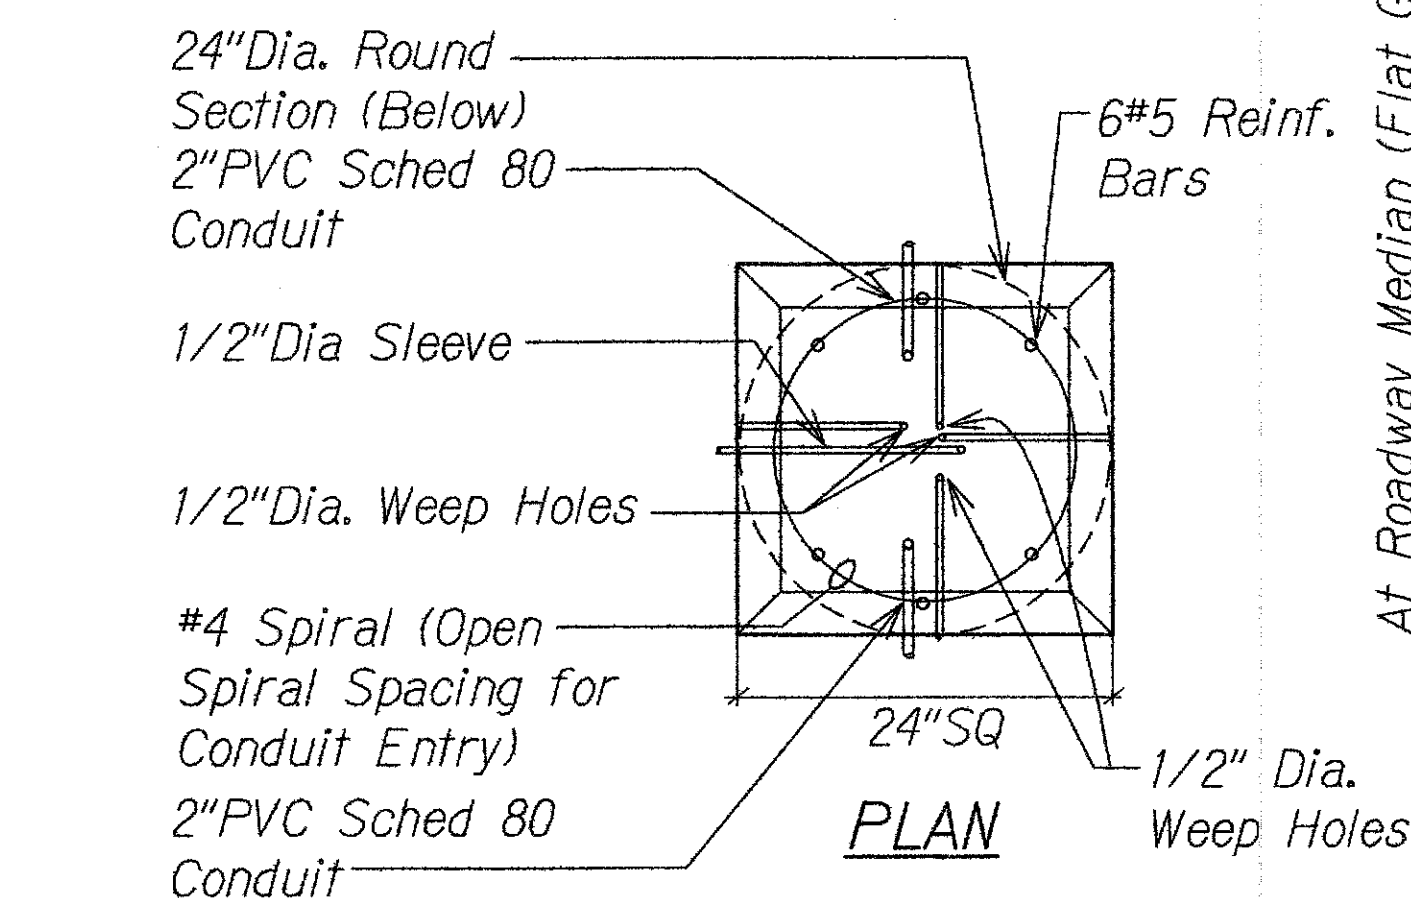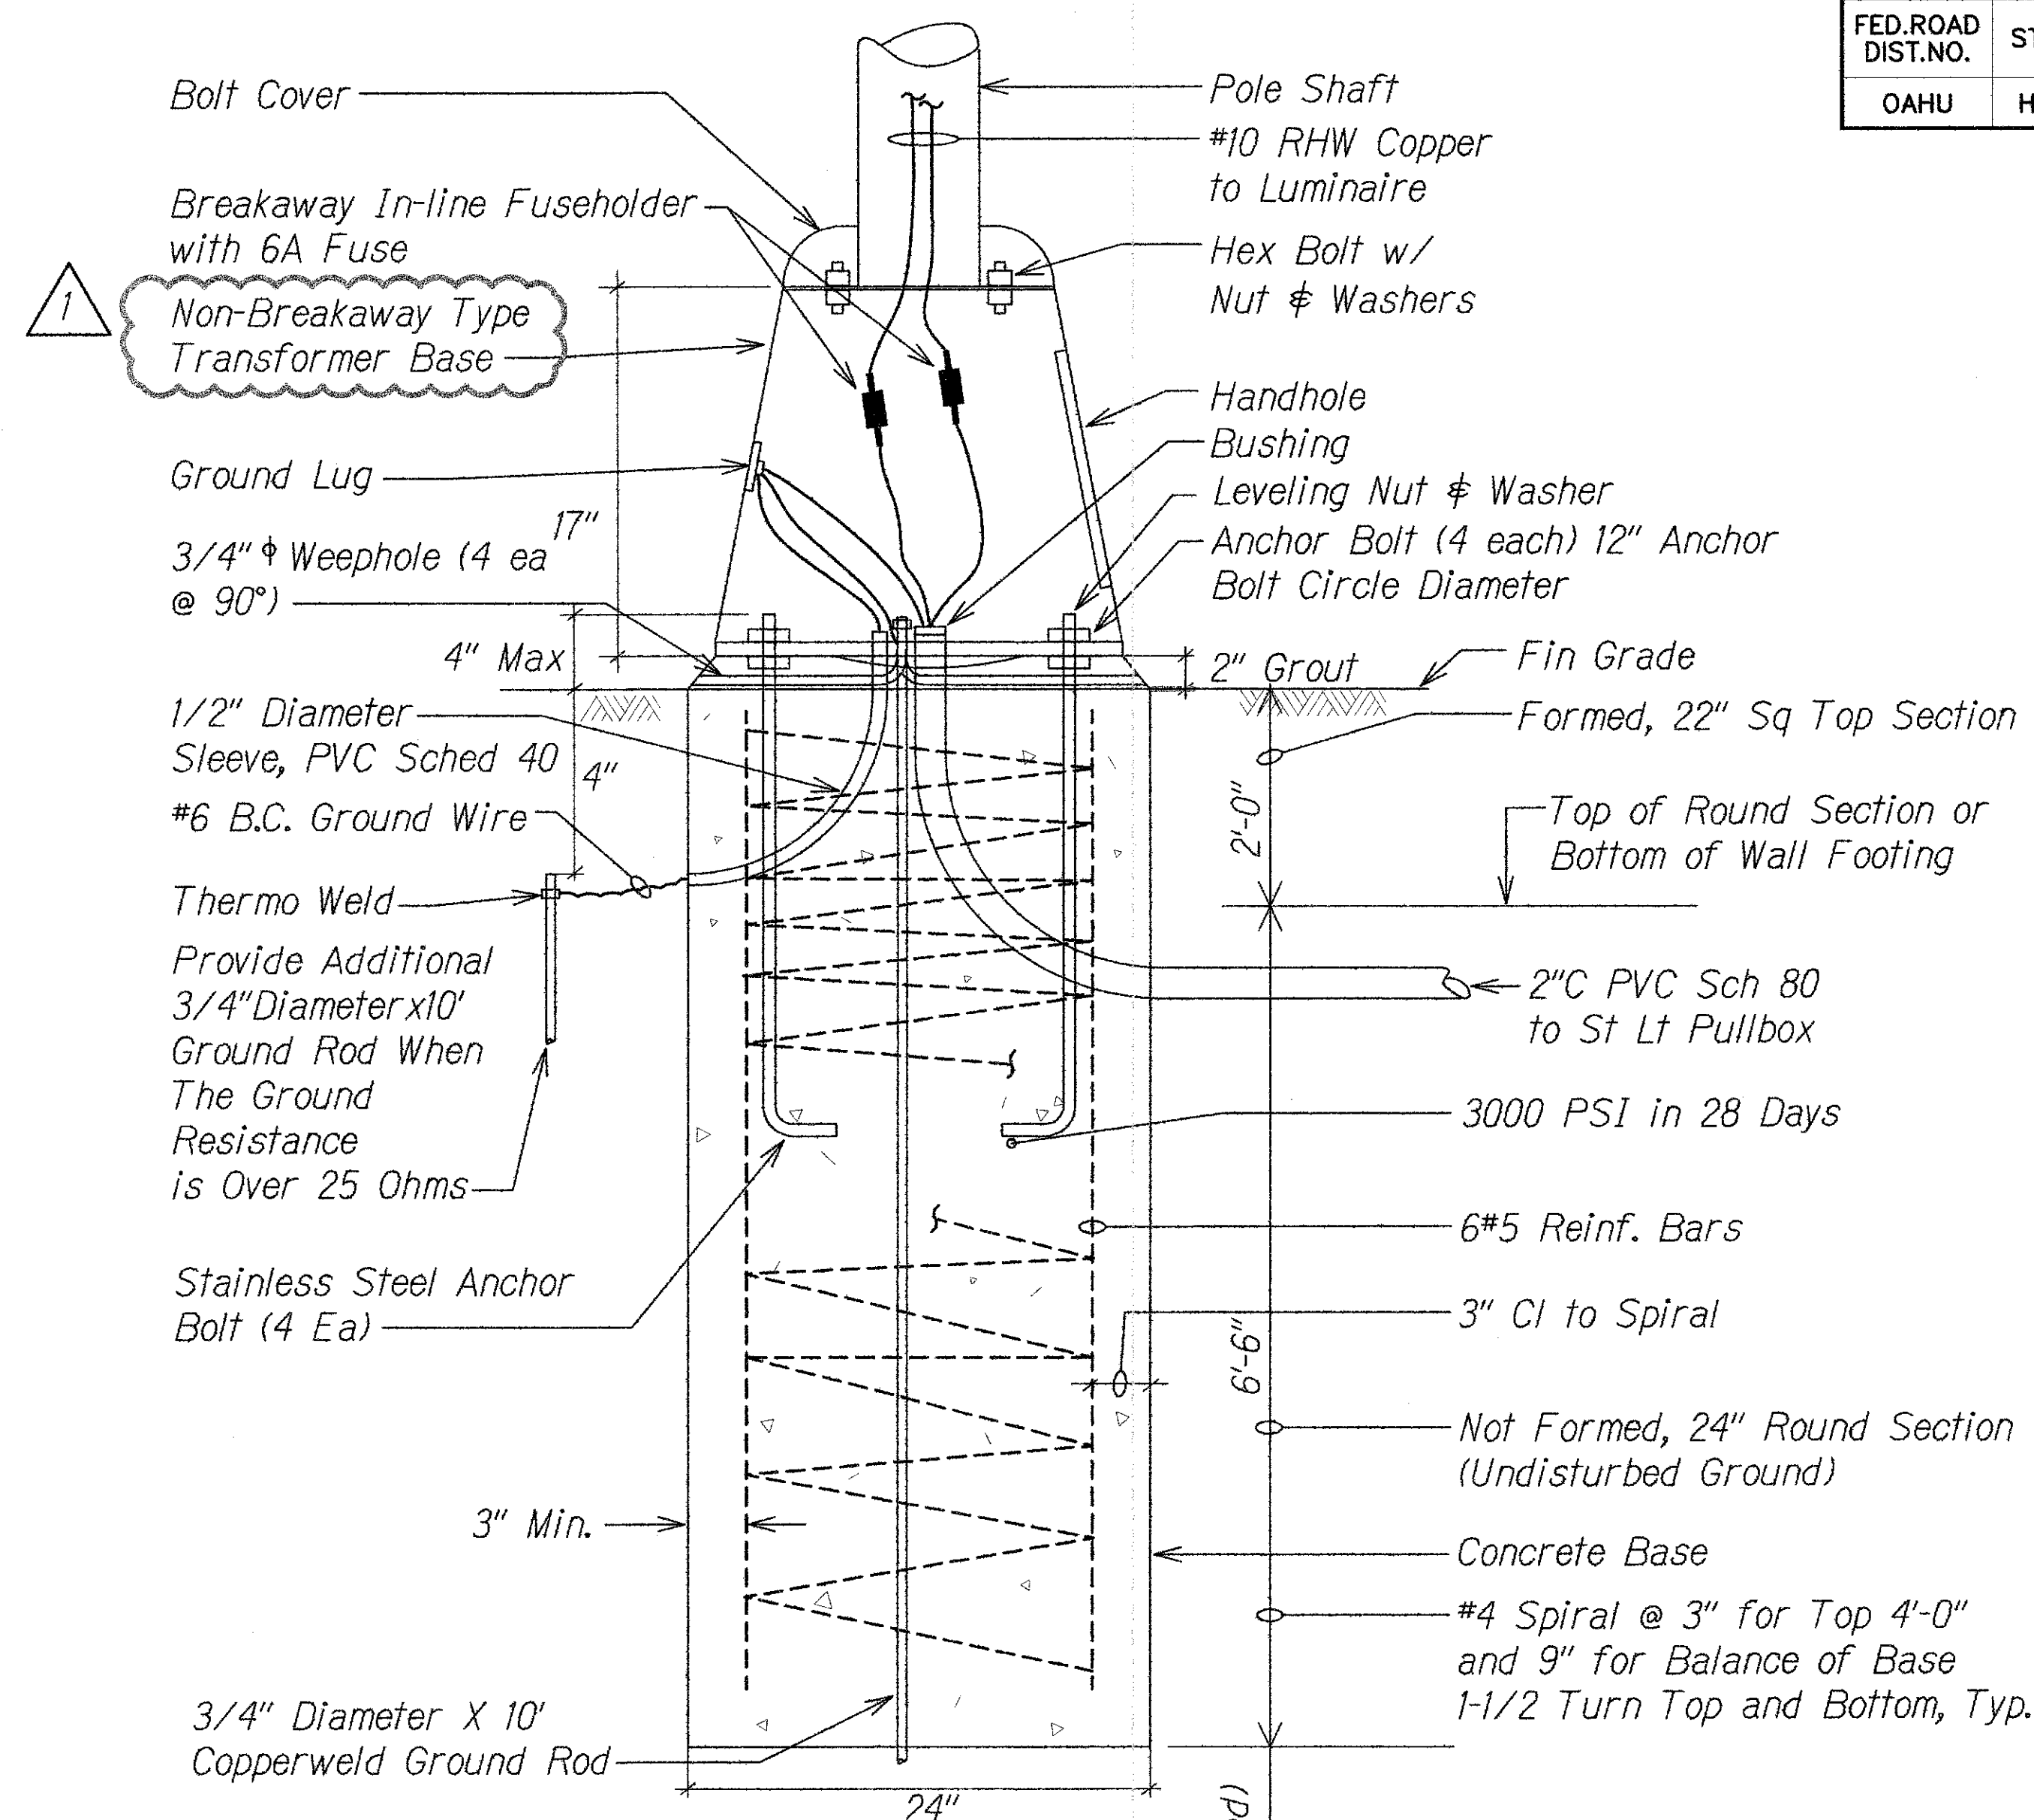

TYPICAL TRANSFORMER BASE WIRING DETAIL
E-009 E-009 NTS

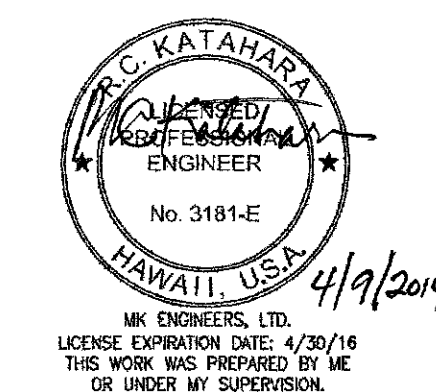

04/07/14	REVISE TRANS. BASE TO NON-BREAKAWAY TYPE
DATE	REVISION
STATE OF HAWAII DEPARTMENT OF TRANSPORTATION HIGHWAYS DIVISION	
STREET LIGHTING DETAILS	
TRAFFIC OPERATIONAL IMPROVEMENTS AT VARIOUS LOCATIONS Vicinity of Kamehameha Highway and Lumaina Street	
Project No. 99C-01-13	
Scale: As Noted	Date: Apr 2014
SHEET No. E-009 OF 9 SHEETS	