
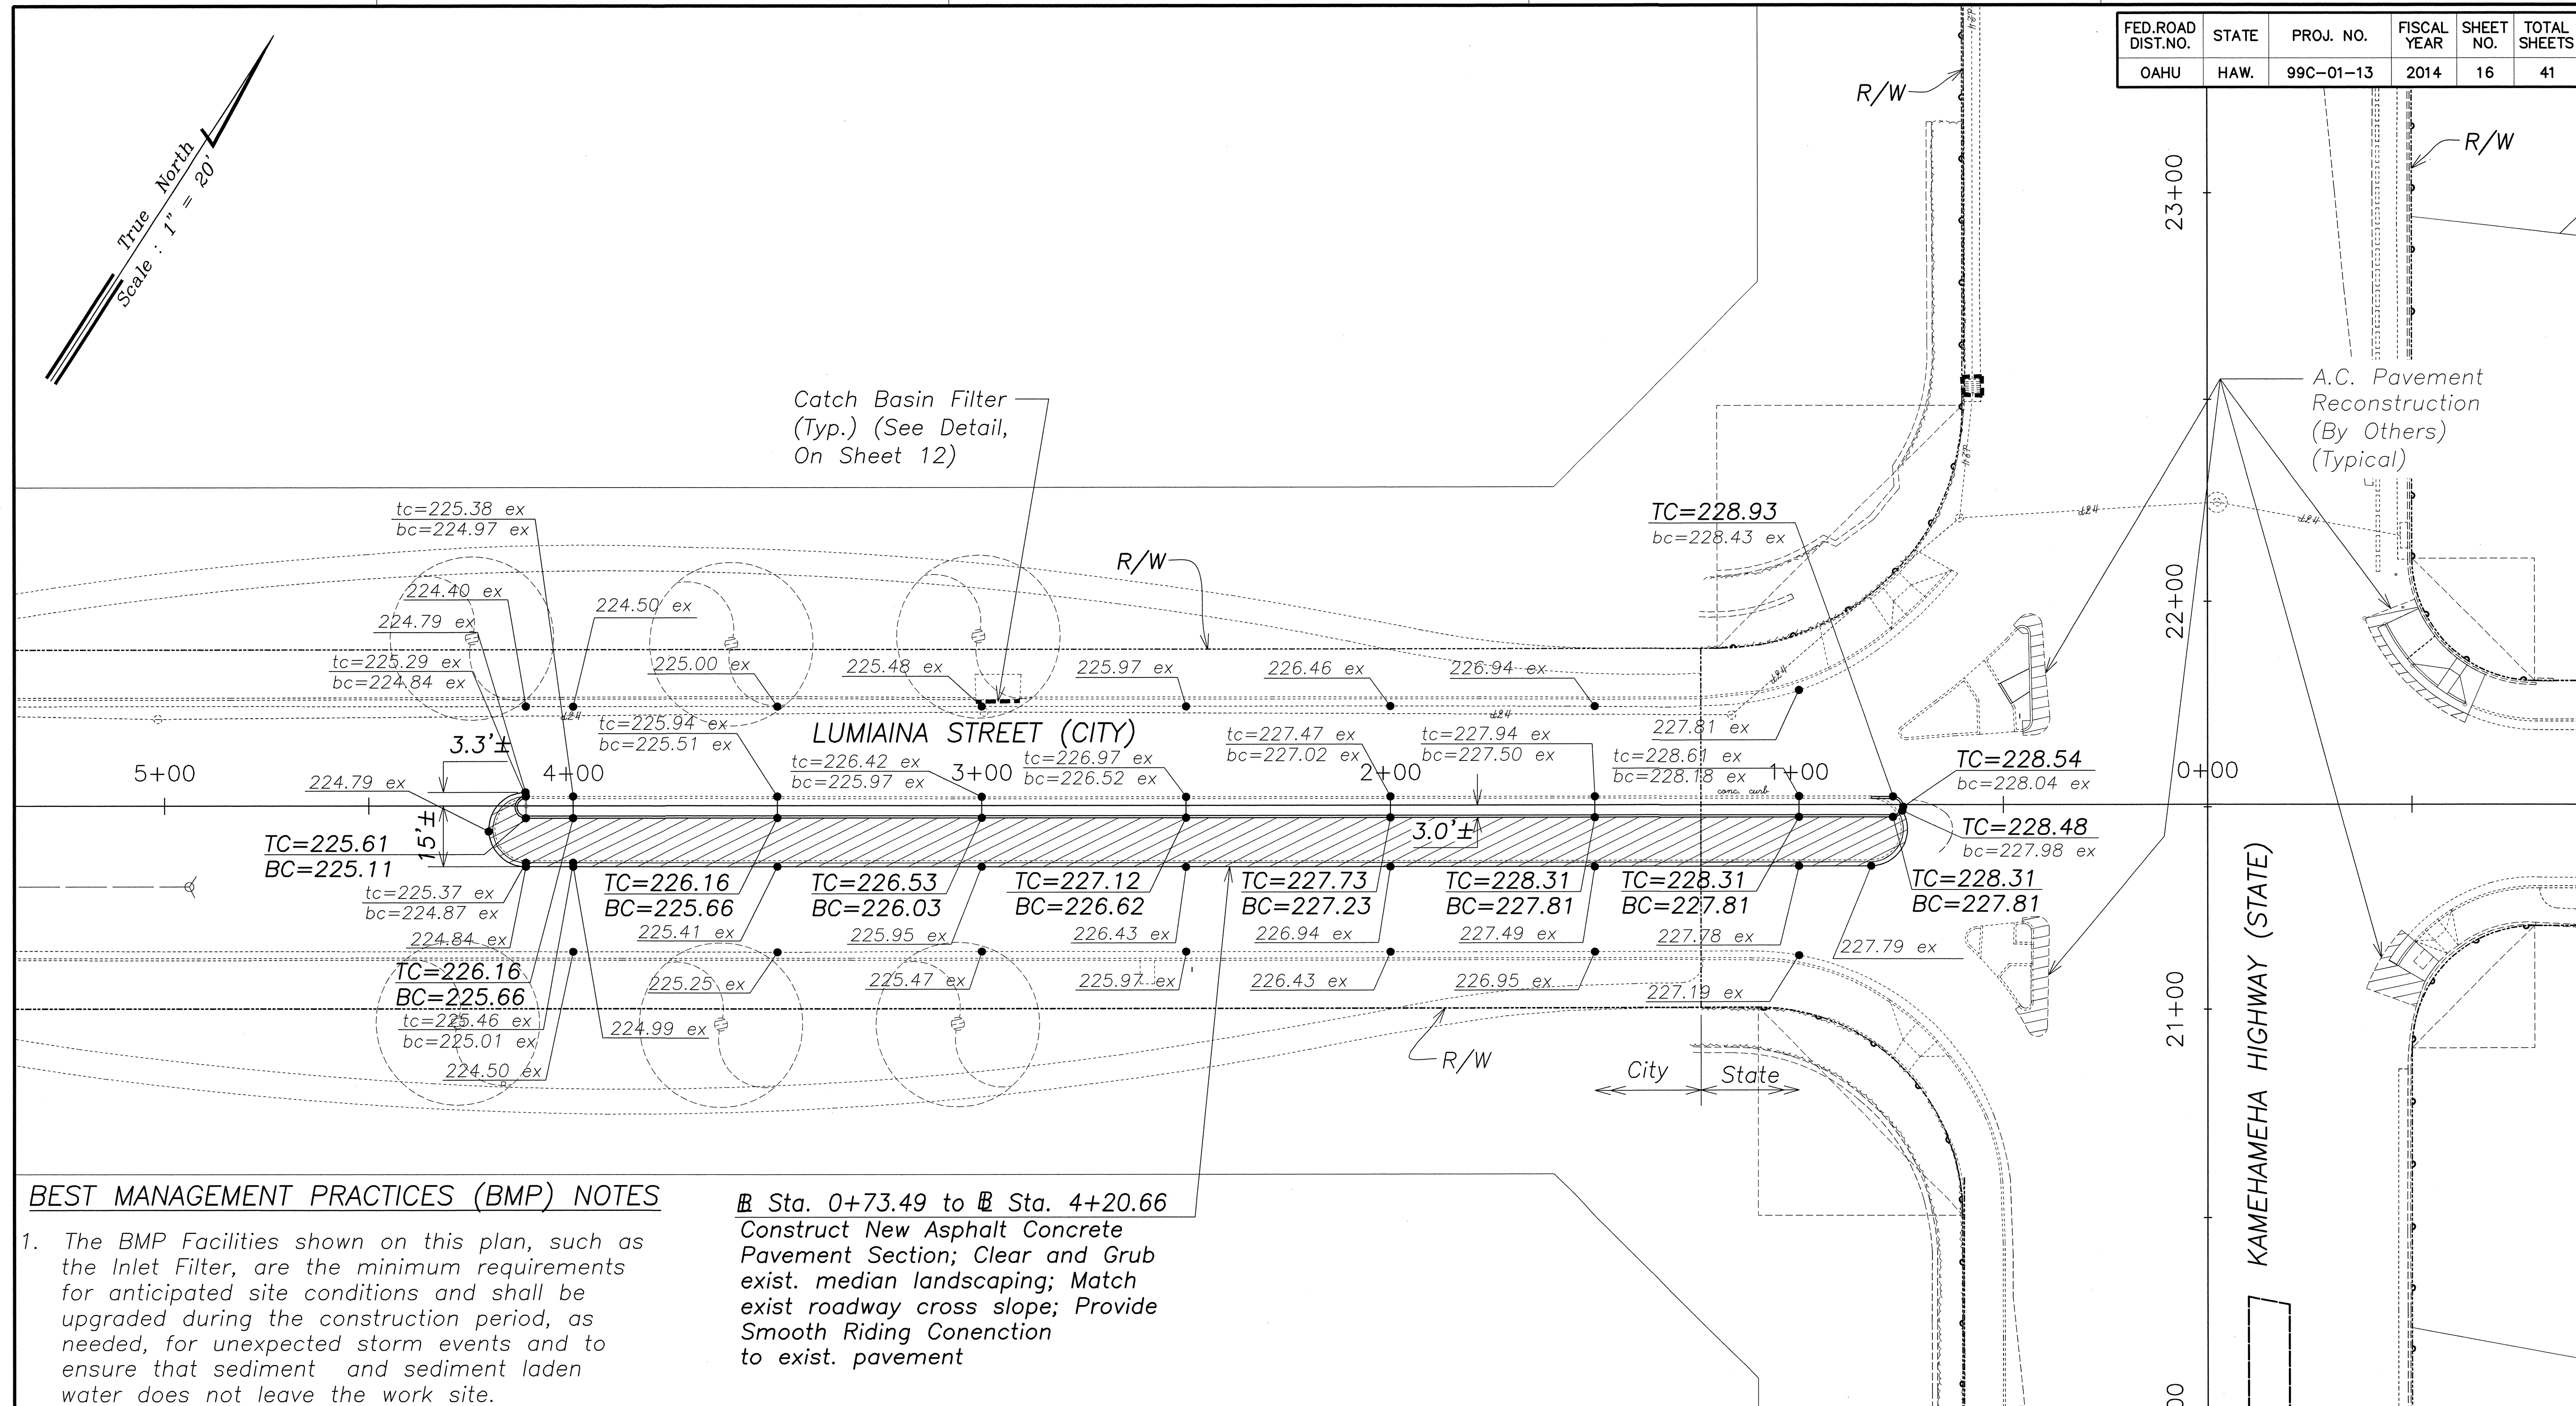


FED. ROAD DIST. NO.	STATE	PROJ. NO.	FISCAL YEAR	SHEET NO.	TOTAL SHEETS
OAHU	HAW.	99C-01-13	2014	16	41

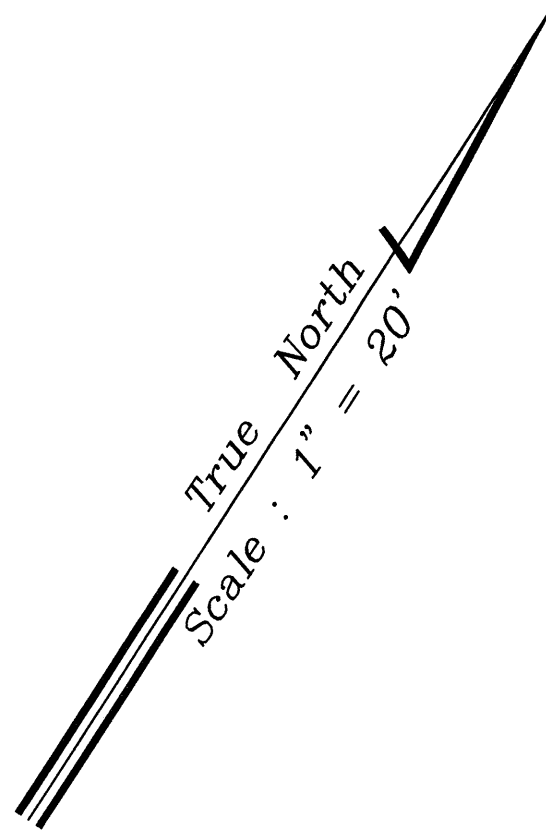

BEST MANAGEMENT PRACTICES (BMP) NOTES


1. The BMP Facilities shown on this plan, such as the Inlet Filter, are the minimum requirements for anticipated site conditions and shall be upgraded during the construction period, as needed, for unexpected storm events and to ensure that sediment and sediment laden water does not leave the work site.
2. Provide Inlet Filter (Tru Dam® Inlet Protection or approved equal) for all catch basin openings, See Detail on Sheet 15)
3. Dust Control should be applied to reduce dust emissions. The Contractor, at his own expense, shall keep the Project Area and surrounding area free from dust nuisance. The work shall be in conformance with the Air Pollution Control Standards contained in the Hawaii Administrative Rules: Chapter 11-60, "Air Pollution Control".

Sta. 0+73.49 to Sta. 4+20.66
Construct New Asphalt Concrete Pavement Section; Clear and Grub exist. median landscaping; Match exist roadway cross slope; Provide Smooth Riding Connection to exist. pavement

SURVEY PLOTTED BY	DATE
DRAWN BY	
DESIGNED BY	
CHECKED BY	
NOTE BOOK	
No.	



APPROVED:
Melvin J. Johnson 1/22/14
DATE
ENGINEER'S SURVEYORS HAWAII, INC.
(FOR WORK WITHIN THE CITY R/W ONLY)

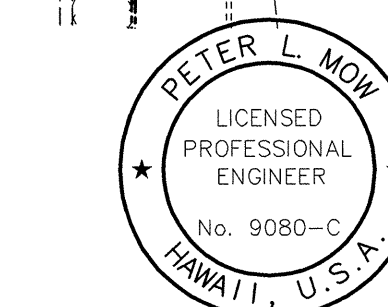

THIS WORK WAS PREPARED BY ME OR UNDER MY SUPERVISION AND CONSTRUCTION OF THIS PROJECT WILL BE UNDER MY OBSERVATION. ("OBSERVATION OF CONSTRUCTION" SHALL BE AS DEFINED IN CHAPTER 115, RULES OF THE BOARD OF PROFESSIONAL ENGINEERS, ARCHITECTS AND SURVEYORS, STATE OF HAWAII, SUBCHAPTER 1, SECTION 16-115-2 DEFINITIONS, EFFECTIVE 08/29/94).
Peter L. Mow
ENGINEER'S SURVEYORS HAWAII, INC.
MY LICENSE EXPIRES: APRIL 30, 2014

STATE OF HAWAII
DEPARTMENT OF TRANSPORTATION
HIGHWAYS DIVISION

FINISH GRADE PLANS

**TRAFFIC OPERATIONAL IMPROVEMENTS
AT VARIOUS LOCATIONS**

**Vicinity of Kamehameha Highway and
Lumaina Street**

Project No. 99C-01-13

Scale: As Noted Date: Jan 2014

SHEET No. 1 OF 1 SHEETS